

Date: Oct 07, 2020, 4:18pm User Name: mlongtin  
 File: P:\1321 - Toledo E Value Engineering\DWGS\BRIDGE\LUC-75-0027 over Maumee River\Sheets\000 INDEX SHEET.dwg


Sheet	Description	Revised for VECP
1295	2 SITE PLAN - 2 OF 6	Revised
1296	3 SITE PLAN - 3 OF 6	Revised
1297	4 SITE PLAN - 4 OF 6	
1298	5 SITE PLAN - 5 OF 6	
1299	6 SITE PLAN - 6 OF 6	
1300	7 GENERAL PLAN - 1 OF 3	Revised
1301	8 GENERAL PLAN - 2 OF 3	Revised
1302	9 GENERAL PLAN - 3 OF 3	Revised
1303	10 GEOMETRIC LAYOUT PLAN - 1 OF 3	Revised
1304	11 GEOMETRIC LAYOUT PLAN - 2 OF 3	Revised
1305	12 GEOMETRIC LAYOUT PLAN - 3 OF 3	Revised
1306	13 GENERAL NOTES	Revised
1307	14 GENERAL NOTES	
1308	15 GENERAL NOTES	
1309	16 ESTIMATED QUANTITIES	Revised
1310	17 FOUNDATION PLAN - SOUTHBOUND	
1311	18 FOUNDATION PLAN - SOUTHBOUND	
1312	19 FOUNDATION PLAN - SOUTHBOUND	
1313	20 FOUNDATION PLAN - NORTHBOUND	Revised
1314	21 FOUNDATION PLAN - NORTHBOUND	Revised
1315	22 FOUNDATION PLAN - NORTHBOUND	
1316	23 REAR ABUTMENT DETAILS - SOUTHBOUND	
1317	24 REAR ABUTMENT DETAILS - NORTHBOUND	Revised
1318	25 REAR ABUTMENT DETAILS	
1319	26 FORWARD ABUTMENT DETAILS - SOUTHBOUND	
1320	27 FORWARD ABUTMENT DETAILS - NORTHBOUND	
1321	28 FORWARD ABUTMENT DETAILS	
1322	29 PIER - COLUMN DETAILS	Revised
1323	30 PIER 1-SB - PLAN AND ELEVATION	
1324	31 PIER 2-SB - PLAN AND ELEVATION	
1325	32 PIER 3-SB, 3-NB, 4-SB, 4-NB, 5-NB - PLAN AND ELEVATION	Revised
1326	33 PIER 5-SB - PLAN AND ELEVATION	
1327	34 PIER 6-SB - PLAN AND ELEVATION	
1328	35 PIER 7-SB, 7-NB, 11-NB - PLAN AND ELEVATION	Revised
1328A	35A PIER 3-NB, 4-NB & 5-NB - PLAN AND ELEVATION	Added
1329	36 PIER 8-SB, 8-NB, 9-SB, 9-NB, 10-SB, 10-NB - PLAN AND ELEVATION	
1330	37 PIER 11-SB - PLAN AND ELEVATION	
1331	38 PIER 1-NB - PLAN AND ELEVATION	Revised
1332	39 PIER 2-NB - PLAN AND ELEVATION	Revised
1333	40 PIER 6-NB - PLAN AND ELEVATION	Revised
1334	41 PIER - MISCELLANEOUS DETAILS	
1335	42 PIER - SEISMIC PEDESTAL DETAILS	
1336	43 PIER - SEISMIC PEDESTAL DETAILS	
1337	44 PIER - SEISMIC PEDESTAL DETAILS	
1338	45 PIER - SEISMIC PEDESTAL DETAILS	
1339	46 PIER - SEISMIC PEDESTAL DETAILS	
1340	47 PIER - SEISMIC PEDESTAL DETAILS	
1341	48 ELASTOMERIC BEARING DETAILS - UNIT 1 SOUTHBOUND	
1342	49 ELASTOMERIC BEARING DETAILS - UNIT 2 SOUTHBOUND	
1343	50 ELASTOMERIC BEARING DETAILS - UNIT 3 SOUTHBOUND	
1344	51 ELASTOMERIC BEARING DETAILS - UNIT 1 NORTHBOUND	Revised
1345	52 ELASTOMERIC BEARING DETAILS - UNIT 2 NORTHBOUND	Revised
1346	53 ELASTOMERIC BEARING DETAILS - UNIT 3 NORTHBOUND	
1347	54 FRAMING PLAN	Revised
1348	55 FRAMING PLAN	Revised
1349	56 FRAMING PLAN	Revised
1350	57 FRAMING PLAN	Revised
1351	58 FRAMING PLAN	
1352	59 FRAMING PLAN	
1353	60 PRESTRESSED I-BEAM DETAILS	Revised
1354	61 PRESTRESSED I-BEAM DETAILS - UNIT 1 SOUTHBOUND	
1355	62 PRESTRESSED I-BEAM DETAILS - UNIT 2 SOUTHBOUND	
1356	63 PRESTRESSED I-BEAM DETAILS - UNIT 3 SOUTHBOUND	
1357	64 PRESTRESSED I-BEAM DETAILS - UNIT 1 NORTHBOUND	Revised
1358	65 PRESTRESSED I-BEAM DETAILS - UNIT 2 NORTHBOUND	Revised
1359	66 PRESTRESSED I-BEAM DETAILS - UNIT 3 NORTHBOUND	Revised
1360	67 PRESTRESSED I-BEAM DETAILS - UNIT 1 SOUTHBOUND	Revised
1361	68 PRESTRESSED I-BEAM DETAILS - UNIT 2 SOUTHBOUND	Revised
1362	69 PRESTRESSED I-BEAM DETAILS - UNIT 3 SOUTHBOUND	Revised
1363	70 PRESTRESSED I-BEAM DETAILS - UNIT 1 NORTHBOUND	Revised
1364	71 PRESTRESSED I-BEAM DETAILS - UNIT 2 NORTHBOUND	Revised
1365	72 PRESTRESSED I-BEAM DETAILS - UNIT 3 NORTHBOUND	Revised
1366	73 PRESTRESSED I-BEAM DETAILS	
1367	74 CAMBER TABLES - SOUTHBOUND	
1368	75 CAMBER TABLES - SOUTHBOUND	
1369	76 CAMBER TABLES - NORTHBOUND	Revised
1370	77 CAMBER TABLES - NORTHBOUND	
1371	78 DIAPHRAGM DETAILS - UNIT 1 SOUTHBOUND	
1372	79 DIAPHRAGM DETAILS - UNIT 2 SOUTHBOUND	
1373	80 DIAPHRAGM DETAILS - UNIT 3 SOUTHBOUND	
1374	81 DIAPHRAGM DETAILS - UNIT 1 NORTHBOUND	Revised
1375	82 DIAPHRAGM DETAILS - UNIT 2 NORTHBOUND	Revised

Sheet	Description	Revised for VECP
1376	83 DIAPHRAGM DETAILS - UNIT 3 NORTHBOUND	
1377	84 DIAPHRAGM DETAILS	Revised
1378	85 SLAB PLAN - 1 OF 27	
1379	86 SLAB PLAN - 2 OF 27	
1380	87 SLAB PLAN - 3 OF 27	
1381	88 SLAB PLAN - 4 OF 27	
1382	89 SLAB PLAN - 5 OF 27	
1383	90 SLAB PLAN - 6 OF 27	
1384	91 SLAB PLAN - 7 OF 27	
1385	92 SLAB PLAN - 8 OF 27	
1386	93 SLAB PLAN - 9 OF 27	
1387	94 SLAB PLAN - 10 OF 27	
1388	95 SLAB PLAN - 11 OF 27	
1389	96 SLAB PLAN - 12 OF 27	
1390	97 SLAB PLAN - 13 OF 27	Revised
1391	98 SLAB PLAN - 14 OF 27	Revised
1392	99 SLAB PLAN - 15 OF 27	Revised
1393	100 SLAB PLAN - 16 OF 27	Revised
1394	101 SLAB PLAN - 17 OF 27	Revised
1395	102 SLAB PLAN - 18 OF 27	Revised
1396	103 SLAB PLAN - 19 OF 27	Revised
1397	104 SLAB PLAN - 20 OF 27	Revised
1398	105 SLAB PLAN - 21 OF 27	Revised
1399	106 SLAB PLAN - 22 OF 27	Revised
1400	107 SLAB PLAN - 23 OF 27	Revised
1401	108 SLAB PLAN - 24 OF 27	Revised
1402	109 SLAB PLAN - 25 OF 27	Revised
1403	110 SLAB PLAN - 26 OF 27	Revised
1404	111 SLAB PLAN - 27 OF 27	Revised
1405	112 ADDITIONAL HAUNCH REINFORCEMENT	
1406	113 ADDITIONAL HAUNCH REINFORCEMENT	
1407	114 ADDITIONAL HAUNCH REINFORCEMENT	Revised
1408	115 DRAINAGE DETAILS	
1409	116 DRAINAGE DETAILS	
1410	117 SUGGESTED SLAB POUR SEQUENCE	Revised
1411	118 EXPANSION JOINT DETAILS	
1412	119 PARAPET AND MEDIAN BARRIER PLAN - 1 OF 12	
1413	120 PARAPET AND MEDIAN BARRIER PLAN - 2 OF 12	
1414	121 PARAPET AND MEDIAN BARRIER PLAN - 3 OF 12	
1415	122 PARAPET AND MEDIAN BARRIER PLAN - 4 OF 12	
1416	123 PARAPET AND MEDIAN BARRIER PLAN - 5 OF 12	
1417	124 PARAPET AND MEDIAN BARRIER PLAN - 6 OF 12	
1418	125 PARAPET AND MEDIAN BARRIER PLAN - 7 OF 12	Revised
1419	126 PARAPET AND MEDIAN BARRIER PLAN - 8 OF 12	Revised
1420	127 PARAPET AND MEDIAN BARRIER PLAN - 9 OF 12	Revised
1421	128 PARAPET AND MEDIAN BARRIER PLAN - 10 OF 12	Revised
1422	129 PARAPET AND MEDIAN BARRIER PLAN - 11 OF 12	Revised
1423	130 PARAPET AND MEDIAN BARRIER PLAN - 12 OF 12	Revised
1424	131 PARAPET DETAILS	
1425	132 MEDIAN BARRIER DETAILS	
1426	133 PARAPET WITH RAILING	
1427	134 LIGHT POLE PILASTER DETAILS	
1428	135 TRANSVERSE SECTION - 1 OF 6	
1429	136 TRANSVERSE SECTION - 2 OF 6	
1430	137 TRANSVERSE SECTION - 3 OF 6	
1431	138 TRANSVERSE SECTION - 4 OF 6	Revised
1432	139 TRANSVERSE SECTION - 5 OF 6	Revised
1433	140 TRANSVERSE SECTION - 6 OF 6	Revised
1434	141 DECK OVERHANGS	
1435	142 DECK OVERHANGS	Revised
1436	143 DECK SURFACE, SCREED AND TOP OF HAUNCH ELEVATIONS PLAN	Revised
1437	144 DECK SURFACE, SCREED AND TOP OF HAUNCH ELEVATIONS PLAN	Revised
1438	145 DECK SURFACE, SCREED AND TOP OF HAUNCH ELEVATIONS PLAN	Revised
1439	146 DECK SURFACE, SCREED AND TOP OF HAUNCH ELEVATIONS PLAN	Revised
1440	147 DECK SURFACE, SCREED AND TOP OF HAUNCH ELEVATIONS PLAN	Revised
1441	148 DECK SURFACE, SCREED AND TOP OF HAUNCH ELEVATIONS PLAN	Revised
1442	149 SCREED ELEVATIONS - SOUTHBOUND - UNIT 1	
1443	150 SCREED ELEVATIONS - SOUTHBOUND - UNIT 2	
1444	151 SCREED ELEVATIONS - SOUTHBOUND - UNIT 2	
1445	152 SCREED ELEVATIONS - SOUTHBOUND - UNIT 3	
1446	153 SCREED ELEVATIONS - SOUTHBOUND - UNIT 3	
1447	154 SCREED ELEVATIONS - NORTHBOUND - UNIT 1	Revised
1448	155 SCREED ELEVATIONS - NORTHBOUND - UNIT 2	Revised
1449	156 SCREED ELEVATIONS - NORTHBOUND - UNIT 2	Revised
1450	157 SCREED ELEVATIONS - SOUTHBOUND - UNIT 3	Revised
1451	158 SCREED ELEVATIONS - SOUTHBOUND - UNIT 3	
1452	159 HAUNCH DIAGRAMS - SOUTHBOUND	
1453	160 HAUNCH DIAGRAMS - SOUTHBOUND - UNIT 1	
1454	161 HAUNCH DIAGRAMS - SOUTHBOUND - UNIT 2	
1455	162 HAUNCH DIAGRAMS - SOUTHBOUND - UNIT 2	
1456	163 HAUNCH DIAGRAMS - SOUTHBOUND - UNIT 3	
1457	164 HAUNCH DIAGRAMS - SOUTHBOUND - UNIT 3	

Sheet	Description	Revised for VECP
1458	165 HAUNCH DIAGRAMS - SOUTHBOUND - UNIT 3	
1459	166 HAUNCH DIAGRAMS - NORTHBOUND	Revised
1460	167 HAUNCH DIAGRAMS - NORTHBOUND - UNIT 1	Revised
1461	168 HAUNCH DIAGRAMS - NORTHBOUND - UNIT 2	Revised
1462	169 HAUNCH DIAGRAMS - NORTHBOUND - UNIT 2	Revised
1463	170 HAUNCH DIAGRAMS - NORTHBOUND - UNIT 3	Revised
1464	171 HAUNCH DIAGRAMS - NORTHBOUND - UNIT 3	
1465	172 HAUNCH DIAGRAMS - NORTHBOUND - UNIT 3	
1466	173 FINAL DECK ELEVATION DIAGRAMS - SOUTHBOUND	
1467	174 FINAL DECK ELEVATION DIAGRAMS - SOUTHBOUND - UNIT 1	
1468	175 FINAL DECK ELEVATION DIAGRAMS - SOUTHBOUND - UNIT 1	
1469	176 FINAL DECK ELEVATION DIAGRAMS - SOUTHBOUND - UNIT 2	
1470	177 FINAL DECK ELEVATION DIAGRAMS - SOUTHBOUND - UNIT 2	
1471	178 FINAL DECK ELEVATION DIAGRAMS - SOUTHBOUND - UNIT 2	
1472	179 FINAL DECK ELEVATION DIAGRAMS - SOUTHBOUND - UNIT 2	
1473	180 FINAL DECK ELEVATION DIAGRAMS - SOUTHBOUND - UNIT 3	
1474	181 FINAL DECK ELEVATION DIAGRAMS - SOUTHBOUND - UNIT 3	
1475	182 FINAL DECK ELEVATION DIAGRAMS - SOUTHBOUND - UNIT 3	
1476	183 FINAL DECK ELEVATION DIAGRAMS - NORTHBOUND	Revised
1477	184 FINAL DECK ELEVATION DIAGRAMS - NORTHBOUND - UNIT 1	Revised
1478	185 FINAL DECK ELEVATION DIAGRAMS - NORTHBOUND - UNIT 1	Revised
1479	186 FINAL DECK ELEVATION DIAGRAMS - NORTHBOUND - UNIT 2	Revised
1480	187 FINAL DECK ELEVATION DIAGRAMS - NORTHBOUND - UNIT 2	Revised
1481	188 FINAL DECK ELEVATION DIAGRAMS - NORTHBOUND - UNIT 2	Revised
1482	189 FINAL DECK ELEVATION DIAGRAMS - NORTHBOUND - UNIT 2	Revised
1483	190 FINAL DECK ELEVATION DIAGRAMS - NORTHBOUND - UNIT 3	Revised
1484	191 FINAL DECK ELEVATION DIAGRAMS - NORTHBOUND - UNIT 3	Revised
1485	192 FINAL DECK ELEVATION DIAGRAMS - NORTHBOUND - UNIT 3	
1486	193 APPROACH SLABS - 1 OF 4	Revised
1487	194 APPROACH SLABS - 2 OF 4	Revised
1488	195 APPROACH SLABS - 3 OF 4	
1489	196 APPROACH SLABS - 4 OF 4	
1490	197 REINFORCING LIST	
1491	198 REINFORCING LIST	Revised
1492	199 REINFORCING LIST	Revised
1493	200 REINFORCING LIST	Revised
1494	201 REINFORCING LIST	
1495	202 REINFORCING LIST	
1496	203 REINFORCING LIST	
1497	204 REINFORCING LIST	Revised
1498	205 REINFORCING LIST	Revised
1499	206 REINFORCING LIST	Revised
1500	207 REINFORCING LIST	Revised
1501	208 REINFORCING LIST	
1502	209 REINFORCING LIST	
1503	210 REINFORCING LIST	Revised
1503A	210A REINFORCING LIST	Added
1504	211 REINFORCING LIST	Revised
1505	212 REINFORCING LIST	Revised
1506	213 REINFORCING LIST	
1507	214 REINFORCING LIST	Revised
1508	215 REINFORCING LIST	Revised
1509	216 REINFORCING LIST	

**NOTE:**  
 JSE STAMP APPLIES ONLY TO  
 MODIFICATIONS AND ADDED  
 SHEETS BY JSE.

**ENGINEERS SEAL:**

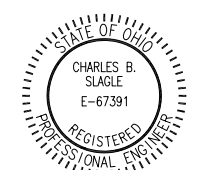

SIGNED: *Charles B. Slagle*  
 DATE: 06/2/2020

INDEX SHEET - 1 OF 1  
 BRIDGE NO. LUC-75-0029 L/R  
 I.R. 75 OVER MAUMEE RIVER

DESIGN AGENCY  
**JANSSEN & SPAANS ENGINEERING, INC.**  
 9120 HARRISON PARK COURT  
 INDIANAPOLIS, IN 46216

DATE  
 5/2020

REVIEWED  
 WJZ

DRAWN  
 REM


CHECKED  
 CBS

STRUCTURE FILE NUMBER  
 4802765/4802767

W00/LUC-75-  
 30.70/0.00  
 PID No. 93592

0/216  
 1293A  
 1792

Date: Oct 07, 2020, 5:13pm User Name: mlongtin  
 File: P:\11221 - Toledo E Value Engineering\DWG\GIS\BRIDGE\LUC-75-0027 over Maumee River\Sheets\072\_0027C\_SP001.DWG

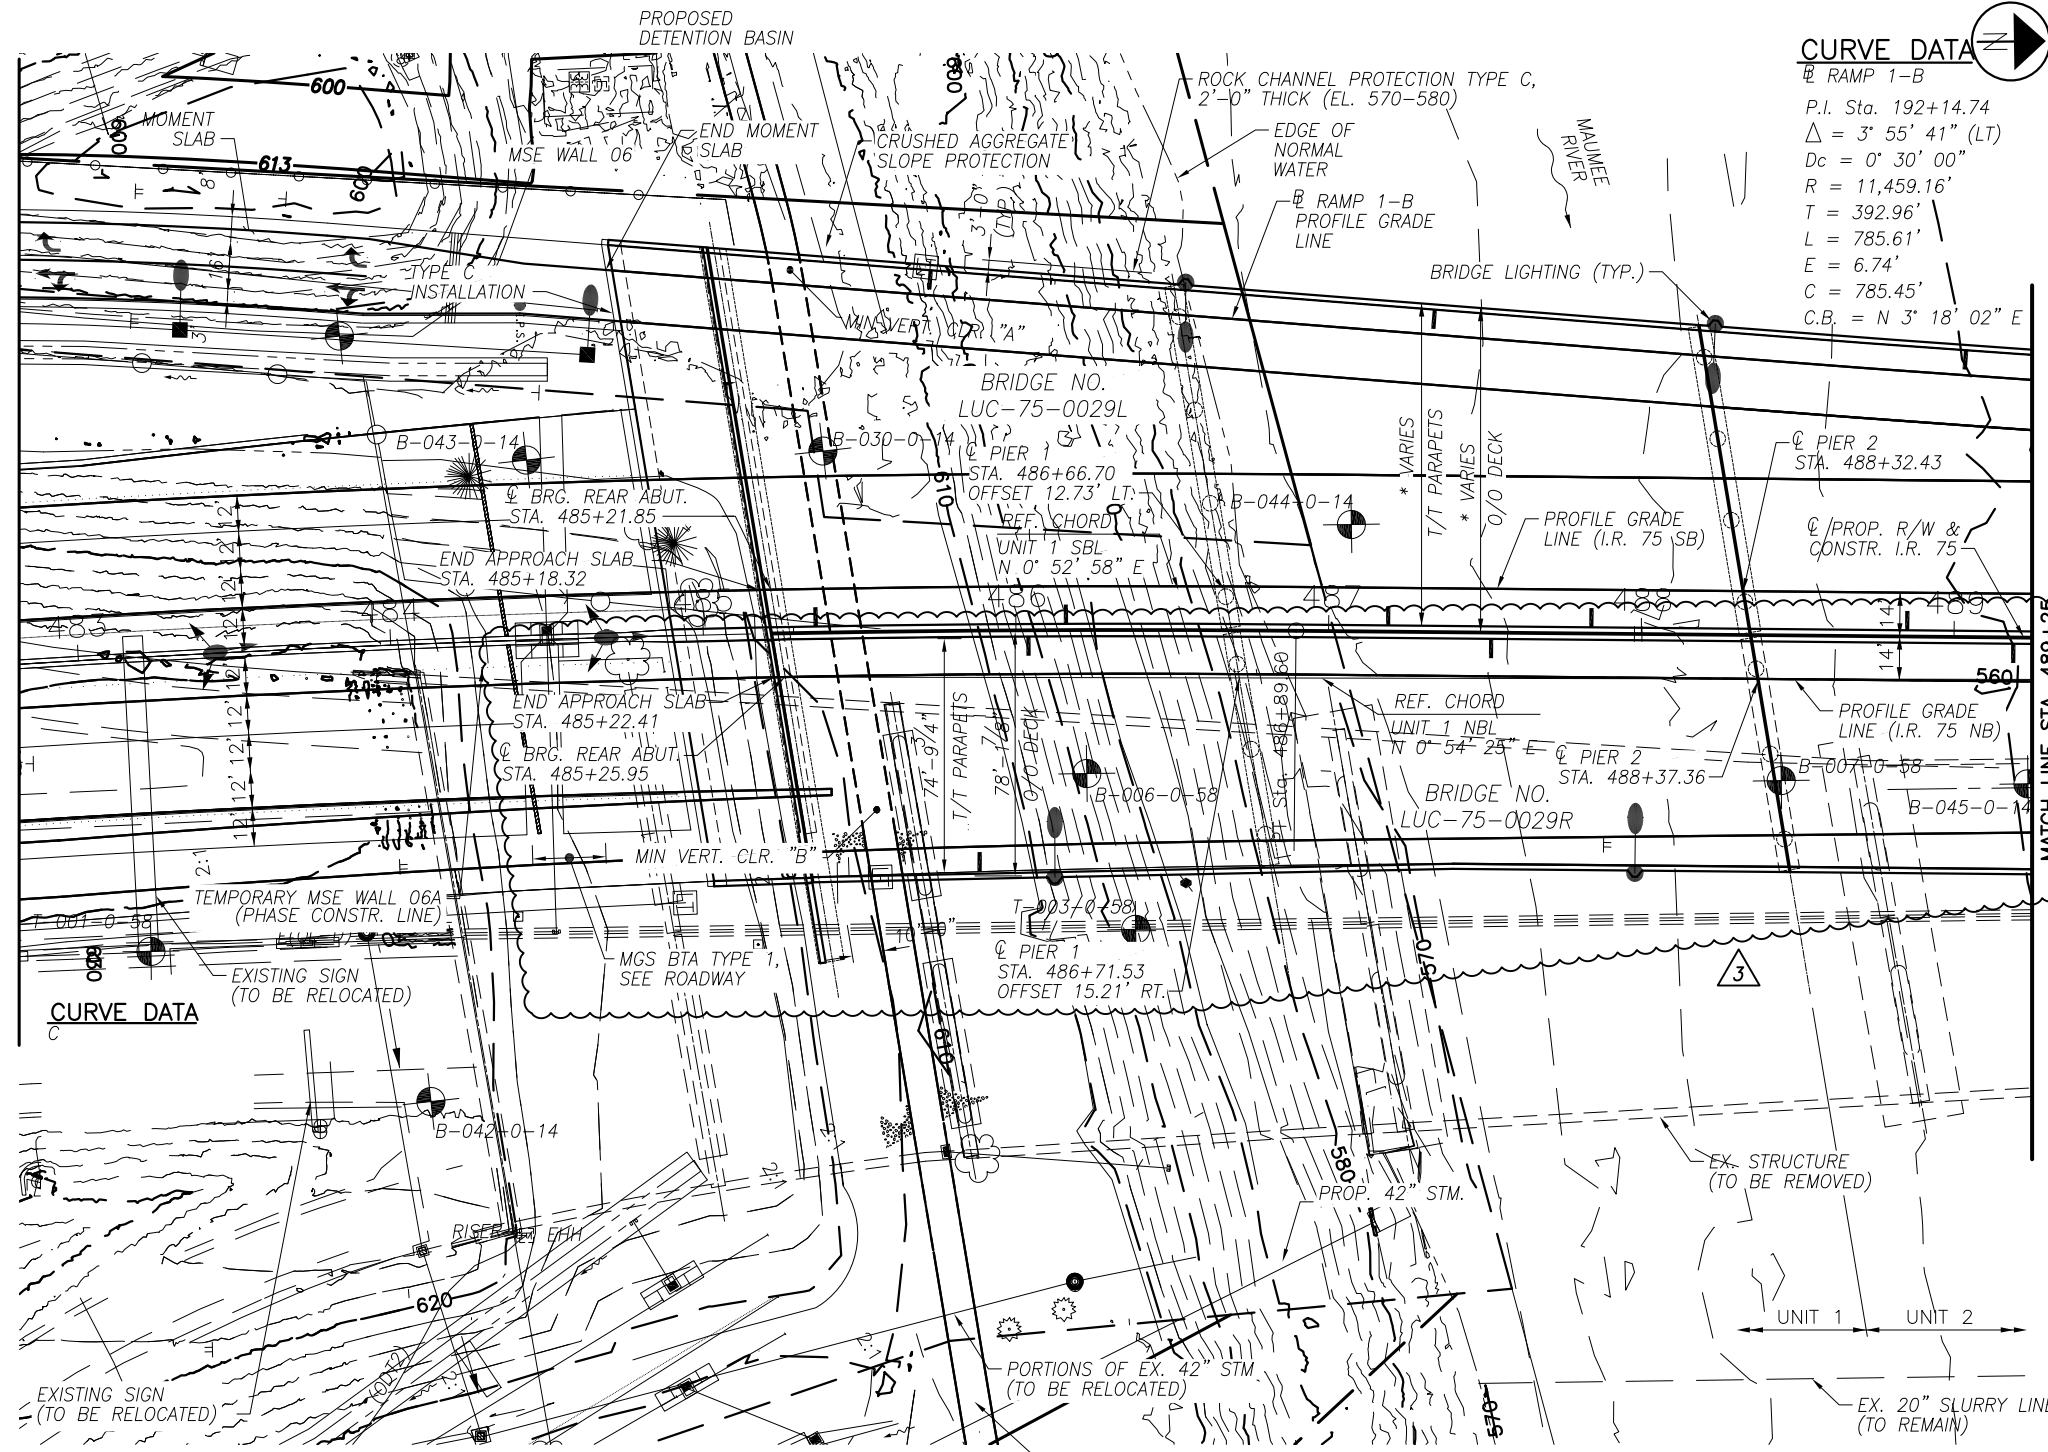

**CURVE DATA**

RAMP 1-B  
 P.I. Sta. 192+14.74  
 $\Delta = 3^\circ 55' 41''$  (LT)  
 $D_c = 0^\circ 30' 00''$   
 $R = 11,459.16'$   
 $T = 392.96'$   
 $L = 785.61'$   
 $E = 6.74'$   
 $C = 785.45'$   
 $C.B. = N 3^\circ 18' 02'' E$

**NOTES**

EARTHWORK LIMITS SHOWN ARE APPROXIMATE. ACTUAL SLOPES SHALL CONFORM TO PLAN CROSS SECTIONS.  
 FOR BENCHMARK INFORMATION, SEE SHEET 10/1792  
 FOR GEOMETRIC LAYOUT DETAILS, SEE SHEETS 10/216 THRU 12/216  
 FOR MSE WALL DETAILS, SEE SHEETS 1675/1792 THRU 1731/1792  
 SEE SHEETS 410/1792 AND 413/1792 FOR SOIL REMEDIATION LIMITS IN EMBANKMENT AT FORWARD AND REAR ABUTMENTS RESPECTIVELY.

DESIGN TRAFFIC:  
 2018 ADT = 100,890 2018 ADTT = 20,178  
 2038 ADT = 116,740 2038 ADTT = 23,348  
 DIRECTIONAL DISTRIBUTION = 50% (SB) / 50% (NB)

**FOUNDATION DATA**

ALL PROPOSED ABUTMENT PILES SHALL BE HP12x53 END BEARING PILES FOUNDED ON ROCK. ALL PROPOSED PIER DRILLED SHAFTS SHALL BE 7'-0", 6'-6" OR 6'-0" DIAMETER AS SHOWN IN PLANS.

**LEGEND**

- HISTORIC BORING LOCATION
- PROJECT BORING LOCATION
- FOR DECK WIDTH DIMENSIONS, SEE SHEET 2/216

VERT. CLEARANCE	
A	16'-3"
B	16'-11"

**CURVE DATA**

**HYDRAULIC DATA**

DRAINAGE AREA = 6,608 SQ. MILES  
 $Q(50) = 111,100$  CFS  $V(50) = 3.7$  FT/S  $H(50) = EL. 578.9'$   
 $Q(100) = 124,300$  CFS  $V(100) = 3.9$  FT/S  $H(100) = EL. 579.6'$   
 $Q(500) = 155,800$  CFS  $V(500) = 4.4$  FT/S  $H(500) = EL. 581.7'$   
 STRUCTURE CLEARS THE LAKE ERIE MEAN LOW WATER BY 50'-2".

**PLAN**

SOIL BORINGS					
BORING NO.	STATION	OFFSET	BORING NO.	STATION	OFFSET
B-029-0-14	483+88	99' RT.	B-047-0-14	495+83	31' RT.
B-030-0-14	485+39	58' LT.	B-048-0-14	499+19	48' LT.
B-042-0-14	484+07	146' RT.	B-049-0-14	502+71	28' RT.
B-043-0-14	484+45	58' LT.	B-049-1-14	502+43	28' RT.
B-044-0-14	487+07	34' LT.	B-050-0-14	505+00	51' LT.
B-045-0-14	489+24	47' RT.	B-051-0-14	505+27	141' LT.
B-046-0-14	492+42	38' LT.			

**EXISTING STRUCTURE**

TYPE: MULTI UNIT, CONTINUOUS SPAN STEEL RIVETED GIRDERS, WELDED GIRDERS AND ROLLED BEAMS WITH REINFORCED CONCRETE DECK AND SUBSTRUCTURE  
 SPANS: BRG. REAR ABUT. TO PIER 1 = 140'-0"±, 10 SPANS @ 166'-0"±, 132'-0"±, 10 SPANS @ 75'-6"±, 3 SPANS @ 97'-6"±, 98'-6"±, 60'-0"±, 60'-6"±, 50'-0"±  
 ROADWAY: VARIES 46'-5"± MIN. (SB), 47'-6"± MIN. (NB) T/T PARAPETS  
 LOADING: CF 2000 (57)  
 SKEW: VARIES 0° TO 29°15'00"  
 APPROACH SLABS: 25'-0"± (AS-1-54)  
 ALIGNMENT: TANGENT  
 CROWN: 0.016± FT/FT  
 WEARING SURFACE: 1" MONOLITHIC CONCRETE  
 STRUCTURAL FILE NUMBER: 4802764  
 DATE BUILT: 1960  
 DISPOSITION: EXISTING STRUCTURE TO BE REMOVED.

**PROPOSED STRUCTURE**

TYPE: MULTI UNIT, PRESTRESSED CONCRETE I-BEAMS WITH COMPOSITE REINFORCED CONCRETE DECK ON STUB ABUTMENTS AND CAP-AND-COLUMN PIERS  
 SPANS: UNIT 1 - 145'-0" BRG. REAR ABUTMENT TO PIER 1  
 166'-0" PIER 1 TO PIER 2  
 UNIT 2 - 4 SPANS @ 166'-0" PIER 1  
 UNIT 3 - 5 SPANS @ 166'-0" PIER 1  
 137'-0" PIER 11 TO BRG. FORWARD ABUTMENT  
 ROADWAY: VARIES 72'-0" MIN. (L/R) T/T PARAPETS  
 LOADING: HL-93 WITH 60 PSF FWS  
 SKEW: 10°00'00" RIGHT FORWARD  
 (EXCEPT AS NOTED ON GEOMETRIC LAYOUT PLAN)  
 APPROACH SLABS: 30'-0" LONG (AS-1-15 & AS-2-15)  
 ALIGNMENT: TANGENT (EXCEPT AS NOTED ON GEOMETRIC LAYOUT PLAN)  
 CROWN: 0.016 FT/FT (EXCEPT AS NOTED ON GEOMETRIC LAYOUT PLAN)  
 WEARING SURFACE: 1" MONOLITHIC CONCRETE  
 COORDINATES: LATITUDE N 41° 37' 19.2"  
 LONGITUDE W 83° 32' 32.3"

5/1/2020 JANSSEN & SPAANS ENGINEERING INC.  
 RECONFIGURED NORTHBOUND ON RAMP

DESIGN AGENCY: AECOM  
 654 WHITE POND DRIVE  
 AKRON, OHIO 44320-1100  
 (330) 836-9111


DESIGNED	MRW	CMA	REVIEWED	JTH	DATE	8/18
CHECKED	CRG	REVIS	STRUCTURE FILE NUMBER	4802765/4802767		

SITE PLAN - 1 OF 6  
 BRIDGE NO. LUC-75-0029 L/R  
 I.R. 75 OVER MAUMEE RIVER  
 W00/LUC-75-30.70/0.00  
 PID No. 93592

1/216  
 1294/1792

**CURVE DATA**

RAMP 1-B  
 P.I. Sta. 192+14  
 $\Delta = 3^{\circ} 55' 41''$  (LT)  
 $D_c = 0^{\circ} 30' 00''$   
 $R = 11,459.16'$   
 $T = 392.96'$   
 $L = 785.61'$   
 $E = 6.74'$   
 $C = 785.45'$   
 $C.B. = N 3^{\circ} 17.07.08' 02'' E$

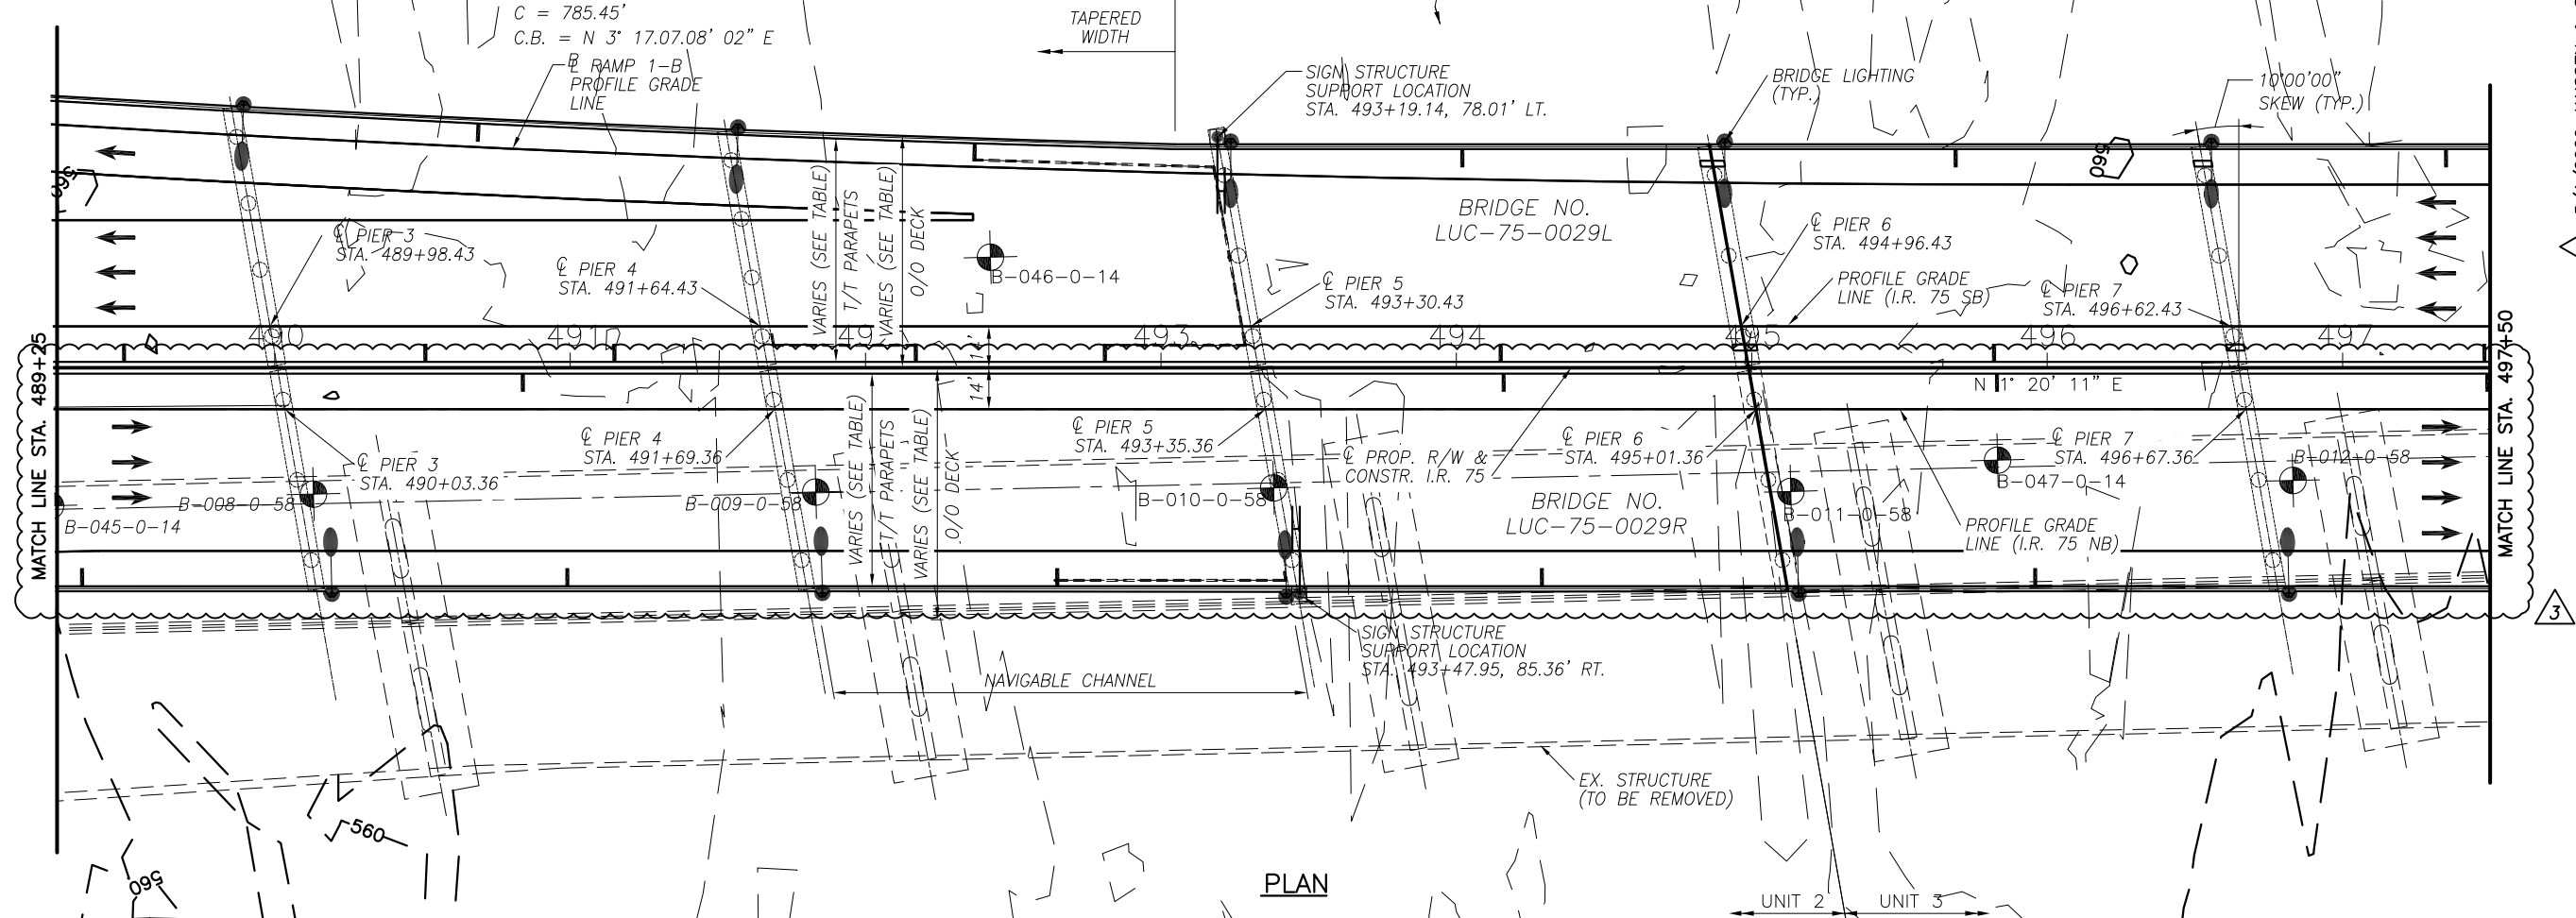

**PLAN**

ELEVATION	NGVD (1929)	GREAT LAKES DATUM (1985)	NAVD (1988)	REPORTED BY U.S. ARMY CORPS OF ENGINEERS
LOW WATER**	570.5'	569.2	569.8 (NAVD (1929) MINUS 0.669***)	-
ORDINARY HIGH WATER**	573.7	572.4 (LOW WATER + 3.2 FT)	573.0	574.3

**NOTES:**

"\*" - 50 AND 100 YEAR WATER SURFACE ELEVATIONS ARE FROM FEMA FLOOD INSURANCE STUDY FOR LUCAS COUNTY AND INCORPORATED AREAS, AUGUST 16, 2011, FLOOD PROFILES, MAUMEE RIVER, 92P, (NAVD) 1988.

"\*\*" -

- LOW WATER SURFACE ELEVATION IS FROM NOAA, MAP 14847, TOLEDO HARBOR LAST CORRECTED 6/24/2014, RIMOUSKI, QUEBEC, INTERNATIONAL GREAT LAKES DATUM (1985), 569.2 FEET.
- THE LOW WATER ELEVATION IS ALSO ESTIMATED TO BE EQUIVALENT TO THE LOW WATER ELEVATION ON THE EXISTING RECORD PLANS 570.5', NGVD (1929).
- THE ESTIMATED ORDINARY HIGH WATER ELEVATION IS FROM THE LAKE ERIE GRAPH AVERAGE LEVELS (1994-2003) LOW LEVEL CHART 569.2 (+3.2).

"\*\*\*" -

- THE CONVERSION FROM 1929 NGVD TO 1988 NAVD WAS DETERMINED FROM NOAA, VERTCON ONLINE SOFTWARE, USING SITE SPECIFIC LATITUDE AND LONGITUDE INFORMATION AND THE EXISTING RECORD PLANS OF LOW WATER EQUAL TO 570.5'.
- THE FEMA FIS REPORTS AN AVERAGE CONVERSION OF -0.635 COUNTY WIDE USING THE NOTED USGS QUADRANGLE MAPS. LOW WATER AND ORDINARY HIGH WATER (OHW) WATER SURFACE ELEVATIONS FROM NOAA, MAP 14847, TOLEDO HARBOR LAST CORRECTED 6/24/2014, RIMOUSKI, QUEBEC, INTERNATIONAL GREAT LAKES DATUM (1985), 569.2 AND LOW WATER CHART 569.2 (+3.2). THE LOW WATER ELEVATION IS ASSUMED TO BE EQUIVALENT TO THE LOW WATER ELEVATION ON THE EXISTING RECORD PLANS 570.5', NGVD (1929).

**NOTE:**  
 FOR NOTES AND LEGEND SEE SHT. 1 / 216


DECK WIDTHS		
LOCATION	O/O DECK	T/T PARAPET
UNIT 1 SB	VARIABLES 123'-6" TO 98'-8"	VARIABLES 120'-1" TO 95'-3"
UNIT 2 SB	VARIABLES 98'-8" TO 75'-5"	VARIABLES 95'-3" TO 72'-0"
UNIT 3 SB	VARIABLES 75'-5" TO 83'-6"	VARIABLES 72'-0" TO 80'-1"
UNIT 1 NB	VARIABLES 79'-6 1/4" TO 75'-5"	VARIABLES 76'-1 1/4" TO 72'-0"
UNIT 2 NB	75'-5"	72'-0"
UNIT 3 NB	75'-5"	72'-0"

Date: Oct 08, 2020, 4:14pm User Name: mlongtin  
 File: P:\11221 - Toledo E Value Engineering\DWG\5\BRIDGE\LUC-75-0027 over Maumee River\Sheets\072\_0027C\_SF001.DWG

5/1/2020 JANSSEN & SPAANS ENGINEERING INC.  
 RECONFIGURED NORTHBOND ON RAMP

DESIGN AGENCY  
 DATE 8/18  
 DRAWN JTH  
 CHECKED CMA  
 DESIGNED MRW  
 REVIEWED JTH  
 STRUCTURE FILE NUMBER 4802765/4802767  
 REVISIONS  
 LUC-75-0029 R STA. 485+22.41 STA. 504+71.92  
 LUC-75-0029 L STA. 485+18.32 STA. 504+66.98  
 SITE PLAN - 2 OF 6  
 BRIDGE NO. LUC-75-0029 L/R I.R. 75 OVER MAUMEE RIVER  
 W00/LUC-75-30.70/0.00  
 PID No. 93592  
 2 / 216  
 1295 / 1792  
**AECOM**  
 654 WHITE POND DRIVE  
 AKRON, OHIO 44320-1100  
 (330) 836-9111

Date: Oct 07, 2020, 5:13pm User Name: mlmgain  
 File: P:\11321 - Toledo E Value Engineering\DWGS\BRIDGE\LUC-75-0027 over Maumee River\Sheets\075\_0027C\_SF001.DWG

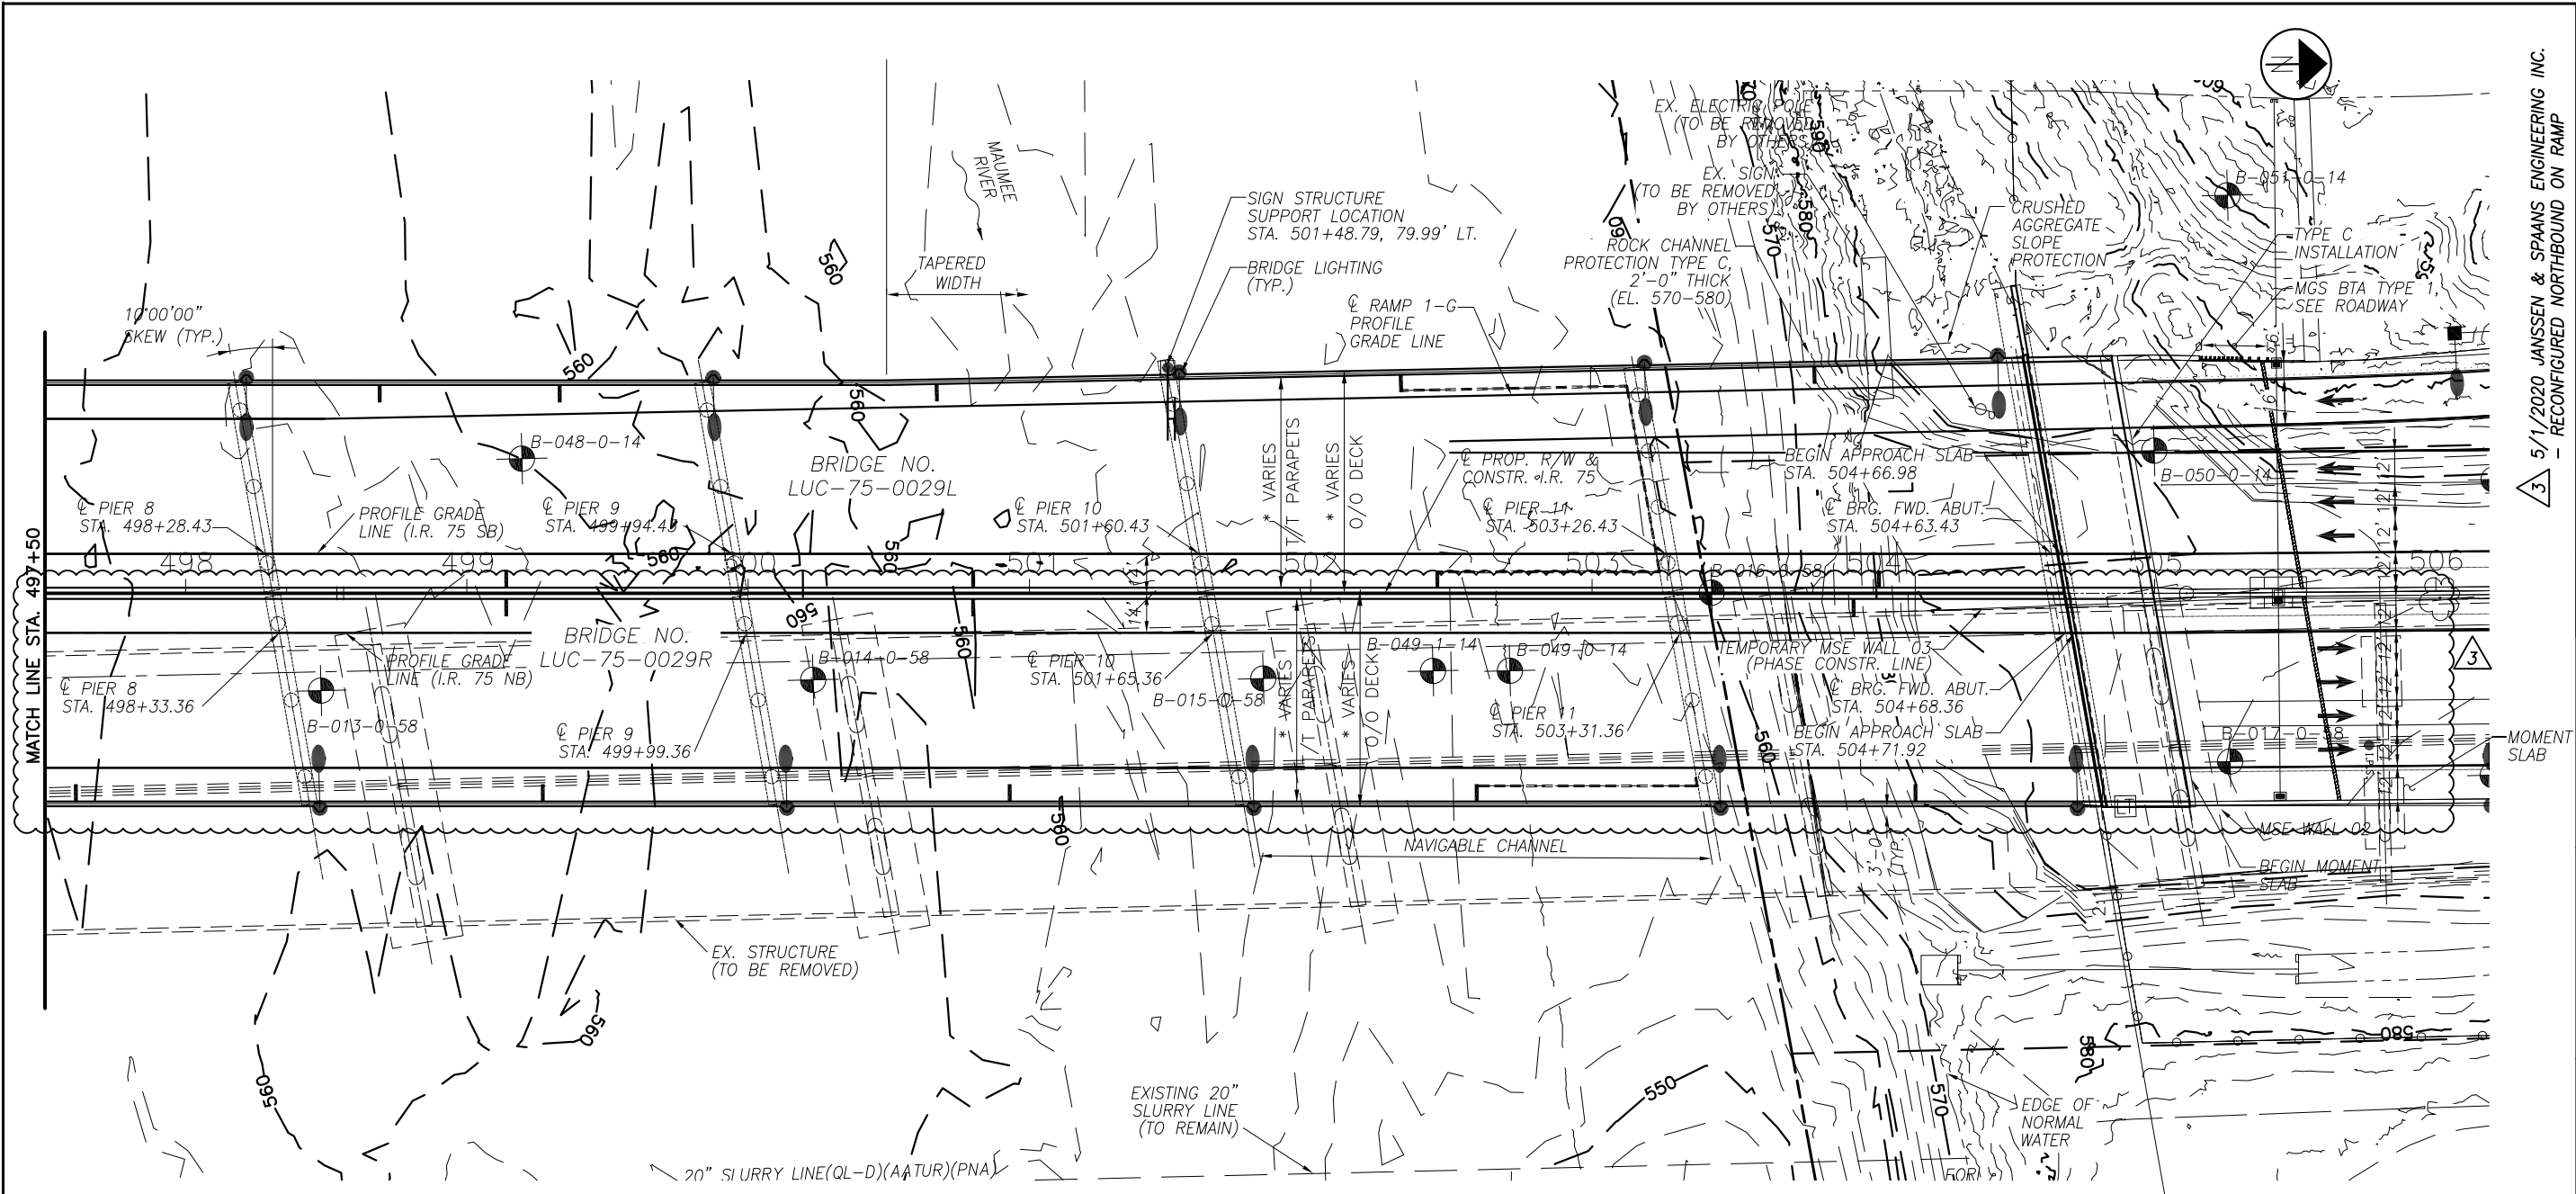


PLAN

NOTE:  
 FOR NOTES AND LEGEND SEE SHT. 1 / 216

W00/LUC-75-30.70/0.00 PID No. 93592	SITE PLAN - 3 OF 6 BRIDGE NO. LUC-75-0029 L/R I.R. 75 OVER MAUMEE RIVER		LUC-75-0029 L STA. 485+18.32 STA. 504+66.98	LUC-75-0029 R STA. 485+22.41 STA. 504+71.92	DESIGNED MRW	CHECKED CRG	DRAWN CMA	REVISIONS JTH 4802765 / 4802767	DATE 8/18	DESIGN AGENCY <b>AECOM</b> 554 WHITE POND DRIVE AKRON, OHIO 44320-1100 (330) 836-9111
	5/1/2020 JANSSEN & SPANNS ENGINEERING INC. - RECONFIGURED NORTHBOUND ON RAMP									
1296 1792	3 / 216									

Date: Oct 07, 2020, 5:12pm User Name: mlongtin  
 File: P:\1321 - Toledo E Value Engineering\DWG\SRIDGE\LUC-75-0027 over Maumee River\Sheets\072\_0027C\_GR002.dwg

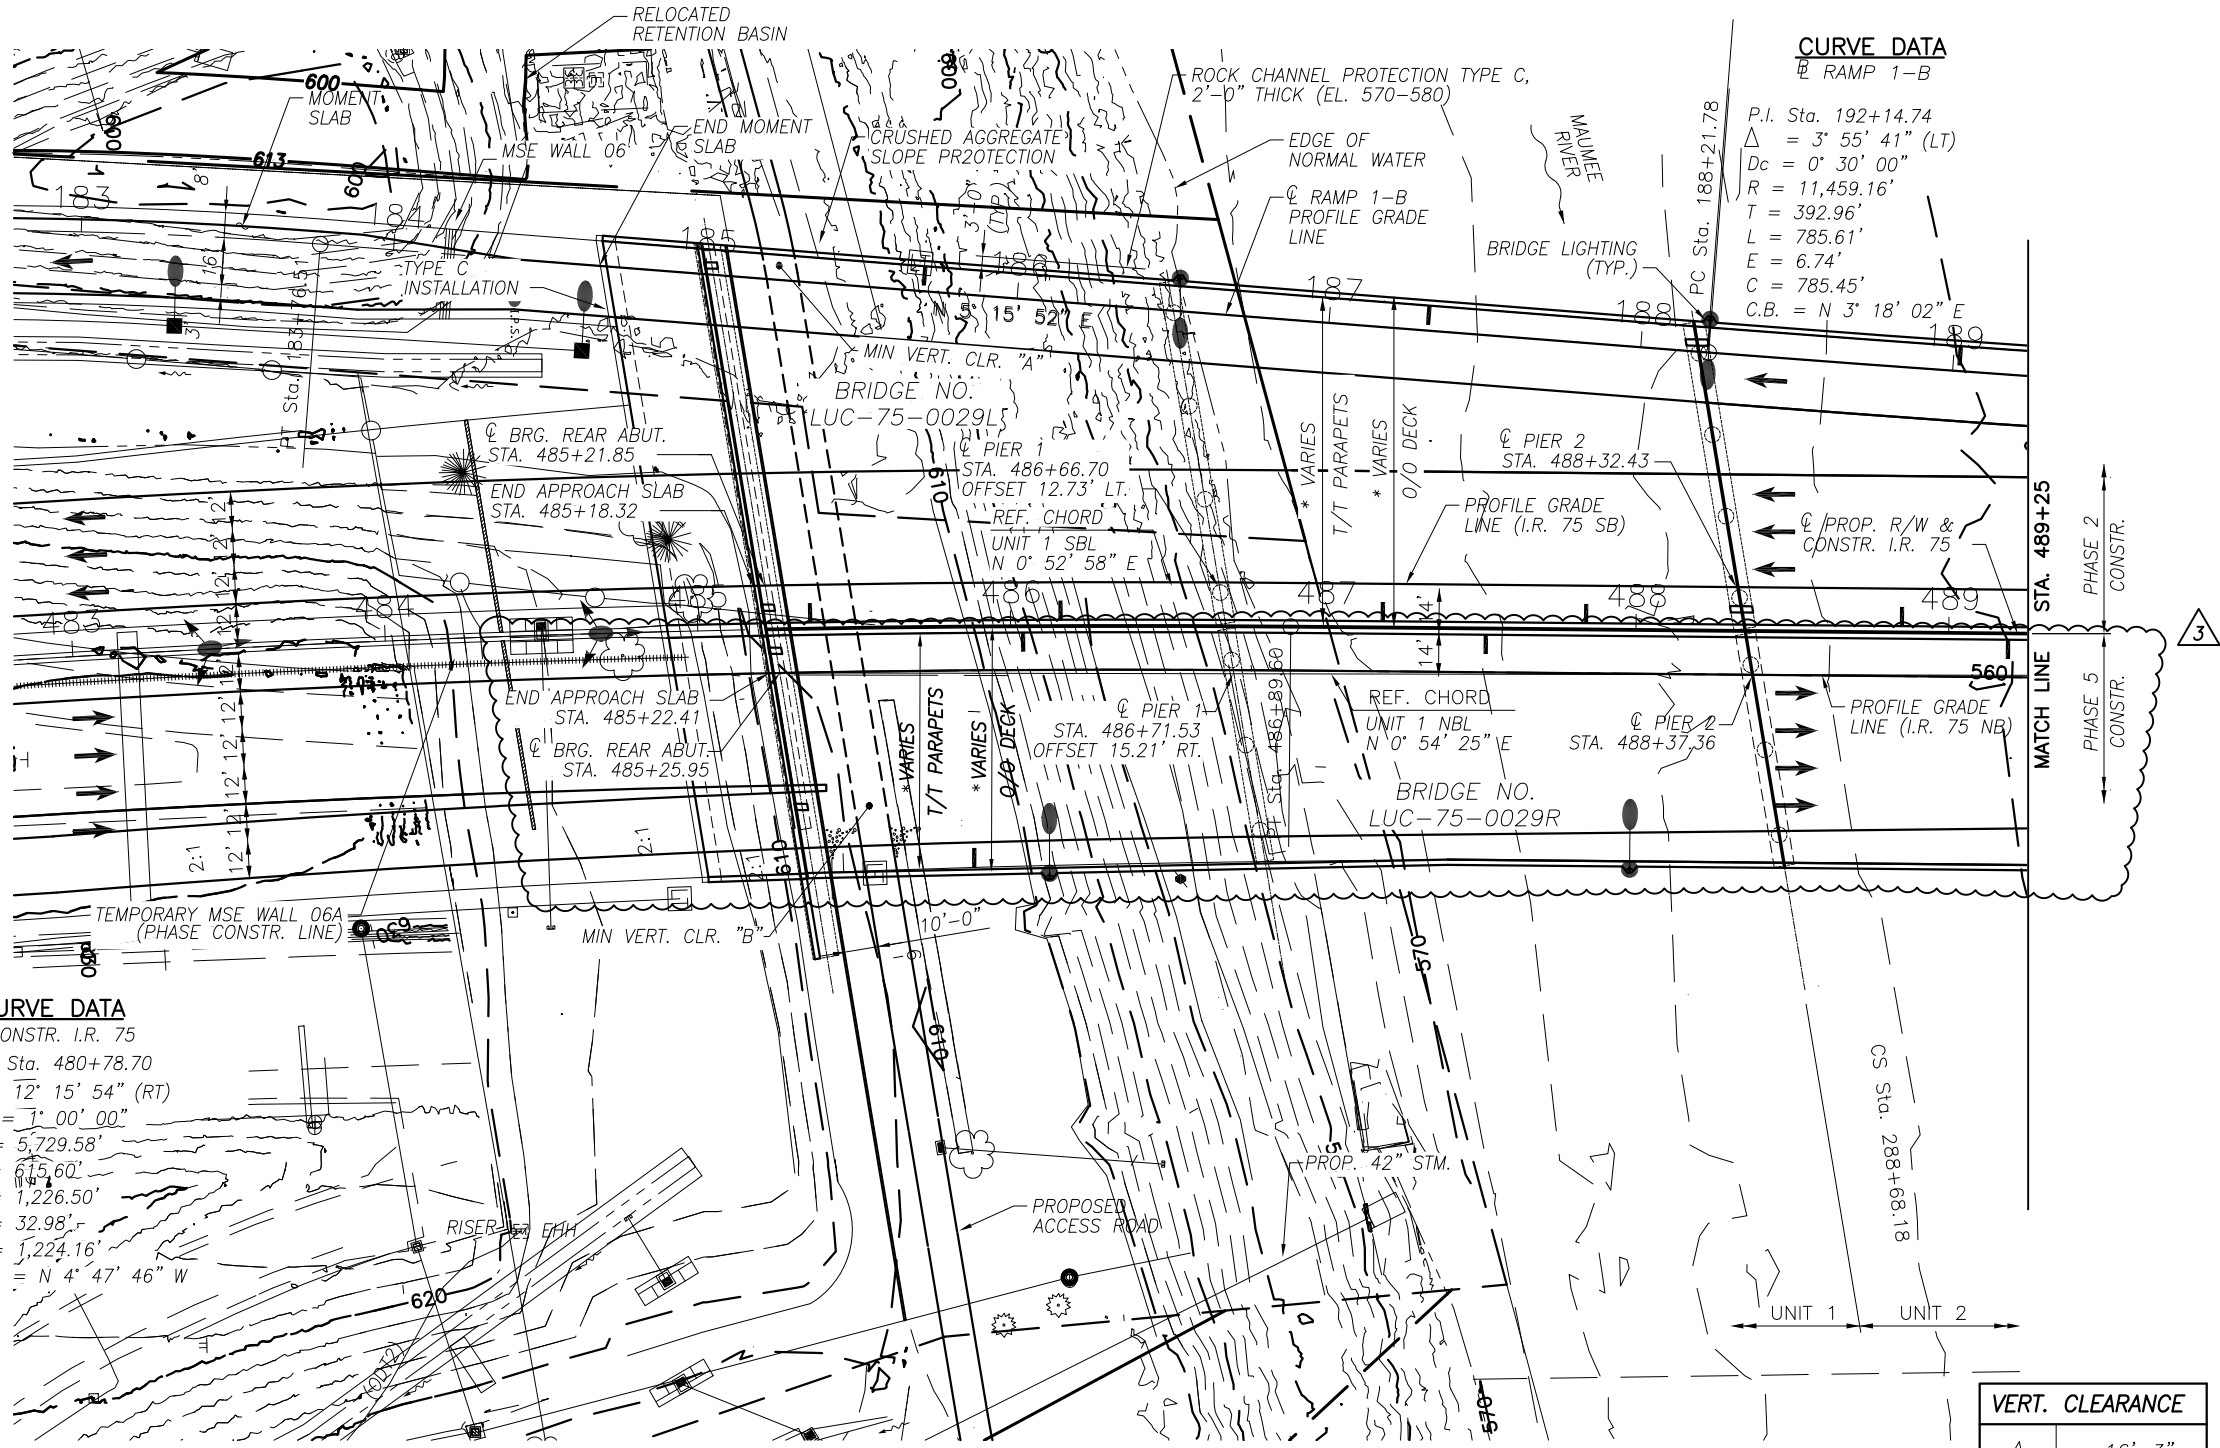

**CURVE DATA**  
 CL CONSTR. I.R. 75  
 P.I. Sta. 480+78.70  
 $\Delta = 12^\circ 15' 54''$  (RT)  
 $D_c = 1^\circ 00' 00''$   
 $R = 5,729.58'$   
 $T = 615.60'$   
 $L = 1,226.50'$   
 $E = 32.98'$   
 $C = 1,224.16'$   
 C.B. = N 4° 47' 46" W

**CURVE DATA**  
 CL RAMP 1-B  
 P.I. Sta. 192+14.74  
 $\Delta = 3^\circ 55' 41''$  (LT)  
 $D_c = 0^\circ 30' 00''$   
 $R = 11,459.16'$   
 $T = 392.96'$   
 $L = 785.61'$   
 $E = 6.74'$   
 $C = 785.45'$   
 C.B. = N 3° 18' 02" E

VERT. CLEARANCE	
A	16'-3"
B	16'-11"

**GENERAL PLAN**

**LEGEND**

\* FOR DECK WIDTH DIMENSIONS, SEE SHEET 2/216

**NOTES**

- FOR SITE PLAN AND PROFILE, SEE SHEETS 1/216 THRU 6/216
- FOR GEOMETRIC LAYOUT PLAN, SEE SHEETS 10/216 THRU 12/216
- FOR LIGHTING LOCATIONS AND ADDITIONAL INFORMATION, SEE SLAB PLAN SHEETS 85/216 THRU 111/216 AND SEE PARAPET PLANS 119/216 THRU 130/216

3/ 5/1/2020 JANSSEN & SPAANS ENGINEERING INC.  
 - RECONFIGURED NORTHBOUND ON RAMP

DESIGN AGENCY  
**AECOM**  
 654 WHITE POND DRIVE  
 AKRON, OHIO 44320-1100  
 (330) 836-9111

DESIGNED MRW CHECKED CRG  
 DRAWN CMA REVISOR  
 DATE 8/18  
 JTH  
 STRUCTURE FILE NUMBER 4802765/4802767

GENERAL PLAN - 1 OF 3  
 BRIDGE NO. LUC-75-0029 L/R  
 I.R. 75 OVER MAUMEE RIVER

W00/LUC-75-30.70/0.00  
 PID No. 93592


7/216

1300  
 1792

Date: Oct 07, 2020, 5:12pm User Name: mlongtin  
 File: P:\11321 - Toledo E Value Engineering\DWGS\BRIDGE\LUC-75-0027 over Maumee River\Sheets\075\_0027C\_GR002.dwg

**CURVE DATA**

RAMP 1-B  
 P.I. Sta. 192+14  
 $\Delta = 3^\circ 55' 41''$  (LT)  
 $D_c = 0^\circ 30' 00''$   
 $R = 11,459.16'$   
 $T = 392.96'$   
 $L = 785.61'$   
 $E = 6.74'$   
 $C = 785.45'$   
 C.B. = N 3° 17.07.08' 02" E

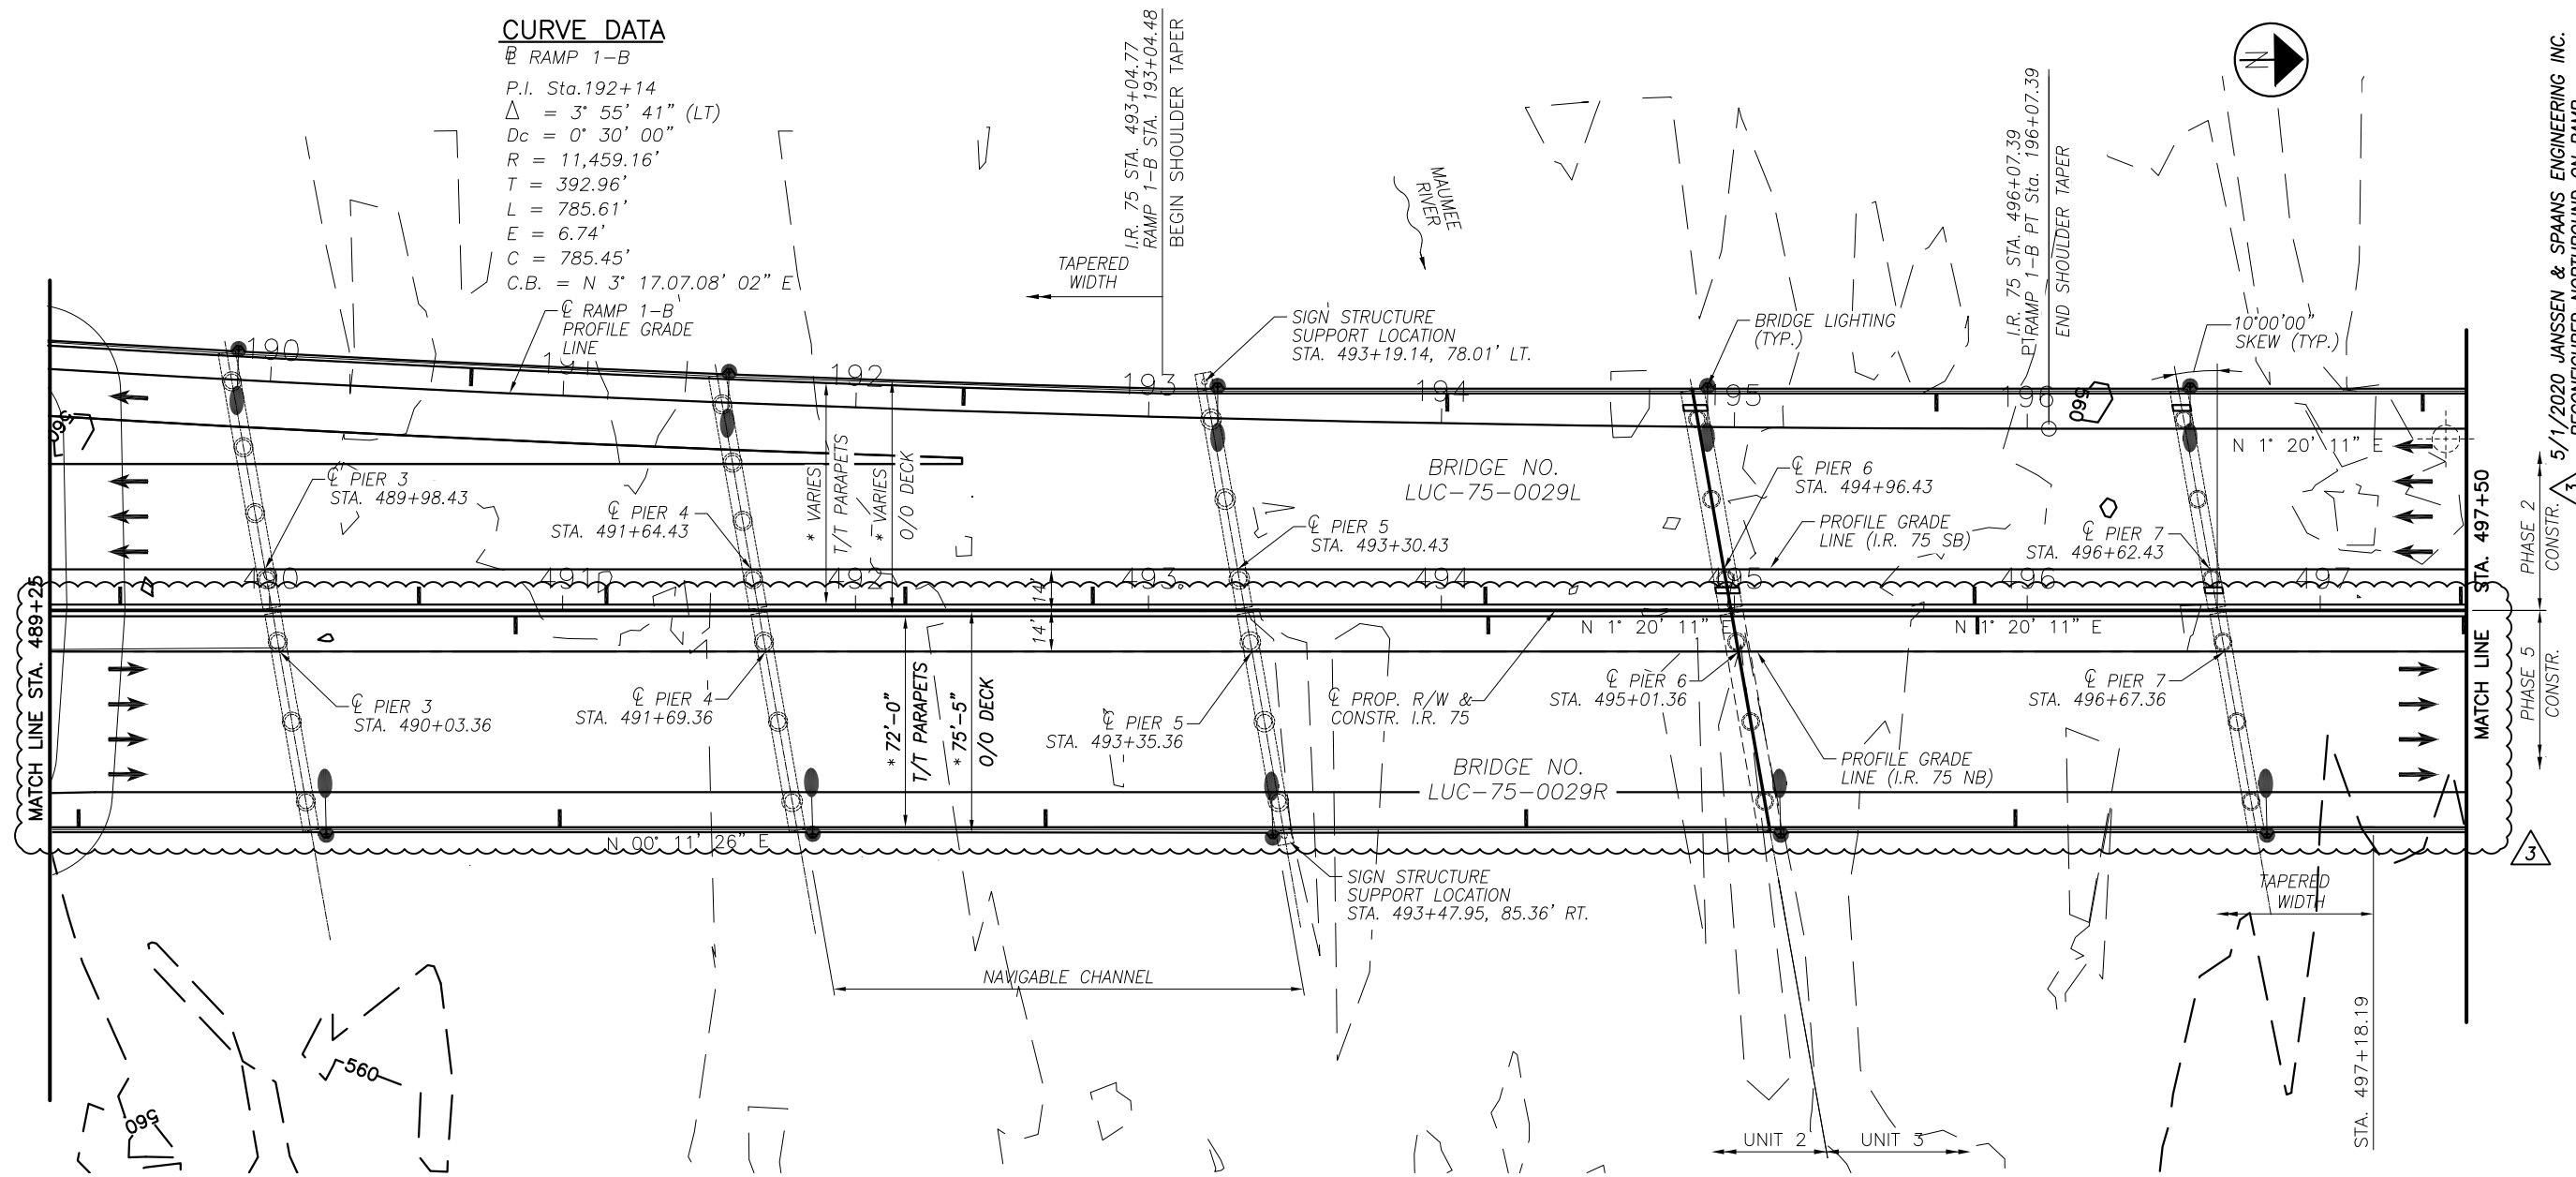

**GENERAL PLAN**

**NOTES**

1. FOR NOTES AND LEGEND, SEE SHEET 7 / 216

GENERAL PLAN - 2 OF 3  
 BRIDGE NO. LUC-75-0029 L/R  
 I.R. 75 OVER MAUMEE RIVER

W00/LUC-75-  
 30.70/0.00  
 PID No. 93592


8 / 216

1301  
 1792

DESIGNED	MRW	CHECKED	CRG
DRAWN	CMA	REVIEWED	JTH
DATE	8/18	STRUCTURE FILE NUMBER	4802765/4802767
DESIGN AGENCY	AECOM (330) 836-9111		

5/1/2020 JANSSEN & SPAANS ENGINEERING INC.  
 RECONFIGURED NORTHBOUND ON RAMP

Date: Oct 07, 2020, 5:12pm User Name: mlongtin  
 File: P:\1321 - Toledo E Value Engineering\DWGS\BRIDGE\LUC-75-0027 over Maumee River\Sheets\075\_0027C\_GP002.dwg

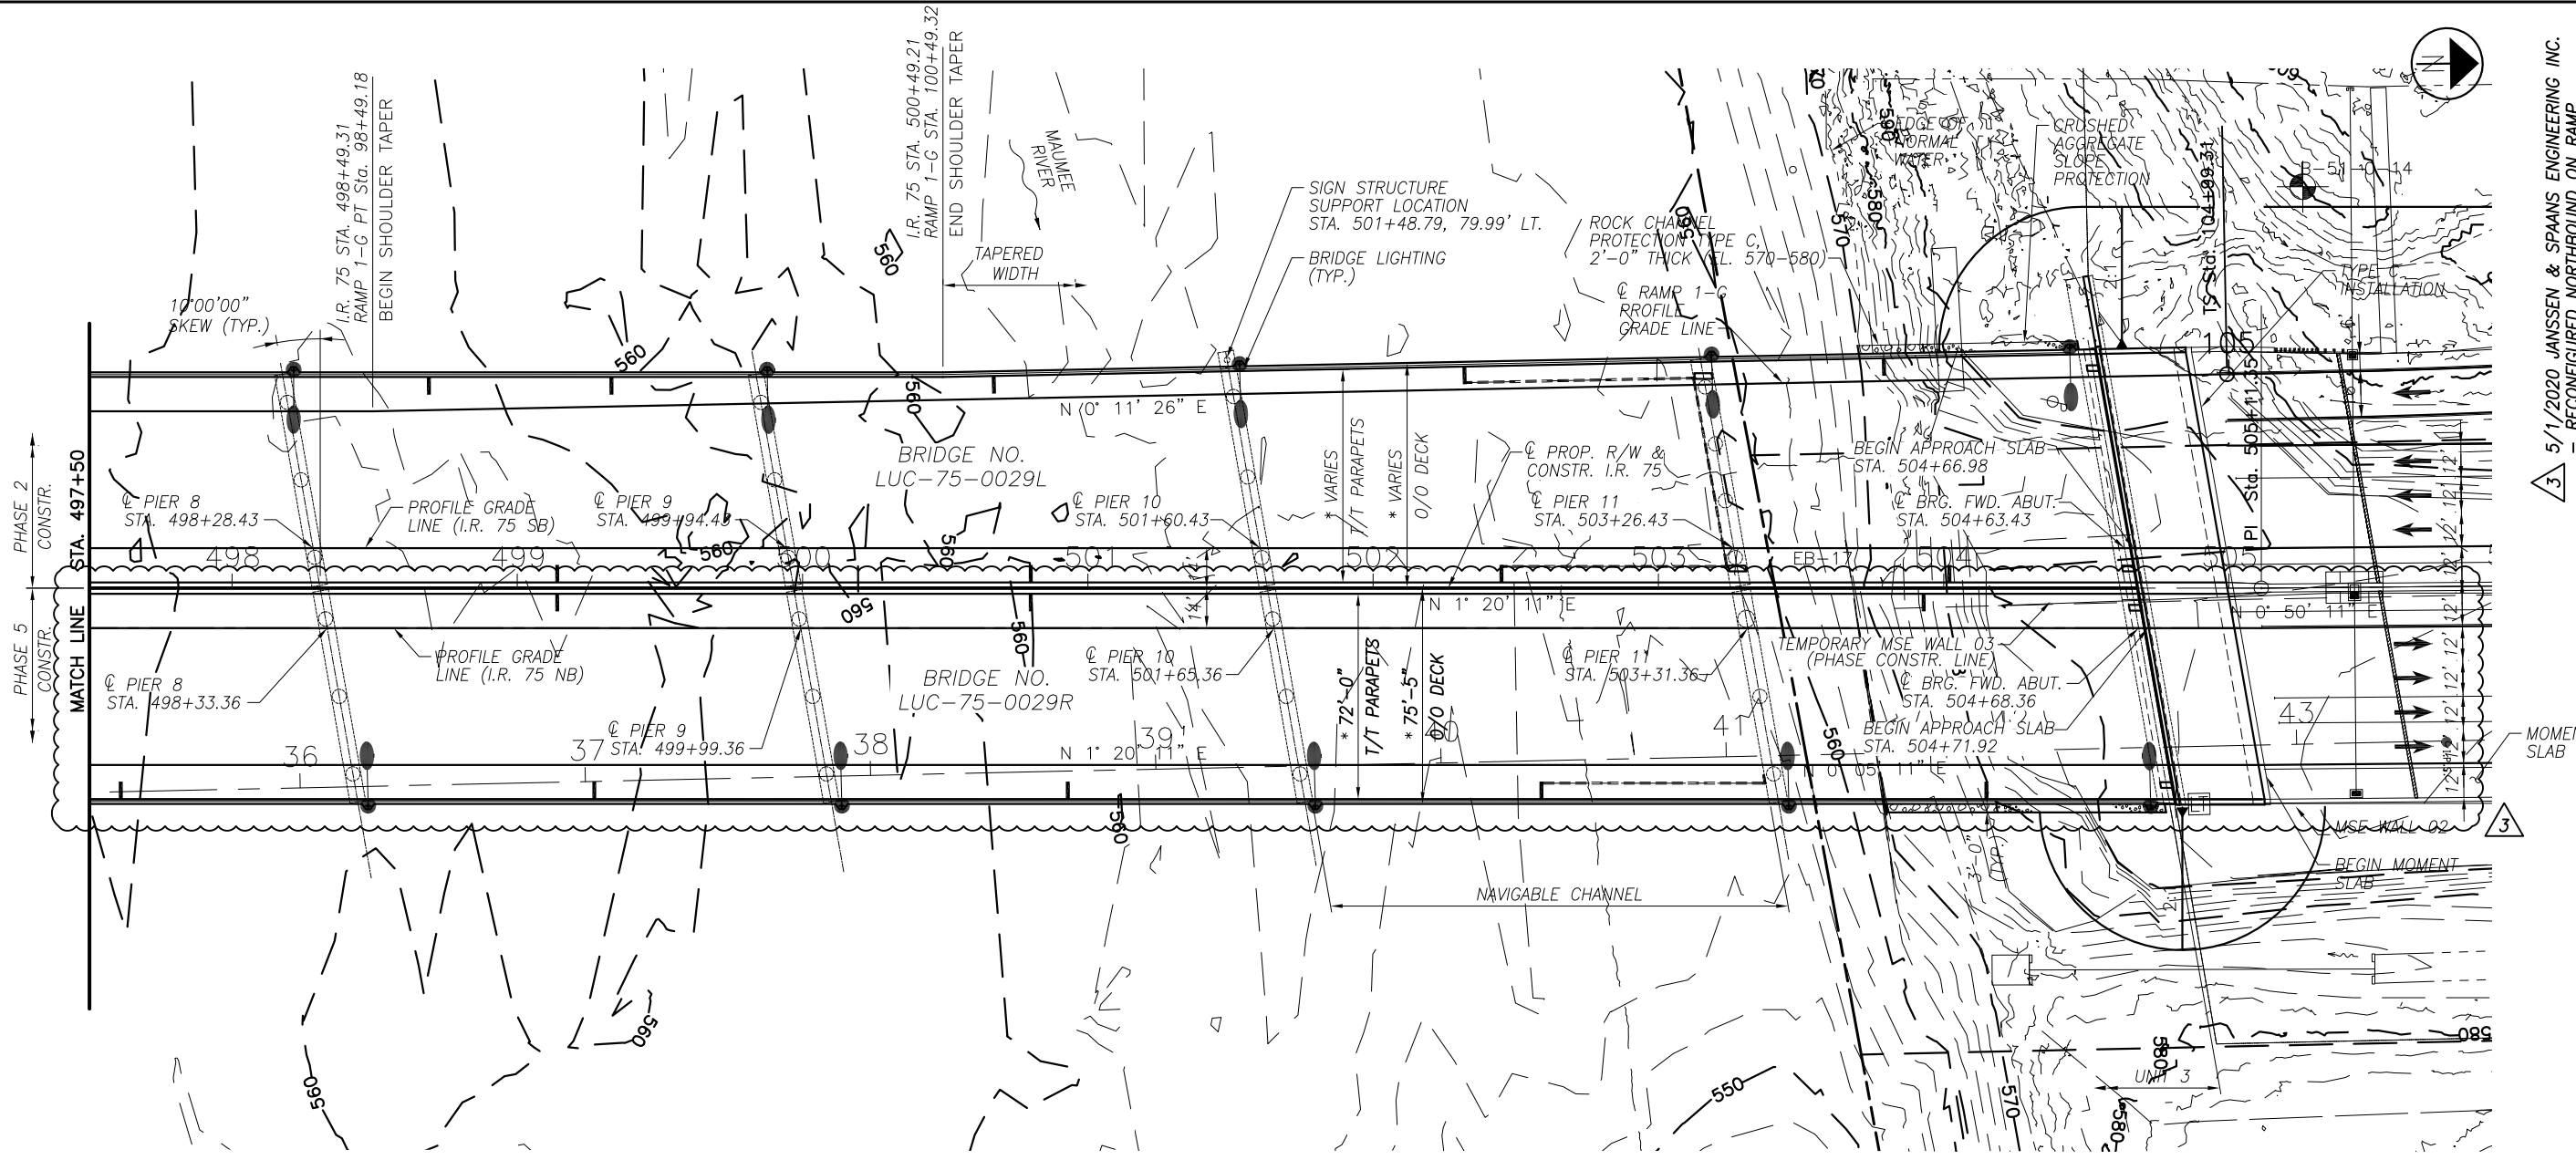

GENERAL PLAN

NOTES


1. FOR NOTES AND LEGEND, SEE SHEET 7 / 216

3 5/1/2020 JANSSEN & SPAANS ENGINEERING INC.  
 RECONFIGURED NORTHBOUND ON RAMP

DESIGNED	MRW	CHECKED	CRG
DRAWN	CMA	REVISD	
REVIEWED	JTH	DATE	8/18
STRUCTURE FILE NUMBER	4802765/4802767	DESIGN AGENCY	JANSSEN & SPAANS ENGINEERING INC.
PID No.	93592	1302	1792
9	216		

654 WHITE POND DRIVE  
 AKRON, OHIO 44320-1100  
**AECOM**  
 (330) 836-9111

Date: Oct 07, 2020 5:11pm User Name: r10nagatn  
 File: P11321 - Toledo E Valley Engineering\DWGS\BRIDGE\LUC-75-0027 over Maumee River\Sheets\075\_0027C\_GR001.dwg

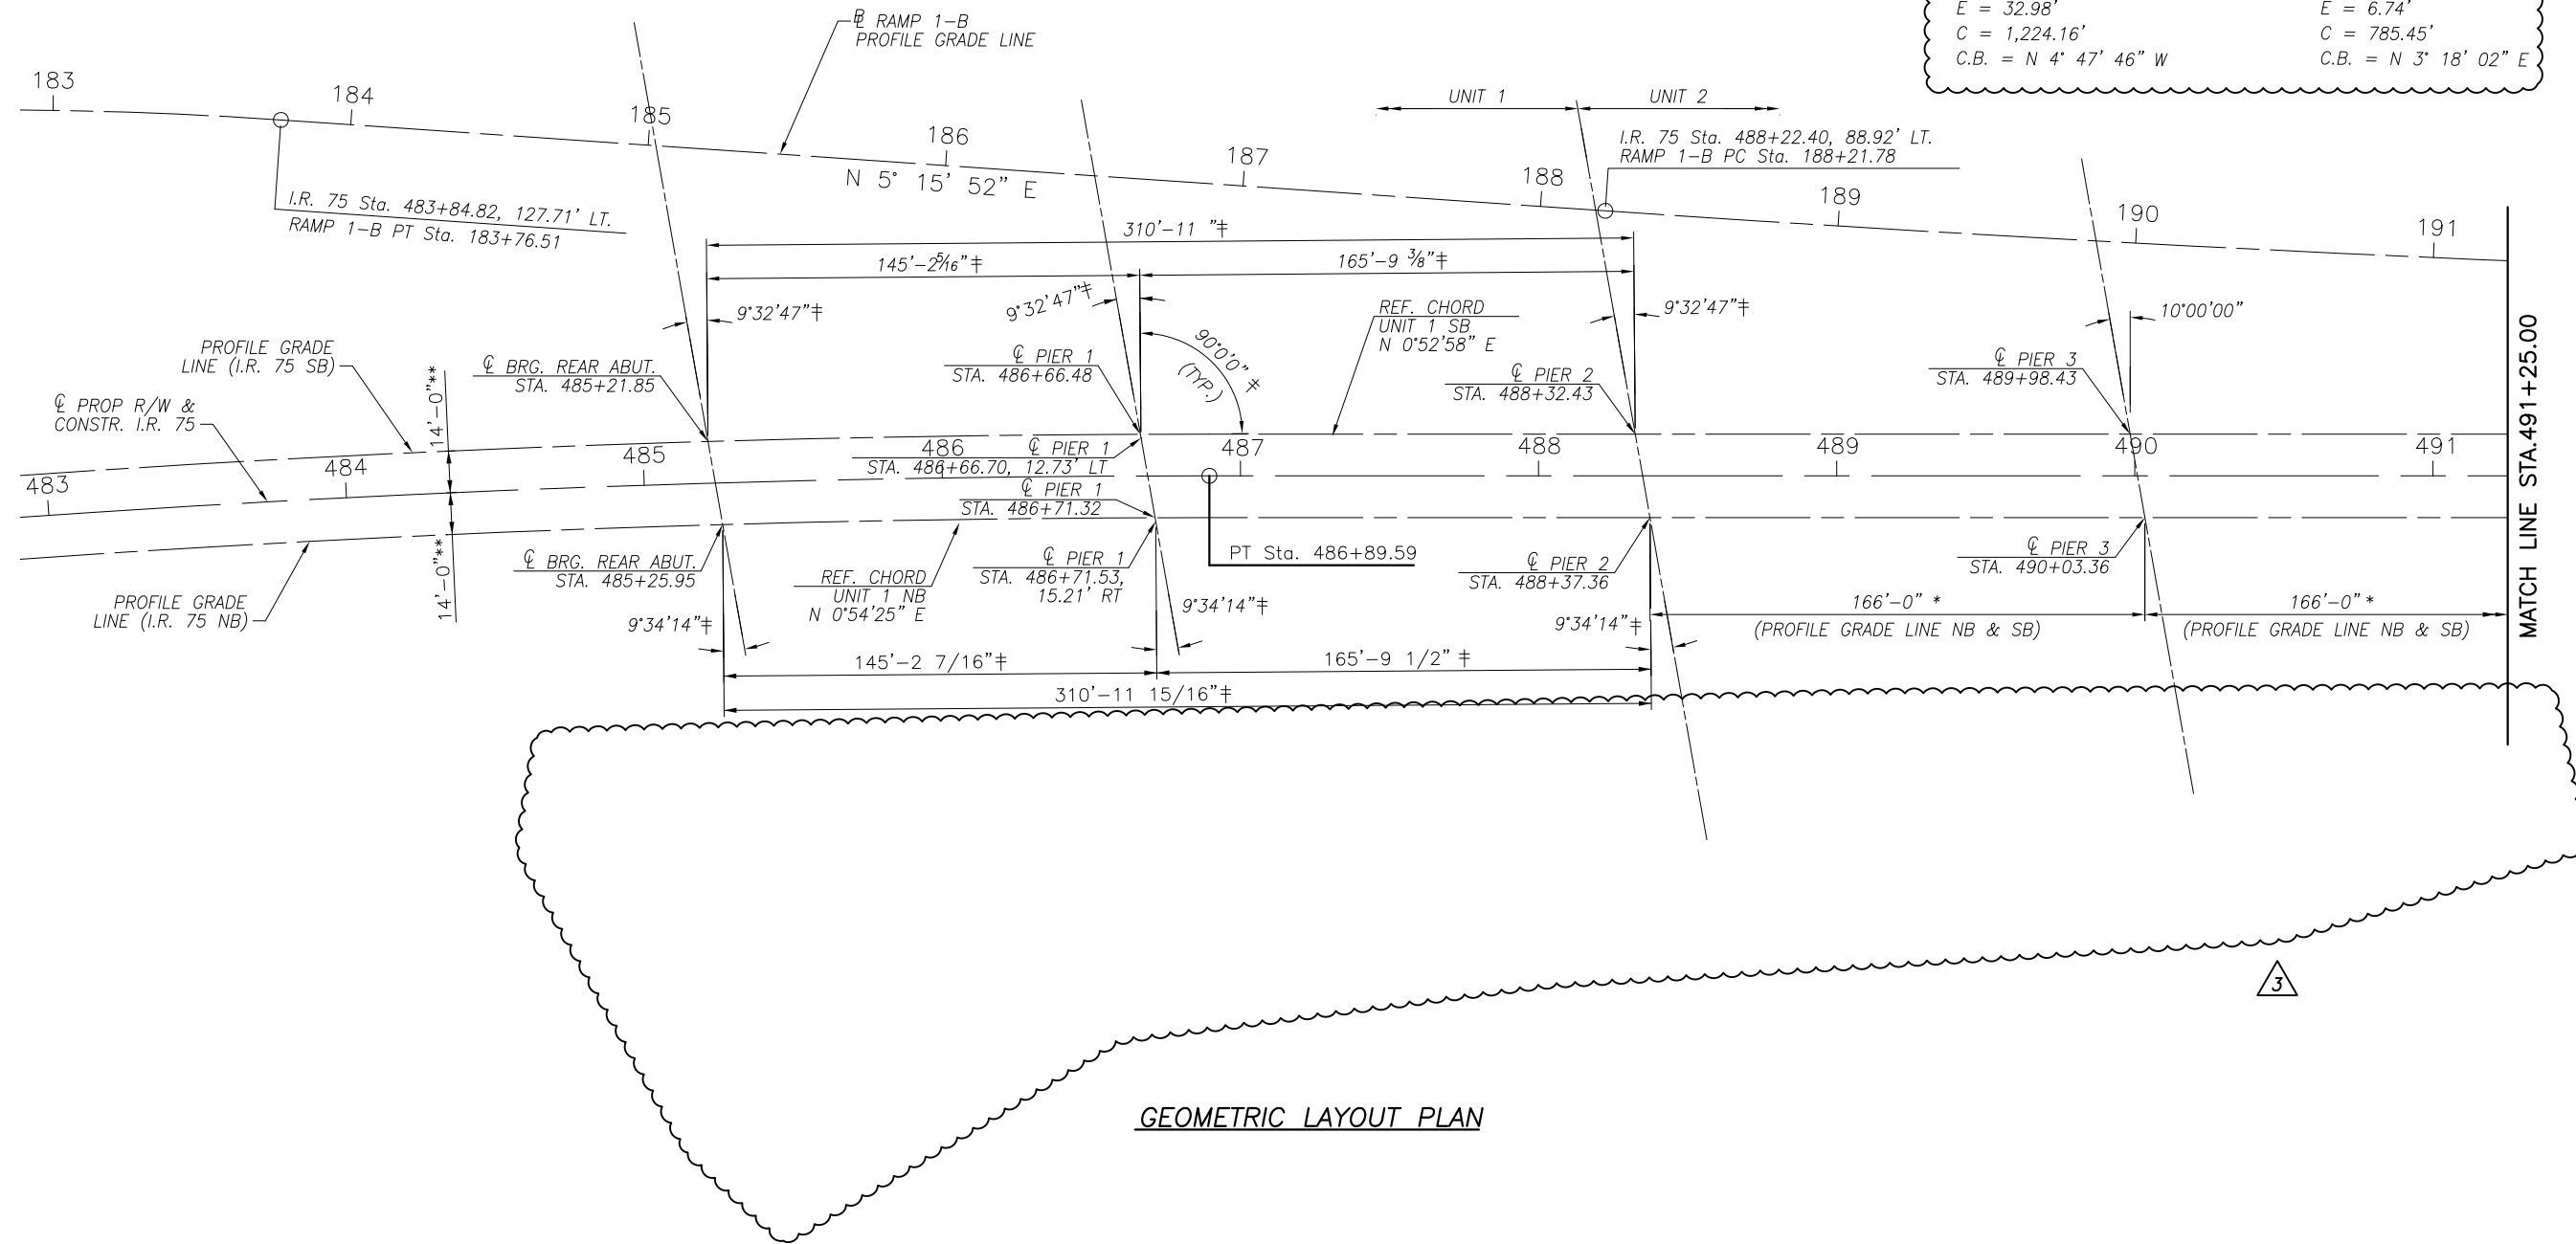

**GEOMETRIC LAYOUT PLAN**

CURVE DATA		CURVE DATA	
☐ PROP. R/W & CONSTR. I.R. 75	P.I. Sta. 480+78.70	☐ RAMP 1-B	P.I. Sta. 192+14.74
	$\Delta = 12' 15' 54''$ (RT)		$\Delta = 3' 55' 41''$ (LT)
	$D_c = 1' 00' 00''$		$D_c = 0' 30' 00''$
	$R = 5,729.58'$		$R = 11,459.16'$
	$T = 615.60'$		$T = 392.96'$
	$L = 1,226.50'$		$L = 785.61'$
	$E = 32.98'$		$E = 6.74'$
	$C = 1,224.16'$		$C = 785.45'$
	$C.B. = N 4' 47' 46'' W$		$C.B. = N 3' 18' 02'' E$

**LEGEND:**  
 \* - MEASURED ALONG L PROP. R/W & CONSTR. I.R. 75  
 \*\* - MEASURED PERP. TO L PROP. R/W & CONSTR. I.R. 75  
 † - MEASURED ALONG/WITH RESPECT TO REFERENCE CHORD




5/1/2020 JANSSEN & SPAANS ENGINEERING INC.  
 RECONFIGURED NORTHBOUND ON RAMP

DESIGNED	MRW	CMA	DESIGN AGENCY	AECOM
CHECKED	CRG	REVISED	DATE	8/18
			JTH	
			STRUCTURE FILE NUMBER	4802765/4802767
GEOMETRIC LAYOUT PLAN - 1 OF 3				
BRIDGE NO. LUC-75-0029 L/R				
I.R. 75 OVER MAUMEE RIVER				
W00/LUC-75-30.70/0.00				
PID No. 93592				
10 / 216				
1303 1792				



Date: Oct 07, 2020, 5:12pm User Name: mlmglin  
 File: P:\11321 - Toledo E Value Engineering\DWG\5\BRIDGE\LUC-75-0027 over Maumee River\Sheets\075\_0027C\_GPO01.dwg

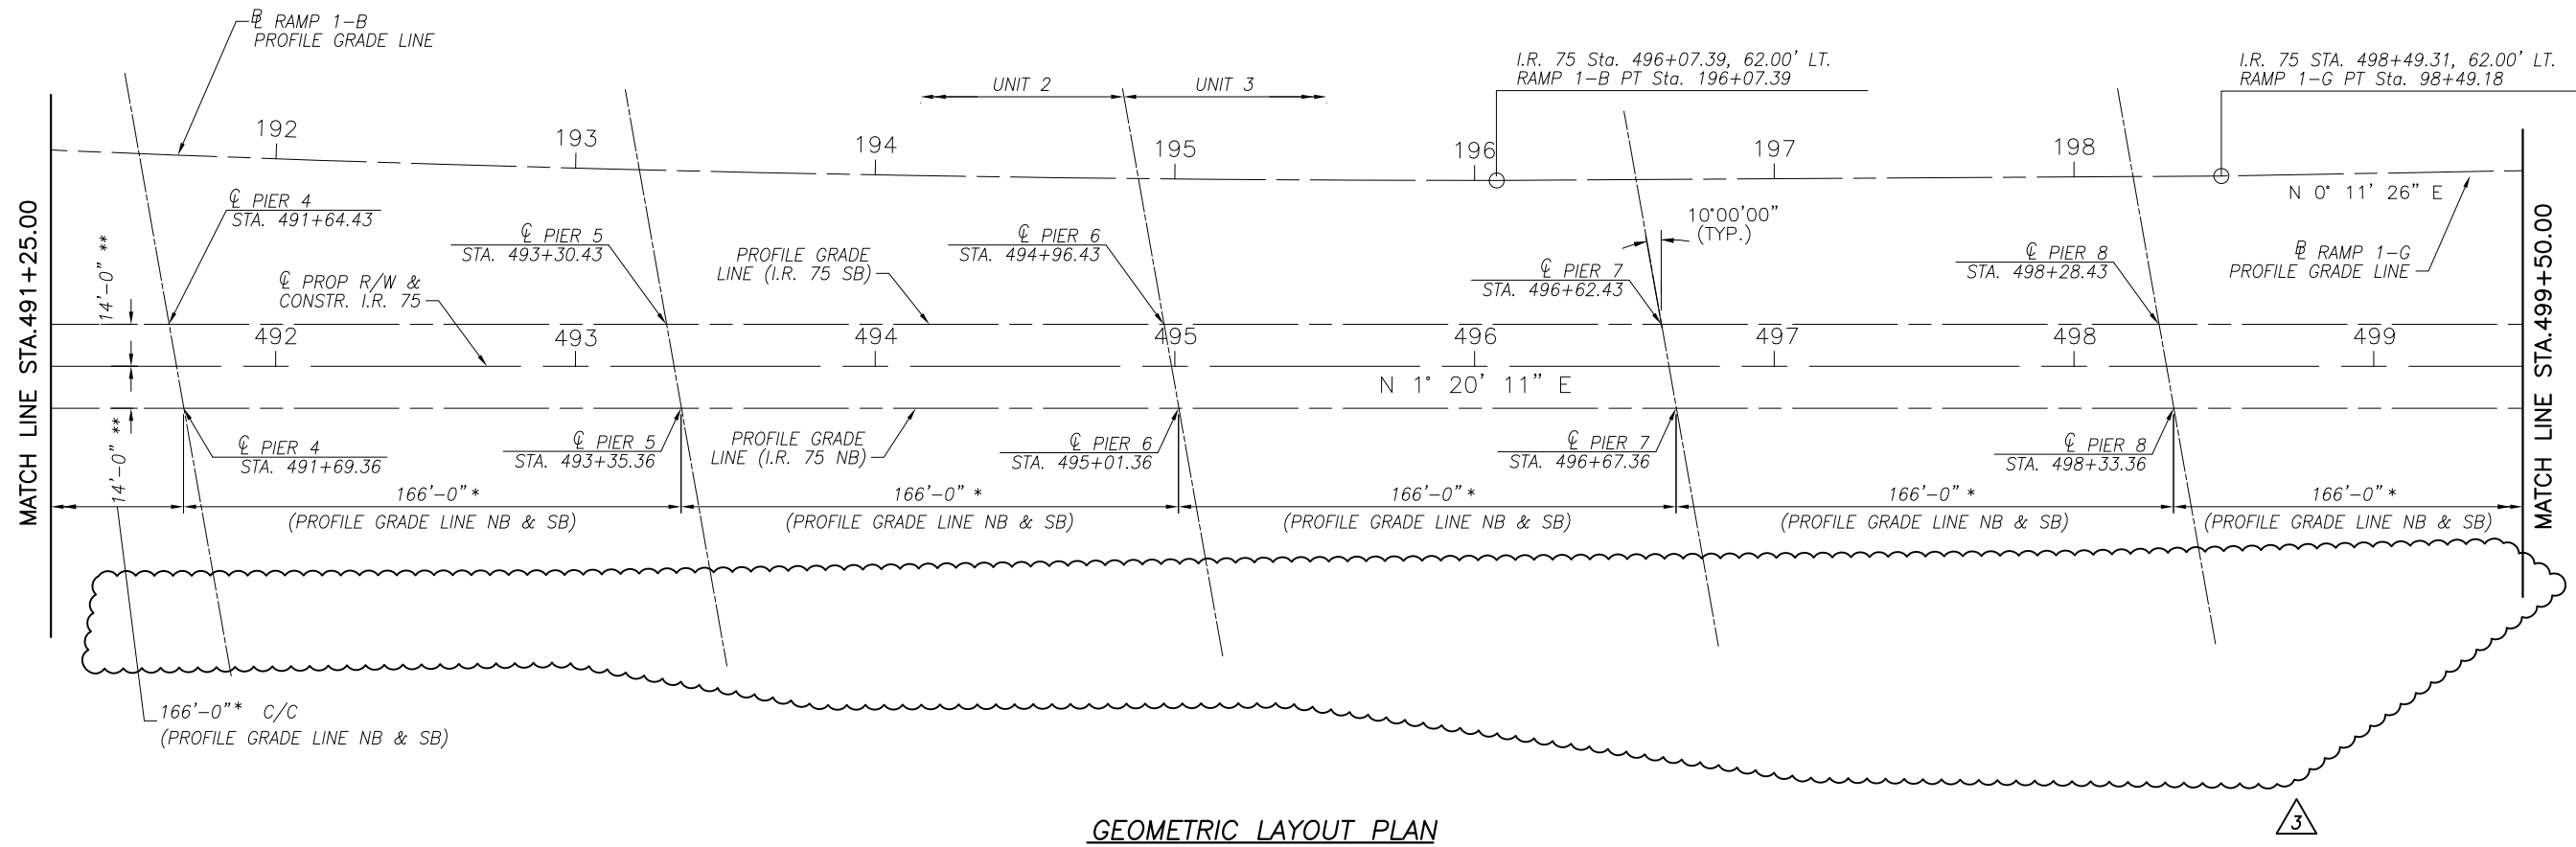

**GEOMETRIC LAYOUT PLAN**

**LEGEND:**

- \* - MEASURED ALONG L PROP. R/W & CONSTR. I.R. 75
- \*\* - MEASURED PERP. TO L PROP. R/W & CONSTR. I.R. 75




5/1/2020 JANSSEN & SPANNS ENGINEERING INC.  
 RECONFIGURED NORTHBOUND ON RAMP

DESIGNED	MRW	CHECKED	CRG
DRAWN	CMA	REVISD	
REVIEWED	JTH	STRUCTURE FILE NUMBER	4802765/4802767
DATE	8/18	DESIGN AGENCY	AECOM

GEOMETRIC LAYOUT PLAN - 2 OF 3  
 BRIDGE NO. LUC-75-0029 L/R  
 I.R. 75 OVER MAUMEE RIVER

W00/LUC-75-  
 30.70/0.00  
 PID No. 93592

Date: Oct 07, 2020, 5:12pm User Name: mlongtin  
 File: P:\1321 - Toledo E Value Engineering\DWG\SRIDGE\LUC-75-0027 over Maumee River\Sheets\075\_0027C\_GRP001.dwg

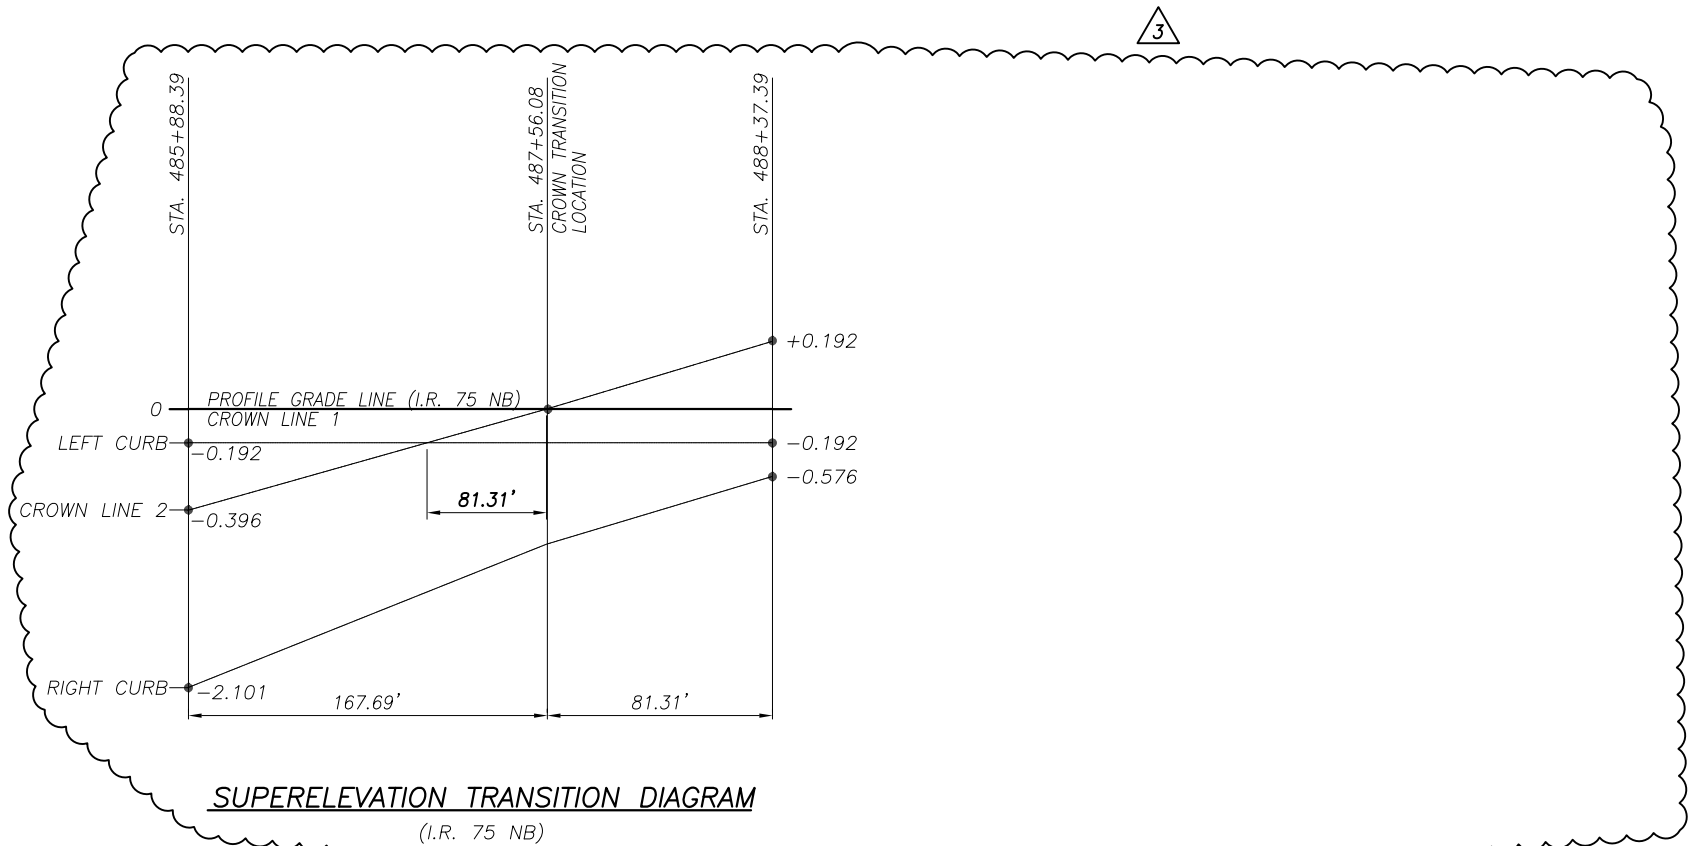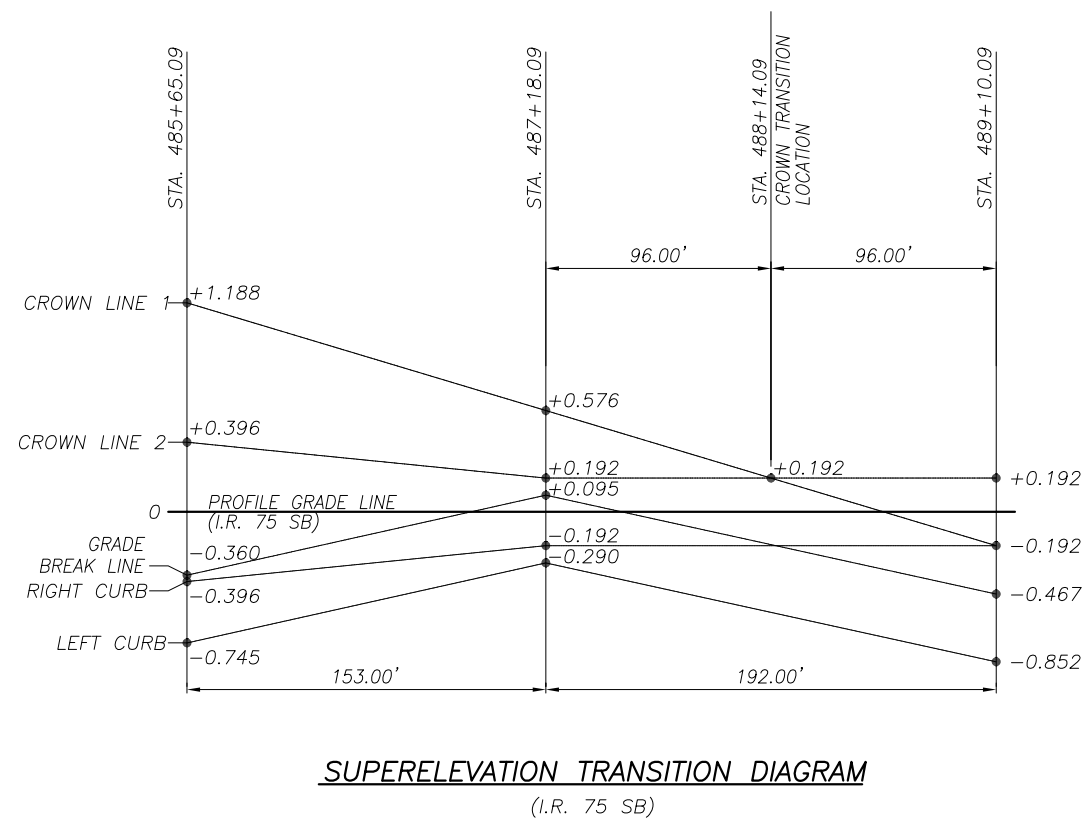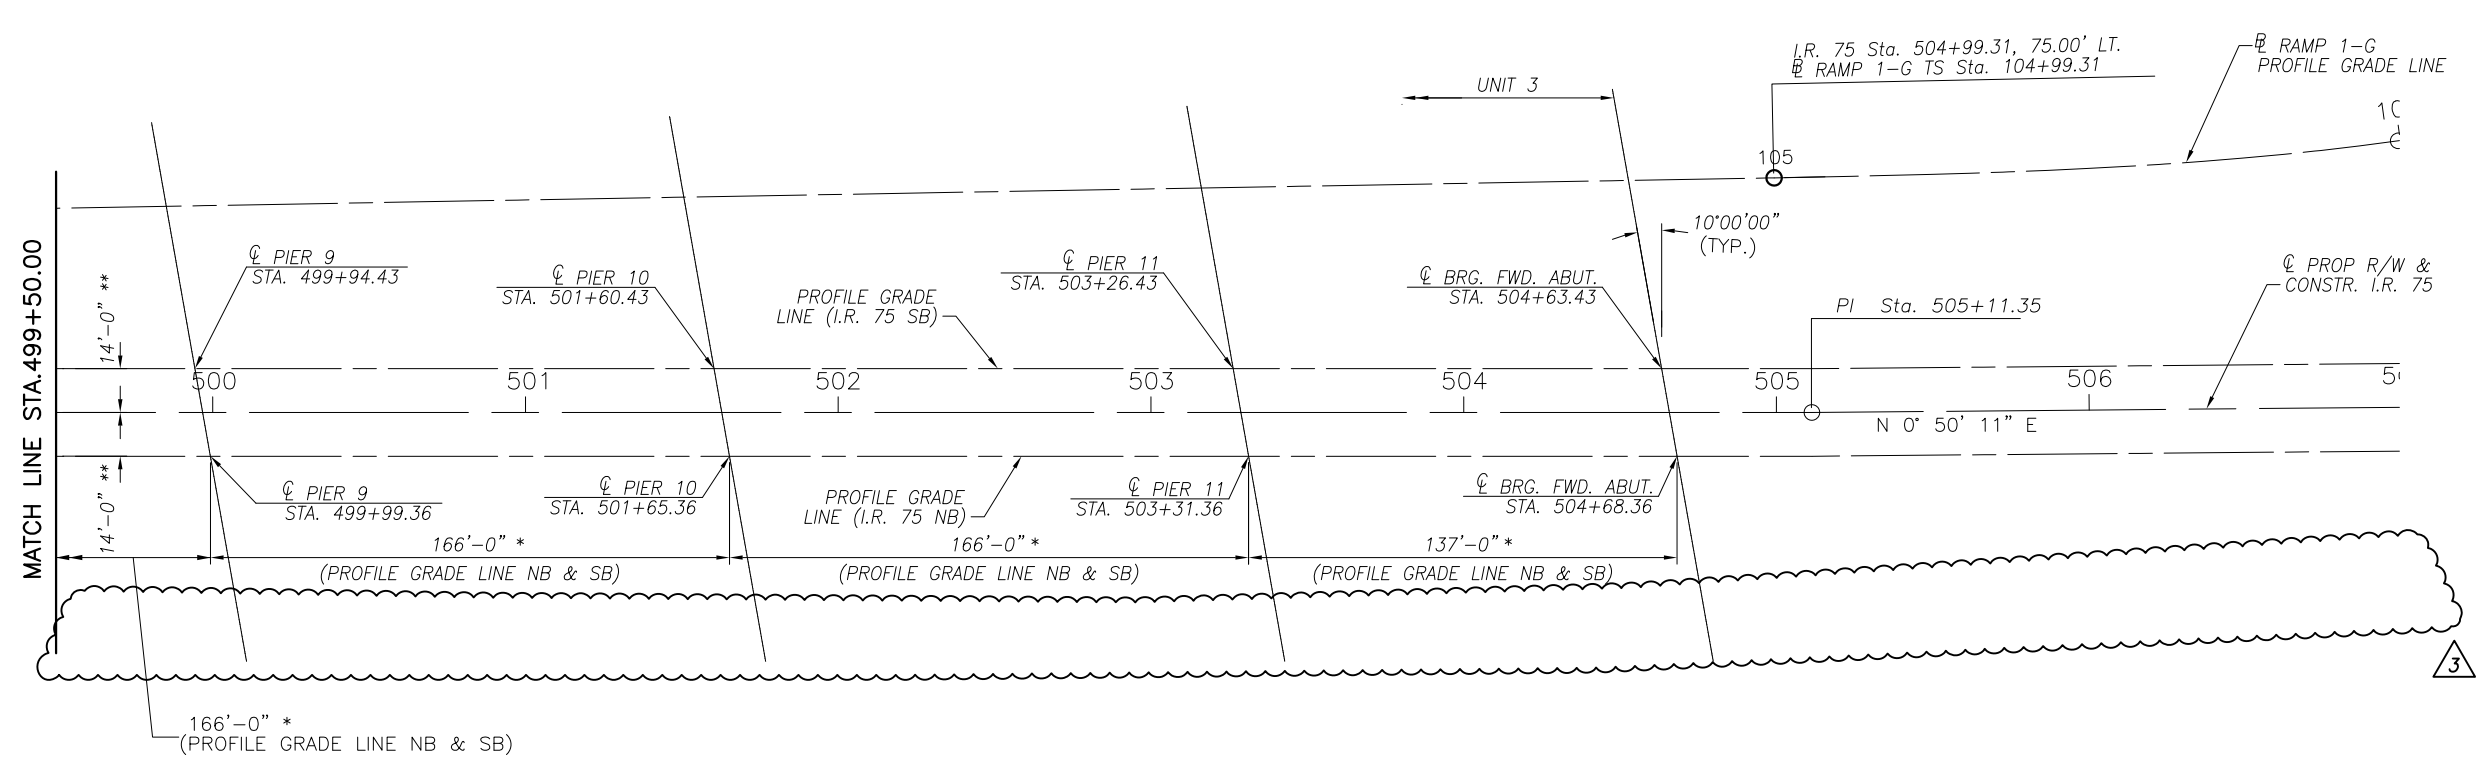

**LEGEND:**

\* - MEASURED ALONG L PROP. R/W & CONSTR. I.R. 75

\*\* - MEASURED PERPENDICULAR TO L PROP. R/W & CONSTR. I.R. 75

**NOTE:**

FOR PAVEMENT ELEVATION TABLES, SEE SHEETS 1305 THRU 1792

5/1/2020 JANSSEN & SPAANS ENGINEERING INC.  
 RECONFIGURED NORTHBOND ON RAMP

DESIGNED	MRW	CHECKED	CRG
DRAWN	CMA	REVISD	
REVIEWED	JTH	STRUCTURE FILE NUMBER	4802765/4802767
DATE	8/18	DESIGN AGENCY	AECOM

GEOMETRIC LAYOUT PLAN - 3 OF 3  
 BRIDGE NO. LUC-75-0029 L/R  
 I.R. 75 OVER MAUMEE RIVER

W00/LUC-75-  
 30.70/0.00  
 PID No. 93592

STANDARD DRAWINGS AND SUPPLEMENTAL SPECIFICATIONS:

REFERENCE SHALL BE MADE TO STANDARD DRAWINGS:

Table with 3 columns: Drawing ID, Status, Date. Includes items like A-1-69 REVISED 07-19-02, AS-1-15 REVISED 07-17-15, etc.

AND TO THE FOLLOWING SUPPLEMENTAL SPECIFICATIONS:

Table with 3 columns: Value, Status, Date. Includes items like 800 DATED 10-19-18, 832 DATED 01-17-14, etc.

DESIGN SPECIFICATIONS:

THIS STRUCTURE CONFORMS TO THE "LRFD BRIDGE DESIGN SPECIFICATIONS" ADOPTED BY THE AMERICAN ASSOCIATION OF STATE HIGHWAY AND TRANSPORTATION OFFICIALS, 2014, 7TH EDITION, INCLUDING 2015 INTERIM SPECIFICATIONS AND THE ODOT BRIDGE DESIGN MANUAL, 2007.

OPERATIONAL IMPORTANCE:

A LOAD MODIFIER OF 1.05 HAS BEEN ASSUMED FOR THE DESIGN OF THIS STRUCTURE IN ACCORDANCE WITH THE AASHTO LRFD BRIDGE DESIGN SPECIFICATIONS, ARTICLE 1.3.5 AND THE ODOT BRIDGE DESIGN MANUAL, 2007.

DESIGN LOADING:

HL-93
FUTURE WEARING SURFACE (FWS) OF 0.060 KSF

PER CORRESPONDENCE WITH ODOT DISTRICT 2 AND CENTRAL OFFICE, THIS BRIDGE HAS BEEN DESIGNED FOR LOADS AND DETAILING REQUIREMENTS CONSISTENT WITH AASHTO LRFD SEISMIC ZONE 2.

DESIGN DATA:

CONCRETE FOR PRESTRESSED BEAMS:
COMPRESSIVE STRENGTH (FINAL) - 10 KSI
COMPRESSIVE STRENGTH (RELEASE) - 8 KSI

PRESTRESSING STRAND:
AREA = 0.217 SQ.IN.
ULTIMATE STRENGTH = 270 KSI
INITIAL STRESS = 202.5 KSI (LOW RELAXATION STRANDS)

CONCRETE CLASS QC2 WITH QC/QA - COMPRESSIVE STRENGTH 4.5 KSI (SUPERSTRUCTURE)

CONCRETE CLASS QC1 WITH QC/QA - COMPRESSIVE STRENGTH 4.0 KSI (ABUTMENTS EXCEPT FOR BREAST WALLS)

MASS CONCRETE CLASS QC4 WITH QC/QA - COMPRESSIVE STRENGTH 4.0 KSI (PIERS AND ABUTMENT BREAST WALLS)

MASS CONCRETE CLASS QC5 WITH QC/QA, - COMPRESSIVE STRENGTH 4.5 KSI (DRILLED SHAFTS) THE COARSE AGGREGATE SHALL BE #8 LIMESTONE

REINFORCING STEEL - SUB-STRUCTURE MINIMUM YIELD STRENGTH 60 KSI,

SOUTHBOUND SLAB, PARAPET, CONCRETE DIAPHRAGMS, AND MEDIAN BARRIER MINIMUM YIELD STRENGTH 60 KSI,

NORTHBOUND SLAB, PARAPET, CONCRETE DIAPHRAGMS AND MEDIAN BARRIER MINIMUM YIELD STRENGTH 75 KSI,

STEEL H-PILES - ASTM A572 - YIELD STRENGTH 50KSI

WELDED WIRE REINFORCEMENT - MINIMUM YIELD STRENGTH 70 KSI

DECK PROTECTION METHOD:

EPOXY COATED REINFORCING STEEL
2 1/2" CONCRETE COVER

MONOLITHIC WEARING SURFACE:

MONOLITHIC WEARING SURFACE IS ASSUMED, FOR DESIGN PURPOSES, TO BE 1" THICK.

UTILITY LINES:

SEE GENERAL NOTES, SHEET 43/1792 FOR THE LIST OF UTILITIES IN THE PROJECT AREA. ALL EXPENSES INVOLVED IN RELOCATION (INSTALLING) THE AFFECTED UTILITY LINE(S) SHALL BE BORNE BY THE UTILITY(IES). THE CONTRACTOR AND THE UTILITY(IES) ARE TO COOPERATE BY ARRANGING THEIR WORK IN SUCH A MANNER THAT INCONVENIENCE TO EITHER WILL BE HELD TO A MINIMUM.

ITEM 202, STRUCTURE REMOVED, OVER 20 FOOT SPAN, AS PER PLAN:

ALL REQUIREMENTS OF ODOT CMS 202.03 SHALL APPLY WITH THE FOLLOWING ADDITIONS: THIS ITEM SHALL INCLUDE ALL LABOR, EQUIPMENT, MATERIALS AND INCIDENTALS ASSOCIATED WITH REMOVAL OF EXISTING BRIDGES LUC-75-0027 L/R AND LUC-75-0079. THIS ALSO INCLUDES ALL COSTS ASSOCIATED WITH THE TEMPORARY SUPPORTS USED DURING PHASED DEMOLITION. FOR DETAILS AND NOTES REGARDING THIS REMOVAL, SEE PHASED CONSTRUCTION DETAILS, SHEETS 1274 THRU 1293/1792.

MAINTENANCE OF TRAFFIC:

FOR MAINTENANCE OF TRAFFIC NOTES AND DETAILS, SEE SHEETS 51/1792 THRU 346/1792.

SEQUENCE OF CONSTRUCTION:

FOR SEQUENCE OF CONSTRUCTION INFORMATION, SEE PHASED CONSTRUCTION DETAILS, SHEETS 1274 THRU 1293/1792.

EXISTING STRUCTURE VERIFICATION:

DETAILS AND DIMENSIONS SHOWN ON THESE PLANS PERTAINING TO THE EXISTING STRUCTURE HAVE BEEN OBTAINED FROM PLANS OF THE EXISTING STRUCTURE AND FROM FIELD OBSERVATIONS AND MEASUREMENTS. CONSEQUENTLY THEY ARE INDICATIVE OF THE EXISTING STRUCTURE AND THE PROPOSED WORK, BUT THEY SHALL BE CONSIDERED TENTATIVE AND APPROXIMATE. THE CONTRACTOR IS REFERRED TO CMS SECTIONS 102.05, 105.02 AND 513.04.

CONTRACT BID PRICES SHALL BE BASED UPON A RECOGNITION OF THE UNCERTAINTIES DESCRIBED ABOVE AND UPON A PREBID EXAMINATION OF THE EXISTING STRUCTURE BY THE CONTRACTOR. HOWEVER, ALL PROJECT WORK SHALL BE BASED UPON ACTUAL DETAILS AND DIMENSIONS WHICH HAVE BEEN VERIFIED BY THE CONTRACTOR IN THE FIELD.

DECK PLACEMENT DESIGN ASSUMPTIONS:

THE FOLLOWING ASSUMPTIONS OF CONSTRUCTION MEANS AND METHODS WERE MADE FOR THE ANALYSIS AND DESIGN OF THE SUPERSTRUCTURE. THE CONTRACTOR IS RESPONSIBLE FOR THE DESIGN OF THE FALSEWORK SUPPORT SYSTEM WITHIN THESE PARAMETERS AND WILL ASSUME RESPONSIBILITY FOR SUPERSTRUCTURE ANALYSIS FOR DEVIATION FROM THESE DESIGN ASSUMPTIONS.

AN EIGHT WHEEL FINISHING MACHINE WITH A MAXIMUM WHEEL LOAD OF 3.36 KIPS.

A MINIMUM OUT-TO-OUT WHEEL SPACING AT EACH END OF THE MACHINE OF 103".

A MAXIMUM SPACING OF OVERHANG FALSEWORK BRACKETS OF 48 IN.

A MAXIMUM DISTANCE FROM THE CENTERLINE OF THE FASCIA GIRDER TO THE FACE OF THE SAFETY HANDRAIL OF 75".

PROPRIETARY RETAINING WALL DATA:

THE PROPRIETARY WALL SUPPLIER SHALL DESIGN THE INTERNAL STABILITY OF A MECHANICALLY STABILIZED EARTH (MSE) WALL IN ACCORDANCE WITH SS840 TO SUPPORT THE ABUTMENT. THE DESIGN FOR INTERNAL STABILITY SHALL INCLUDE A NOMINAL (I.E. UNFACTORED) HORIZONTAL STRIP LOAD DUE TO FRICTION (FR) FROM THE SUPERSTRUCTURE OF 1.4 K/FT APPLIED PERPENDICULAR TO THE FACE OF WALL AT THE BASE OF THE CONCRETE FOOTING. THIS STRIP LOAD DOES NOT INCLUDE EARTH PRESSURE LOADS FROM THE ABUTMENT BACKFILL. HOWEVER, THE PROPRIETARY WALL SUPPLIER SHALL INCLUDE EARTH PRESSURE LOADS FROM THE ABUTMENT BACKFILL IN THE DESIGN CALCULATIONS.

PILES TO BEDROCK:

DRIVE PILES TO REFUSAL ON BEDROCK. THE DEPARTMENT WILL CONSIDER REFUSAL TO BE OBTAINED WHEN THE PILE PENETRATION IS AN INCH OR LESS AFTER RECEIVING AT LEAST 20 BLOWS FROM THE PILE HAMMER. SELECT THE HAMMER SIZE TO ACHIEVE THE REQUIRED DEPTH TO BEDROCK AND REFUSAL.

THE TOTAL FACTORED LOAD IS 338 KIPS PER PILE FOR THE ABUTMENT PILES.

ABUTMENT PILES:

REAR ABUTMENT
SB: 34 - HP12x53 PILES 105 FEET LONG, ORDER LENGTH
NB: 28 - HP12x53 PILES 105 FEET LONG, ORDER LENGTH

FORWARD ABUTMENT
SB: 8 - HP12x53 PILES 100 FEET LONG, ORDER LENGTH
23 - HP12x53 PILES 105 FEET LONG, ORDER LENGTH
NB: 6 - HP12x53 PILES 100 FEET LONG, ORDER LENGTH
16 - HP12x53 PILES 105 FEET LONG, ORDER LENGTH

ITEM 203 EMBANKMENT, AS PER PLAN:

PLACE AND COMPACT EMBANKMENT MATERIAL IN 6 INCH LIFTS FOR THE CONSTRUCTION OF THE APPROACH EMBANKMENT BETWEEN STATIONS 484+22.41 TO 505+71.92.

PILE DRIVING CONSTRAINTS:

PRIOR TO DRIVING ABUTMENT PILES TO REFUSAL ON BEDROCK, CONSTRUCT THE MSE WALL AND THE BRIDGE APPROACH EMBANKMENT BEHIND THE ABUTMENT UP TO THE BOTTOM OF THE FOOTING FOR A MINIMUM DISTANCE OF 200' BEHIND EACH ABUTMENT. THE CONTRACTOR MAY PRE-DRIVE ABUTMENT PILES BEFORE CONSTRUCTING MSE WALLS. PRE-DRIVING CONSISTS OF INSTALLING THE ABUTMENT PILES INTO THE SOIL ONLY AS FAR AS NECESSARY SO THAT THE PILE WILL REMAIN VERTICAL OR AT PRESCRIBED BATTER DURING MSE WALL CONSTRUCTION. IF PRE-DRIVING PILES, INSTALL PILE SLEEVES AROUND PILES BEFORE CONSTRUCTING THE MSE WALL. AT LEAST THREE FEET OF PILE MUST EXTEND ABOVE THE TOP OF THE PILE SLEEVE TO MEET THE REQUIREMENTS OF CMS 507.09 REGARDING SPLICES. DO NOT DRIVE ABUTMENT PILES TO REFUSAL ON BEDROCK UNTIL AFTER THE ABOVE REQUIRED MSE WALL AND EMBANKMENT HAVE BEEN CONSTRUCTED AND A 180 CALENDAR DAY WAITING PERIOD HAS ELAPSED. THE ENGINEER MAY ADJUST THE LENGTH OF THE WAITING PERIOD BASED ON SETTLEMENT PLATFORM READINGS. AFTER THE SPECIFIED WAITING PERIOD HAS ELAPSED, DRIVE ABUTMENT PILES TO REFUSAL ON BEDROCK. IN ORDER TO REMOVE ANY NEGATIVE SKIN FRICTION THAT HAS DEVELOPED DURING THE WAITING PERIOD, DRIVE EACH ABUTMENT PILE A DISTANCE OF AT LEAST 0.5 INCH.

IF NOT PRE-DRIVING ABUTMENT PILES, INSTALL THE ABUTMENT PILES THROUGH PILE SLEEVES AFTER THE ABOVE REQUIRED MSE WALL AND EMBANKMENT HAVE BEEN CONSTRUCTED AND THE SPECIFIED WAITING PERIOD HAS ELAPSED. DUE TO BATTER, FORWARD ABUTMENT PILES SHALL BE PRE-DRIVEN.

PILE SPLICES:

IN LIEU OF USING THE FULL PENETRATION BUTT WELDS SPECIFIED IN CMS 507.09 TO SPLICE STEEL H-PILES, THE CONTRACTOR MAY USE A MANUFACTURED H-PILE SPLICER. FURNISH SPLICERS FROM THE FOLLOWING MANUFACTURER:

ASSOCIATED PILE AND FITTING CORPORATION
8 WOOD HOLLOW RD. PLAZA 1
PARSIPPANY, NEW JERSEY 07054

INSTALL AND WELD THE SPLICER TO THE PILE SECTIONS IN ACCORDANCE WITH THE MANUFACTURER'S WRITTEN ASSEMBLY PROCEDURE SUPPLIED TO THE ENGINEER BEFORE THE WELDING IS PERFORMED.

DRILLED SHAFTS:

THE MAXIMUM FACTORED LOAD TO BE SUPPORTED BY EACH DRILLED SHAFT IS AS FOLLOWS:

- 7' DIAMETER = 4547 KIPS
6.5' DIAMETER = 3844 KIPS
6' DIAMETER = 4507 KIPS

THIS LOAD IS RESISTED BY TIP RESISTANCE. THE FACTORED RESISTANCE PROVIDED BY THE DRILLED SHAFT TIP IS AS FOLLOWS:

- 7' DIAMETER = 7499 KIPS
6.5' DIAMETER = 6390 KIPS
6' DIAMETER = 5369 KIPS

PRIOR TO POURING THE DRILLED SHAFT CONCRETE, THE CONTRACTOR SHALL DETERMINE THE COLUMN LOCATION BY SURVEY AND ACCURATELY PLACE THE COLUMN SPLICE REINFORCING CAGE. IF THE COLUMN SPLICE CAGE IS FOUND TO BE LOCATED MORE THAN 3 INCHES OFF CENTER WITH RESPECT TO CENTER OF DRILLED SHAFT, THE CONTRACTOR SHALL IMMEDIATELY NOTIFY THE ENGINEER. THE DRILLED SHAFT CONCRETE SHALL NOT BE POURED UNTIL THE EFFECT OF MISALIGNMENT IS CORRECTED TO THE SATISFACTION OF THE ENGINEER.

EXISTING AND PROPOSED FOUNDATION ELEMENTS:

ALL EXISTING FOUNDATION PILES ARE TO REMAIN IN-PLACE. WHILE LOCATING THE PROPOSED SUBSTRUCTURE PILES AND DRILLED SHAFTS, AN ATTEMPT WAS MADE TO AVOID INTERFERENCE BETWEEN THE PROPOSED AND EXISTING FOUNDATION ELEMENTS. HOWEVER, IF INTERFERENCE IS ENCOUNTERED, THE CONTRACTOR SHALL NOTIFY THE ENGINEER IMMEDIATELY. IF THE INTERFERENCE INVOLVES A PROPOSED PILE, THE CONTRACTOR SHALL PROPOSE AN ALTERNATE LOCATION TO INSTALL A REPLACEMENT PILE TO THE ENGINEER FOR REVIEW. THE ENGINEER SHALL APPROVE OR COMMENT UPON THE CONTRACTOR'S SUBMITTAL WITHIN 3 BUSINESS DAYS. IF A NEW PILE LOCATION IS APPROVED, THE CONTRACTOR SHALL BE PAID AT THE UNIT PRICE BID FOR FURNISHING AND INSTALLING THE WASTED LENGTH OF PILE. NO SEPARATE PAYMENT WILL BE MADE FOR PULLING THE WASTED PILE. IF INTERFERENCE IS ENCOUNTERED WHEN DRILLING A SHAFT, THE ENGINEER SHALL DECIDE EITHER TO PULL THE EXISTING PILE OR PROVIDE A DESIGN CHANGE TO ELIMINATE THE INTERFERENCE.

Date: Oct 09, 2020, 12:31pm User Name: mlongtin File: \\jse.com\files\projects\1321 - Toledo E Value Engineering\DWGS\Bridges\LUC-75-0027 over Maumee River\Sheets\075\_0027C\_GN001.dwg

1 9/17/2020 JANSSEN & SPAANS ENGINEERING INC. - REVISED NOTES

3 5/1/2020 JANSSEN & SPAANS ENGINEERING INC. - RECONFIGURED NORTHBOUND ON RAMP

GENERAL NOTES

BRIDGE NO. LUC-75-0029 L/R I.R. 75 OVER MAUMEE RIVER

W00/LUC-75-30.70/0.00 PID No. 93592

13 216

1306 1792

DESIGN AGENCY 564 WHITE POND DRIVE AKRON, OHIO 44320-1100 (330) 836-9111 AECOM

Date: Nov 24, 2020, 1:51pm User Name: mlonghin  
 File: \\use.com\files\projects\1321 - Toledo E Value Engineering\DWGS\BRIDGE\LUC-75-0027 over Maumee River\Sheets\075\_0027C\_EQ001.dwg

Estimated Quantities										CALC BY: WOZ 6/1/20		CHECK BY: CBS 6/2/20				
ITEM ODOT	EXT.	PARTICIPATION 02/BRO/BR	TOTAL	UNIT	DESCRIPTION	LUC-75-0029L (SOUTHBOUND)					LUC-75-0029L (NORTHBOUND)					REFERENCE SHEET(S)
						ABUTMENTS		PIERS	SUPER.	GENERAL	ABUTMENTS		PIERS	SUPER.	GENERAL	
						REAR	FWD.				REAR	FWD.				
202	110033	LS	LS		STRUCTURE REMOVED, OVER 20 FOOT SPAN, AS PER PLAN					LS					13 / 216	
202	22900	794	794	SY	APPROACH SLAB REMOVED						504	290				
505	11100		LS		PILE DRIVING EQUIPMENT MOBILIZATION					LS						
507	200	11975	11975	FT	STEEL PILES HP12X53, FURNISHED	3570	3185				2940	2280				
507	250	11400	11400	FT	STEEL PILES HP12X53, DRIVEN	3400	3030				2800	2170				
507	92201	4340	4340	FT	PREBORED HOLES, AS PER PLAN	2380					1960				14 / 216	
509	10000	3432854	3432854	LB	EPOXY COATED REINFORCING STEEL, GRADE 60	27376	36748	499247	2381338		20730	23999	443416			
509	10001	1324919	1324919	LB	EPOXY COATED REINFORCING STEEL, GRADE 75							1324919		2		
511	33418	1429	1429	CY	CLASS QC2 CONCRETE WITH QC/QA, SUPERSTRUCTURE				749				680			
511	34446	9945	9945	CY	CLASS QC2 CONCRETE WITH QC/QA, BRIDGE DECK				5216				4729			
511	34450	1294	1294	CY	CLASS QC2 CONCRETE WITH QC/QA, BRIDGE DECK (PARAPET)				645				649			
511	43512	831	831	CY	CLASS QC1 CONCRETE WITH QC/QA, ABUTMENT INCLUDING FOOTING	303	201				206	121				
511	45602	5774	5774	CY	CLASS QC4 MASS CONCRETE, SUBSTRUCTURE WITH QC/QA		241	2859				200	2474			
512	10100	13883	13883	SY	SEALING OF CONCRETE SURFACES (EPOXY-URETHANE)	281	219	147	6067	88	211	160	160	6462	88	
512	10300	327	327	SY	SEALING OF CONCRETE SURFACES (EPOXY-URETHANE)				168					159		
512	33000	20	20	SY	TYPE 2 WATERPROOFING		6				8	6				
515	15140	20	20	EACH	DRAPED STRAND PRESTRESSED CONCRETE BRIDGE I-BEAM MEMBERS, LEVEL 3, TYPE WF84-49 (145' +/-)				12					8		
515	15140	172	172	EACH	DRAPED STRAND PRESTRESSED CONCRETE BRIDGE I-BEAM MEMBERS, LEVEL 3, TYPE WF84-49 (166' +/-)				92					80		
515	15140	16	16	EACH	DRAPED STRAND PRESTRESSED CONCRETE BRIDGE I-BEAM MEMBERS, LEVEL 3, TYPE WF84-49 (137' +/-)				8					8		
515	20001	704	704	EACH	INTERMEDIATE DIAPHRAGMS, AS PER PLAN				382					322	135 / 216 THRU 140 / 216	
516	11210	698	698	FT	STRUCTURAL EXPANSION JOINT INCLUDING ELASTOMERIC STRIP SEAL	125	85	177			80	77	154			
516	13600	235	235	SF	1" PREFORMED EXPANSION JOINT FILLER	20	30	135			20	30				
516	13600	402	402	SF	2" PREFORMED EXPANSION JOINT FILLER	206	31				105	60				
516	44201	152	152	EACH	ELASTOMERIC BEARING WITH INTERNAL LAMINATES AND LOAD PLATE (NEOPRENE), AS PER PLAN (3-4 IN. THK., PAD AND PLATE SIZES VARY, SEE PLANS)			64			8		80		48 / 216 THRU 53 / 216	
516	44301	232	232	EACH	ELASTOMERIC BEARING WITH INTERNAL LAMINATES AND LOAD PLATE (NEOPRENE), AS PER PLAN (4-5 IN. THK., PAD AND PLATE SIZES VARY, SEE PLANS)	12		132					88		48 / 216 THRU 53 / 216	
516	44401	32	32	EACH	ELASTOMERIC BEARING WITH INTERNAL LAMINATES AND LOAD PLATE (NEOPRENE), AS PER PLAN (>5 IN. THK., PAD AND PLATE SIZES VARY, SEE PLANS)		8	8				8	8		48 / 216 THRU 53 / 216	
517	73501	3899	3899	FT	RAILING, PIPE, AS PER PLAN				1957					1942	133 / 216	
518	12500	51	51	EACH	SCUPPER, MISC.: 72" X 15" SCUPPER WITH NONSHRINK NONMETALLIC GROUT				30					21		
518	12701	51	51	EACH	SCUPPER, VERTICAL EXTENSION, AS PER PLAN				30					21	115 / 216 AND 116 / 216	
518	21200	439	439	CY	POROUS BACKFILL WITH GEOTEXTILE FABRIC	127	129				95	88				
518	4000	423	423	FT	6" PERFORATED CORRUGATED PLASTIC PIPE	128	116				105	74				
518	40011	10	10	FT	6" NON-PERFORATED CORRUGATED PLASTIC PIPE, INCLUDING SPECIALS, AS PER PLAN		10								26 / 216	
518	51101	845	845	FT	8" PIPE DOWNSPOUT, INCLUDING SPECIALS, AS PER PLAN			220	370				85	170	115 / 216 AND 116 / 216	
518	51201	60	60	FT	PIPE DOWNSPOUT, INCLUDING SPECIALS, AS PER PLAN, 12"			60							115 / 216 AND 116 / 216	
524	94935	78	78	FT	DRILLED SHAFTS, 66" DIAMETER, INTO BEDROCK, AS PER PLAN			42					36		14 / 216 AND 116 / 216	
524	94951	42	42	FT	DRILLED SHAFTS, 72" DIAMETER, INTO BEDROCK, AS PER PLAN			24					18		14 / 216 AND 116 / 216	
524	94981	93	93	FT	DRILLED SHAFTS, 78" DIAMETER, INTO BEDROCK, AS PER PLAN			48					45		14 / 216 AND 116 / 216	
524	94947	1624	1624	FT	DRILLED SHAFTS, 66" DIAMETER, ABOVE BEDROCK, AS PER PLAN			875					749		14 / 216 AND 116 / 216	
524	94971	854	854	FT	DRILLED SHAFTS, 72" DIAMETER, ABOVE BEDROCK, AS PER PLAN			488					366		14 / 216 AND 116 / 216	
524	94991	1884	1884	FT	DRILLED SHAFTS, 78" DIAMETER, ABOVE BEDROCK, AS PER PLAN			972					912		14 / 216 AND 116 / 216	
SPECIAL	53000200	LS	LS		STRUCTURES : SPECIAL BRIDGE ACCESS LT.					LS					14 / 216	
SPECIAL	53000200	LS	LS		STRUCTURES : SPECIAL BRIDGE ACCESS RT.									LS	14 / 216	
526	30001	1228	1228	SY	REINFORCED CONCRETE APPROACH SLABS (T=17"), AS PER PLAN					712				516	193 / 216	
526	90030	374	374	FT	TYPE C INSTALLATION	131	88				80	75				
601	20000	4929	4929	SY	CRUSHED AGGREGATE SLOPE PROTECTION	1712	641				2039	537				
601	21000	47	47	SY	CONCRETE SLOPE PROTECTION	24					23					
601	32204	1047	1047	CY	ROCK CHANNEL PROTECTION, TYPE C WITH GEOTEXTILE FABRIC	266	204				363	214				
SPECIAL	69098400	LS	LS		PRE AND POST CONSTRUCTION RIVER BOTTOM SURVEYS					LS				LS	14 / 216	


11/23/2020 JANSSEN & SPAANS ENGINEERING INC. - REVISED REINFORCING OVER PIERS.  
 5/1/2020 JANSSEN & SPAANS ENGINEERING INC. - RECONFIGURED NORTHBOUND ON RAMP

DESIGN AGENCY: AECOM  
 564 WHITE POND DRIVE  
 AKRON, OHIO 44320-1100  
 (330) 836-9111


ESTIMATED QUANTITIES  
 BRIDGE NO. LUC-75-0029 L/R  
 I.R. 75 OVER MAUMEE RIVER

W00/LUC-75-30.70/0.00  
 PID No. 93592  
 16 / 216  
 1309 / 1792

Date: Oct 07, 2020, 5:11pm User Name: mlongtin  
 File: P:\1321 - Toledo E Value Engineering\DWGS\BRIDGE\LUC-75-0027 over Maumee River\Sheets\027C\_0027C\_FP004.dwg

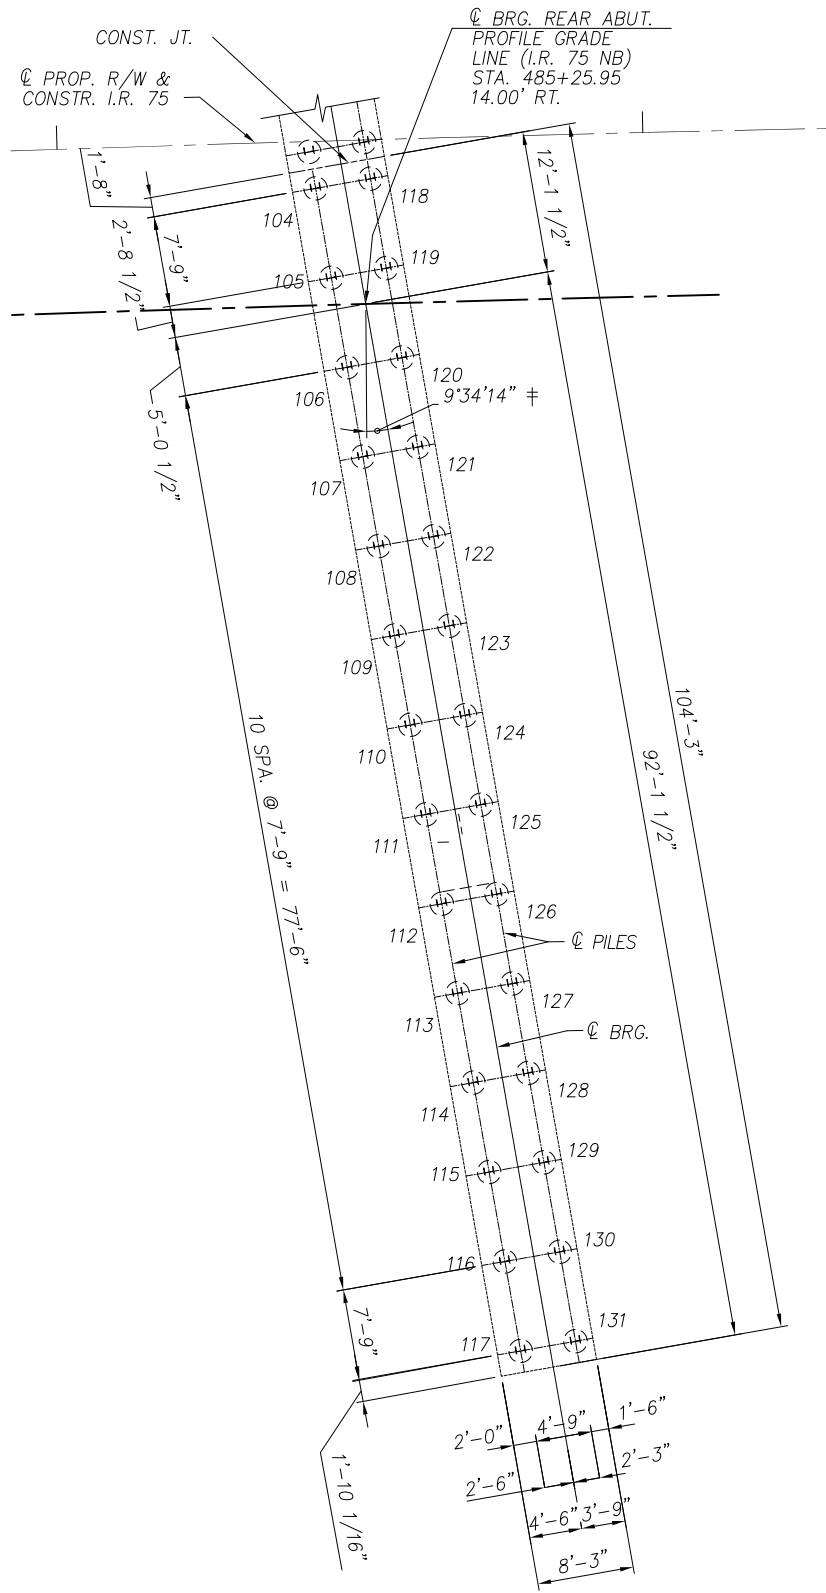

**PLAN**  
(REAR ABUTMENT)

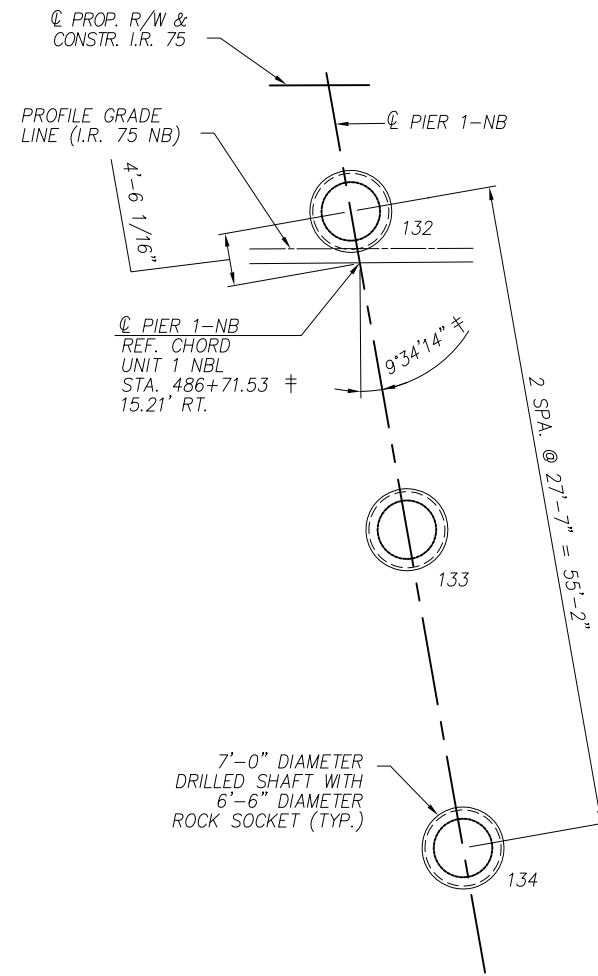

**PLAN**  
(PIER 1-NB)

**NOTES:**

1. FOR FOUNDATION PLAN NOTES, LEGEND AND TABLES, SEE SHEET 17/216.



3 5/1/2020 JANSSEN & SPAANS ENGINEERING INC. - RECONFIGURED NORTHBOUND ON RAMP, SHEET REPLACED



DESIGNED	WJZ	CHECKED	CBS
DRAWN	REM	REVISD	
REVIEWED	WJZ	DATE	5/2/2020
STRUCTURE FILE NUMBER	4802765/4802767		

DESIGN AGENCY  
**JANSSEN & SPAANS ENGINEERING, INC.**  
 9120 HARRISON PARK COURT  
 INDIANAPOLIS, IN 46216

FOUNDATION PLAN - NORTHBOUND  
 BRIDGE NO. LUC-75-0029 L/R  
 I.R. 75 OVER MAUMEE RIVER

W00/LUC-75-  
 30.70/0.00  
 PID No. 93592

Date: Oct 07, 2020, 5:11pm User Name: mlongtin  
 File: P:\1321 - Toledo E Value Engineering\DWG\BRIDGE\LUC-75-0027 over Maumee River\Sheets\027C\_0027C\_FR005.dwg

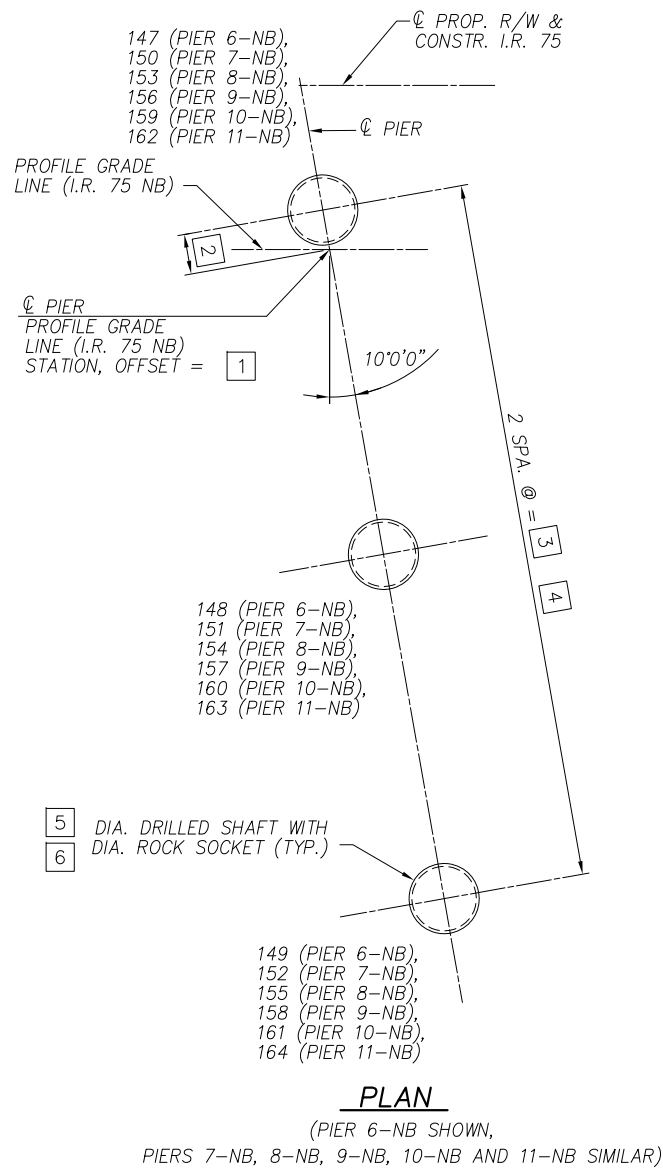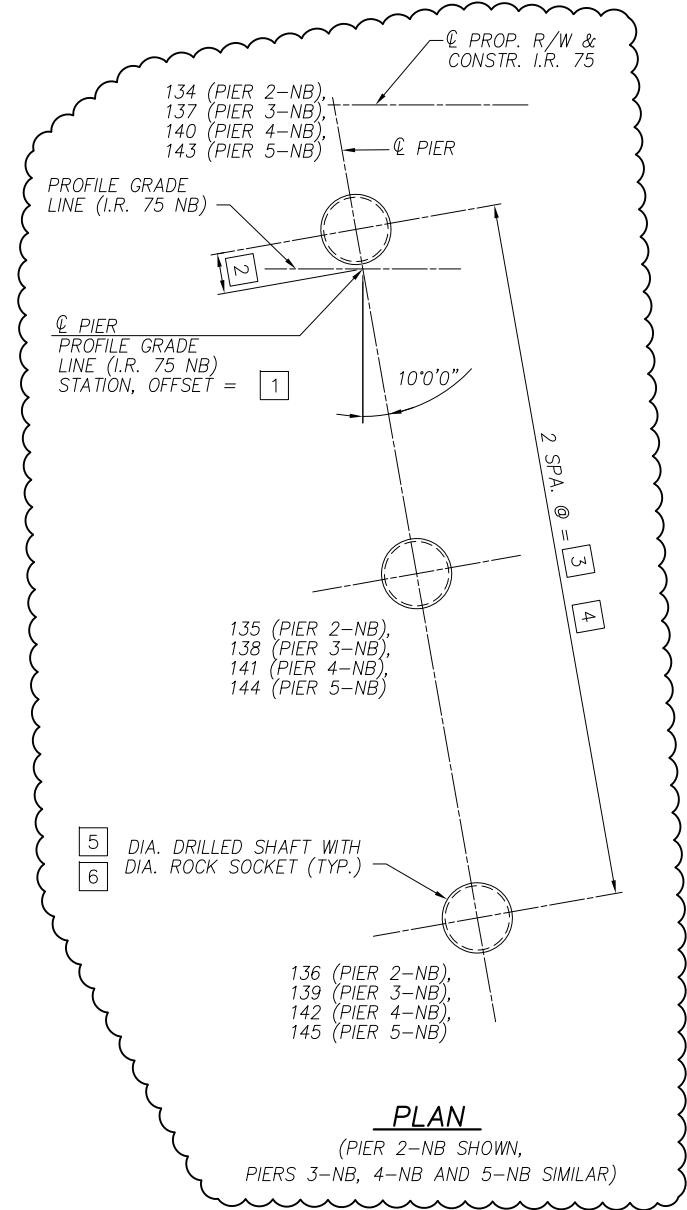

LOCATION	1		2	3	4	5	6
	STATION	OFFSET					
PIER 2-NB	488+37.36	14.00' RT.	3'-3 1/16"	27'-7"	55'-2"	6'-0"	5'-6"
PIER 3-NB	490+03.36	14.00' RT.	3'-3 1/16"	27'-7"	55'-2"	6'-6"	6'-0"
PIER 4-NB	491+69.36	14.00' RT.	3'-3 1/16"	27'-7"	55'-2"	6'-6"	6'-0"
PIER 5-NB	493+35.36	14.00' RT.	3'-3 1/16"	27'-7"	55'-2"	7'-0"	6'-6"
PIER 6-NB	495+01.36	14.00' RT.	3'-3 1/16"	27'-7"	55'-2"	6'-0"	5'-6"
PIER 7-NB	496+67.36	14.00' RT.	3'-3 1/16"	27'-7"	55'-2"	6'-0"	5'-6"
PIER 8-NB	498+33.36	14.00' RT.	3'-3 1/16"	27'-7"	55'-2"	7'-0"	6'-6"
PIER 9-NB	499+99.36	14.00' RT.	3'-3 1/16"	27'-7"	55'-2"	7'-0"	6'-6"
PIER 10-NB	501+65.36	14.00' RT.	3'-3 1/16"	27'-7"	55'-2"	7'-0"	6'-6"
PIER 11-NB	503+31.36	14.00' RT.	3'-3 1/16"	27'-7"	55'-2"	6'-0"	5'-6"

NOTES:  
 1. FOR FOUNDATION PLAN NOTES, LEGEND AND TABLES, SEE SHEET 17 / 216 .

2. SHAFT 146 NOT PRESENT.

3

5/1/2020 JANSSEN & SPAANS ENGINEERING INC.  
 - ADJUSTED PIERS 2 THRU 7

DESIGNED	MRW	CHECKED	CRG
DRAWN	CMA	REVISD	
REVIEWED	JTH	STRUCTURE FILE NUMBER	4802765/4802767
DATE	8/18		

DESIGN AGENCY  
**AECOM**  
 564 WHITE POND DRIVE  
 AKRON, OHIO 44320-1100  
 (330) 836-9111


FRAMING PLAN - 4 OF 6  
 BRIDGE NO. LUC-75-0029 L/R  
 I.R. 75 OVER MAUMEE RIVER

WOO/LUC-75-  
 30.70/0.00  
 PID No. 93592


21 / 216

1314  
 1792

Date: Oct 07, 2020, 5:10pm User Name: mlongtin  
File: P:\1321 - Toledo E Value Engineering\DWGS\BRIDGE\LUC-75-0027 over Maumee River\Sheets\075\_0027C\_AR002.DWG

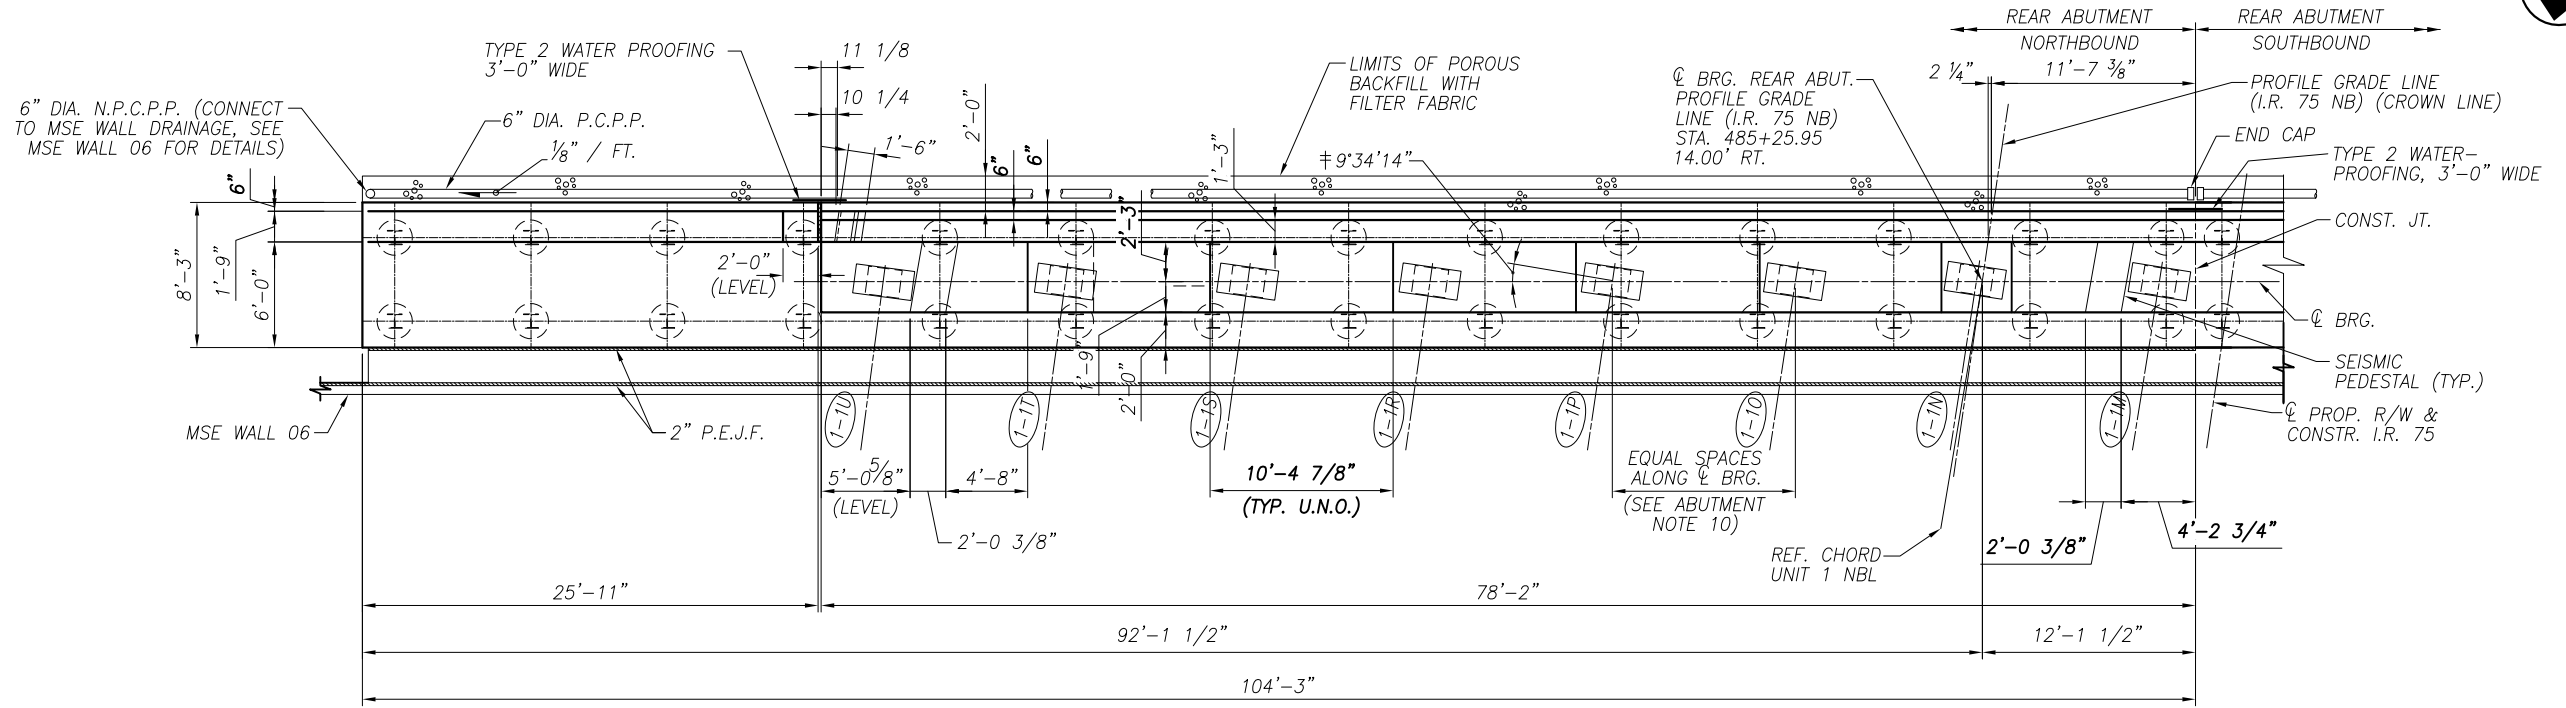

**PLAN**

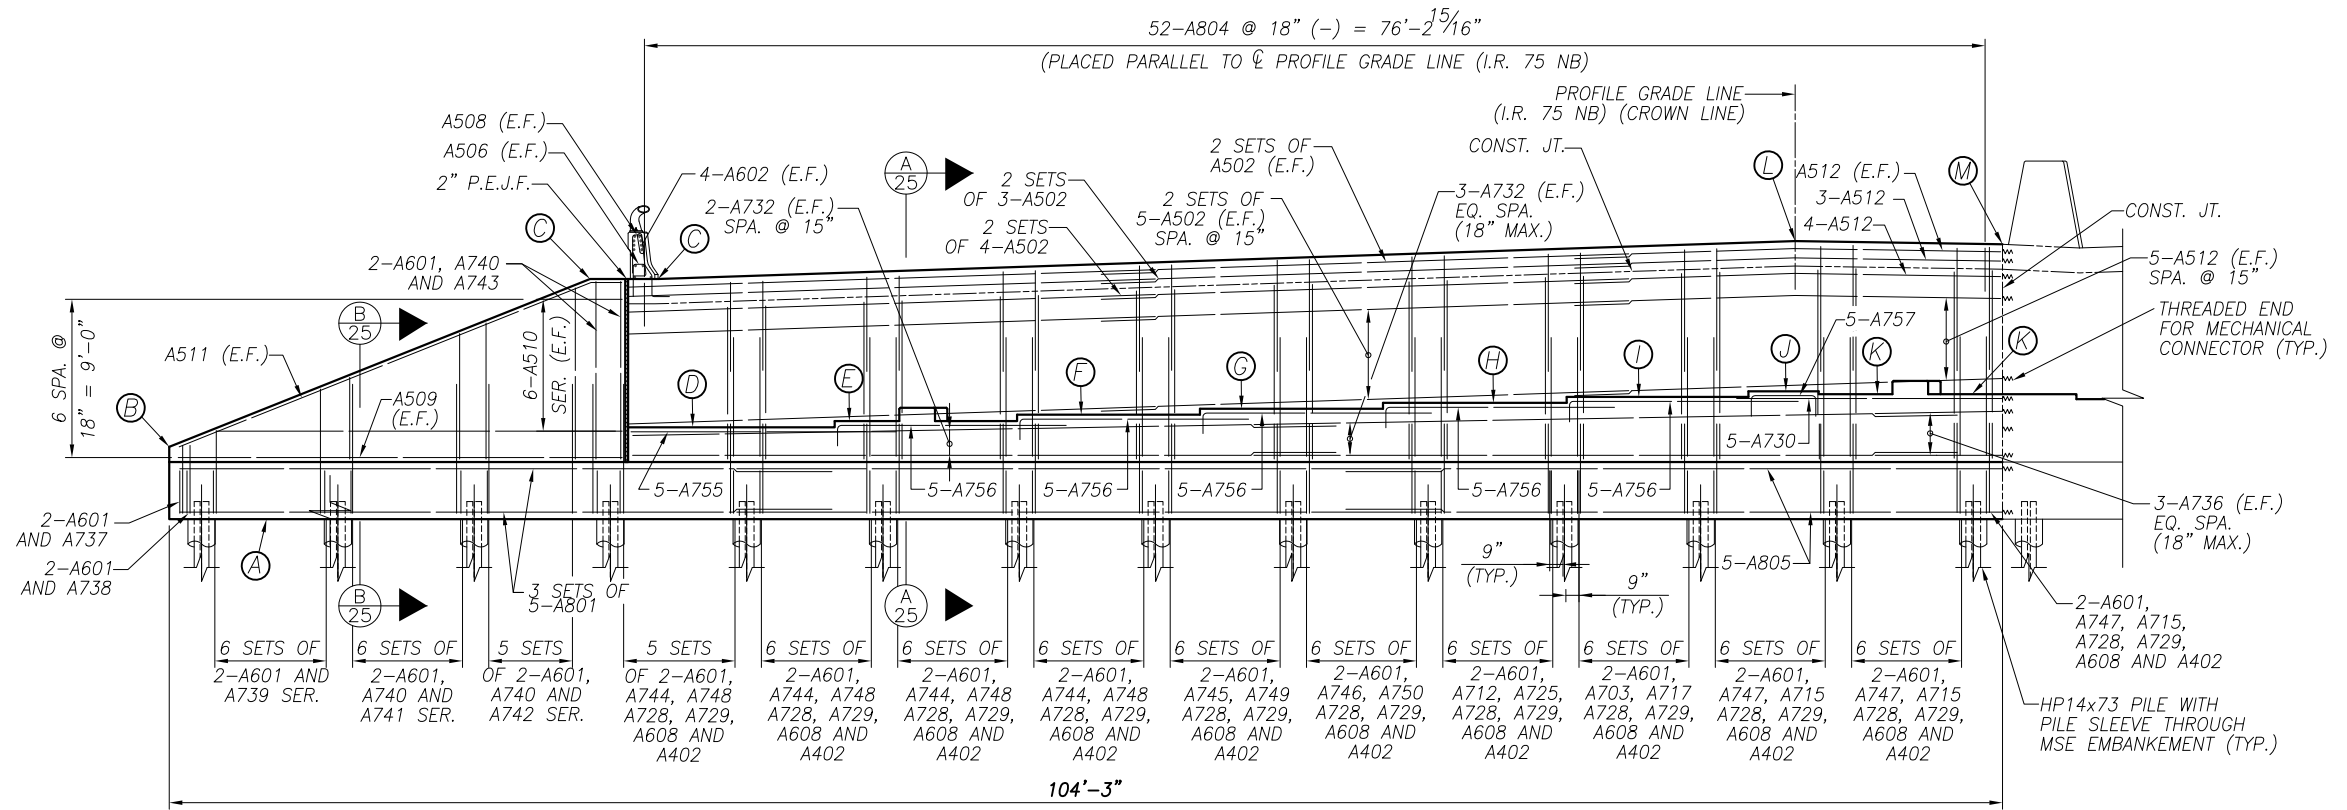

**ELEVATION**

		ELEVATION MARK												
		(A)	(B)	(C)	(D)	(E)	(F)	(G)	(H)	(I)	(J)	(K)	(L)	(M)
ELEVATION		617.75	622.00	631.55	622.90	623.24	623.58	623.93	624.27	624.94	624.95	624.81	633.55	633.37

**NOTES:**

1. FOR ABUTMENT NOTES AND LEGEND, SEE SHEET 25/216.



3/ 5/1/2020 JANSSEN & SPAANS ENGINEERING INC. - RECONFIGURED NORTHBOUND ON RAMP, SHEET REPLACED


DESIGNED	WJZ	WJZ	REVIEWED	WJZ	DATE	5/2020
CHECKED	CBS	REVISION	FILE NUMBER	4802765/4802767	DESIGN AGENCY	JANSSEN & SPAANS ENGINEERING, INC. 9120 HARRISON PARK COURT INDIANAPOLIS, IN 46216

REAR ABUTMENT DETAILS - NORTHBOUND  
BRIDGE NO. LUC-75-0029 L/R  
I.R. 75 OVER MAUMEE RIVER

W00/LUC-75-0029/0.00  
PID No. 93592


1317  
1792

Date: Oct 08, 2020, 4:28pm User Name: mlongtin  
File: P:\11321 - Toledo E Value Engineering\DWG\BRIDGE\LUC-75-0027 over Maumee River\Sheets\075\_0027C\_P1012.dwg

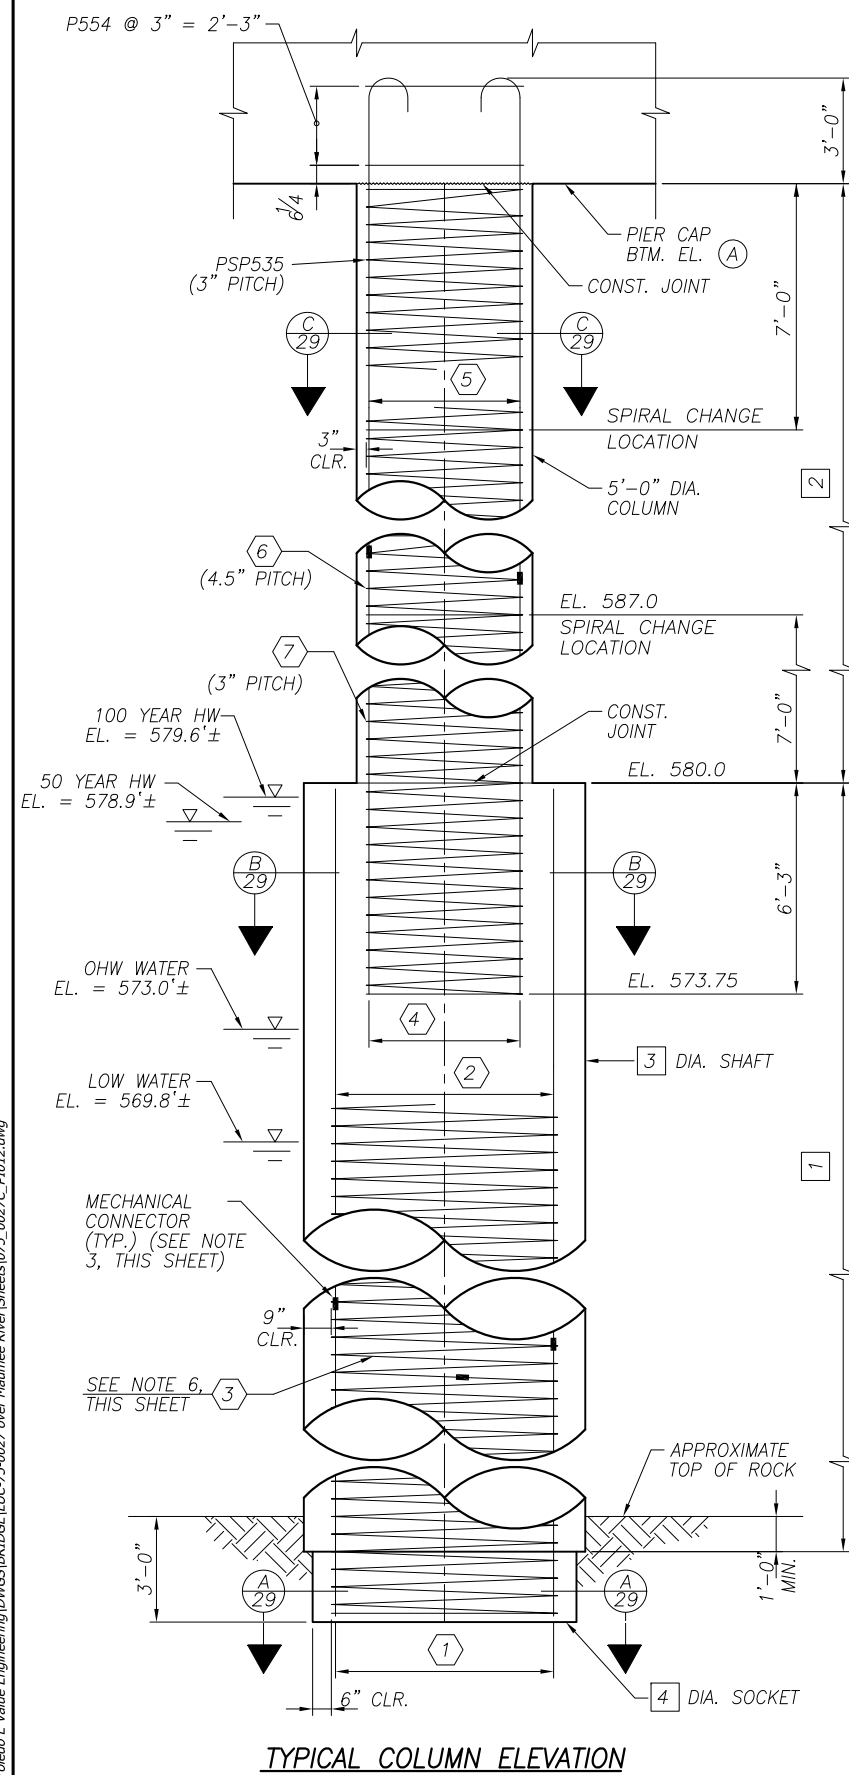

TYPICAL COLUMN ELEVATION

PIER NO.	NO. OF SHAFTS PER PIER	ELEVATION MARK (A)	DIMENSION MARK				REINFORCING MARK						
			1	2	3	4	1	2	3	4	5	6	7
1-NB	3	613.57	60.50'	33.57'	7'-0"	6'-6"	22-DS1103/22-DS1104	22-DS1101/22-DS1102	2-DSSP601	14-DS1001/14-DS1002	14-P1058/14-P1059	PSP412	DSSP501
1-SB	4	614.68	60.50'	34.68'	7'-0"	6'-6"	22-DS1103/22-DS1104	22-DS1101/22-DS1102	2-DSSP601	14-DS1001/14-DS1002	14-P1040/14-P1041	PSP401	DSSP501
2-NB	3	613.73	63.00'	33.73'	6'-0"	5'-6"	20-DS1105/20-DS1106	20-DS1101/20-DS1102	2-DSSP602	14-DS1001/14-DS1002	14-P1060/14-P1061	PSP413	DSSP501
2-SB	4	613.71	63.00'	33.71'	6'-0"	5'-6"	20-DS1105/20-DS1106	20-DS1101/20-DS1102	2-DSSP602	11-DS1001/11-DS1002	11-P1042/11-P1043	PSP402	DSSP502
3-NB	3	612.24	62.50'	32.24'	6'-6"	6'-0"	23-DS1107/23-DS1103	23-DS1101/23-DS1102	2-DSSP603	14-DS1001/14-DS1002	14-P1062/14-P1063	PSP414	DSSP501
3-SB	4	613.03	62.50'	33.03'	6'-6"	6'-0"	23-DS1107/23-DS1103	23-DS1101/23-DS1102	2-DSSP603	14-DS1001/14-DS1002	14-P1044/14-P1045	PSP403	DSSP501
4-NB	3	612.80	61.50'	32.80'	6'-6"	6'-0"	23-DS1108/23-DS1109	23-DS1101/23-DS1102	2-DSSP604	14-DS1001/14-DS1002	14-P1062/14-P1063	PSP414	DSSP501
4-SB	4	612.91	61.50'	32.91'	6'-6"	6'-0"	23-DS1108/23-DS1109	23-DS1101/23-DS1102	2-DSSP604	14-DS1001/14-DS1002	14-P1046/14-P1047	PSP404	DSSP501
5-NB	3	612.31	60.10'	32.31'	7'-0"	6'-6"	22-DS1110/22-DS1111	22-DS1101/22-DS1102	2-DSSP605	14-DS1001/14-DS1002	14-P1032/14-P1035	PSP415	DSSP501
5-SB	3	612.50	60.10'	32.50'	7'-0"	6'-6"	22-DS1110/22-DS1111	22-DS1101/22-DS1102	2-DSSP605	15-DS1001/15-DS1002	15-P1032/15-P1035	PSP405	DSSP501
6-NB	3	611.76	63.40'	31.76'	6'-0"	5'-6"	20-DS1112/20-DS1113	20-DS1101/20-DS1102	2-DSSP606	14-DS1001/14-DS1002	14-P1064/14-P1065	PSP416	DSSP501
6-SB	3	611.77	63.40'	31.77'	6'-0"	5'-6"	20-DS1112/20-DS1113	20-DS1101/20-DS1102	2-DSSP606	11-DS1001/11-DS1002	11-P1048/11-P1049	PSP406	DSSP502
7-NB	3	611.33	62.20'	31.33'	6'-0"	5'-6"	20-DS1114/20-DS1115	20-DS1101/20-DS1102	2-DSSP607	11-DS1001/11-DS1002	11-P1066/11-P1067	PSP407	DSSP502
7-SB	3	611.41	62.20'	31.41'	6'-0"	5'-6"	20-DS1114/20-DS1115	20-DS1101/20-DS1102	2-DSSP607	11-DS1001/11-DS1002	11-P1050/11-P1051	PSP407	DSSP502
8-NB	3	610.91	61.40'	30.91'	7'-0"	6'-6"	22-DS1113/22-DS1112	22-DS1101/22-DS1102	2-DSSP608	14-DS1001/14-DS1002	14-P1068/14-P1069	PSP417	DSSP501
8-SB	3	610.97	61.40'	30.97'	7'-0"	6'-6"	22-DS1113/22-DS1112	22-DS1101/22-DS1102	2-DSSP608	14-DS1001/14-DS1002	14-P1052/14-P1053	PSP408	DSSP501
9-NB	3	610.40	61.70'	30.40'	7'-0"	6'-6"	22-DS1116/22-DS1117	22-DS1101/22-DS1102	2-DSSP609	14-DS1001/14-DS1002	14-P1054/14-P1055	PSP409	DSSP501
9-SB	3	610.40	61.70'	30.40'	7'-0"	6'-6"	22-DS1116/22-DS1117	22-DS1101/22-DS1102	2-DSSP609	14-DS1001/14-DS1002	14-P1054/14-P1055	PSP409	DSSP501
10-NB	3	609.90	65.20'	29.90'	7'-0"	6'-6"	22-DS1118/22-DS1119	22-DS1101/22-DS1102	2-DSSP610	14-DS1001/14-DS1002	14-P1070/14-P1071	PSP418	DSSP501
10-SB	3	609.88	65.20'	29.88'	7'-0"	6'-6"	22-DS1118/22-DS1119	22-DS1101/22-DS1102	2-DSSP610	15-DS1001/15-DS1002	15-P1038/15-P1039	PSP410	DSSP501
11-NB	3	609.36	64.90'	29.36'	6'-0"	5'-6"	20-DS1120/20-DS1121	20-DS1101/20-DS1102	2-DSSP611	11-DS1001/11-DS1002	11-P1072/11-P1073	PSP419	DSSP502
11-SB	4	609.34	64.90'	29.34'	6'-0"	5'-6"	20-DS1120/20-DS1121	20-DS1101/20-DS1102	2-DSSP611	11-DS1001/11-DS1002	11-P1056/11-P1057	PSP411	DSSP502

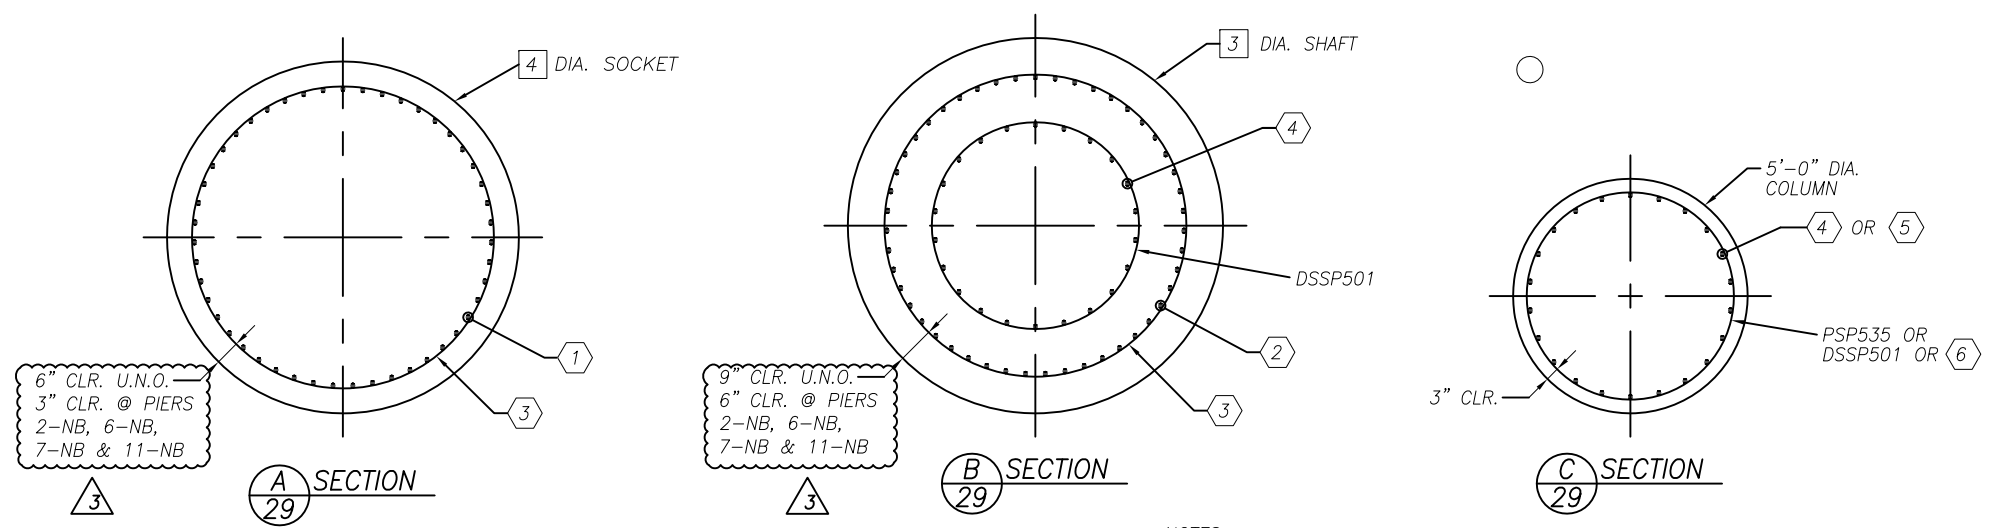

- NOTES:
- FOR PIER ELEVATIONS AND DETAILS, SEE SHEETS 30/216 THRU 47/216.
  - FOR REINFORCING STEEL LISTS, SEE SHEETS 213/216 THRU 214/216.
  - MECHANICAL CONNECTORS PER ODOT CMS 509.07 SHALL BE USED FOR VERTICAL AND SPIRAL BARS. VERTICAL BAR CONNECTORS SHALL BE STAGGERED AT A MINIMUM OF 2'-0".
  - DRILLED SHAFTS AND ROCK SOCKETS SHALL USE MASS CONCRETE CLASS QC5 WITH QC/QA, AS PER PLAN, AS DESCRIBED IN THE DESIGN DATA SECTION OF THE GENERAL NOTES AND ODOT CMS 511.
  - TABLE PROVIDES REINFORCING FOR ONE COLUMN AND DRILLED SHAFT.
  - FOR SPIRAL PITCH, SEE REINFORCING LIST ON SHEETS 213/216 AND 214/216.
  - THE PIER NUMBER AND BRIDGE LANE DIRECTION SHALL BE ADDED TO THE BEGINNING OF ALL BARMARKS. EXAMPLES:

- LEGEND:
- (A) ELEVATION MARK
  - # REINFORCING MARK
  - # DIMENSION MARK
- 3NB-DSSP501 NORTHBOUND PIER 3  
4SB-PSP401 SOUTHBOUND PIER 4

DESIGN AGENCY: AECOM (330) 636-9111  
564 WHITE POND DRIVE AKRON, OHIO 44320-1100

DESIGNED: MRW  
CHECKED: MRW  
DEB  
VFC

DRAWN: JTH  
VFC

REVIEWED: JTH  
STRUCTURE FILE NUMBER: 4802765/4802767

DATE: 8/18

REVISION TABLE INFORMATION

5/1/2020 JANSSEN & SPAANS ENGINEERING INC. - REVISED


PIER - COLUMN DETAILS  
BRIDGE NO. LUC-75-0029 L/R  
I.R. 75 OVER MAUMEE RIVER

W00/LUC-75-30.70/0.00  
PID No. 93592


29/216  
1322  
1792




Date: Oct 08, 2020, 4:29pm User Name: mlongin File: P:\1121 - Toledo E Value Engineering\DWG\BRIDGE\LUC-75-0027 over Maumee River\Sheets\075\_0027C\_P1003.dwg

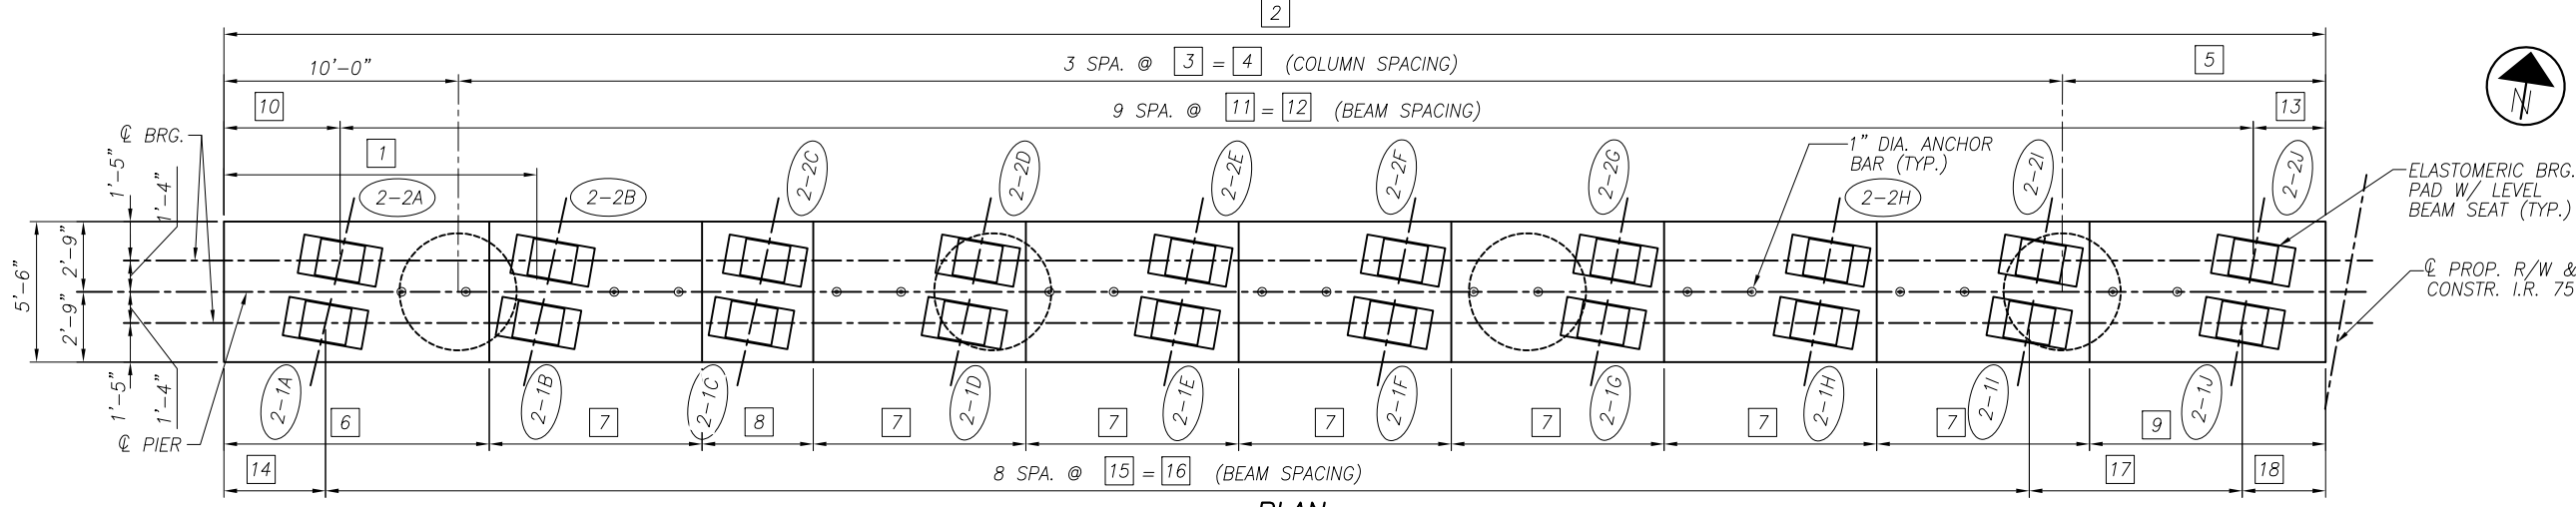

**PLAN**  
(PIER 3-SB SHOWN, PIER 4-SB SIMILAR)

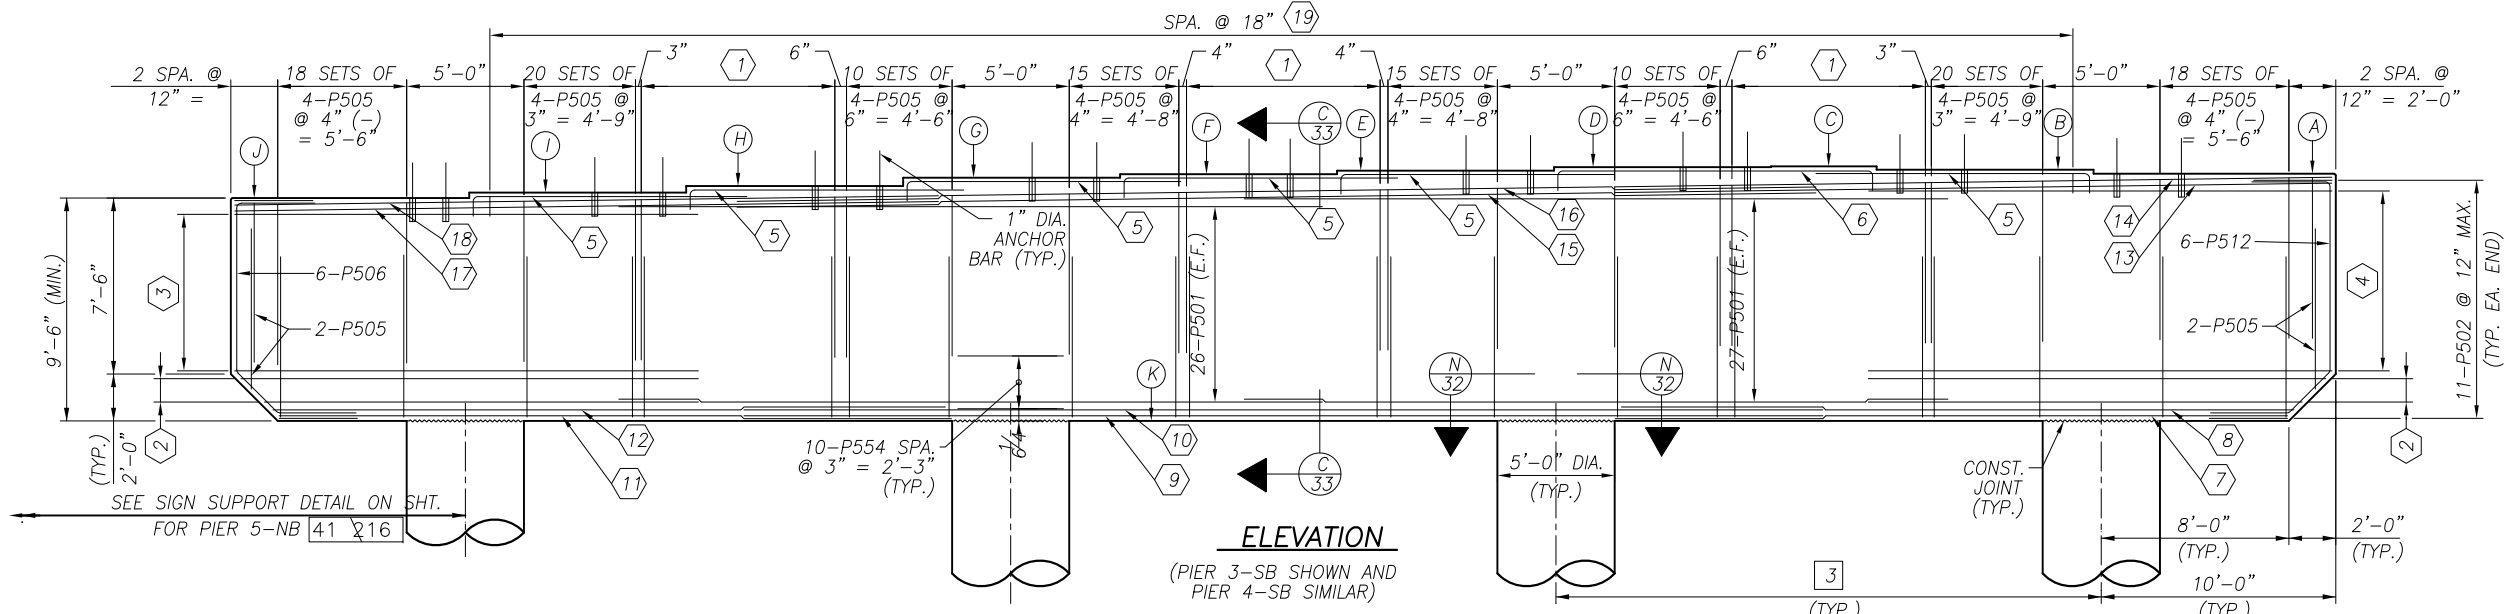

**ELEVATION**  
(PIER 3-SB SHOWN AND PIER 4-SB SIMILAR)

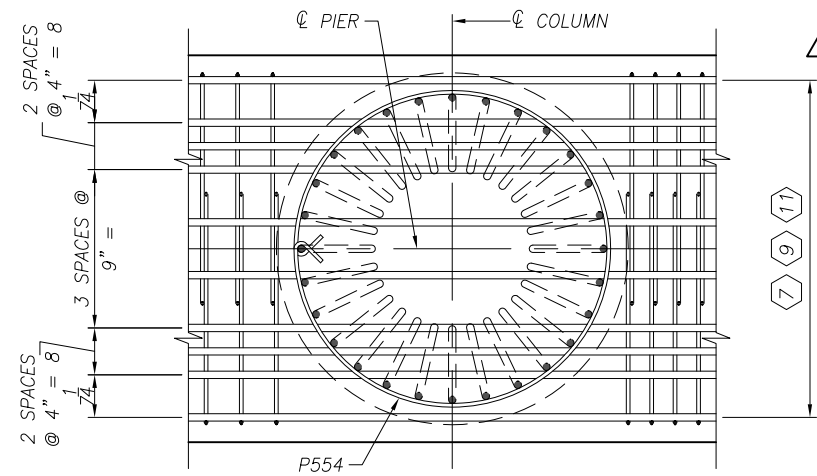

**SECTION**  
(PIER 3-NB SHOWN, PIERS 3-SB, 4-NB AND 4-SB SIMILAR. SEE SECTION 'X' ON SHT. 41/216 FOR PIER 5-NB)

- LEGEND:**
- ELEVATION MARK
  - # DIMENSION MARK
  - ⬡ REINFORCING MARK
- NOTE:**
- FOR PIER NOTES, SEE SHEET 30/216.





PIER	STATION	OFFSET	ELEVATION MARK										
			(A)	(B)	(C)	(D)	(E)	(F)	(G)	(H)	(I)	(J)	(K)
3-SB	489+98.43	14.00' LT.	623.11	623.28	623.43	623.38	623.17	622.98	622.85	622.71	622.58	622.38	612.88
4-SB	491+64.43	14.00' LT.	622.68	622.83	622.96	623.02	622.90	622.77	622.65	622.52	622.40	622.26	612.76

PIER	DIMENSION MARK																	
	1	2	3	4	5	6	7	8	9	10	11	12	13	14	15	16	17	18
3-SB	13'-4 <sup>3</sup> / <sub>16</sub> "	88'-6"	22'-10"	68'-6"	10'-0"	10'-1"	9'-1"	4'-9"	10'-1"	3'-1 <sup>1</sup> / <sub>8</sub> "	9'-0 <sup>5</sup> / <sub>16</sub> "	81'-8 <sup>1</sup> / <sub>16</sub> "	3'-8 <sup>1</sup> / <sub>2</sub> "	3'-8 <sup>1</sup> / <sub>16</sub> "	9'-1 <sup>1</sup> / <sub>8</sub> " (+)	72'-9 <sup>1</sup> / <sub>8</sub> "	9'-1 <sup>1</sup> / <sub>8</sub> " (+)	3'-1 <sup>1</sup> / <sub>8</sub> "
4-SB	13'-4 <sup>1</sup> / <sub>4</sub> "	80'-6"	20'-2"	60'-6"	10'-0"	9'-4"	8'-2"	4'-9"	9'-3"	3'-1 <sup>1</sup> / <sub>8</sub> "	8'-2 <sup>5</sup> / <sub>16</sub> "	73'-8 <sup>3</sup> / <sub>16</sub> "	3'-8 <sup>1</sup> / <sub>16</sub> "	3'-6 <sup>3</sup> / <sub>4</sub> "	8'-2 <sup>1</sup> / <sub>16</sub> " (+)	65'-7 <sup>1</sup> / <sub>16</sub> "	8'-2 <sup>1</sup> / <sub>16</sub> " (+)	3'-1 <sup>1</sup> / <sub>8</sub> "

PIER	REINFORCING MARK																		
	1	2	3	4	5	6	7	8	9	10	11	12	13	14	15	16	17	18	19
3-SB	7 SETS OF 4-P505 @ 15 <sup>1</sup> / <sub>4</sub> " (-) = 7'-10"	4-P514 SER. (E.F.)	21-P513 (E.F.)	23-P513 (E.F.)	5-P565	5-P565	10-P1013	4-P1013	10-P1012	4-P1012	10-P1013	4-P1013	8-P1014	10-P1014	8-P1010	10-P1010	8-P1014	10-P1014	46-P558
4-SB	5 SETS OF 4-P505 @ 15 <sup>1</sup> / <sub>4</sub> " = 5'-2"	4-P516 SER. (E.F.)	21-P515 (E.F.)	22-P515 (E.F.)	5-P560	5-P567	10-P1017	4-P1017	10-P1018	4-P1018	10-P1017	4-P1017	8-P1011	10-P1011	8-P1010	10-P1010	8-P1011	10-P1011	42-P558

5/1/2020 JANSSEN & SPAANS ENGINEERING INC. -  
 MOVED NORTHBOUND PIERS TO SEPARATE SHEET  
 DESIGN AGENCY DATE 8/18  
 DRAWN TMR  
 CHECKED PJW  
 DESIGNED MRW  
 STRUCTURE FILE NUMBER 4802765/4802767  
 REVIEWED JTH  
 AECOM (330) 836-9111  
 584 WHITE POND DRIVE  
 AKRON, OHIO 44320-1100  
 WOO/LUC-75-  
 30.70/0.00  
 PID No. 93592  
 32/216  
 1325  
 1792

Date: Oct 12, 2020, 12:11pm User Name: mlongtin  
File: P:\1321 - Toledo E Value Engineering\DWG\SRDCE\LUC-75-0027 over Maumee River\Sheets\075\_0027C\_P1006.dwg

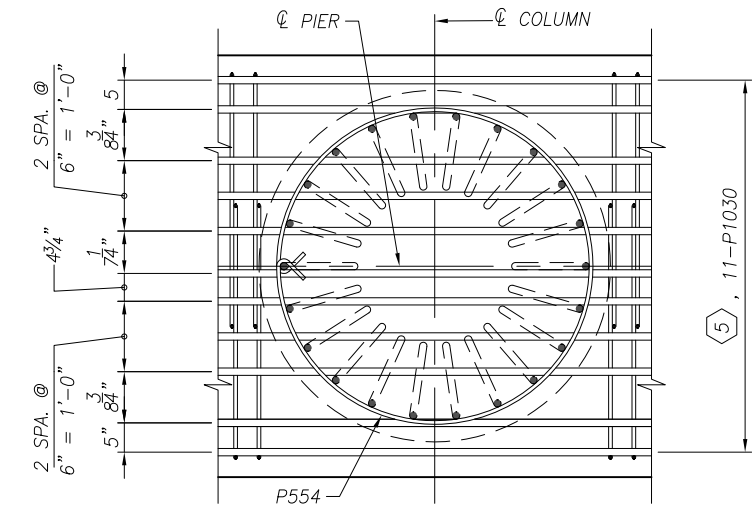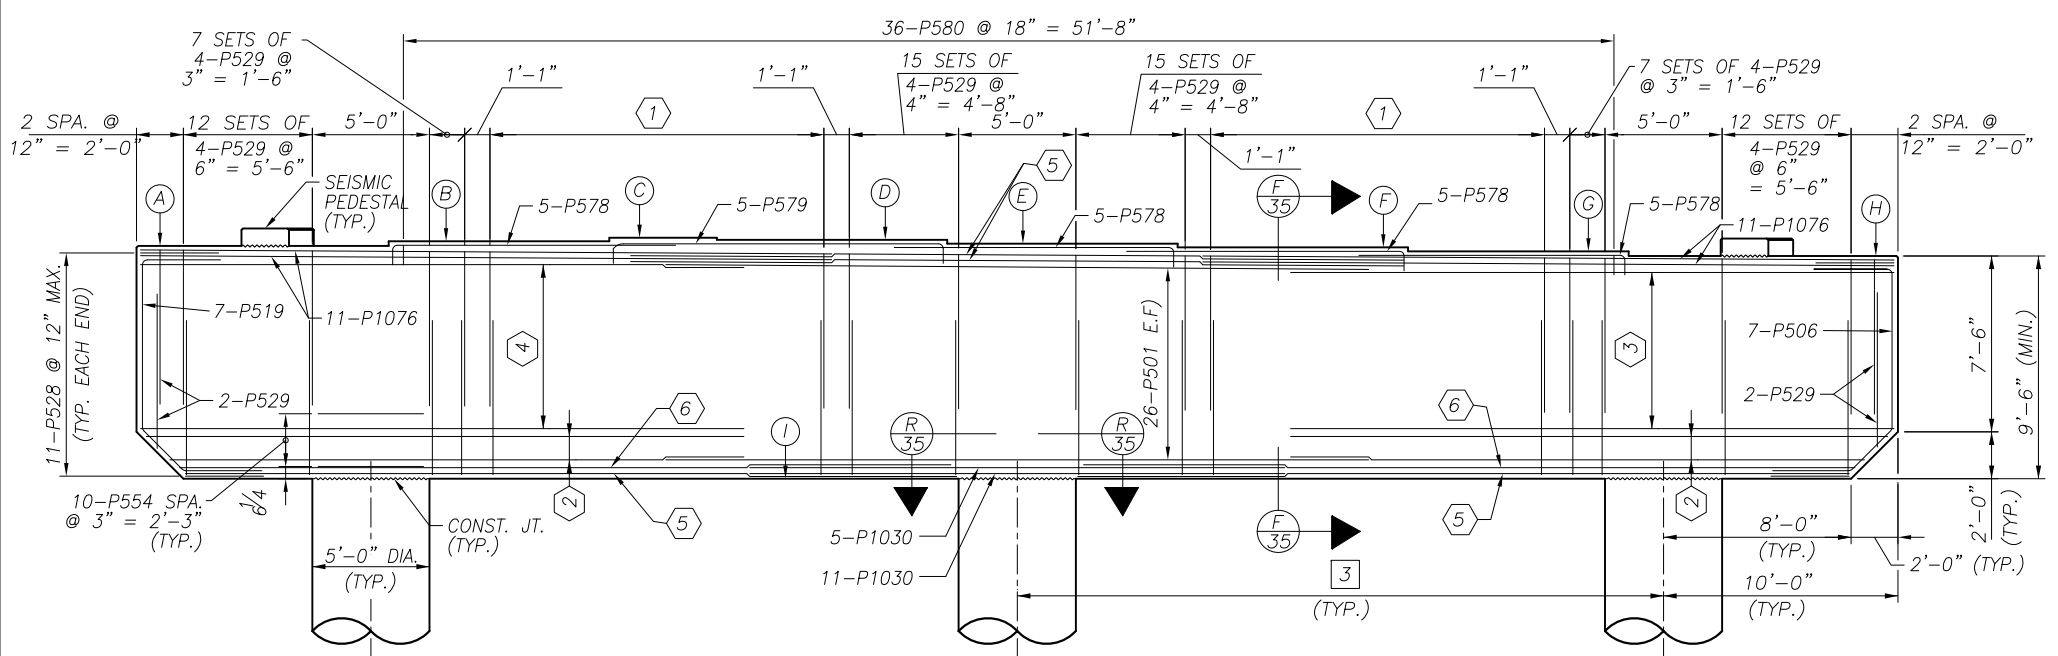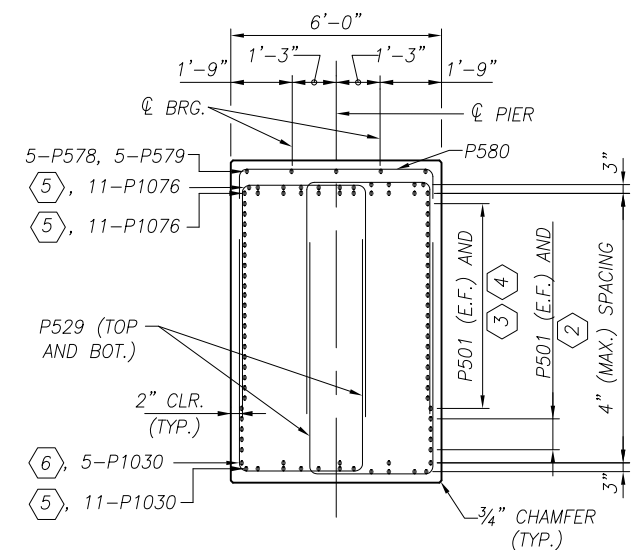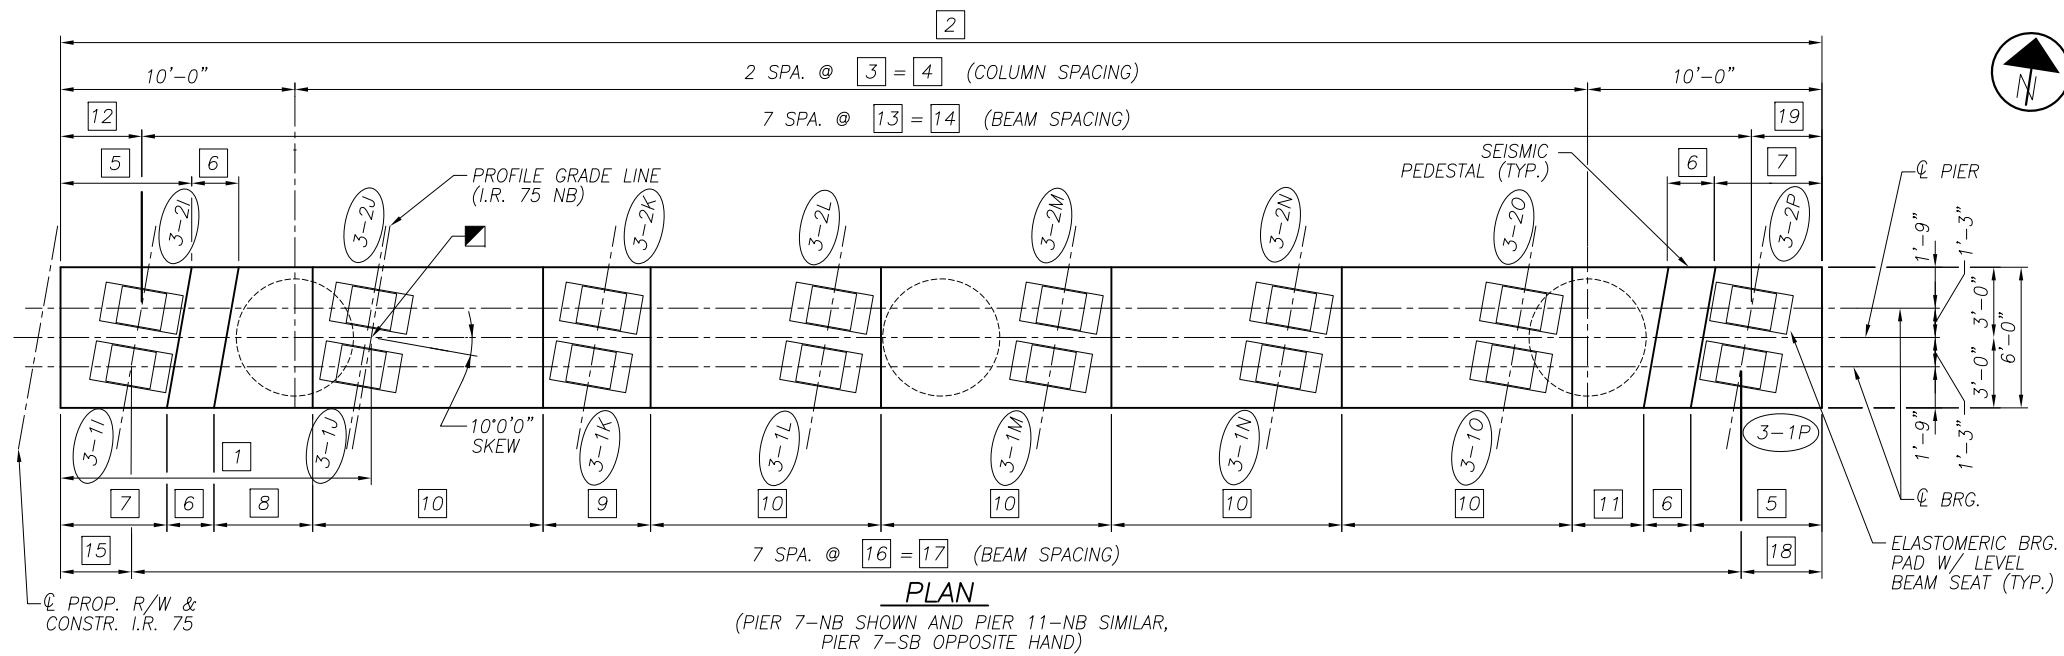

PIER	STATION	OFFSET
7-NB	496+67.36	14.00' RT.
7-SB	496+62.43	14.00' LT.
11-NB	503+31.36	14.00' RT.

PIER	REINFORCING MARK					
	①	②	③	④	⑤	⑥
7-NB	12 SETS OF 4-P529 @ 16" = 14'-8"	4-P552 SER. (E.F.)	21-P551 (E.F.)	22-P551 (E.F.)	11-P1029	5-P1029
7-SB	12 SETS OF 4-P529 @ 15 1/16" (-) = 14'-3"	4-P527 SER. (E.F.)	21-P526 (E.F.)	22-P526 (E.F.)	11-P1022	5-P1022
11-NB	12 SETS OF 4-P529 @ 15 1/16" (-) = 14'-3"	4-P534 SER. (E.F.)	21-P526 (E.F.)	22-P526 (E.F.)	11-P1022	5-P1022

**LEGEND:**

- ELEVATION MARK
- # DIMENSION MARK
- ⊕ REINFORCING MARK





**NOTE:**

1. FOR PIER NOTES, SEE SHEET 30/216.

PIER	ELEVATION MARK									DIMENSION MARK																		
	A	B	C	D	E	F	G	H	I	1	2	3	4	5	6	7	8	9	10	11	12	13	14	15	16	17	18	19
7-NB	621.27	621.46	621.61	621.52	621.36	621.20	621.03	620.83	611.33	13'-3 1/16"	75'-2"	27'-7"	55'-2"	5'-6 3/8"	2'-0 3/8"	4'-5 5/8"	4'-2 1/8"	4'-7"	9'-10"	3'-2"	3'-5 3/8"	9'-9 3/16" (-)	68'-8 1/2"	3'-0 1/16"	9'-9 3/16" (-)	68'-8 1/2"	3'-5 3/8"	3'-0 1/16"
7-SB	621.26	621.45	621.61	621.55	621.40	621.25	621.10	620.91	611.41	13'-3 1/16"	75'-2"	27'-7"	55'-2"	4'-8 1/2"	2'-0 3/8"	5'-6 1/8"	3'-1 5/8"	4'-7"	9'-10"	4'-3"	3'-0 1/16"	9'-9 3/16" (-)	68'-8 1/2"	3'-5 3/8"	9'-9 3/16" (-)	68'-8 1/2"	3'-0 1/16"	3'-5 3/8"
11-NB	619.28	619.47	619.62	619.54	619.38	619.22	619.06	618.86	609.36	13'-3 1/16"	75'-2"	27'-7"	55'-2"	5'-6 3/8"	2'-0 3/8"	4'-5 3/4"	4'-2 1/8"	4'-7"	9'-10"	3'-2"	3'-5 3/8"	9'-9 3/16" (-)	68'-8 1/2"	3'-0 1/16"	9'-9 3/16" (-)	68'-8 1/2"	3'-5 3/8"	3'-0 1/16"

DESIGN AGENCY: AECOM  
 DATE: 8/18  
 REVIEWED: JTH  
 DRAWN: TMR  
 DESIGNED: MRW  
 CHECKED: PJW  
 STRUCTURE FILE NUMBER: 4802765/4802767  
 5/1/2020 JANSSEN & SPANSEN ENGINEERING INC. - REVISED 7-NB BEAM SPACING  
 PIERS 7-SB, 7-NB, 11-NB - PLAN AND ELEVATION  
 BRIDGE NO. LUC-75-0029 L/R  
 I.R. 75 OVER MAUMEE RIVER  
 WOO/LUC-75-30.70/0.00  
 PID No. 93592  
 35 / 216  
 1328 / 1792

Date: Oct 07, 2020, 5:09pm User Name: mlongtin File: P:\1321 - Toledo E Value Engineering\DWG\SRDCE\LUC-75-0027 over Maumee River\Sheets\072\_0027C\_P1006-5.dwg

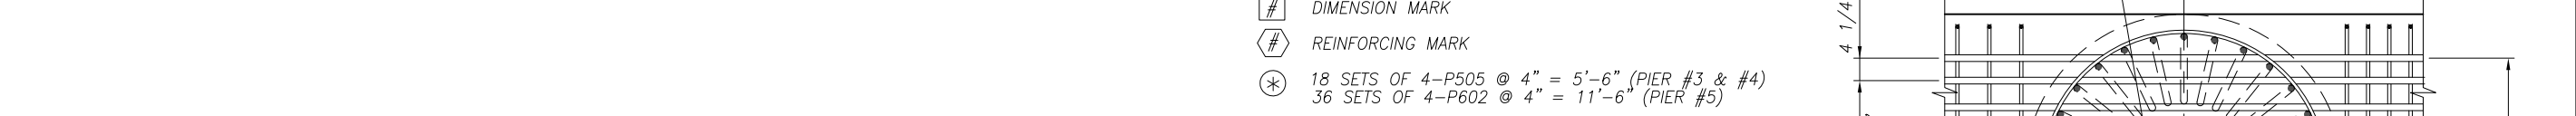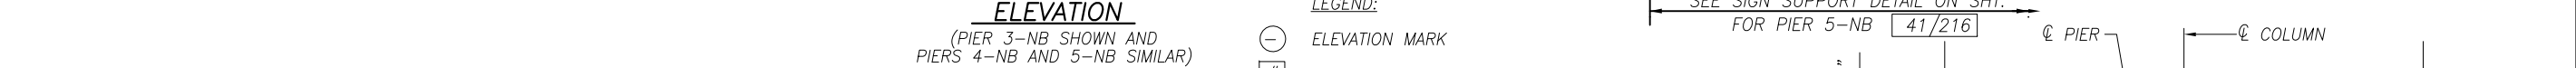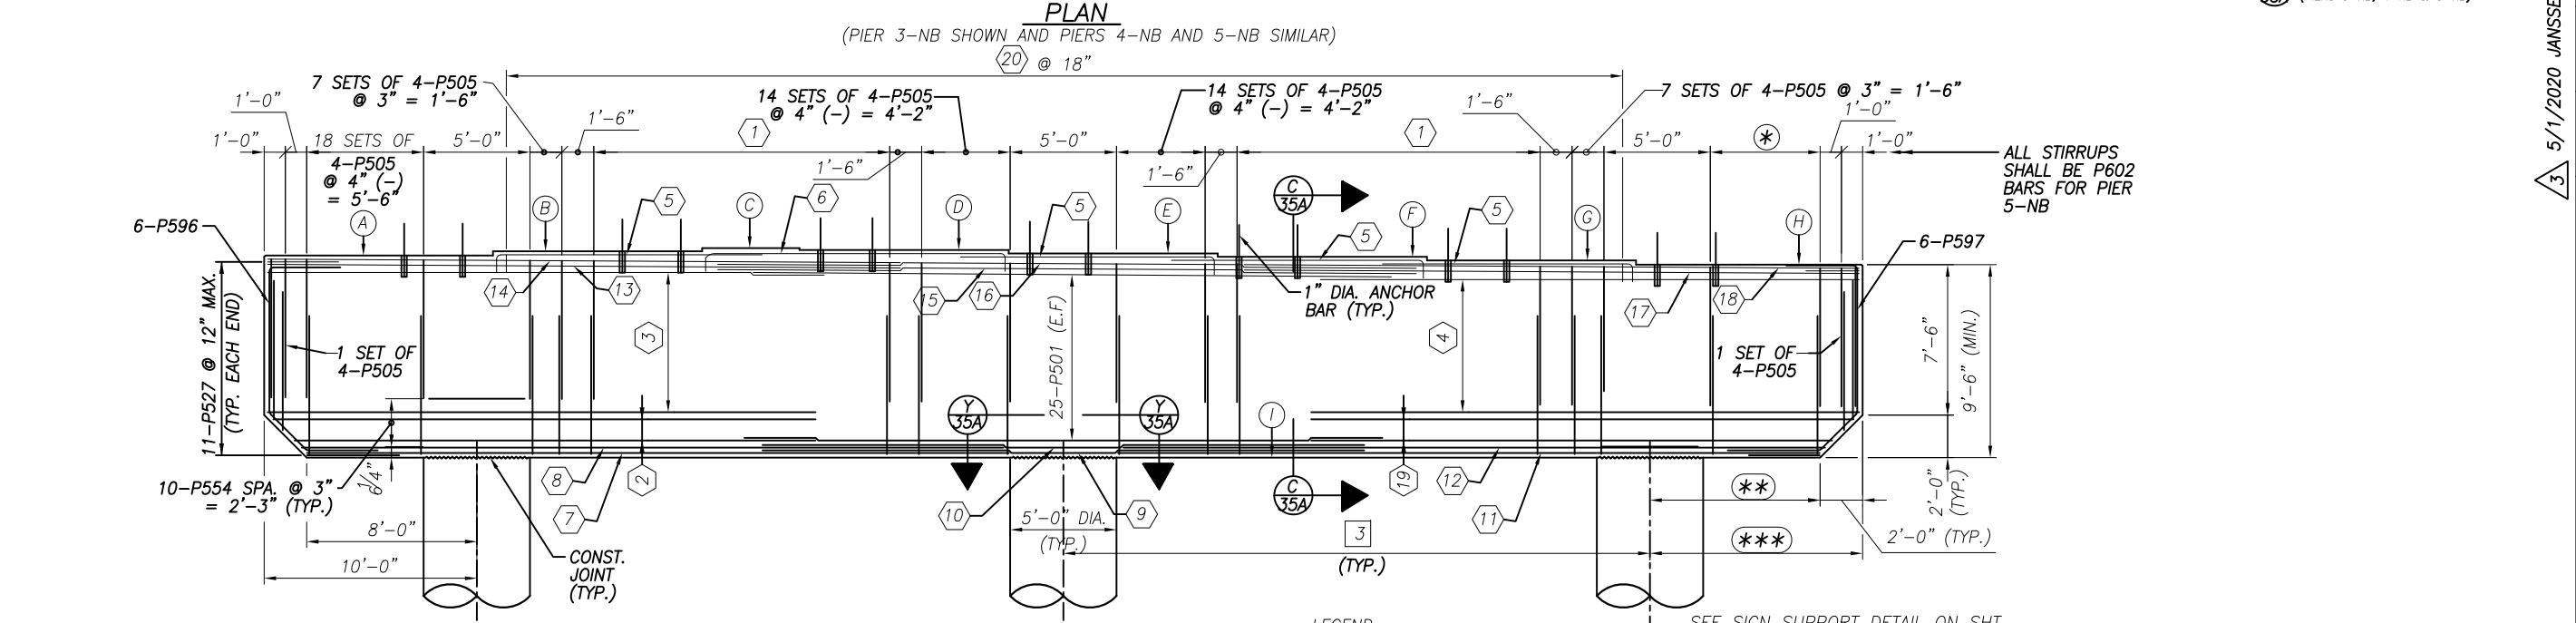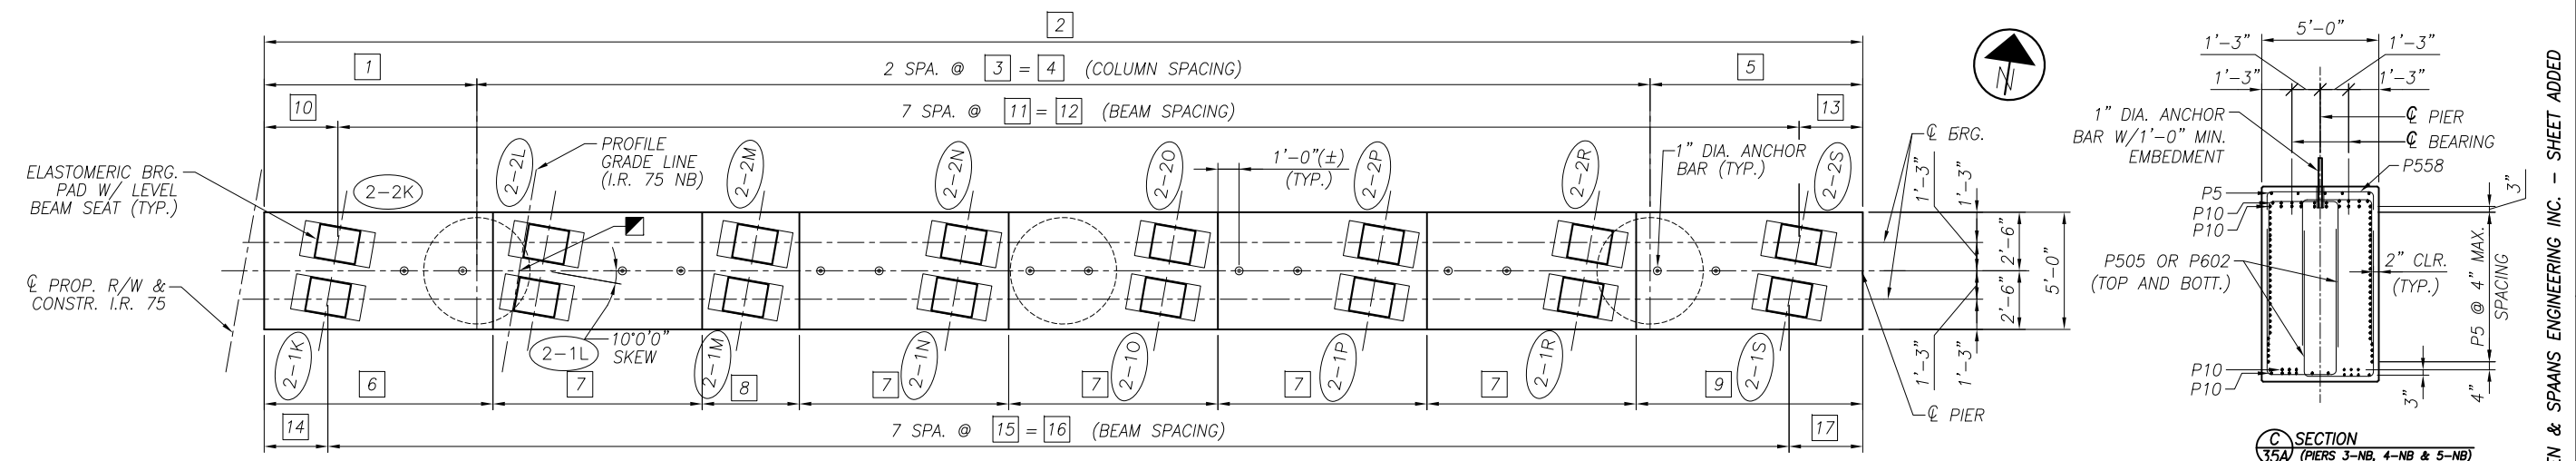

PIER	STATION	OFFSET	ELEVATION MARK								
			(A)	(B)	(C)	(D)	(E)	(F)	(G)	(H)	(I)
3-NB	490+03.36	14.00' RT.	623.16	623.31	623.32	623.38	623.22	623.06	622.90	622.74	613.24
4-NB	491+69.36	14.00' RT.	622.72	622.87	622.88	622.94	622.78	622.62	622.46	622.30	612.80
5-NB	493+35.36	14.00' RT.	622.23	622.37	622.38	622.45	622.29	622.13	621.97	621.81	612.31





PIER	DIMENSION MARK																
	1	2	3	4	5	6	7	8	9	10	11	12	13	14	15	16	17
3-NB	10'-0"	75'-2"	27'-7"	55'-2"	10'-0"	10'-4"	9'-10"	5'-0"	10'-8"	3'-5 1/16"	9'-9 3/16" (-)	68'-8 1/2"	2'-11 5/16"	2'-11 5/16"	9'-9 3/16" (-)	68'-8 1/2"	3'-5 1/16"
4-NB	10'-0"	75'-2"	27'-7"	55'-2"	10'-0"	10'-4"	9'-10"	5'-0"	10'-8"	3'-5 1/16"	9'-9 3/16" (-)	68'-8 1/2"	2'-11 5/16"	2'-11 5/16"	9'-9 3/16" (-)	68'-8 1/2"	3'-5 1/16"
5-NB	10'-0"	81'-2"	27'-7"	55'-2"	16'-0"	10'-4"	9'-10"	5'-0"	16'-8"	3'-5 1/16"	9'-9 3/16" (-)	68'-8 1/2"	8'-11 5/16"	2'-11 5/16"	9'-9 3/16" (-)	68'-8 1/2"	9'-5 1/16"

PIER	REINFORCING MARK																				
	(1)	(2)	(3)	(4)	(5)	(6)	(7)	(8)	(9)	(10)	(11)	(12)	(13)	(14)	(15)	(16)	(17)	(18)	(19)	(20)	
3-NB	11 SETS OF 4-P505 @ 16 11/16" (-) = 13'-11"	4-P534 SER. (E.F.)	21-P598 (E.F.)	20-P598 (E.F.)	5-P569	5-P579	10-P1022	6-P1022	10-P1086	6-P1086	10-P1022	6-P1022	10-P1087	10-P1087	10-P1022	10-P1022	10-P1022	10-P1022	10-P1022	4-P534 SER. (E.F.)	36-P573
4-NB	11 SETS OF 4-P505 @ 16 11/16" (-) = 13'-11"	4-P534 SER. (E.F.)	21-P598 (E.F.)	20-P598 (E.F.)	5-P569	5-P579	10-P1022	6-P1022	10-P1086	6-P1086	10-P1022	6-P1022	10-P1087	10-P1087	10-P1022	10-P1022	10-P1022	10-P1022	10-P1022	4-P534 SER. (E.F.)	36-P573
5-NB	11 SETS OF 4-P602 @ 16 11/16" (-) = 13'-11"	4-P534 SER. (E.F.)	21-P598 (E.F.)	20-P594 (E.F.)	5-P569	5-P579	10-P1022	6-P1022	10-P1086	6-P1086	10-P1085	6-P1085	10-P1087	10-P1087	10-P1022	10-P1022	10-P1085	10-P1085	4-P595 SER. (E.F.)	36-P573	

5/1/2020 JANSSEN & SPAANS ENGINEERING INC. - SHEET ADDED  
 DESIGN AGENCY: JANSSEN & SPAANS ENGINEERING, INC.  
 9120 HARRISON PARK COURT  
 INDIANAPOLIS, IN 46216  
 DATE: 5/20  
 STRUCTURE FILE NUMBER: 4802765/4802767  
 REVIEWED: WJZ  
 DRAWN: KRO  
 CHECKED: CBS  
 DESIGNED: WJZ  
 BRIDGE NO. LUC-75-0029 L/R  
 I.R. 75 OVER MAUMEE RIVER  
 P1030  
 35A/216  
 WOO/LUC-75-30.70/0.00  
 PID No. 93592  
 1325A  
 1792

Date: Oct 07, 2020, 5:09pm User Name: mlongtin  
 File: P:\11321 - Toledo E Value Engineering\DWG\BRIDGE\LUC-75-0027 over Maumee River\Sheets\027C\_P1009.dwg

MARK	SKEW ANGLE
1-1M	9°03'39"
1-1N	8°49'49"
1-1O	8°38'36"
1-1P	8°24'45"
1-1R	8°11'45"
1-1S	7°58'44"
1-1T	7°45'43"
1-1U	7°32'41"

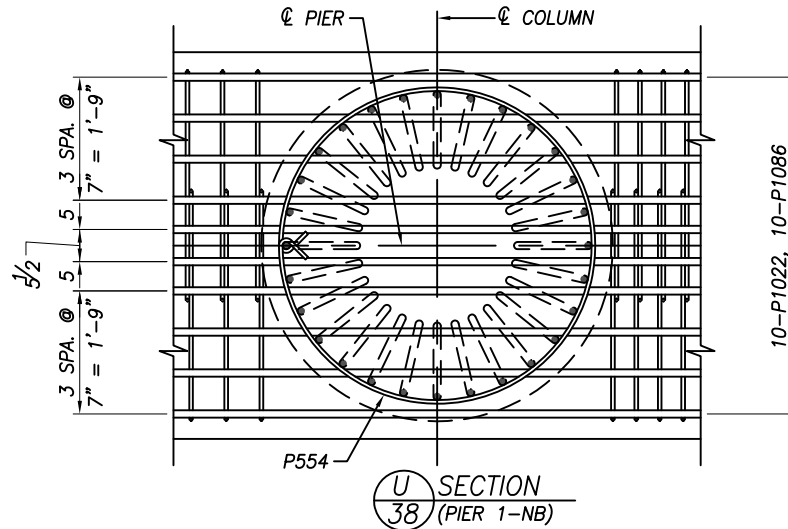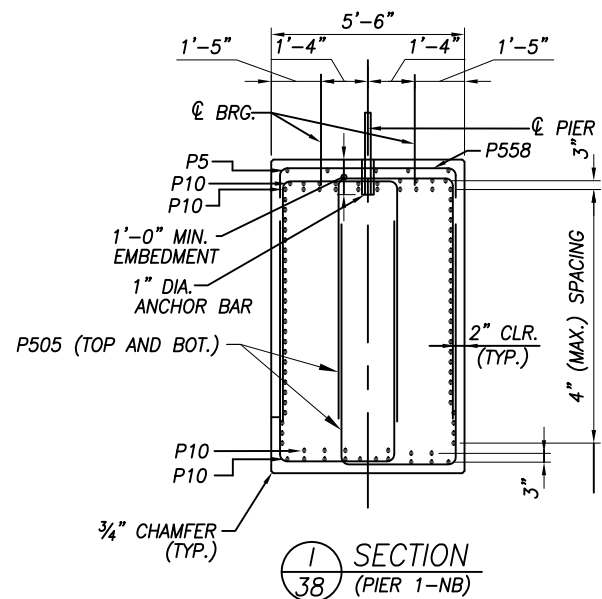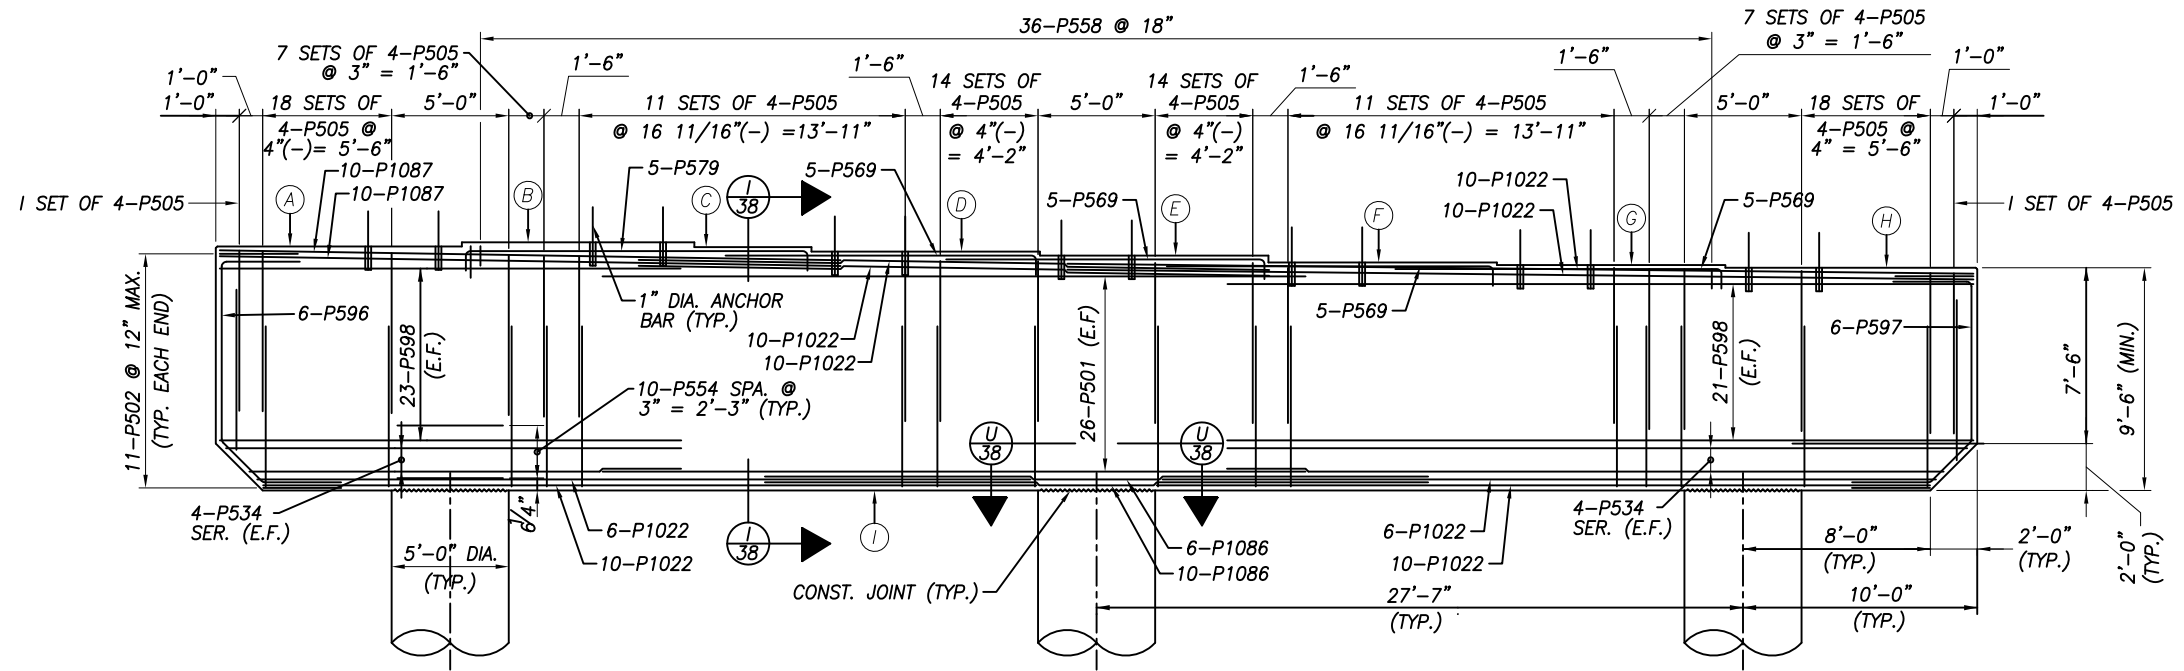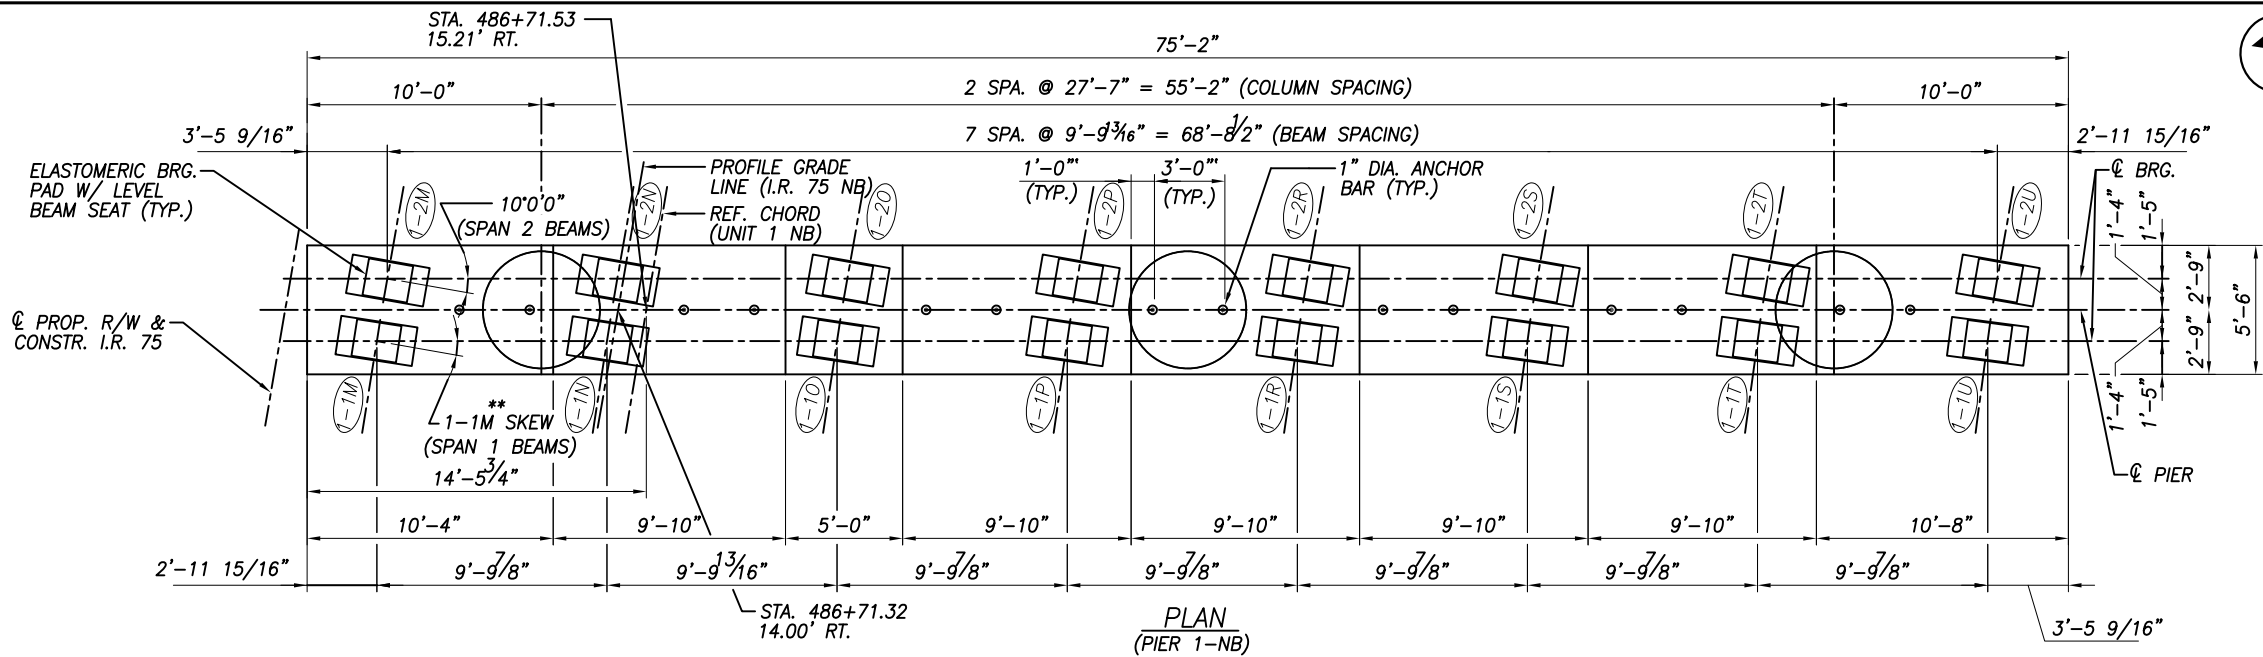

MARK	ELEVATION
(A)	624.16
(B)	624.31
(C)	624.30
(D)	623.94
(E)	623.72
(F)	623.50
(G)	623.28
(H)	623.07
(I)	613.57

LEGEND:

(-) ELEVATION MARK

NOTE:

1. FOR PIER NOTES, SEE SHEET 30/216.

DESIGNED: WJZ  
 CHECKED: CBS  
 DRAWN: KRO  
 REVIEWED: WJZ  
 DATE: 5/20  
 STRUCTURE FILE NUMBER: 4802765/4802767  
 DESIGN AGENCY: JANSSEN & SPAANS ENGINEERING, INC.  
 9120 HARRISON PARK COURT  
 INDIANAPOLIS, IN 46216





PIER 1-NB - PLAN AND ELEVATION  
 BRIDGE NO. LUC-75-0029 L/R  
 I.R. 75 OVER MAUMEE RIVER

W00/LUC-75-30.70/0.00  
 PID No. 93592

38 / 216

1331  
 1792

Date: Oct 07, 2020, 5:08pm User Name: mlongtin  
 File: P:\11321 - Toledo E Value Engineering\DWG\BRIDGE\LUC-75-0027 over Maumee River\Sheets\075\_0027C\_P101.0.dwg

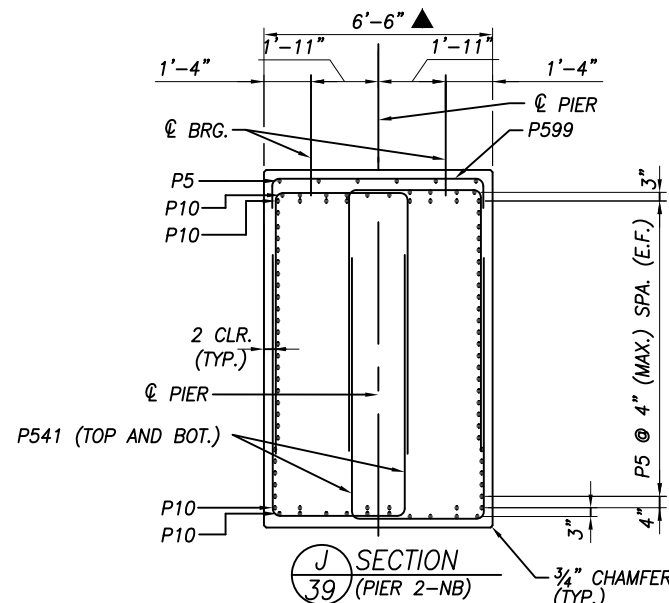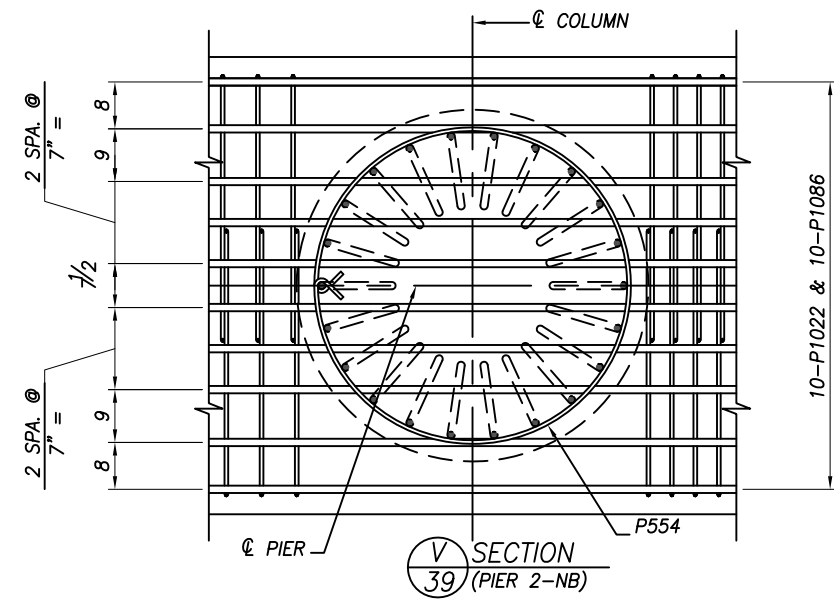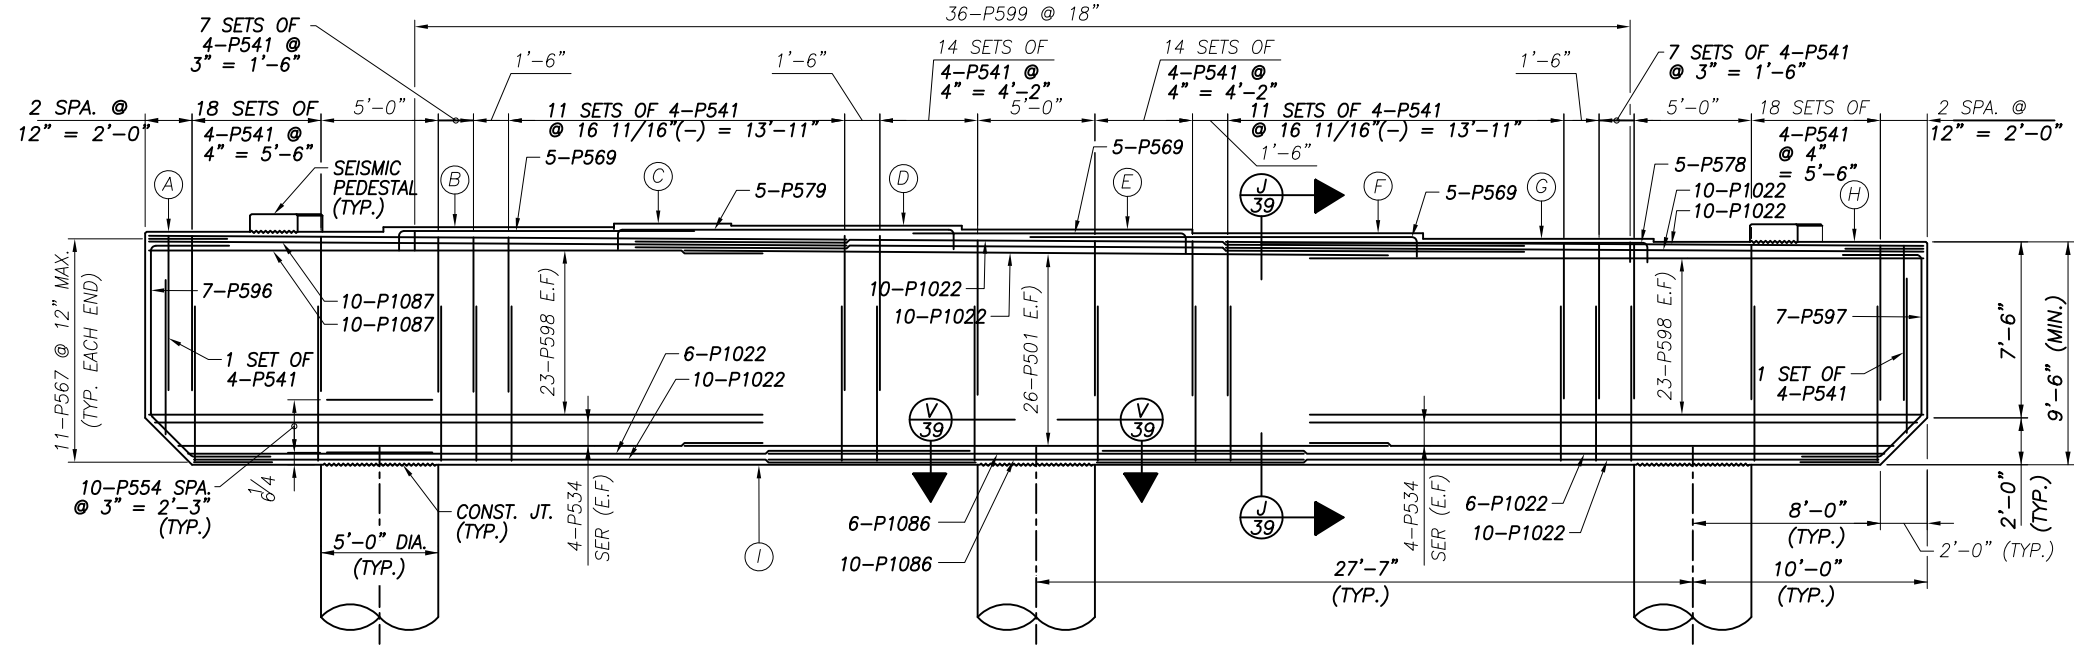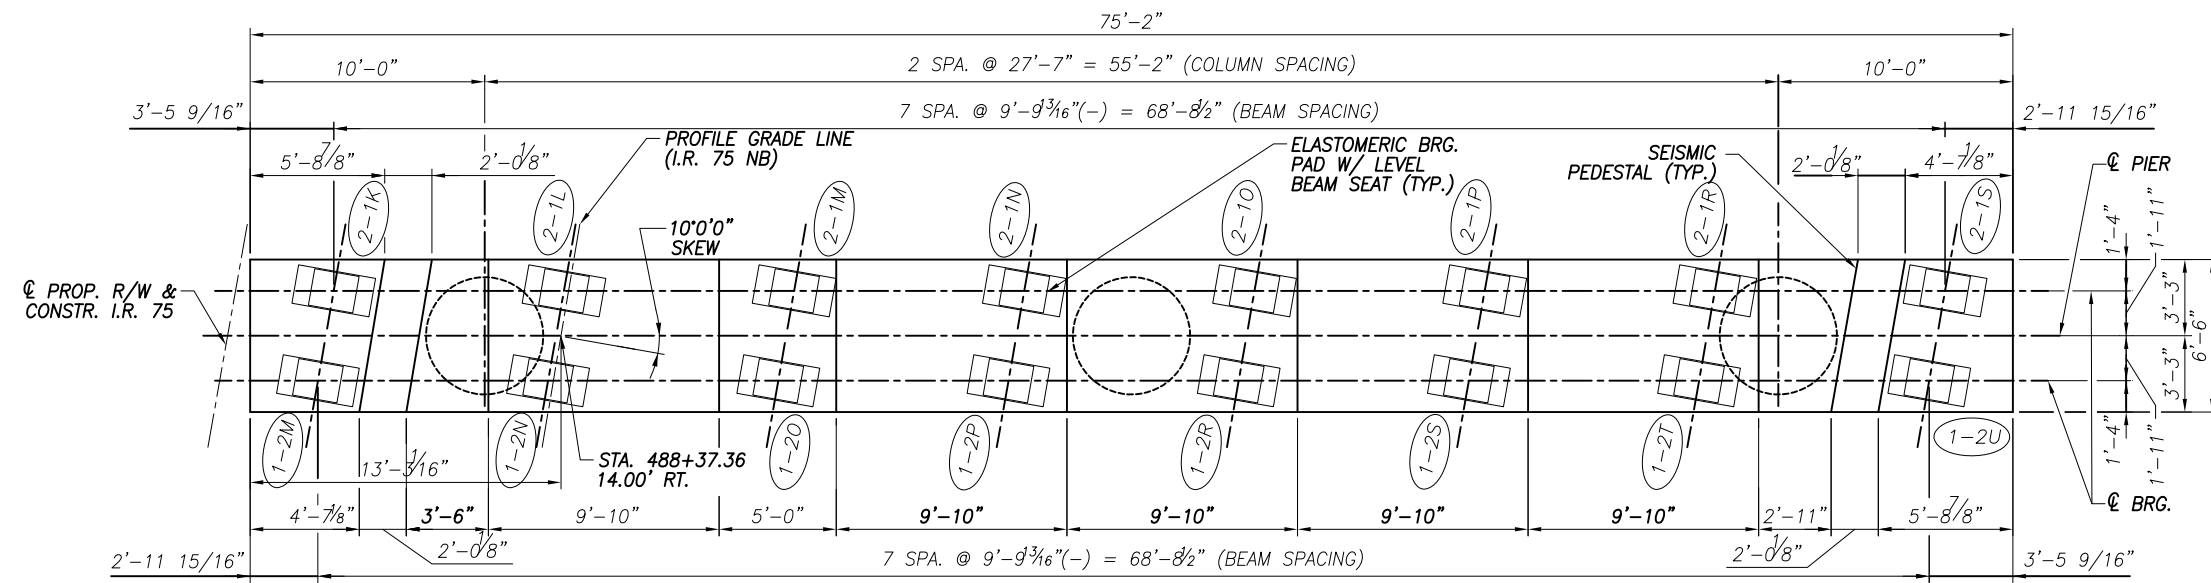

BEARING	
MARK	ELEVATION
(A)	623.65
(B)	623.80
(C)	623.80
(D)	623.87
(E)	623.71
(F)	623.55
(G)	623.39
(H)	623.23
(I)	613.73

LEGEND:

- ▲ ITEM 512 - SEALING OF CONCRETE SURFACES (EPOXY URETHANE)
- ELEVATION MARK
- □ PROP. R/W & CONSTR. I.R. 75  
STA. 488+49.02  
OFFSET 89.80' RT.
- ⊔ RAMP 1-D PROFILE GRADE LINE  
STA. 288+48.32  
OFFSET 0.00'

NOTE:

1. FOR PIER NOTES, SEE SHEET 30/216.



DESIGN AGENCY  
**JANSSEN & SPAANS ENGINEERING, INC.**  
 9120 HARRISON PARK COURT  
 INDIANAPOLIS, IN 46216

DESIGNED  
 WJZ

DRAWN  
 KRO

REVIEWED  
 WJZ

DATE  
 5/20

STRUCTURE FILE NUMBER  
 4802765/4802767

REVISIONS  
 CHECKED  
 CBS


PIER 2-NB - PLAN AND ELEVATION  
 BRIDGE NO. LUC-75-0029 L/R  
 I.R. 75 OVER MAUMEE RIVER

W00/LUC-75-  
 30.70/0.00  
 PID No. 93592


39 / 216

1332  
 1792


Date: Oct 07, 2020, 5:07pm User Name: mlongtin  
 File: P:\1321 - Toledo E Value Engineering\DWG\BRIDGE\LUC-75-0027 over Maumee River\Sheets\075\_0027C\_P101.1.dwg

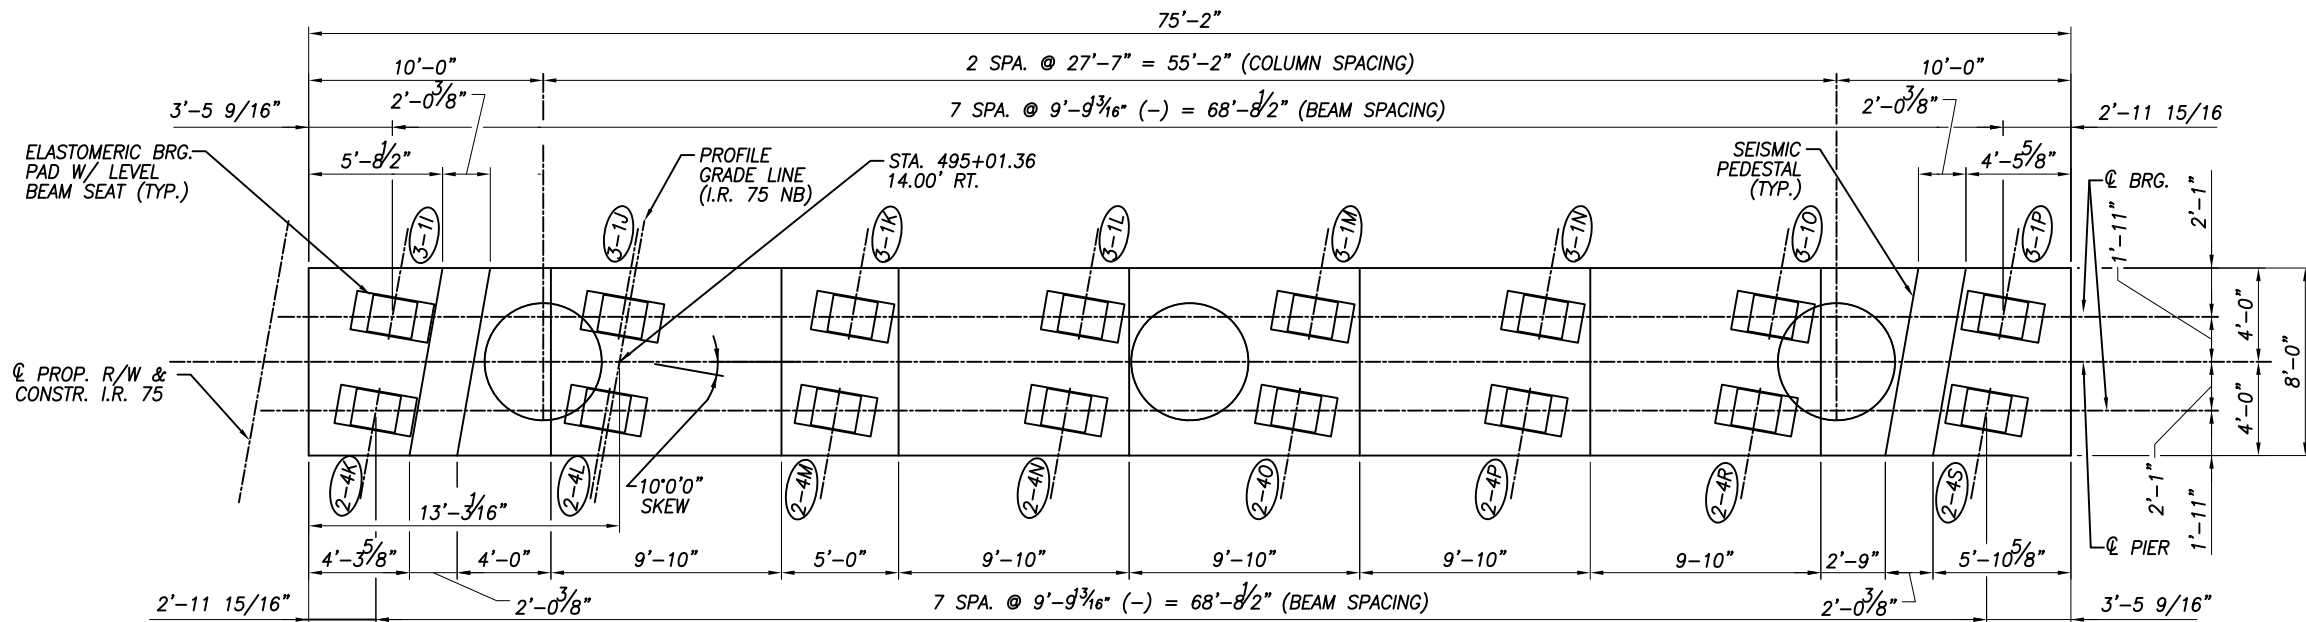


PLAN  
(PIER 6-NB)

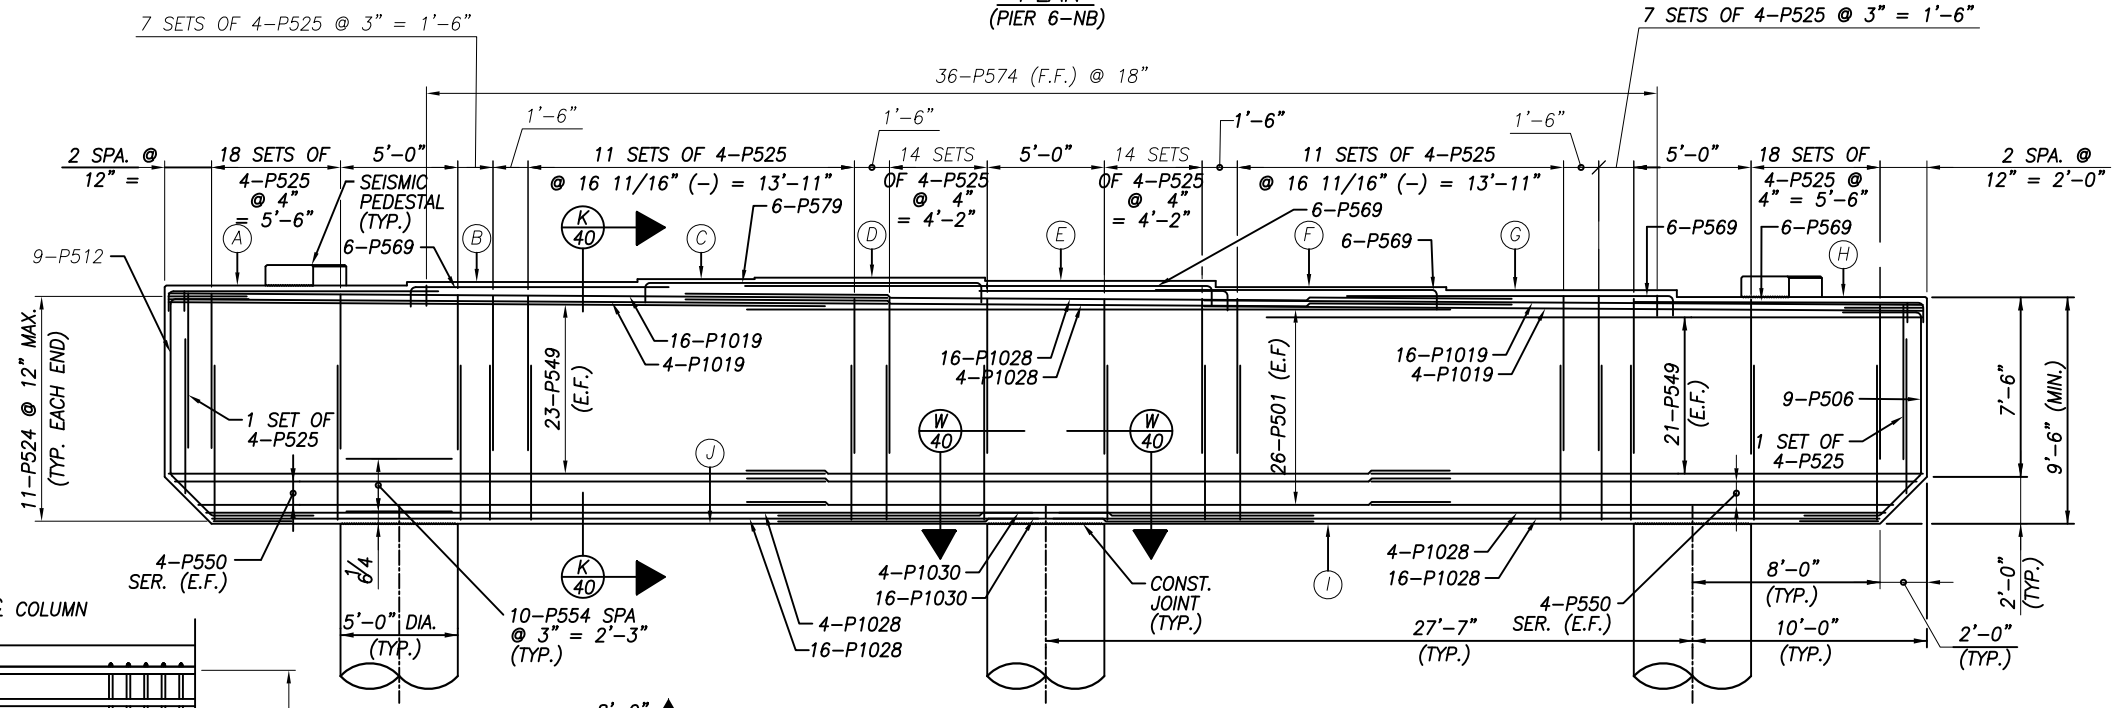

ELEVATION  
(PIER 6-NB)

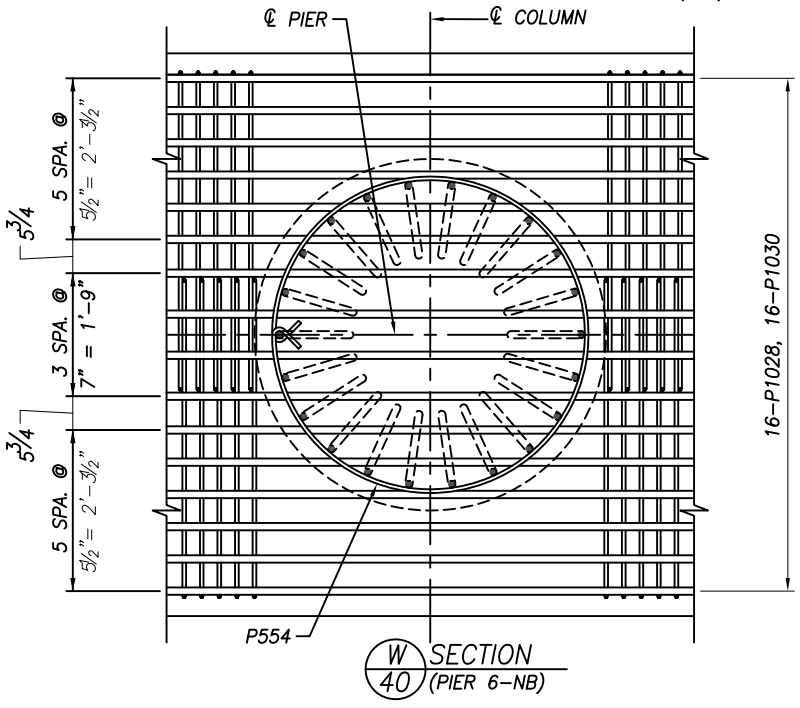

SECTION  
W-40  
(PIER 6-NB)

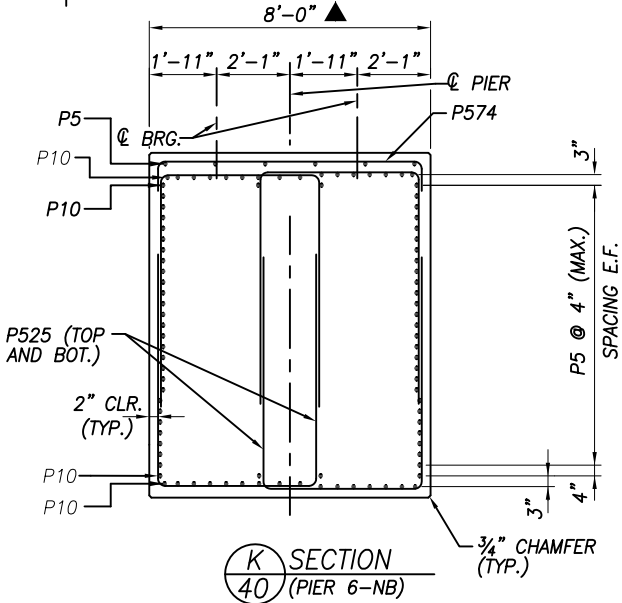

SECTION  
K-40  
(PIER 6-NB)

BEARING	
MARK	ELEVATION
(A)	621.68
(B)	621.82
(C)	621.83
(D)	621.90
(E)	621.74
(F)	621.58
(G)	621.42
(H)	621.26
(I)	611.76

LEGEND:  
 ▲ ITEM 512 - SEALING OF CONCRETE SURFACES (EPOXY URETHANE)  
 ⊖ ELEVATION MARK

NOTE:  
 1. FOR PIER NOTES, SEE SHEET 30/216.

3 5/1/2020 JANSSEN & SPAANS ENGINEERING INC. - REPLACED SHEET

DESIGN AGENCY: JANSSEN & SPAANS ENGINEERING, INC.  
 9120 HARRISON PARK COURT  
 INDIANAPOLIS, IN 46216








DESIGNED: WJZ  
 DRAWN: KRO  
 REVIEWED: WJZ  
 DATE: 5/20  
 STRUCTURE FILE NUMBER: 4802765/480276

PIER 6-NB - PLAN AND ELEVATION  
 BRIDGE NO. LUC-75-0029 L/R  
 I.R. 75 OVER MAUMEE RIVER

W00/LUC-75-30.70/0.00  
 PID No. 93592

40 / 216

1333  
 1792

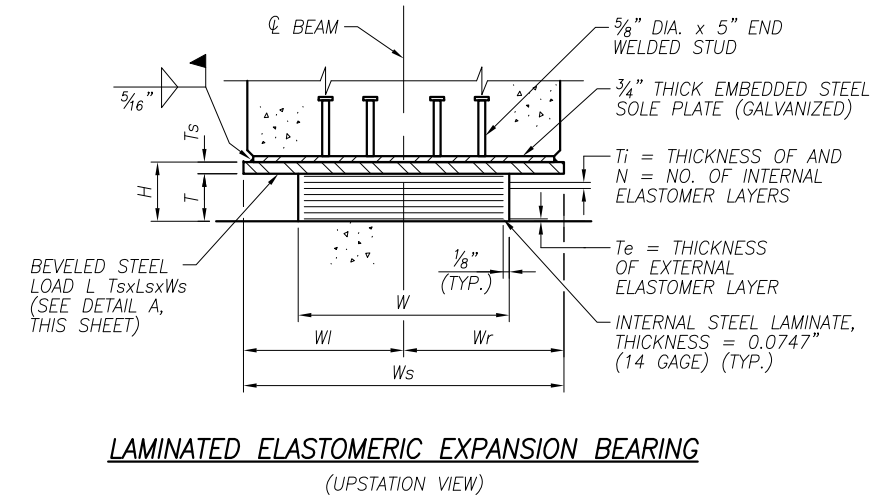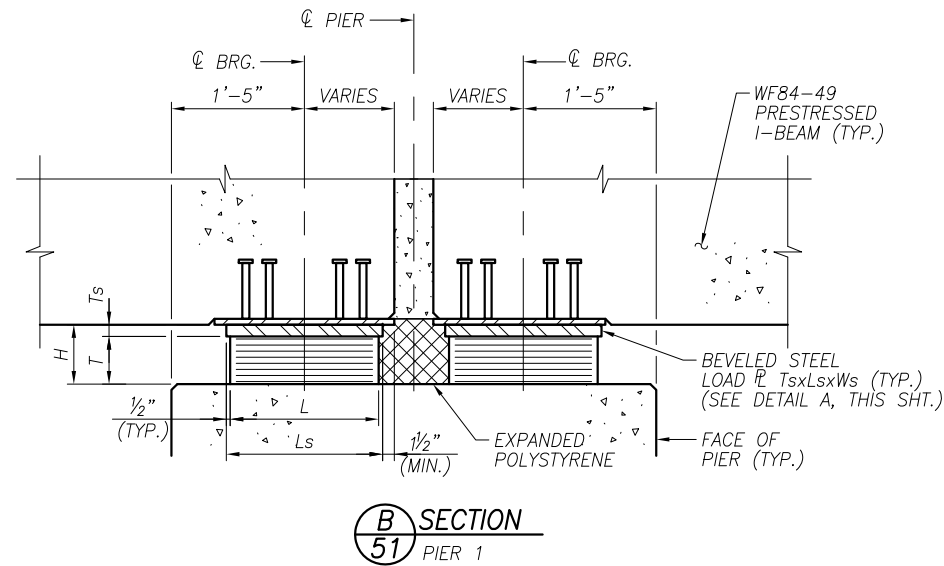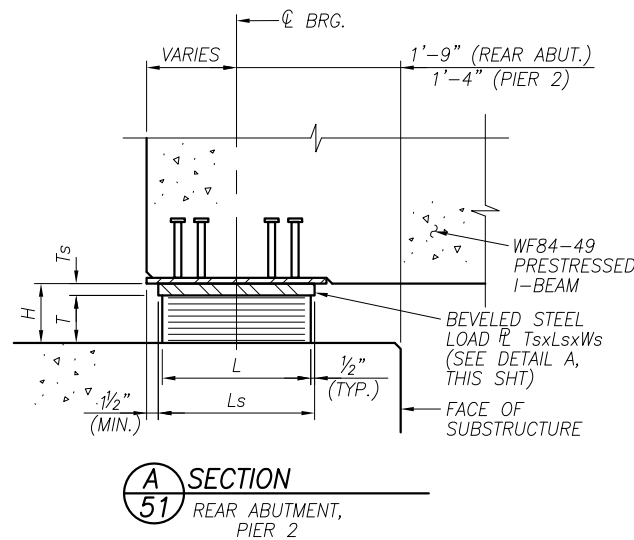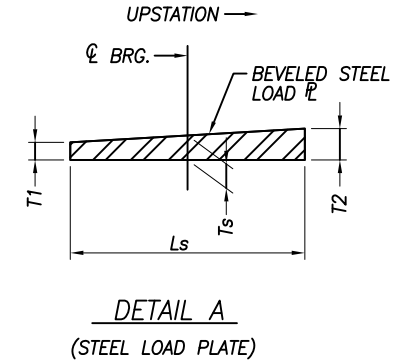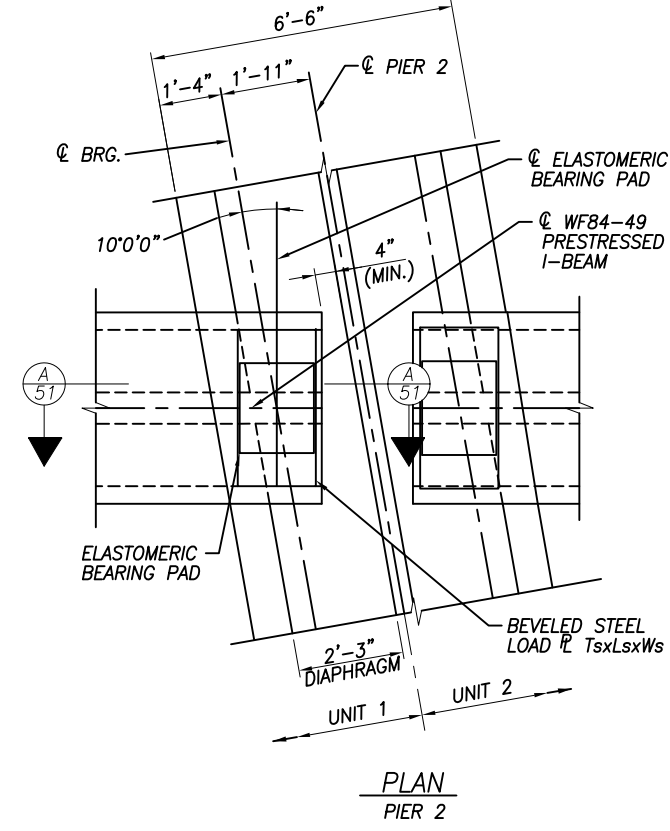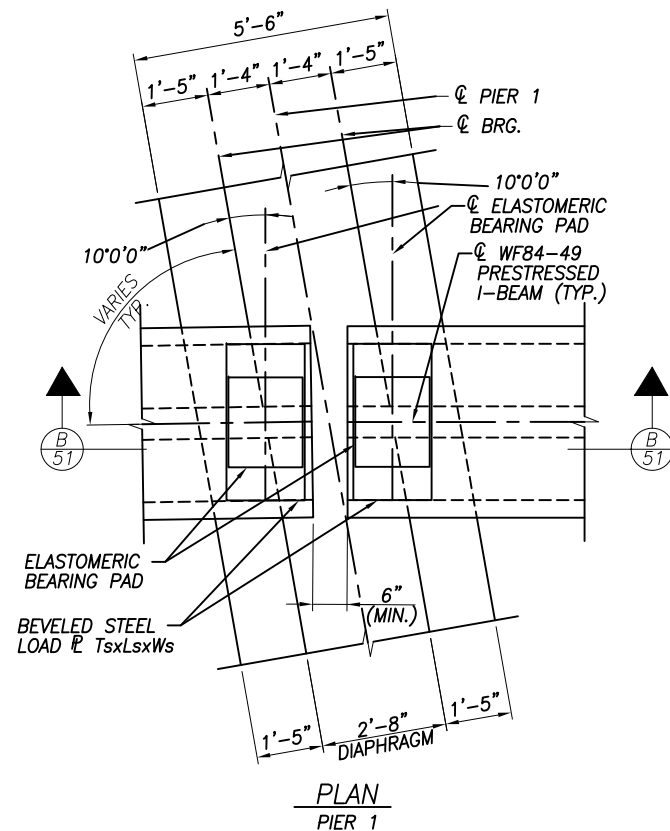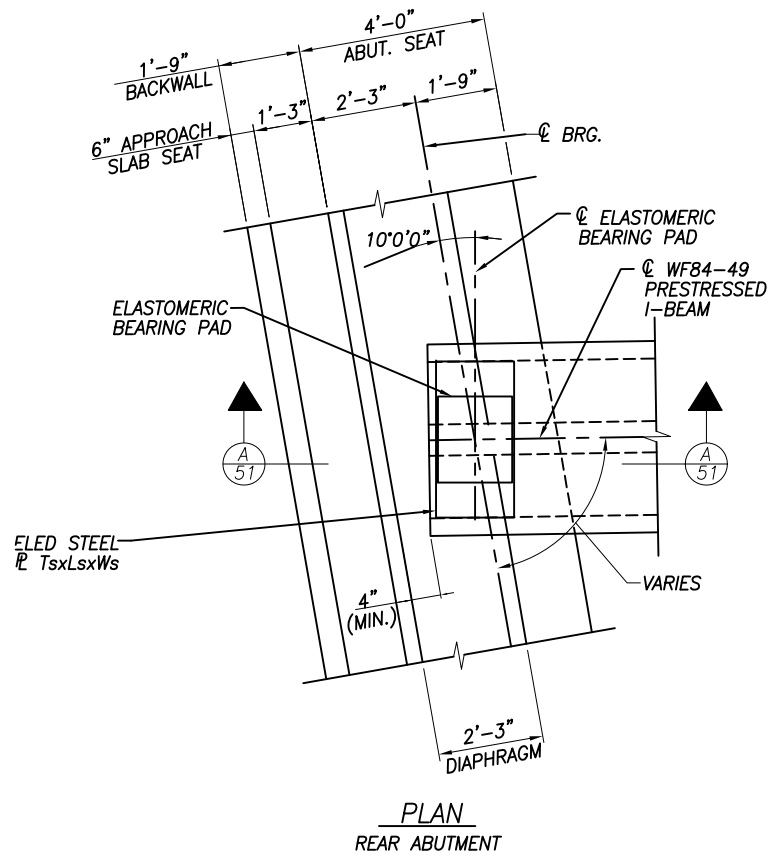







NOTES:  
1. FOR ADDITIONAL NOTES, SEE SHEET 48/216.

BEARING DETAIL TABLE - UNIT 1 NORTHBOUND																					
LOCATION				BEARING PAD							LOAD PLATE							SERVICE REACTIONS			
SUBSTRUCTURE UNIT	UNIT SPAN	BEAMS	No. REQ'D	TYPE	L (IN)	W (IN)	Te (IN)	Ti (IN)	N	T (IN)	H (IN)	Ts (IN)	Ls (IN)	Wl (IN)	Wr (IN)	Ws (IN)	T1 (IN)	T2 (IN)	Rdl (KIPS)	Rll (KIPS)	Rtotal (KIPS)
REAR ABUTMENT	1	1-1M THRU 1T	7	EXP.	19	22	0.3125	0.625	5	3.81	5.31	1.5	20	20	20	40	1.50	1.50	258.8	129.7	388.6
REAR ABUTMENT	1	1-1U	1	EXP.	19	22	0.3125	0.625	5	3.81	5.31	1.5	20	20.75	20	40.75	1.50	1.50	258.8	129.7	388.6
PIER 1	1	1-1M THRU 1-1U	8	FIX.	19	23	0.3125	0.625	6	4.51	7.93	3.42	20	20	20	40	3.47	3.37	247.1	129.7	376.8
PIER 1	2	1-2M THRU 1-2T	8	FIX.	19	23	0.3125	0.625	6	4.51	6.01	1.5	20	20	20	40	1.55	1.45	279.8	137.1	416.9
PIER 2	2	1-2M	1	EXP.	19	23	0.3125	0.625	6	4.51	6.01	1.5	20	20	20.625	40.625	1.55	1.45	291.2	137.1	428.3
PIER 2	2	1-2N THRU 1-2T	6	EXP.	19	23	0.3125	0.625	6	4.51	6.01	1.5	20	20	20	40	1.55	1.45	291.2	137.1	428.3
PIER 2	2	1-2U	1	EXP.	19	23	0.3125	0.625	6	4.51	6.01	1.5	20	20.625	20	40.625	1.55	1.45	291.2	137.1	428.3

Date: Oct 07, 2020, 5:07pm User Name: mlongtin File: P:\11321 - Toledo E Value Engineering\DWG\BRIDGE\LUC-75-0027 over Maumee River\Sheets\075\_0027C\_BR004.dwg

5/1/2020 JANSSEN & SPAANS ENGINEERING INC. - RECONFIGURED NORTHBOUND ON RAMP, SHEET REPLACED  
 DESIGN AGENCY: JANSSEN & SPAANS ENGINEERING, INC. 9120 HARRISON PARK COURT INDIANAPOLIS, IN 46216  
 DATE: 5/2020  
 REVIEWED: WJZ  
 DRAWN: WJZ  
 CHECKED: CBS  
 STRUCTURE FILE NUMBER: 4802765/4802767  
 ELASTOMERIC BEARING DETAILS - UNIT 1 NORTHBOUND  
 BRIDGE NO. LUC-75-0029 L/R  
 I.R. 75 OVER MAUMEE RIVER  
 WJZ/LUC-75-30.70/0.00  
 PID No. 93592  
 51 / 216  
 1344 / 1792

Date: Oct 07, 2020, 5:07pm User Name: mlongtin  
 File: P:\11321 - Toledo E Value Engineering\DWG\5\BRIDGE\LUC-75-0027 over Maumee River\Sheets\075\_0027C\_BR0005.dwg

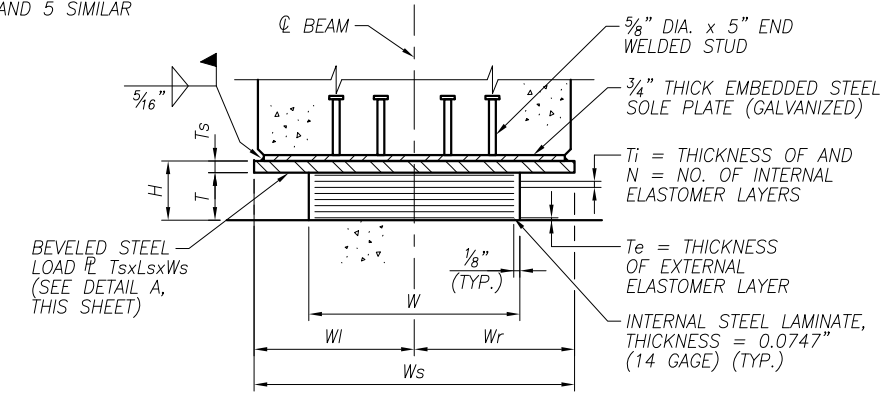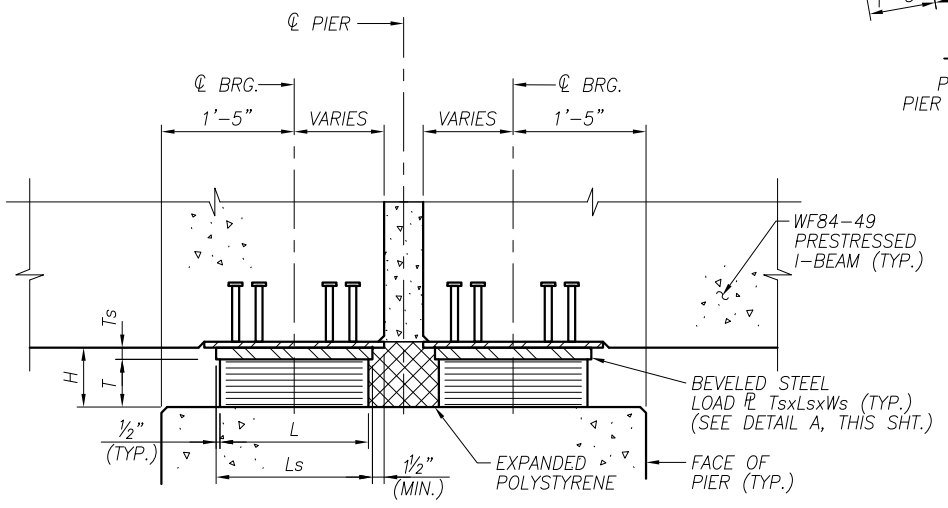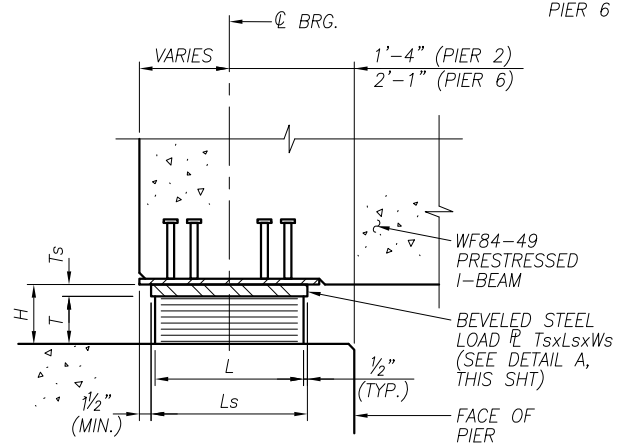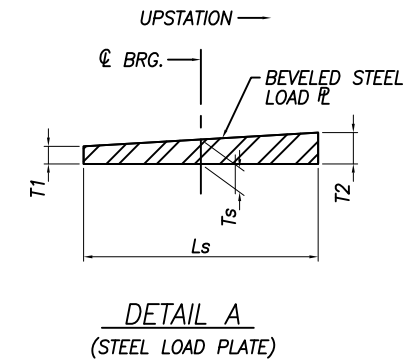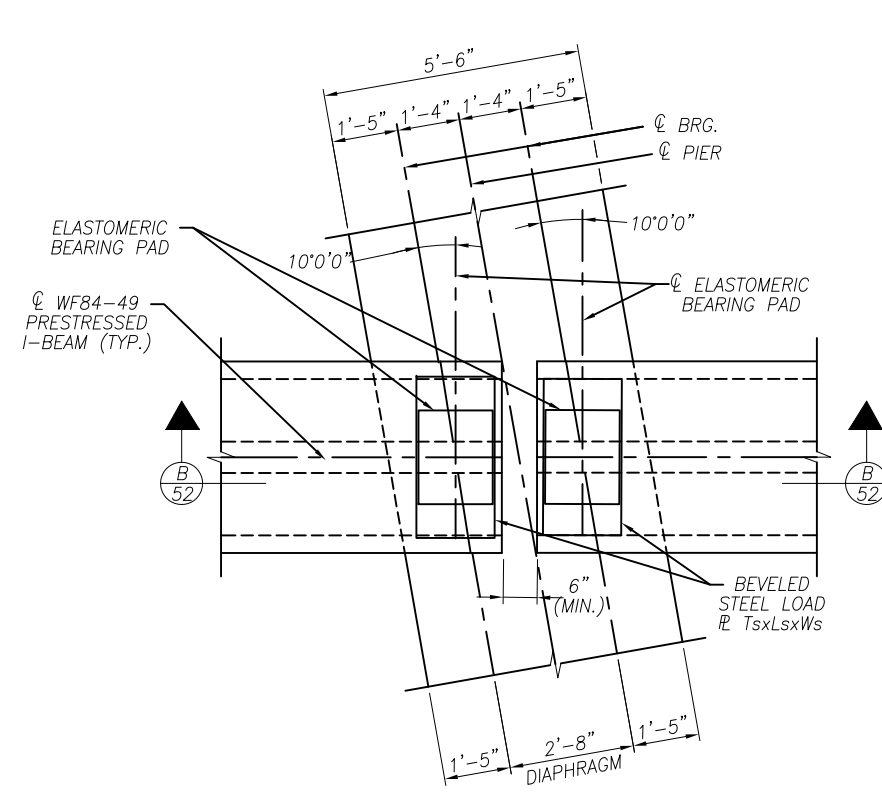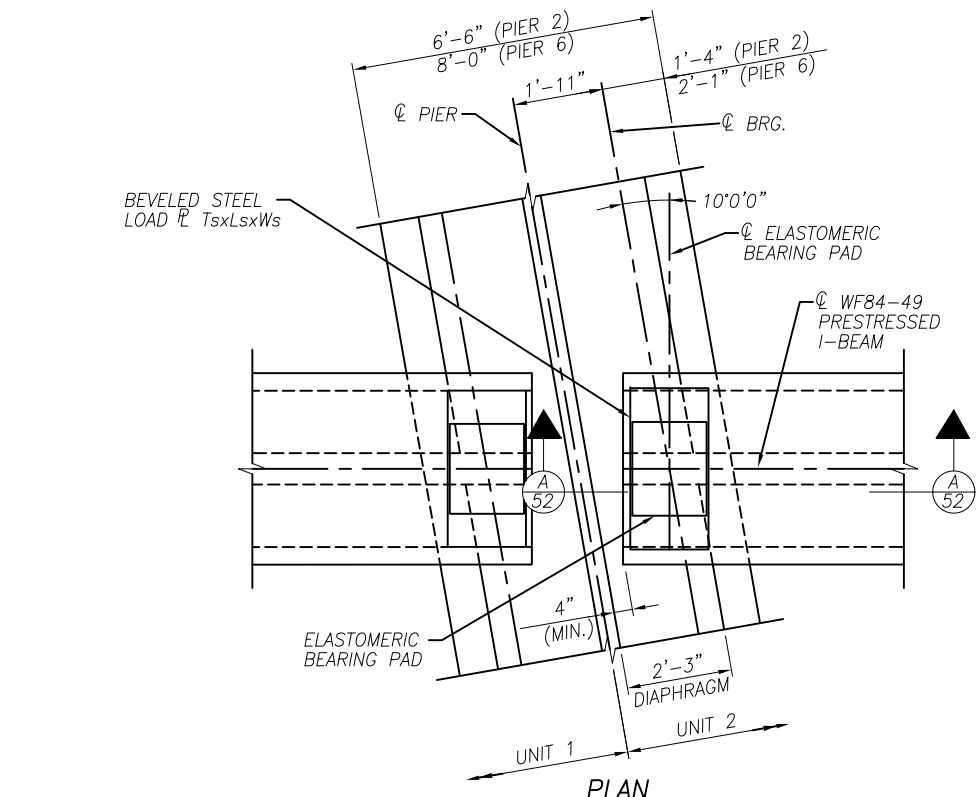


NOTES:  
 1. FOR ADDITIONAL NOTES, SEE SHEET 48/216.

BEARING DETAIL TABLE - UNIT 2 NORTHBOUND																						
LOCATION				BEARING PAD								LOAD PLATE						SERVICE REACTIONS				
SUBSTRUCTURE UNIT	UNIT SPAN	BEAMS	No. REQ'D	TYPE	L (IN)	W (IN)	Te (IN)	Ti (IN)	N	T (IN)	H (IN)	Ts (IN)	Ls (IN)	Wl (IN)	Wr (IN)	Ws (IN)	T1 (IN)	T2 (IN)	Rdl (KIPS)	Rll (KIPS)	Rtotal (KIPS)	
PIER 2	1	2-1K THRU 2-1S	8	EXP.	19	24	0.3125	0.625	6	4.51	6.14	1.625	20	20.625	20.625	41.25	1.63	1.63	291.2	137.1	428.3	
PIER 3	1	2-1K THRU 2-1S	8	FIX.	19	24	0.3125	0.625	6	4.51	6.14	1.625	20	20.625	20.625	41.25	1.67	1.58	279.8	137.1	416.9	
PIER 3	2	2-2K THRU 2-2S	8	FIX.	19	23	0.3125	0.625	6	4.51	6.01	1.5	20	20	20	40	1.5	1.5	279.8	137.1	416.9	
PIER 4	2	2-2K THRU 2-2S	8	FIX.	19	23	0.3125	0.625	5	3.81	5.31	1.5	20	20	20	40	1.55	1.45	279.8	137.1	416.9	
PIER 4	3	2-3K THRU 2-3S	8	FIX.	19	23	0.3125	0.625	5	3.81	5.31	1.5	20	20	20	40	1.5	1.50	279.8	137.1	416.9	
PIER 5	3	2-3K THRU 2-3S	8	FIX.	19	23	0.3125	0.625	5	3.81	5.31	1.5	20	20	20	40	1.56	1.44	279.8	137.1	416.9	
PIER 5	4	2-4K THRU 2-4S	8	FIX.	19	23	0.3125	0.625	5	3.81	5.31	1.5	20	20	20	40	1.5	1.5	279.8	137.1	416.9	
PIER 6	4	2-4K THRU 2-4S	8	EXP.	19	23	0.3125	0.625	6	4.51	6.01	1.5	20	20	20	40	1.56	1.44	291.2	137.1	428.3	

5/1/2020 JANSSEN & SPAANS ENGINEERING INC. - RECONFIGURED NORTHBOUND ON RAMP, SHEET REPLACED  
 DESIGN AGENCY: JANSSEN & SPAANS ENGINEERING, INC. 9120 HARRISON PARK COURT INDIANAPOLIS, IN 46216  
 DATE: 5/2020  
 REVIEWED: WJZ  
 STRUCTURE FILE NUMBER: 4802765/4802767  
 DRAWN: WJZ  
 REM: WJZ  
 CHECKED: CBS  
 DESIGNED: CBS  
 ELASTOMERIC BEARING DETAILS - UNIT 2 NORTHBOUND  
 BRIDGE NO. LUC-75-0029 L/R  
 I.R. 75 OVER MAUMEE RIVER  
 W00/LUC-75-30.70/0.00  
 PID No. 93592  
 52 / 216  
 1345 / 1792



Date: Oct 07, 2020, 5:06pm User Name: mlongtin  
 File: P:\1321 - Toledo E Value Engineering\DWG\BRIDGE\LUC-75-0027 over Maumee River\Sheets\025\_0027C\_S0001.dwg

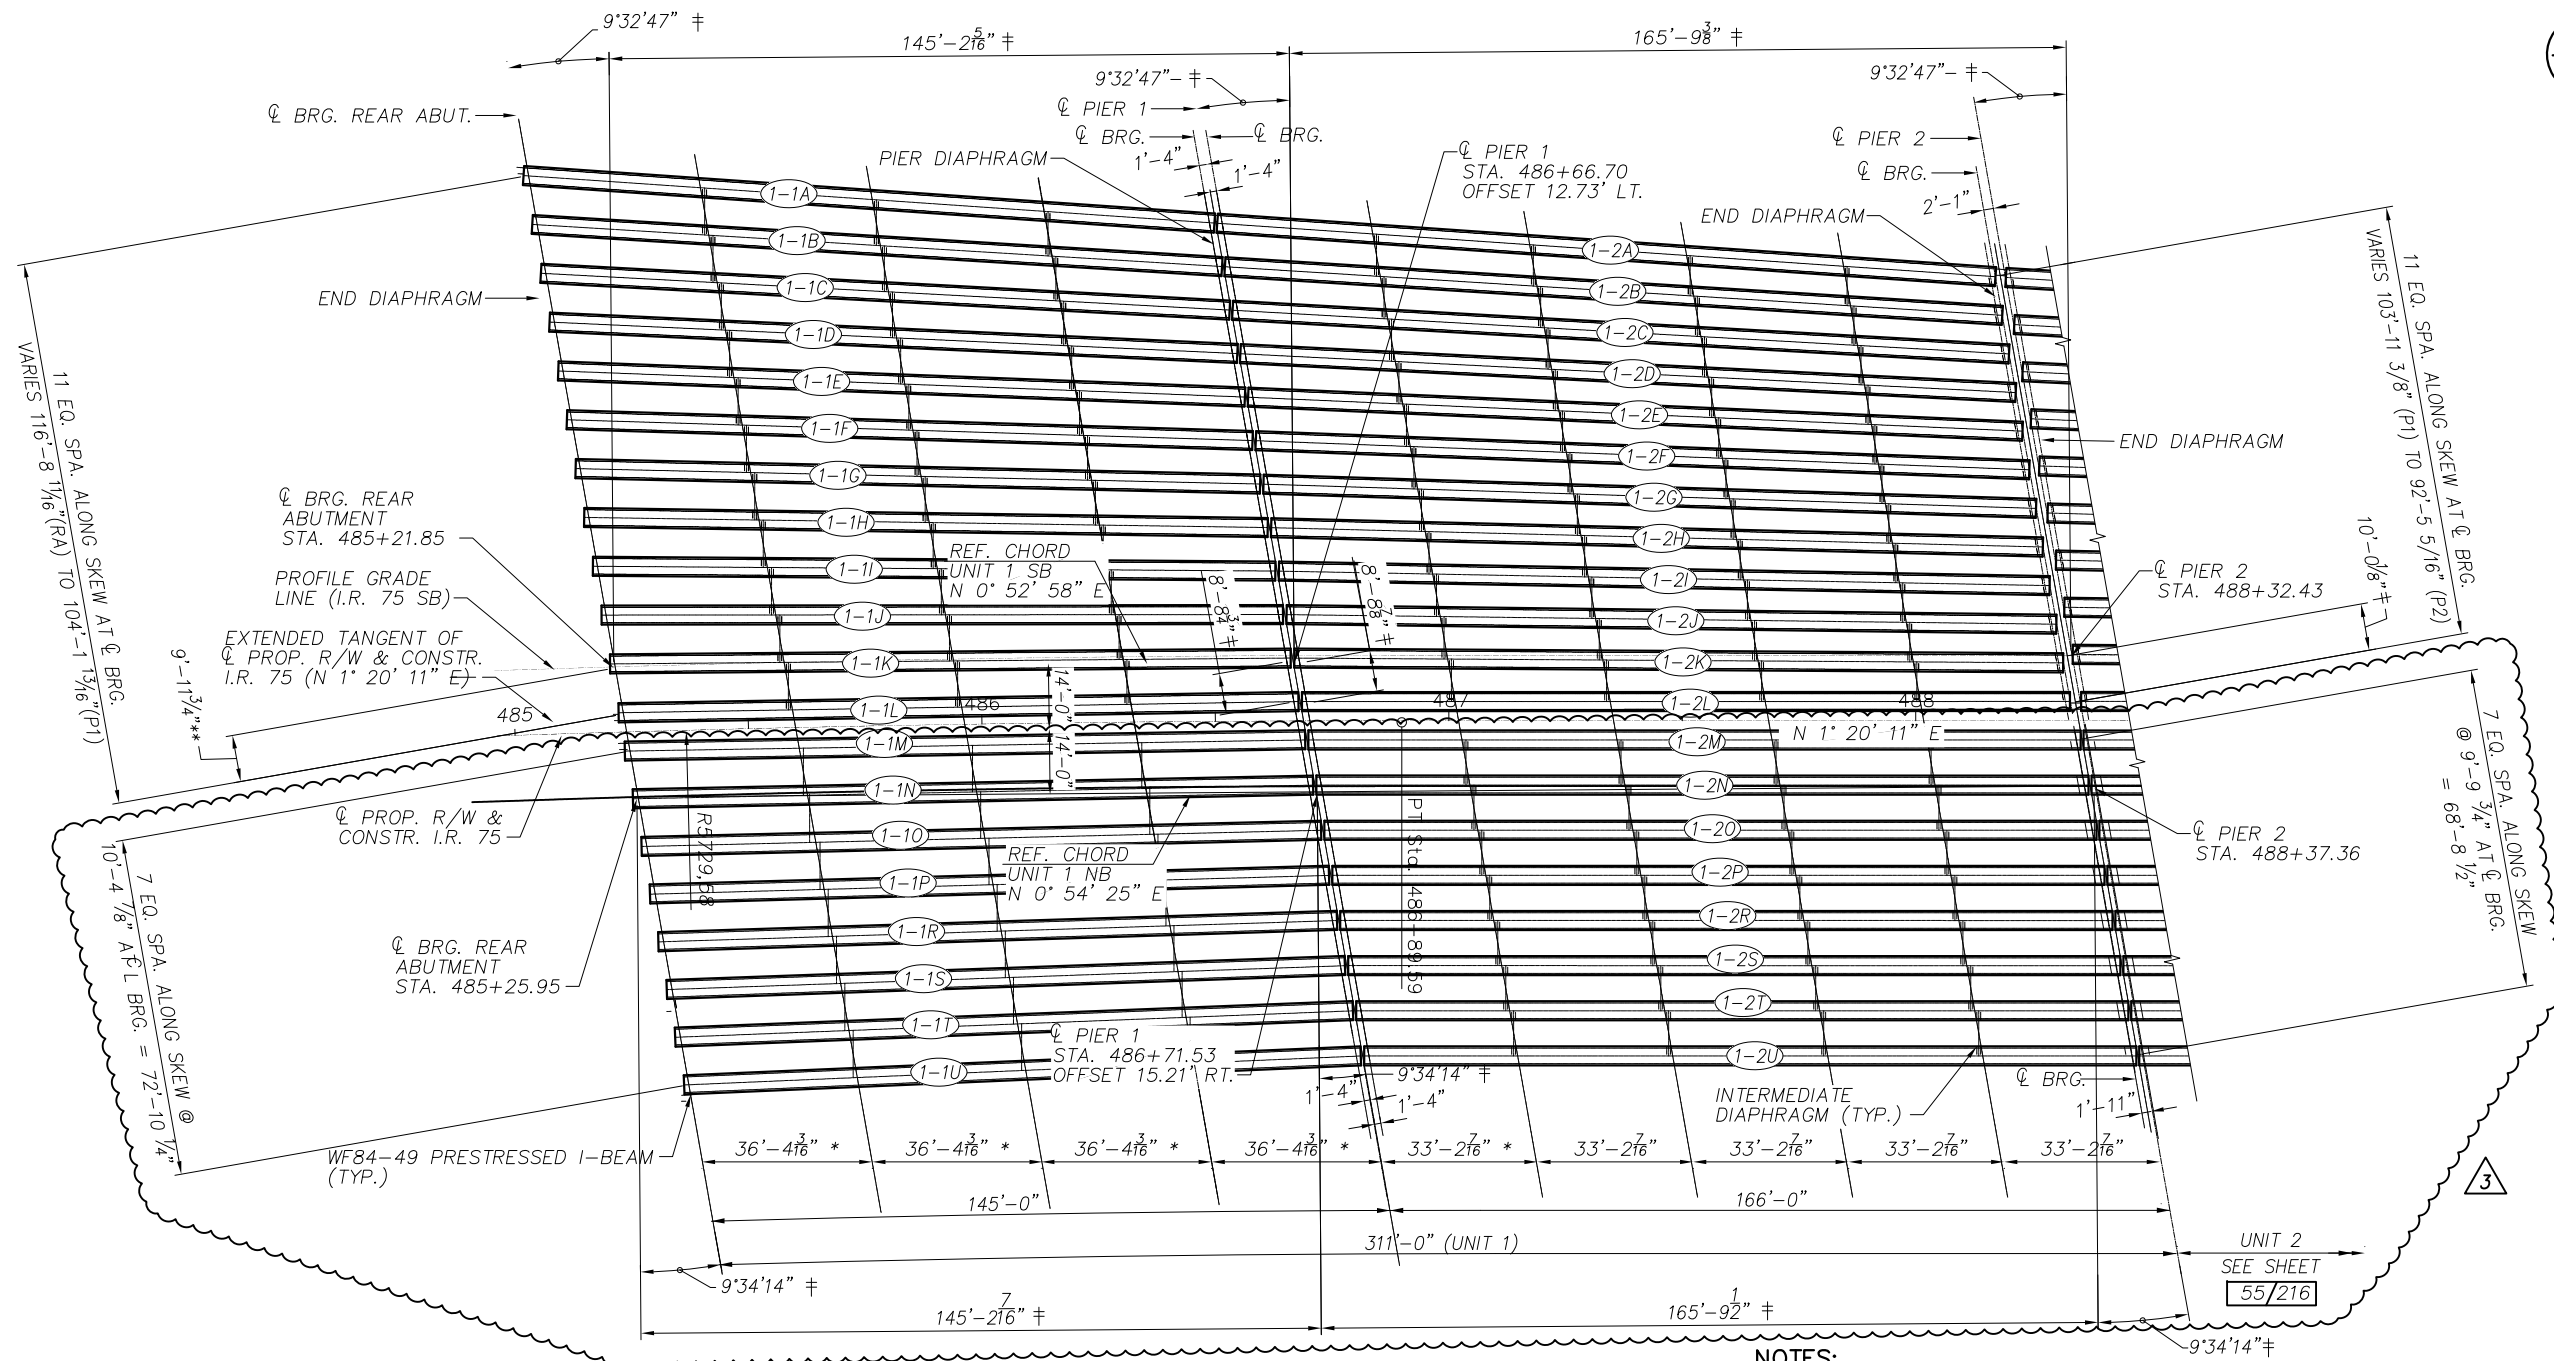

**FRAMING PLAN (UNIT 1)**  
 NORTHBOUND AND SOUTHBOUND BRIDGES


- LEGEND:**
- 1-1A - BEAM IDENTIFICATION
  - ‡ - MEASURED ALONG/WITH RESPECT TO REFERENCE CHORD
  - \* - MEASURED ALONG EXTENDED TANGENT OF CL PROP. R/W & CONSTR. I.R. 75 (SEE NOTE 1)
  - \*\* - MEASURED ALONG CL BRG. FROM PROFILE GRADE LINE TO CL BM.

- NOTES:**
1. INTERMEDIATE DIAPHRAGMS ARE PLACED PERPENDICULAR TO TANGENT PORTION OF L PROPOSED R/W & CONSTRUCTION I.R.75 AND ACCORDING TO STANDARD DWG. PSID-1-13 PLAN LAYOUT FOR SKEW ANGLES GREATER THAN 10'.
  2. THE SPAN AND UNIT LENGTHS ARE GIVEN ALONG L PROP. R/W & CONSTR. I.R. 75. INTERMEDIATE DIAPHRAGM SPACINGS ARE GIVEN ALONG CL PROP. R/W & CONSTR. I.R. 75, EXCEPT IN THE CURVED REGION WHERE THEY ARE PROVIDED ALONG AN EXTENDED TANGENT.
  3. CONCRETE INTERMEDIATE DIAPHRAGMS SHALL BE CONSTRUCTED ACCORDING TO STANDARD DWG. PSID-1-13 FOR 60", 66" & 72" BEAMS, WITH THE EXCEPTION THAT NO. 7 REINFORCEMENT SHALL BE USED. CONTRACTOR MAY USE STEEL PER ODOT BDM 302.5.2.6. IF STEEL IS CHOSEN, TOP CHORD L6x4x5/16 SHALL BE PROVIDED FOR DIAPHRAGMS IN THE EXTERIOR BAYS. USE 1" DIA. BOLTS FOR TOP AND BOTTOM CHORDS IN EXTERIOR BAY. REMAINING CONNECTIONS SHALL COMPLY WITH THE STANDARD DRAWING.
  4. FOR END AND PIER DIAPHRAGM DETAILS, SEE SHEETS 78/216 THRU 84/216.
  5. FOR PRESTRESSED I-BEAM DETAILS, SEE SHEETS 60/216 THRU 73/216.
  6. EACH BEAM MARK DESIGNATES ITS UNIT, SPAN AND BEAM. THE FIRST NUMBER INDICATES THE UNIT. THE NEXT NUMBER INDICATES THE SPAN OF THE UNIT AND THE FINAL LETTER INDICATES THE BEAM NUMBER FOR THAT SPAN.

EXAMPLE: 3-4K  
 BEAM K  
 SPAN 4  
 UNIT 3

<p>3 5/1/2020 JANSEN &amp; SPAANS ENGINEERING INC.        - RECONFIGURED NORTHBOUND ON RAMP</p>		<p>DESIGN AGENCY  <b>AECOM</b>        564 WHITE POND DRIVE        AKRON, OHIO 44320-1100        (330) 836-9111</p>
<p>FRAMING PLAN - 1 OF 6        BRIDGE NO. LUC-75-0029 L/R        I.R. 75 OVER MAUMEE RIVER</p>	<p>DESIGNED: MRW        DRAWN: CMA        CHECKED: CRG</p>	<p>REVIEWED: JTH        DATE: 8/18        STRUCTURE FILE NUMBER: 4802765/4802767</p>
<p>W00/LUC-75-0029/0.00        PID No. 93592</p>		<p>54 / 216        1347        1792</p>

Date: Oct 07, 2020, 5:06pm User Name: mlongtin  
 File: P:\1321 - Toledo E Value Engineering\DWGS\BRIDGE\LUC-75-0027 over Maumee River\Sheets\075\_0027C\_S0001.dwg

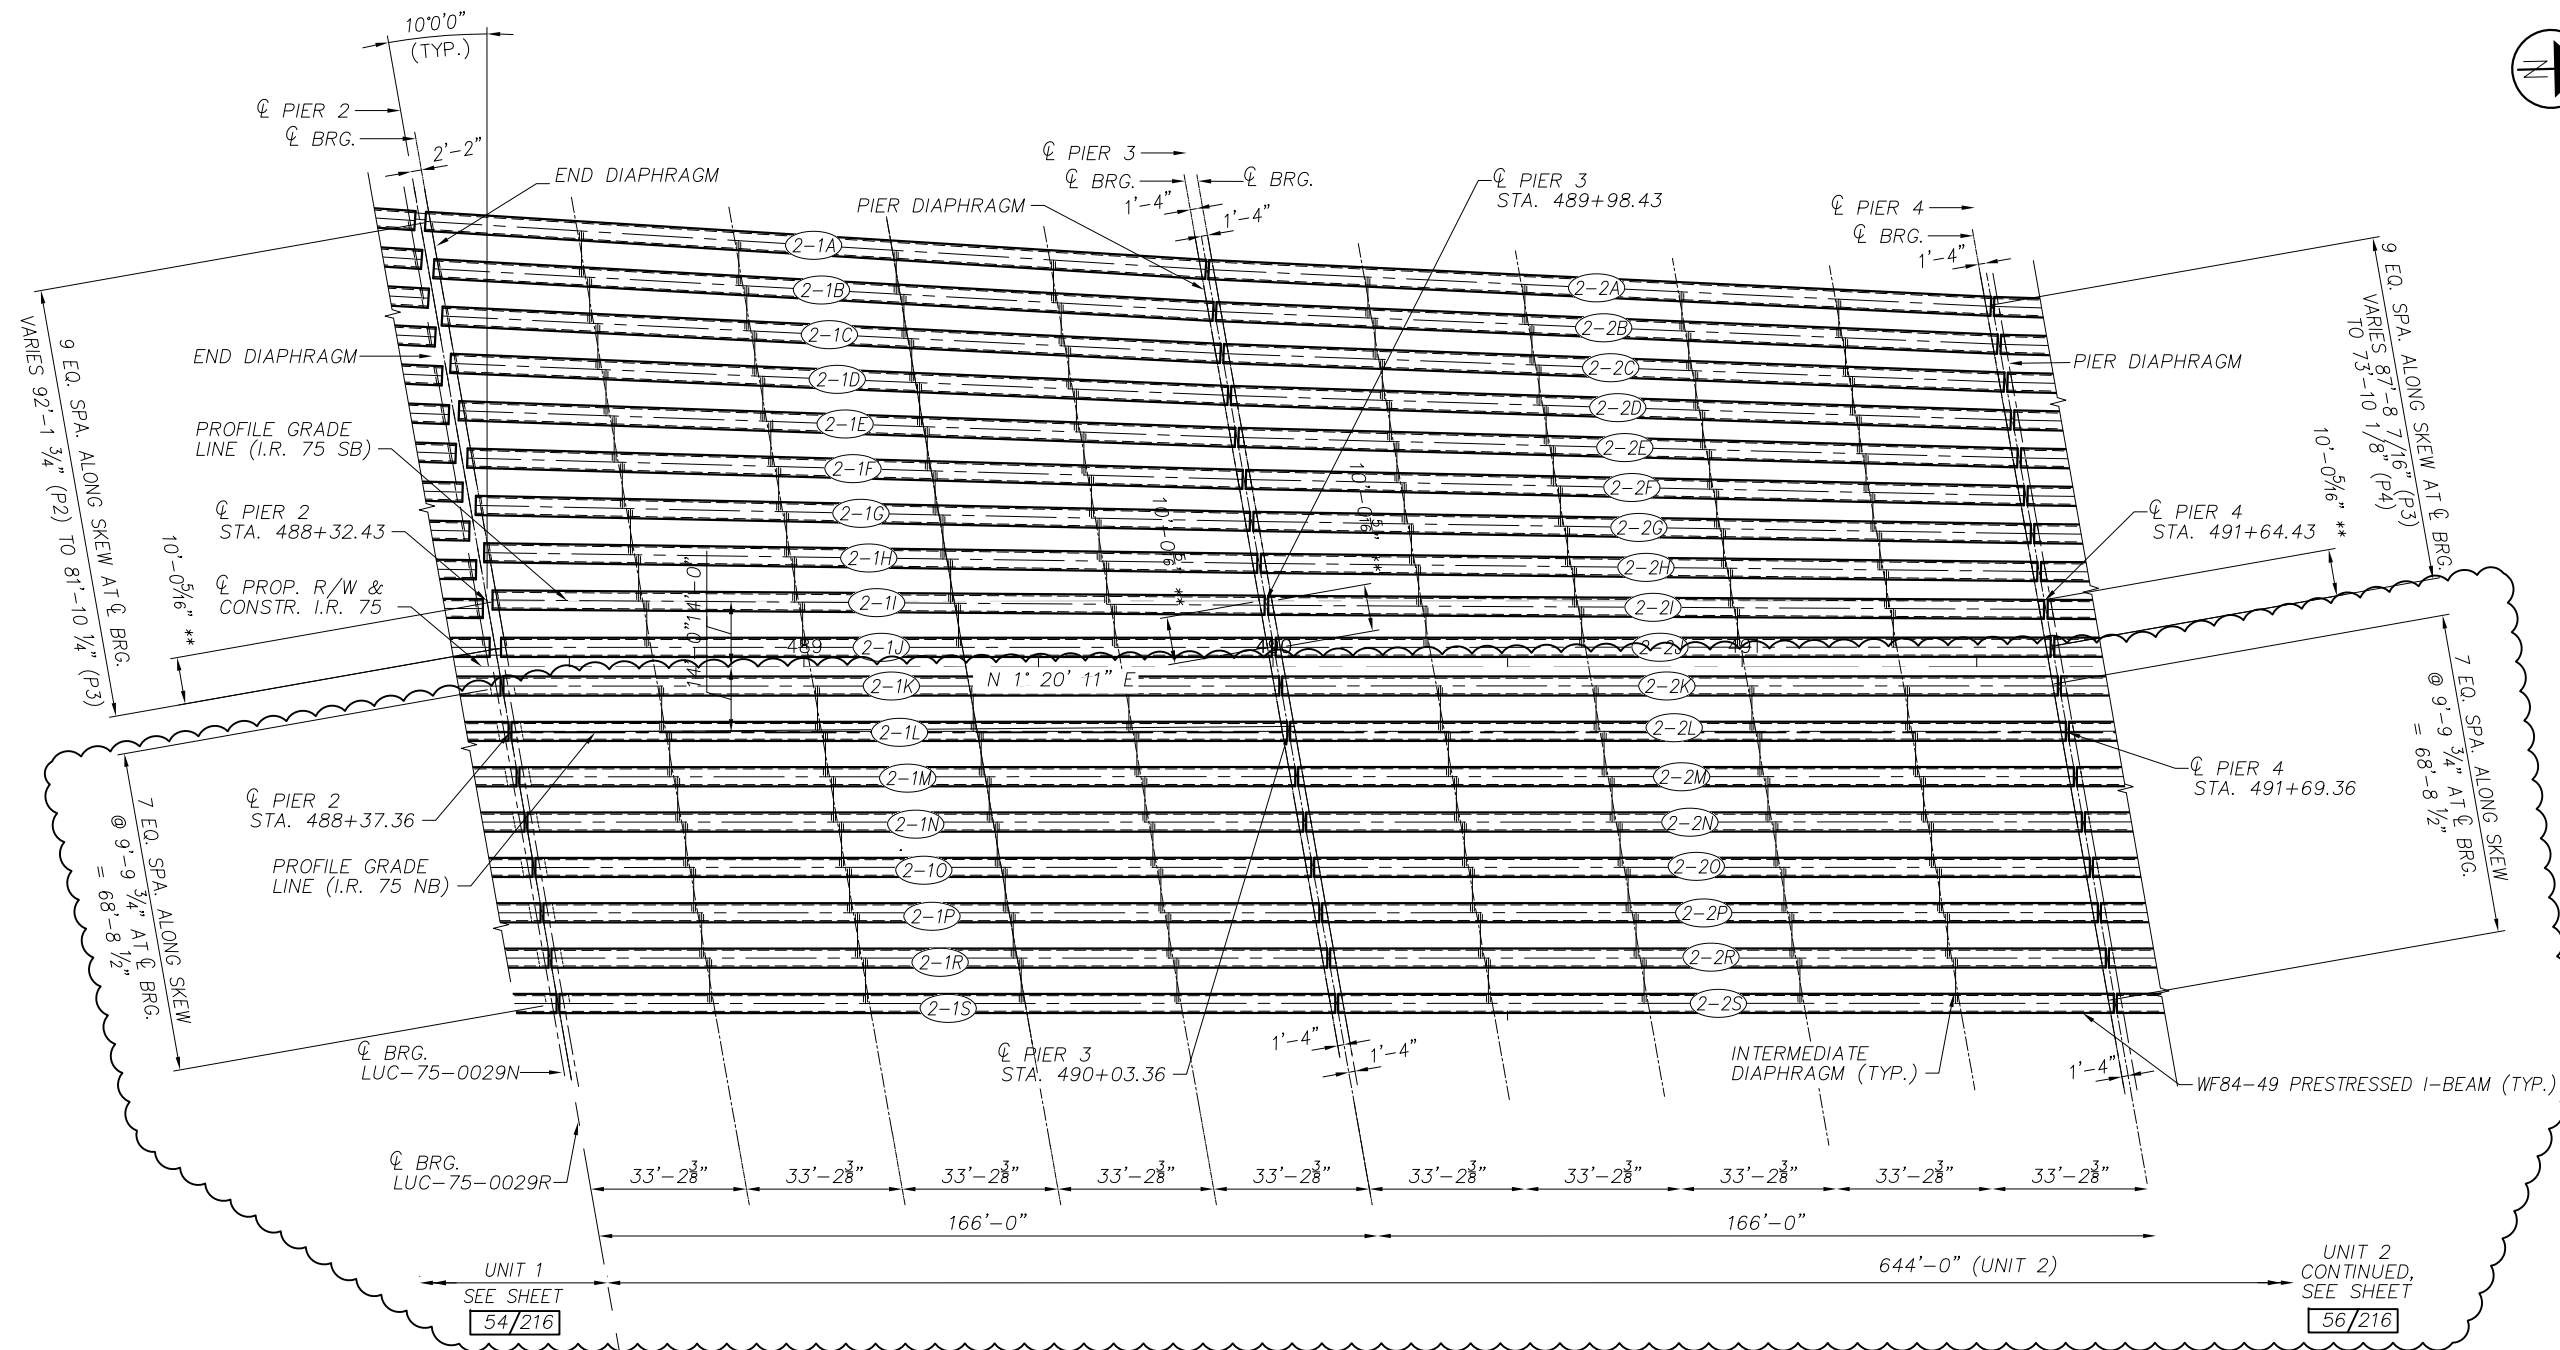


**FRAMING PLAN (UNIT 2)**  
 NORTHBOUND AND SOUTHBOUND BRIDGES

**NOTE:**  
 1. SEE SHEET **54/216** FOR LEGEND AND NOTES.

5/1/2020 JANSSEN & SPAANS ENGINEERING INC. - RECONFIGURED NORTHBOUND ON RAMP		DESIGN AGENCY <b>AECOM</b> 654 WHITE POND DRIVE AKRON, OHIO 44320-1100 (330) 636-9111
DRAWN MRW	CHECKED CRG	DATE 8/18
DESIGNED MRW		STRUCTURE FILE NUMBER 4802765/4802767
FRAMING PLAN - 2 OF 6 BRIDGE NO. LUC-75-0029 L/R I.R. 75 OVER MAUMEE RIVER		
W00/LUC-75- 30.70/0.00 PID No. 93592		55 / 216
1348 1792		

Date: Oct 07, 2020, 5:06pm User Name: mlongtin  
 File: P:\1321 - Toledo E Value Engineering\DWGS\BRIDGE\LUC-75-0027 over Maumee River\Sheets\072\_0027C\_S0001.dwg

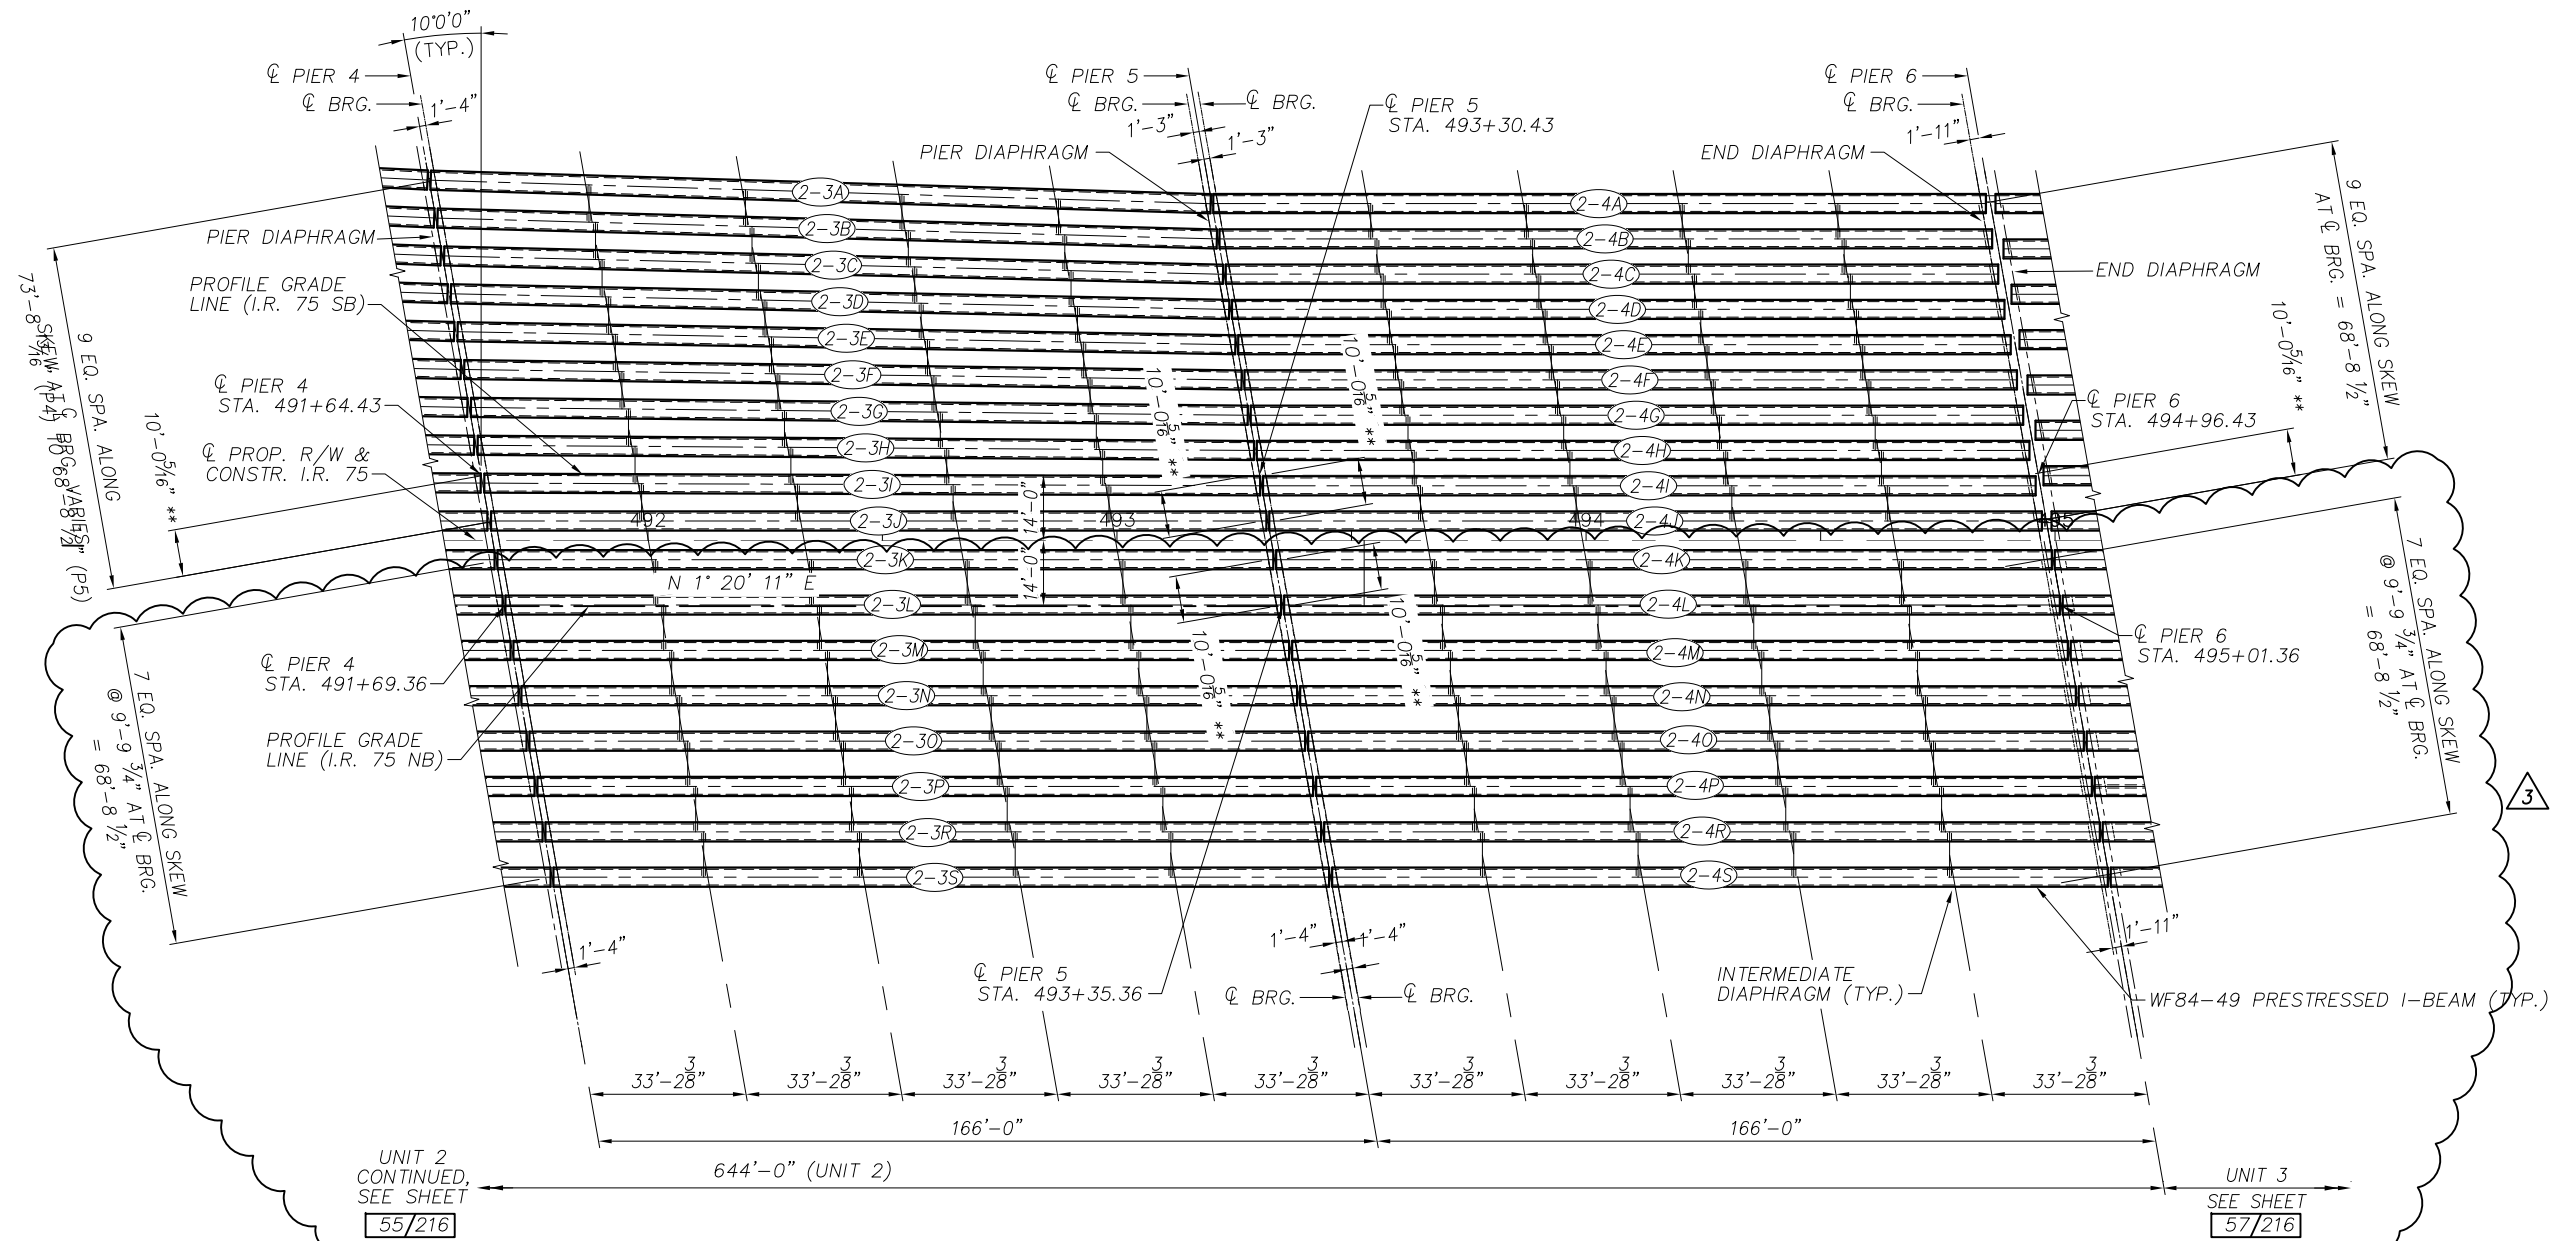


**FRAMING PLAN (UNIT 2)**  
 NORTHBOUND AND SOUTHBOUND BRIDGES

**NOTE:**  
 1. SEE SHEET 54/216 FOR LEGEND AND NOTES.

3 5/1/2020 JANSSEN & SPAANS ENGINEERING INC. - RECONFIGURED NORTHBOUND ON RAMP	DESIGNED	MRW	CHECKED	CRG
	DRAWN	CMA	REVIEWED	JTH
	DATE	8/18	REVIEWED	JTH
	STRUCTURE FILE NUMBER	4802765/4802767	DESIGN AGENCY	AECOM
			564 WHITE POND DRIVE AKRON, OHIO 44320-1100 (330) 636-9111	
FRAMING PLAN - 3 OF 6				
BRIDGE NO. LUC-75-0029 L/R				
I.R. 75 OVER MAUMEE RIVER				
W00/LUC-75-0027		56 / 216		
30.70/0.00		1349		
PID No. 93592		1792		

Date: Oct 07, 2020, 5:06pm User Name: mlongtin  
 File: P:\11321 - Toledo E Value Engineering\DWG\5\BRIDGE\LUC-75-0027 over Maumee River\Sheets\075\_0027C\_S0001.dwg

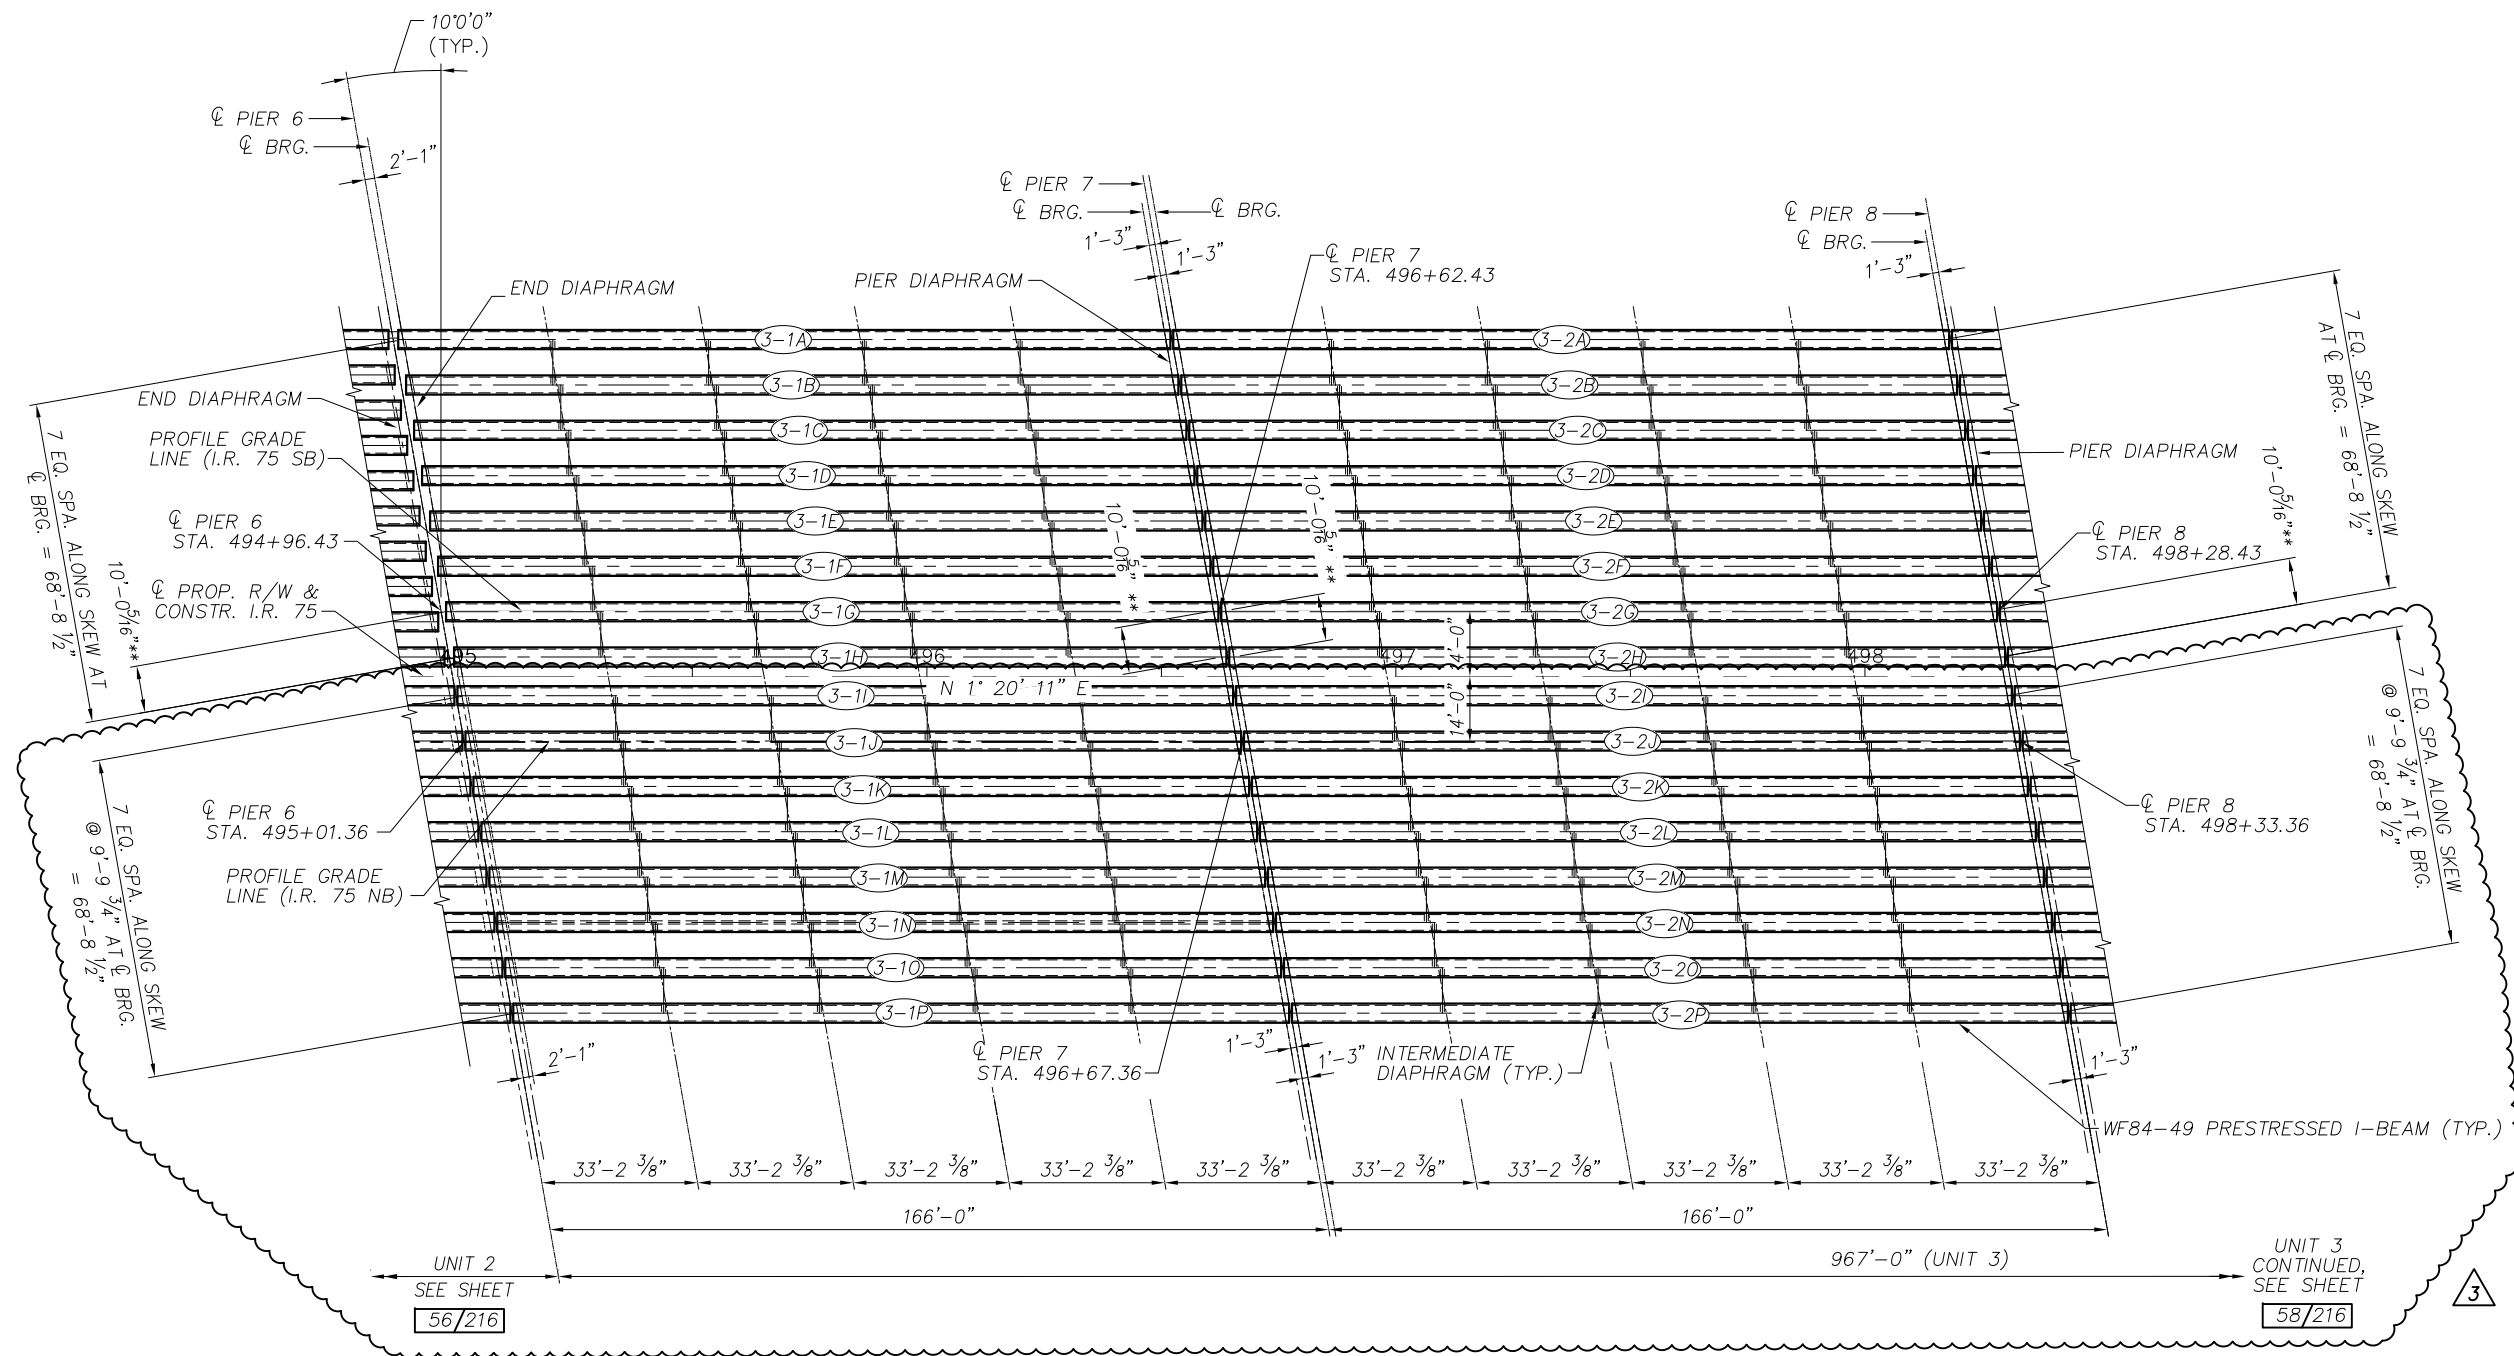

**FRAMING PLAN (UNIT 3)**  
 NORTHBOUND AND SOUTHBOUND BRIDGES



3 5/1/2020 JANSSEN & SPAANS ENGINEERING INC.  
 - RECONFIGURED NORTHBOUND ON RAMP

DESIGNED	MRW	CHECKED	CRG
DRAWN	CMA	REVIEWED	JTH
DATE	8/18	STRUCTURE FILE NUMBER	4802765/4802767
DESIGN AGENCY	AECOM		
654 WHITE POND DRIVE AKRON, OHIO 44320-1100 (330) 636-9111			

FRAMING PLAN - 4 OF 6  
 BRIDGE NO. LUC-75-0029 L/R  
 I.R. 75 OVER MAUMEE RIVER

W00/LUC-75-  
 30.70/0.00  
 PID No. 93592


57 / 216

1350  
 1792


**NOTE:**  
 1. SEE SHEET 54/216 FOR LEGEND AND NOTES.

Date: Oct 07, 2020, 5:05pm User Name: mlongtin  
 File: P:\11321 - Toledo E Value Engineering\DWG\BRIDGE\LUC-75-0027 over Maumee River\Sheets\075\_0027C\_S0002.dwg


VARIABLE	SHEAR REINFORCING SPACING TABLE																							
	BEAM MARK																							
	1-1A THRU 1-1L	1-1M THRU 1-1U	1-2A THRU 1-2L	1-2M THRU 1-2U	2-1A THRU 2-1J	2-1K THRU 2-1S	2-2A THRU 2-2J	2-2K THRU 2-2S	2-3A THRU 2-3J	2-3K THRU 2-3S	2-4A THRU 2-4J	2-4K THRU 2-4S	3-1A THRU 3-1H	3-1I THRU 3-1P	3-2A THRU 3-2H	3-2I THRU 3-2P	3-3A THRU 3-3H	3-3I THRU 3-3P	3-4A THRU 3-4H	3-4I THRU 3-4P	3-5A THRU 3-5H	3-5I THRU 3-5P	3-6A THRU 3-6H	3-6I THRU 3-6P
(B)	6	8	6	8	6	8	6	8	6	8	6	8	6	8	6	8	6	8	6	8	6	8	6	8
(C)	11	15	11	15	11	15	11	15	11	15	11	15	11	15	11	15	11	15	11	15	11	15	11	15
(D)	1'-8"	2'-4"	1'-8"	2'-4"	1'-8"	2'-4"	1'-8"	2'-4"	1'-8"	2'-4"	1'-8"	2'-4"	1'-8"	2'-4"	1'-8"	2'-4"	1'-8"	2'-4"	1'-8"	2'-4"	1'-8"	2'-4"	1'-8"	2'-4"
(E)	20	19	50	50	50	50	50	50	50	50	50	50	50	50	50	50	50	50	50	50	56	50	50	50
(F)	9'-6"	9'-0"	24'-6"	24'-6"	24'-6"	24'-6"	24'-6"	24'-6"	24'-6"	24'-6"	24'-6"	24'-6"	24'-6"	24'-6"	24'-6"	24'-6"	24'-6"	24'-6"	24'-6"	24'-6"	27'-6"	24'-6"	24'-6"	24'-6"

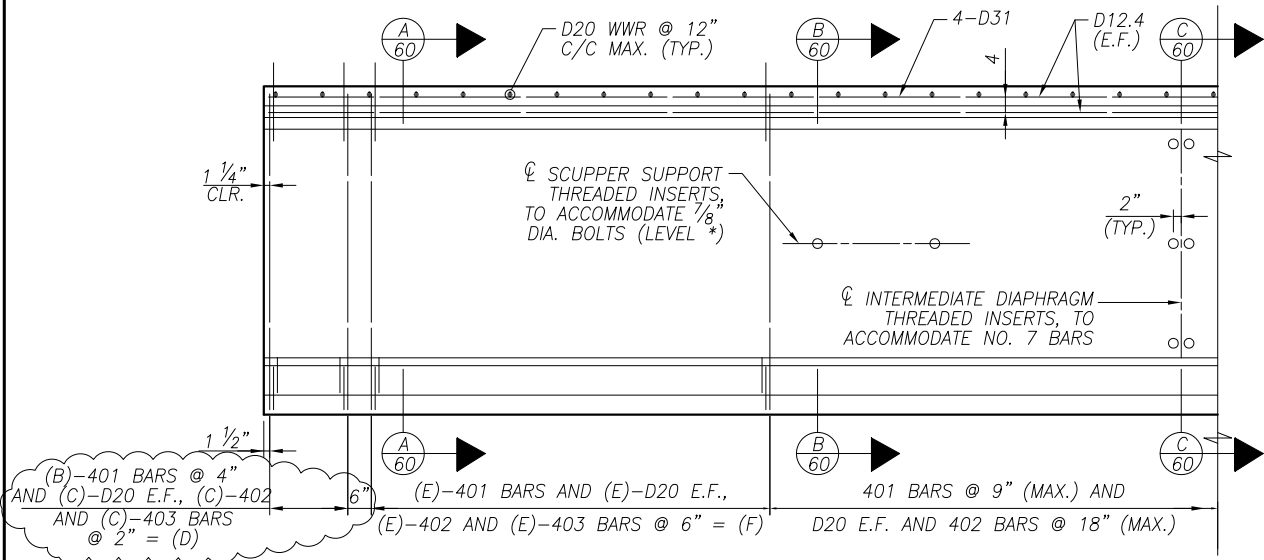

**BEAM ELEVATION - SHEAR REINFORCING**  
 (STRANDS NOT SHOWN FOR CLARITY)

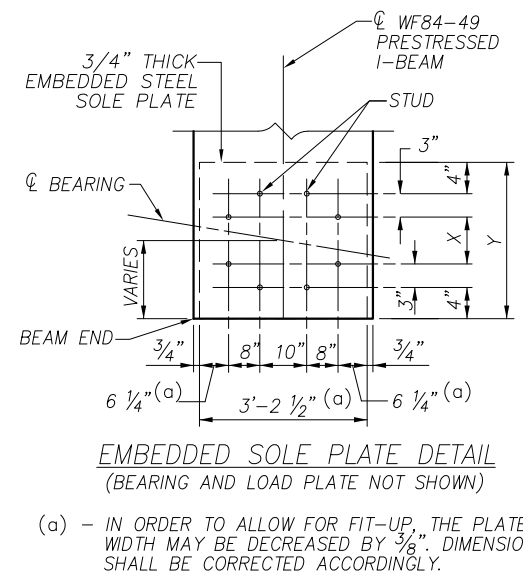

		EMBEDDED SOLE PLATE TABLE																	
		X	9"			10"			11"			1'-0"			1'-1"				
		Y	1'-11"			2'-0"			2'-1"			2'-2"			2'-3"				
BEAM LOCATIONS	NORTHBOUND	UNIT	3	3	3	1	1	2	2	2	3	3	-	-	3	-	-	-	2
	SPAN	3	4	5	1	2	2	3	4	2	6	-	-	1	-	-	-	1	
SOUTHBOUND	UNIT	3	3	-	2	3	3	-	-	-	2	2	3	1	1	2	3	-	
	SPAN	2	3	-	4	4	5	-	-	-	2	3	1	1	2	1	6	-	

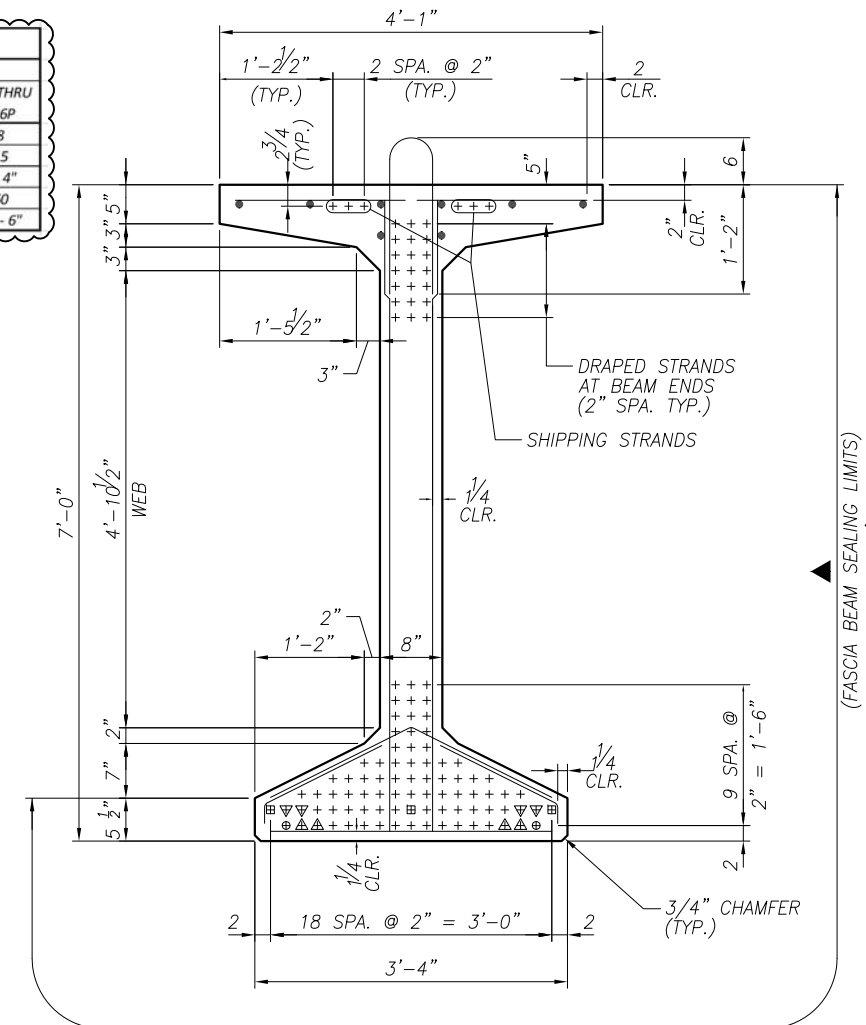

▽ = DEBOND STRANDS 4'-0" FROM EACH END OF BEAM  
 ⊕ = DEBOND STRANDS 8'-0" FROM EACH END OF BEAM  
 ⊙ = DEBOND STRANDS 12'-0" FROM EACH END OF BEAM  
 △ = DEBOND STRANDS 16'-0" FROM EACH END OF BEAM


DEBONDING APPLIES TO ALL BEAMS EXCEPT THOSE IN...  
 - UNIT 1 - SPAN 1  
 - UNIT 3 - SPAN 6

**TYPICAL BEAM SECTION**

**LEGEND:**  
 ▲ ITEM 512 - SEALING OF CONCRETE SURFACES (EPOXY URETHANE)  
 \* INSERT LOCATIONS MAY BE ADJUSTED BY UP TO 5 INCHES TO AVOID INTERFERENCE WITH DRAPED STRANDS. SPACING BETWEEN INSERTS SHALL NOT BE LESS THAN 1'-10".

**NOTES:**  
 1. ALL REINFORCING SHOWN SHALL BE PAID FOR UNDER ITEM 515.  
 2. ALL REINFORCING IS DIMENSIONED OUT-TO-OUT.  
 3. FOR ADDITIONAL NOTES AND DETAILS NOT SHOWN, SEE STD. DWG. PSID-1-13.  
 4. FOR BEAM STRAND LAYOUT, SEE SHEETS [61/216] THRU [70/216].  
 5. EACH BEAM MARK DESIGNATES ITS UNIT, SPAN AND BEAM. THE FIRST NUMBER INDICATES THE UNIT. THE NEXT NUMBER INDICATES THE SPAN OF THE UNIT AND THE FINAL LETTER INDICATES THE BEAM NUMBER FOR THAT SPAN.

EXAMPLE: 3-4K  
 BEAM K  
 SPAN 4  
 UNIT 3

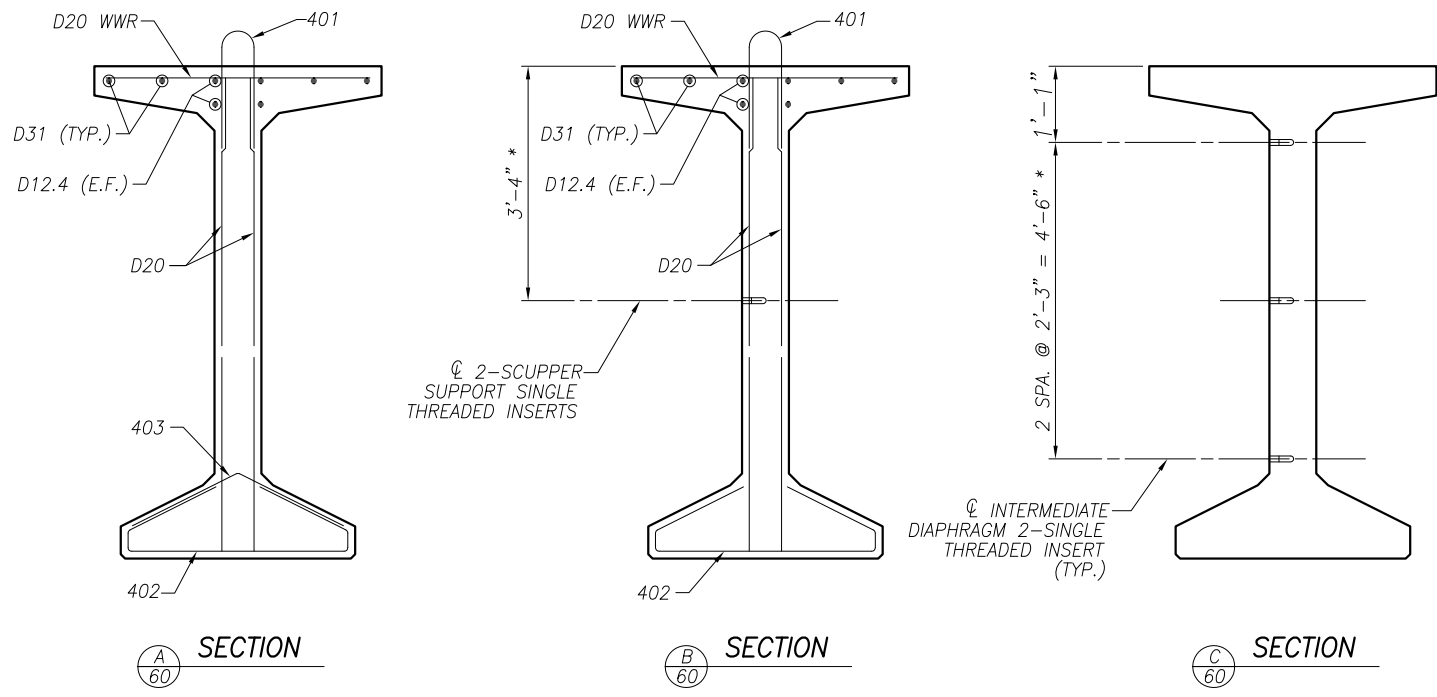

		BENDING TABLE			
MARK	TYPE	DIMENSIONS			
		A	B	C	D
401	1	5 1/2"	1'-8"	-	-
402	2	3'-1 1/2"	3 1/2"	7 1/2"	1'-3"
403	5	9"	1'-6"	-	-

DESIGNED BY: MRW  
 CHECKED BY: CRG  
 DRAWN BY: CMA  
 REVISIONS: 1

DATE: 8/18  
 JTH  
 STRUCTURE FILE NUMBER: 4802765/4802767

DESIGN AGENCY: AECOM  
 564 WHITE POND DRIVE  
 AKRON, OHIO 44320-1100  
 (330) 836-9111


5/1/2020 JANSSEN & SPAANS ENGINEERING INC.  
 RECONFIGURED NORTHBOUND ON RAMP

BRIDGE NO. LUC-75-0029 L/R  
 I.R. 75 OVER MAUMEE RIVER


W00/LUC-75-30.70/0.00  
 PID No. 93592

60/216  
 1353  
 1792





Date: Oct 07, 2020, 5:05pm User Name: mlongtin  
 File: P:\11321 - Toledo E Value Engineering\DWG\51BRIDGE\LUC-75-0027 over Maumee River\Sheets\07\_0027C\_S0008.dwg

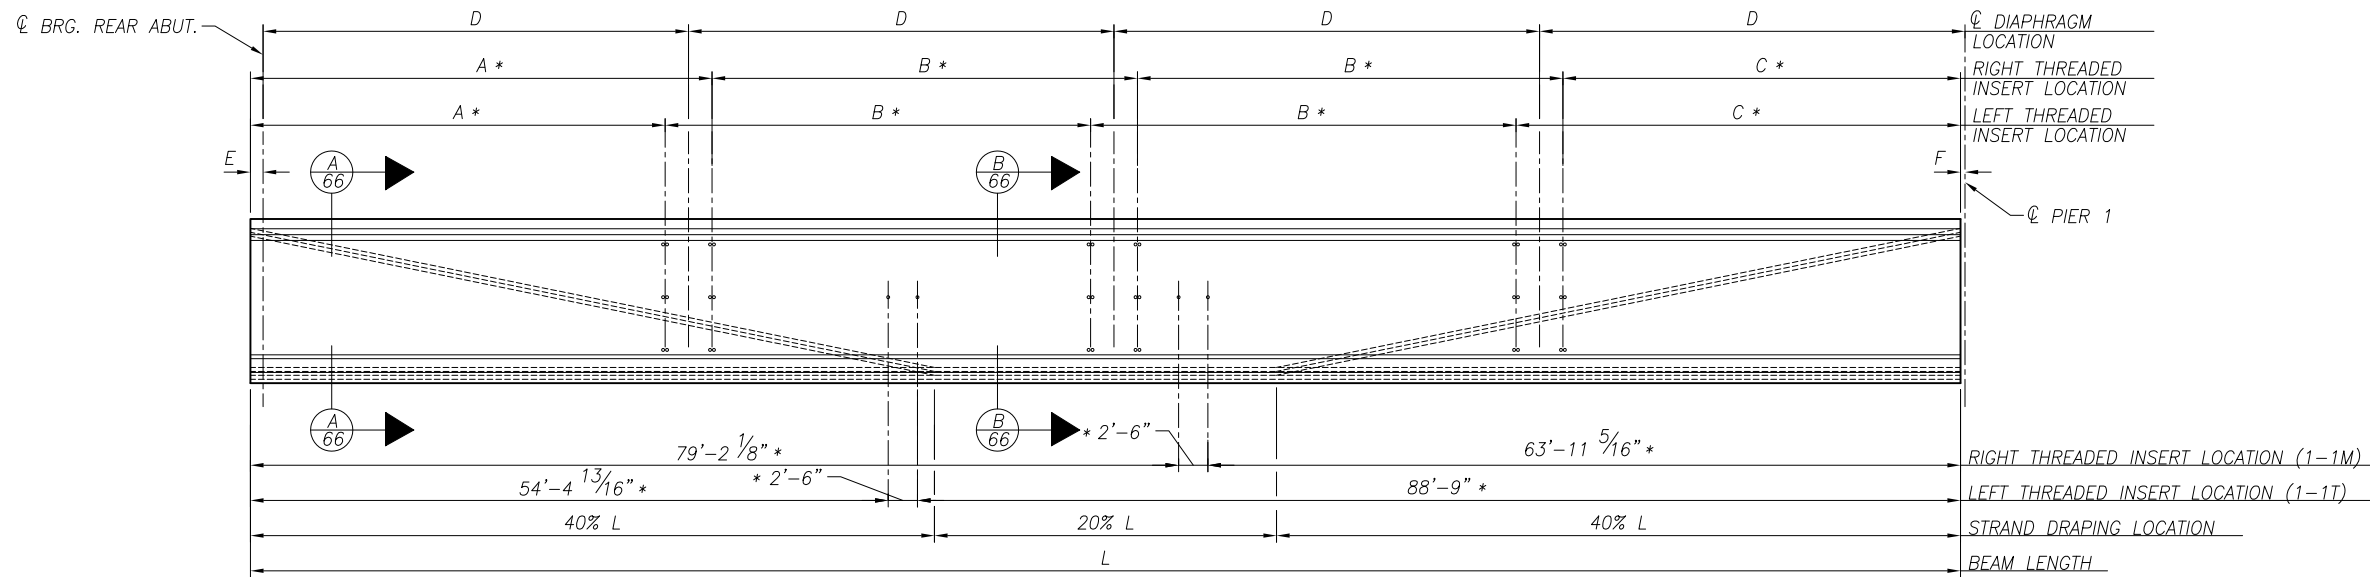

**BEAM ELEVATION**  
 1-1M THRU 1-1U  
 (SHEAR REINFORCING NOT SHOWN FOR CLARITY)

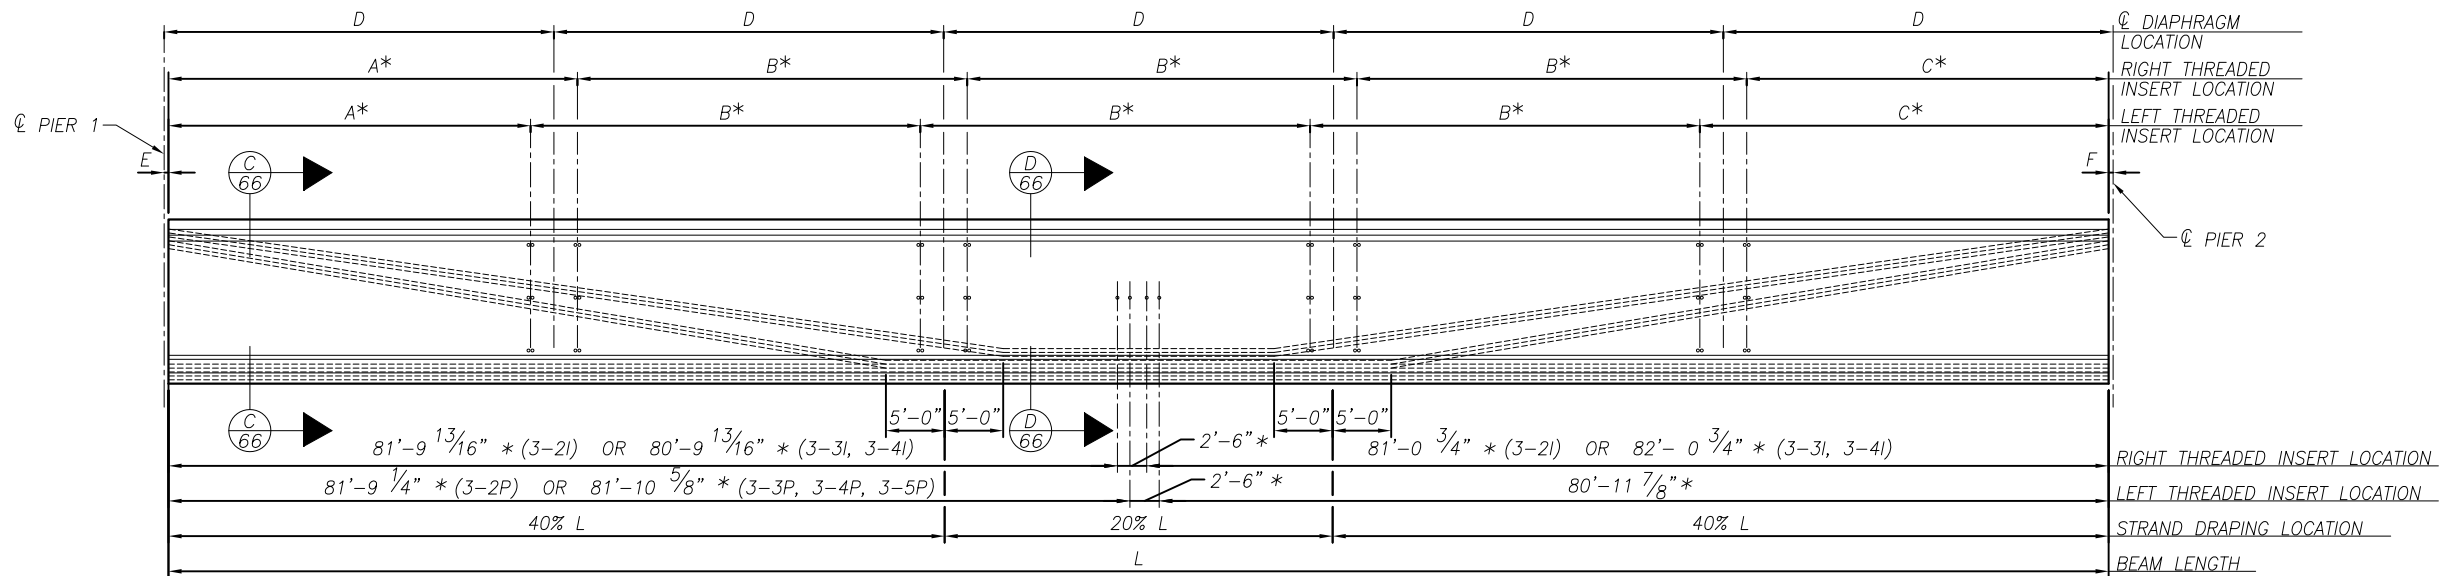

**BEAM ELEVATION**  
 1-2M THRU 1-2U  
 (SHEAR REINFORCING NOT SHOWN FOR CLARITY)

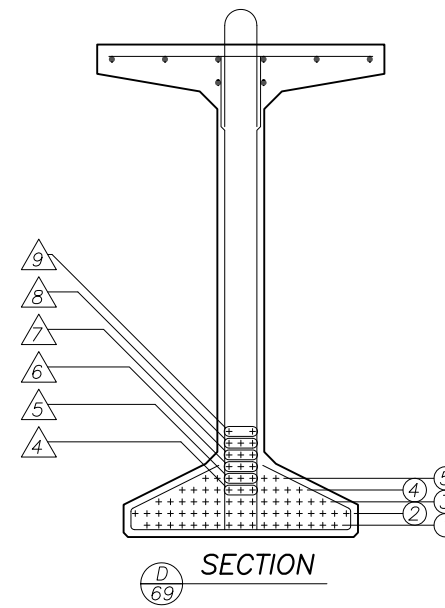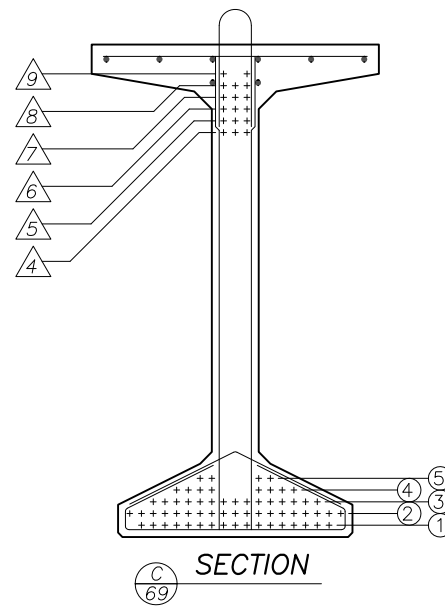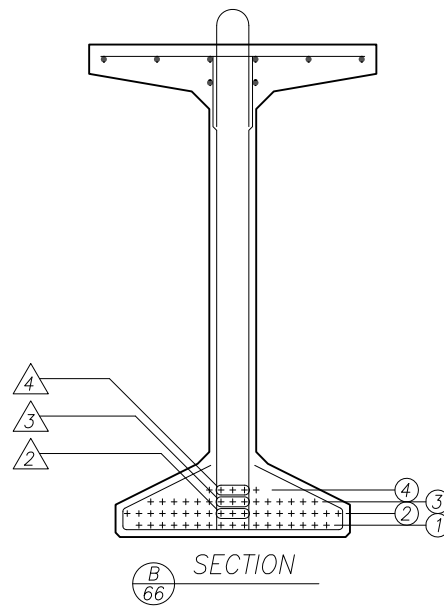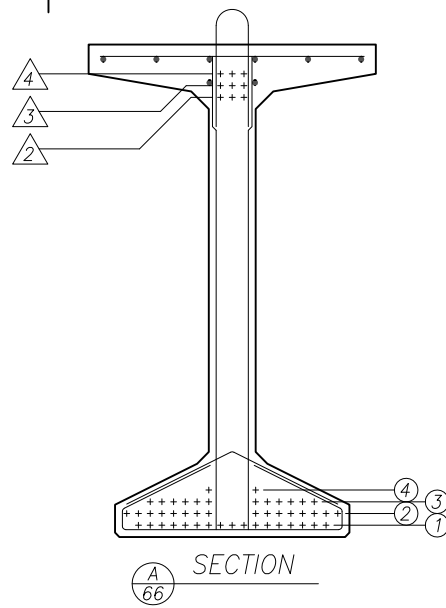

**LEGEND:**  
 \* MEASURED ALONG FACE OF WEB.

- NOTES:**
- FOR SHEAR REINFORCING, TYPICAL SECTIONS, DIAPHRAGM THREADED INSERT SPACING AND ADDITIONAL NOTES, SEE SHEET [60/216].
  - FOR DIMENSIONS A, B, C, D, E, F AND L, SEE SHEET [71/216].
  - FOR ADDITIONAL DIAPHRAGM SPACING LAYOUT, SEE STD. DWG. PSID-1-13 (SKEW ANGLES GREATER THAN 10 DEGREES) AND FRAMING PLANS [54/216] THRU [59/216].
  - FOR THE NUMBER OF STRANDS PER ROW, SEE TABLE ON SHEET [70/216].
  - ALL DIMENSIONS MEASURED ALONG  $\phi$  BEAM UNLESS OTHERWISE NOTED.

5/1/2020 JANSSEN & SPAANS ENGINEERING INC. - SHEET REPLACED

DESIGN AGENCY  
**JANSSEN & SPAANS ENGINEERING, INC.**  
 9120 HARRISON PARK COURT  
 INDIANAPOLIS, IN 46216

DESIGNED	WJZ	CBS
DRAWN	REM	REVIS
DATE	5/2020	
WJZ	STRUCTURE FILE NUMBER	4802765/4802767


PRESTRESSED I-BEAM DETAILS - UNIT 1 NORTHBOUND  
 BRIDGE NO. LUC-75-0029 L/R  
 I.R. 75 OVER MAUMEE RIVER

WJZ/LUC-75-  
 30.70/0.00  
 PID No. 93592


66 / 216

1359  
 1792

Date: Oct 07, 2020, 5:05pm User Name: mlongtin  
 File: P:\1321 - Toledo E Value Engineering\DWGS\BRIDGE\LUC-75-0027 over Maumee River\Sheets\075\_0027C\_SD0009.dwg

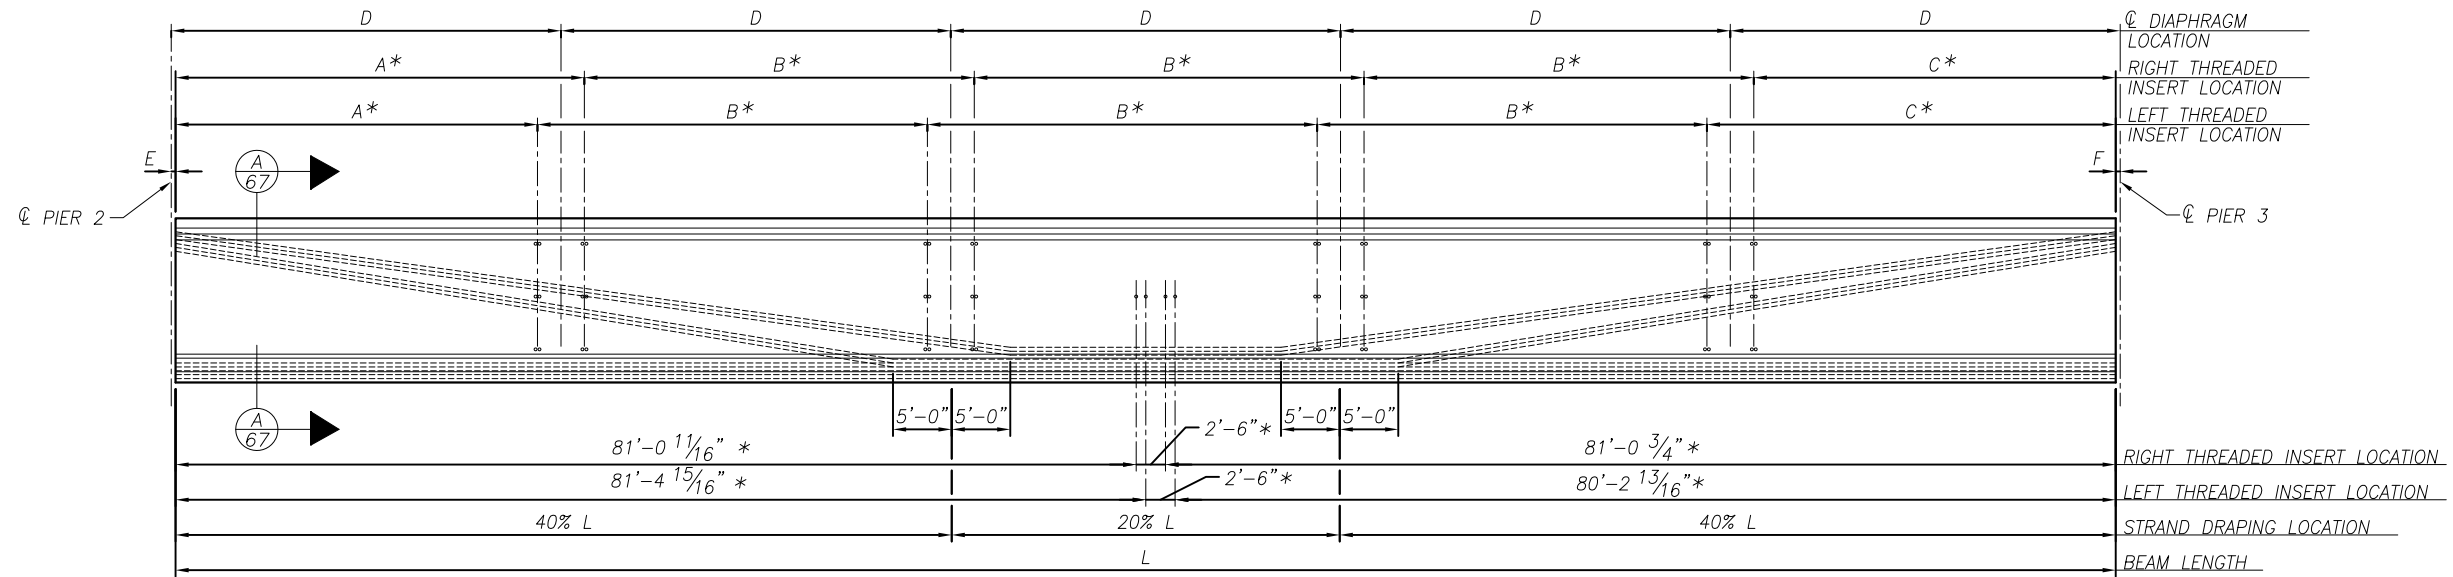

**BEAM ELEVATION**  
 2-1K THRU 2-1S, 2-2K THRU 2-2S, 2-3K THRU 2-3S, 2-4K THRU 2-4S  
 (SHEAR REINFORCING NOT SHOWN FOR CLARITY)

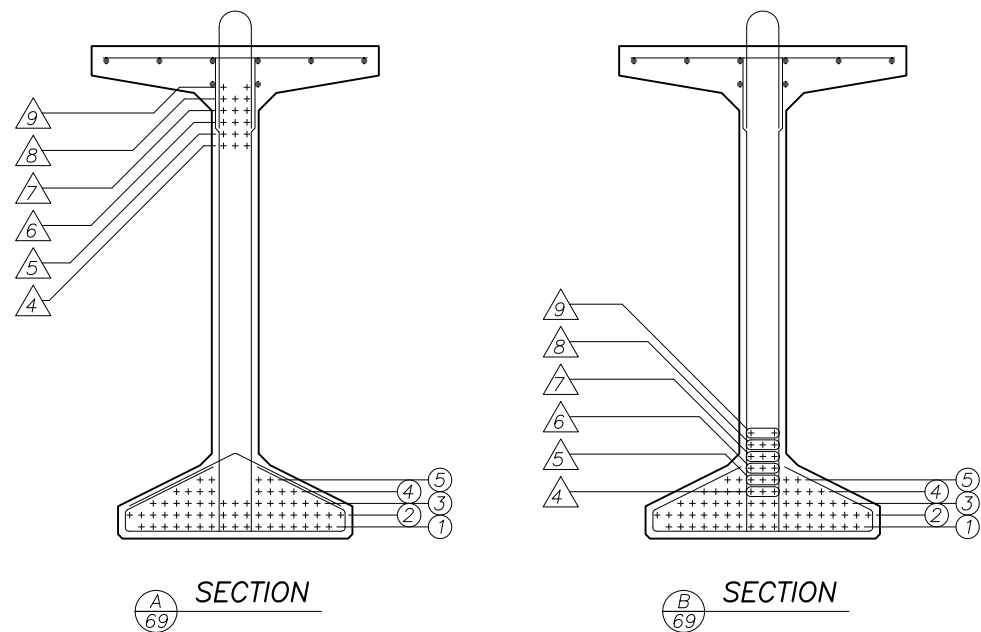

**LEGEND:**

\* MEASURED ALONG FACE OF WEB.

**NOTES:**

- FOR SHEAR REINFORCING, TYPICAL SECTIONS, DIAPHRAGM THREADED INSERT SPACING AND ADDITIONAL NOTES, SEE SHEET [60/216].
- FOR DIMENSIONS A, B, C, D, E, F AND L, SEE SHEET [71/216].
- FOR ADDITIONAL DIAPHRAGM SPACING LAYOUT, SEE STD. DWG. PSID-1-13 (SKEW ANGLES GREATER THAN 10 DEGREES) AND FRAMING PLANS [54/216] THRU [59/216].
- FOR THE NUMBER OF STRANDS PER ROW, SEE TABLE ON SHEET [70/216].
- ALL DIMENSIONS MEASURED ALONG  $\phi$  BEAM UNLESS OTHERWISE NOTED.

5/1/2020 JANSSEN & SPAANS ENGINEERING INC. - SHEET REPLACED

DESIGN AGENCY  
**JANSSEN & SPAANS ENGINEERING, INC.**  
 9120 HARRISON PARK COURT  
 INDIANAPOLIS, IN 46216

DESIGNED	WJZ	CBS
DRAWN	REM	REVISD
REVIEWED	WJZ	4802765/4802767
DATE	5/2020	
STRUCTURE FILE NUMBER		


PRESTRESSED I-BEAM DETAILS - UNIT 2 NORTHBOUND  
 BRIDGE NO. LUC-75-0029 L/R  
 I.R. 75 OVER MAUMEE RIVER

W00/LUC-75-  
 30.70/0.00  
 PID No. 93592


67 / 216

1360  
 1792


Date: Oct 08, 2020, 4:30pm User Name: mlongtin  
 File: P:\1321 - Toledo E Value Engineering\DWGS\BRIDGE\LUC-75-0027 over Maumee River\Sheets\075\_0027C\_S0010.dwg

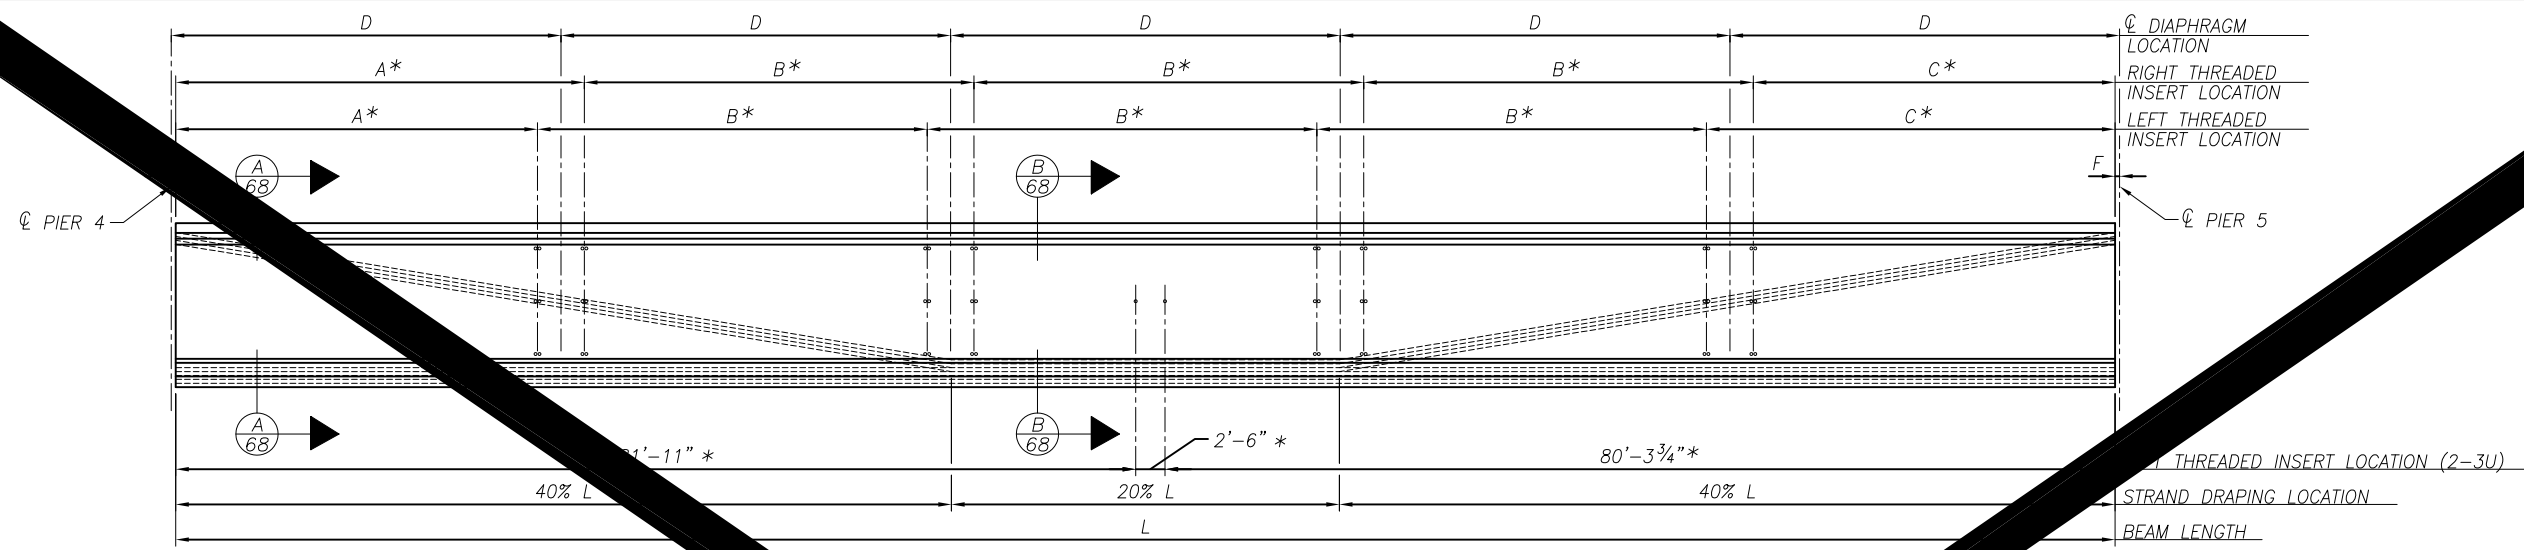


**BEAM ELEVATION**  
 2-3K THRU 2-3U  
 (SHEAR REINFORCING NOT SHOWN FOR CLARITY)

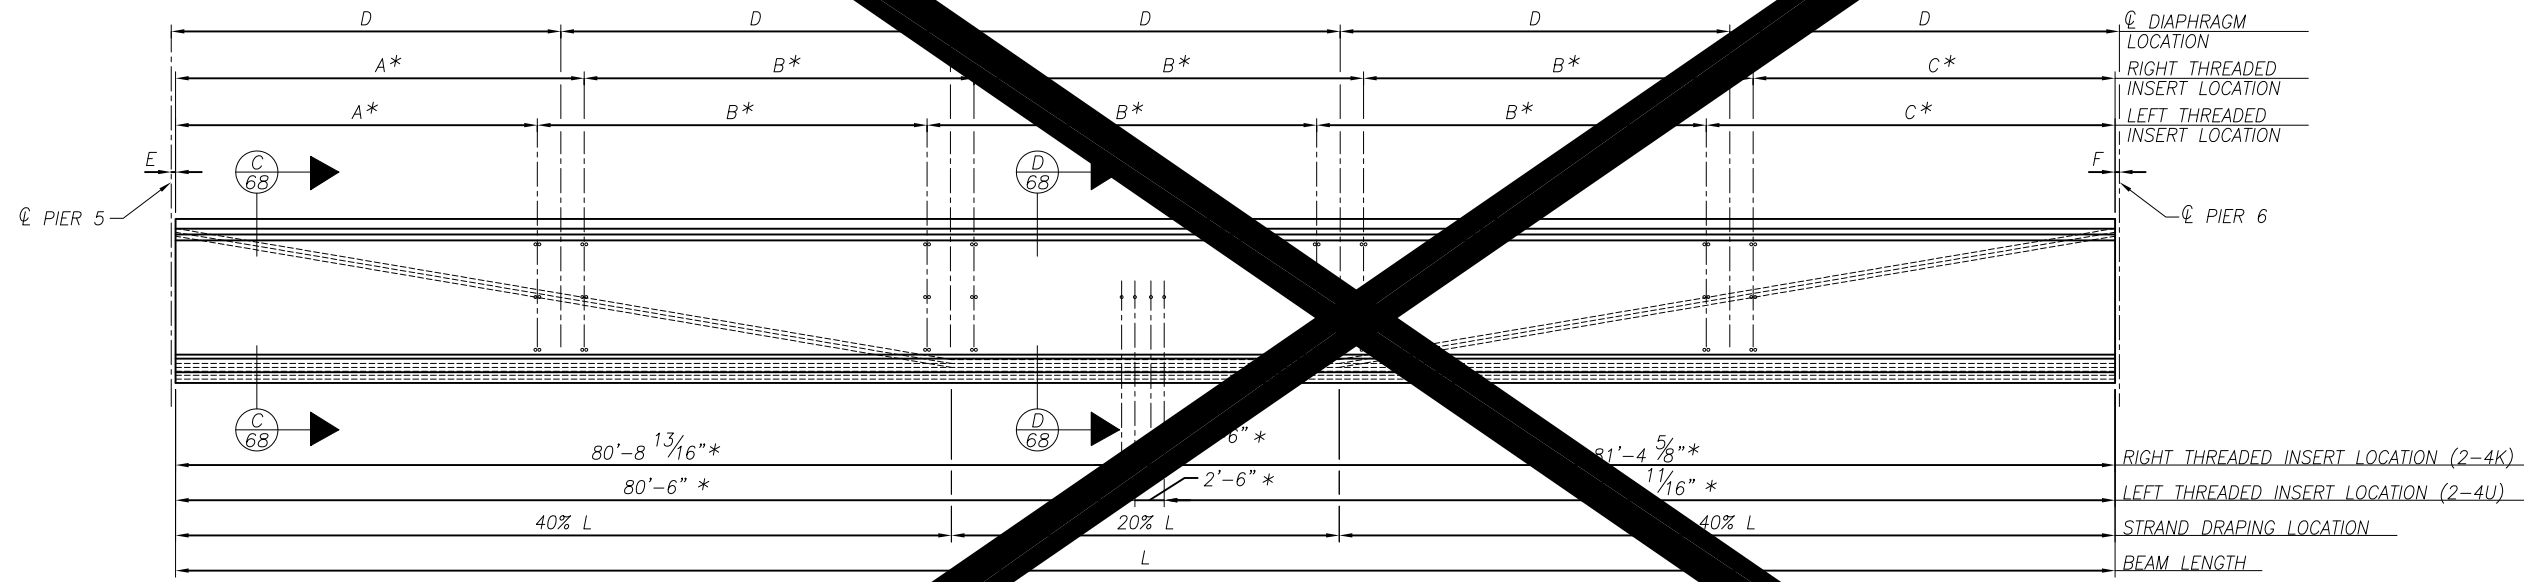


**BEAM ELEVATION**  
 2-4K THRU 2-4U  
 (SHEAR REINFORCING NOT SHOWN FOR CLARITY)

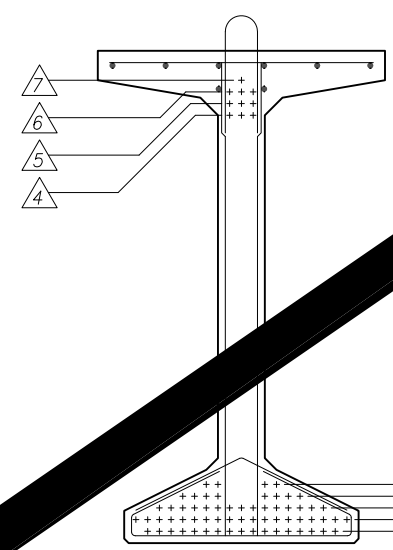


**SECTION**  
 A/68

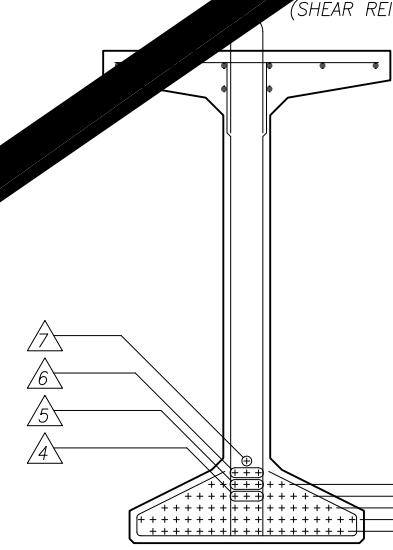

**SECTION**  
 B/68

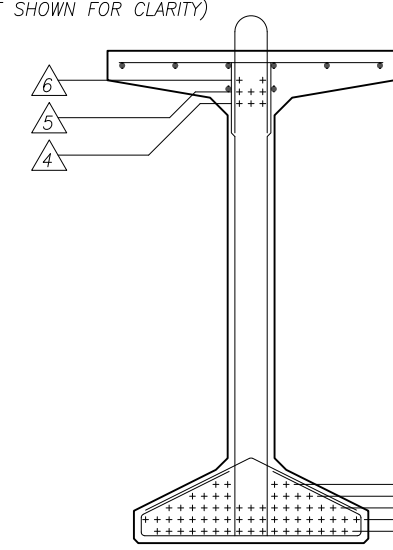

**SECTION**  
 C/68

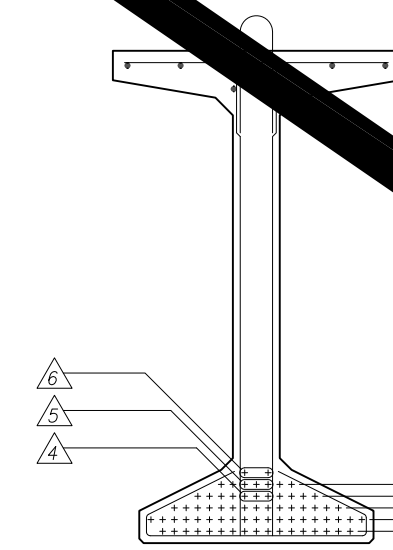

**SECTION**  
 D/68

- LEGEND:**
- \* MEASURED ALONG FACE OF WEB.
  - NOTES:
  - 1. FOR SHEAR REINFORCING, TYPICAL SECTIONS, SEE STANDARD DRAWING PSID-100 AND FOR STRAND THREADED INSERT SPACING AND ADDITIONAL NOTES, SEE SHEET [60/216].
  - 2. FOR DIMENSIONS A, B, C, D, E, F AND L, SEE SHEET [71/216].
  - 3. FOR ADDITIONAL DIAPHRAGM SPACING LAYOUT, SEE STD. DWG. PSID-100 FOR SKEW ANGLES GREATER THAN 10 DEGREES) AND FOR PLAN LAYOUTS [54/216] THRU [59/216].
  - 4. FOR THE NUMBER OF STRANDS PER SECTION, SEE TABLE ON SHEET [70/216].
  - 5. ALL DIMENSIONS MEASURED ALONG C/L BEAM UNLESS OTHERWISE NOTED.

3 5/1/2020 JANSSEN & SPANNS ENGINEERING INC. - SHEET REMOVED


DESIGNED	MRW	CMA	CHECKED	CRG
DRAWN	JTH	REVIS		
DATE	8/18	STRUCTURE FILE NUMBER	4802765/4802767	
DESIGN AGENCY	564 WHITE POND DRIVE AKRON, OHIO 44320-1100 <b>AECOM</b> (330) 636-9111			

PRESTRESSED I-BEAM DETAILS - UNIT 2 NORTHBOUND  
 BRIDGE NO. LUC-75-0029 L/R  
 I.R. 75 OVER MAUMEE RIVER



WOO/LUC-75-0027/0.00  
 30.70/0.00  
 PID No. 93592

68 / 216  
 1361 / 1792



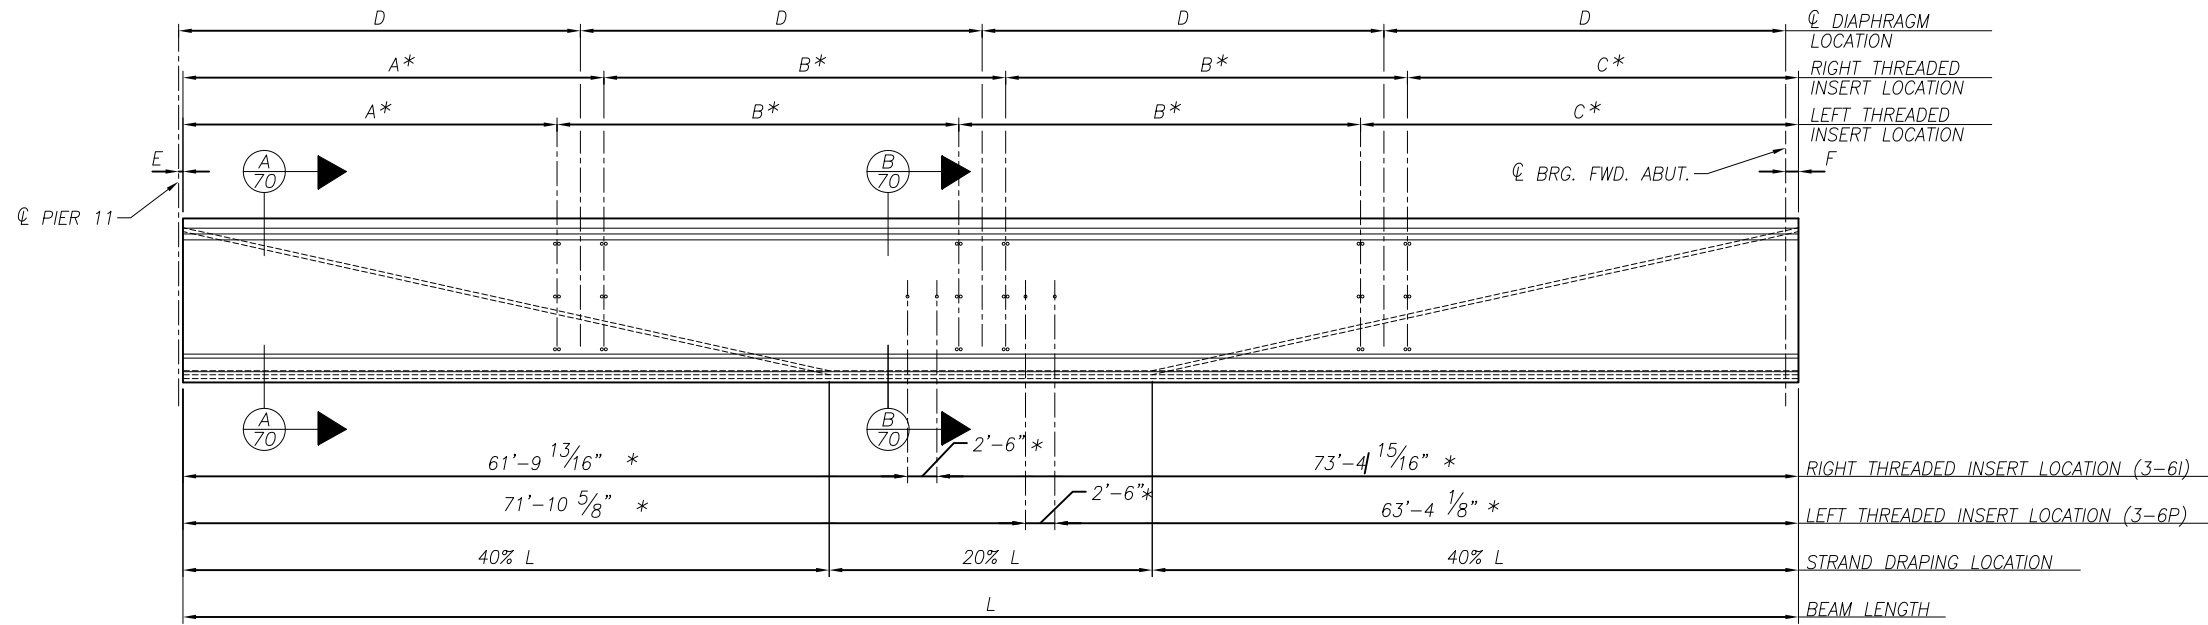

**BEAM ELEVATION**  
3-6I THRU 3-6P  
(SHEAR REINFORCING NOT SHOWN FOR CLARITY)

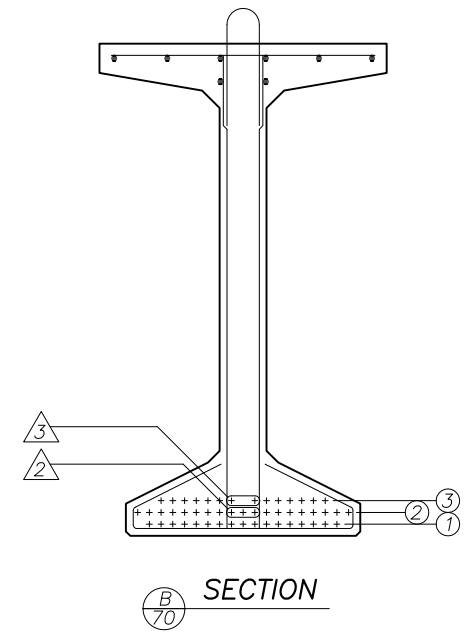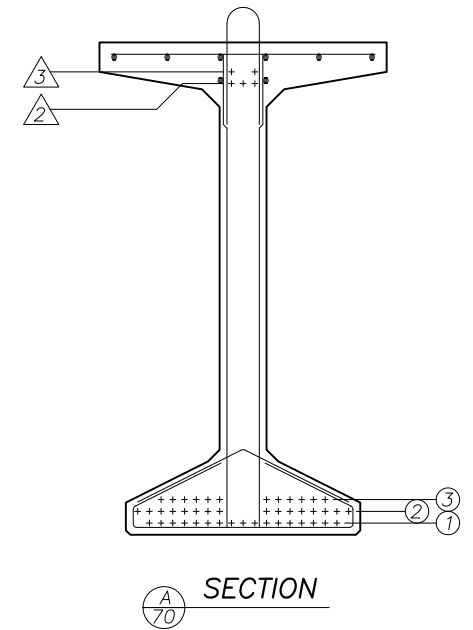

BEAM MARK	NUMBER OF STRANDS PER ROW														TOTAL STRANDS	CONCRETE STRENGTH	
	①	②	③	④	⑤	②	③	④	⑤	⑥	⑦	⑧	⑨	⑩		f'ci (KSI)	f'c (KSI)
1-1A THRU 1-1L	17	16	12	4		3	3	3	1						59	8	10
1-2A THRU 1-2L	17	19	15	8	4			3	3	3	3	1			76	8	10
2-1A THRU 2-1J	17	19	15	8	4			3	3	3	3	3	1		79	8	10
2-2A THRU 2-2J	17	19	15	8	4			3	3	3	2				74	8	10
2-3A THRU 2-3J	17	19	15	8	4			3	3	1					70	8	10
2-4A THRU 2-4J	17	19	15	8	2			3	2						66	8	10
3-1A THRU 3-1H	17	19	15	8	4			3	3	3	3	3	2		80	8	10
3-2A THRU 3-2H	17	19	15	8	4			3	3	3	3	3	2		80	8	10
3-3A THRU 3-3H	17	19	15	8	4			3	3	3	3	3	2		80	8	10
3-4A THRU 3-4H	17	19	15	8	4			3	3	3	3	3	3		81	8	10
3-5A THRU 3-5H	17	19	15	8	4			3	3	3	3	3	3	3	84	8	10
3-6A THRU 3-6H	17	16	12			3	3	3							54	8	10
1-1M THRU 1-1U	17	16	12	2		3	3	3							56	8	10
1-2M THRU 1-2U	17	19	15	8	4			3	3	3	3	3	2		80	8	10
2-1K THRU 2-1S	17	19	15	8	4			3	3	3	3	3	2		80	8	10
2-2K THRU 2-2S	17	19	15	8	4			3	3	3	3	3	2		80	8	10
2-3K THRU 2-3S	17	19	15	8	4			3	3	3	3	3	2		80	8	10
2-4K THRU 2-4S	17	19	15	8	4			3	3	3	3	3	2		80	8	10
3-1I THRU 3-1P	17	19	15	8	4			3	3	3	3	3	3	1	82	8	10
3-2I THRU 3-2P	17	19	15	8	4			3	3	3	3	3	2		80	8	10
3-3I THRU 3-3P	17	19	15	8	4			3	3	3	3	3	2		80	8	10
3-4I THRU 3-4P	17	19	15	8	4			3	3	3	3	3	2		80	8	10
3-5I THRU 3-5P	17	19	15	8	4			3	3	3	3	3	2		80	8	10
3-6I THRU 3-6P	17	16	12			3	2								50	8	10

LEGEND:

\* MEASURED ALONG FACE OF WEB.

NOTES:

- FOR SHEAR REINFORCING, TYPICAL SECTIONS, DIAPHRAGM THREADED INSERT SPACING AND ADDITIONAL NOTES, SEE SHEET [60/216].
- FOR DIMENSIONS A, B, C, D, E, F AND L, SEE SHEET [73/216].
- FOR ADDITIONAL DIAPHRAGM SPACING LAYOUT, SEE STD. DWG. PSID-1-13 (SKEW ANGLES GREATER THAN 10 DEGREES) AND FRAMING PLANS [54/216] THRU [59/216].
- ALL DIMENSIONS MEASURED ALONG | BEAM UNLESS OTHERWISE NOTED.

Date: Oct 07, 2020, 4:19pm User Name: mlongin File: P:\1321 - Toledo E Value Engineering\DWGS\BRIDGE\LUC-75-0027 over Maumee River\Sheets\075\_0027C\_S0012.dwg

DESIGN AGENCY  
**JANSSEN & SPAANS ENGINEERING, INC.**  
9120 HARRISON PARK COURT  
INDIANAPOLIS, IN 46216

REVIEWED  
DATE 8/18  
JTH  
STRUCTURE FILE NUMBER  
4802765/4802767

DRAWN  
KRO  
DESIGNED  
WOZ  
CHECKED  
CRG

5/1/2020 JANSSEN & SPAANS ENGINEERING INC. - TABLE UPDATED

PRESTRESSED I-BEAM DETAILS - UNIT 3 NORTHBOUND  
BRIDGE NO. LUC-75-0029 L/R  
I.R. 75 OVER MAUMEE RIVER

W00/LUC-75-  
30.70/0.00  
PID No. 93592

70 / 216

1363  
1792





Date: Oct 12, 2020, 3:55pm User Name: mlongtin  
 File: \\jbc.com\files\Projects\1321 - Toledo E. Value Engineering\DWG\BRIDGE\LUC-75-0027 over Maumee River\Sheets\075-0027C\_SD0068.dwg

CAMBER (NORTHBOUND BRIDGE - UNIT 1 (INCHES))																	
		SPAN 1								SPAN 2							
		1-1M	1-1N	1-1O	1-1P	1-1R	1-1S	1-1T	1-1U	1-1M	1-1N	1-1O	1-1P	1-1R	1-1S	1-1T	1-1U
DECK THICKNESS	A	8.5	8.5	8.5	8.5	8.5	8.5	8.5	8.5	8.5	8.5	8.5	8.5	8.5	8.5	8.5	
DECK THICKNESS @ CL BRG.	B	13.7155	13.7155	13.7155	13.7155	13.7155	13.7155	13.7155	13.7155	15.8805	15.6385	15.6385	15.6385	15.6385	15.6385	15.8805	
DECK THICKNESS @ MIDSPAN	C	11.3085	11.3085	11.3085	11.3085	11.3085	11.3085	11.3085	11.3085	11.3085	11.3085	11.3085	11.3085	11.3085	11.3085	11.3085	
ESTIMATED CAMBER AT TIME OF RELEASE (DAY 0 = D0)		2.392	2.392	2.392	2.392	2.392	2.392	2.392	2.392	4.204	4.204	4.204	4.204	4.204	4.204	4.204	
ESTIMATED CAMBER AT DAY 30 (D30)		4.209	4.209	4.209	4.209	4.209	4.209	4.209	4.209	7.401	7.401	7.401	7.401	7.401	7.401	7.401	
REMAINING DEAD LOAD DEFLECTION		1.803	1.803	1.803	1.803	1.803	1.803	1.803	1.803	2.831	3.072	3.072	3.072	3.072	3.072	2.831	

CAMBER (NORTHBOUND BRIDGE - UNIT 2 (INCHES))																	
		SPAN 1								SPAN 2							
		2-1K	2-1L	2-1M	2-1N	2-1O	2-1P	2-1R	2-1S	2-2K	2-2L	2-2M	2-2N	2-2O	2-2P	2-2R	2-2S
DECK THICKNESS	A	8.5	8.5	8.5	8.5	8.5	8.5	8.5	8.5	8.5	8.5	8.5	8.5	8.5	8.5	8.5	
DECK THICKNESS @ CL BRG.	B	15.8805	15.6385	15.6385	15.6385	15.6385	15.6385	15.6385	15.8805	15.8805	15.6385	15.6385	15.6385	15.6385	15.6385	15.8805	
DECK THICKNESS @ MIDSPAN	C	11.3085	11.3085	11.3085	11.3085	11.3085	11.3085	11.3085	11.3085	11.3085	11.3085	11.3085	11.3085	11.3085	11.3085	11.3085	
ESTIMATED CAMBER AT TIME OF RELEASE (DAY 0 = D0)		4.204	4.204	4.204	4.204	4.204	4.204	4.204	4.204	4.204	4.204	4.204	4.204	4.204	4.204	4.204	
ESTIMATED CAMBER AT DAY 30 (D30)		7.401	7.401	7.401	7.401	7.401	7.401	7.401	7.401	7.401	7.401	7.401	7.401	7.401	7.401	7.401	
REMAINING DEAD LOAD DEFLECTION		2.831	3.072	3.072	3.072	3.072	3.072	3.072	2.831	2.831	3.072	3.072	3.072	3.072	3.072	2.831	

CAMBER (NORTHBOUND BRIDGE - UNIT 2 (INCHES))																	
		SPAN 3								SPAN 4							
		2-3K	2-3L	2-3M	2-3N	2-3O	2-3P	2-3R	2-3S	2-4K	2-4L	2-4M	2-4N	2-4O	2-4P	2-4R	2-4S
DECK THICKNESS	A	8.5	8.5	8.5	8.5	8.5	8.5	8.5	8.5	8.5	8.5	8.5	8.5	8.5	8.5	8.5	
DECK THICKNESS @ CL BRG.	B	15.8805	15.6385	15.6385	15.6385	15.6385	15.6385	15.6385	15.8805	15.8805	15.6385	15.6385	15.6385	15.6385	15.6385	15.8805	
DECK THICKNESS @ MIDSPAN	C	11.3085	11.3085	11.3085	11.3085	11.3085	11.3085	11.3085	11.3085	11.3085	11.3085	11.3085	11.3085	11.3085	11.3085	11.3085	
ESTIMATED CAMBER AT TIME OF RELEASE (DAY 0 = D0)		4.204	4.204	4.204	4.204	4.204	4.204	4.204	4.204	4.204	4.204	4.204	4.204	4.204	4.204	4.204	
ESTIMATED CAMBER AT DAY 30 (D30)		7.401	7.401	7.401	7.401	7.401	7.401	7.401	7.401	7.401	7.401	7.401	7.401	7.401	7.401	7.401	
REMAINING DEAD LOAD DEFLECTION		2.831	3.072	3.072	3.072	3.072	3.072	3.072	2.831	2.831	3.072	3.072	3.072	3.072	3.072	2.831	

3 5/1/2020 JANSSEN & SPAANS ENGINEERING INC. - RECONFIGURED NORTHBOUND ON RAMP SHEET REPLACED

CAMBER TABLES - NORTHBOUND  
 BRIDGE NO. LUC-75-0029 L/R  
 I.R. 75 OVER MAUMEE RIVER

W00/LUC-75-30.70/0.00  
 PID No. 93592

DESIGN AGENCY  
 JANSSEN & SPAANS ENGINEERING, INC.  
 9120 HARRISON PARK COURT  
 INDIANAPOLIS, IN 46216

DATE  
 5/2020



REVIEWED  
 WJZ

STRUCTURE FILE NUMBER  
 4802765/4802767

DRAWN  
 KRO

CHECKED  
 CBS

Date: Oct 07, 2020, 4:22pm User Name: mlongtin  
 File: P:\1321 - Toledo E Value Engineering\DWGS\BRIDGE\LUC-75-0027 over Maumee River\Sheets\075\_0027C\_S0018.dwg

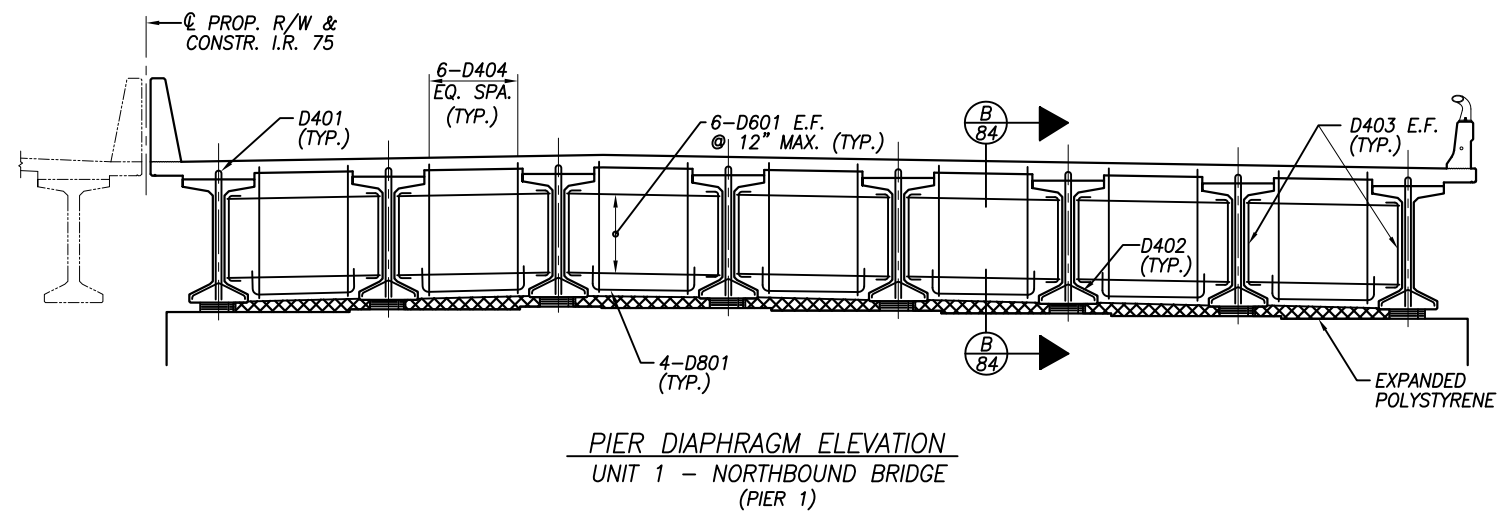
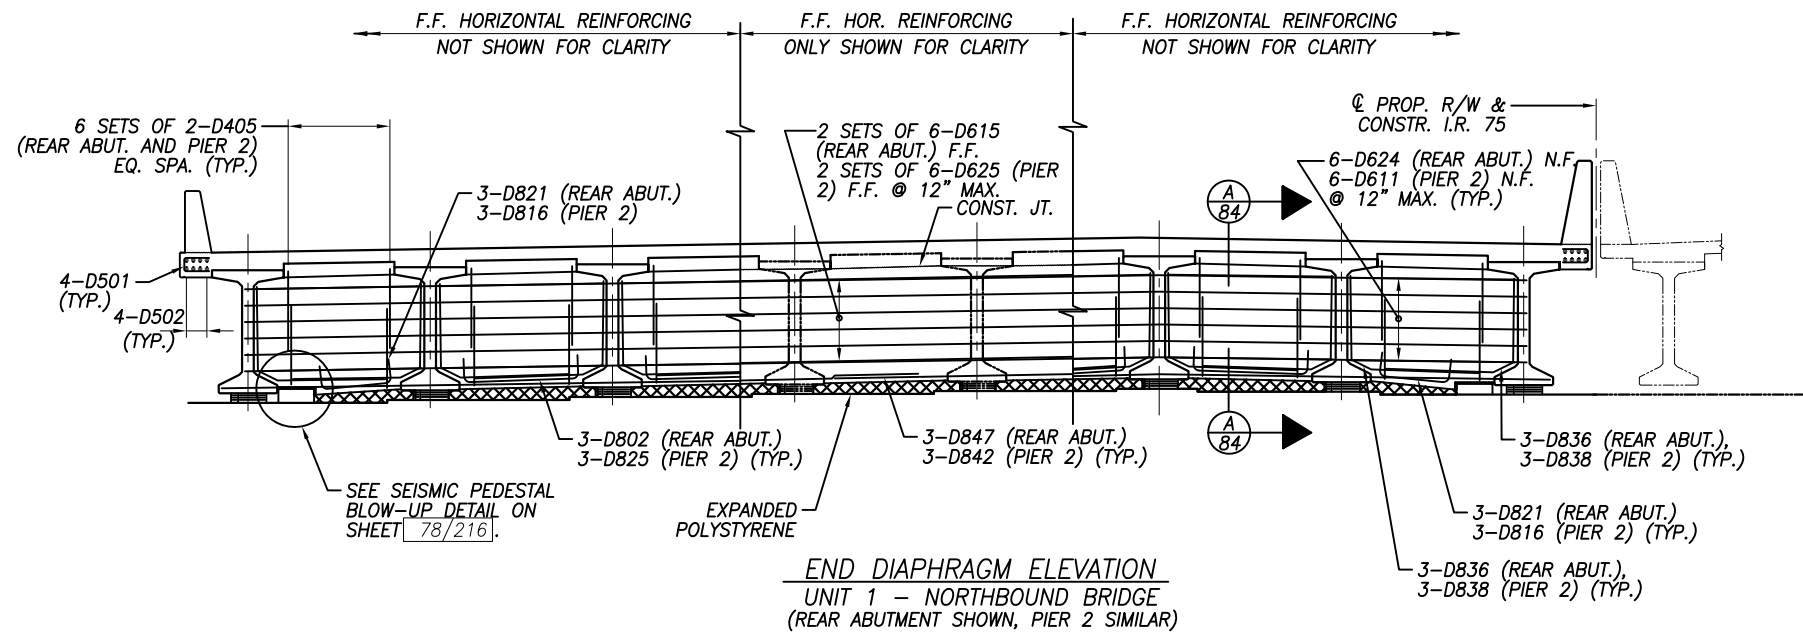


NOTES:

1. FOR ADDITIONAL NOTES SEE SHEET 78/216 .

3 5/1/2020 JANSSEN & SPAANS ENGINEERING INC. - SHEET REPLACED DESIGNED WJZ CHECKED CBS	DRAWN TLH REVISED	REVIEWED WJZ STRUCTURE FILE NUMBER 4802765/4802767	DATE 5/20	DESIGN AGENCY JANSSEN & SPAANS ENGINEERING, INC. 9120 HARRISON PARK COURT INDIANAPOLIS, IN 46216
	DIAPHRAGM DETAILS - UNIT 1 NORTHBOUND BRIDGE NO. LUC-75-0029 L/R I.R. 75 OVER MAUMEE RIVER			W00/LUC-75-0029/0.00 PID No. 93592
81 / 216		1374 1792		

Date: Oct 07, 2020, 4:22pm User Name: mlongtin  
 File: P:\1321 - Toledo E Value Engineering\DWGS\BRIDGE\LUC-75-0027 over Maumee River\Sheets\075\_0027C\_S0019.dwg

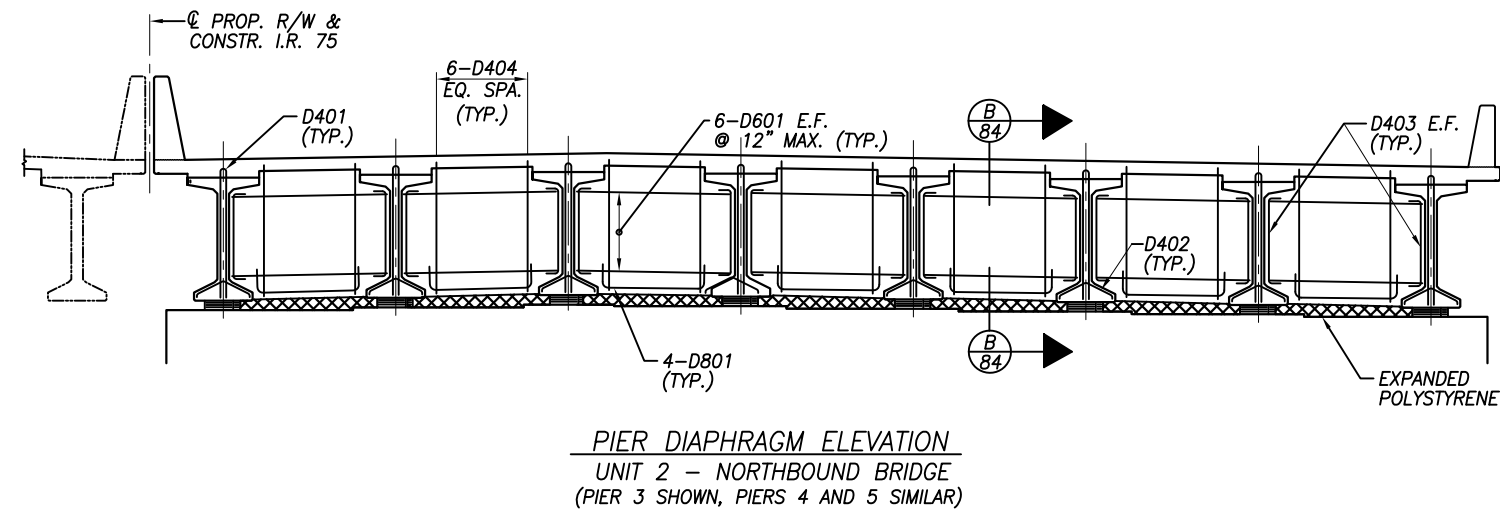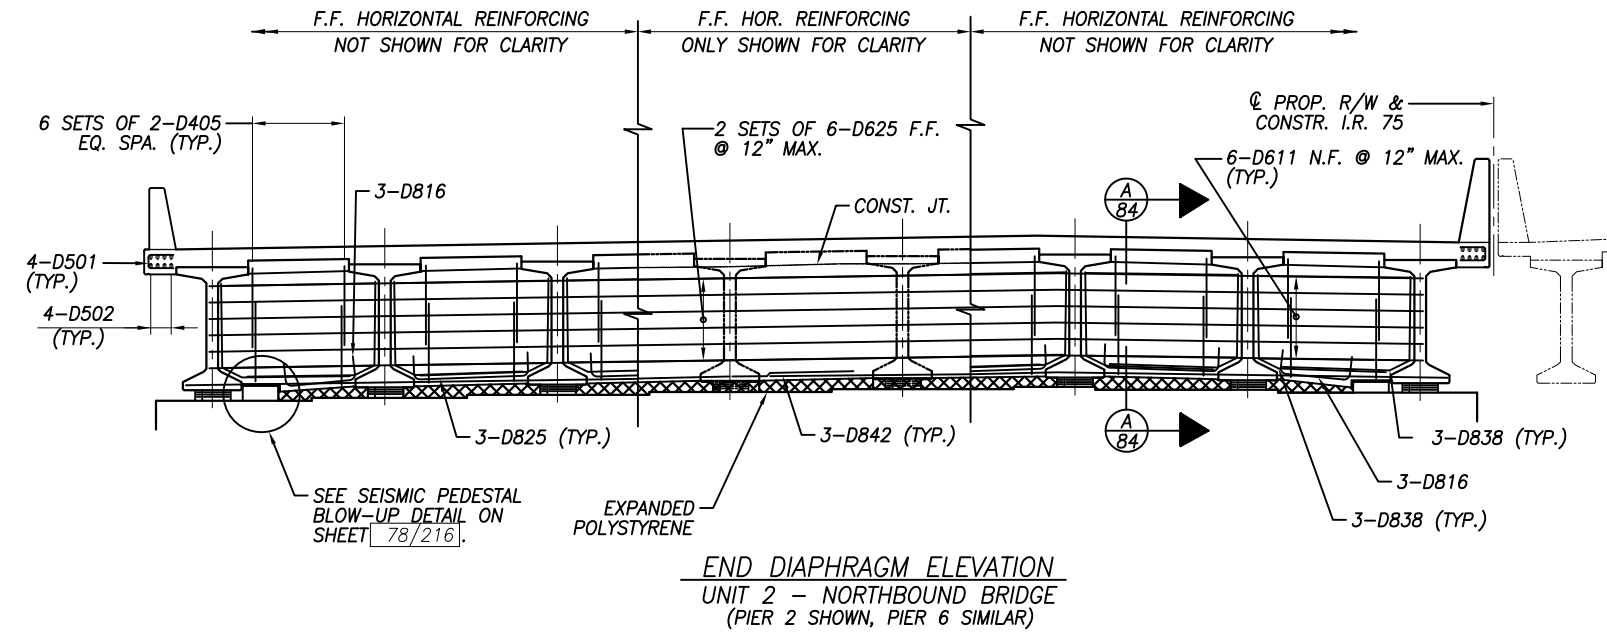


NOTES:

1. FOR ADDITIONAL NOTES SEE SHEET 78/216.


DESIGNED	WOZ	CBS
DRAWN	TLH	REVIS
REVIEWED	WOZ	STRUCTURE FILE NUMBER
DATE	5/20	4802765/4802767
DESIGN AGENCY		
JANSSEN & SPAANS ENGINEERING, INC.		
9120 HARRISON PARK COURT		
INDIANAPOLIS, IN 46216		

3 5/1/2020 JANSSEN & SPAANS ENGINEERING INC. - SHEET REPLACED  
 DIAPHRAGM DETAILS - UNIT 2 NORTHBOUND  
 BRIDGE NO. LUC-75-0029 L/R  
 I.R. 75 OVER MAUMEE RIVER


W00/LUC-75- 30.70/0.00 PID No. 93592	82 / 216	1375 1792
--	----------	--------------

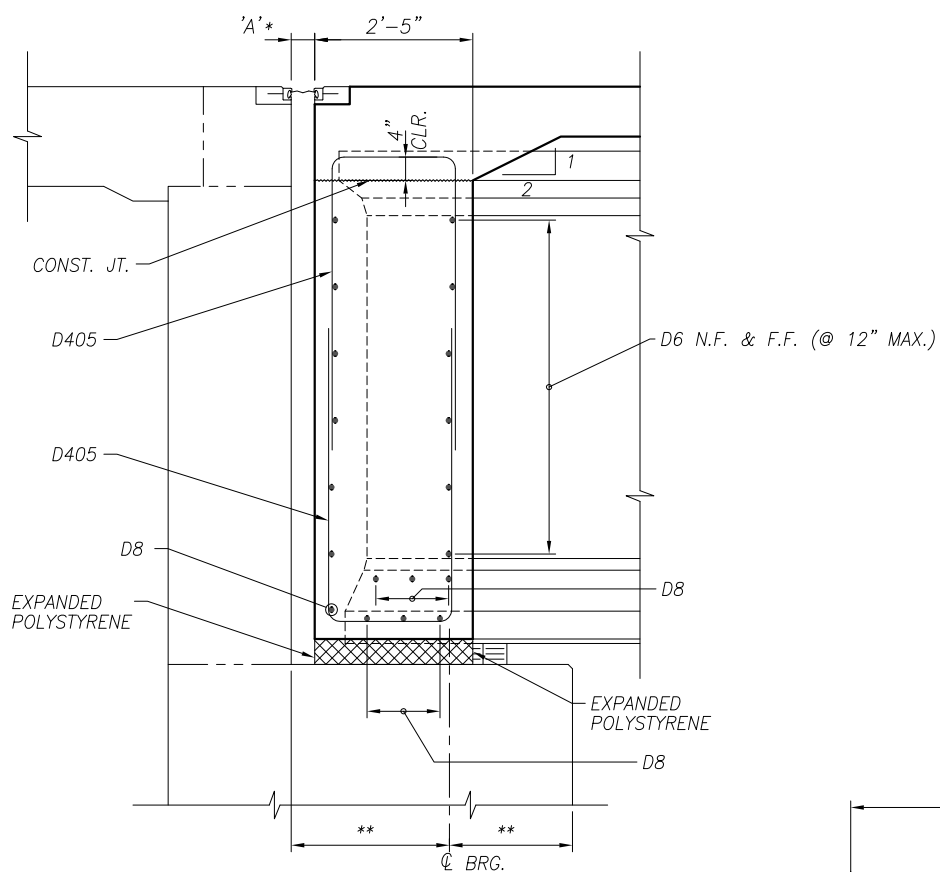

**A** END DIAPHRAGM SECTION - AT ABUTMENTS  
78, 80, 81, 83

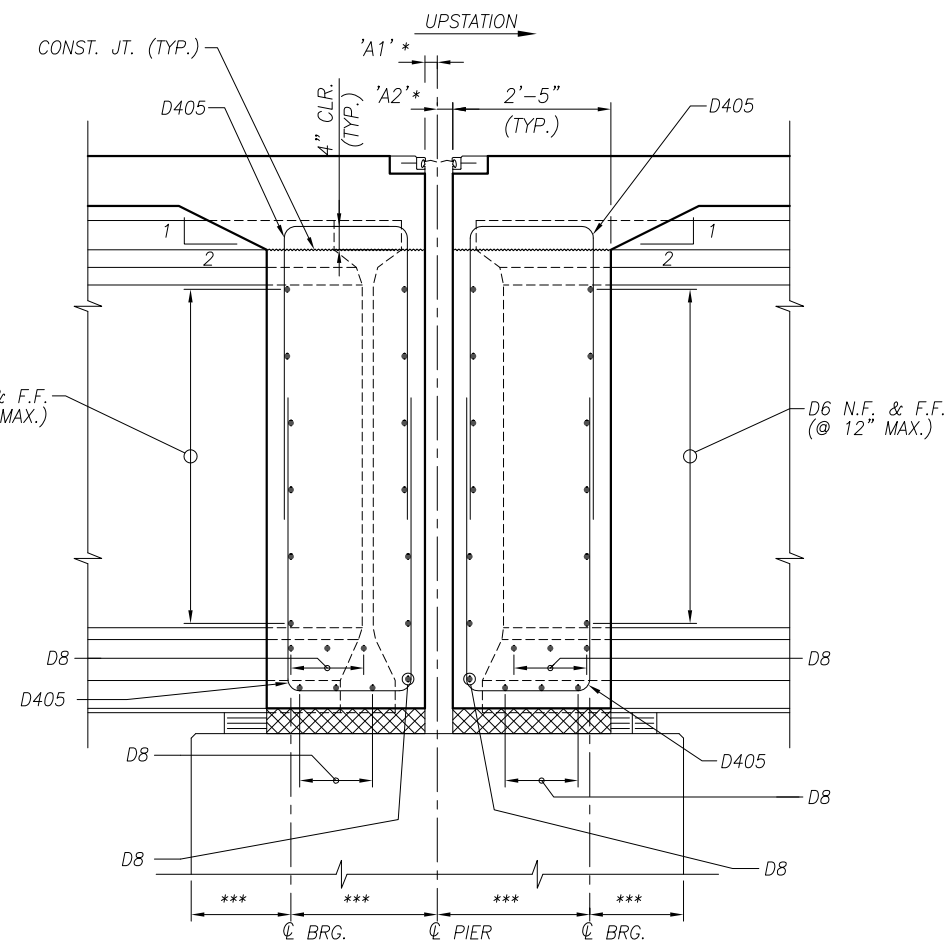

**A** END DIAPHRAGM SECTION - AT PIERS  
78, 79, 80, 81, 82, 83

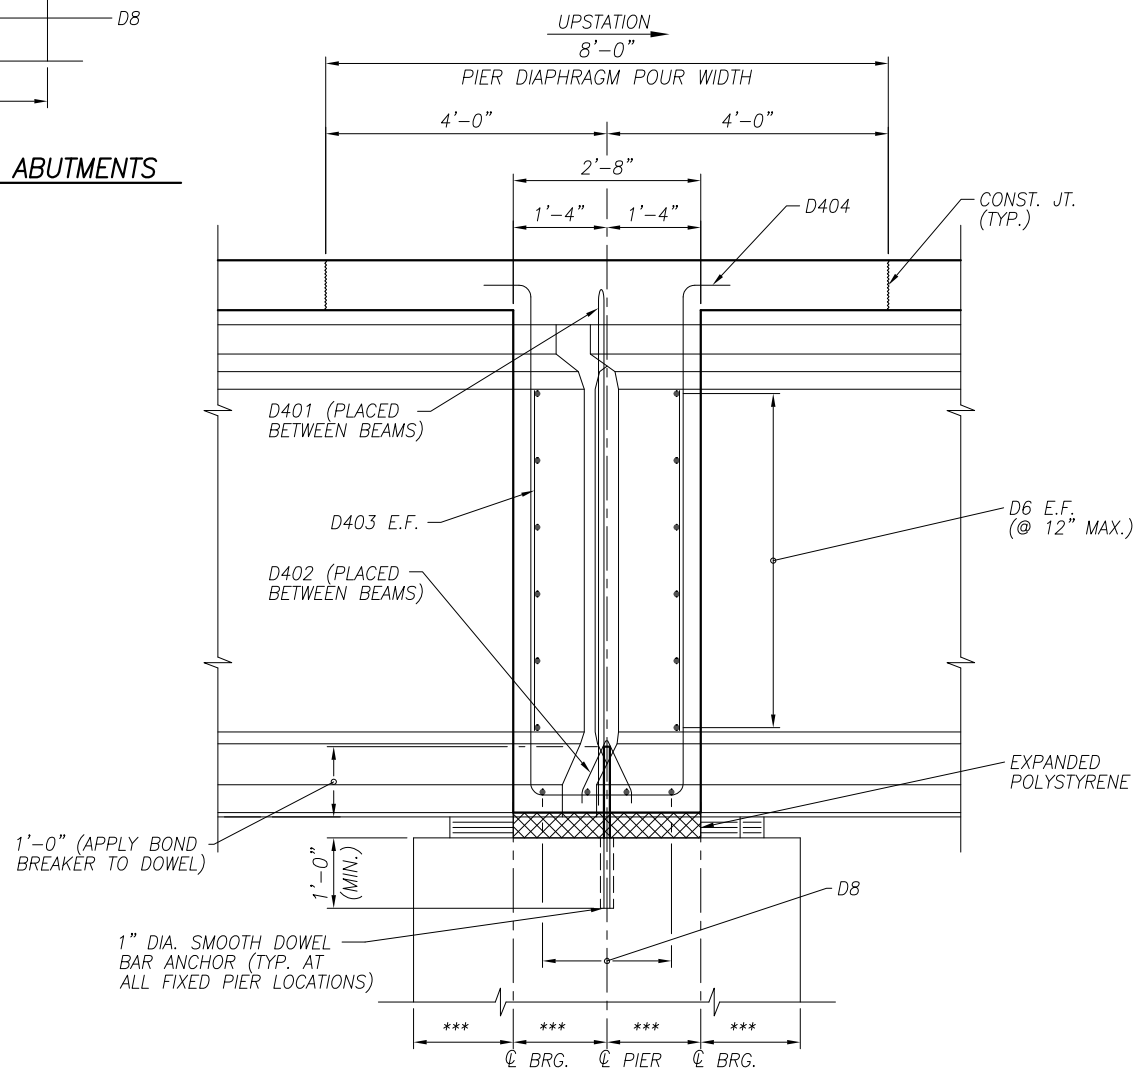

**B** PIER DIAPHRAGM SECTION  
78, 79, 80, 81, 82, 83

**LEGEND:**

- \* FOR EXPANSION JOINT OPENING DIMENSIONS AND ADDITIONAL DETAILS, SEE SHEET 118/216.
- \*\* FOR ABUTMENT DETAILS AND DIMENSIONS, SEE SHEETS 23/216 THRU 28/216.
- \*\*\* FOR PIER DETAILS AND DIMENSIONS, SEE SHEETS 29/216 THRU 41/216.

**NOTES:**

1. FOR ADDITIONAL NOTES SEE SHEET 78/216.
2. FOR ADDITIONAL ANCHOR BAR NOTES AND DETAILS, SEE SHEETS 30/216 THRU 40/216.

Date: Oct 07, 2020, 4:23pm User Name: mlongtin File: P:\1321 - Toledo E Value Engineering\DWGS\BRIDGE\LUC-75-0027 over Maumee River\Sheets\075\_0027C\_SD0021.dwg



5/1/2020 JANSEN & SPAANS ENGINEERING INC. -  
3 BAR CALLOUTS SIMPLIFIED

DESIGNED	DRAWN	REVIEWED	DATE	DESIGN AGENCY
DEB	VFC	JTH	8/18	AECOM
CHECKED	REVISED	STRUCTURE FILE NUMBER	4802765/4802767	564 WHITE POND DRIVE AKRON, OHIO 44320-1100 (330) 836-9111
MRW				

DIAPHRAGM DETAILS  
BRIDGE NO. LUC-75-0029 L/R  
I.R. 75 OVER MAUMEE RIVER

W00/LUC-75-  
30.70/0.00  
PID No. 93592


Date: Dec 04, 2020, 10:23am User Name: mlongtin  
 File: \\jse.com\files\Projects\1321 - Toledo E Value Engineering\DWGS\BRIDGE\LUC-75-0027 over Maumee River\Sheets\075\_0027C\_DP007.dwg

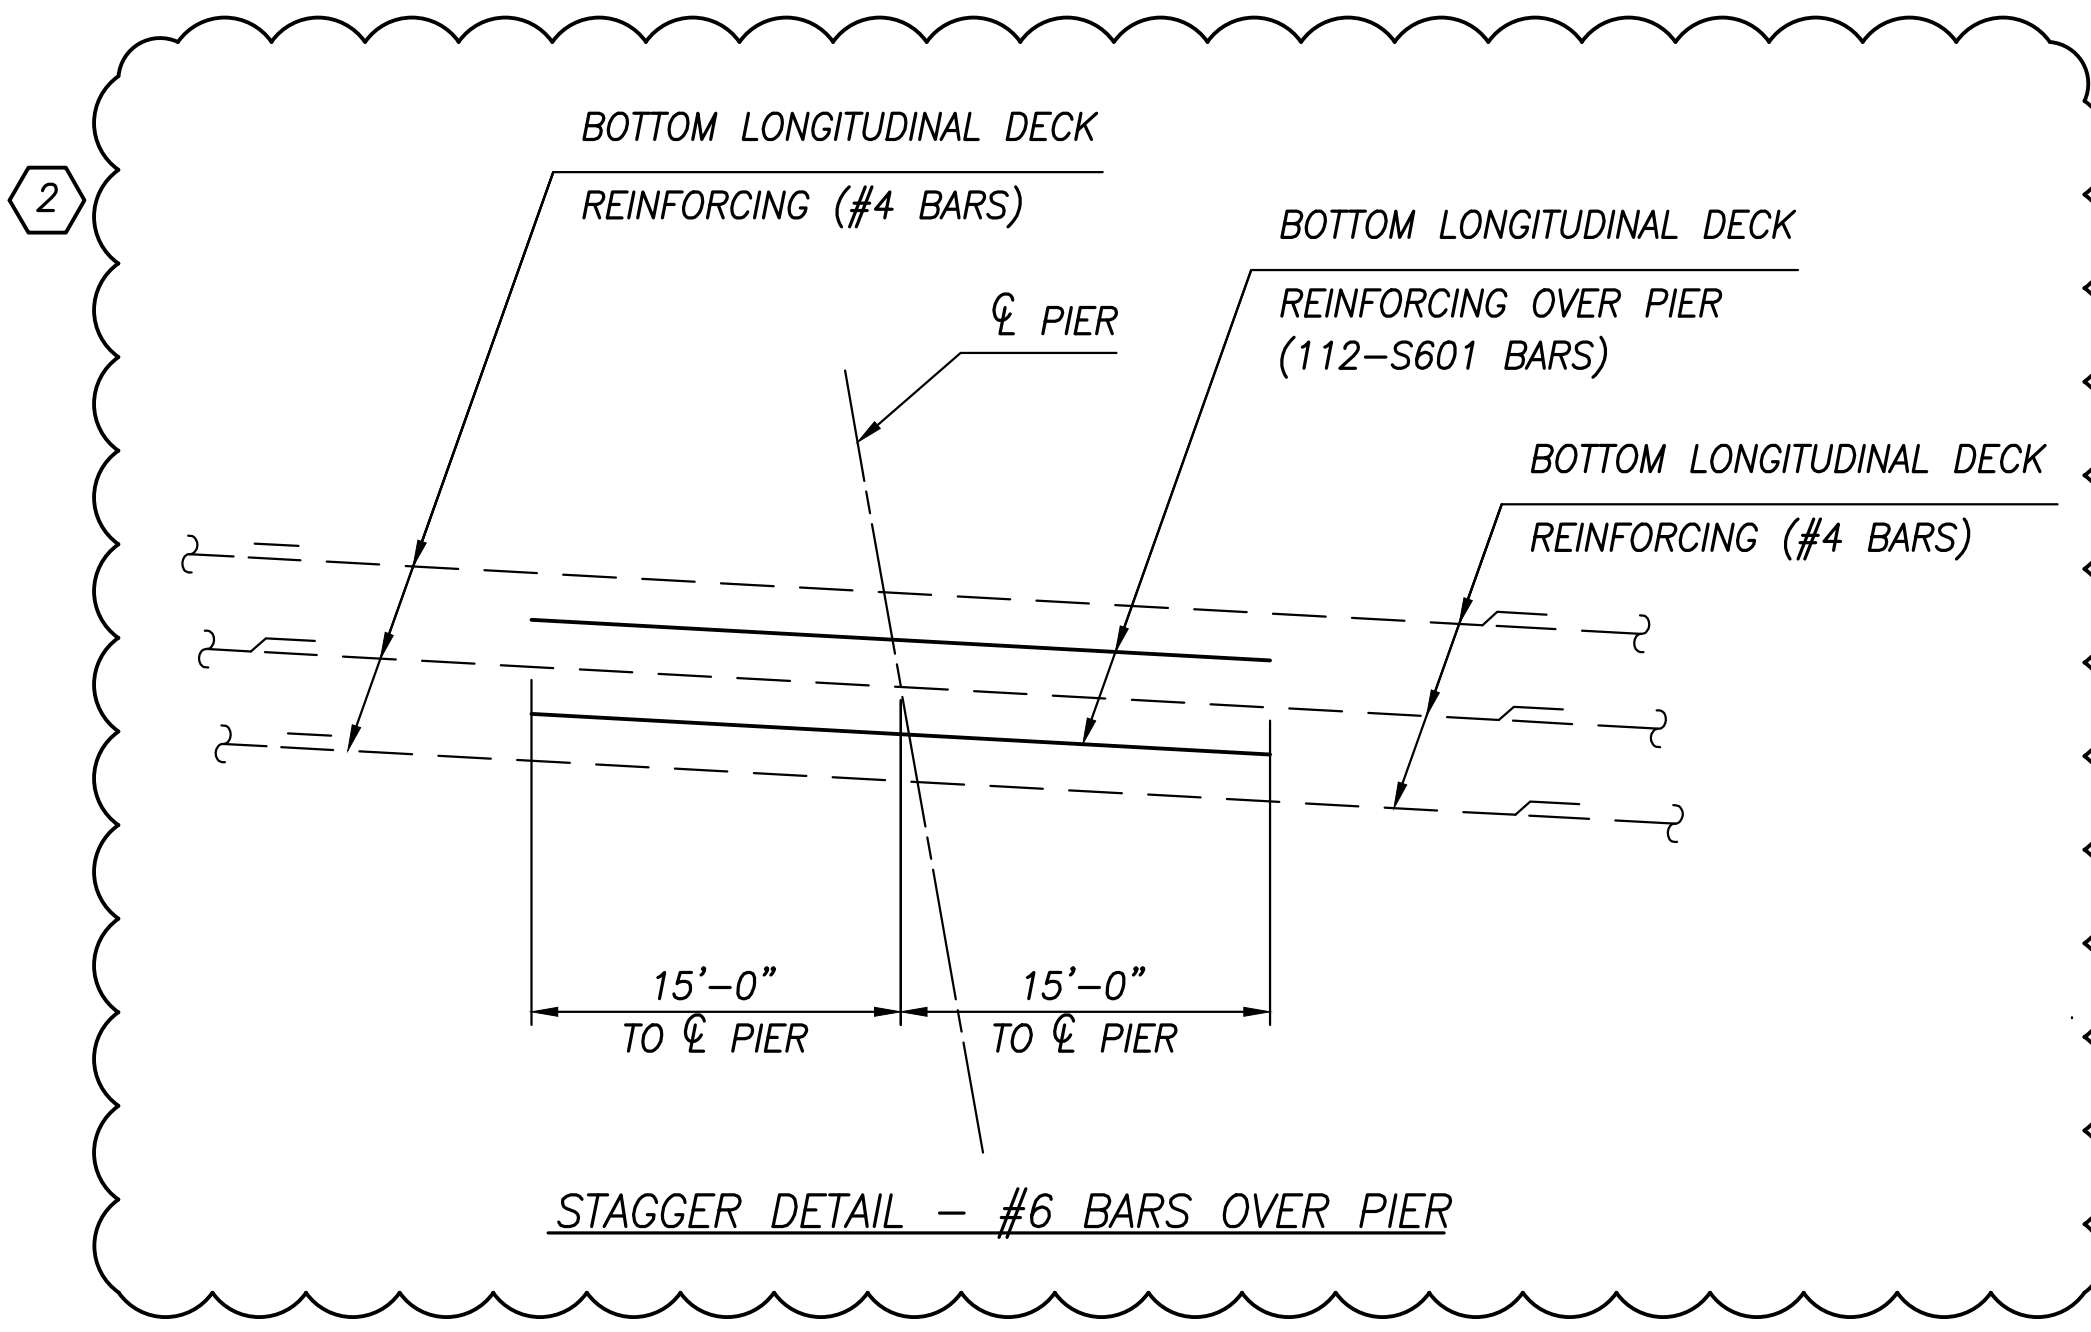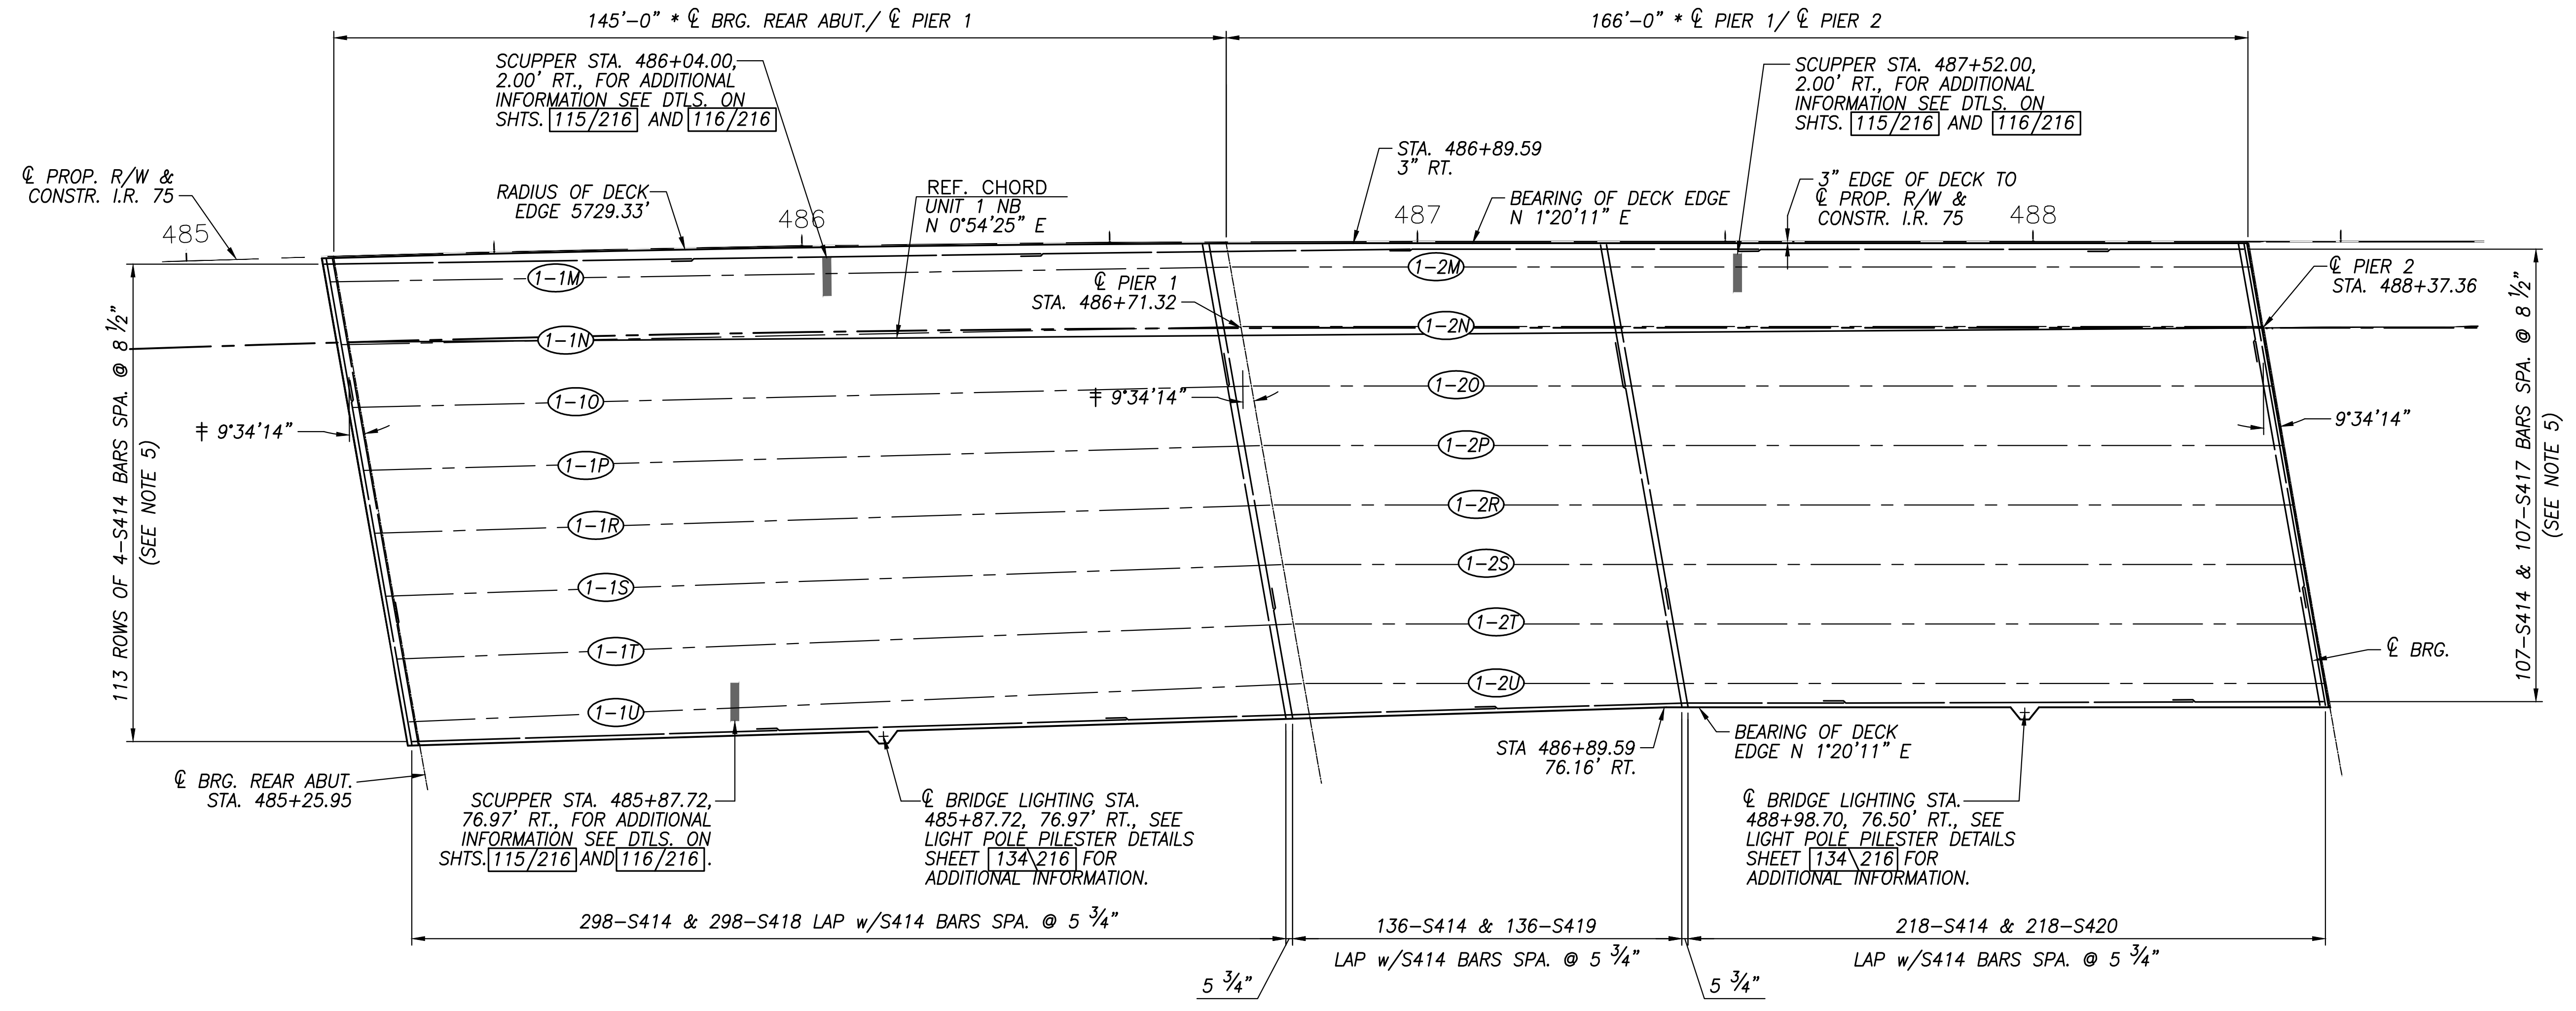

SLAB PLAN - BOTTOM REINFORCING  
 UNIT 1 NORTHBOUND BRIDGE

- NOTES:
- FOR TRANSVERSE SECTION, SEE SHEET 138/216 .
  - FOR PARAPET AND MEDIAN BARRIER DETAILS, SEE SHEETS 119/216 THRU 134/216 .
  - FOR SCREED, TOP OF HAUNCH, AND FINAL DECK ELEVATIONS, SEE SHEETS 143/216 THRU 192/216 .
  - FOR REINFORCING STEEL LIST, SEE SHEETS 210/216 AND 211/216 .
  - FOR EXPANSION JOINT DETAILS, SEE SHEET 118/216 .
  - BARS CALLED OUT  $\phi$  BEAM-TO- $\phi$  BEAM AND TYP. BETWEEN BEAMS TO SIMPLY CALLOUTS. HOWEVER, THERE IS ONLY ONE REBAR LINE ON BEAM  $\phi$ .
  - FOR TOP REINFORCING, SEE SHEET 98/216 .
  - FOR HAUNCH REINFORCING, SEE SHEET 114/216 .
  - MINIMUM REBAR LAP LENGTHS ARE AS FOLLOWS:  
 NO. 4 (HOR.) 3'-3"

- LEGEND:
- (1-1A) - GIRDER IDENTIFICATION
  - \* - MEASURED ALONG  $\phi$  PROP. R/W & CONSTR. I.R. 75
  - \*\* - MEASURED PERPENDICULAR TO  $\phi$  PROP. R/W & CONSTR. I.R. 75
  - ± - MEASURED ALONG/WITH RESPECT TO REFERENCE CHORD

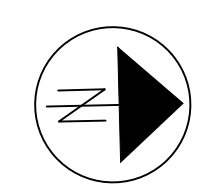


11/23/2020 JANSSEN & SPAANS ENGINEERING INC. -  
 ADDED REBAR OVER PIERS.  
 5/1/2020 JANSSEN & SPAANS ENGINEERING INC. -  
 RECONFIGURED NORTHBOUND ON RAMP SHEET REPLACED

DESIGNED	WJZ	CBS	DATE	5/2020	FILE NUMBER	4802765/4802767
DRAWN	WJZ	REVIS	REVIEWED	WJZ	STRUCTURE	4802765/4802767
SLAB PLAN - 13 OF 27 BRIDGE NO. LUC-75-0029 L/R I.R. 75 OVER MAUMEE RIVER						
WJZ/LUC-75- 30.70/0.00 PID No. 93592						
97 / 216						
1390 1792						


JANSSEN & SPAANS ENGINEERING, INC.  
 9120 HARRISON PARK COURT  
 INDIANAPOLIS, IN 46216



Date: Oct 07, 2020, 4:09pm User Name: mlongtin  
 File: P:\11321 - Toledo E Value Engineering\DWG5\BRIDGE\LUC-75-0027 over Maumee River\Sheets\075\_0027C\_DP008.dwg

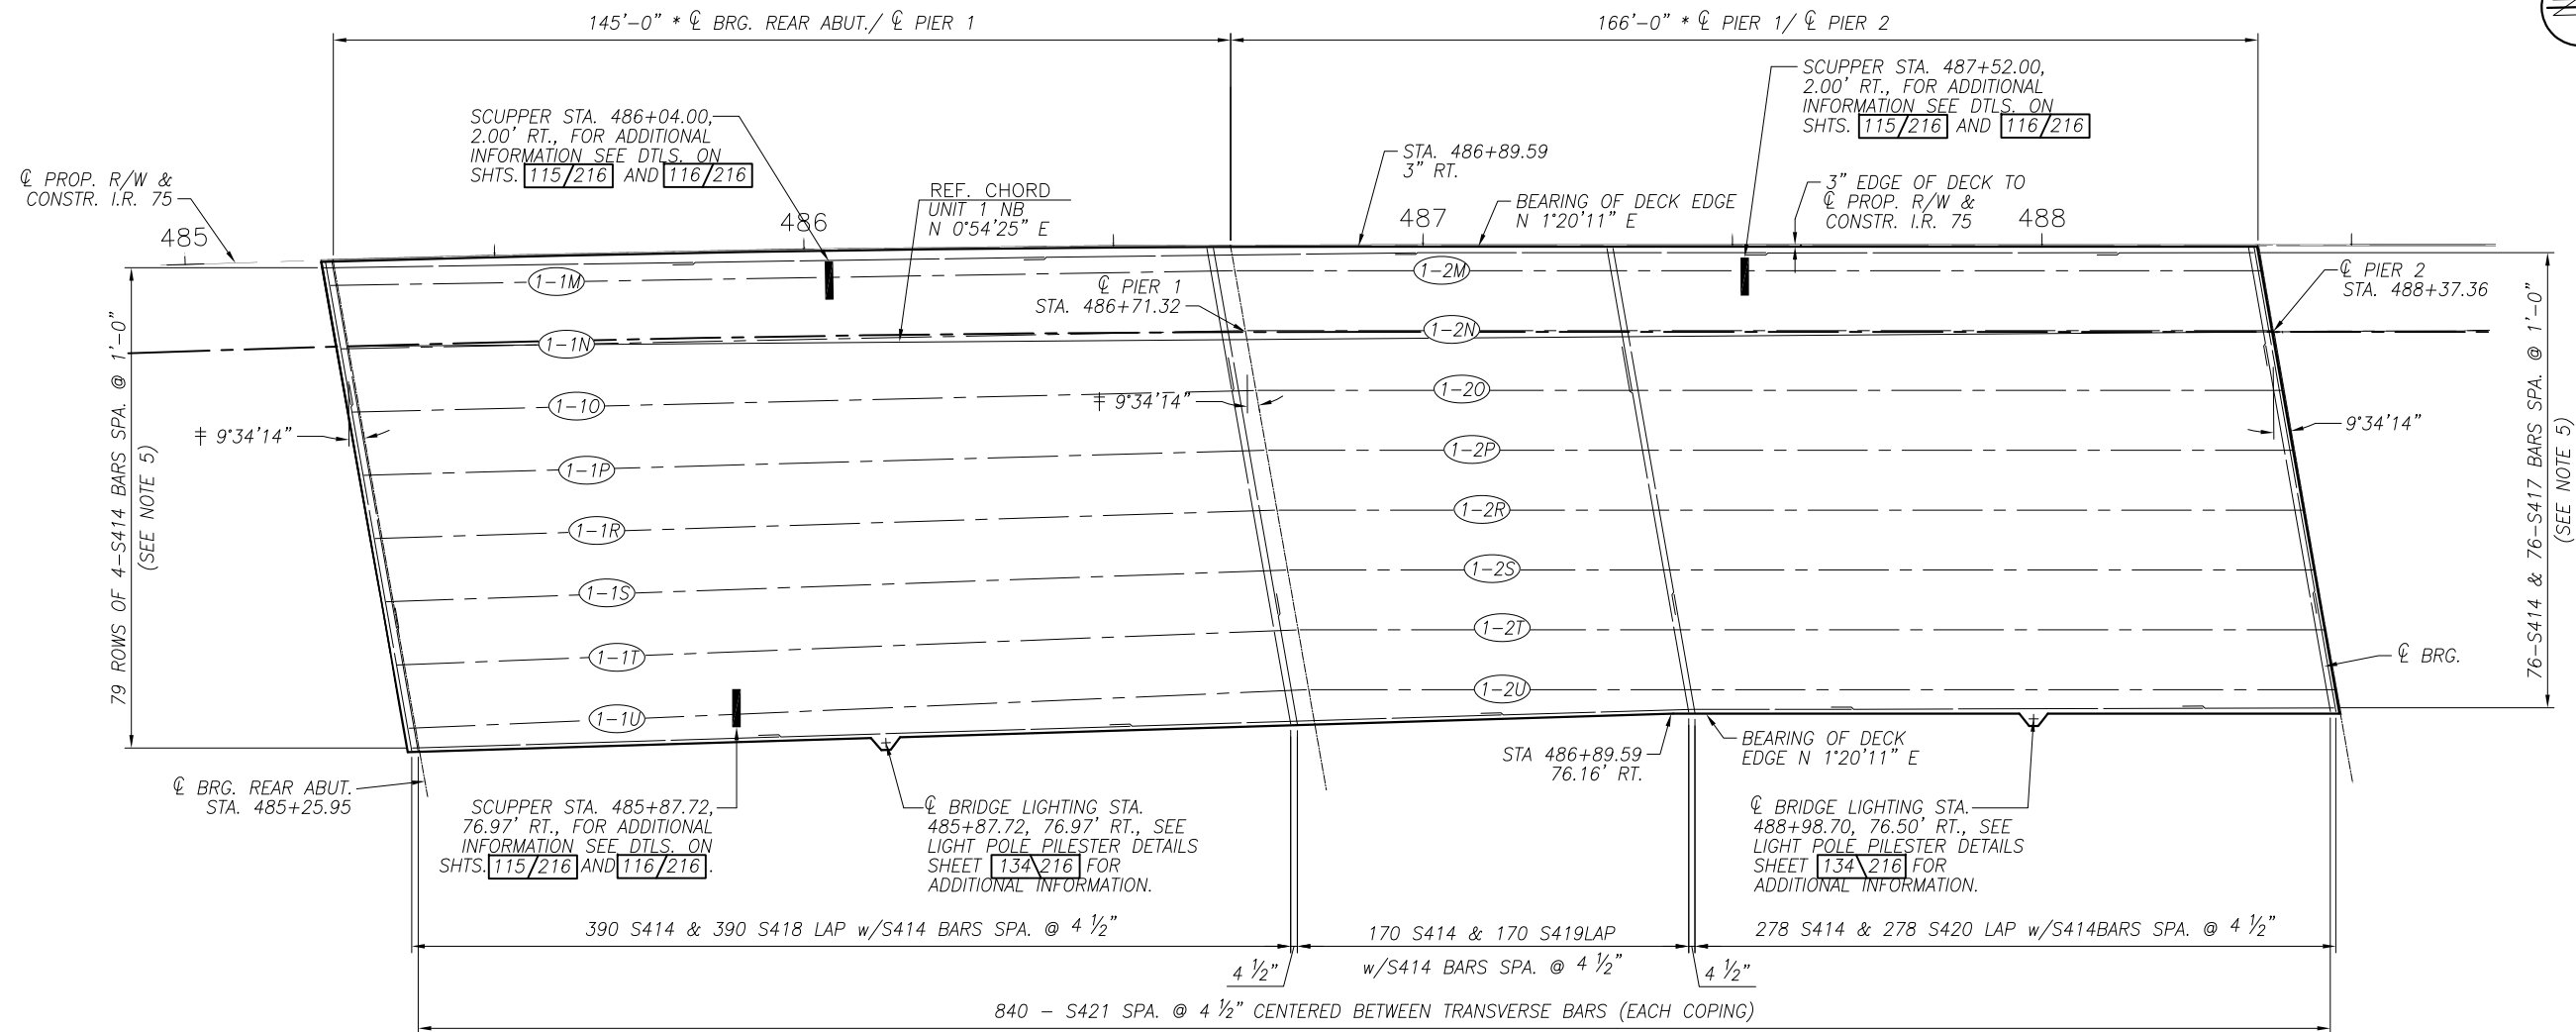

**SLAB PLAN - TOP REINFORCING**  
 UNIT 1 NORTHBOUND BRIDGE

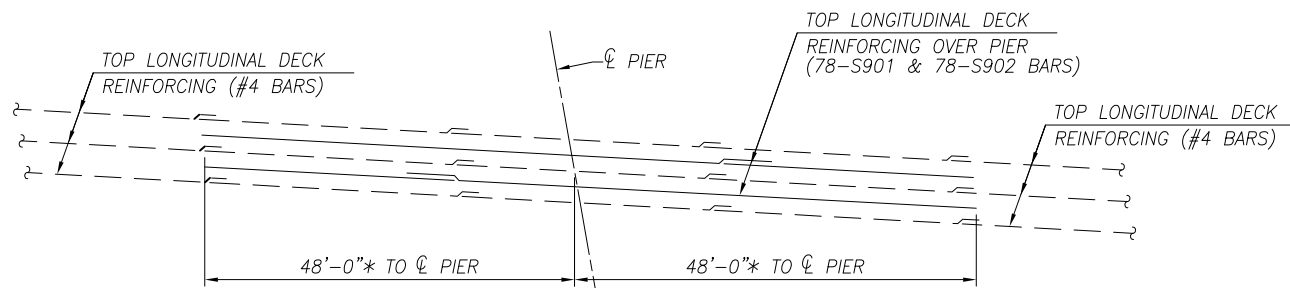

**STAGGER DETAIL - #9 BARS OVER PIER**

**LEGEND:**

- (1-1A) - GIRDER IDENTIFICATION
- \* - MEASURED ALONG  $\phi$  PROP. R/W & CONSTR. I.R. 75
- \*\* - MEASURED PERPENDICULAR TO L PROP. R/W & CONSTR. I.R. 75
- † - MEASURED ALONG/WITH RESPECT TO REFERENCE CHORD

**NOTES:**

1. FOR TRANSVERSE SECTION, SEE SHEET 138/216.
2. FOR PARAPET AND MEDIAN BARRIER DETAILS, SEE SHEETS 119/216 THRU 134/216.
3. FOR SCREED, TOP OF HAUNCH, AND FINAL DECK ELEVATIONS, SEE SHEETS 143/216 THRU 192/216.
4. FOR REINFORCING STEEL LIST, SEE SHEETS 210/216 AND 217/216.
5. FOR EXPANSION JOINT DETAILS, SEE SHEET 118/216.
6. FOR TOP REINFORCING, SEE SHEET 97/216.
7. MINIMUM REBAR LAP LENGTHS ARE AS FOLLOWS:

NO. 4 (HOR.) 3'-3"  
 NO. 9 (HOR.) 10'-2"



3 5/1/2020 JANSSEN & SPAANS ENGINEERING INC. - RECONFIGURED NORTHBOUND ON RAMP SHEET REPLACED


DESIGN AGENCY  
**JANSSEN & SPAANS ENGINEERING, INC.**  
 9120 HARRISON PARK COURT  
 INDIANAPOLIS, IN 46216

DESIGNED	WJZ	CBS
DRAWN	REM	CBS
REVIEWED	WJZ	
DATE	5/2020	
STRUCTURE FILE NUMBER	4802765/4802767	


SLAB PLAN - 14 OF 27  
 BRIDGE NO. LUC-75-0029 L/R  
 I.R. 75 OVER MAUMEE RIVER

W00/LUC-75-30.70/0.00  
 PID No. 93592

Date: Dec 04, 2020, 10:21am User Name: mlongtin  
 File: \\jse.com\files\projects\1321 - Toledo E Value Engineering\DWGS\BRIDGE\LUC-75-0027 over Maumee River\Sheets\075\_0027C\_DP009.dwg

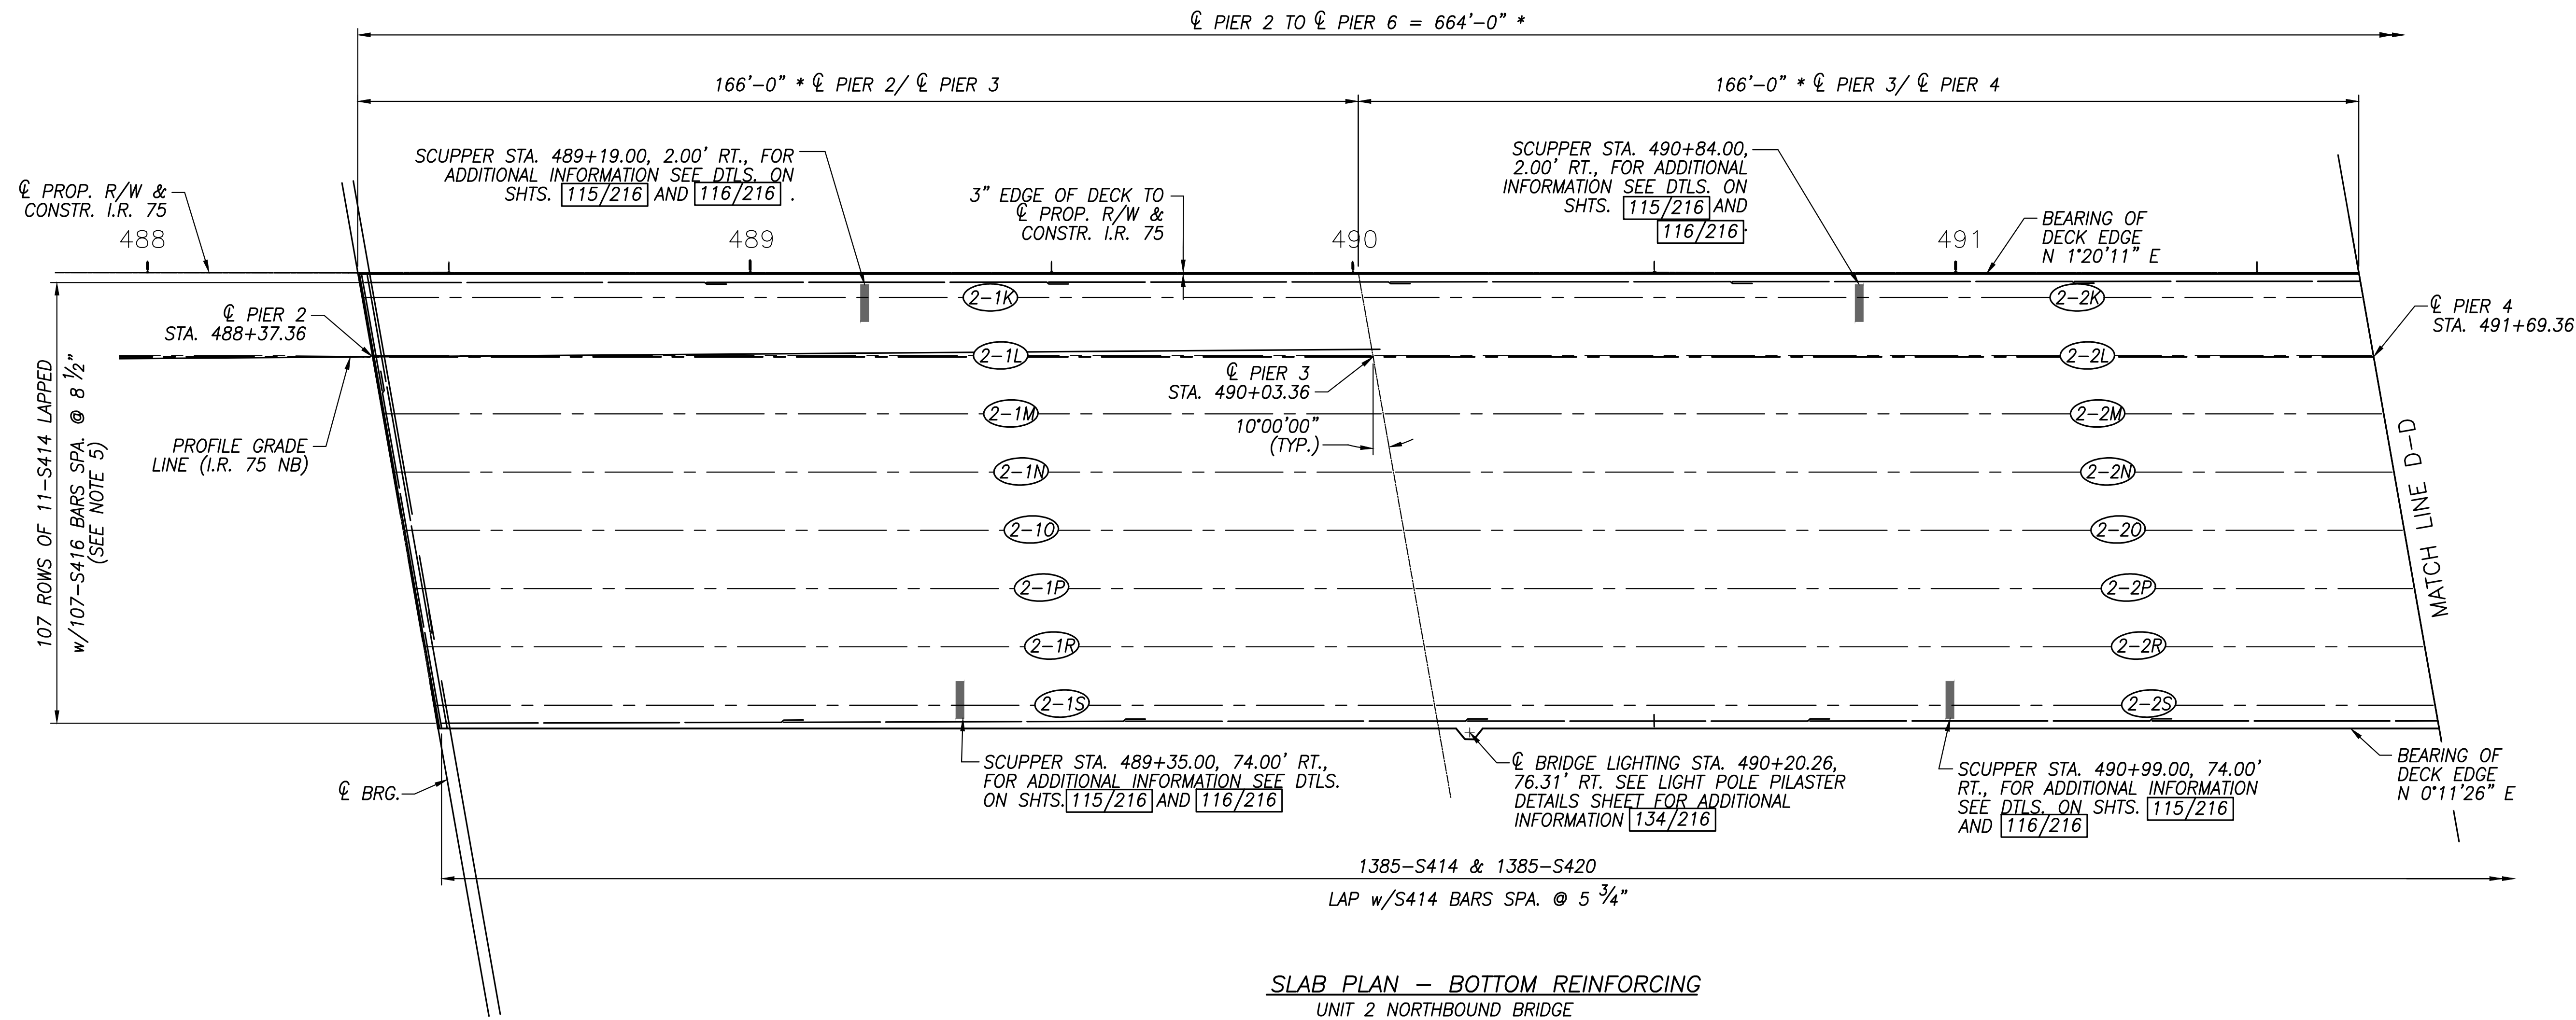

SLAB PLAN - BOTTOM REINFORCING  
 UNIT 2 NORTHBOUND BRIDGE

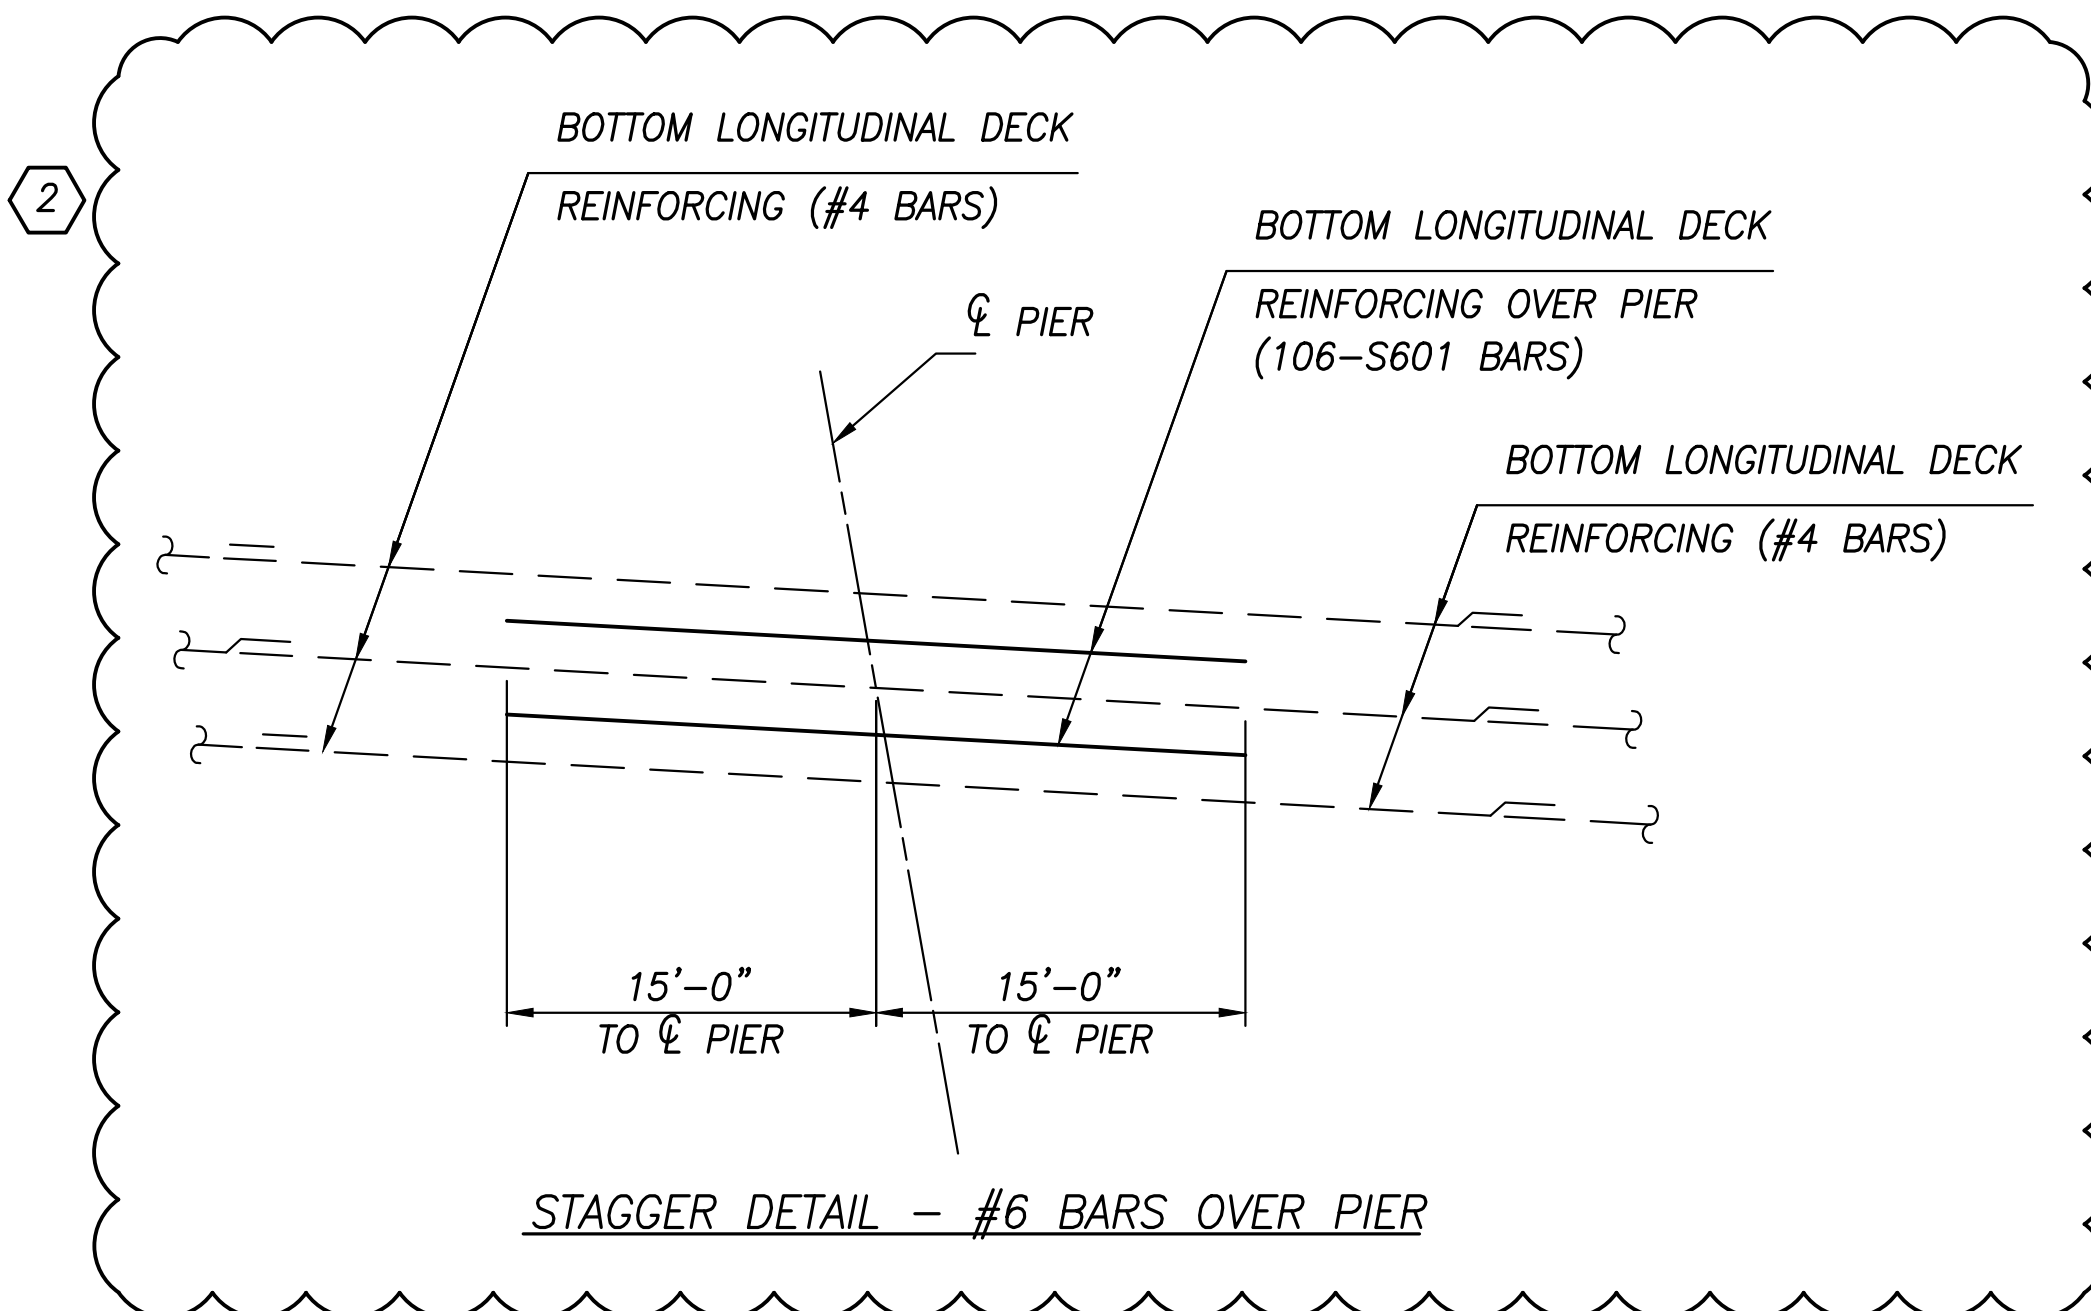


NOTES:

1. FOR TRANSVERSE SECTION, SEE SHEET [139/216].
2. FOR PARAPET AND MEDIAN BARRIER DETAILS, SEE SHEETS [119/216] THRU [134/216].
3. FOR SCREED, TOP OF HAUNCH, AND FINAL DECK ELEVATIONS, SEE SHEETS [143/216] THRU [192/216].
4. FOR REINFORCING STEEL LIST, SEE SHEETS [210/216] AND [211/216].
5. FOR EXPANSION JOINT DETAILS, SEE SHEETS [118/216].
6. BARS CALLED OUT CL BEAM-TO-CL BEAM AND TYP. BETWEEN BEAMS TO SIMPLYIFY CALLOUTS. HOWEVER, THERE IS ONLY ONE REBAR LINE ON BEAM CL.
7. FOR TOP REINFORCING, SEE SHEETS [104/216] AND [105/216].
8. FOR HAUNCH REINFORCING, SEE SHEET [114/216].
9. MINIMUM REBAR LAP LENGTHS ARE AS FOLLOWS:

LEGEND:

- (1-1A) - GIRDER IDENTIFICATION
- \* - MEASURED ALONG CL PROP. R/W & CONSTR. I.R. 75
- \*\* - MEASURED PERPENDICULAR TO CL PROP. R/W & CONSTR. I.R. 75

NO. 4 (HOR.) 3'-3"

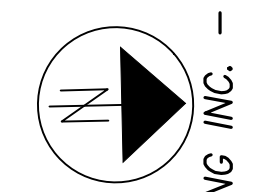

11/23/2020 JANSSEN & SPAANS ENGINEERING INC. - ADDED REBAR OVER PIERS.  
 5/1/2020 JANSSEN & SPAANS ENGINEERING INC. - RECONFIGURED NORTHBOUND ON RAMP SHEET REPLACED


DESIGN AGENCY  
**JANSSEN & SPAANS ENGINEERING, INC.**  
 9120 HARRISON PARK COURT  
 INDIANAPOLIS, IN 46216

DESIGNED	CHECKED	REVISION	DATE	REVIEWED
WOZ	CBS		5/2020	WOZ

SLAB PLAN - 15 OF 27  
 BRIDGE NO. LUC-75-0029 L/R  
 I.R. 75 OVER MAUMEE RIVER

W00/LUC-75-30.70/0.00  
 PID No. 93592

Date: Oct 08, 2020, 4:31pm User Name: mlongtin  
File: C:\11321 - Toledo E Value Engineering\DWG\BRIDGE\LUC-75-0027 over Maumee River\Sheets\100-101-102.dwg

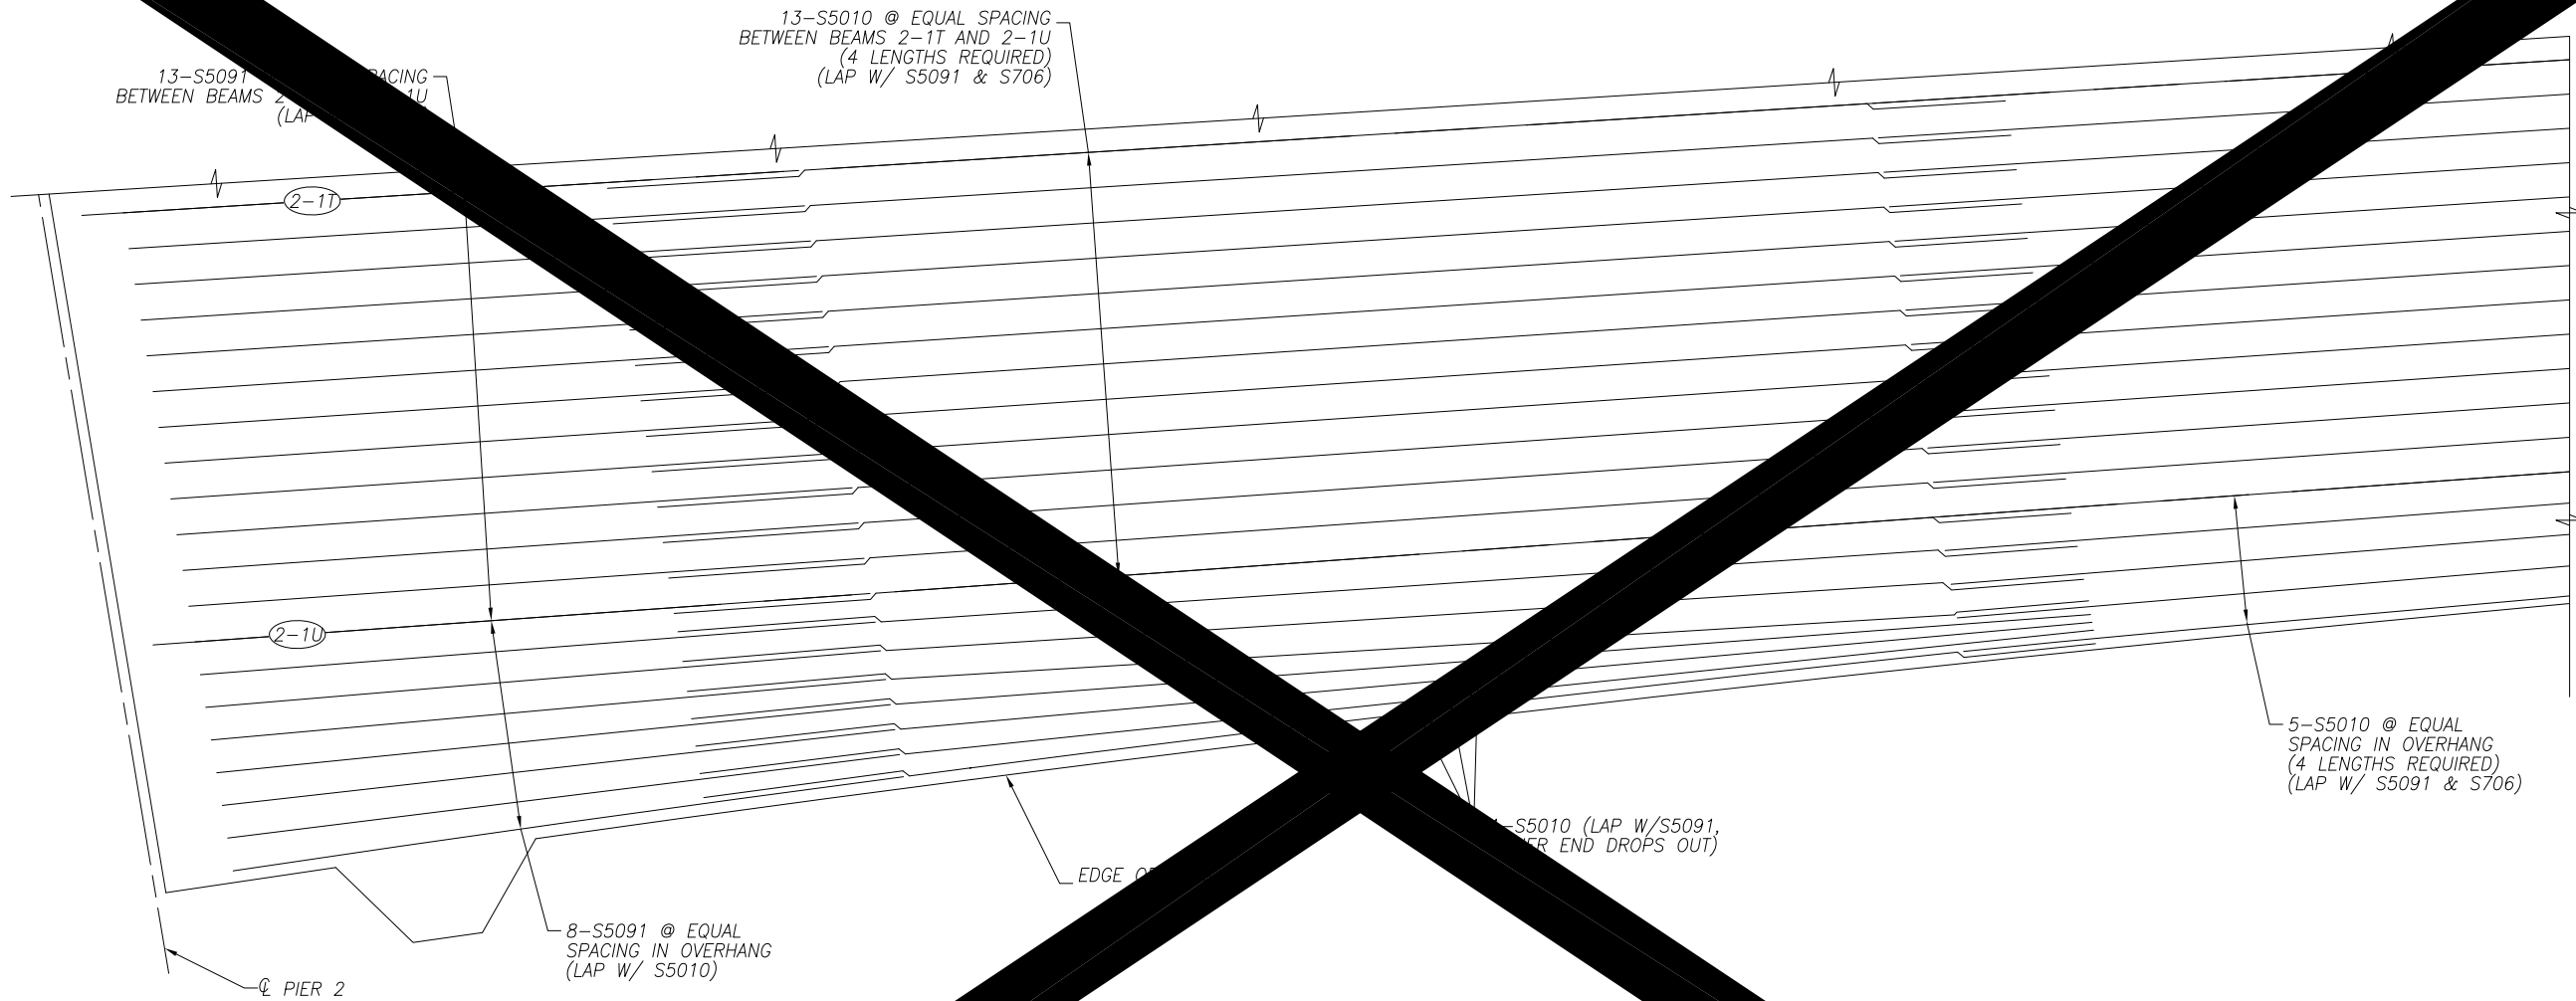

**DETAIL 1 - BOTTOM REINFORCING**  
UNIT 2 NORTHBOUND BRIDGE

- LEGEND:
- BEAM IDENTIFICATION
  - LONGITUDINAL REINFORCING
  - ADDITIONAL POSITIVE MOMENT REINFORCING

**NOTES:**

1. BARS CALLED OUT @ BEAM-TYP. AND TYP. BETWEEN BEAMS TO SIMPLIFY CALLING OUT. HOWEVER, THERE IS ONLY ONE REBAR LINE ON EACH BEAM.
2. FOR DETAIL 1 LOCATION, SEE SHT. 99/216
3. MINIMUM REBAR LAP LENGTHS ARE AS FOLLOWS:

NO. 5 (HOR.) 2'-10"  
NO. 7 (HOR.) 5'-4"

5/1/2020 JANSSEN & SPAANS ENGINEERING INC. -  
RECONFIGURED NORTHBOUND ON RAMP SHEET REMOVED

SLAB PLAN - 16 OF 27  
BRIDGE NO. LUC-75-0029 L/R  
I.R. 75 OVER MAUMEE RIVER


W00/LUC-75-  
30.70/0.00  
PID No. 93592

100/216

DESIGN AGENCY  
564 WHITE POND  
AKRON, OHIO 44333  
**AECOM**  
(330) 836-9111

DESIGNED	DRAWN	REVIEWED	DATE	DESIGN AGENCY
DEB	VFC	JTH	8/18	564 WHITE POND
CHECKED	REVISD	STRUCTURE FILE NUMBER		AKRON, OHIO 44333
MRW		4802765/4802767		(330) 836-9111

Date: Oct 08, 2020, 4:32pm User Name: mlongin  
 File: C:\1321 - Toledo E Value Engineering\DWG\BRIDGE\LUC-75-0027 over Maumee River\Sheets\100-101-102.dwg

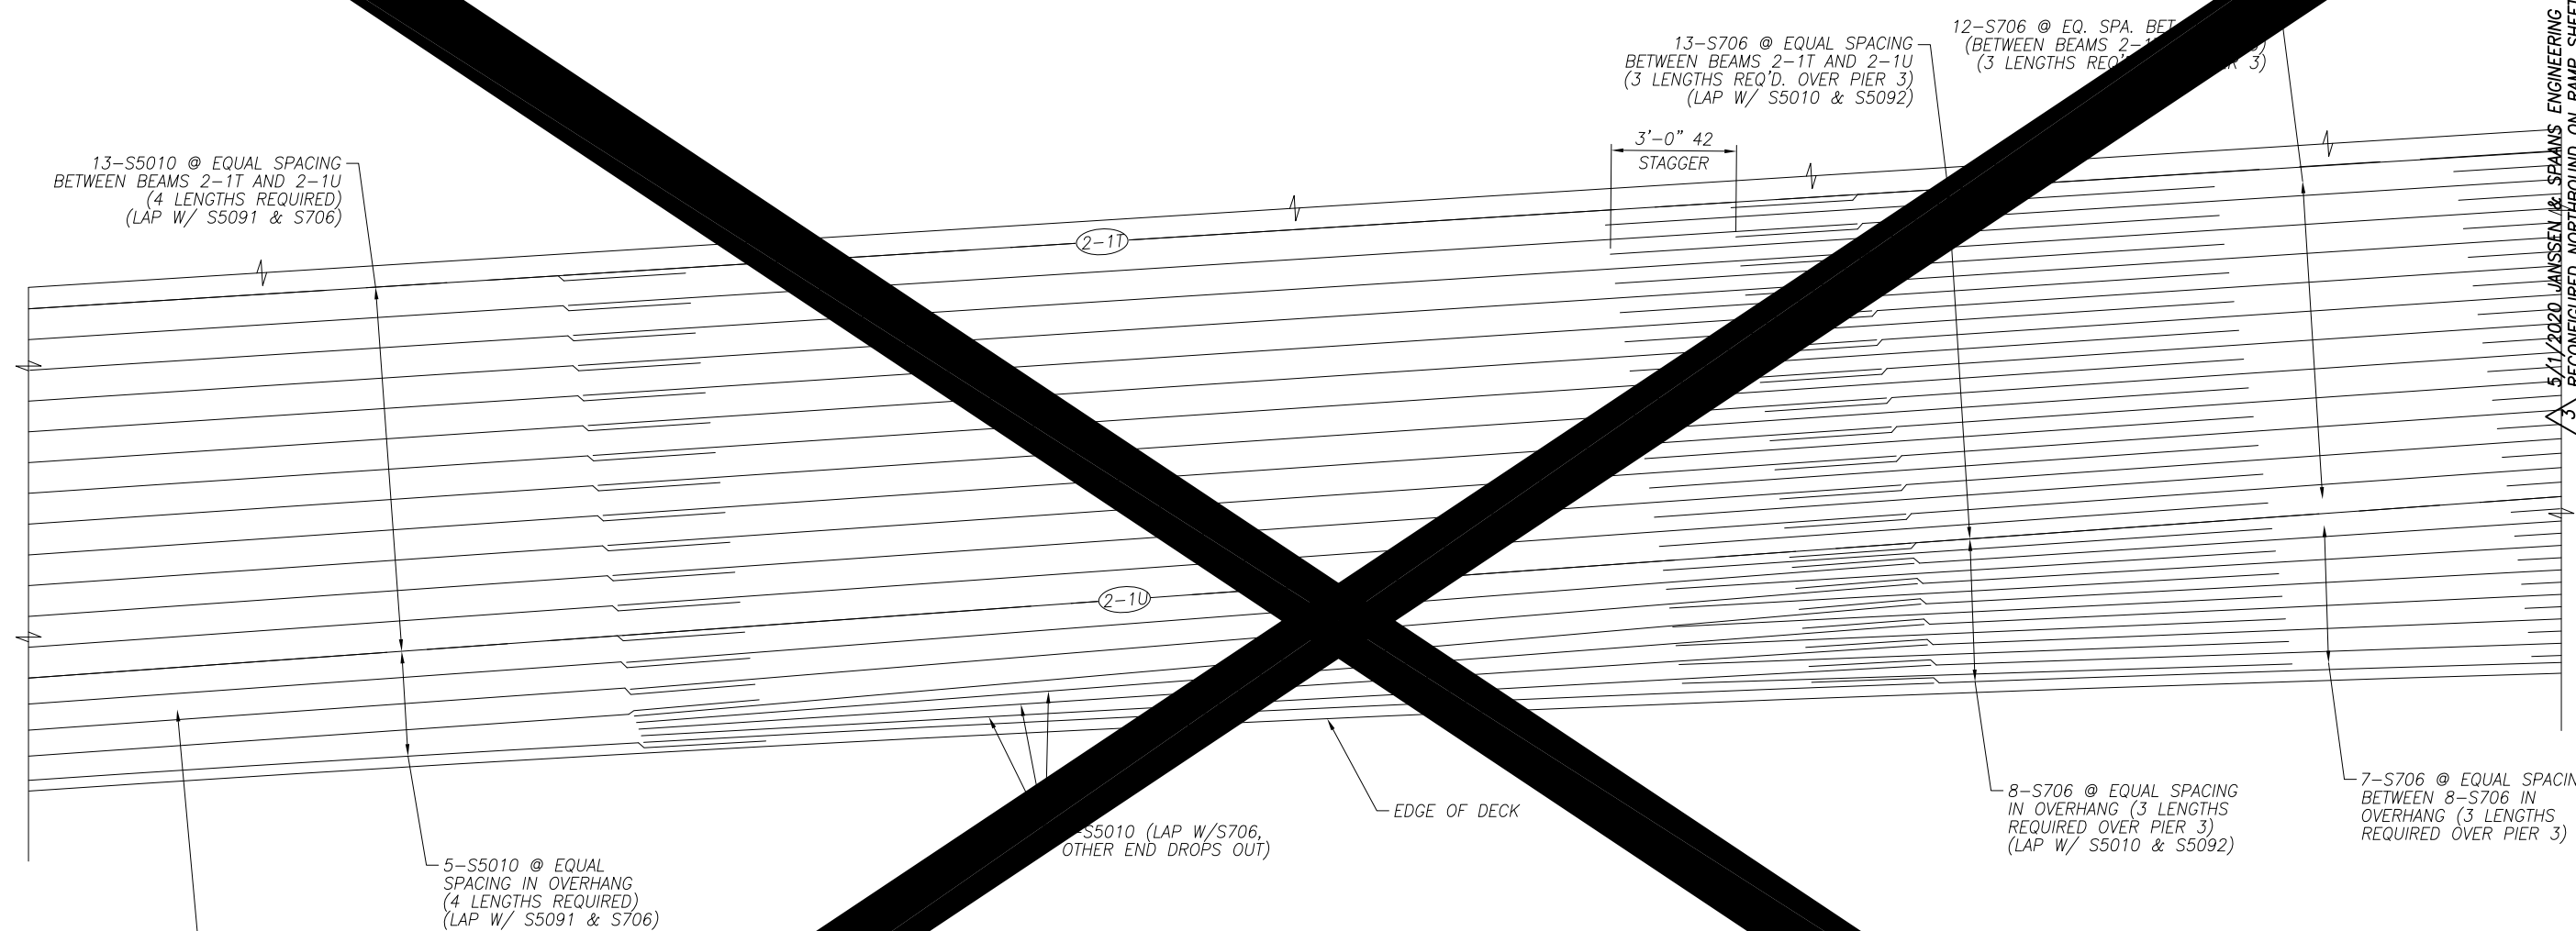

**DETAIL 2 - BOTTOM REINFORCING**  
 UNIT 2 NORTHBOUND BRIDGE

SCUPPER STA. 489+35.00, 92.02' RT.,  
 FOR ADDITIONAL INFORMATION SEE DTLS.  
 ON SHTS. 115/216 AND 116/216

LEGEND:  
 ○ BEAM IDENTIFICATION  
 ——— LONGITUDINAL REINFORCING  
 - - - - - ADDITIONAL MOMENT REINFORCING

- NOTES:**
1. BARS CALLED OUT @ BEAM-TYP. AND TYP. BETWEEN BEAMS TO SIMPLIFY CALLING OUT. HOWEVER, THERE IS ONLY ONE REBAR LINE ON EACH BEAM.
  2. FOR DETAIL 2 LOCATION AND PIER 3 STAGGER DETAIL, SEE SHT. 99/216.
  3. MINIMUM REBAR LAP LENGTHS ARE AS FOLLOWS:  
 NO. 5 (HOR.) 2'-10"  
 NO. 7 (HOR.) 5'-4"

5/11/2020 JANSSEN & SPANNS ENGINEERING, INC. -  
 RECONFIGURED NORTHBOUND ON RAMP SHEET REMOVED

SLAB PLAN - 17 OF 27  
 BRIDGE NO. LUC-75-0029 L/R  
 I.R. 75 OVER MAUMEE RIVER


W00/LUC-75-  
 30.70/0.00  
 PID No. 93592

101/216

DESIGN AGENCY  
 564 WHITE POND  
 AKRON, OHIO 44333  
**AECOM**  
 (330) 836-9111

DESIGNED	DEB	CHECKED	MRW
DRAWN	VFC	REVISED	
REVIEWED	JTH	STRUCTURE FILE NUMBER	4802765/4802767
DATE	8/18		

Date: Oct 08, 2020, 4:32pm User Name: mlongtin  
 File: C:\11321 - Toledo E Value Engineering\DWG\BRIDGE\LUC-75-0027 over Maumee River\Sheets\100-101-102.dwg

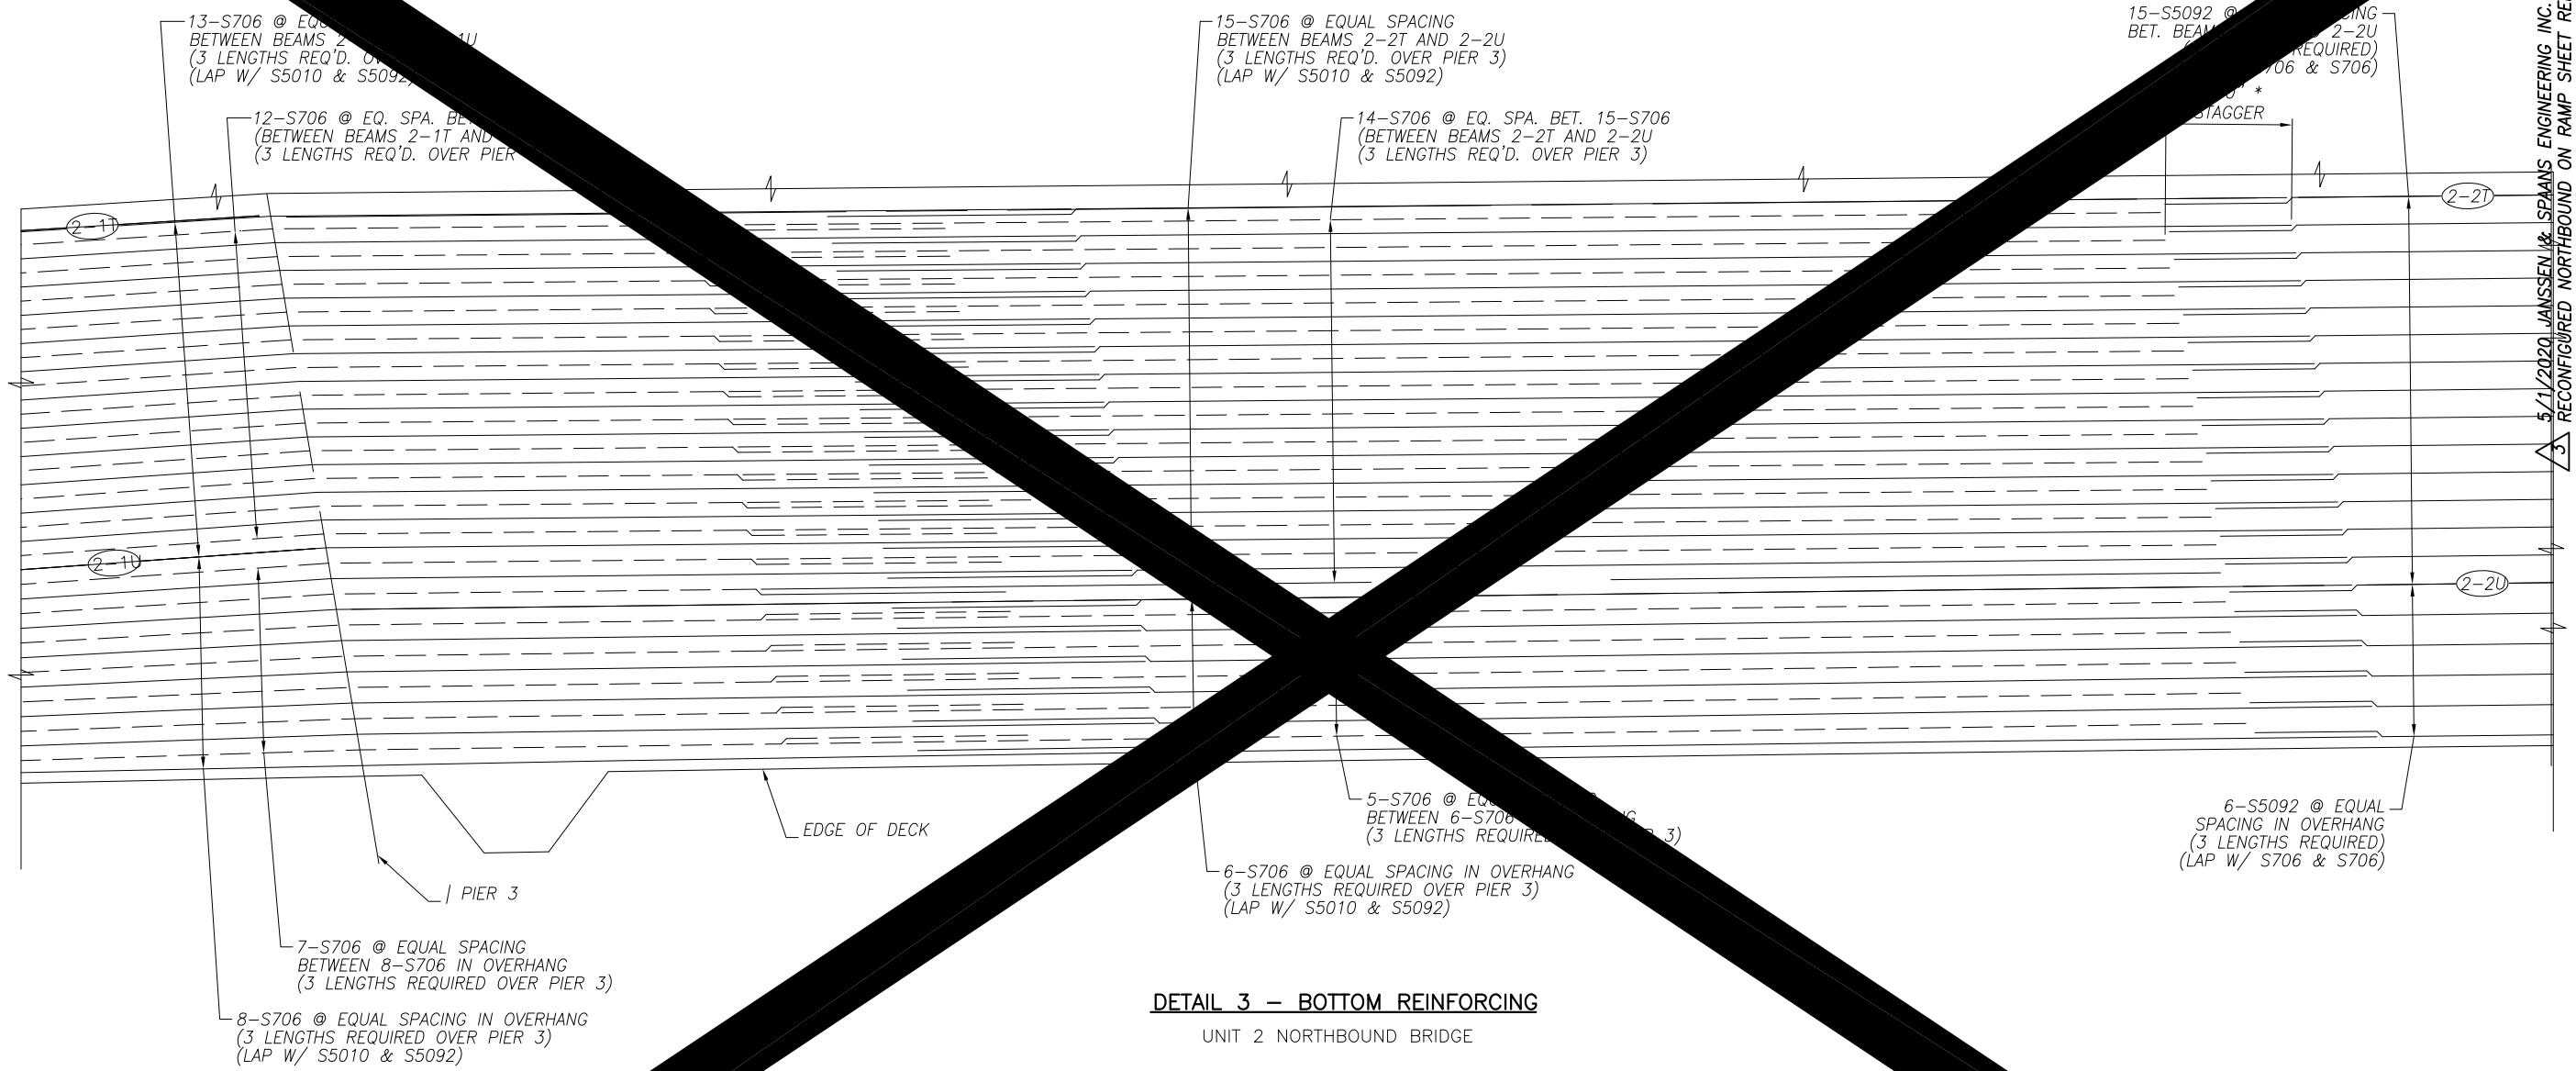

**DETAIL 3 - BOTTOM REINFORCING**

UNIT 2 NORTHBOUND BRIDGE

LEGEND:  
 ———— REBAR IDENTIFICATION  
 ———— LONGITUDINAL REINFORCING  
 - - - - - ADDITIONAL POSITIVE MOMENT REINFORCING

**NOTES:**

1. BARS CALLED OUT @ BEAM-TYP. AND TYP. BETWEEN BEAMS TO SIMPLIFY CALLOUTS. HOWEVER, THERE IS ONLY ONE REBAR LINE ON EACH BEAM.
2. FOR DETAIL 3 LOCATION AND PIER 3 STAGGER DETAIL, SEE SHT. [99/216].
3. MINIMUM REBAR LAP LENGTHS ARE AS FOLLOWS:

NO. 5 (HOR.) 2'-10"  
 NO. 7 (HOR.) 5'-4"

5/1/2020 JANSSEN & SPANNS ENGINEERING INC. -  
 RECONFIGURED NORTHBOUND ON RAMP SHEET REMOVED

SLAB PLAN - 18 OF 27  
 BRIDGE NO. LUC-75-0029 L/R  
 I.R. 75 OVER MAUMEE RIVER


W00/LUC-75-  
 30.70/0.00  
 PID No. 93592

102/216


DESIGN AGENCY  
 564 WHITE POND  
 AKRON, OHIO 44333  
**AECOM**  
 (330) 836-9111

DESIGNED	DEB	CHECKED	MRW
DRAWN	VFC	REVISED	
REVIEWED	JTH	STRUCTURE FILE NUMBER	4802765/4802767
DATE	8/18		

Date: Dec 04, 2020, 10:21am, User Name: mlonatin  
 File: \\jse.com\files\Projects\1321 - Toledo E Value Engineering\DWGS\BRIDGE\LUC-75-0027 over Maumee River\Sheets\075\_0027C\_DP009.dwg

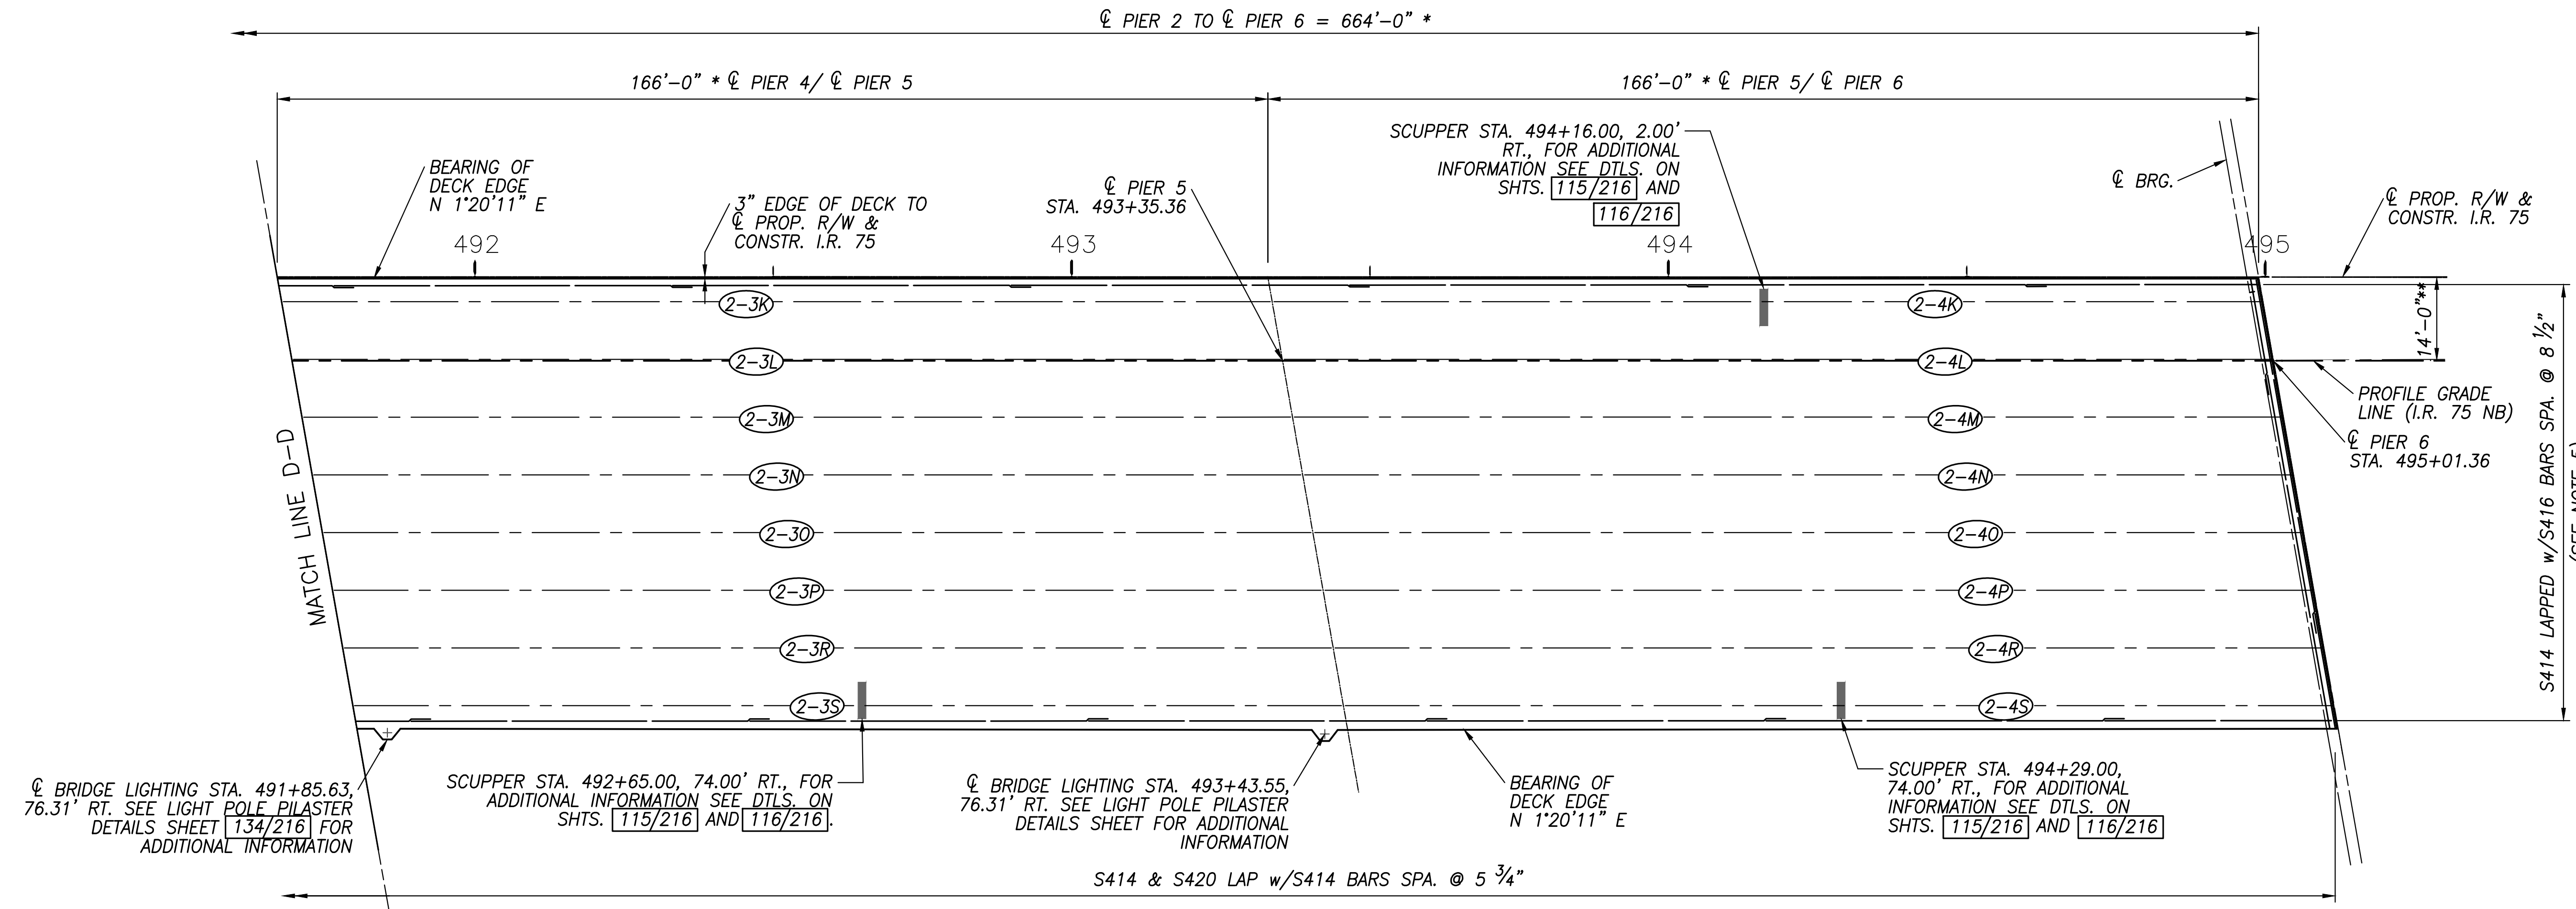

SLAB PLAN - BOTTOM REINFORCING  
 UNIT 2 NORTHBOUND BRIDGE

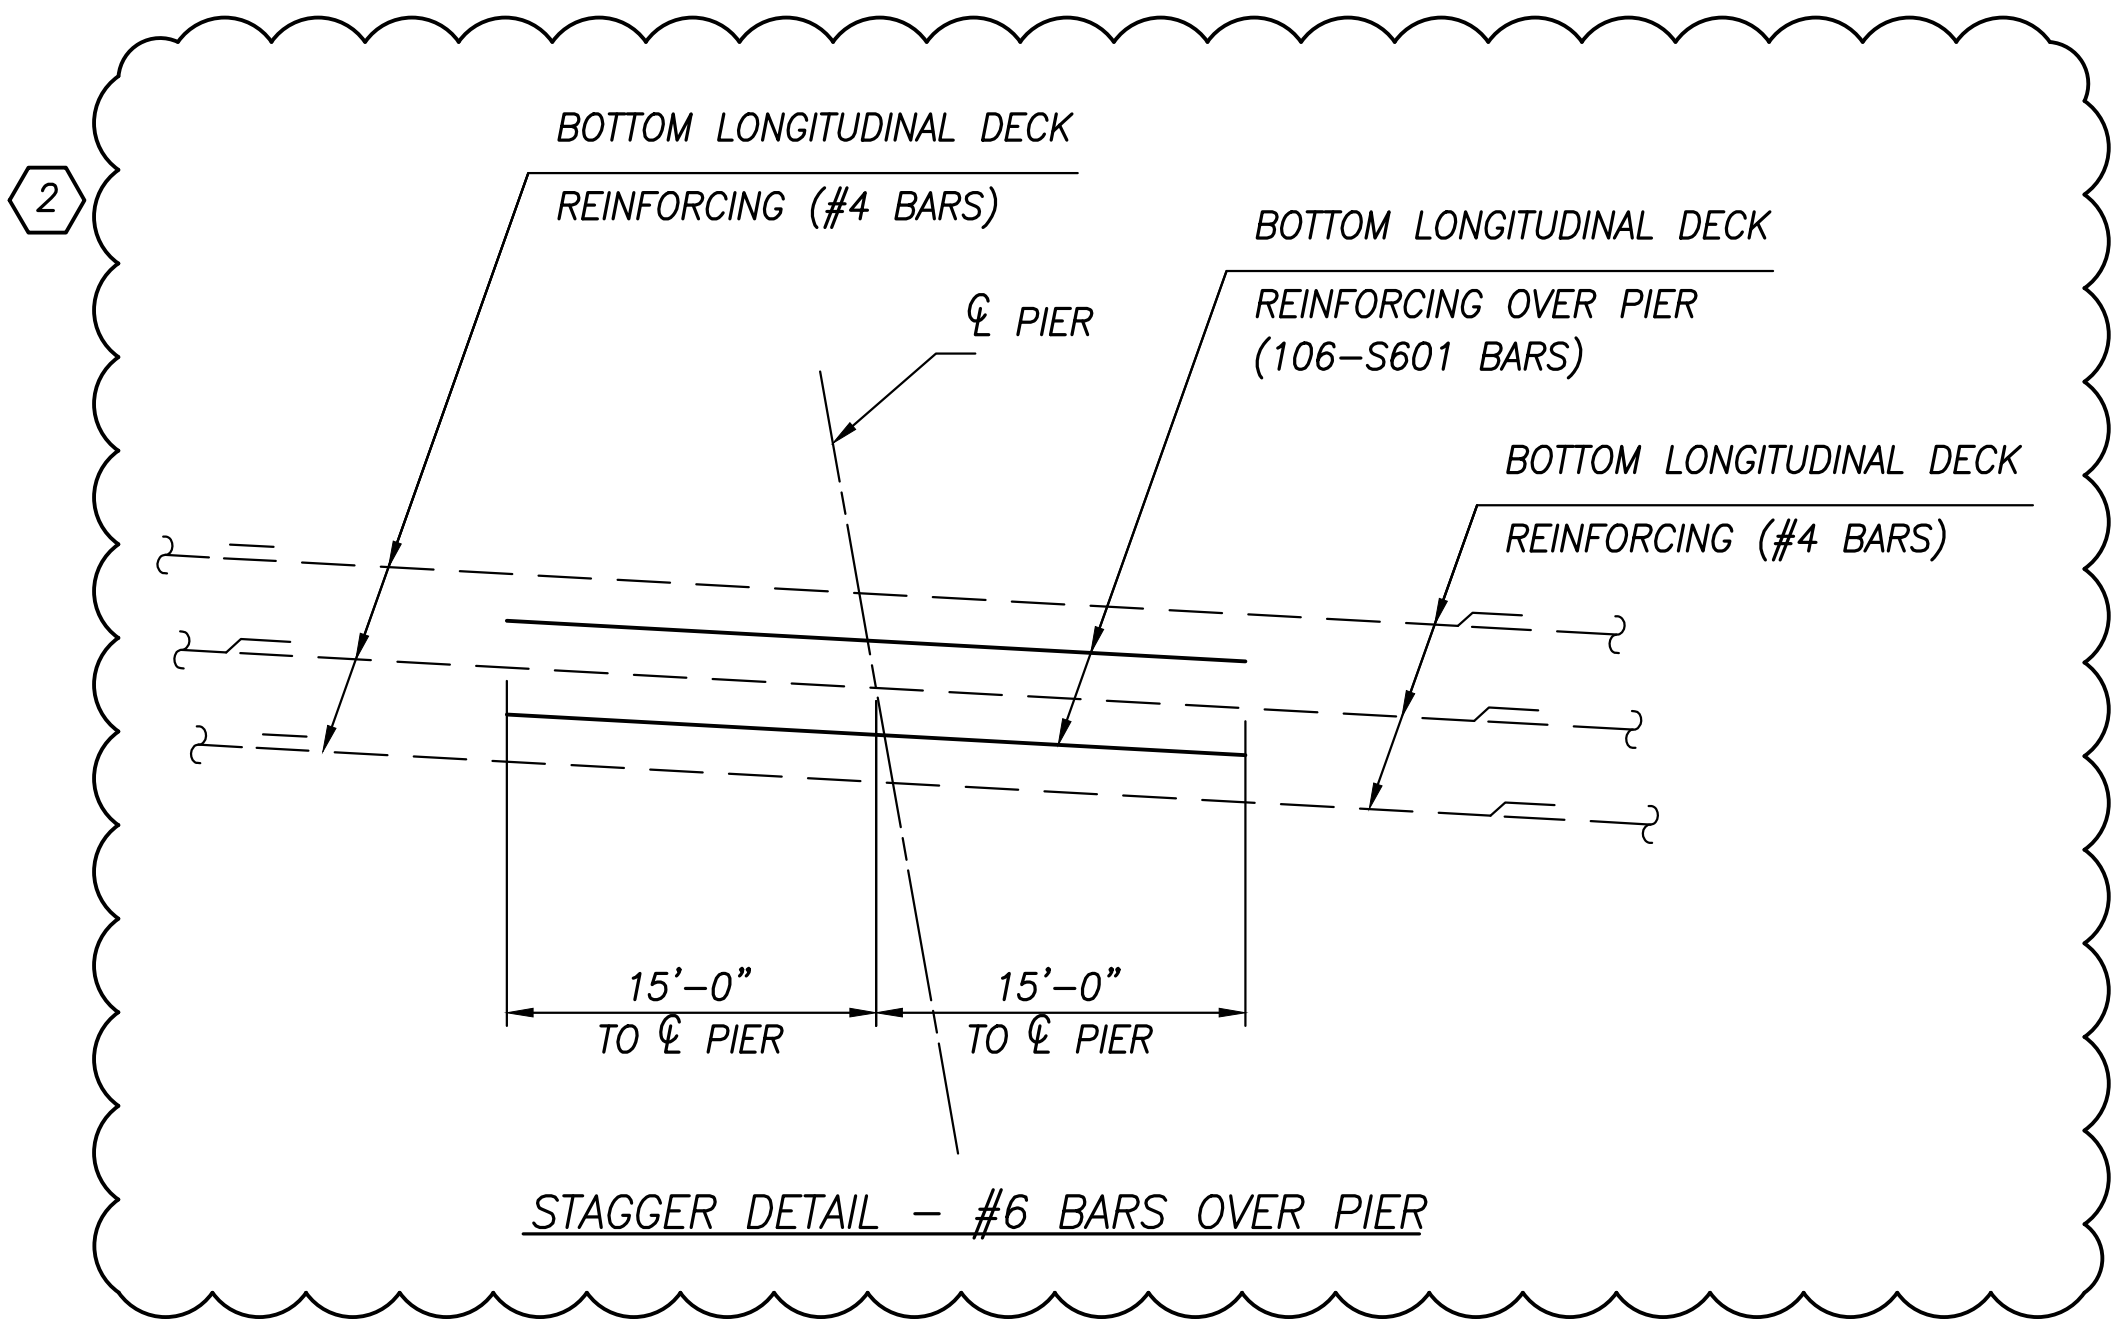


LEGEND:

- (1-1A) - GIRDER IDENTIFICATION
- \* - MEASURED ALONG  $\phi$  PROP. R/W & CONSTR. I.R. 75
- \*\* - MEASURED PERPENDICULAR TO  $\phi$  PROP. R/W & CONSTR. I.R. 75

NOTES:

1. FOR TRANSVERSE SECTION, SEE SHEET 139/216.
2. FOR PARAPET AND MEDIAN BARRIER DETAILS, SEE SHEETS 119/216 THRU 134/216.
3. FOR SCREED, TOP OF HAUNCH, AND FINAL DECK ELEVATIONS, SEE SHEETS 143/216 THRU 192/216.
4. FOR REINFORCING STEEL LIST, SEE SHEETS 210/216 AND 211/216.
5. FOR EXPANSION JOINT DETAILS, SEE SHEET 118/216.
6. BARS CALLED OUT  $\phi$  BEAM-TO- $\phi$  BEAM AND TYP. BETWEEN BEAMS TO SIMPLIFY CALLOUTS. HOWEVER, THERE IS ONLY ONE REBAR LINE ON BEAM  $\phi$ .
7. FOR TOP REINFORCING, SEE SHEETS 104/216 AND 105/216.
8. FOR HAUNCH REINFORCING, SEE SHEET 114/216.
9. MINIMUM REBAR LAP LENGTHS ARE AS FOLLOWS:  
 NO. 4 (HOR.) 3'-3"

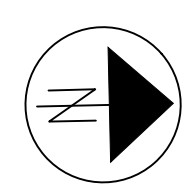

11/23/2020 JANSSEN & SPAANS ENGINEERING INC. -  
 ADDED REBAR OVER PIERS.

5/1/2020 JANSSEN & SPAANS ENGINEERING INC. -  
 RECONSTRUCTED NORTHBOUND ON-RAMP SHEET REPLACED  
 DESIGN AGENCY  
 JANSSEN & SPAANS ENGINEERING, INC.  
 9120 HARRISON PARK COURT  
 INDIANAPOLIS, IN 46216

DESIGNED W03  
 CHECKED CBS

DRAWN W03  
 REM W03  
 REVISIONS


SLAB PLAN - 19 OF 27  
 BRIDGE NO. LUC-75-0029 L/R  
 I.R. 75 OVER MAUMEE RIVER

W00/LUC-75-  
 30.70/0.00  
 PID No. 93592


103/216

1396  
 1792

Date: Oct 07, 2020, 5:03pm User Name: mlongtin  
 File: P:\1321 - Toledo E Value Engineering\DWG\5\BRIDGE\LUC-75-0027 over Maumee River\Sheets\075\_0027C\_DP010.dwg

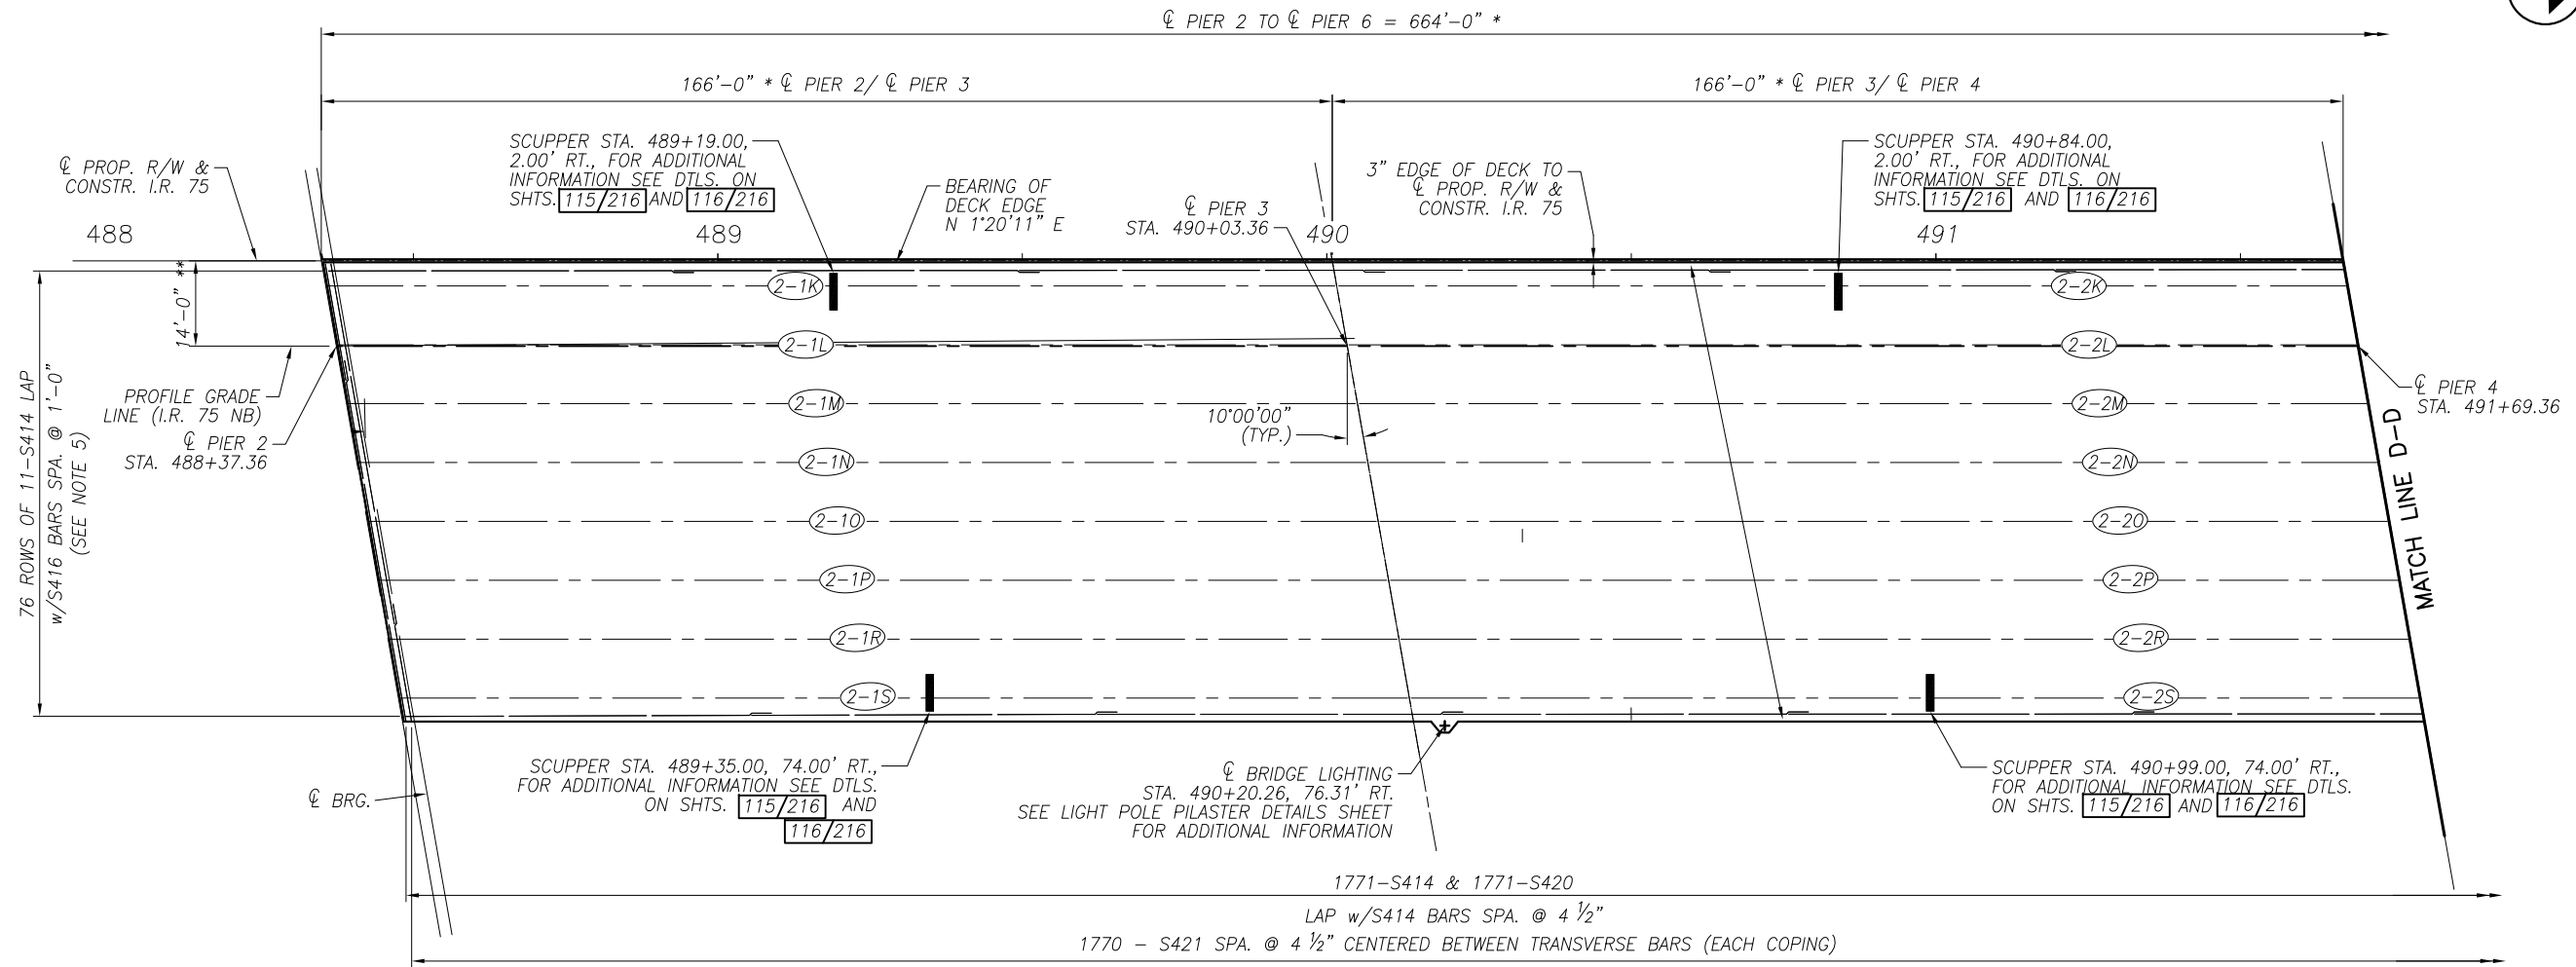

**SLAB PLAN - TOP REINFORCING**  
 UNIT 2 NORTHBOUND BRIDGE

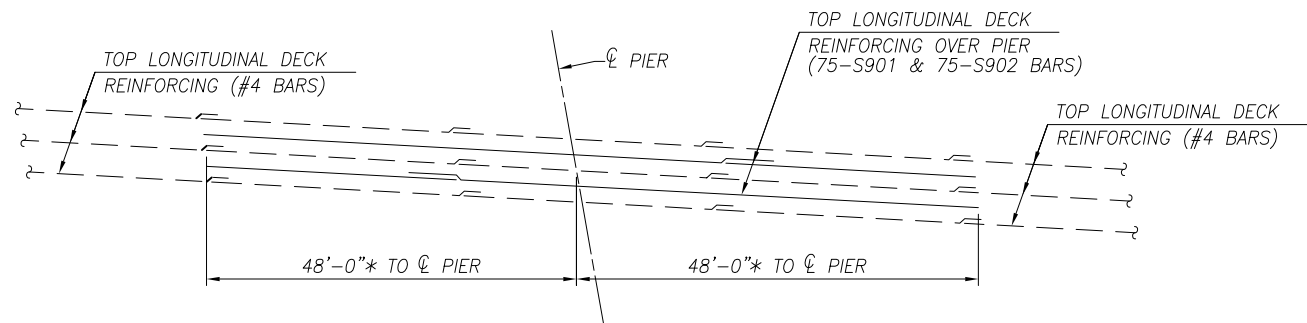

**STAGGER DETAIL - #9 BARS OVER PIER**

**LEGEND:**

- (1-1A) - GIRDER IDENTIFICATION
- \* - MEASURED ALONG CL PROP. R/W & CONSTR. I.R. 75
- \*\* - MEASURED PERPENDICULAR TO CL PROP. R/W & CONSTR. I.R. 75


**NOTES:**

1. FOR TRANSVERSE SECTION, SEE SHEET 139/216.
2. FOR PARAPET AND MEDIAN BARRIER DETAILS, SEE SHEETS 119/216 THRU 134/216.
3. FOR SCREED, TOP OF HAUNCH, AND FINAL DECK ELEVATIONS, SEE SHEETS 143/216 THRU 192/216.
4. FOR REINFORCING STEEL LIST, SEE SHEETS 210/216 AND 211/216.
5. FOR EXPANSION JOINT DETAILS, SEE SHEETS 118/216.
6. FOR BOTTOM REINFORCING, SEE SHEETS 99/216 THRU 103/216.
7. MINIMUM REBAR LAP LENGTHS ARE AS FOLLOWS:


NO. 4 (HOR.) 3'-3"  
 NO. 9 (HOR.) 10'-2"



3 5/1/2020 JANSSEN & SPANNS ENGINEERING INC. - RECONFIGURED NORTHBOUND ON RAMP SHEET REPLACED  
 DESIGN AGENCY: JANSSEN & SPANNS ENGINEERING, INC. 9120 HARRISON PARK COURT INDIANAPOLIS, IN 46216  
 DATE: 5/2020  
 REVIEWED: WJZ  
 DRAWN: REM  
 CHECKED: CBS  
 STRUCTURE FILE NUMBER: 4802765/4802767  
 SLAB PLAN - 20 OF 27  
 BRIDGE NO. LUC-75-0029 L/R  
 I.R. 75 OVER MAUMEE RIVER  
 W00/LUC-75-30.70/0.00  
 PID No. 93592  
 104/216  
 1397  
 1792

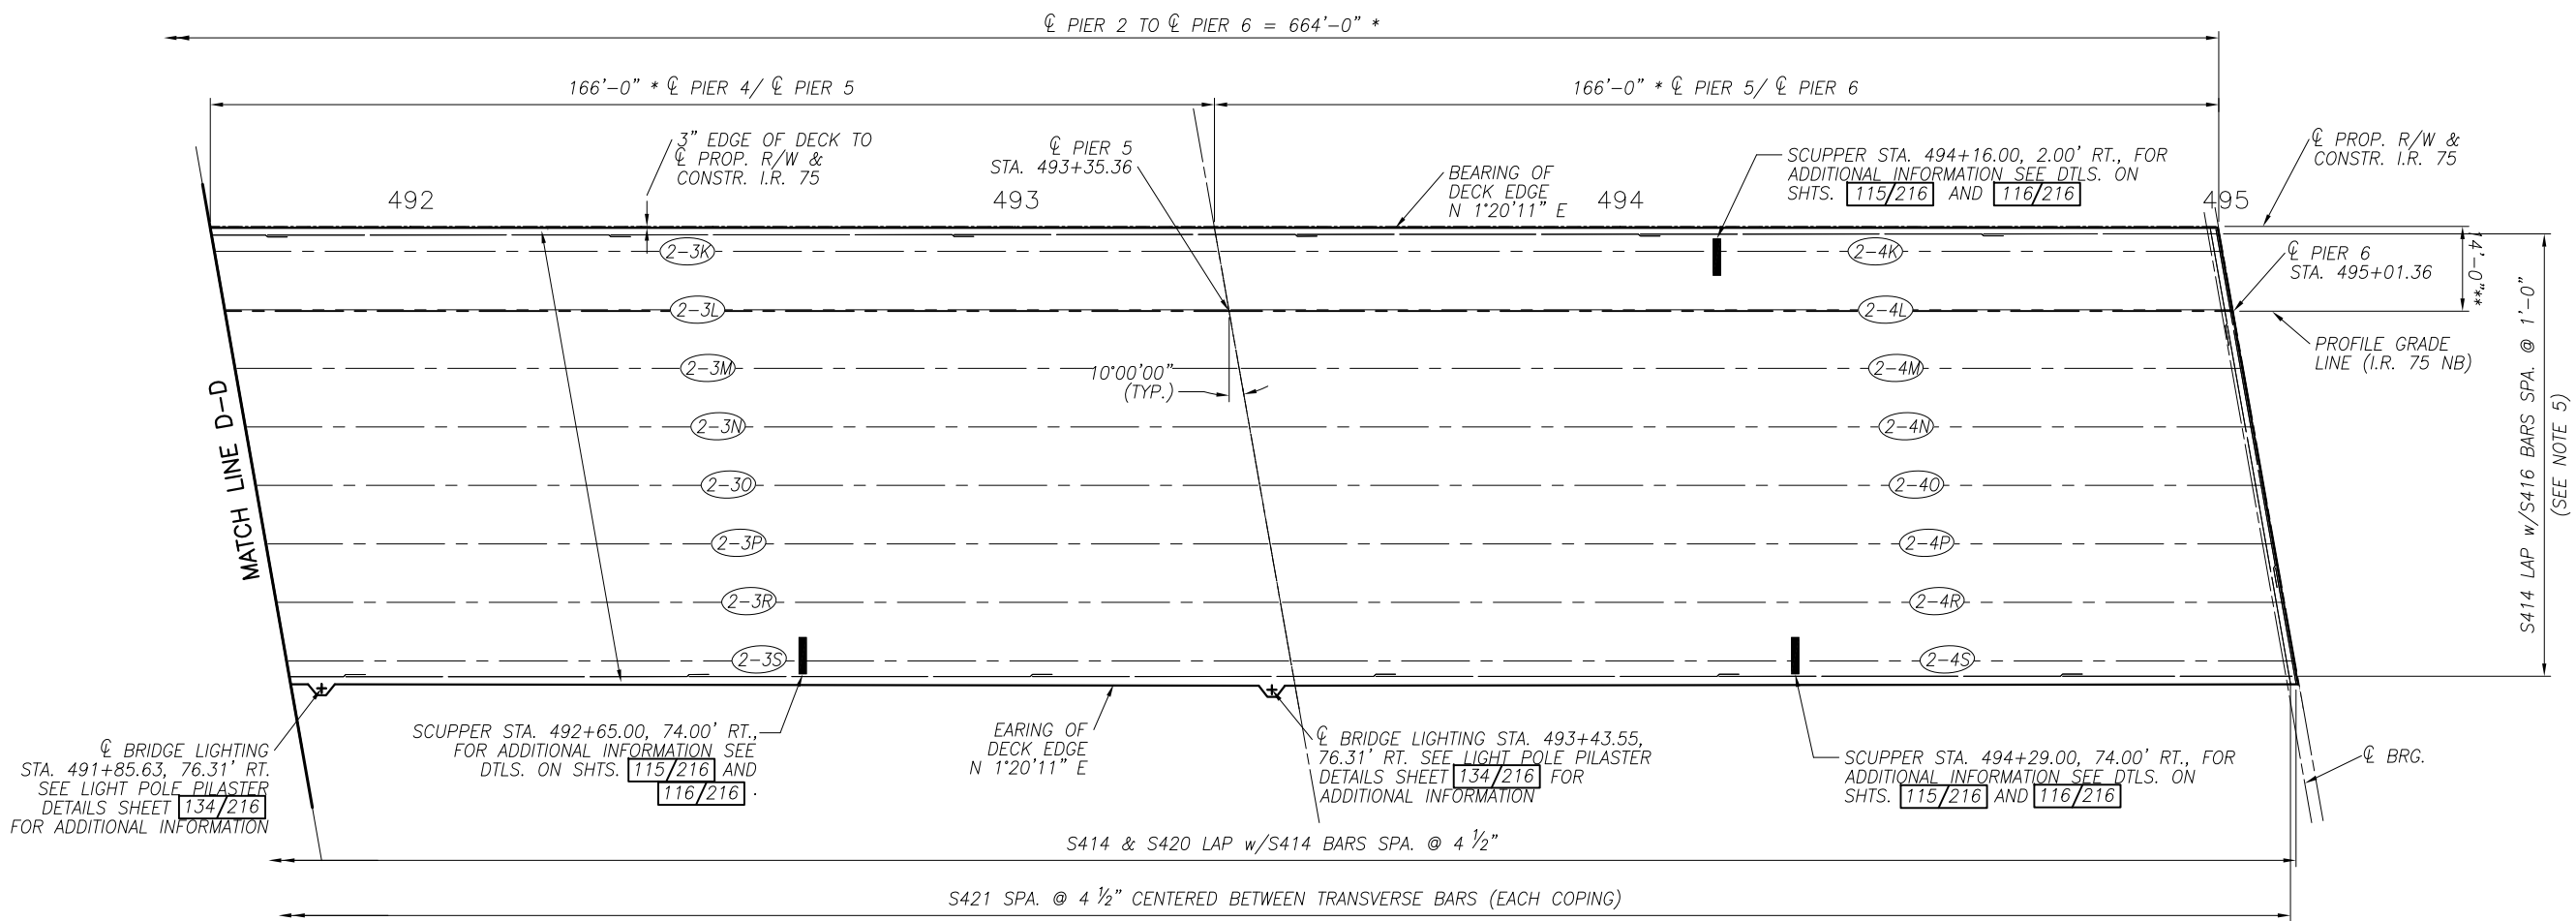

**SLAB PLAN – TOP REINFORCING**  
UNIT 2 NORTHBOUND BRIDGE

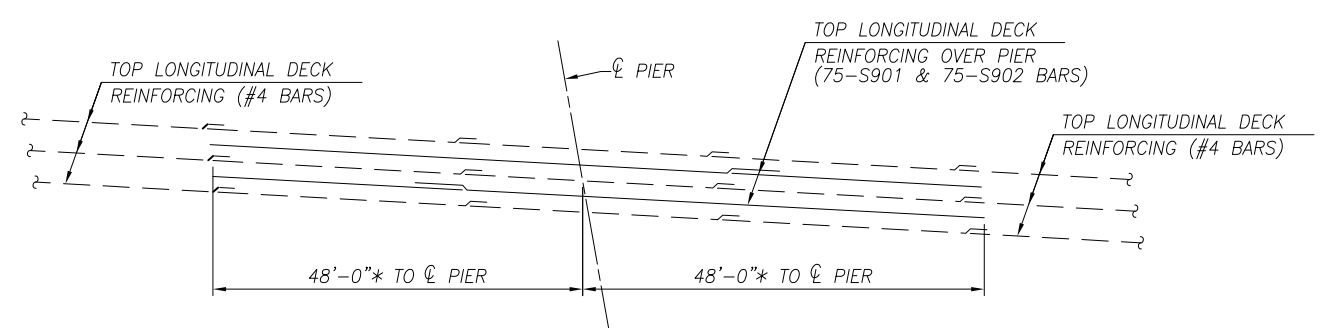

**STAGGER DETAIL – #9 BARS OVER PIER**

**NOTES:**

- FOR TRANSVERSE SECTION, SEE SHEET 139/216.
- FOR PARAPET AND MEDIAN BARRIER DETAILS, SEE SHEETS 119/216 THRU 134/216.
- FOR SCREED, TOP OF HAUNCH, AND FINAL DECK ELEVATIONS, SEE SHEETS 143/216 THRU 192/216.
- FOR REINFORCING STEEL LIST, SEE SHEETS 210/216 AND 211/216.
- FOR EXPANSION JOINT DETAILS, SEE SHEET 118/216.
- FOR BOTTOM REINFORCING, SEE SHEETS 99/216 THRU 103/216.
- MINIMUM REBAR LAP LENGTHS ARE AS FOLLOWS:  
NO. 4 (HOR.) 3'-3"  
NO. 9 (HOR.) 10'-2"

**LEGEND:**

- (1-1A) – GIRDER IDENTIFICATION
- \* – MEASURED ALONG  $\phi$  PROP. R/W & CONSTR. I.R. 75
- \*\* – MEASURED PERPENDICULAR TO  $\phi$  PROP. R/W & CONSTR. I.R. 75


Date: Oct 07, 2020, 5:04pm User Name: mlongtin File: P:\11321 - Toledo E Value Engineering\DWG\SLAB\DC\1075-0027 over Maumee River\Sheets\075\_0027C\_DP010.dwg

<b>3</b> 5/1/2020 JANSSEN & SPAANS ENGINEERING INC. – RECONFIGURED NORTHBOUND ON RAMP SHEET REPLACED	
DESIGNED: WJZ CHECKED: CBS	DATE: 5/2020 REVIEWED: WJZ DRAWN: REM REVISIONS:
SLAB PLAN – 21 OF 27 BRIDGE NO. LUC-75-0029 L/R I.R. 75 OVER MAUMEE RIVER	
W00/LUC-75-30.70/0.00 PID No. 93592	
105/216	
1398 1792	


DESIGN AGENCY:  
**JANSSEN & SPAANS ENGINEERING, INC.**  
 9120 HARRISON PARK COURT  
 INDIANAPOLIS, IN 46216



Date: Dec 04, 2020, 10:15am User Name: mlongtin  
 File: \\jse.com\files\projects\1321 - Toledo E Value Engineering\DWG5\BRIDGE\LUC-75-0027 over Maumee River\Sheets\075\_0027C\_DP011.dwg

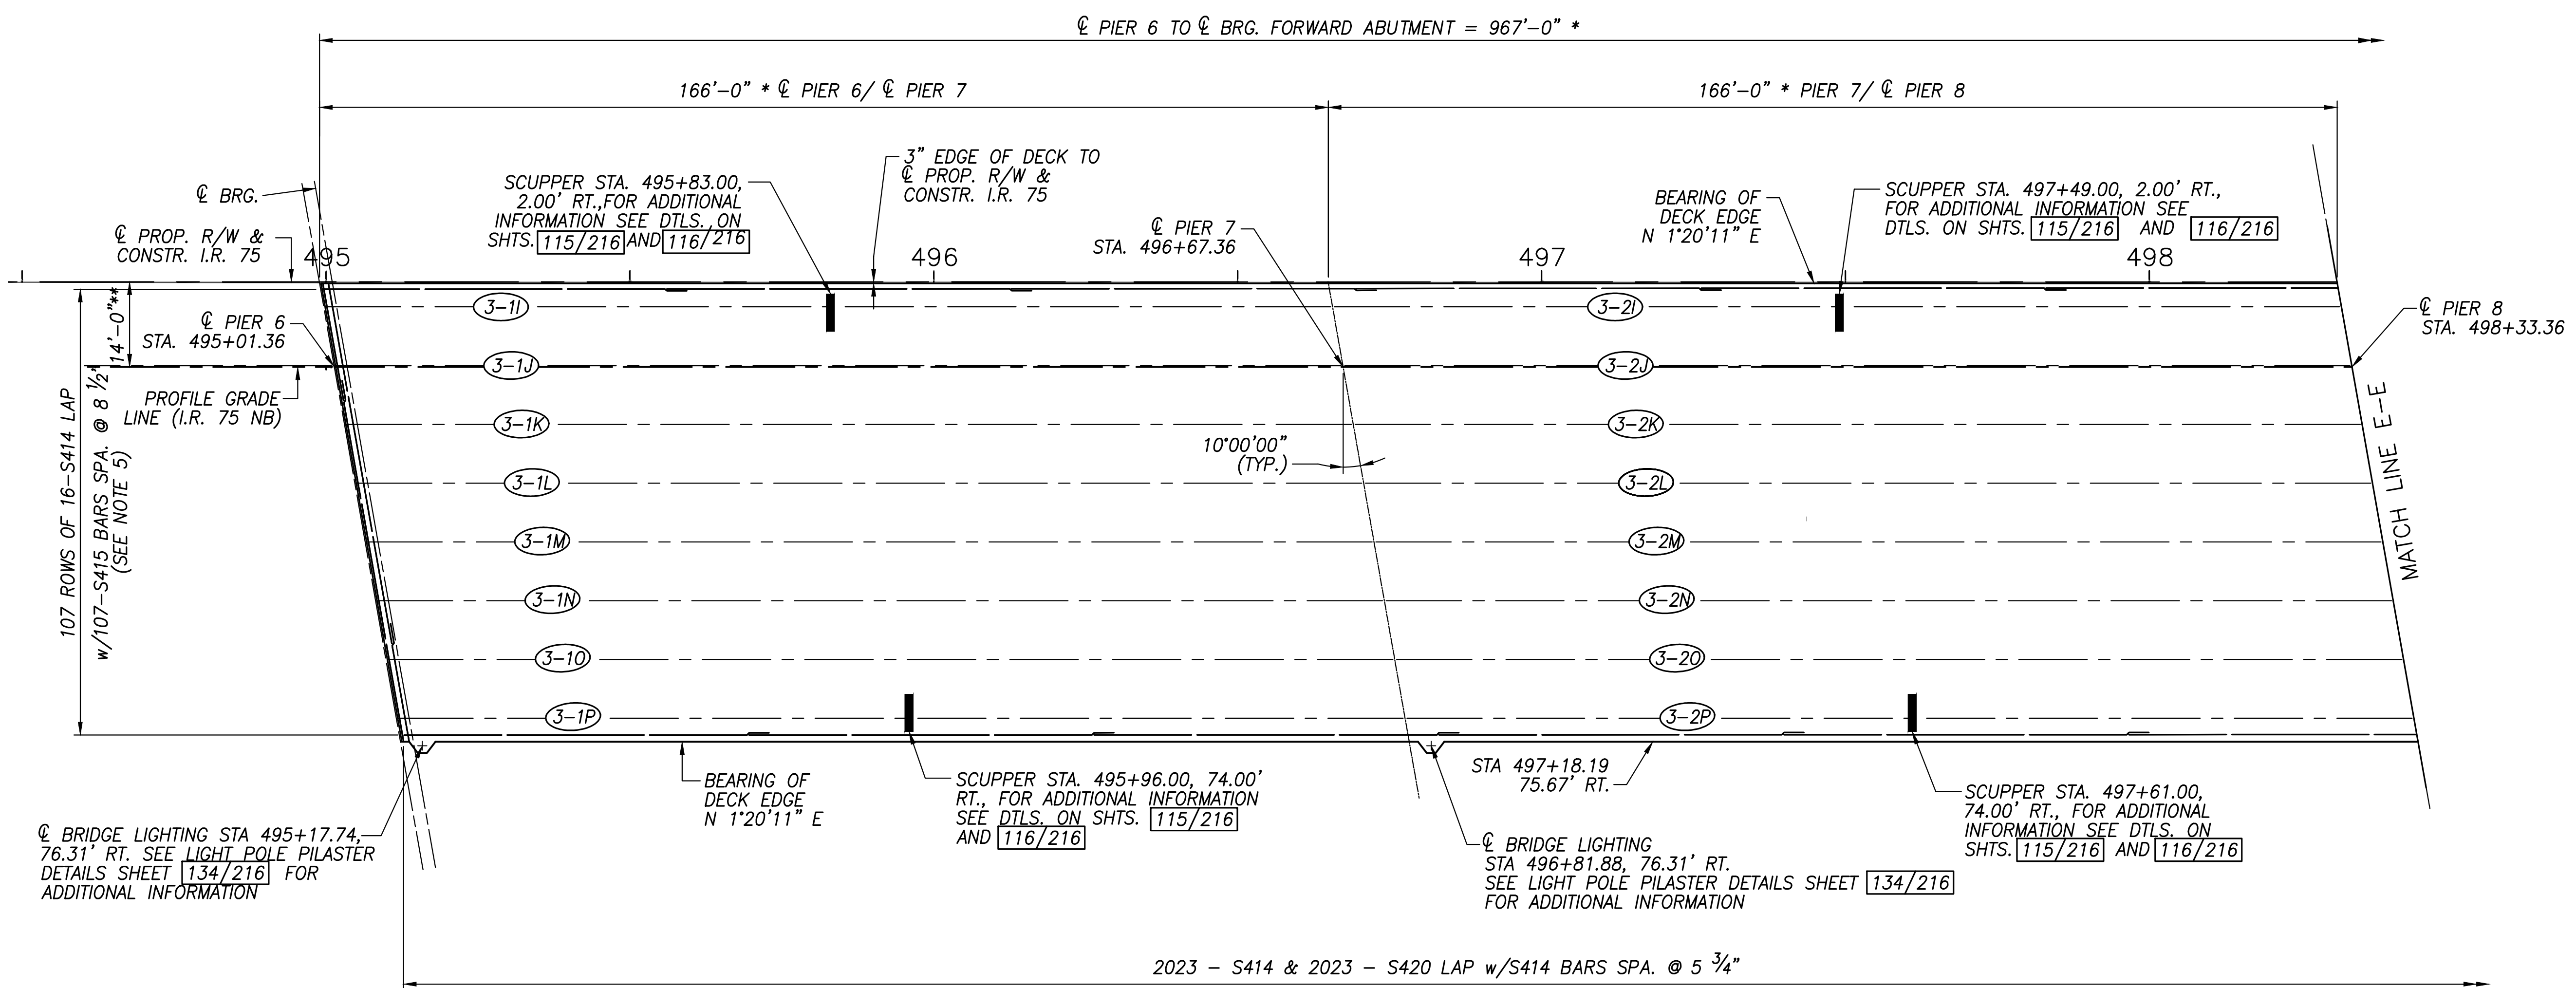

SLAB PLAN - BOTTOM REINFORCING  
 UNIT 3 NORTHBOUND BRIDGE

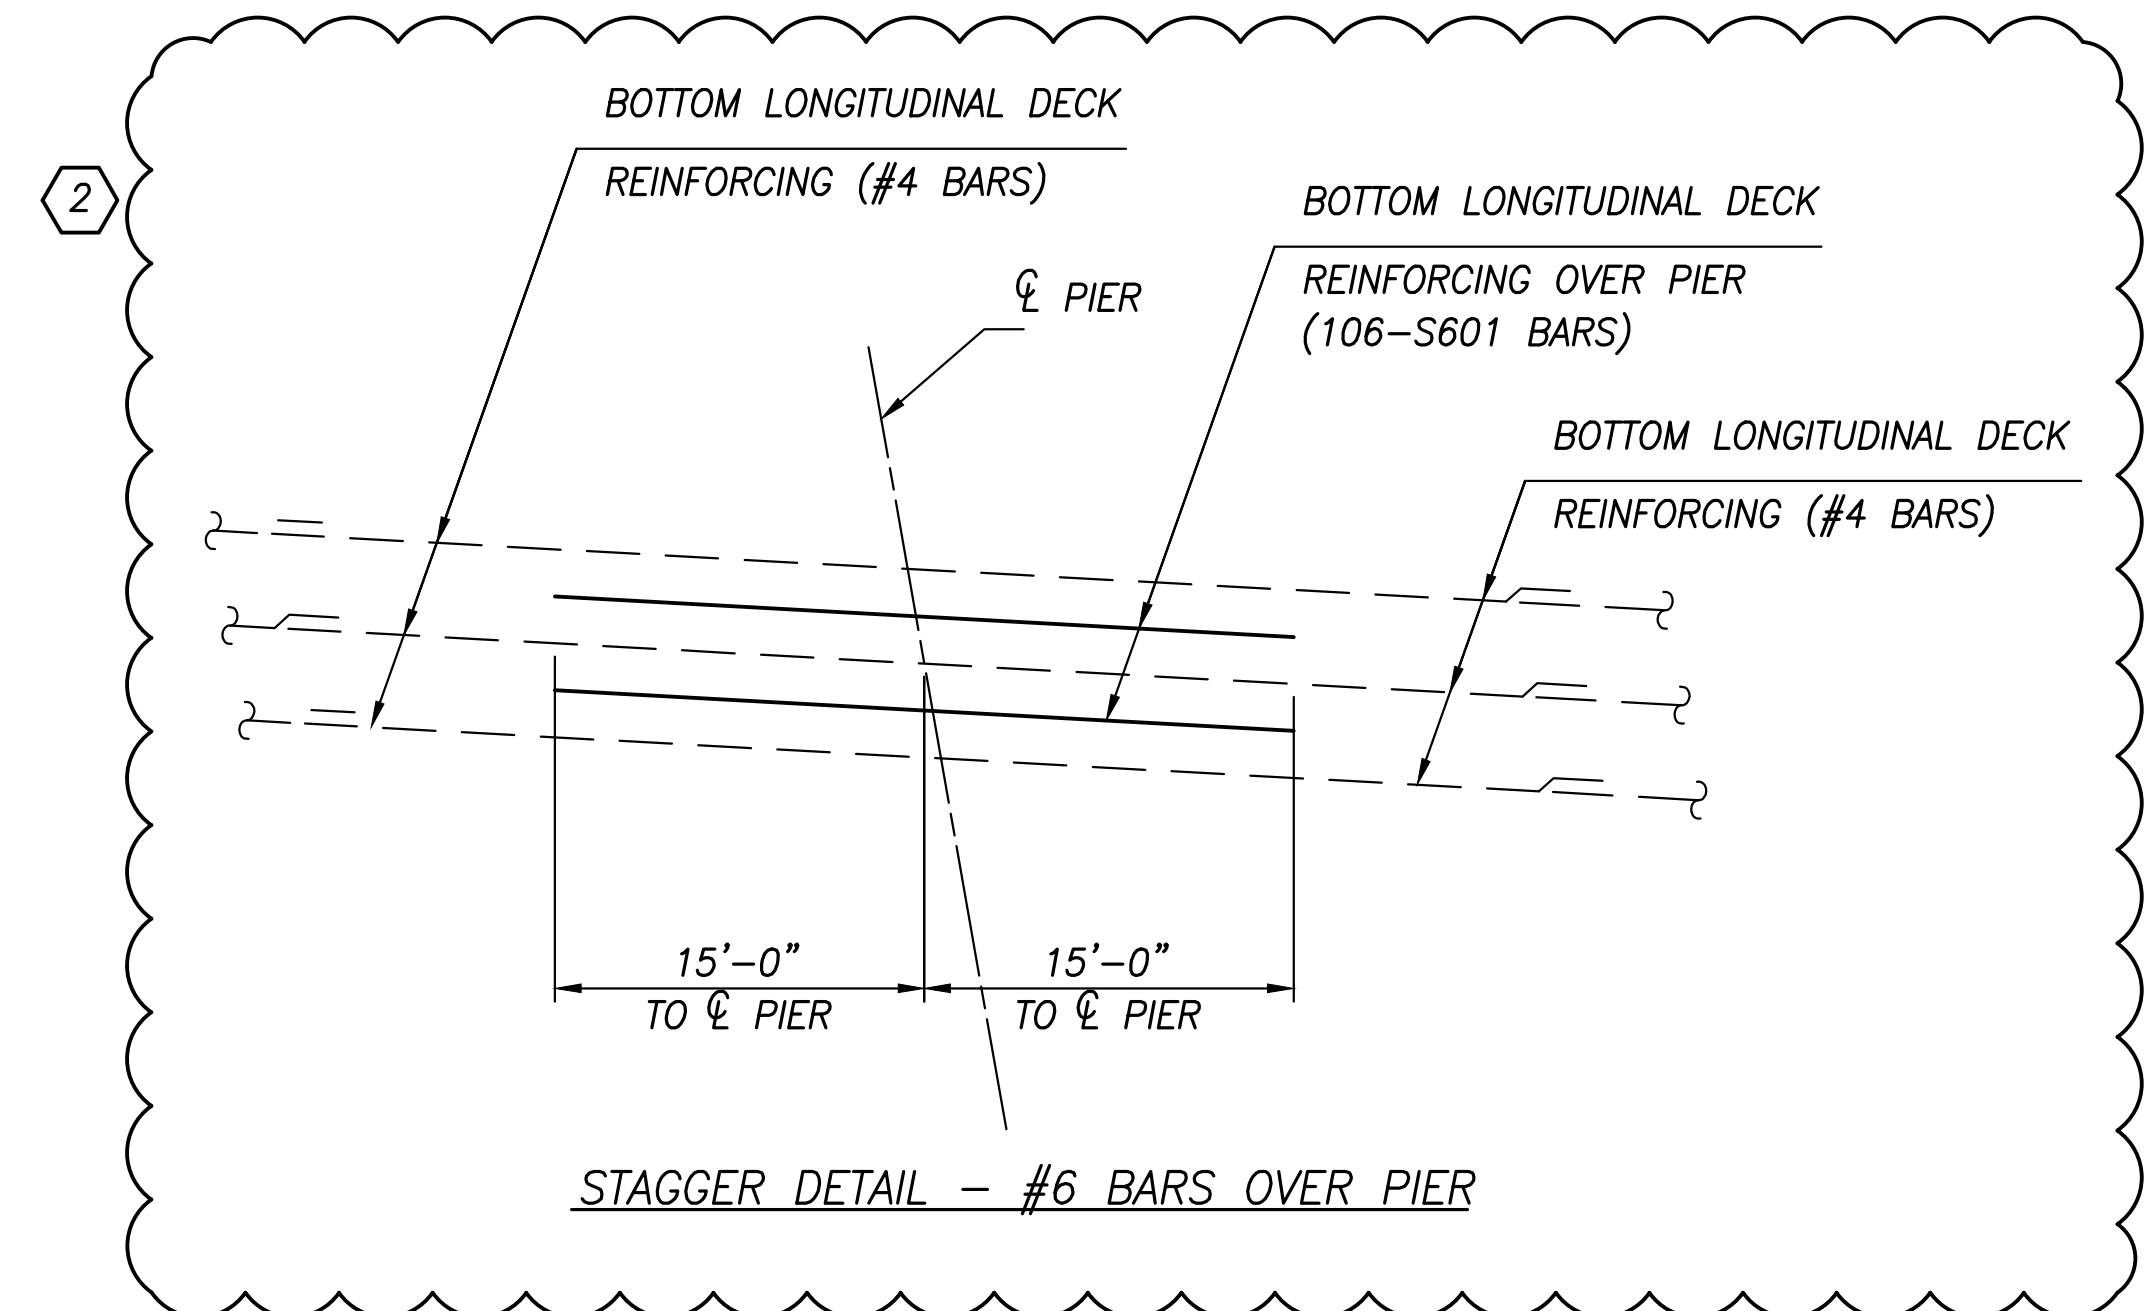


NOTES:

- FOR TRANSVERSE SECTION, SEE SHEET [140/216].
- FOR PARAPET AND MEDIAN BARRIER DETAILS, SEE SHEETS [119/216] THRU [134/216].
- FOR SCREED, TOP OF HAUNCH, AND FINAL DECK ELEVATIONS, SEE SHEETS [143/216] THRU [192/216].
- FOR REINFORCING STEEL LIST, SEE SHEETS [210/216] AND [211/216].
- FOR EXPANSION JOINT DETAILS, SEE SHEET [118/216].
- BARS CALLED OUT  $\phi$  BEAM-TO- $\phi$  BEAM AND TYP. BETWEEN BEAMS TO SIMPLYIFY CALLOUTS. HOWEVER, THERE IS ONLY ONE REBAR LINE ON BEAM  $\phi$ .
- FOR TOP REINFORCING, SEE SHEETS [109/216] THRU [111/216].
- FOR HAUNCH REINFORCING, SEE SHEET [114/216].
- MINIMUM REBAR LAP LENGTHS ARE AS FOLLOWS:

LEGEND:

- (1-1A) - GIRDER IDENTIFICATION
- \* - MEASURED ALONG  $\phi$  PROP. R/W & CONSTR. I.R. 75
- \*\* - MEASURED PERPENDICULAR TO  $\phi$  PROP. R/W & CONSTR. I.R. 75

NO. 4 (HOR.) 3'-3"

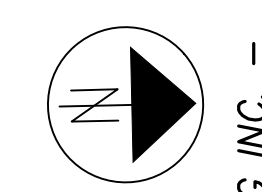

11/23/2020 JANSSEN & SPAANS ENGINEERING INC. - ADDED REBAR OVER PIERS.  
 5/1/2020 JANSSEN & SPAANS ENGINEERING INC. - RECONFIGURED NORTHBOUND ON RAMP SHEET REPLACED

DESIGN AGENCY  
**JANSSEN & SPAANS ENGINEERING, INC.**  
 9120 HARRISON PARK COURT  
 INDIANAPOLIS, IN 46216

DESIGNED	DRAWN	REVIEWED	DATE
WOZ	REM	JTH	8/18
CRC	REVISED	STRUCTURE FILE NUMBER	4802765/4802767


SLAB PLAN - 22 OF 27  
 BRIDGE NO. LUC-75-0029 L/R  
 I.R. 75 OVER MAUMEE RIVER

W00/LUC-75-30.70/0.00  
 PID No. 93592


106/216

1399  
 1792

Date: Dec 04, 2020, 10:20am User Name: mlongtin  
 File: \\jse.com\files\Projects\1321 - Toledo E Value Engineering\DWGS\Bridges\1075-0027 over Maumee River\Sheets\075\_0027C\_DP011.dwg

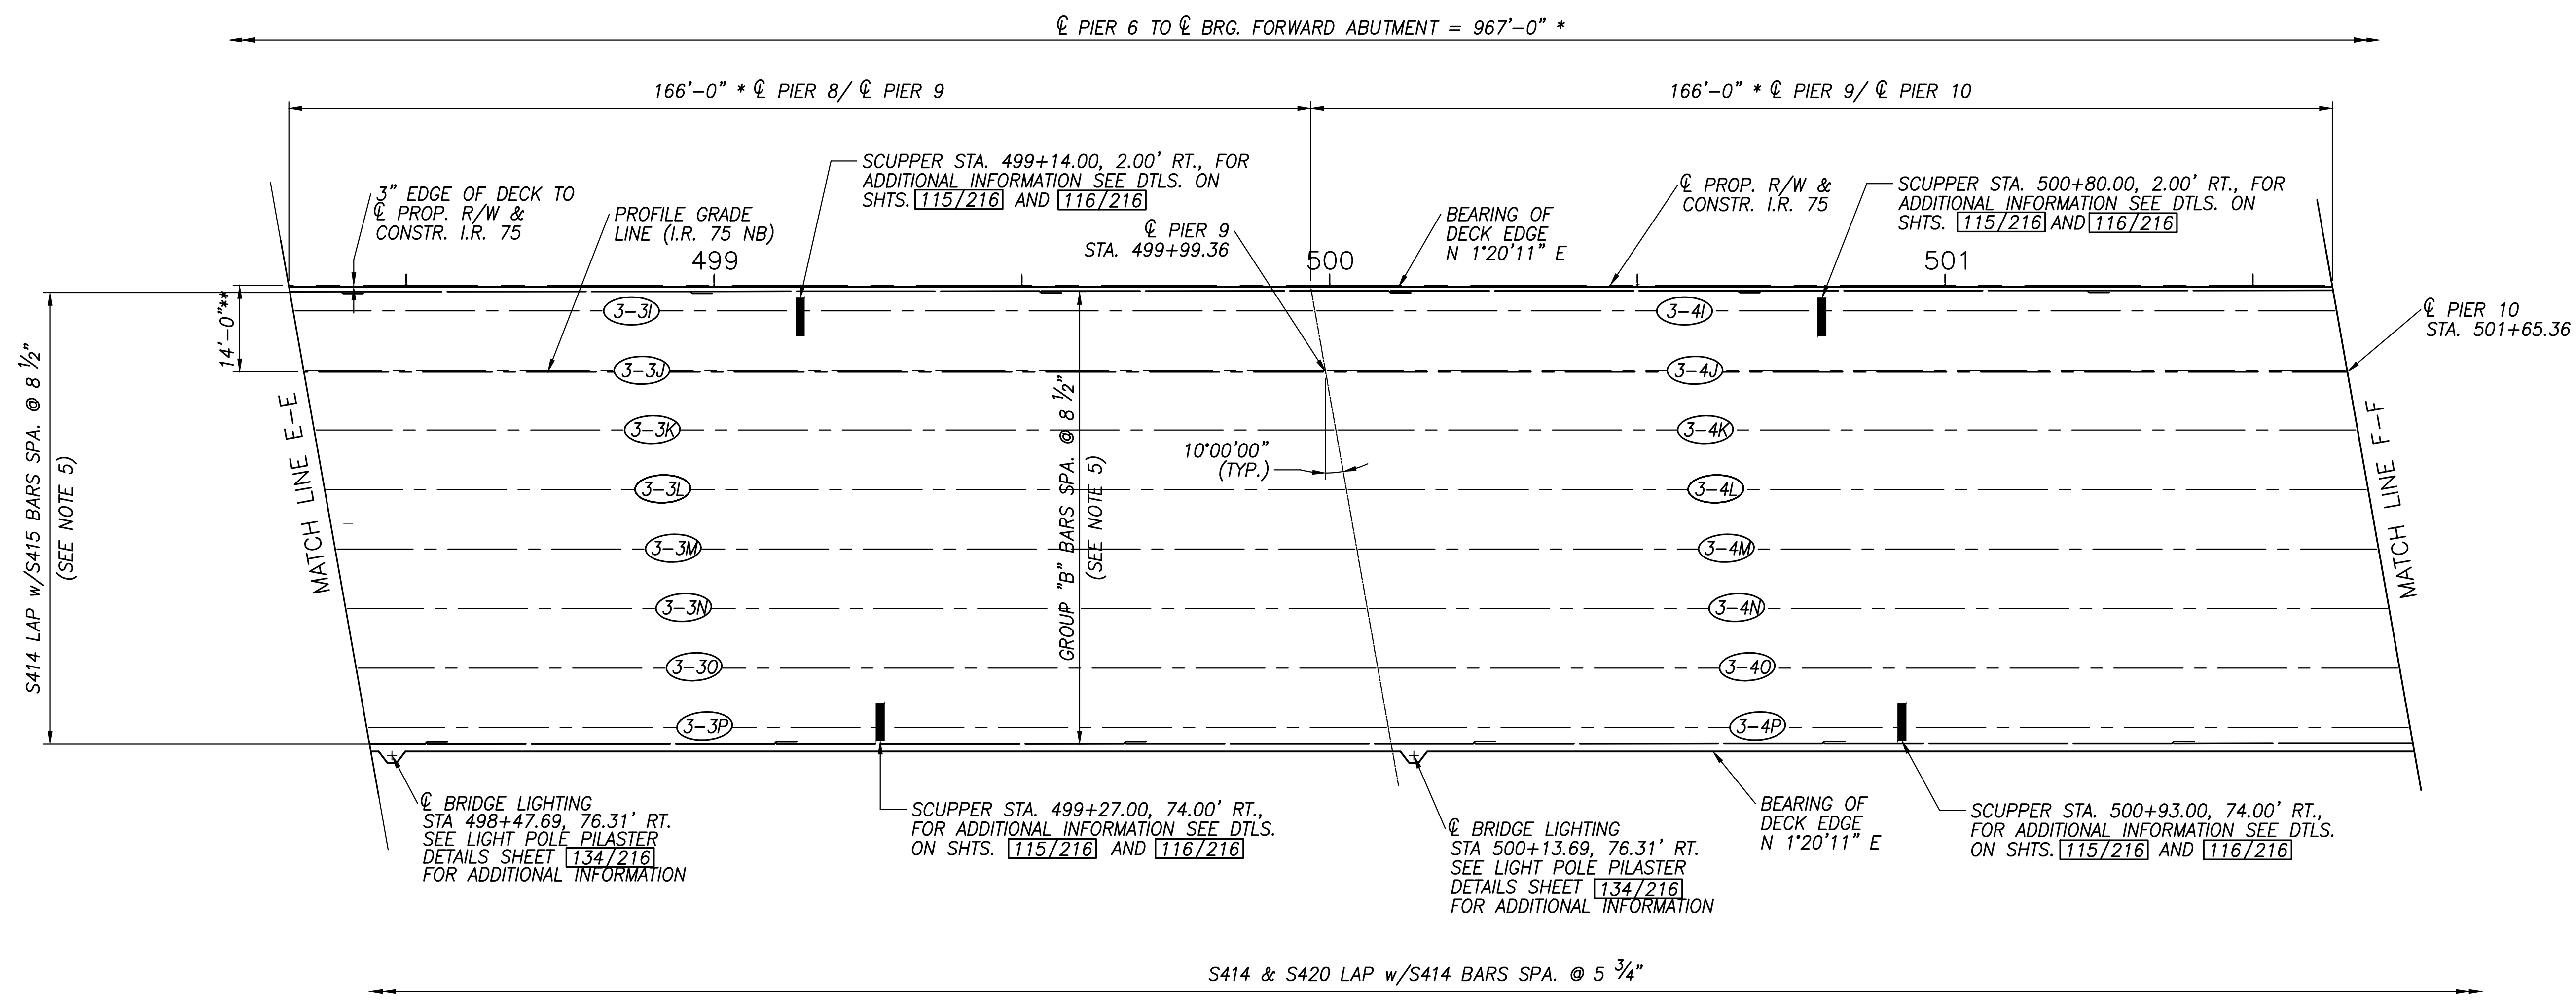

SLAB PLAN - BOTTOM REINFORCING  
 UNIT 3 NORTHBOUND BRIDGE

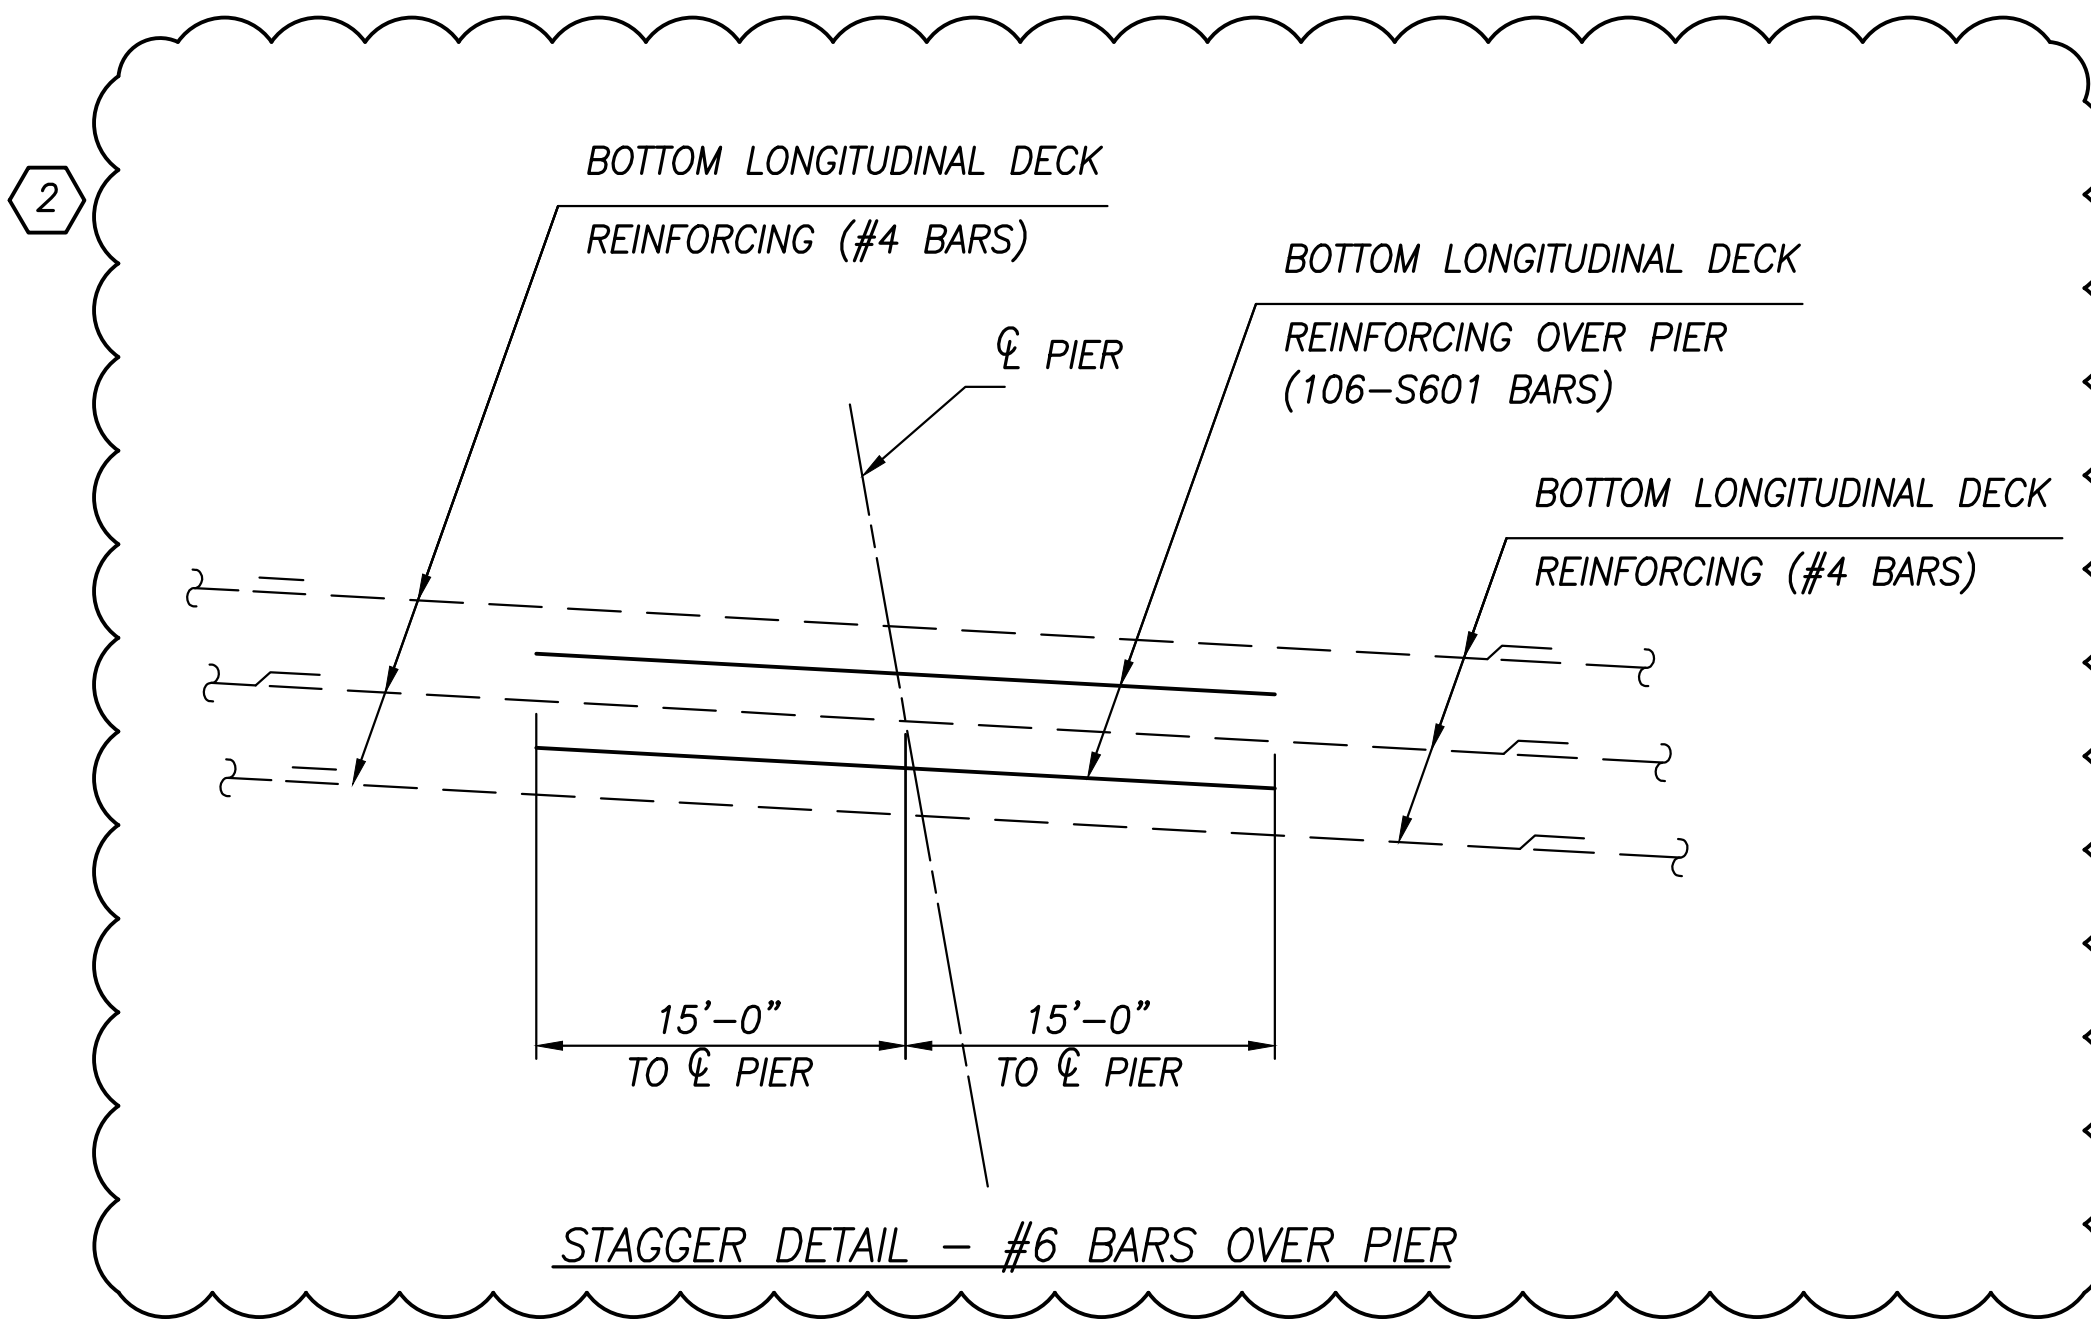


NOTES:

1. FOR TRANSVERSE SECTION, SEE SHEET [140/216].
2. FOR PARAPET AND MEDIAN BARRIER DETAILS, SEE SHEETS [119/216] THRU [134/216].
3. FOR SCREED, TOP OF HAUNCH, AND FINAL DECK ELEVATIONS, SEE SHEETS [143/216] THRU [192/216].
4. FOR REINFORCING STEEL LIST, SEE SHEETS [210/216] AND [211/216].
5. FOR EXPANSION JOINT DETAILS, SEE SHEET [118/216].
6. BARS CALLED OUT  $\phi$  BEAM-TO- $\phi$  BEAM AND TYP. BETWEEN BEAMS TO SIMPLYIFY CALLOUTS. HOWEVER, THERE IS ONLY ONE REBAR LINE ON BEAM  $\phi$ .
7. FOR TOP REINFORCING, SEE SHEETS [109/216] THRU [111/216].
8. FOR HAUNCH REINFORCING, SEE SHEET [114/216].
9. MINIMUM REBAR LAP LENGTHS ARE AS FOLLOWS:

LEGEND:

- (1-1A) - GIRDER IDENTIFICATION
- \* - MEASURED ALONG  $\phi$  PROP. R/W & CONSTR. I.R. 75
- \*\* - MEASURED PERPENDICULAR TO  $\phi$  PROP. R/W & CONSTR. I.R. 75

NO. 4 (HOR.) 3'-3"

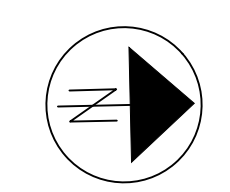

11/23/2020 JANSSEN & SPAANS ENGINEERING INC. - ADDED REBAR OVER PIERS.  
 5/1/2020 JANSSEN & SPAANS ENGINEERING INC. - RECONFIGURED NORTHBOUND ON RAMP SHEET REPLACED

DESIGN AGENCY  
**JANSSEN & SPAANS ENGINEERING, INC.**  
 9120 HARRISON PARK COURT  
 INDIANAPOLIS, IN 46216

DESIGNED	WOZ	CRC
CHECKED		
REVIEWED	JTH	
DATE	8/18	
STRUCTURE FILE NUMBER	4802765/4802767	


SLAB PLAN - 23 OF 27  
 BRIDGE NO. LUC-75-0029 L/R  
 I.R. 75 OVER MAUMEE RIVER

W00/LUC-75-30.70/0.00  
 PID No. 93592


107/216

1400  
 1792

Date: Dec 04, 2020, 10:20am User Name: mlongtin  
 File: \\jse.com\files\Projects\1321 - Toledo E Value Engineering\DWGS\BRIDGE\LUC-75-0027 over Maumee River\Sheets\075\_0027C\_DP011.dwg

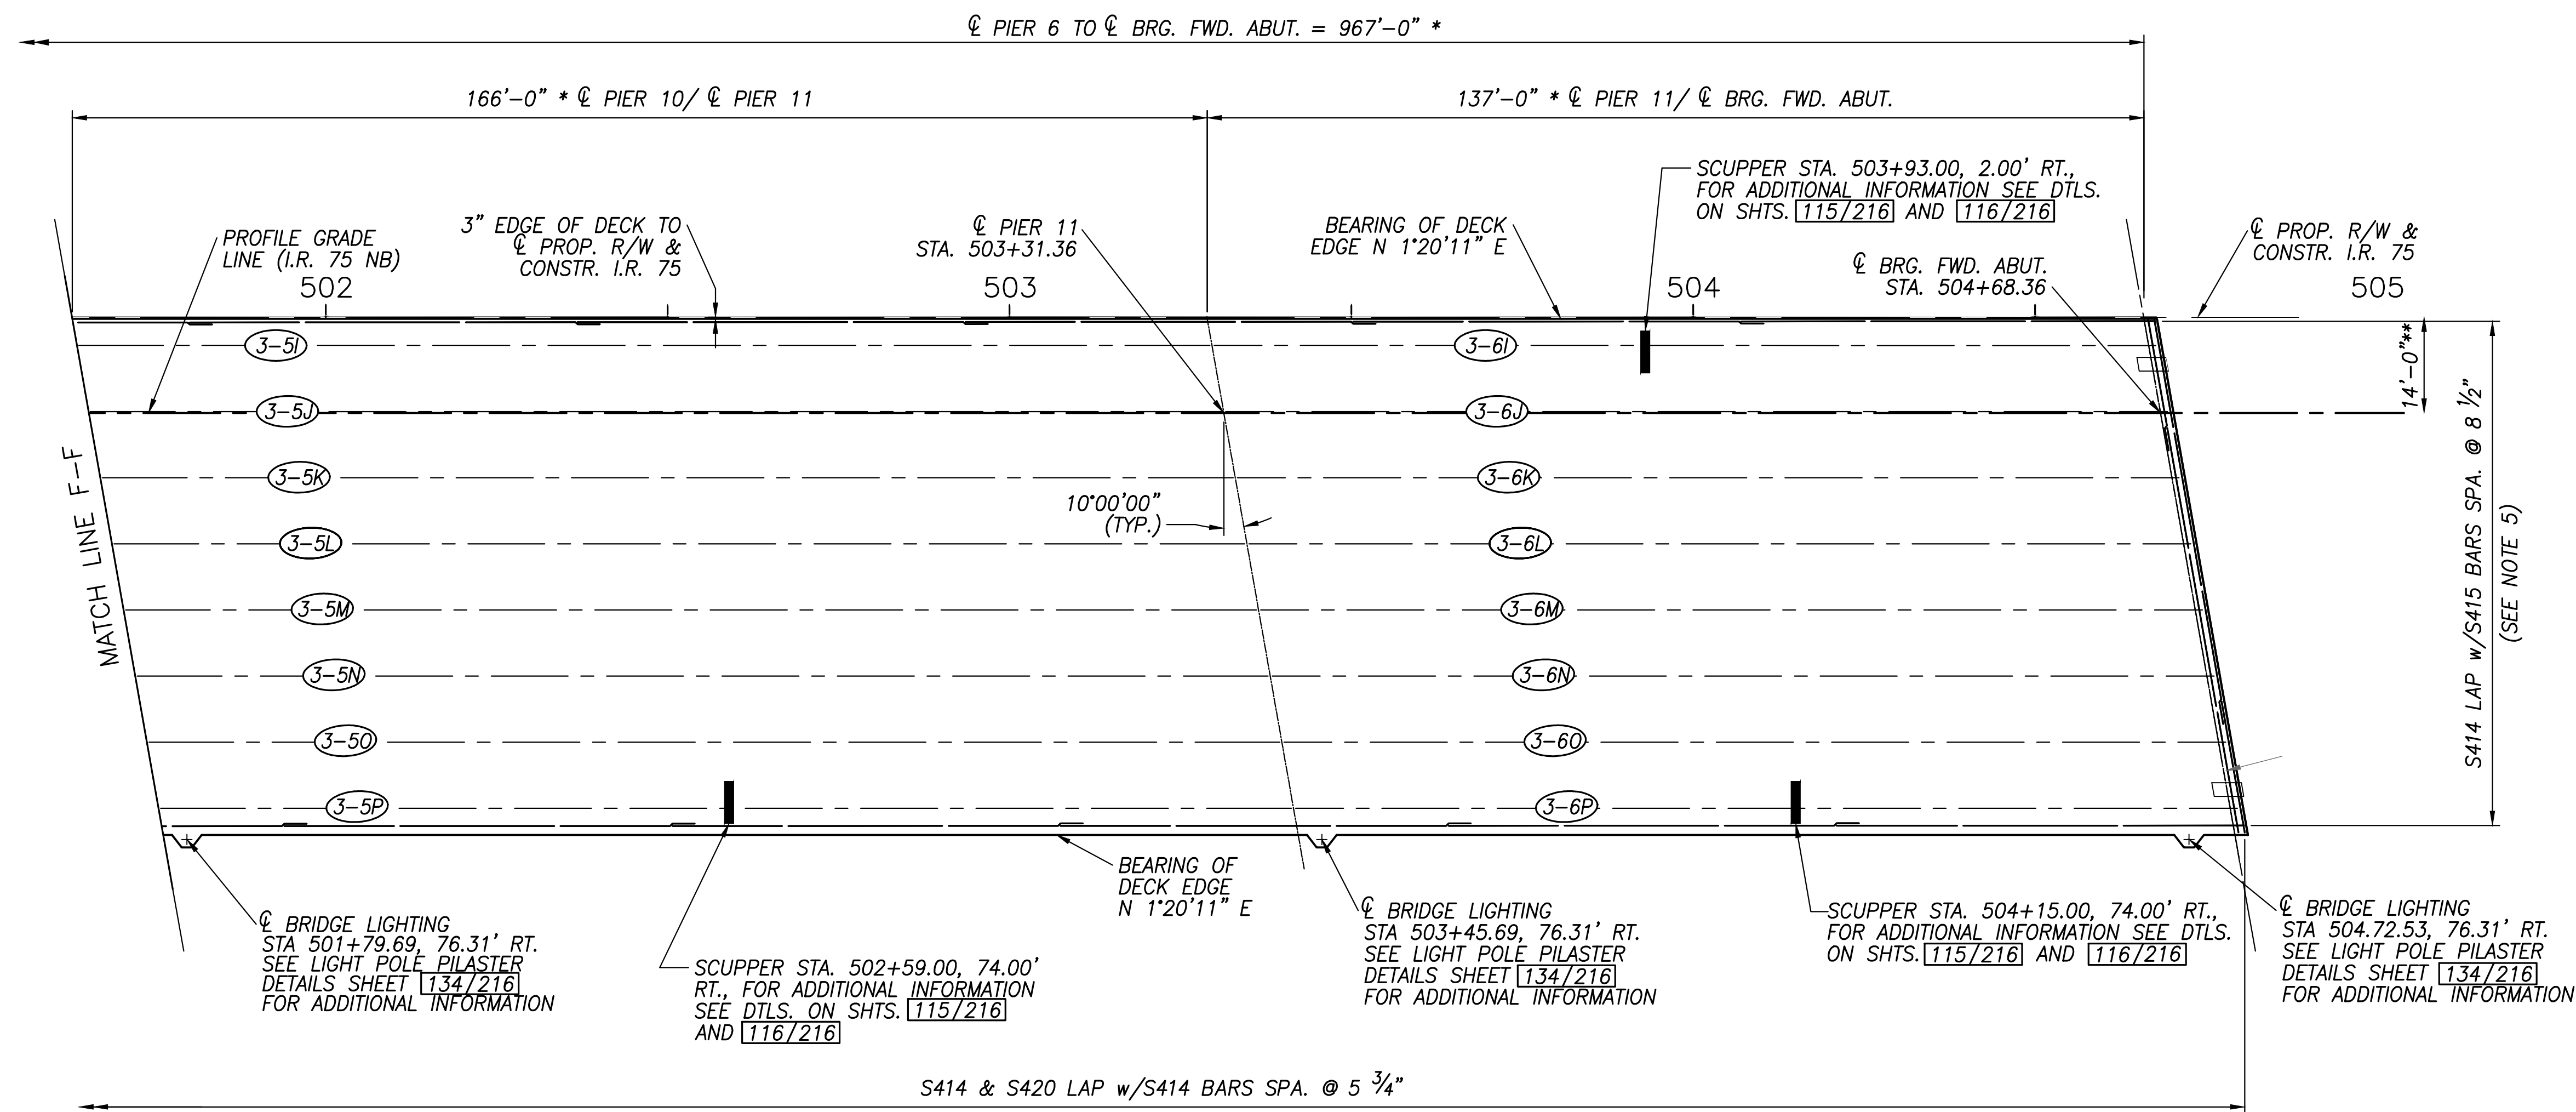

SLAB PLAN - BOTTOM REINFORCING  
 UNIT 3 NORTHBOUND BRIDGE

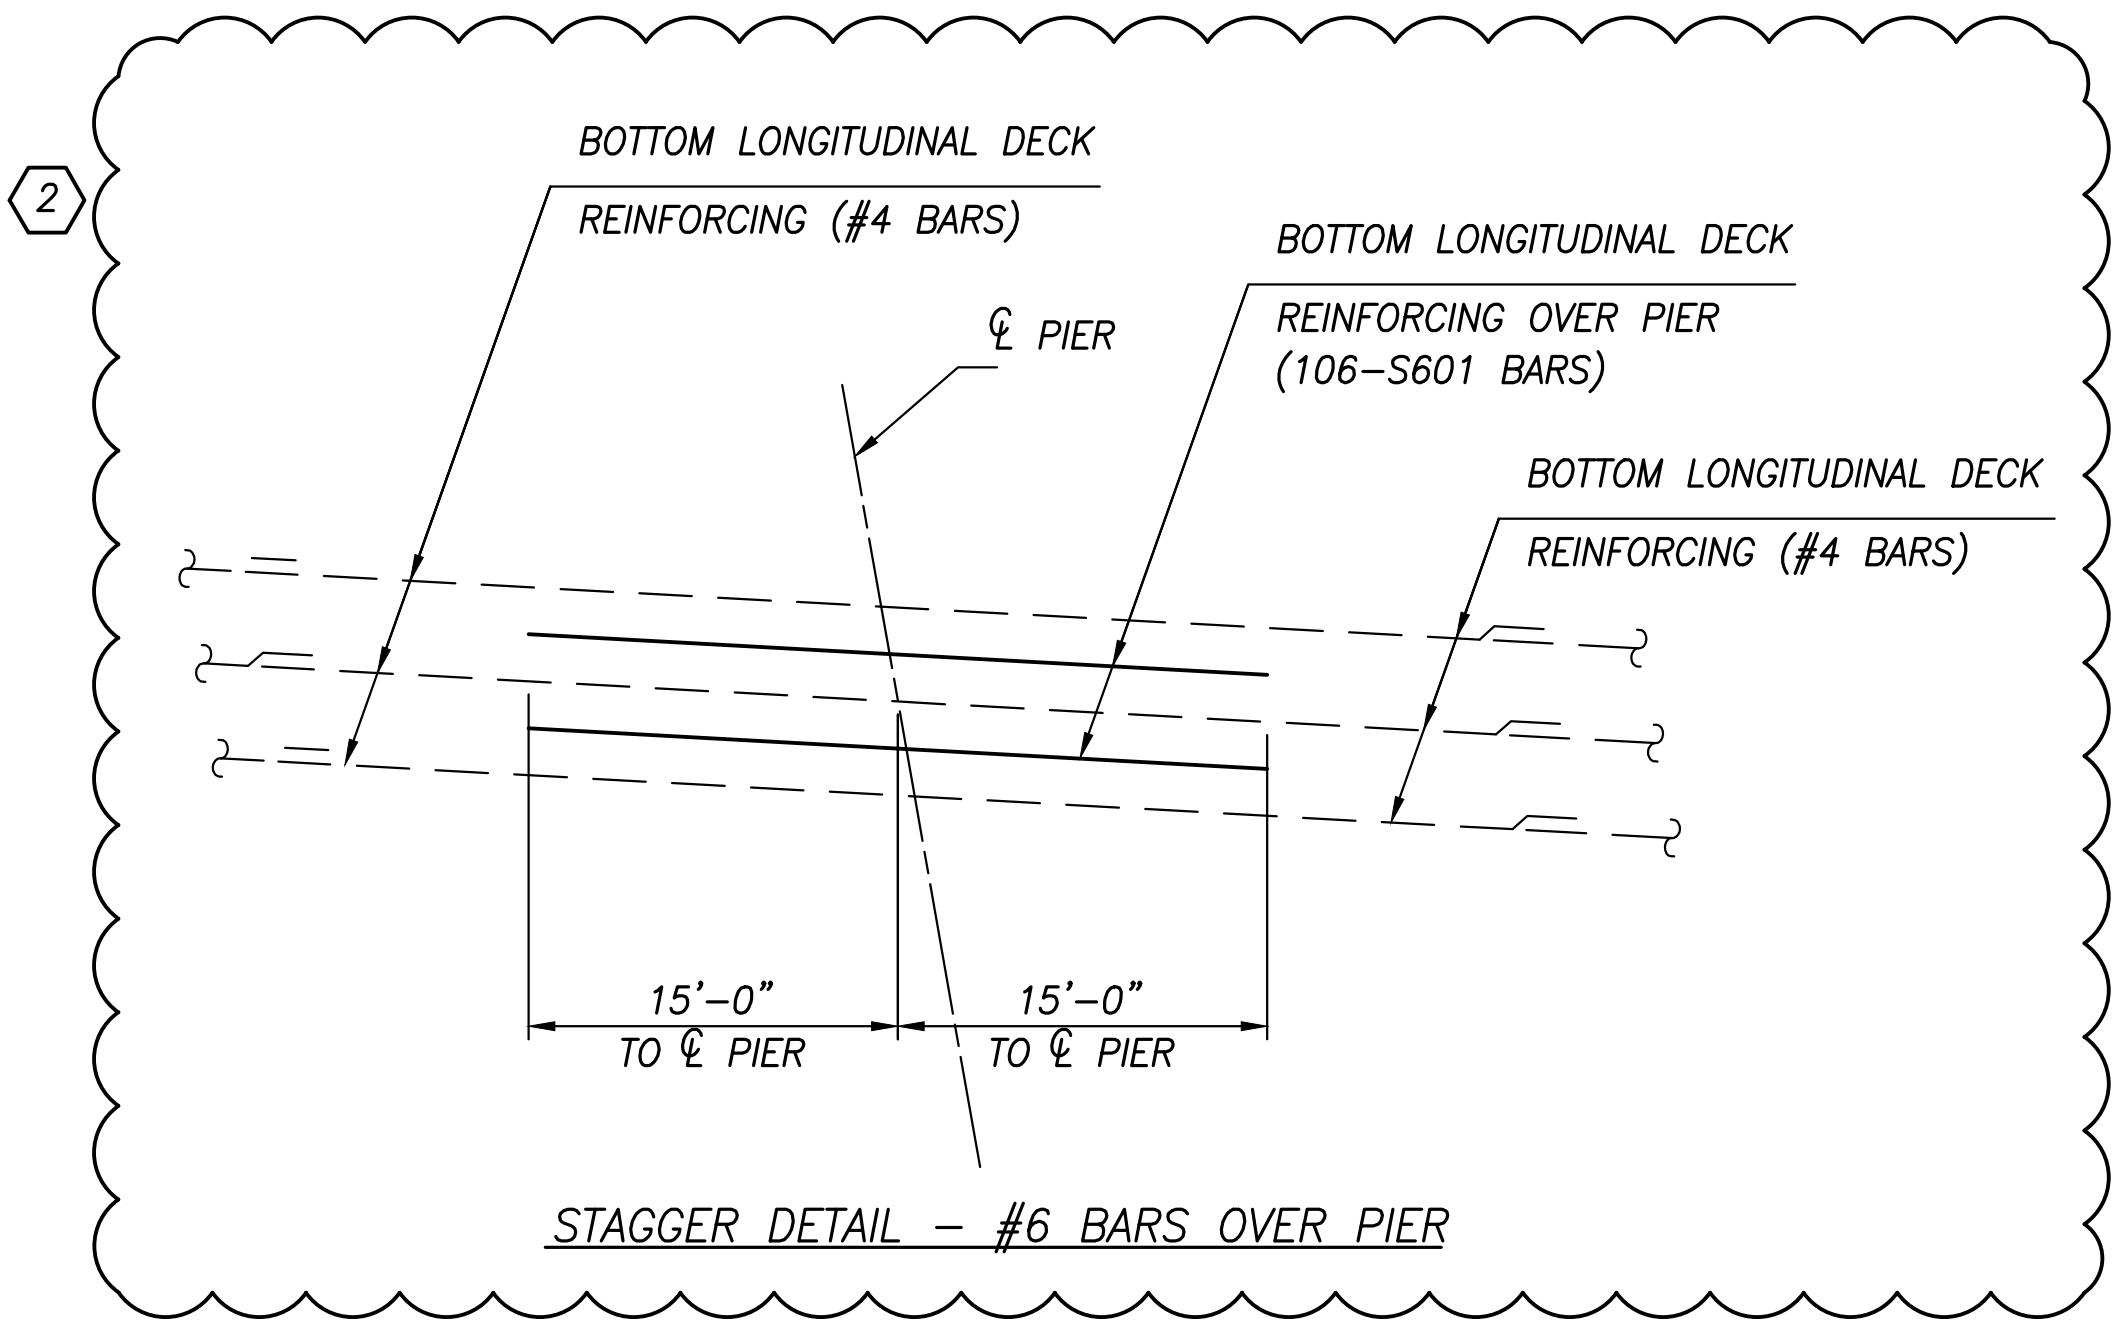


NOTES:

1. FOR TRANSVERSE SECTION, SEE SHEET [140/216].
2. FOR PARAPET AND MEDIAN BARRIER DETAILS, SEE SHEETS [119/216] THRU [134/216].
3. FOR SCREED, TOP OF HAUNCH, AND FINAL DECK ELEVATIONS, SEE SHEETS [143/216] THRU [192/216].
4. FOR REINFORCING STEEL LIST, SEE SHEETS [210/216] AND [211/216].
5. FOR EXPANSION JOINT DETAILS, SEE SHEET [118/216].
6. BARS CALLED OUT  $\phi$  BEAM-TO- $\phi$  BEAM AND TYP. BETWEEN BEAMS TO SIMPLY CALLOUTS. HOWEVER, THERE IS ONLY ONE REBAR LINE ON BEAM  $\phi$ .
7. FOR TOP REINFORCING, SEE SHEETS [109/216] THRU [111/216].
8. FOR HAUNCH REINFORCING, SEE SHEET [114/216].
9. MINIMUM REBAR LAP LENGTHS ARE AS FOLLOWS:  
 NO. 4 (HOR.) 3'-3"

LEGEND:

- (1-1A) - GIRDER IDENTIFICATION
- \* - MEASURED ALONG  $\phi$  PROP. R/W & CONSTR. I.R. 75
- \*\* - MEASURED PERPENDICULAR TO  $\phi$  PROP. R/W & CONSTR. I.R. 75

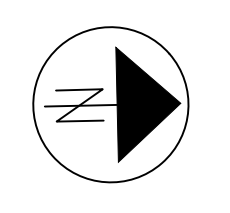

11/23/2020 JANSSEN & SPAANS ENGINEERING INC. - ADDED REBAR OVER PIERS.  
 5/1/2020 JANSSEN & SPAANS ENGINEERING INC. - RECONFIGURED NORTHBOUND ON RAMP SHEET REPLACED

DESIGN AGENCY  
**JANSSEN & SPAANS ENGINEERING, INC.**  
 9120 HARRISON PARK COURT  
 INDIANAPOLIS, IN 46216

DESIGNED	DRAWN	REVIEWED	DATE
WOZ	JTH	JTH	8/18
CHECKED	REVISION	STRUCTURE FILE NUMBER	
CRG		4802765/4802767	

SLAB PLAN - 24 OF 27  
 BRIDGE NO. LUC-75-0029 L/R  
 I.R. 75 OVER MAUMEE RIVER

W00/LUC-75-30.70/0.00  
 PID No. 93592

108/216

1401  
 1792



5/1/2020 JANSSEN & SPAANS ENGINEERING INC. - RECONFIGURED NORTHBOUND ON RAMP SHEET REPLACED

DESIGN AGENCY  
**JANSSEN & SPAANS ENGINEERING, INC.**  
 9120 HARRISON PARK COURT  
 INDIANAPOLIS, IN 46216


DATE	5/2020
REVIEWED	WJZ
DRAWN	REM
DESIGNED	CBS
STRUCTURE FILE NUMBER	4802765/4802767

SLAB PLAN - 25 OF 27  
 BRIDGE NO. LUC-75-0029 L/R  
 I.R. 75 OVER MAUMEE RIVER


W00/LUC-75-30.70/0.00  
 PID No. 93592

109/216

1492  
 1792

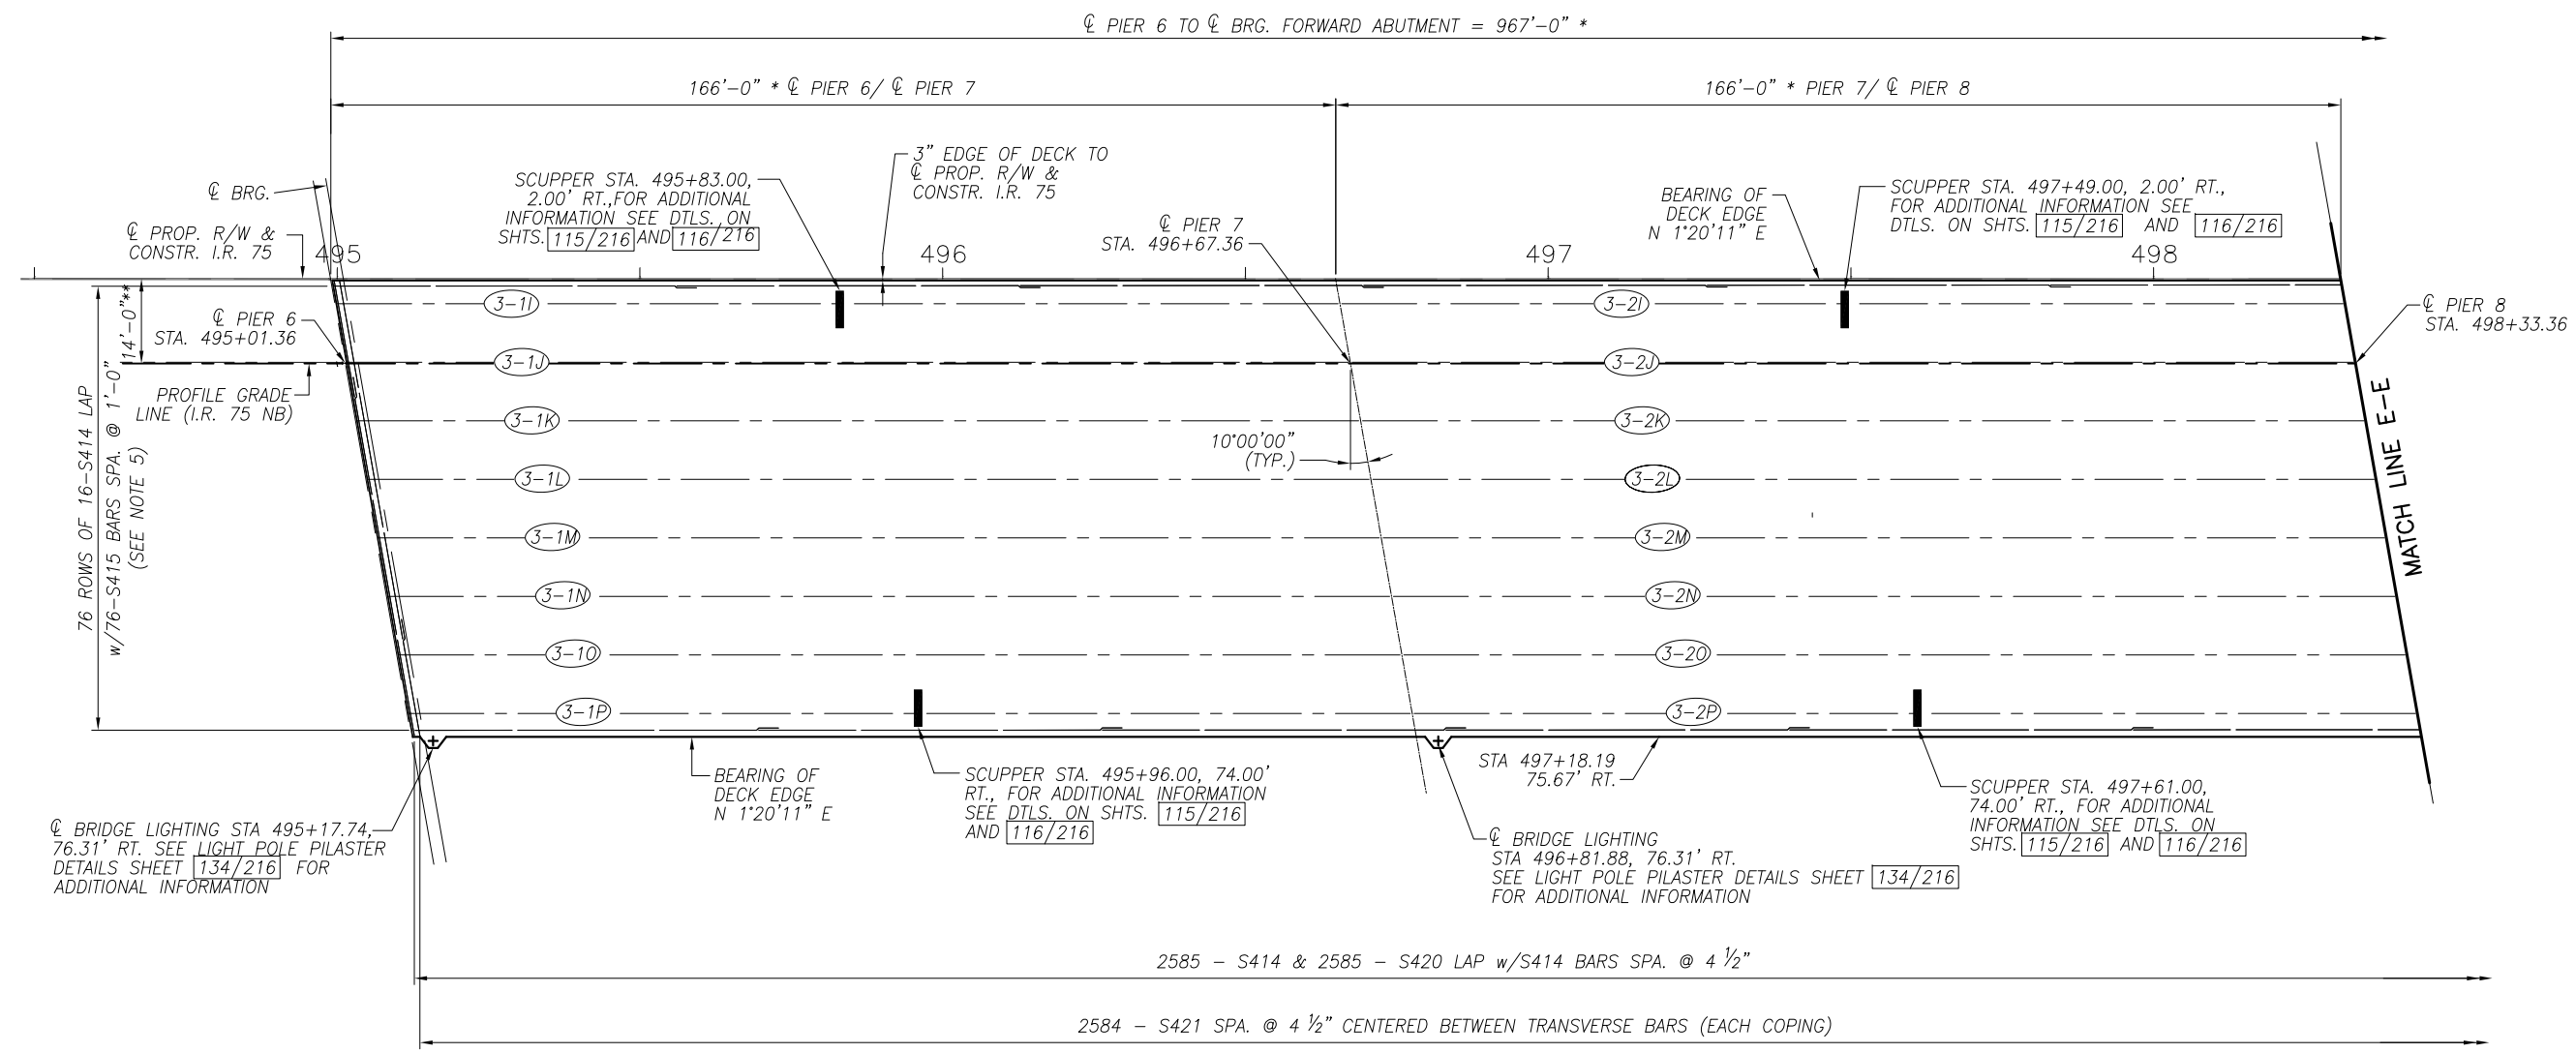

**SLAB PLAN - TOP REINFORCING**  
 UNIT 3 NORTHBOUND BRIDGE

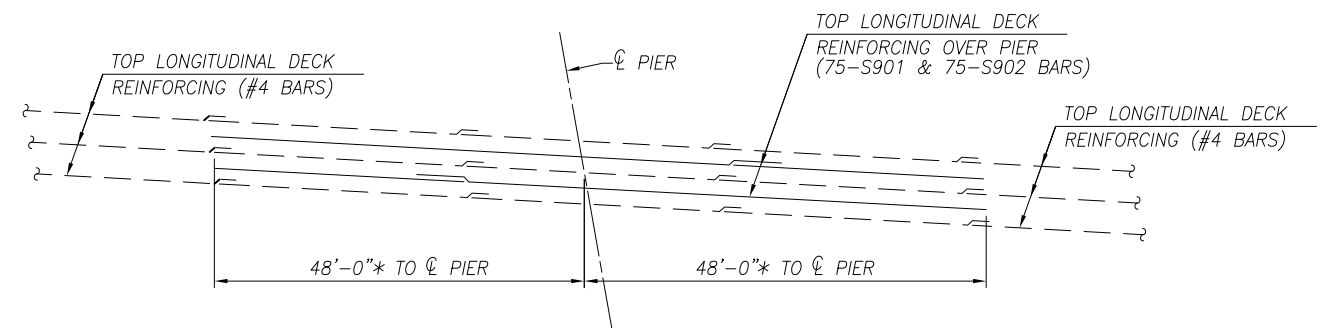

**STAGGER DETAIL - #9 BARS OVER PIER**

**NOTES:**


- FOR TRANSVERSE SECTION, SEE SHEET [140/216].
- FOR PARAPET AND MEDIAN BARRIER DETAILS, SEE SHEETS [119/216] THRU [134/216].
- FOR SCREED, TOP OF HAUNCH, AND FINAL DECK ELEVATIONS, SEE SHEETS [143/216] THRU [192/216].
- FOR REINFORCING STEEL LIST, SEE SHEETS [210/216] AND [211/216].
- FOR EXPANSION JOINT DETAILS, SEE SHEET [118/216].
- FOR BOTTOM REINFORCING, SEE SHEETS [106/216] THRU [108/216].
- MINIMUM REBAR LAP LENGTHS ARE AS FOLLOWS:

**LEGEND:**

- (1-1A) - GIRDER IDENTIFICATION
- \* - MEASURED ALONG  $\phi$  PROP. R/W & CONSTR. I.R. 75
- \*\* - MEASURED PERPENDICULAR TO  $\phi$  PROP. R/W & CONSTR. I.R. 75


NO. 4 (HOR.) 3'-3"  
 NO. 9 (HOR.) 10'-2"

Date: Oct 07, 2020, 5:01pm User Name: mlongtin  
 File: P:\11321 - Toledo E Value Engineering\DWG\SRIDGE\LUC-75-0027 over Maumee River\Sheets\075\_0027C\_DP012.dwg

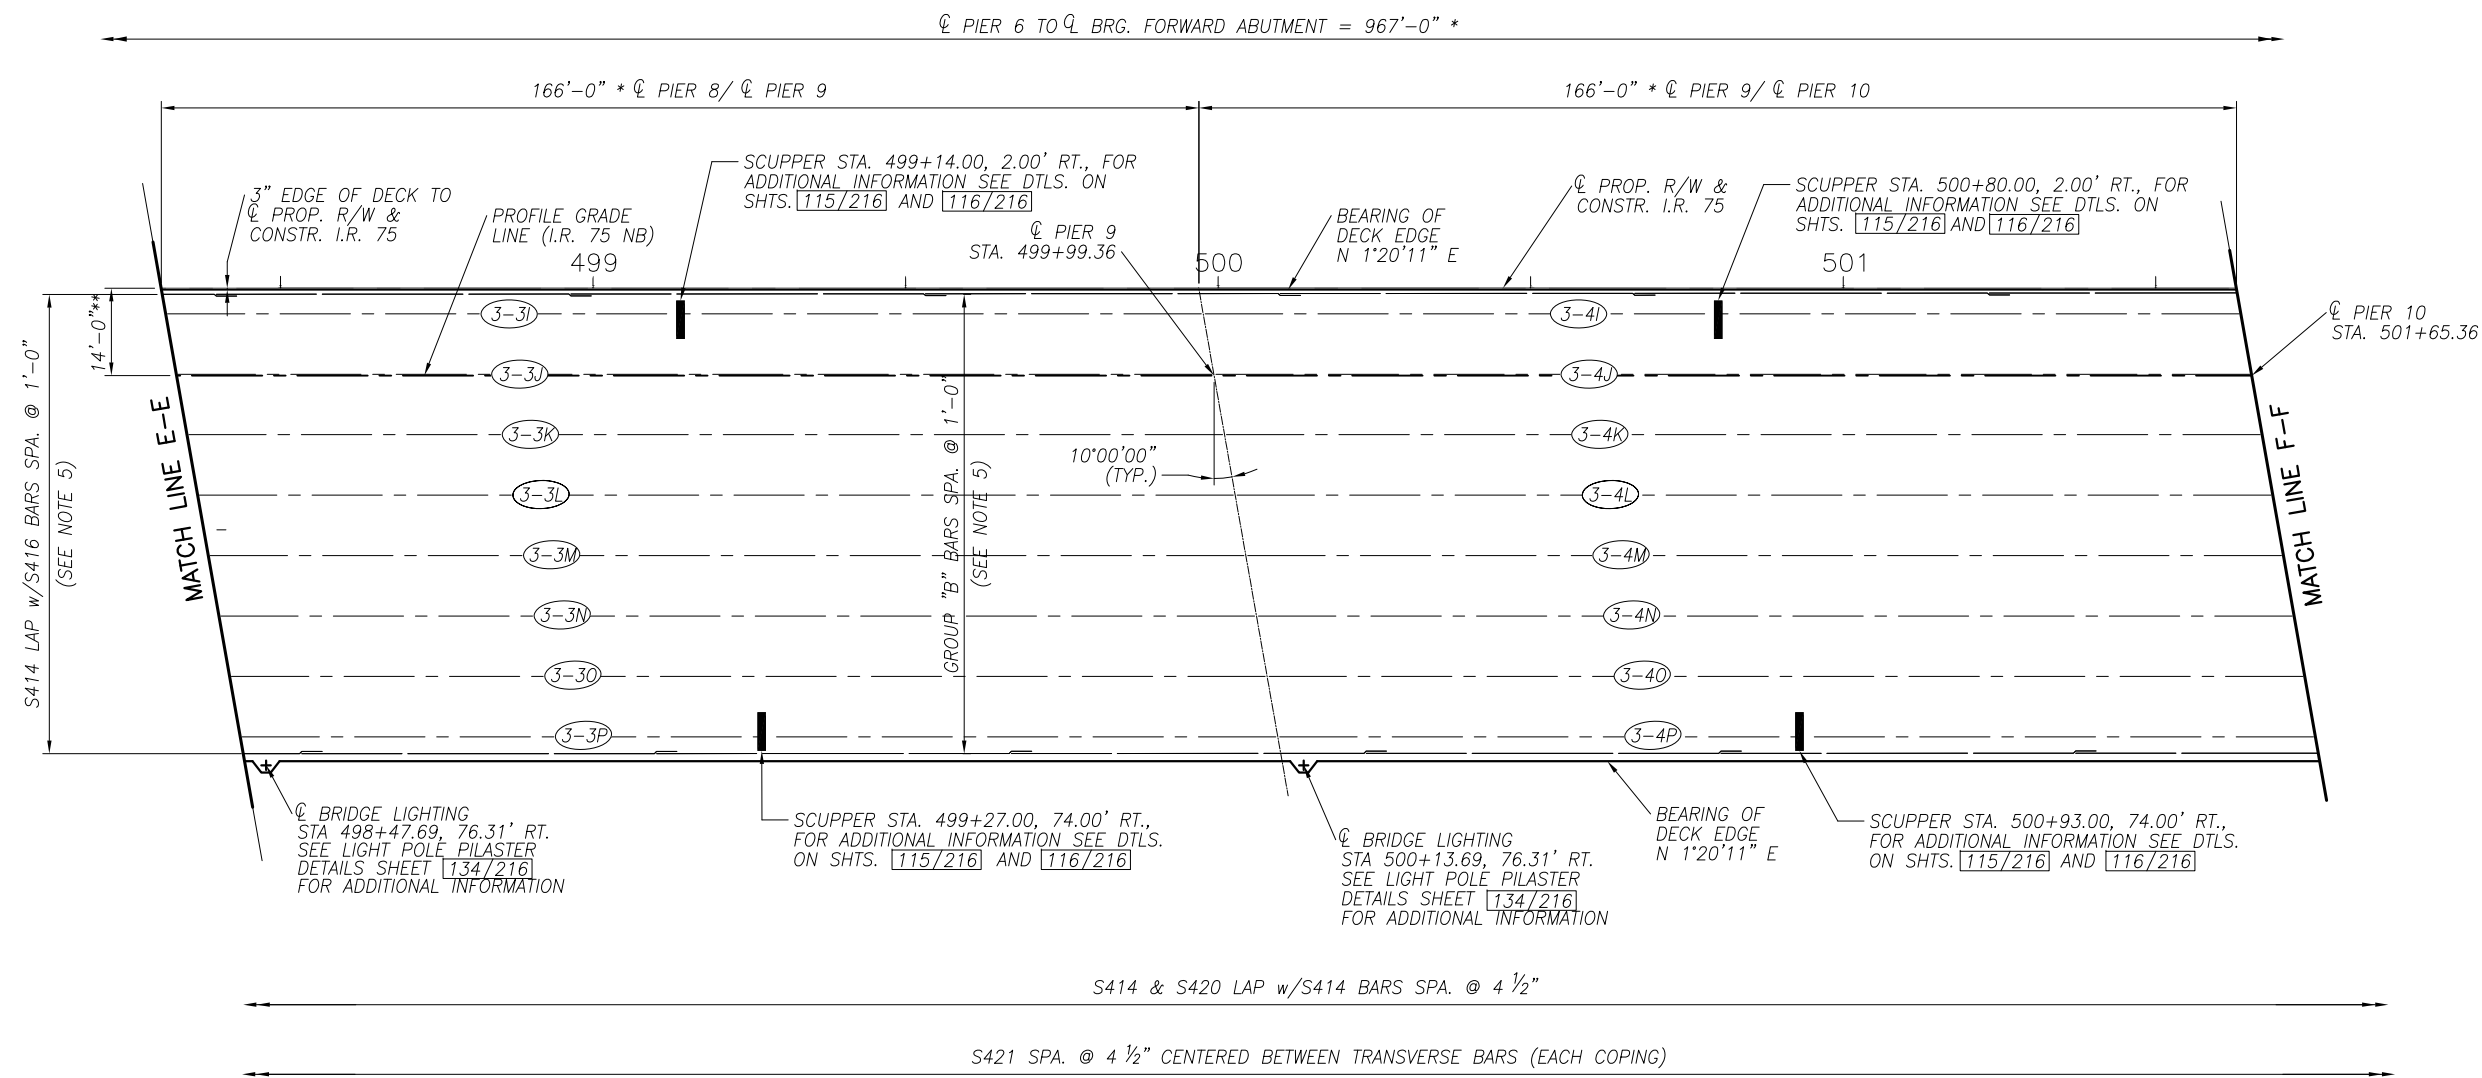

**SLAB PLAN - TOP REINFORCING**

UNIT 3 NORTHBOUND BRIDGE

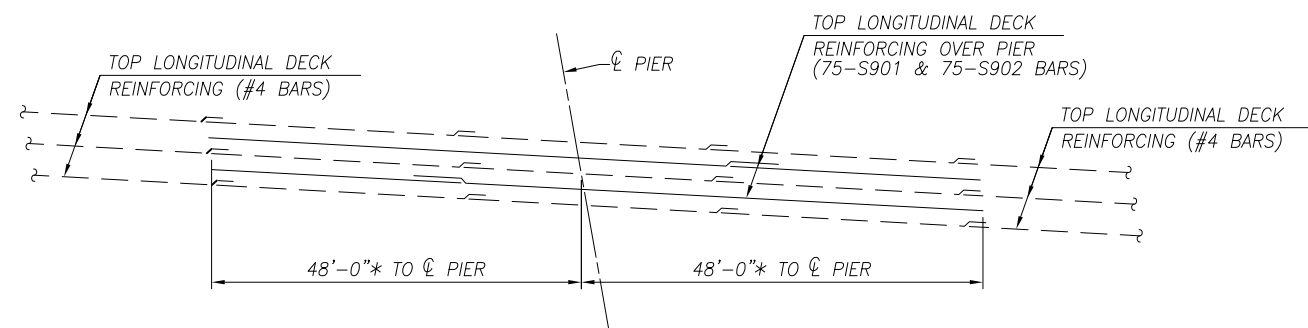

**STAGGER DETAIL - #9 BARS OVER PIER**

**NOTES:**

1. FOR TRANSVERSE SECTION, SEE SHEET [140/216].
2. FOR PARAPET AND MEDIAN BARRIER DETAILS, SEE SHEETS [119/216] THRU [134/216].
3. FOR SCREED, TOP OF HAUNCH, AND FINAL DECK ELEVATIONS, SEE SHEETS [143/216] THRU [192/216].
4. FOR REINFORCING STEEL LIST, SEE SHEETS [210/216] AND [211/216].
5. FOR EXPANSION JOINT DETAILS, SEE SHEET [118/216].
6. FOR BOTTOM REINFORCING, SEE SHEETS [106/216] THRU [108/216].
7. MINIMUM REBAR LAP LENGTHS ARE AS FOLLOWS:

**LEGEND:**

- (1-1A) - GIRDER IDENTIFICATION
- \* - MEASURED ALONG CL PROP. R/W & CONSTR. I.R. 75
- \*\* - MEASURED PERPENDICULAR TO CL PROP. R/W & CONSTR. I.R. 75

NO. 4 (HOR.)	3'-3"
NO. 9 (HOR.)	10'-2"

Date: Oct 07, 2020, 5:04pm User Name: mlongtin File: P:\1321 - Toledo E Value Engineering\DWGS\BRIDGE\LUC-75-0027 over Maumee River\Sheets\075\_0027C\_DP012.dwg

3	DESIGNED	WOZ	CBS
	CHECKED		
3	DRAWN	REM	REVIS
	REVISED		
5/1/2020	DATE	5/2020	DATE
JANSEN & SPAANS ENGINEERING, INC.	DESIGN AGENCY	JANSEN & SPAANS ENGINEERING, INC.	DESIGN AGENCY
9120 HARRISON PARK COURT	INDIANAPOLIS, IN 46216	9120 HARRISON PARK COURT	INDIANAPOLIS, IN 46216
4802765/4802767	STRUCTURE FILE NUMBER	4802765/4802767	STRUCTURE FILE NUMBER


SLAB PLAN - 26 OF 27  
BRIDGE NO. LUC-75-0029 L/R  
I.R. 75 OVER MAUMEE RIVER

W00/LUC-75-30.70/0.00  
PID No. 93592


110/216

1403  
1792

Date: Oct 07, 2020, 5:02pm User Name: mlongtin  
 File: P:\11321 - Toledo E Value Engineering\DWG\BRIDGE\LUC-75-0027 over Maumee River\Sheets\027C\_0027C\_DP012.dwg

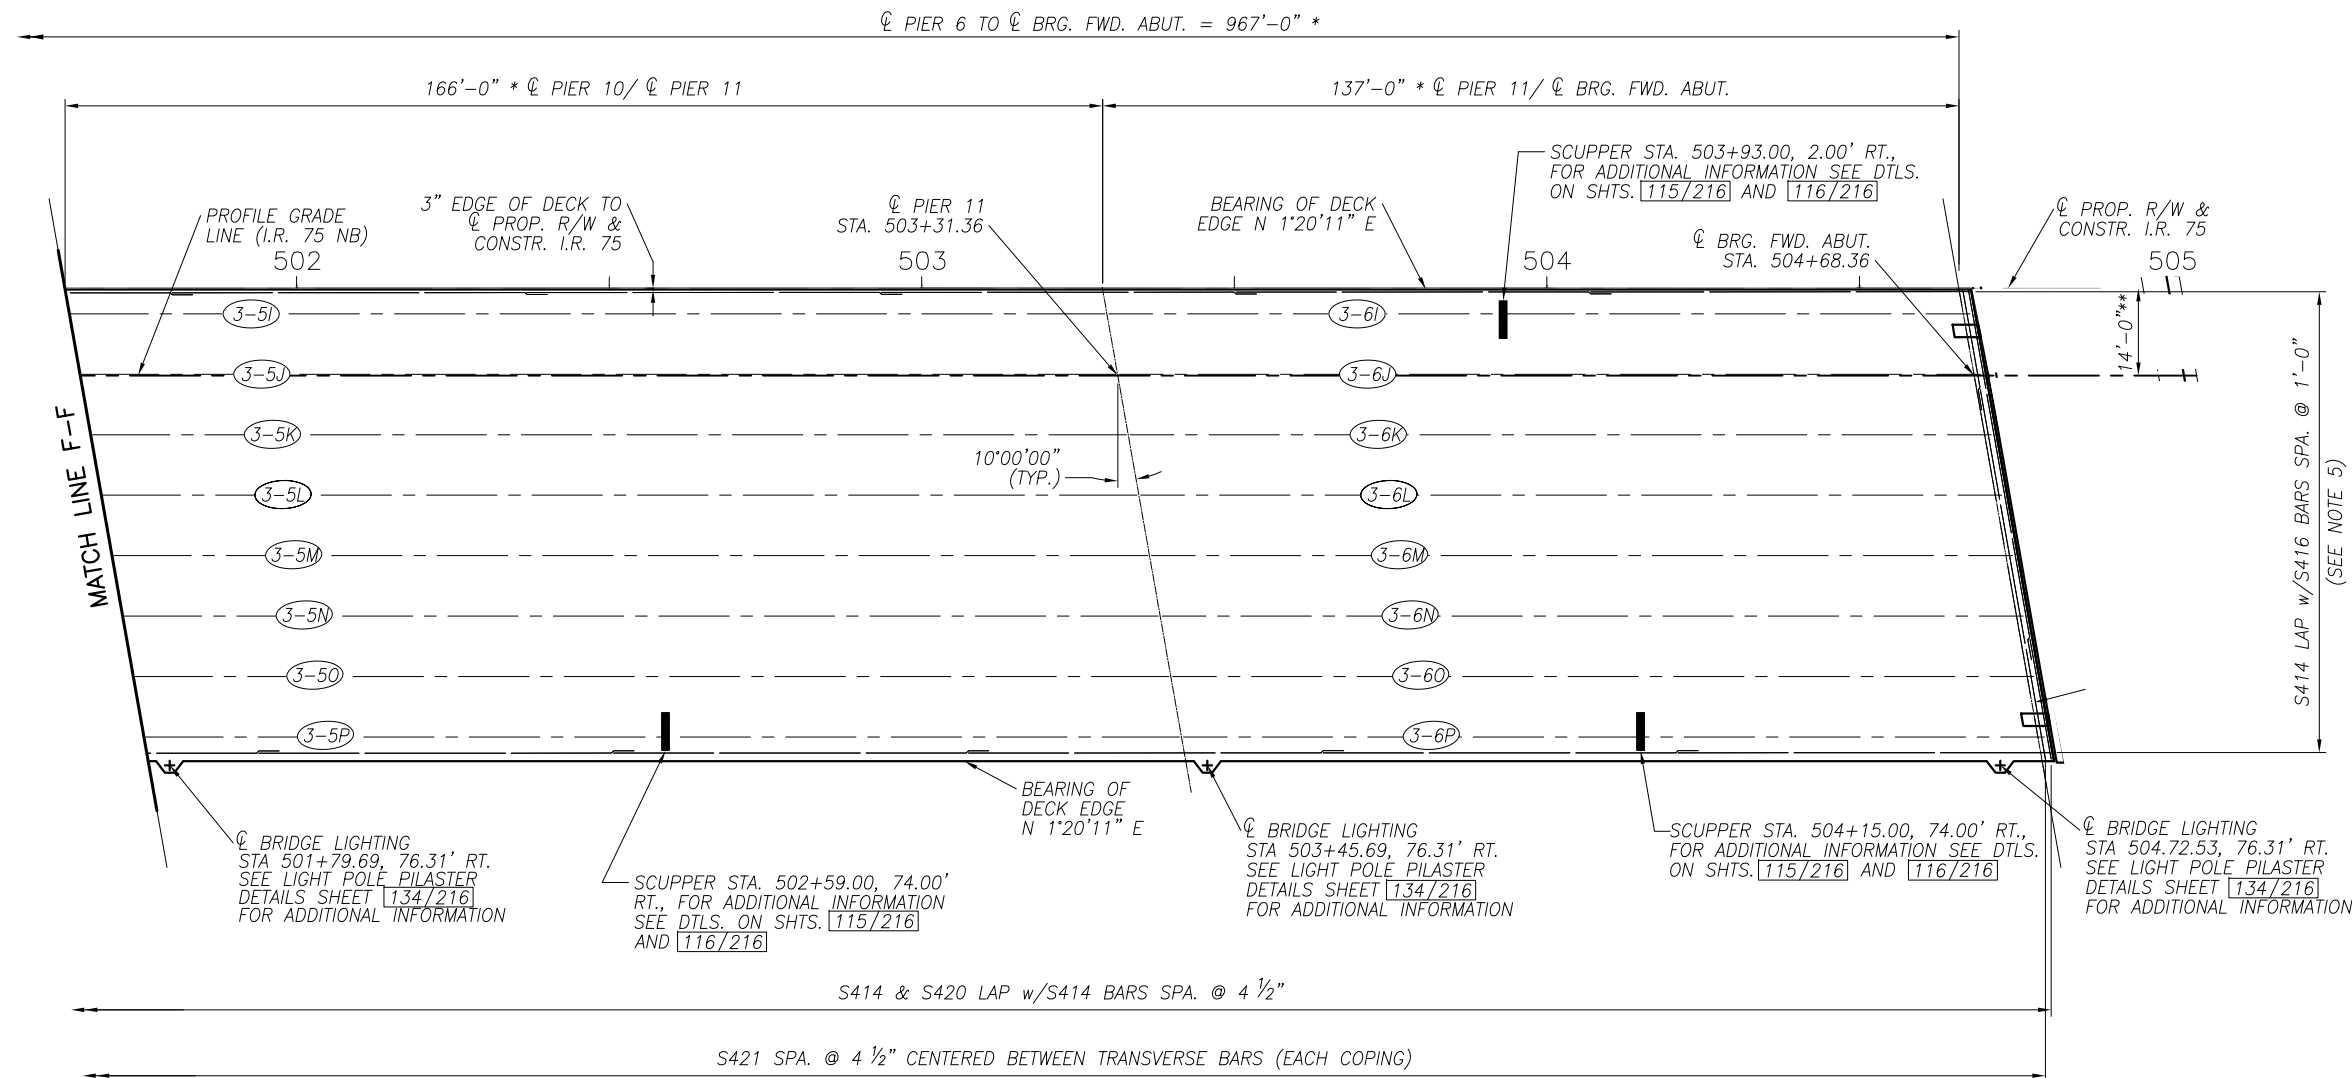

**SLAB PLAN - TOP REINFORCING**  
 UNIT 3 NORTHBOUND BRIDGE

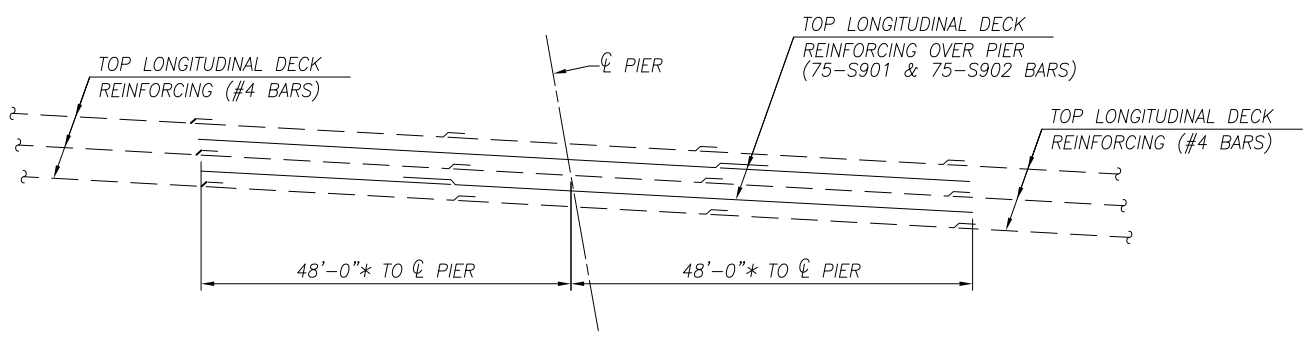

**STAGGER DETAIL - #9 BARS OVER PIER**

**LEGEND:**

- (1-1A) - GIRDER IDENTIFICATION
- \* - MEASURED ALONG CL PROP. R/W & CONSTR. I.R. 75
- \*\* - MEASURED PERPENDICULAR TO CL PROP. R/W & CONSTR. I.R. 75

**NOTES:**

1. FOR TRANSVERSE SECTION, SEE SHEET [140/216].
2. FOR PARAPET AND MEDIAN BARRIER DETAILS, SEE SHEETS [119/216] THRU [134/216].
3. FOR SCREED, TOP OF HAUNCH, AND FINAL DECK ELEVATIONS, SEE SHEETS [143/216] THRU [192/216].
4. FOR REINFORCING STEEL LIST, SEE SHEETS [210/216] AND [211/216].
5. FOR EXPANSION JOINT DETAILS, SEE SHEET [118/216].
6. FOR BOTTOM REINFORCING, SEE SHEETS [106/216] THRU [108/216].
7. MINIMUM REBAR LAP LENGTHS ARE AS FOLLOWS:  
 NO. 4 (HOR.) 3'-3"  
 NO. 9 (HOR.) 10'-2"



3 5/1/2020 JANSEN & SPAANS ENGINEERING INC. - RECONFIGURED NORTHBOUND ON RAMP SHEET REPLACED

DESIGNED	WOZ	CBS
DRAWN	REM	REVIS
REVIEWED	WOZ	STRUCTURE FILE NUMBER
DATE	5/2020	4802765/4802767

DESIGN AGENCY  
**JANSEN & SPAANS ENGINEERING, INC.**  
 9120 HARRISON PARK COURT  
 INDIANAPOLIS, IN 46216

SLAB PLAN - 27 OF 27  
 BRIDGE NO. LUC-75-0029 L/R  
 I.R. 75 OVER MAUMEE RIVER

W00/LUC-75-30.70/0.00  
 PID No. 93592

111/216

1404  
 1792

ADDITIONAL HAUNCH REINFORCEMENT (NORTHBOUND BRIDGE - UNIT 1)									
BEAM	LOCATION	SOUTH END *	BAR MARK	NO. OF S412	NO. OF SETS OF 3-S5010 **	NORTH END *	BAR MARK	NO. OF S412	NO. OF SETS OF 3-S5010 **
M	SPAN 1	36'	S412	74	2	36'	S412	74	2
	SPAN 2	24'	S412	50	1	24'	S412	50	1
N	SPAN 1	36'	S412	74	2	36'	S412	74	2
	SPAN 2	24'	S412	50	1	24'	S412	50	1
O	SPAN 1	36'	S412	74	2	36'	S412	74	2
	SPAN 2	24'	S412	50	1	24'	S412	50	1
P	SPAN 1	36'	S412	74	2	36'	S412	74	2
	SPAN 2	24'	S412	50	1	24'	S412	50	1
R	SPAN 1	36'	S412	74	2	36'	S412	74	2
	SPAN 2	24'	S412	50	1	24'	S412	50	1
S	SPAN 1	36'	S412	74	2	36'	S412	74	2
	SPAN 2	24'	S412	50	1	24'	S412	50	1
T	SPAN 1	36'	S412	74	2	36'	S412	74	2
	SPAN 2	24'	S412	50	1	24'	S412	50	1
U	SPAN 1	36'	S412	74	2	36'	S412	74	2
	SPAN 2	24'	S412	50	1	24'	S412	50	1

ADDITIONAL HAUNCH REINFORCEMENT (NORTHBOUND BRIDGE - UNIT 1)									
BEAM	LOCATION	SOUTH END *	BAR MARK	NO. OF S412	NO. OF SETS OF 3-S5010 **	NORTH END *	BAR MARK	NO. OF S412	NO. OF SETS OF 3-S5010 **
K	SPAN 1	24'	S412	50	1	24'	S412	50	1
	SPAN 2	24'	S412	50	1	24'	S412	50	1
	SPAN 3	24'	S412	50	1	24'	S412	50	1
	SPAN 4	24'	S412	50	1	24'	S412	50	1
L	SPAN 1	24'	S412	50	1	24'	S412	50	1
	SPAN 2	24'	S412	50	1	24'	S412	50	1
	SPAN 3	24'	S412	50	1	24'	S412	50	1
M	SPAN 1	24'	S412	50	1	24'	S412	50	1
	SPAN 2	24'	S412	50	1	24'	S412	50	1
	SPAN 3	24'	S412	50	1	24'	S412	50	1
	SPAN 4	24'	S412	50	1	24'	S412	50	1
N	SPAN 1	24'	S412	50	1	24'	S412	50	1
	SPAN 2	24'	S412	50	1	24'	S412	50	1
	SPAN 3	24'	S412	50	1	24'	S412	50	1
	SPAN 4	24'	S412	50	1	24'	S412	50	1
O	SPAN 1	24'	S412	50	1	24'	S412	50	1
	SPAN 2	24'	S412	50	1	24'	S412	50	1
	SPAN 3	24'	S412	50	1	24'	S412	50	1
	SPAN 4	24'	S412	50	1	24'	S412	50	1
P	SPAN 1	24'	S412	50	1	24'	S412	50	1
	SPAN 2	24'	S412	50	1	24'	S412	50	1
	SPAN 3	24'	S412	50	1	24'	S412	50	1
	SPAN 4	24'	S412	50	1	24'	S412	50	1
R	SPAN 1	24'	S412	50	1	24'	S412	50	1
	SPAN 2	24'	S412	50	1	24'	S412	50	1
	SPAN 3	24'	S412	50	1	24'	S412	50	1
	SPAN 4	24'	S412	50	1	24'	S412	50	1
S	SPAN 1	24'	S412	50	1	24'	S412	50	1
	SPAN 2	24'	S412	50	1	24'	S412	50	1
	SPAN 3	24'	S412	50	1	24'	S412	50	1
	SPAN 4	24'	S412	50	1	24'	S412	50	1

3

ADDITIONAL HAUNCH REINFORCEMENT (NORTHBOUND BRIDGE - UNIT 3)									
BEAM	LOCATION	SOUTH END *	BAR MARK	NO. OF S412	NO. OF SETS OF 3-S5010**	NORTH END *	BAR MARK	NO. OF S412	NO. OF SETS OF 3-S5010**
I	SPAN 1	28'	S412	57	1	27'	S412	56	1
	SPAN 2	27'	S412	56	1	27'	S412	56	1
	SPAN 3	27'	S412	56	1	27'	S412	56	1
	SPAN 4	27'	S412	56	1	27'	S412	56	1
	SPAN 5	27'	S412	56	1	27'	S412	56	1
	SPAN 6	8'	S412	18	1	8'	S412	18	1
J	SPAN 1	23'	S412	48	1	22'	S412	46	1
	SPAN 2	22'	S412	46	1	22'	S412	46	1
	SPAN 3	22'	S412	46	1	22'	S412	46	1
	SPAN 4	22'	S412	46	1	22'	S412	46	1
	SPAN 5	22'	S412	46	1	22'	S412	46	1
	SPAN 6	5'	S412	12	1	5'	S412	12	1
K	SPAN 1	23'	S412	48	1	22'	S412	46	1
	SPAN 2	22'	S412	46	1	22'	S412	46	1
	SPAN 3	22'	S412	46	1	22'	S412	46	1
	SPAN 4	22'	S412	46	1	22'	S412	46	1
	SPAN 5	22'	S412	46	1	22'	S412	46	1
	SPAN 6	5'	S412	12	1	5'	S412	12	1
L	SPAN 1	23'	S412	48	1	22'	S412	46	1
	SPAN 2	22'	S412	46	1	22'	S412	46	1
	SPAN 3	22'	S412	46	1	22'	S412	46	1
	SPAN 4	22'	S412	46	1	22'	S412	46	1
	SPAN 5	22'	S412	46	1	22'	S412	46	1
	SPAN 6	5'	S412	12	1	5'	S412	12	1
M	SPAN 1	23'	S412	48	1	22'	S412	46	1
	SPAN 2	22'	S412	46	1	22'	S412	46	1
	SPAN 3	22'	S412	46	1	22'	S412	46	1
	SPAN 4	22'	S412	46	1	22'	S412	46	1
	SPAN 5	22'	S412	46	1	22'	S412	46	1
	SPAN 6	5'	S412	12	1	5'	S412	12	1
N	SPAN 1	23'	S412	48	1	22'	S412	46	1
	SPAN 2	22'	S412	46	1	22'	S412	46	1
	SPAN 3	22'	S412	46	1	22'	S412	46	1
	SPAN 4	22'	S412	46	1	22'	S412	46	1
	SPAN 5	22'	S412	46	1	22'	S412	46	1
	SPAN 6	5'	S412	12	1	5'	S412	12	1
O	SPAN 1	23'	S412	48	1	22'	S412	46	1
	SPAN 2	22'	S412	46	1	22'	S412	46	1
	SPAN 3	22'	S412	46	1	22'	S412	46	1
	SPAN 4	22'	S412	46	1	22'	S412	46	1
	SPAN 5	22'	S412	46	1	22'	S412	46	1
	SPAN 6	5'	S412	12	1	5'	S412	12	1
P	SPAN 1	28'	S412	57	1	28'	S412	57	1
	SPAN 2	27'	S412	56	1	27'	S412	56	1
	SPAN 3	27'	S412	56	1	27'	S412	56	1
	SPAN 4	27'	S412	56	1	27'	S412	56	1
	SPAN 5	27'	S412	56	1	27'	S412	56	1
	SPAN 6	8'	S412	18	1	8'	S412	18	1

LEGEND:

- \* DISTANCE AT END OF BEAM FOR WHICH HAUNCH EXCEEDS 4"
- \*\* NO. OF SETS OF 3-S5010 (30'-0" LONG) BARS NECESSARY TO REINFORCE REGION WHERE HAUNCH EXCEEDS 4"

NOTES:

1. FOR ADDITIONAL HAUNCH REINFORCEMENT TABLES, SEE SHEETS [112/216] AND [113/216].

5/1/2020 JANSSEN & SPAANS ENGINEERING INC. - RECONFIGURED NORTHBOUND ON RAMP

DESIGN AGENCY  
 DATE 8/18  
 REVIEWED JTH  
 DRAWN VFG/TMR  
 CHECKED MRW  
 STRUCTURE FILE NUMBER 4802765/4802767




ADDITIONAL HAUNCH REINFORCEMENT  
 BRIDGE NO. LUC-75-0029 L/R  
 I.R. 75 OVER MAUMEE RIVER


W00/LUC-75-0029/0.00  
 PID No. 93592

114/216

1407  
 1792

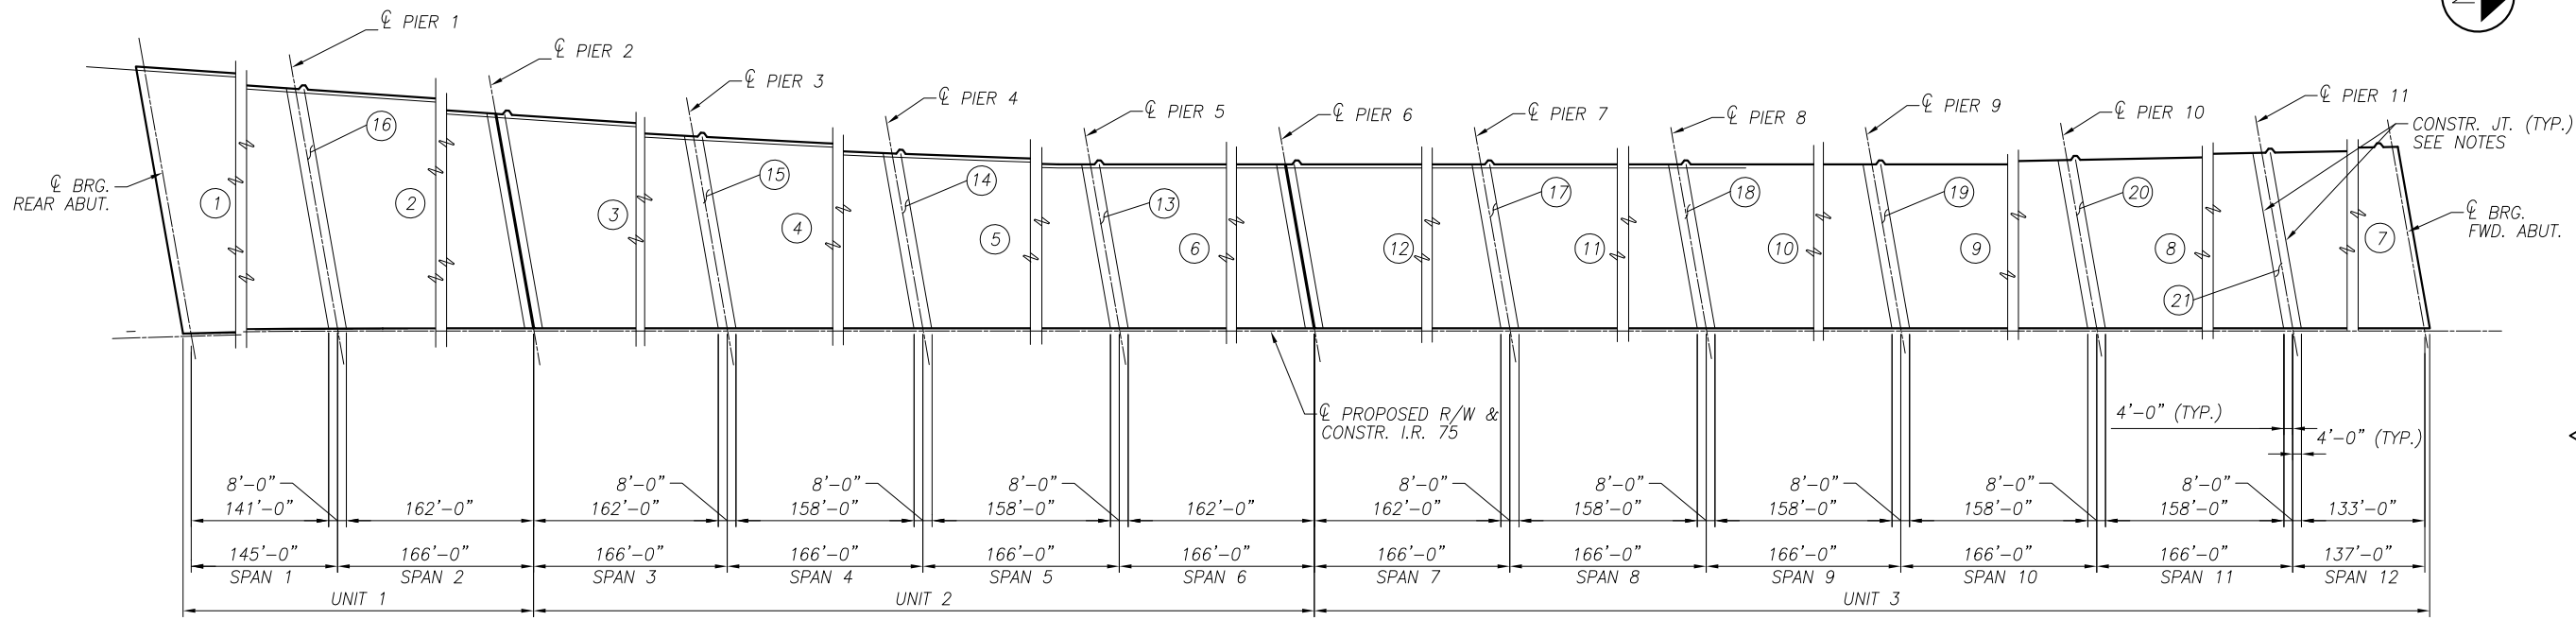

**SUGGESTED SLAB POUR SEQUENCE**  
BRIDGE NO. LUC-75-0029L

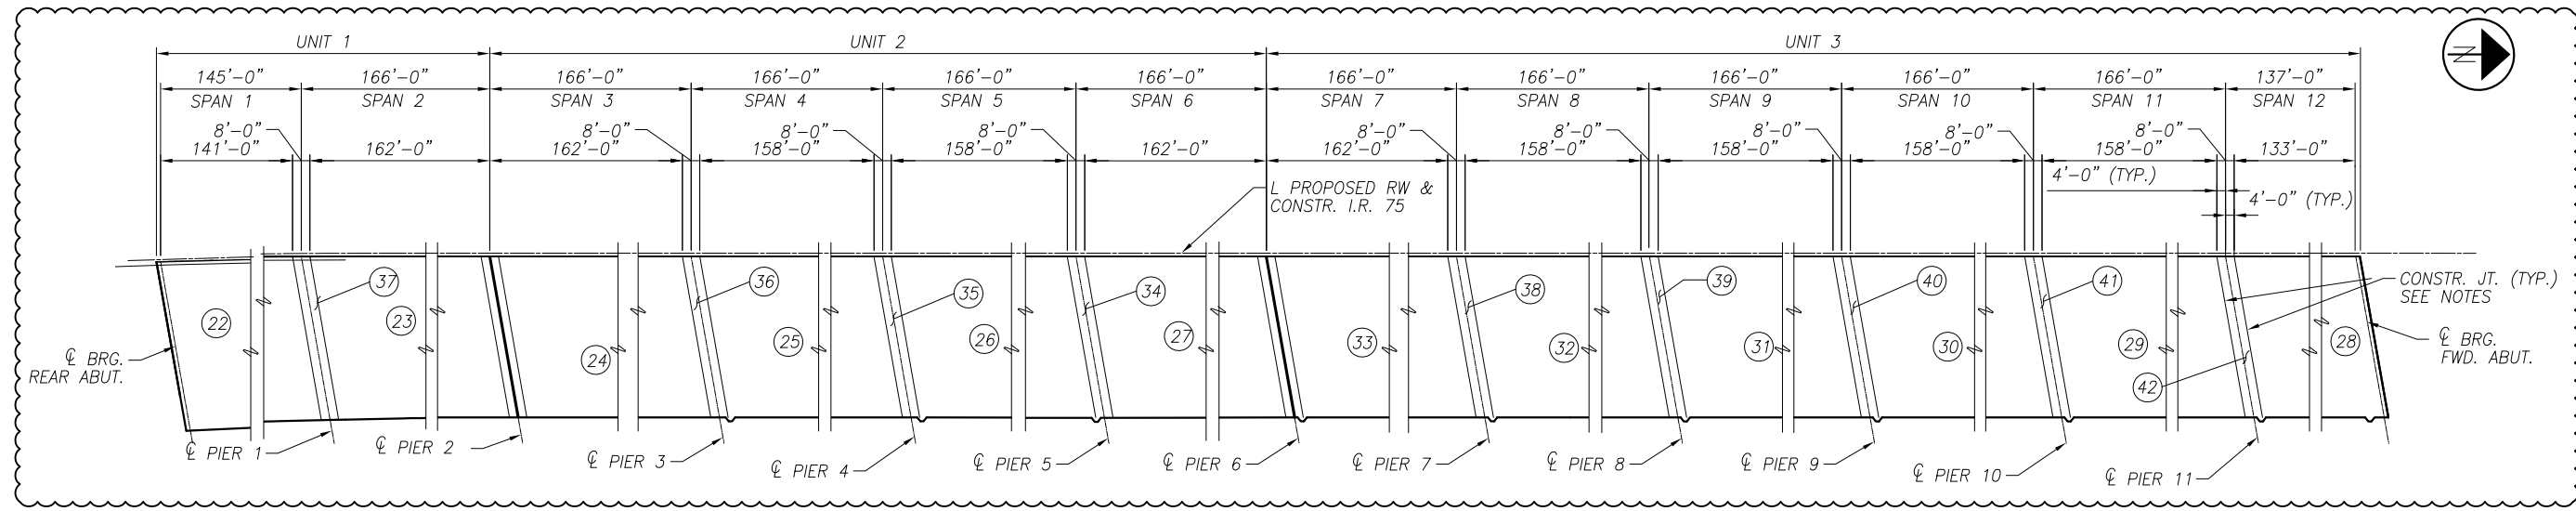

**SUGGESTED SLAB POUR SEQUENCE**  
BRIDGE NO. LUC-75-0029R

**LEGEND:**

Ⓝ DENOTES SUGGESTED SEQUENCE FOR POURING THE DECK, SEE NOTE 4.

**NOTES:**

- DIMENSIONS SHOWN ARE MEASURED ALONG  $\phi$  PROP. R/W & CONSTR. I.R. 75.
- SEAL ALL DECK CONSTRUCTION JOINTS WITH A 2'-0" WIDE STRIP OF HIGH MOLECULAR WEIGHT METHACRYLATE (H.M.W.M.) RESIN PER CMS 511.22.
- THE SUGGESTED SEQUENCE FOR POURING THE DECK CONCRETE IS BASED ON PSID-1-13. SHOULD THE CONTRACTOR PROPOSE TO USE A DIFFERENT SEQUENCE, THE SUBMITTAL SHALL BE MADE IN ACCORDANCE WITH CMS 501 AND 511.
- THE PLACEMENT OF DECK CONCRETE SHALL NOT PROCEED UNTIL ALL INTERMEDIATE DIAPHRAGMS HAVE BEEN PROPERLY INSTALLED.
- FOR ADDITIONAL INFORMATION, SEE STANDARD DRAWING PSID-1-13.
- EACH INDIVIDUAL POUR SHALL BE PLACED FROM SOUTH TO NORTH (IN THE DOWNHILL DIRECTION).

Date: Oct 07, 2020, 4:29pm User Name: mlongtin  
File: P:\1321 - Toledo E Value Engineering\DWG\SRIDGELUC-75-0027 over Maumee River\Sheets\075\_0027C\_S0072.dwg

5/1/2020 JANSSEN & SPANNS ENGINEERING INC. -  
RECONFIGURED NORTHBOUND ON RAMP

DESIGN AGENCY  
564 WHITE POND DRIVE  
AKRON, OHIO 44320-1100  
**AECOM**  
(330) 836-9111

DATE 8/18  
REVIEWED JTH  
DRAWN VFG  
DESIGNED DEB  
CHECKED MRW  
STRUCTURE FILE NUMBER 4802765/4802767

SUGGESTED SLAB POUR SEQUENCE  
BRIDGE NO. LUC-75-0029 L/R  
I.R. 75 OVER MAUMEE RIVER


W00/LUC-75-  
30.70/0.00  
PID No. 93592

117/216

1410  
1792



Date: Oct 07, 2020, 5:00pm User Name: mlongtin  
 File: P:\11321 - Toledo E Value Engineering\DWG\5\BRIDGE\LUC-75-0027 over Maumee River\Sheets\075\_0027C\_DP016.dwg

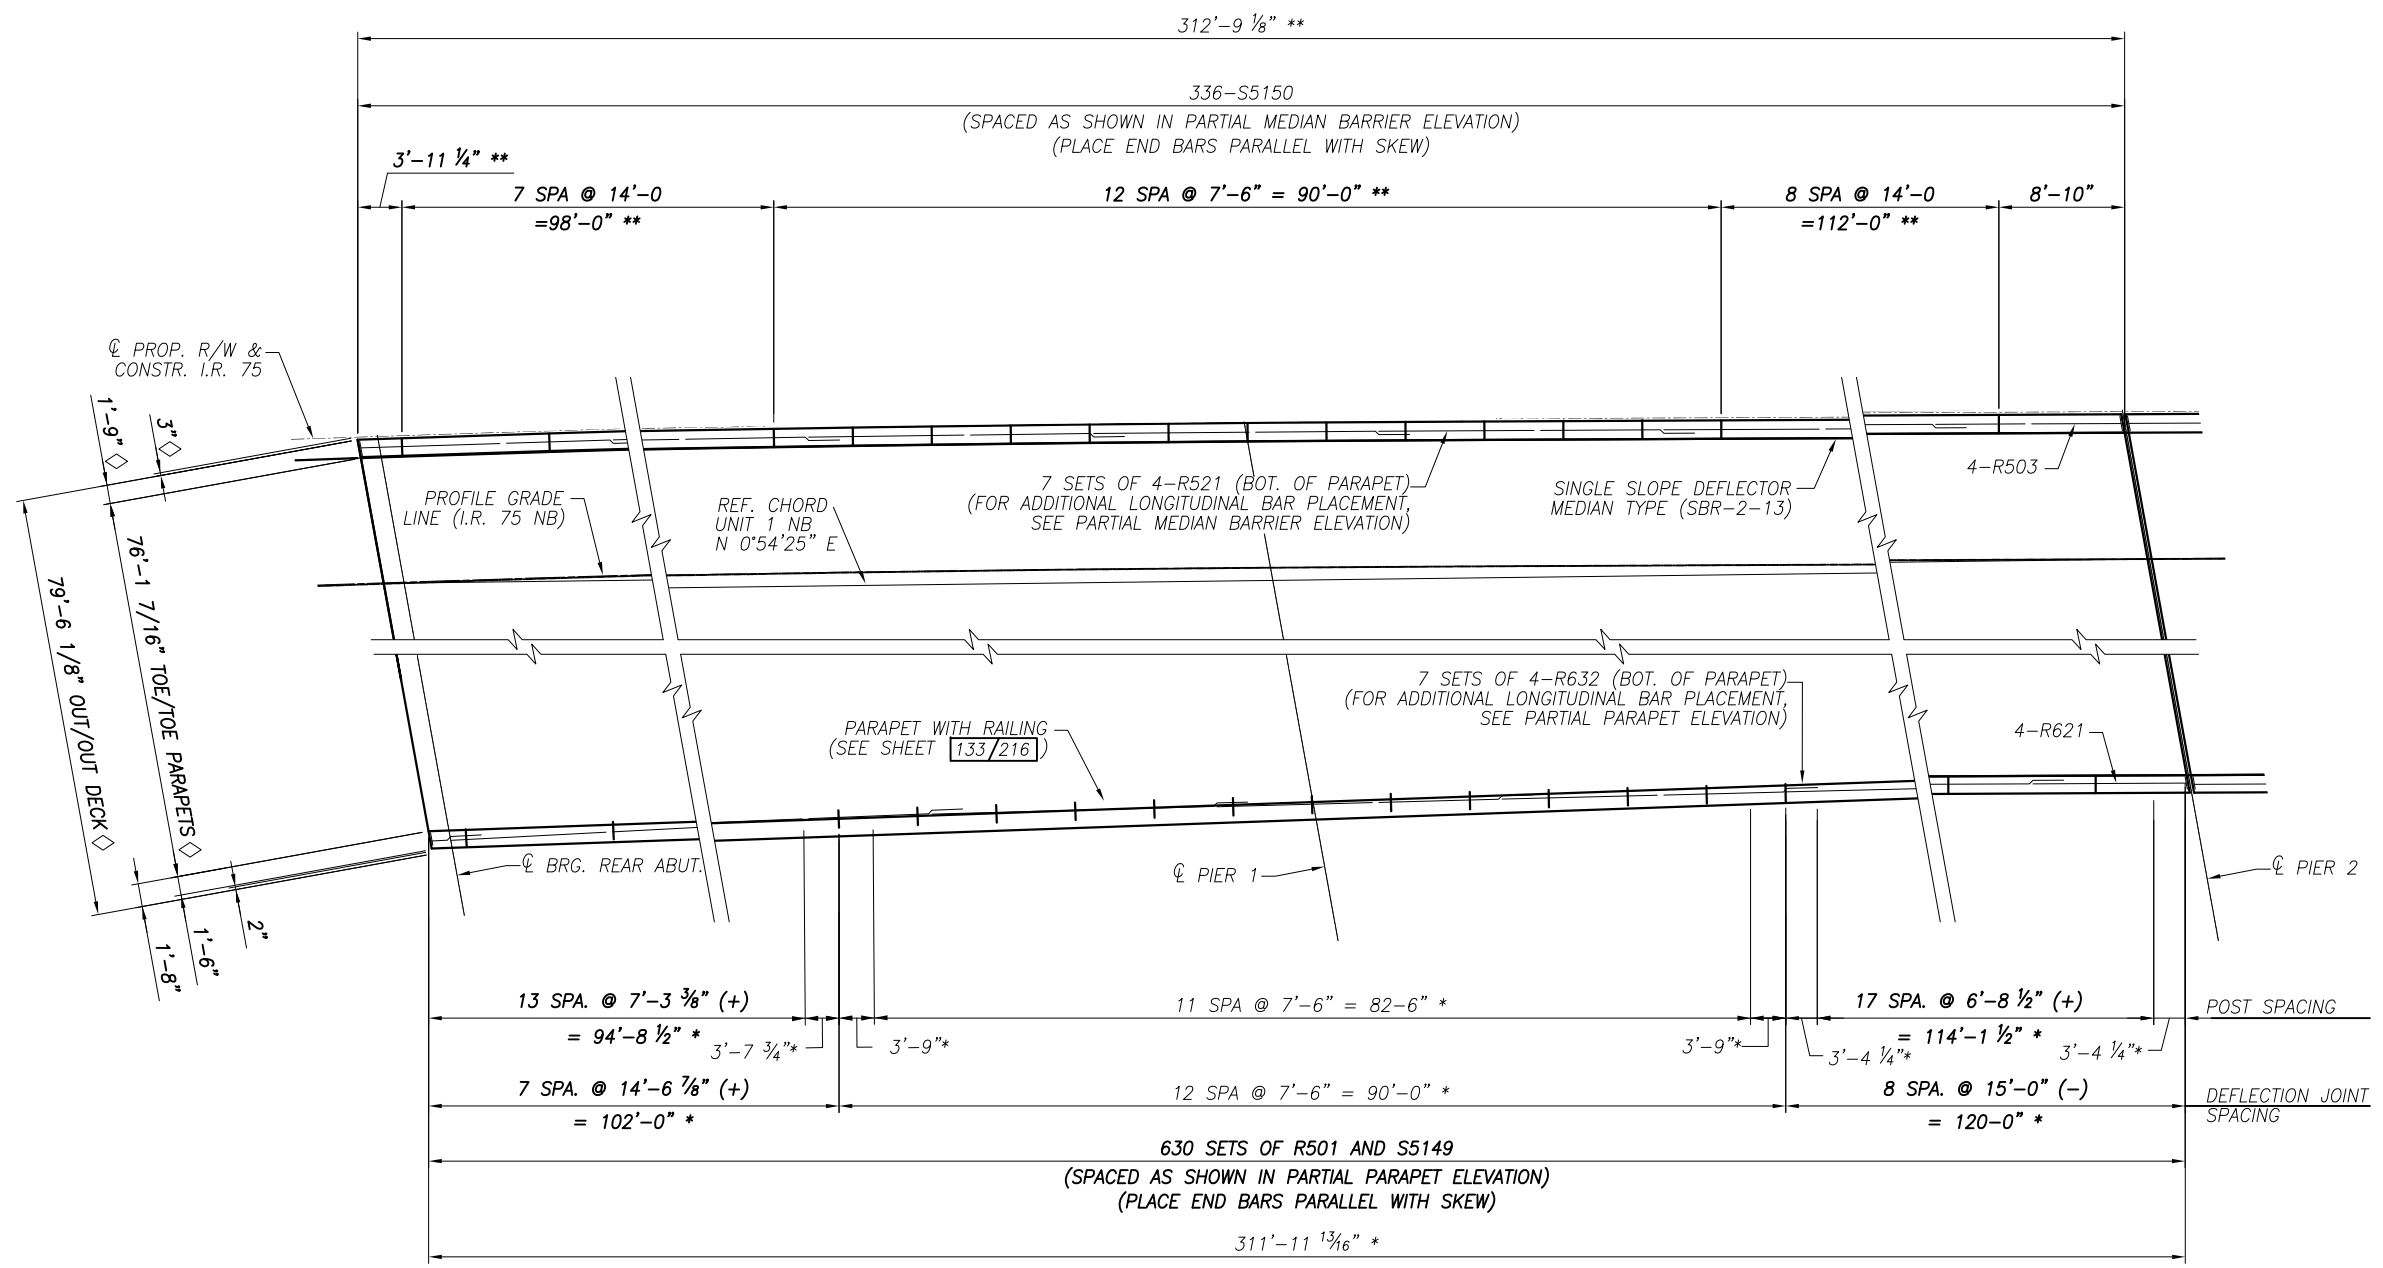

**PARAPET AND MEDIAN BARRIER PLAN**  
 UNIT 1 NORTHBOUND BRIDGE

No. OF PANELS	LENGTH "X"	No. OF BARS IN EA. PANEL	BAR "8-Z1"
7	14'-6 7/8"	30	R622
12	7'-6"	15	R604
8	15'-0"	30	R633

SEE PARTIAL PARAPET ELEVATION ON SHEET **131/216** FOR ADDITIONAL INFORMATION PERTAINING TO TABLE ABOVE.

No. OF PANELS	LENGTH "X"	No. OF BARS IN EA. PANEL	BAR "Z1"	BAR 6-"Z2"
15	14'-0"	15	R606	R504
12	7'-6"	8	R604	R505
1	3'-11 1/4"	5	R607	R506
1	8'-10"	10	R608	R507

SEE MEDIAN BARRIER ELEVATION ON SHEET **132/216** FOR ADDITIONAL INFORMATION PERTAINING TO TABLE ABOVE.

NO. 5 BAR	4'-6"
NO. 6 BAR	5'-5"

**NOTES:**

- FOR DEFLECTION JOINT AND ADDITIONAL PARAPET AND MEDIAN BARRIER DETAILS, SEE SHEETS **131/216** AND **133/216**.
- FOR SLAB PLANS, SEE SHEETS **85/216** AND **111/216**.
- FOR TRANSVERSE SECTION, SEE SHEET **138/216**.
- FOR REINFORCING STEEL LIST, SEE SHEET **212/216**.
- FOR LIGHTING PILASTER DETAILS, SEE SHEET **134/216**.

**LEGEND:**

- \* - MEASURED ALONG TOE OF PARAPET
- \*\* - MEASURED ALONG TOE OF MEDIAN BARRIER
- ◇ - MEASURED PERPENDICULAR TO CL PROP. R/W & CONSTR. I.R. 75
- ‡ - MEASURED ALONG / WITH RESPECT TO REFERENCE CHORD

5/1/2020 JANSSEN & SPAANS ENGINEERING INC. - RECONFIGURED NORTHBOUND ON RAMP SHEET REPLACED

DESIGNED	WUZ	CBS
REVIEWED	WUZ	REVIS
DATE	5/2020	STRUCTURE FILE NUMBER
4802765/4802767		


PARAPET AND MEDIAN BARRIER PLAN - 7 OF 12  
 BRIDGE NO. LUC-75-0029 L/R  
 I.R. 75 OVER MAUMEE RIVER

W00/LUC-75-30.70/0.00  
 PID No. 93592  
 125/216  
 1418  
 1792

DESIGN AGENCY  
 JANSSEN & SPAANS ENGINEERING, INC.  
 9120 HARRISON PARK COURT  
 INDIANAPOLIS, IN 46216



Date: Oct 07, 2020, 5:01pm User Name: mlmgltin  
 File: P:\11321 - Toledo E Value Engineering\DWG\51BRIDGE\LUC-75-0027 over Maumee River\Sheets\075\_0027C\_DP016.dwg

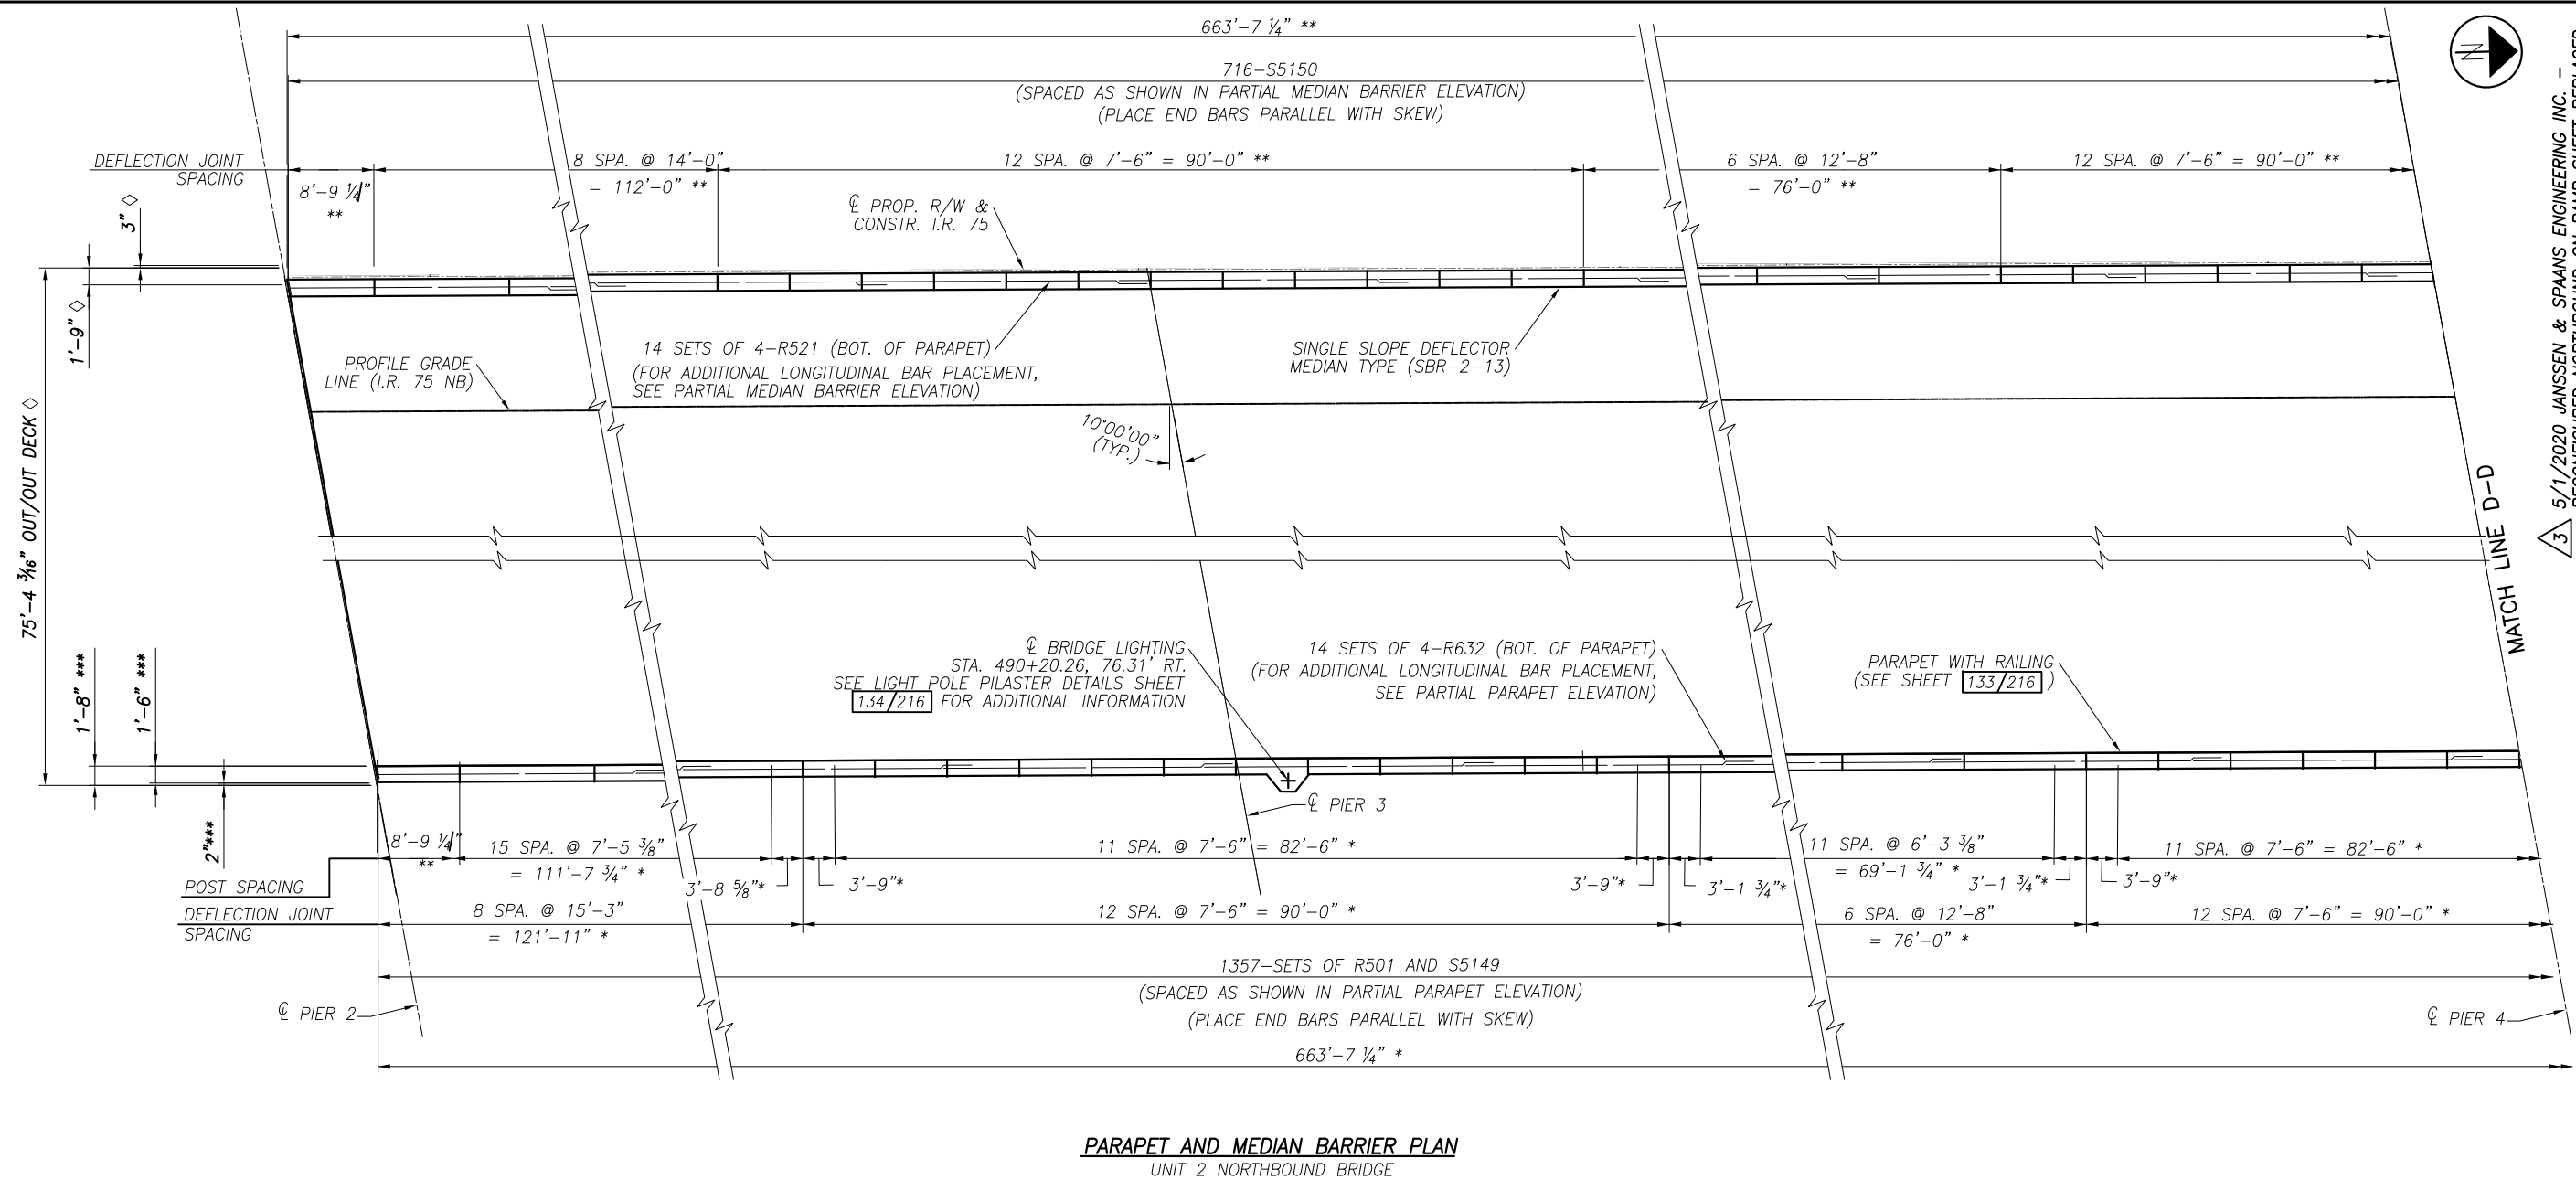

**PARAPET AND MEDIAN BARRIER PLAN**  
 UNIT 2 NORTHBOUND BRIDGE

No. OF PANELS	LENGTH "X"	No. OF BARS IN EA. PANEL "Y"	BAR 8-"Z1"
8	15'-3"	32	R606
6	12'-8"	27	R626
36	7'-6"	15	R604
6	12'-6 7/8"	26	R626
9	13'-4 3/8"	27	R627

SEE PARTIAL PARAPET ELEVATION ON SHEET **131/216** FOR ADDITIONAL INFORMATION PERTAINING TO TABLE ABOVE.

No. OF PANELS	LENGTH "X"	No. OF BARS IN EA. PANEL "Y"	BAR "Z1"	BAR 6-"Z2"
16	14'-0"	15	R606	R504
36	7'-6"	8	R604	R505
12	12'-8"	14	R628	R509
2	8'-9 1/2"	10	R614	R510

SEE MEDIAN BARRIER ELEVATION ON SHEET **132/216** FOR ADDITIONAL INFORMATION PERTAINING TO TABLE ABOVE.

NO. 5 BAR	4'-6"
NO. 6 BAR	5'-5"

**NOTES:**

- FOR DEFLECTION JOINT AND ADDITIONAL PARAPET AND MEDIAN BARRIER DETAILS, SEE SHEETS **131/216** AND **133/216**.
- FOR SLAB PLANS, SEE SHEETS **85/216** AND **111/216**.
- FOR TRANSVERSE SECTION, SEE SHEET **139/216**.
- FOR REINFORCING STEEL LIST, SEE SHEET **212/216**.
- FOR LIGHTING PILASTER DETAILS, SEE SHEET **134/216**.

**LEGEND:**

- \* - MEASURED ALONG TOE OF PARAPET
- \*\* - MEASURED ALONG TOE OF MEDIAN BARRIER
- \*\*\* - MEASURED PERPENDICULAR TO EDGE OF DECK
- ◇ - MEASURED PERPENDICULAR TO  $\phi$  PROP. R/W & CONSTR. I.R. 75

DESIGN AGENCY  
**JANSSEN & SPAANS ENGINEERING, INC.**  
 9120 HARRISON PARK COURT  
 INDIANAPOLIS, IN 46216

DATE  
 5/2020

REVIEWED  
 WJZ

STRUCTURE FILE NUMBER  
 4802765/4802767

DESIGNED  
 WJZ

CHECKED  
 CBS

DRAWN  
 WJZ

REVISIONS  
 REM  
 REVISED


3 5/1/2020 JANSSEN & SPAANS ENGINEERING INC. -  
 RECONFIGURED NORTHBOUND ON RAMP SHEET REPLACED

PARAPET AND MEDIAN BARRIER PLAN - 8 OF 12  
 BRIDGE NO. LUC-75-0029 L/R  
 I.R. 75 OVER MAUMEE RIVER

W00/LUC-75-  
 30.70/0.00  
 PID No. 93592

126/216  
 1419  
 1792

Date: Oct 07, 2020, 5:04pm User Name: mlongtin  
 File: P:\1321 - Toledo E Value Engineering\DWG\SRIDCE\LUC-75-0027 over Maumee River\Sheets\075\_0027C\_DP016.dwg

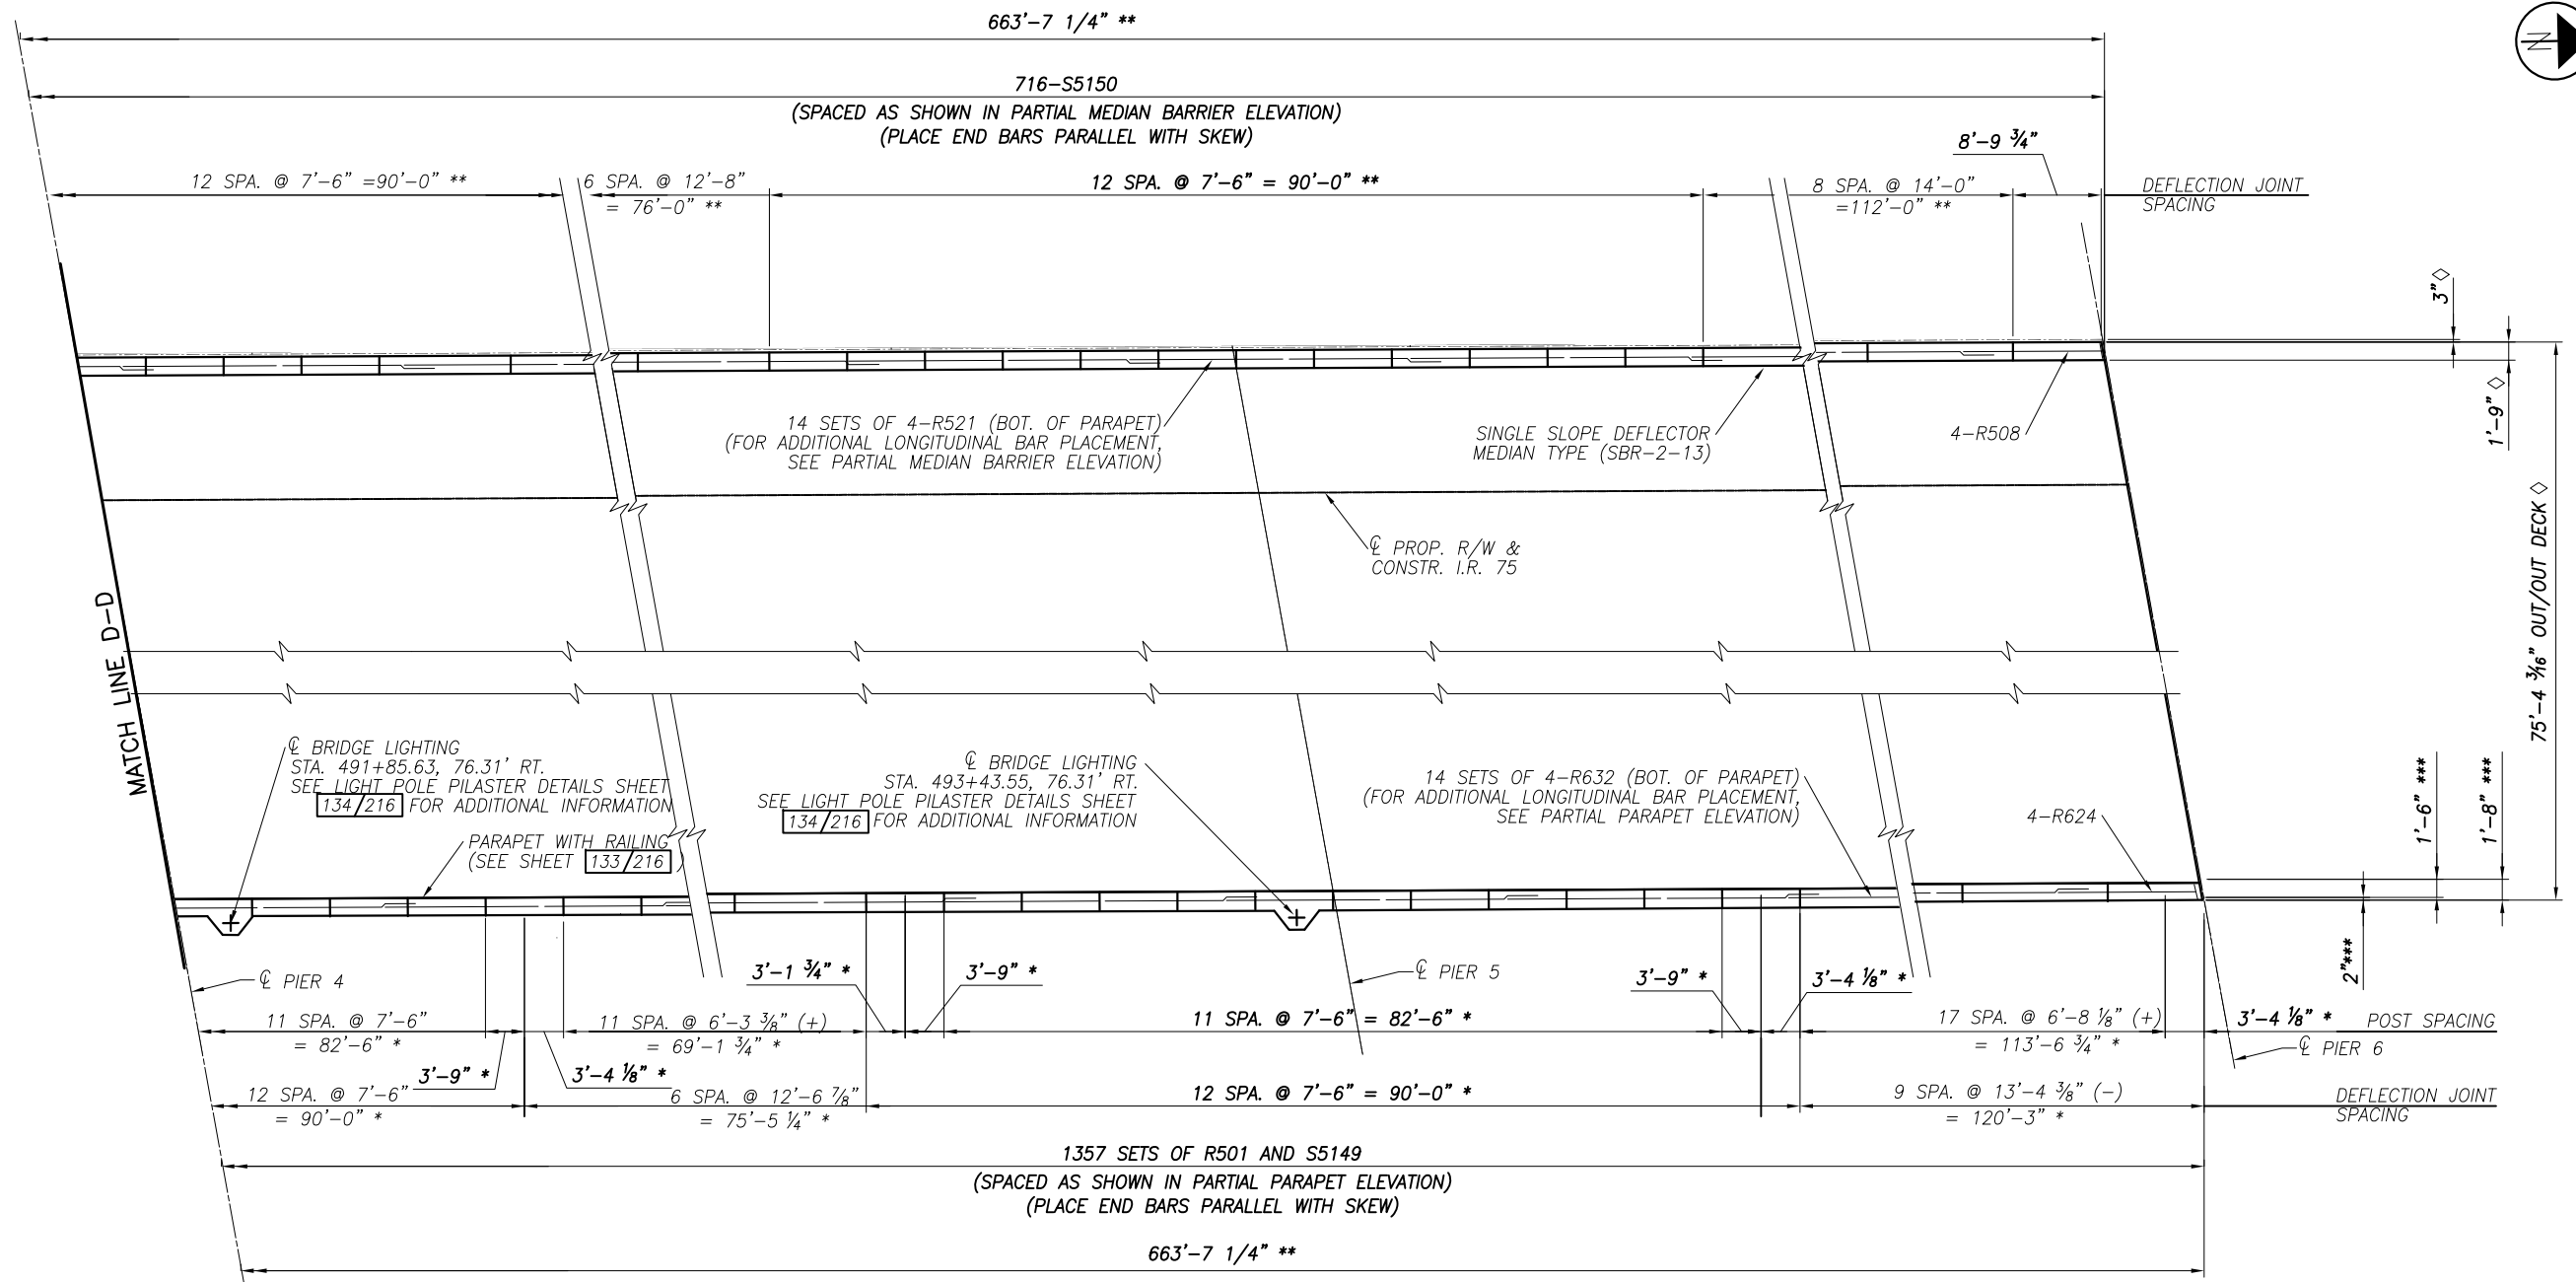

**PARAPET AND MEDIAN BARRIER PLAN**  
 UNIT 2 NORTHBOUND BRIDGE

MIN. BAR LAP LENGTHS	
NO. 5 BAR	4'-6"
NO. 6 BAR	5'-5"

**NOTES:**

- FOR DEFLECTION JOINT AND ADDITIONAL PARAPET AND MEDIAN BARRIER DETAILS, SEE SHEETS 131/216 AND 133/216.
- FOR SLAB PLANS, SEE SHEETS 85/216 AND 111/216.
- FOR TRANSVERSE SECTION, SEE SHEET 139/216.
- FOR REINFORCING STEEL LIST, SEE SHEET 212/216.
- FOR LIGHTING PILASTER DETAILS, SEE SHEET 134/216.

**LEGEND:**

- \* - MEASURED ALONG TOE OF PARAPET
- \*\* - MEASURED ALONG TOE OF MEDIAN BARRIER
- \*\*\* - MEASURED PERPENDICULAR TO EDGE OF DECK
- ◇ - MEASURED PERPENDICULAR TO CL PROP. R/W & CONSTR. I.R. 75
- ‡ - MEASURED ALONG / WITH RESPECT TO REFERENCE CHORD

3 5/1/2020 JANSEN & SPANS ENGINEERING INC. - RECONFIGURED NORTHBOUND ON RAMP SHEET REPLACED


DESIGNED	WJZ	CBS
DRAWN	WJZ	CBS
REVIEWED	WJZ	CBS
DATE	5/2020	
DESIGN AGENCY	JANSSEN & SPANS ENGINEERING, INC. 9120 HARRISON PARK COURT INDIANAPOLIS, IN 46216	
STRUCTURE FILE NUMBER	4802765/4802767	

PARAPET AND MEDIAN BARRIER PLAN - 9 OF 12  
 BRIDGE NO. LUC-75-0029 L/R  
 I.R. 75 OVER MAUMEE RIVER

W00/LUC-75-30.70/0.00  
 PID No. 93592

127/216  
 1420  
 1792

Date: Oct 07, 2020, 4:59pm User Name: mlongtin  
 File: P:\1321 - Toledo E Value Engineering\DWG\5\BRIDGE\LUC-75-0027 over Maumee River\Sheets\027C\_DP018.dwg

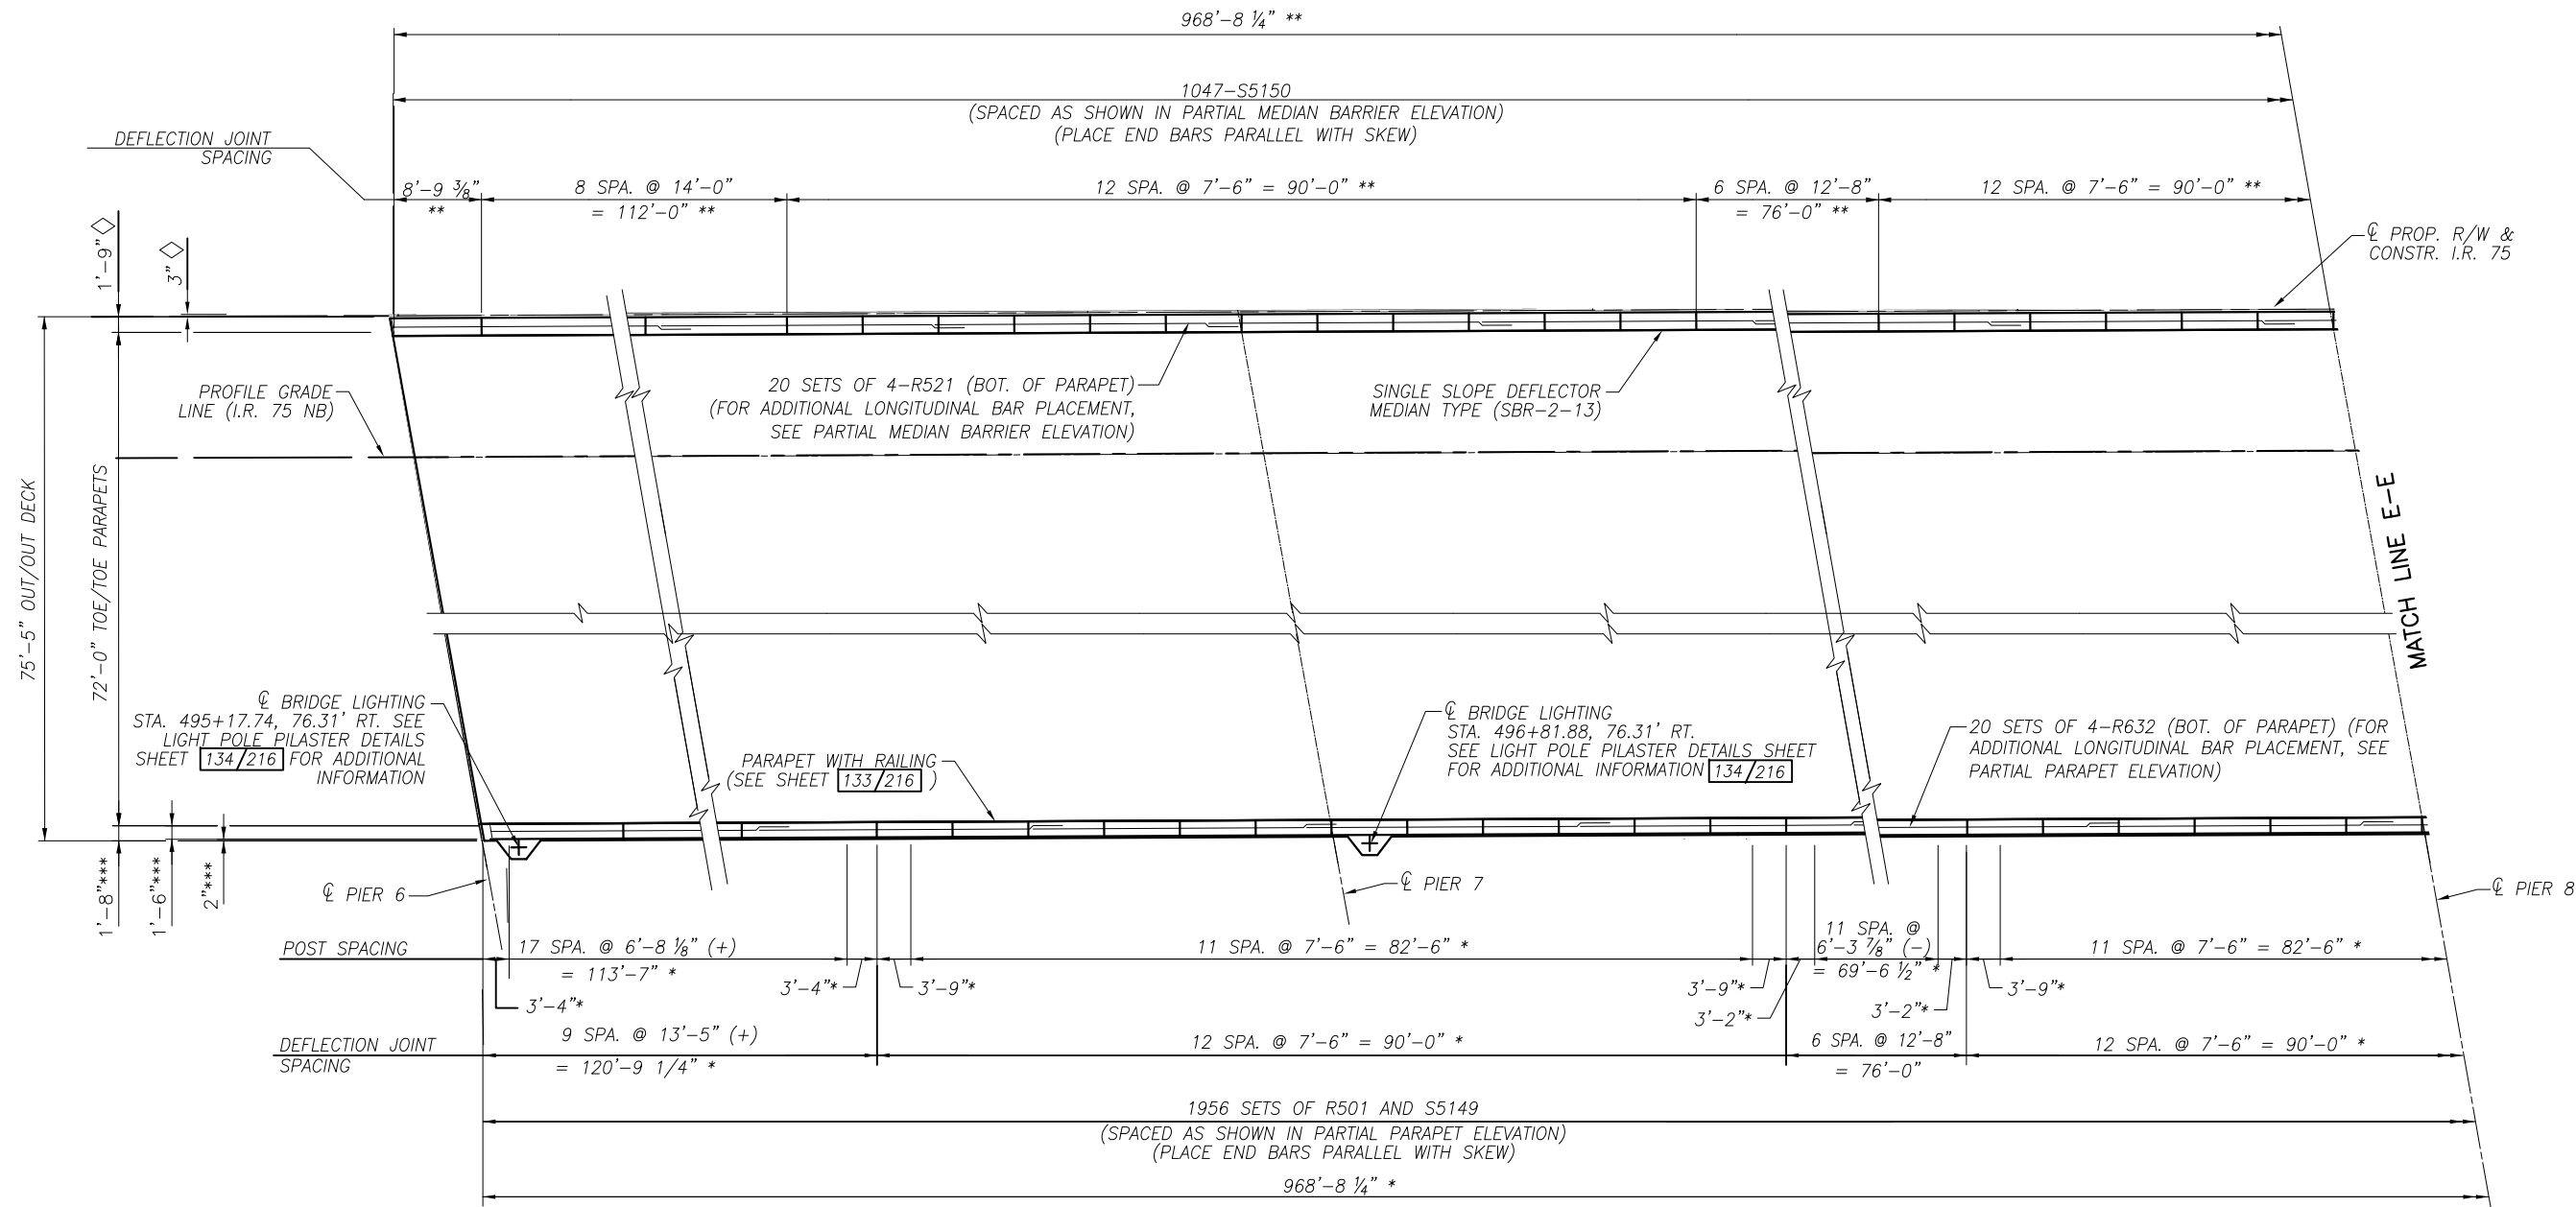

**PARAPET AND MEDIAN BARRIER PLAN**  
 UNIT 3 NORTHBOUND BRIDGE

No. OF PANELS	LENGTH "X"	No. OF BARS IN EA. PANEL "Y"	BAR 8-"Z1"
9	13'-5"	27	R627
60	7'-6"	15	R604
7	13'-5"	27	R623
24	12'-8"	26	R628

SEE PARTIAL PARAPET ELEVATION ON SHEET **131/216** FOR ADDITIONAL INFORMATION PERTAINING TO TABLE ABOVE.

No. OF PANELS	LENGTH "X"	No. OF BARS IN EA. PANEL "Y"	BAR "Z1"	BAR 6-"Z2"
14	14'-0"	15	R606	R504
60	7'-6"	8	R604	R505
24	12'-8"	14	R628	R517
1	8'-9 3/8"	10	R614	R518
1	9'-10 7/8"	11	R631	R512

SEE MEDIAN BARRIER ELEVATION ON SHEET **132/216** FOR ADDITIONAL INFORMATION PERTAINING TO TABLE ABOVE.


NO. 5 BAR	4'-6"
NO. 6 BAR	5'-5"

**NOTES:**

- FOR DEFLECTION JOINT AND ADDITIONAL PARAPET AND MEDIAN BARRIER DETAILS, SEE SHEETS **131/216** AND **133/216**.
- FOR SLAB PLANS, SEE SHEETS **85/216** AND **111/216**.
- FOR TRANSVERSE SECTION, SEE SHEET **140/216**.
- FOR REINFORCING STEEL LIST, SEE SHEET **212/216**.
- FOR LIGHTING PILASTER DETAILS, SEE SHEET **134/216**.

**LEGEND:**

- \* - MEASURED ALONG TOE OF PARAPET
- \*\* - MEASURED ALONG TOE OF MEDIAN BARRIER
- \*\*\* - MEASURED PERPENDICULAR TO EDGE OF DECK
- ◇ - MEASURED PERPENDICULAR TO CL PROP. R/W & CONSTR. I.R. 75

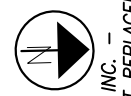

3 5/1/2020 JANSSEN & SPANS ENGINEERING INC. RECONFIGURED NORTHBOUND ON RAMP SHEET REPLACED  
 DESIGN AGENCY: JANSSEN & SPANS ENGINEERING, INC. 9120 HARRISON PARK COURT INDIANAPOLIS, IN 46216  
 DATE: 5/2020  
 REVIEWED: WJZ  
 DRAWN: REM  
 CHECKED: CBS  
 STRUCTURE FILE NUMBER: 4802765/4802767


PARAPET AND MEDIAN BARRIER PLAN - 10 OF 12  
 BRIDGE NO. LUC-75-0029 L/R  
 I.R. 75 OVER MAUMEE RIVER

W00/LUC-75-30.70/0.00  
 PID No. 93592

128/216

1421  
1792

Date: Oct 07, 2020, 5:00pm User Name: mlongtin  
 File: P:\11321 - Toledo E Value Engineering\DWG\5\BRIDGE\LUC-75-0027 over Maumee River\Sheets\075\_0027C\_DP018.dwg

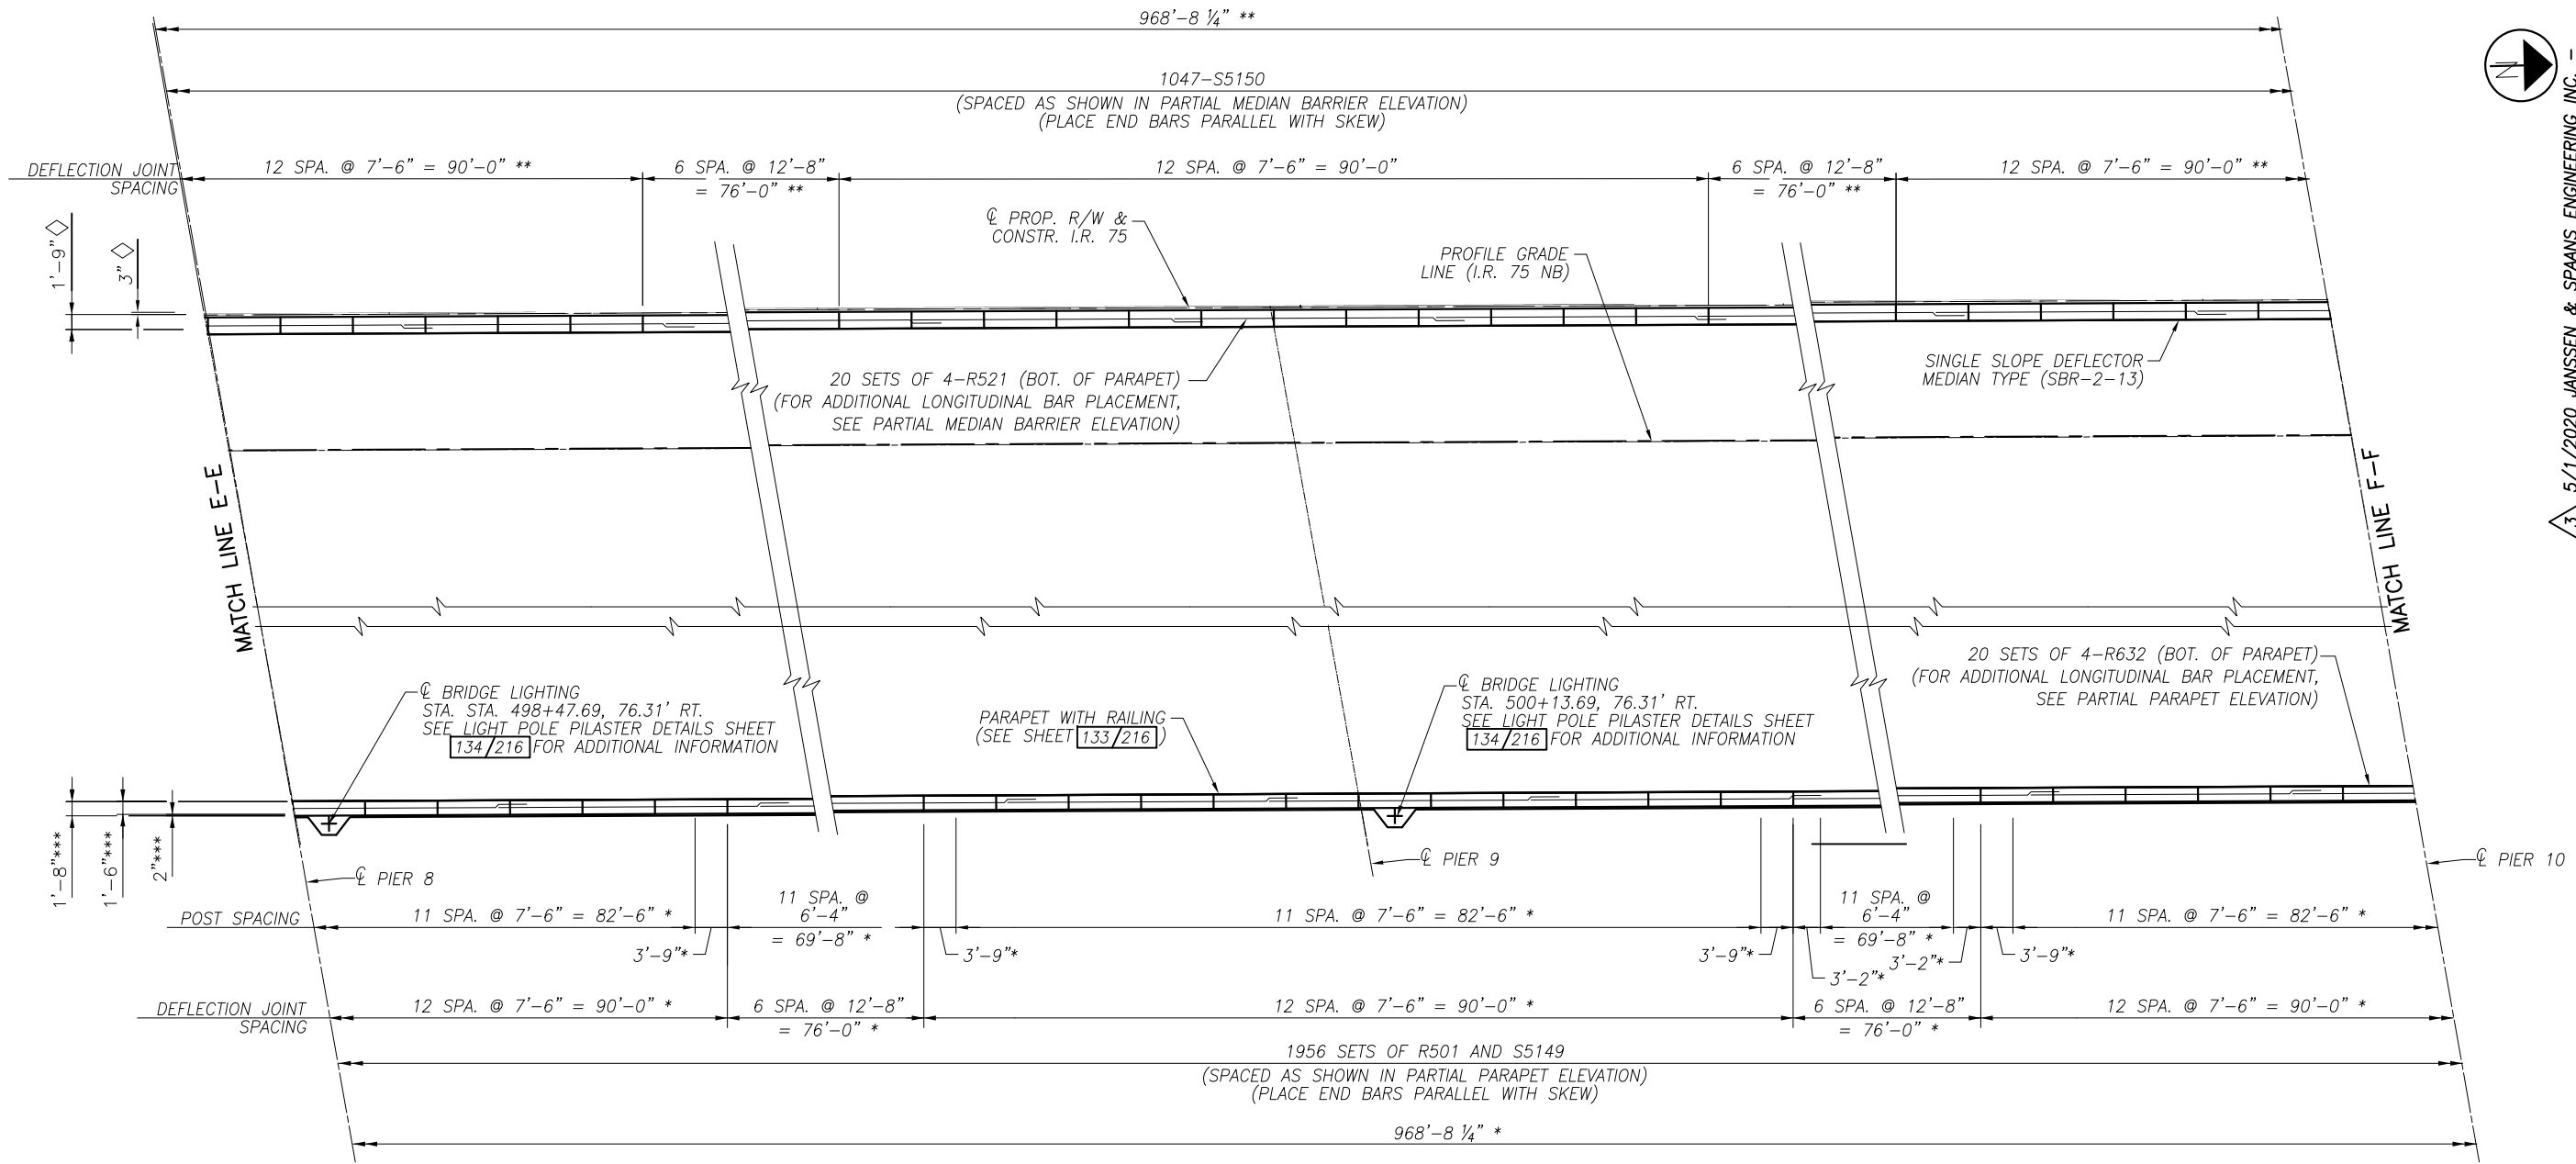

**PARAPET AND MEDIAN BARRIER PLAN**  
 UNIT 3 NORTHBOUND BRIDGE

MIN. BAR LAP LENGTHS	
NO. 5 BAR	4'-6"
NO. 6 BAR	5'-5"

**NOTES:**

- FOR DEFLECTION JOINT AND ADDITIONAL PARAPET AND MEDIAN BARRIER DETAILS, SEE SHEETS 131/216 AND 133/216.
- FOR SLAB PLANS, SEE SHEETS 85/216 AND 111/216.
- FOR TRANSVERSE SECTION, SEE SHEET 140/216.
- FOR REINFORCING STEEL LIST, SEE SHEET 212/216.
- FOR LIGHTING PILASTER DETAILS, SEE SHEET 134/216.

**LEGEND:**

- \* - MEASURED ALONG TOE OF PARAPET
- \*\* - MEASURED ALONG TOE OF MEDIAN BARRIER
- \*\*\* - MEASURED PERPENDICULAR TO EDGE OF DECK
- ◇ - MEASURED PERPENDICULAR TO  $\phi$  PROP. R/W & CONSTR. I.R. 75

3 5/1/2020 JANSEN & SPAANS ENGINEERING INC. RECONFIGURED NORTHBOUND ON RAMP SHEET REPLACED

DESIGN AGENCY  
**JANSEN & SPAANS ENGINEERING, INC.**  
 9120 HARRISON PARK COURT  
 INDIANAPOLIS, IN 46216

DATE 5/2020  
 REVIEWED WJZ  
 DRAWN REM  
 STRUCTURE FILE NUMBER 4802765/4802767  
 CHECKED CBS


PARAPET AND MEDIAN BARRIER PLAN - 11 OF 12  
 BRIDGE NO. LUC-75-0029 L/R  
 I.R. 75 OVER MAUMEE RIVER

W00/LUC-75-30.70/0.00  
 PID No. 93592

129/216

1422  
 1792

Date: Oct 07, 2020, 5:00pm User Name: mlongtin  
 File: P:\1321 - Toledo E Value Engineering\DWG\5\BRIDGE\LUC-75-0027 over Maumee River\Sheets\075\_0027C\_DP018.dwg

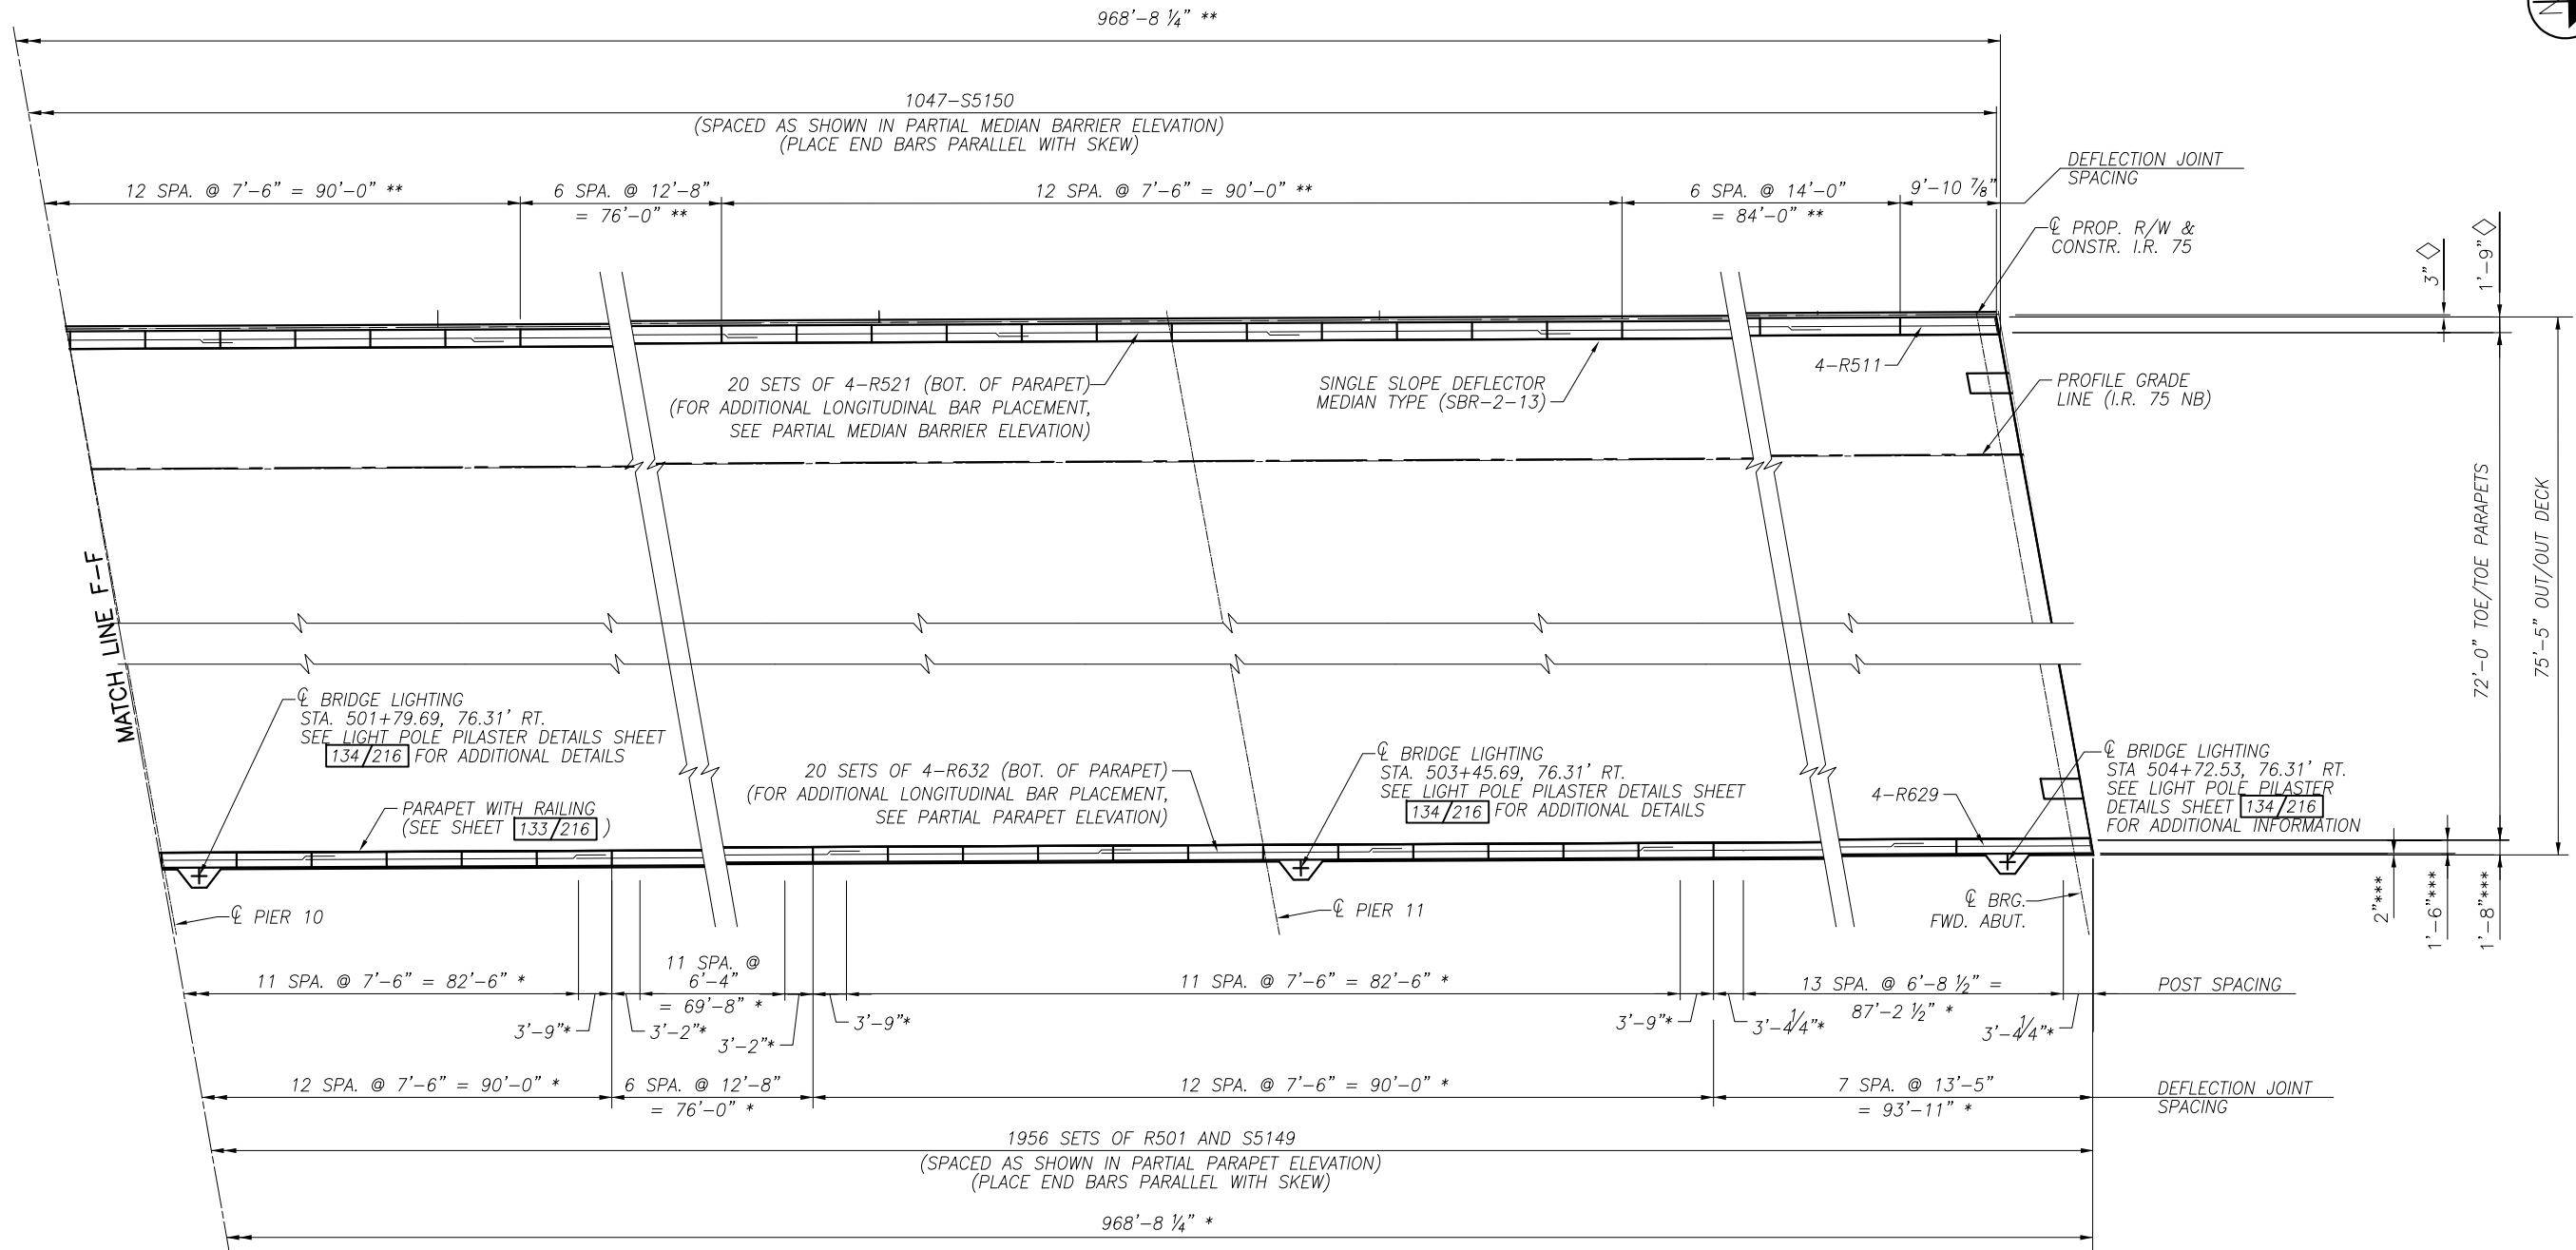

**PARAPET AND MEDIAN BARRIER PLAN**  
 UNIT 3 NORTHBOUND BRIDGE

MIN. BAR LAP LENGTHS	
NO. 5 BAR	4'-6"
NO. 6 BAR	5'-5"

**NOTES:**

- FOR DEFLECTION JOINT AND ADDITIONAL PARAPET AND MEDIAN BARRIER DETAILS, SEE SHEETS 131/216 AND 133/216.
- FOR SLAB PLANS, SEE SHEETS 85/216 AND 111/216.
- FOR TRANSVERSE SECTION, SEE SHEET 140/216.
- FOR REINFORCING STEEL LIST, SEE SHEET 212/216.
- FOR LIGHTING PILASTER DETAILS, SEE SHEET 134/216.

**LEGEND:**

- \* - MEASURED ALONG TOE OF PARAPET
- \*\* - MEASURED ALONG TOE OF MEDIAN BARRIER
- \*\*\* - MEASURED PERPENDICULAR TO EDGE OF DECK
- ◇ - MEASURED PERPENDICULAR TO CL PROP. R/W & CONSTR. I.R. 75

5/1/2020 JANSSEN & SPANNS ENGINEERING INC. - RECONFIGURED NORTHBOUND ON RAMP SHEET REPLACED

DESIGN AGENCY  
**JANSSEN & SPANNS ENGINEERING, INC.**  
 9120 HARRISON PARK COURT  
 INDIANAPOLIS, IN 46216


DESIGNED	DATE	REVIEWED	DATE
WJZ	5/2020	WJZ	5/2020
CBS		REVIS	4802765/4802767

PARAPET AND MEDIAN BARRIER PLAN - 12 OF 12  
 BRIDGE NO. LUC-75-0029 L/R  
 I.R. 75 OVER MAUMEE RIVER

W00/LUC-75-30.70/0.00  
 PID No. 93592

130/216

1423  
 1792

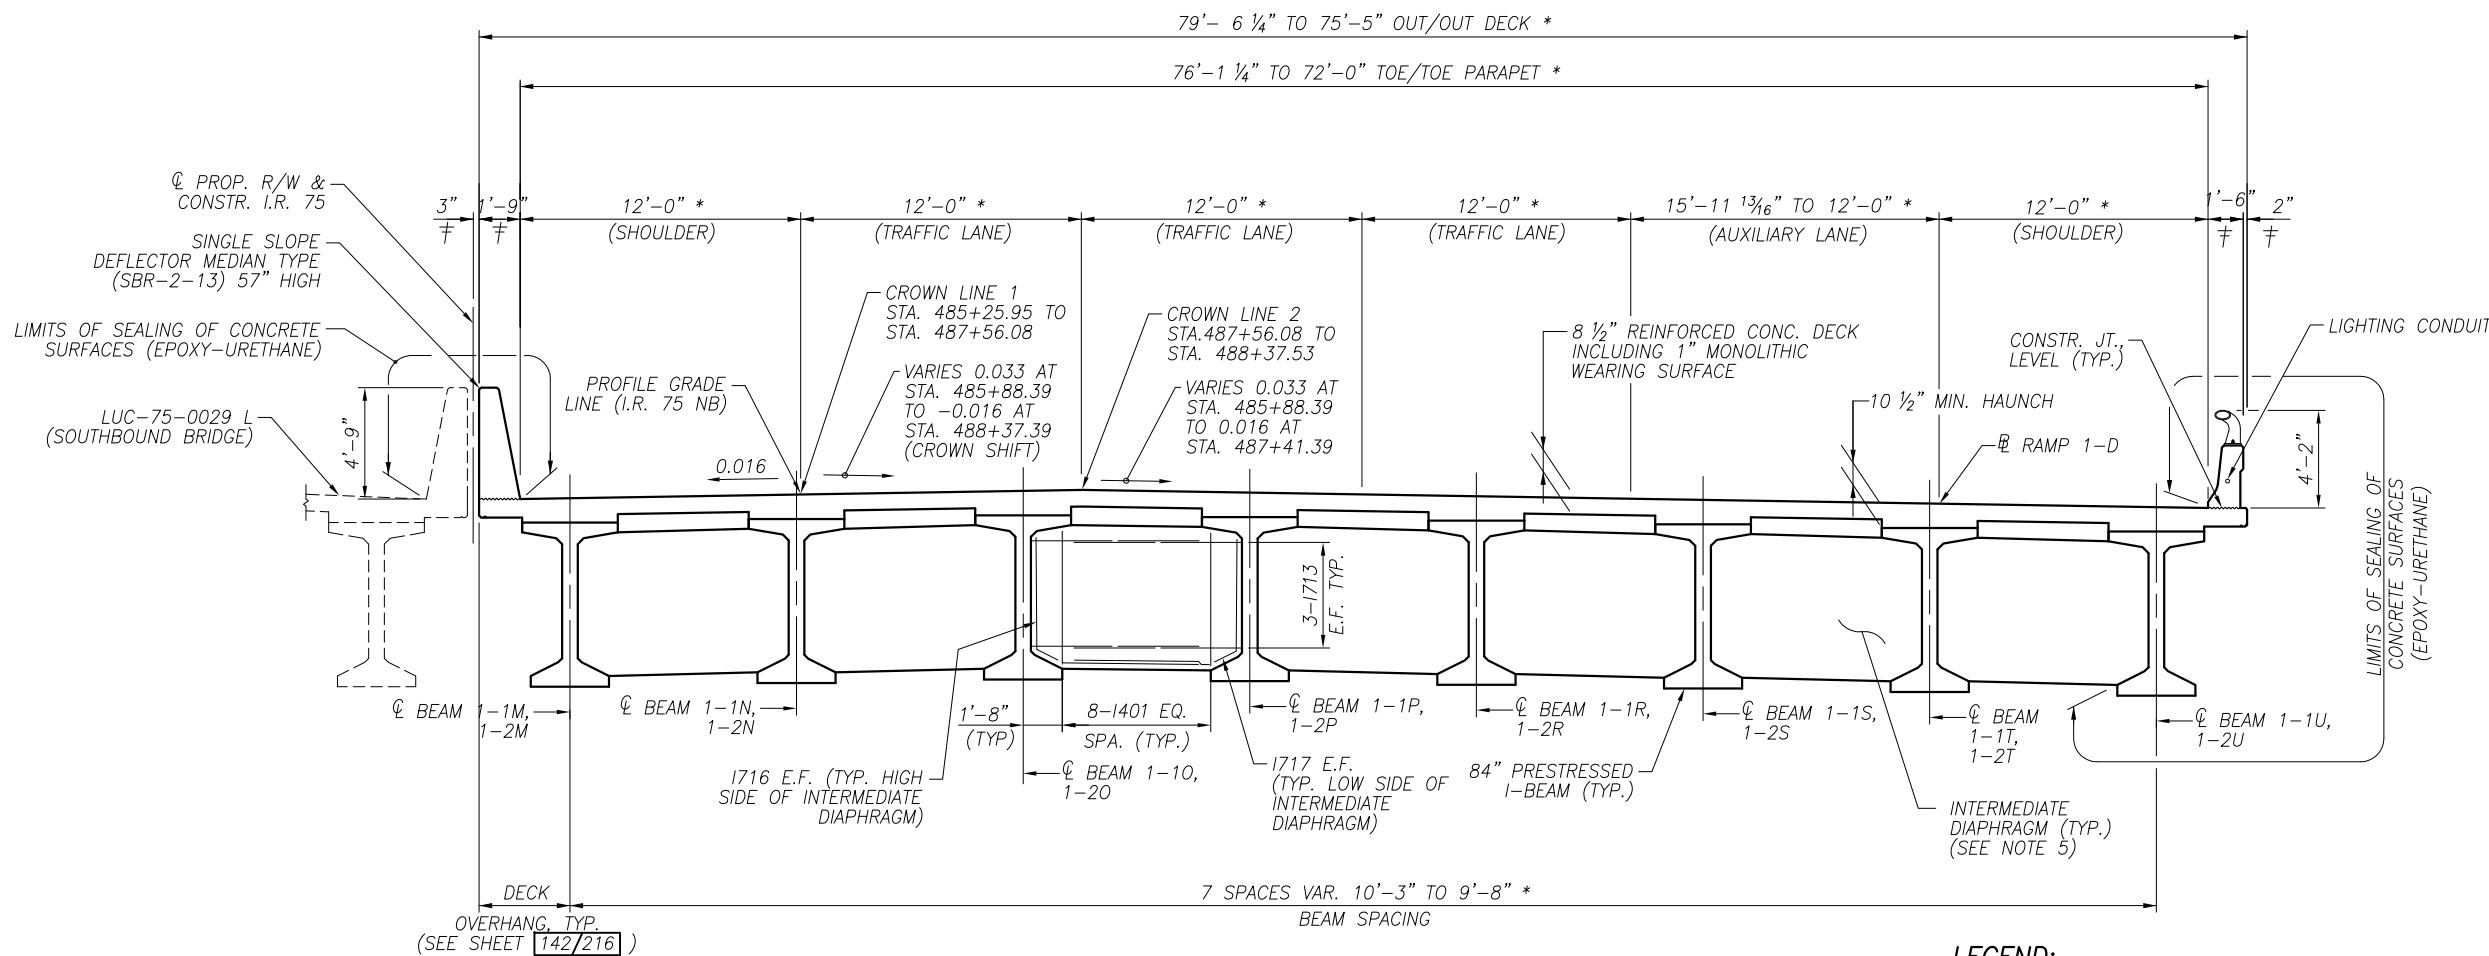


**TRANSVERSE SECTION**  
 LUC-75-0029 R  
 UNIT 1 NORTHBOUND BRIDGE  
 (SLAB REINFORCING NOT SHOWN FOR CLARITY)

**LEGEND:**

- \* - MEASURED PERPENDICULAR TO CL PROP. R/W & CONSTR. I.R. 75
- \*\*\* - MEASURED ALONG CL OF BEARING
- † - BARRIER DIMENSIONS PROVIDED PERPENDICULAR TO EDGE OF DECK

**NOTES:**

1. DECK SLAB CONCRETE QUANTITY: THE ESTIMATED QUANTITY OF DECK SLAB CONCRETE IS BASED ON THE CONSTANT DECK SLAB THICKNESS, AS SHOWN, PLUS THE QUANTITY OF CONCRETE THAT FORMS EACH BEAM HAUNCH. THE ESTIMATE ASSUMES A CONSTANT HAUNCH THICKNESS OF 4 INCHES. DEVIATE FROM THIS HAUNCH THICKNESS AS NECESSARY TO PLACE THE DECK SURFACE AT THE FINISHED GRADE. THE HAUNCH THICKNESS WAS MEASURED AT THE CENTERLINE OF THE GIRDER, FROM THE SURFACE OF THE DECK TO THE TOP OF THE TOP FLANGE MINUS THE DECK SLAB THICKNESS.
2. FOR GENERAL NOTES, SEE SHEETS 13/216 AND 14/216.
3. FOR SLAB PLANS, SEE SHEETS 106/216 THRU 111/216.
4. FOR REINFORCING STEEL LIST, SEE SHEETS 208/216 THRU 212/216 AND 215/216.
5. CONCRETE INTERMEDIATE DIAPHRAGMS SHALL BE CONSTRUCTED ACCORDING TO STANDARD DWG. PSID-1-13 FOR 60", 66" & 72" BEAMS, WITH THE EXCEPTION THAT NO. 7 REINFORCEMENT SHALL BE USED IN PLACE OF THE NO. 6 REINFORCEMENT SHOWN IN THE STANDARD DWG. THREADED INSERTS SHALL ACCOMMODATE NO. 7 REINFORCEMENT. CONTRACTOR MAY USE STEEL PER ODOT BDM 302.5.2.6. IF STEEL IS CHOSEN, TOP CHORD L 6x4x3/16" SHALL BE PROVIDED FOR DIAPHRAGMS IN THE EXTERIOR BAYS. USE 1" DIA. BOLTS FOR TOP AND BOTTOM CHORDS IN EXTERIOR BAY. REMAINING CONNECTIONS SHALL COMPLY WITH STANDARD DWG.
6. FOR FINAL DECK ELEVATIONS, SCREED, AND TOP OF HAUNCH, SEE SHEETS 143/216 THRU 192/216.
7. INTERMEDIATE DIAPHRAGM MINIMUM REBAR LAP LENGTHS ARE AS FOLLOWS:  
 NO. 7 = 4'-2"

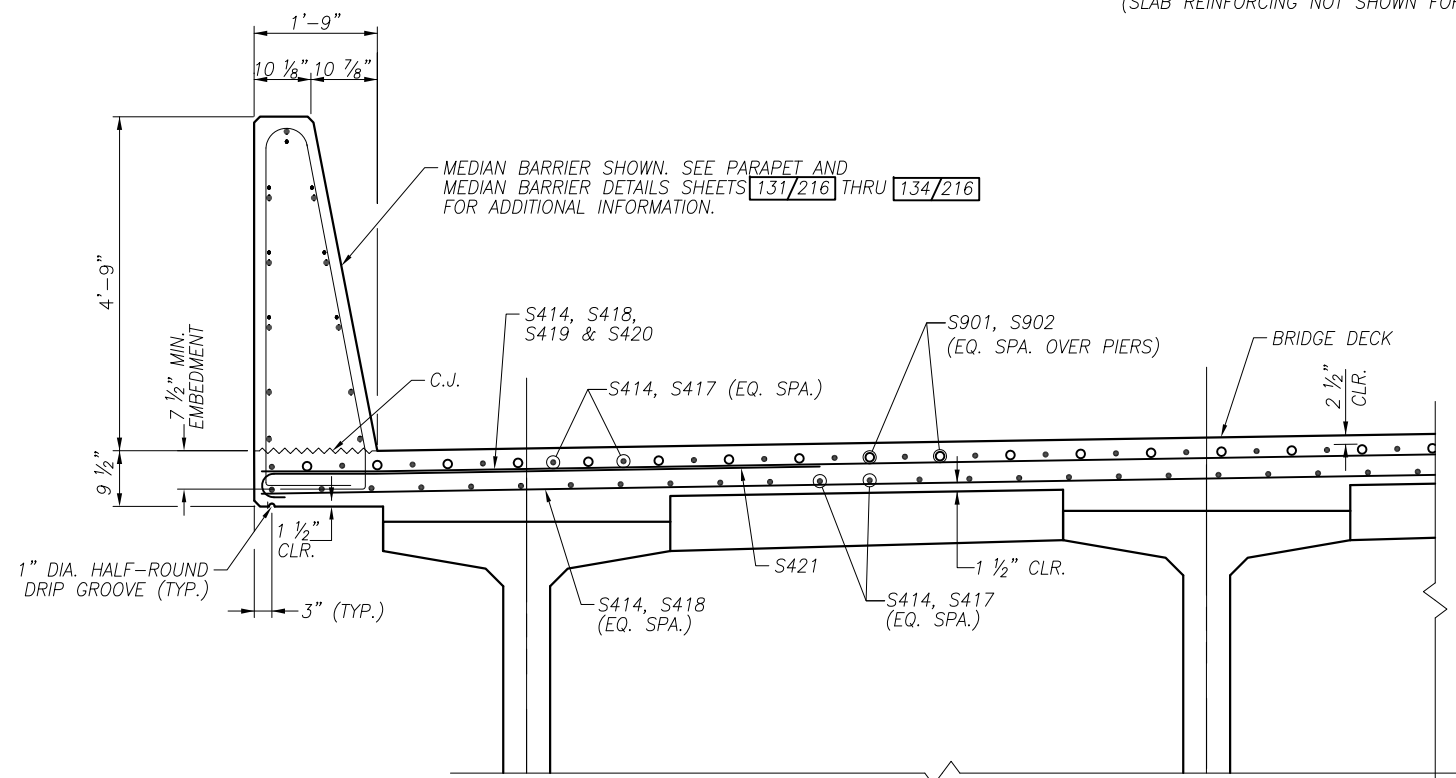

**REINFORCING DETAIL**

Date: Oct 08, 2020, 7:29am User Name: mlongtin  
 File: P:\11321 - Toledo E Value Engineering\DWG\5\BRIDGE\LUC-75-0027 over Maumee River\Sheets\075\_0027C\_T5006.dwg

3 5/1/2020 JANSSEN & SPAANS ENGINEERING INC. - RECONFIGURED NORTHBOUND ON RAMP SHEET REPLACED

DESIGNED	WJZ	CBS
DRAWN	WJZ	CBS
REVIEWED	WJZ	CBS
DATE	5/2020	
STRUCTURE FILE NUMBER	4802765/4802767	
DESIGN AGENCY	JANSSEN & SPAANS ENGINEERING, INC. 9120 HARRISON PARK COURT INDIANAPOLIS, IN 46216	


TRANSVERSE SECTION - 4 OF 6  
 BRIDGE NO. LUC-75-0029 L/R  
 I.R. 75 OVER MAUMEE RIVER

W00/LUC-75-30.70/0.00  
 PID No. 93592

138/216

1431  
1792

Date: Oct 08, 2020, 7:17am User Name: mlongtin  
 File: P:\11321 - Toledo E Value Engineering\DWG\5\BRIDGE\LUC-75-0027 over Maumee River\Sheets\075\_0027C\_T5006.dwg

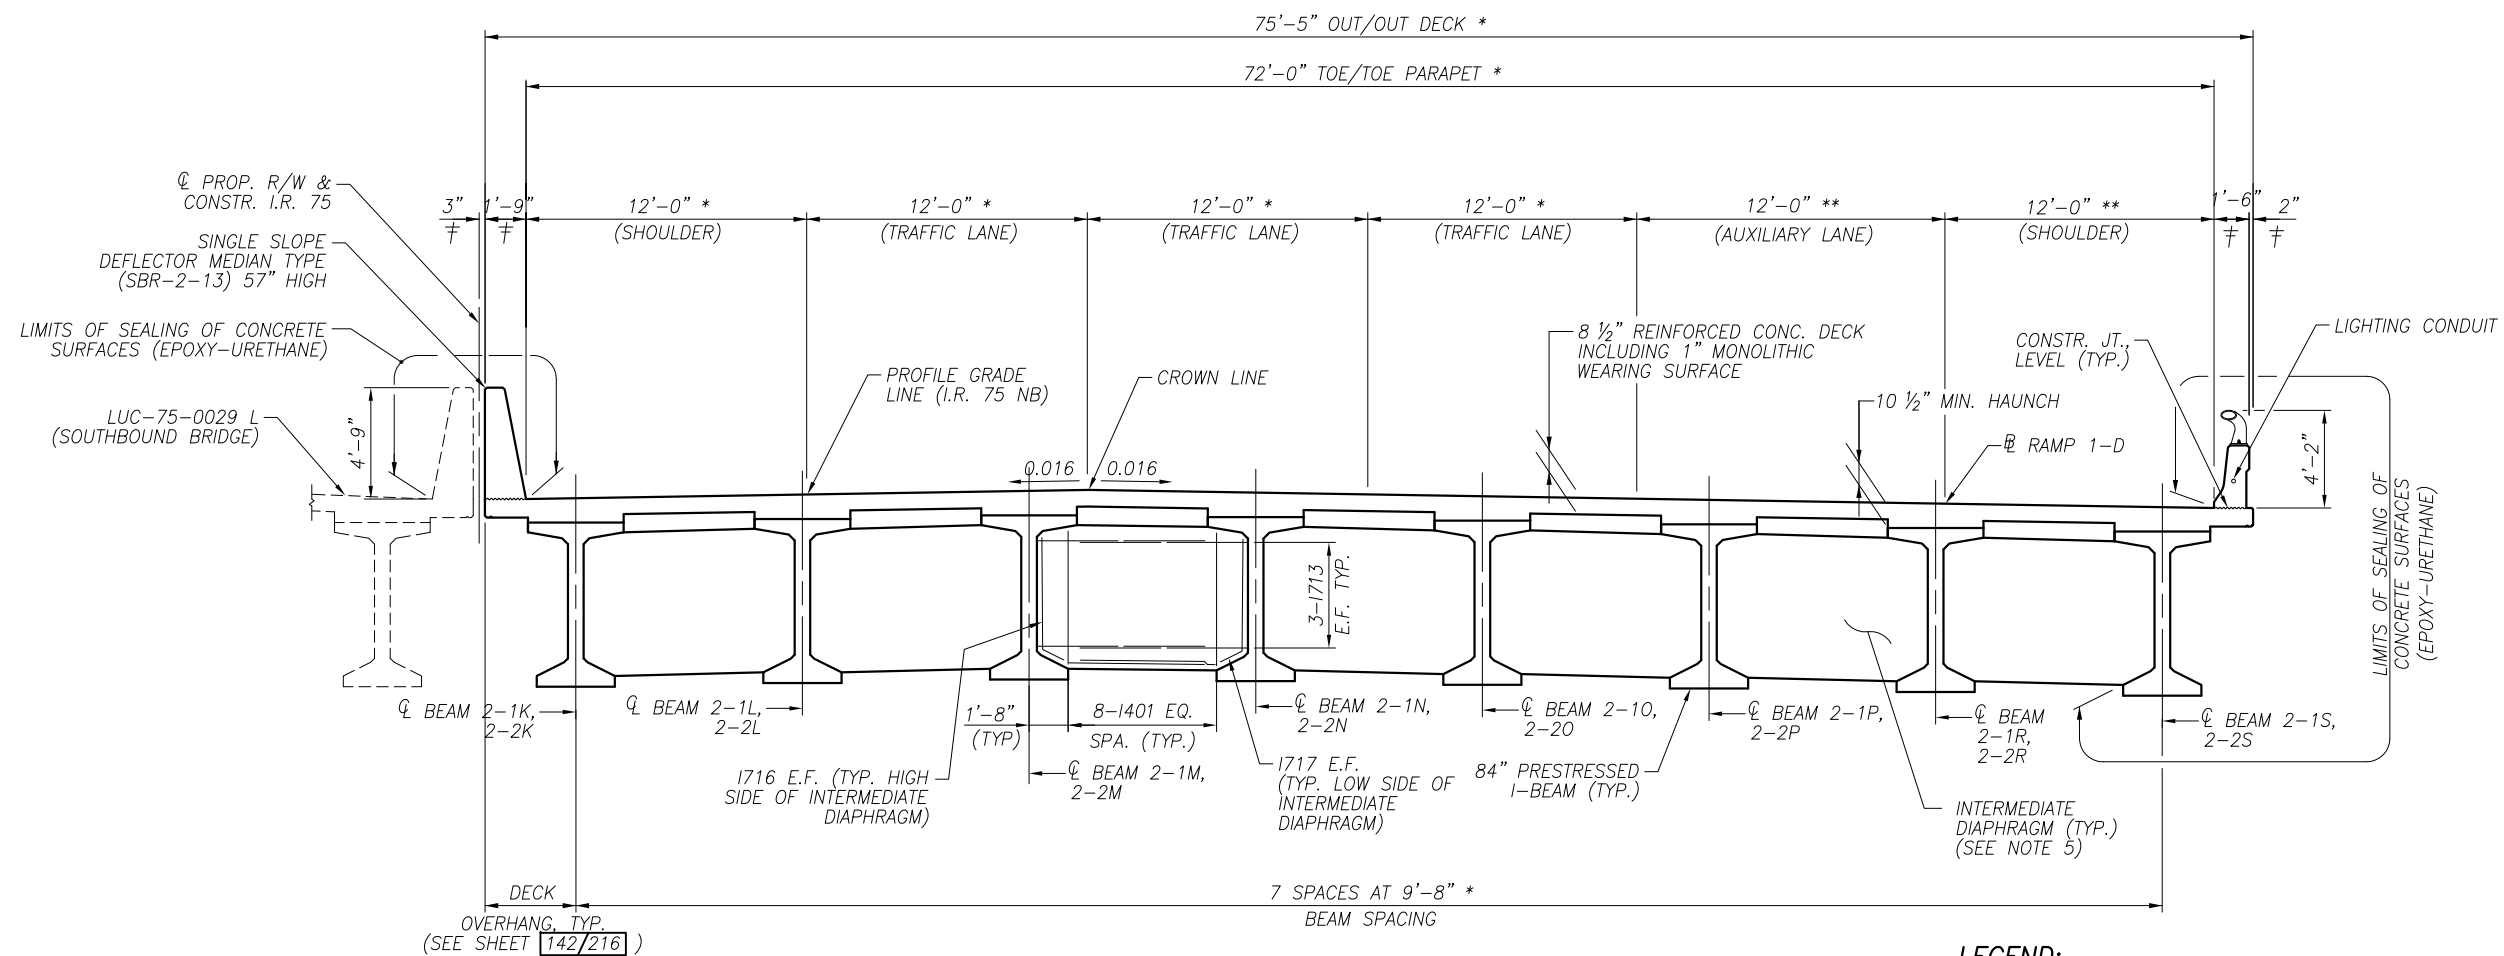

**TRANSVERSE SECTION**


LUC-75-0029 R  
 UNIT 2 NORTHBOUND BRIDGE  
 (SLAB REINFORCING NOT SHOWN FOR CLARITY)

**LEGEND:**

- \* - MEASURED PERPENDICULAR TO CL PROP. R/W & CONSTR. I.R. 75
- \*\*\* - MEASURED ALONG CL OF BEARING
- † - BARRIER DIMENSIONS PROVIDED PERPENDICULAR TO EDGE OF DECK

**NOTES:**

1. DECK SLAB CONCRETE QUANTITY: THE ESTIMATED QUANTITY OF DECK SLAB CONCRETE IS BASED ON THE CONSTANT DECK SLAB THICKNESS, AS SHOWN, PLUS THE QUANTITY OF CONCRETE THAT FORMS EACH BEAM HAUNCH. THE ESTIMATE ASSUMES A CONSTANT HAUNCH THICKNESS OF 4 INCHES. DEVIATE FROM THIS HAUNCH THICKNESS AS NECESSARY TO PLACE THE DECK SURFACE AT THE FINISHED GRADE. THE HAUNCH THICKNESS WAS MEASURED AT THE CENTERLINE OF THE GIRDER, FROM THE SURFACE OF THE DECK TO THE TOP OF THE TOP FLANGE MINUS THE DECK SLAB THICKNESS.
2. FOR GENERAL NOTES, SEE SHEETS 13/216 AND 14/216.
3. FOR SLAB PLANS, SEE SHEETS 106/216 THRU 111/216.
4. FOR REINFORCING STEEL LIST, SEE SHEETS 208/216 THRU 212/216 AND 215/216.
5. CONCRETE INTERMEDIATE DIAPHRAGMS SHALL BE CONSTRUCTED ACCORDING TO STANDARD DWG. PSID-1-13 FOR 60", 66" & 72" BEAMS, WITH THE EXCEPTION THAT NO. 7 REINFORCEMENT SHALL BE USED IN PLACE OF THE NO. 6 REINFORCEMENT SHOWN IN THE STANDARD DWG. THREADED INSERTS SHALL ACCOMMODATE NO. 7 REINFORCEMENT. CONTRACTOR MAY USE STEEL PER ODOT BDM 302.5.2.6. IF STEEL IS CHOSEN, TOP CHORD L 6x4x3/16" SHALL BE PROVIDED FOR DIAPHRAGMS IN THE EXTERIOR BAYS. USE 1" DIA. BOLTS FOR TOP AND BOTTOM CHORDS IN EXTERIOR BAY. REMAINING CONNECTIONS SHALL COMPLY WITH STANDARD DWG.
6. FOR FINAL DECK ELEVATIONS, SCREED, AND TOP OF HAUNCH, SEE SHEETS 143/216 THRU 192/216.
7. INTERMEDIATE DIAPHRAGM MINIMUM REBAR LAP LENGTHS ARE AS FOLLOWS:  
 NO. 7 = 4'-2"

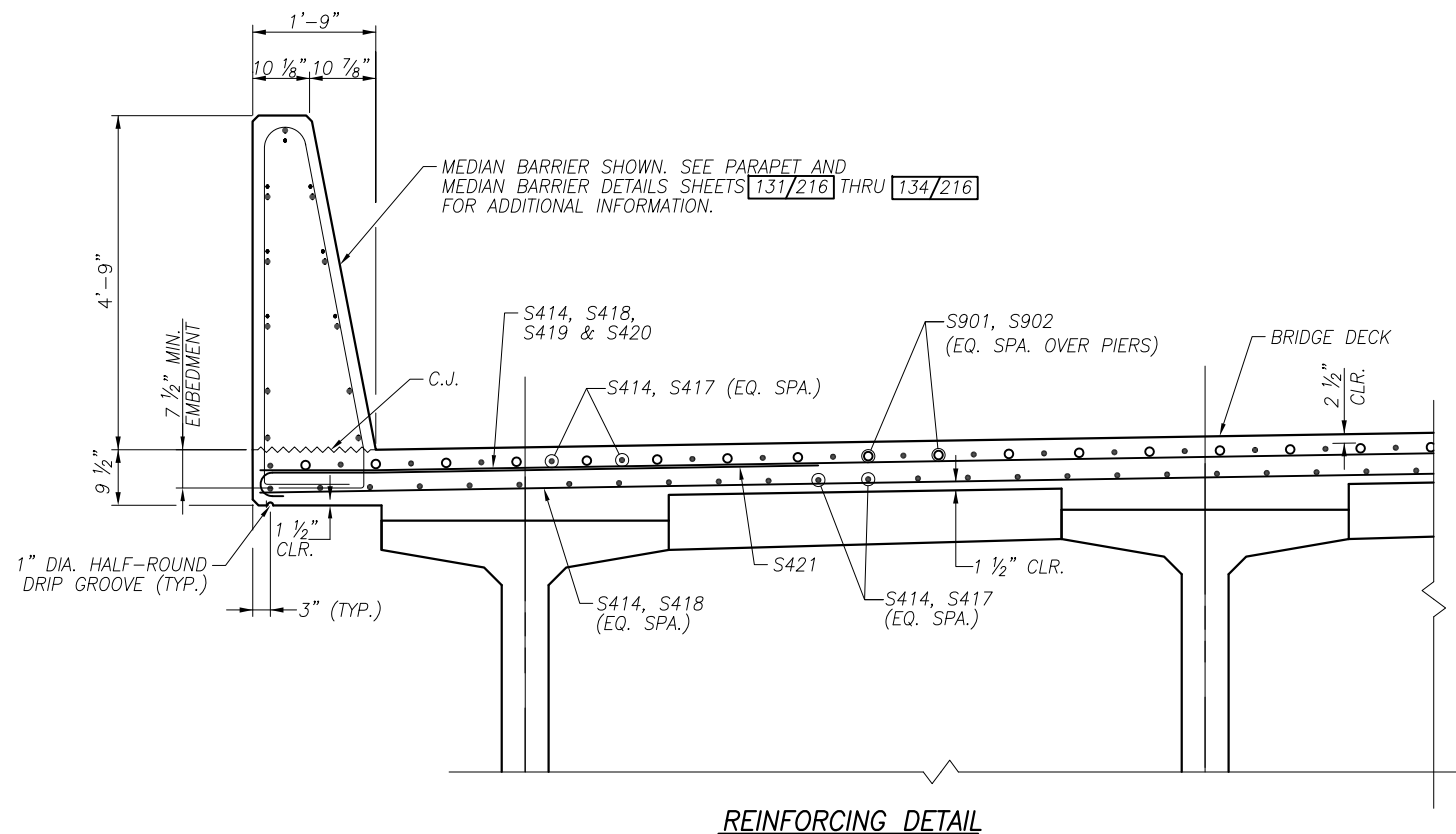

**REINFORCING DETAIL**

DESIGNED		DRAWN		REVIEWED		DATE		DESIGN AGENCY	
WOZ	CBS	WOZ	REM	WOZ	WOZ	5/2020		JANSSEN & SPAANS ENGINEERING, INC.	
CHECKED		REVIS		STRUCTURE FILE NUMBER		9120 HARRISON PARK COURT			
CBS				4802765/4802767		INDIANAPOLIS, IN 46216			

3 5/1/2020 JANSSEN & SPAANS ENGINEERING INC. - RECONFIGURED NORTHBOUND ON RAMP SHEET REPLACED  
 TRANSVERSE SECTION - 5 OF 6  
 BRIDGE NO. LUC-75-0029 L/R  
 I.R. 75 OVER MAUMEE RIVER


W00/LUC-75-30.70/0.00  
 PID No. 93592

139/216

1432  
 1792



Date: Oct 08, 2020, 7:17am User Name: mlongtin  
 File: P:\11321 - Toledo E Value Engineering\DWGS\BRIDGE\LUC-75-0027 over Maumee River\Sheets\075\_0027C\_T5006.dwg

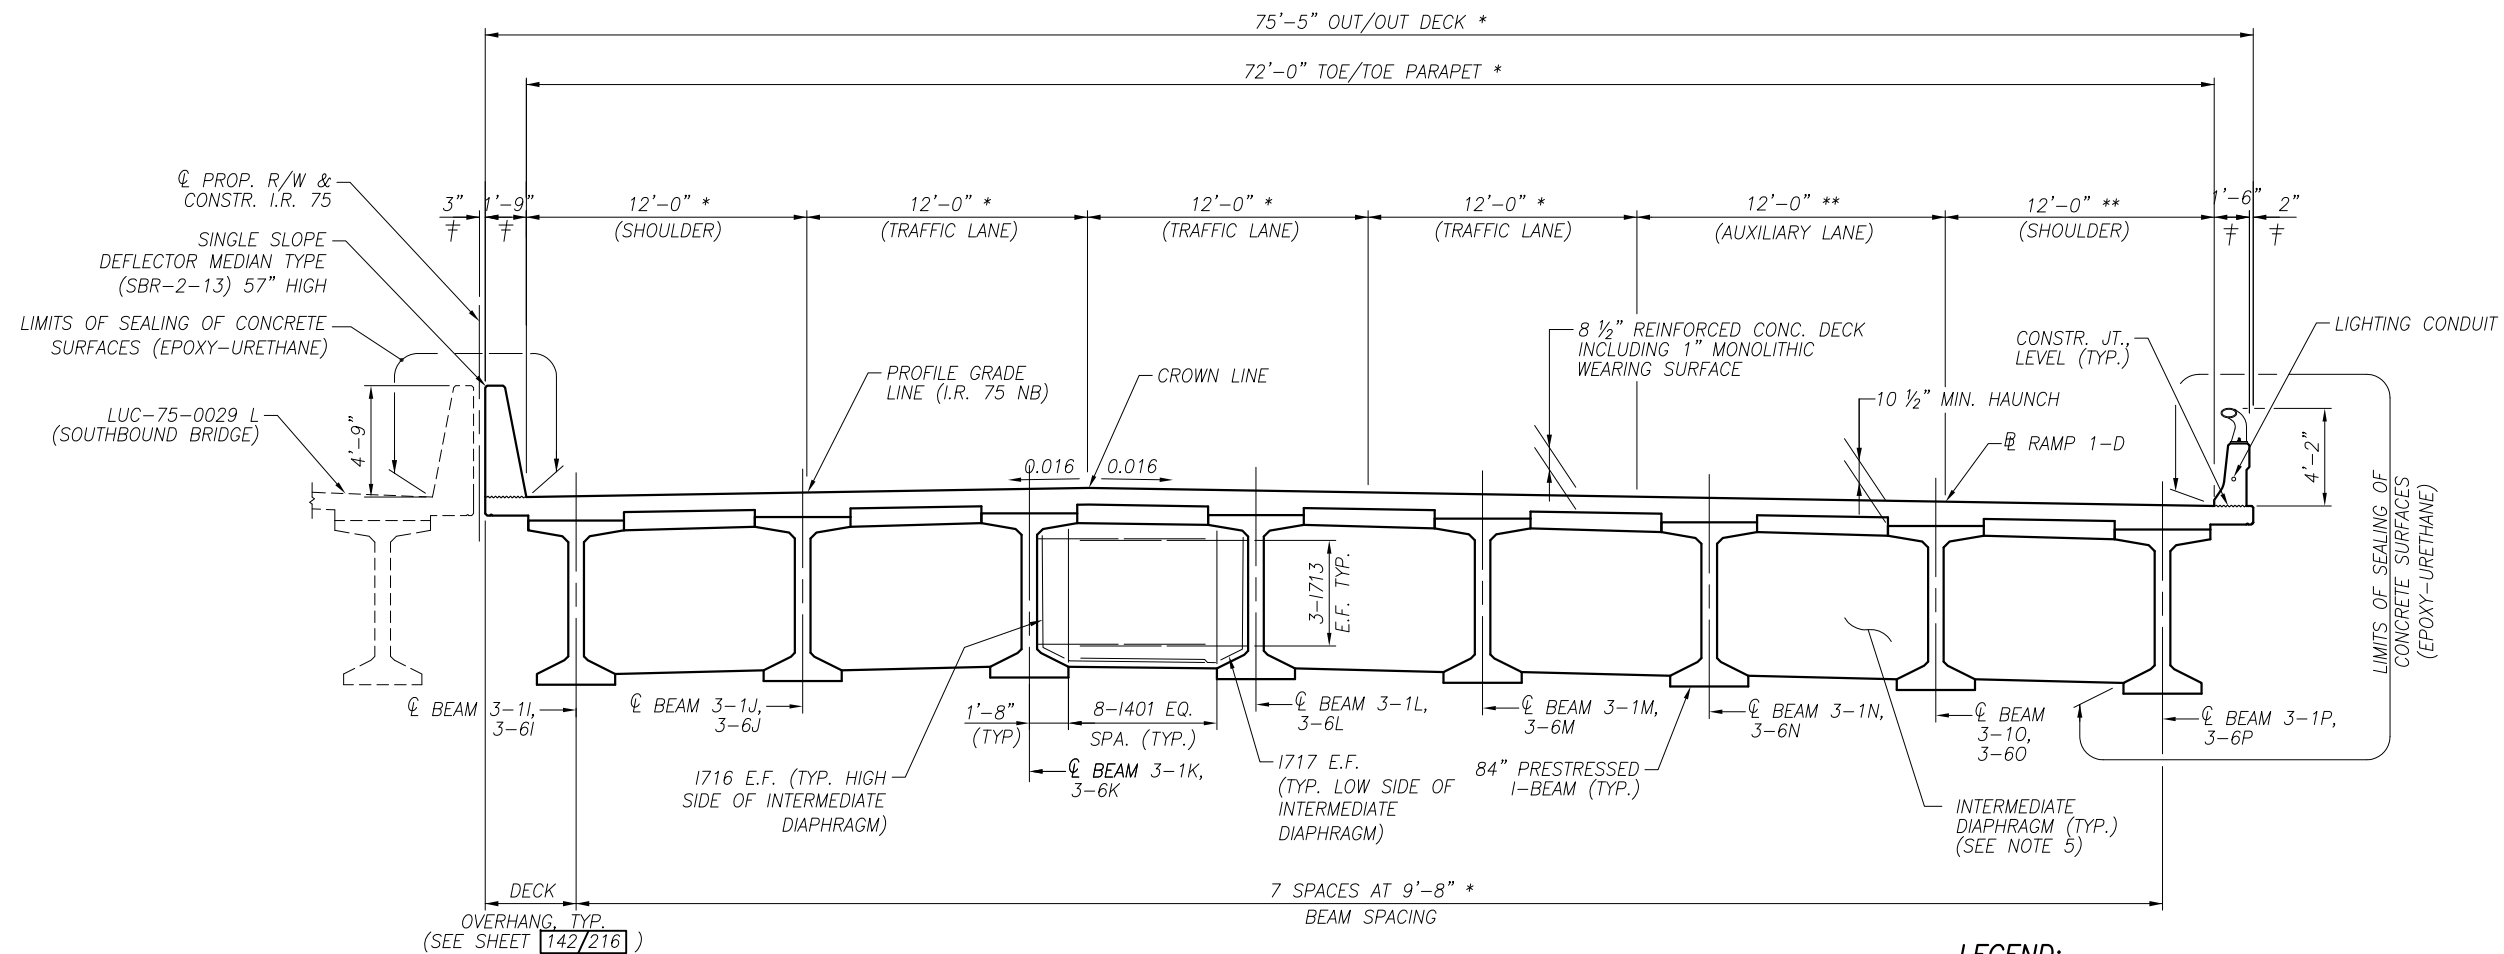


**TRANSVERSE SECTION**  
 LUC-75-0029 R  
 UNIT 3 NORTHBOUND BRIDGE  
 (SLAB REINFORCING NOT SHOWN FOR CLARITY)

**LEGEND:**

- \* - MEASURED PERPENDICULAR TO CL PROP. R/W & CONSTR. I.R. 75
- \*\*\* - MEASURED ALONG CL OF BEARING
- ‡ - BARRIER DIMENSIONS PROVIDED PERPENDICULAR TO EDGE OF DECK

**NOTES:**

1. DECK SLAB CONCRETE QUANTITY: THE ESTIMATED QUANTITY OF DECK SLAB CONCRETE IS BASED ON THE CONSTANT DECK SLAB THICKNESS, AS SHOWN, PLUS THE QUANTITY OF CONCRETE THAT FORMS EACH BEAM HAUNCH. THE ESTIMATE ASSUMES A CONSTANT HAUNCH THICKNESS OF 4 INCHES. DEVIATE FROM THIS HAUNCH THICKNESS AS NECESSARY TO PLACE THE DECK SURFACE AT THE FINISHED GRADE. THE HAUNCH THICKNESS WAS MEASURED AT THE CENTERLINE OF THE GIRDER, FROM THE SURFACE OF THE DECK TO THE TOP OF THE TOP FLANGE MINUS THE DECK SLAB THICKNESS.
2. FOR GENERAL NOTES, SEE SHEETS 13/216 AND 14/216.
3. FOR SLAB PLANS, SEE SHEETS 106/216 THRU 111/216.
4. FOR REINFORCING STEEL LIST, SEE SHEETS 208/216 THRU 212/216 AND 215/216.
5. CONCRETE INTERMEDIATE DIAPHRAGMS SHALL BE CONSTRUCTED ACCORDING TO STANDARD DWG. PSID-1-13 FOR 60", 66" & 72" BEAMS, WITH THE EXCEPTION THAT NO. 7 REINFORCEMENT SHALL BE USED IN PLACE OF THE NO. 6 REINFORCEMENT SHOWN IN THE STANDARD DWG. THREADED INSERTS SHALL ACCOMMODATE NO. 7 REINFORCEMENT. CONTRACTOR MAY USE STEEL PER ODOT BDM 302.5.2.6. IF STEEL IS CHOSEN, TOP CHORD L 6x4x3/16" SHALL BE PROVIDED FOR DIAPHRAGMS IN THE EXTERIOR BAYS. USE 1" DIA. BOLTS FOR TOP AND BOTTOM CHORDS IN EXTERIOR BAY. REMAINING CONNECTIONS SHALL COMPLY WITH STANDARD DWG.
6. FOR FINAL DECK ELEVATIONS, SCREED, AND TOP OF HAUNCH, SEE SHEETS 143/216 THRU 192/216.
7. INTERMEDIATE DIAPHRAGM MINIMUM REBAR LAP LENGTHS ARE AS FOLLOWS:  
 NO. 7 = 4'-2"

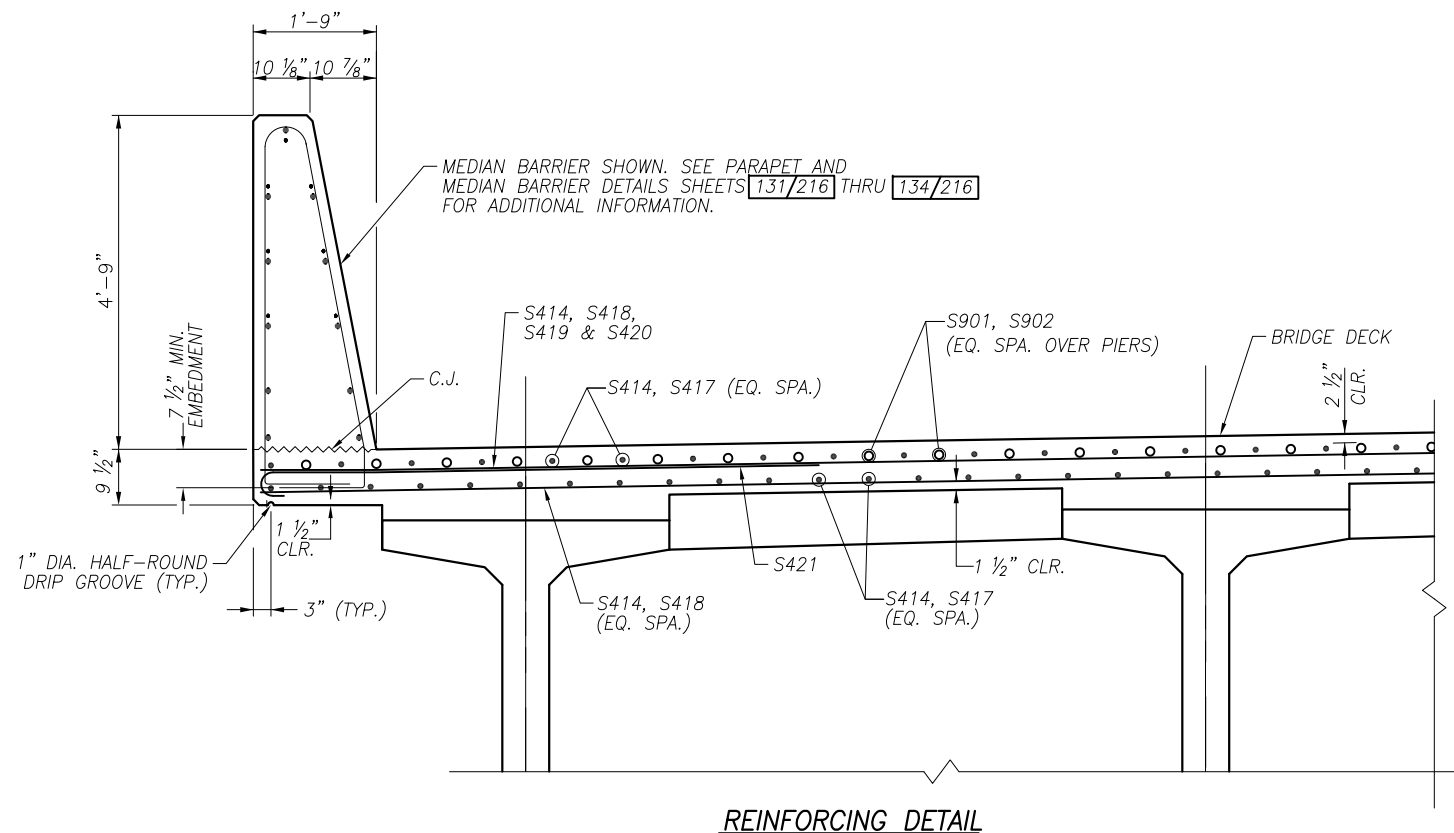

**REINFORCING DETAIL**

3 5/1/2020 JANSSEN & SPAANS ENGINEERING INC. - RECONFIGURED NORTHBOUND ON RAMP SHEET REPLACED

DESIGN AGENCY  
**JANSSEN & SPAANS ENGINEERING, INC.**  
 9120 HARRISON PARK COURT  
 INDIANAPOLIS, IN 46216

DESIGNED	WJZ	CBS
DRAWN	REM	REVIS
REVIEWED	WJZ	4802765/4802767
DATE	5/2020	STRUCTURE FILE NUMBER

TRANSVERSE SECTION - 6 OF 6  
 BRIDGE NO. LUC-75-0029 L/R  
 I.R. 75 OVER MAUMEE RIVER

W00/LUC-75-30.70/0.00  
 PID No. 93592

140/216

1433  
 1792

Date: Oct 07, 2020, 4:30pm User Name: mlongtin  
 File: P:\11221 - Toledo E Value Engineering\DWG\5\BRIDGE\LUC-75-0027 over Maumee River\Sheets\075\_0027C\_S0078.dwg

DECK OVERHANG LENGTH (NORTHBOUND BRIDGE - UNIT 1 (FT))

CENTERLINE OF GIRDER	TO	EDGE OF DECK	REAR ABUTMENT	1/8 POINT	1/4 POINT	3/8 POINT	1/2 POINT	5/8 POINT	3/4 POINT	7/8 POINT	PIER 1	1/8 POINT	1/4 POINT	3/8 POINT	1/2 POINT	5/8 POINT	3/4 POINT	7/8 POINT	PIER 2
BEAM M	TO	LEFT EDGE	3.88	3.88	3.88	3.88	3.88	3.88	3.88	3.88	3.88	3.88	3.88	3.88	3.88	3.88	3.88	3.88	3.88
BEAM U	TO	RIGHT EDGE	3.85	4.07	4.30	4.53	4.76	4.98	5.21	5.44	5.66	5.03	4.39	3.88	3.88	3.88	3.88	3.88	3.88

DECK OVERHANG LENGTH (NORTHBOUND BRIDGE - UNIT 2 (FT))

CENTERLINE OF GIRDER	TO	EDGE OF DECK	PIER 2	1/8 POINT	1/4 POINT	3/8 POINT	1/2 POINT	5/8 POINT	3/4 POINT	7/8 POINT	PIER 3	1/8 POINT	1/4 POINT	3/8 POINT	1/2 POINT	5/8 POINT	3/4 POINT	7/8 POINT	PIER 4
BEAM LINE K	TO	LEFT EDGE	3.88	3.88	3.88	3.88	3.88	3.88	3.88	3.88	3.88	3.88	3.88	3.88	3.88	3.88	3.88	3.88	3.88
BEAM LINE S	TO	RIGHT EDGE	3.88	3.88	3.88	3.88	3.88	3.88	3.88	3.88	3.88	3.88	3.88	3.88	3.88	3.88	3.88	3.88	3.88

DECK OVERHANG LENGTH (NORTHBOUND BRIDGE - UNIT 2 (FT))

CENTERLINE OF GIRDER	TO	EDGE OF DECK	PIER 4	1/8 POINT	1/4 POINT	3/8 POINT	1/2 POINT	5/8 POINT	3/4 POINT	7/8 POINT	PIER 5	1/8 POINT	1/4 POINT	3/8 POINT	1/2 POINT	5/8 POINT	3/4 POINT	7/8 POINT	PIER 6
BEAM LINE K	TO	LEFT EDGE	3.88	3.88	3.88	3.88	3.88	3.88	3.88	3.88	3.88	3.88	3.88	3.88	3.88	3.88	3.88	3.88	3.88
BEAM LINE S	TO	RIGHT EDGE	3.88	3.88	3.88	3.88	3.88	3.88	3.88	3.88	3.88	3.88	3.88	3.88	3.88	3.88	3.88	3.88	3.88

DECK OVERHANG LENGTH (NORTHBOUND BRIDGE - UNIT 3 (FT))

CENTERLINE OF GIRDER	TO	EDGE OF DECK	PIER 6	1/8 POINT	1/4 POINT	3/8 POINT	1/2 POINT	5/8 POINT	3/4 POINT	7/8 POINT	PIER 7	1/8 POINT	1/4 POINT	3/8 POINT	1/2 POINT	5/8 POINT	3/4 POINT	7/8 POINT	PIER 8
BEAM LINE I	TO	LEFT EDGE	3.88	3.88	3.88	3.88	3.88	3.88	3.88	3.88	3.88	3.88	3.88	3.88	3.88	3.88	3.88	3.88	3.88
BEAM LINE P	TO	RIGHT EDGE	3.88	3.88	3.88	3.88	3.88	3.88	3.88	3.88	3.88	3.88	3.88	3.88	3.88	3.88	3.88	3.88	3.88

DECK OVERHANG LENGTH (NORTHBOUND BRIDGE - UNIT 3 (FT))

CENTERLINE OF GIRDER	TO	EDGE OF DECK	PIER 8	1/8 POINT	1/4 POINT	3/8 POINT	1/2 POINT	5/8 POINT	3/4 POINT	7/8 POINT	PIER 9	1/8 POINT	1/4 POINT	3/8 POINT	1/2 POINT	5/8 POINT	3/4 POINT	7/8 POINT	PIER 10
BEAM LINE I	TO	LEFT EDGE	3.88	3.88	3.88	3.88	3.88	3.88	3.88	3.88	3.88	3.88	3.88	3.88	3.88	3.88	3.88	3.88	3.88
BEAM LINE P	TO	RIGHT EDGE	3.88	3.88	3.88	3.88	3.88	3.88	3.88	3.88	3.88	3.88	3.88	3.88	3.88	3.88	3.88	3.88	3.88

DECK OVERHANG LENGTH (NORTHBOUND BRIDGE - UNIT 3 (FT))

CENTERLINE OF GIRDER	TO	EDGE OF DECK	PIER 10	1/8 POINT	1/4 POINT	3/8 POINT	1/2 POINT	5/8 POINT	3/4 POINT	7/8 POINT	PIER 11	1/8 POINT	1/4 POINT	3/8 POINT	1/2 POINT	5/8 POINT	3/4 POINT	7/8 POINT	FWD. ABUT.
BEAM LINE I	TO	LEFT EDGE	3.88	3.88	3.88	3.88	3.88	3.88	3.88	3.88	3.88	3.88	3.88	3.88	3.88	3.88	3.88	3.88	3.88
BEAM LINE P	TO	RIGHT EDGE	3.88	3.88	3.88	3.88	3.88	3.88	3.88	3.88	3.88	3.88	3.88	3.88	3.88	3.88	3.88	3.88	3.88

NOTES:

- FOR ADDITIONAL DECK OVERHANG TABLES, SEE SHEET 141/216.

5/1/2020 JANSSEN & SPAANS ENGINEERING INC. - RECONFIGURED NORTHBOUND ON RAMP SHEET REPLACED


DESIGN AGENCY  
 JANSSEN & SPAANS ENGINEERING, INC.  
 9120 HARRISON PARK COURT  
 INDIANAPOLIS, IN 46216

DATE 5/2020  
 REVIEWED WJZ  
 STRUCTURE FILE NUMBER 4802765/4802767  
 DRAWN REM  
 CHECKED CBS

DECK OVERHANGS  
 BRIDGE NO. LUC-75-0029 L/R  
 I.R. 75 OVER MAUMEE RIVER

W00/LUC-75-30.70/0.00  
 PID No. 93592

Date: Oct 07, 2020, 4:31pm User Name: mlongtin  
 File: P:\11321 - Toledo E Value Engineering\DWGS\BRIDGE\LUC-75-0027 over Maumee River\Sheets\027C\_0027C\_S0070.dwg

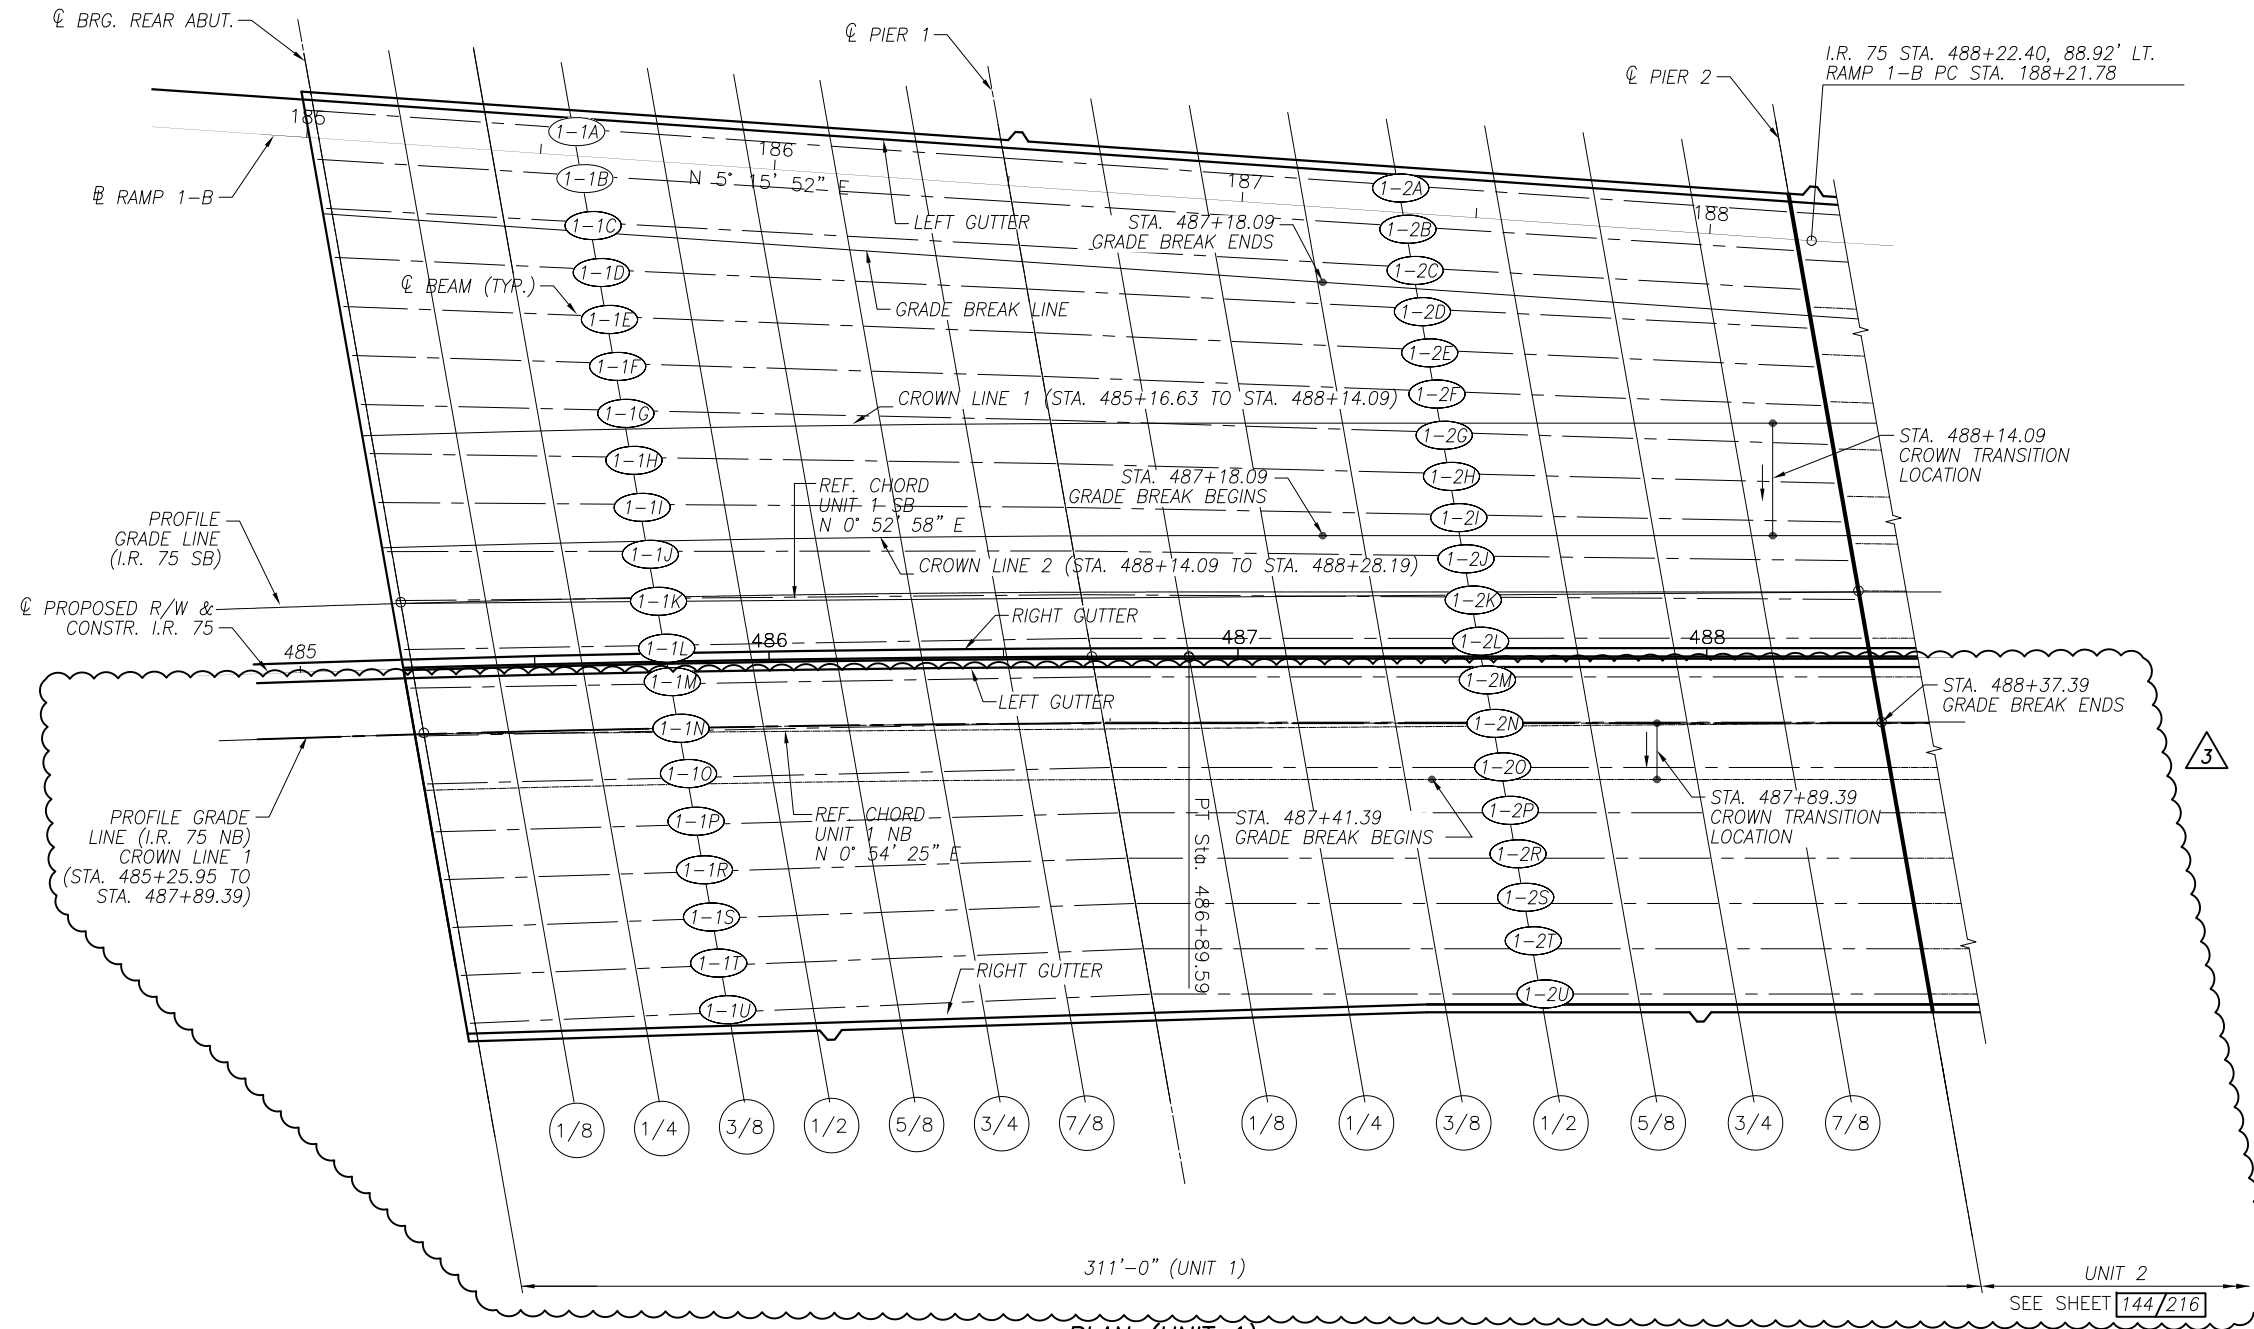


**PLAN (UNIT 1)**

NORTHBOUND AND SOUTHBOUND BRIDGES

**NOTES:**

- DIMENSIONS ARE PROVIDED ALONG  $\phi$  PROPOSED R/W &  $\phi$  CONSTRUCTION I.R. 75.
- SEE SLAB PLAN SHEETS 85/216 THRU 111/216 FOR ADDITIONAL INFORMATION.
- FOR FINAL DECK ELEVATIONS, SCREED, AND TOP OF HAUNCH, SEE SHEETS 143/216 THRU 192/216.
- FOR TRANSVERSE SECTIONS, SEE SHEETS 135/216 THRU 140/216.

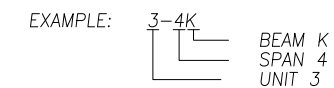

5/1/2020 JANSSEN & SPANS ENGINEERING INC. -  
 RECONFIGURED NORTHBOUND ON RAMP

DESIGNED	DEB	CHECKED	MRW
DRAWN	VFG	REVISD	
REVIEWED	JTH	STRUCTURE FILE NUMBER	4802765/4802767
DATE	8/18	DESIGN AGENCY	AECOM


BRIDGE NO. LUC-75-0029 L/R  
 I.R. 75 OVER MAUMEE RIVER

WOO/LUC-75-30.70/0.00  
 PID No. 93592

143/216

1436  
1792

Date: Oct 07, 2020, 4:31pm User Name: mlmgain  
 File: P:\1321 - Toledo E Value Engineering\DWGS\BRIDGE\LUC-75-0027 over Maumee River\Sheets\075\_0027C\_S0070.dwg

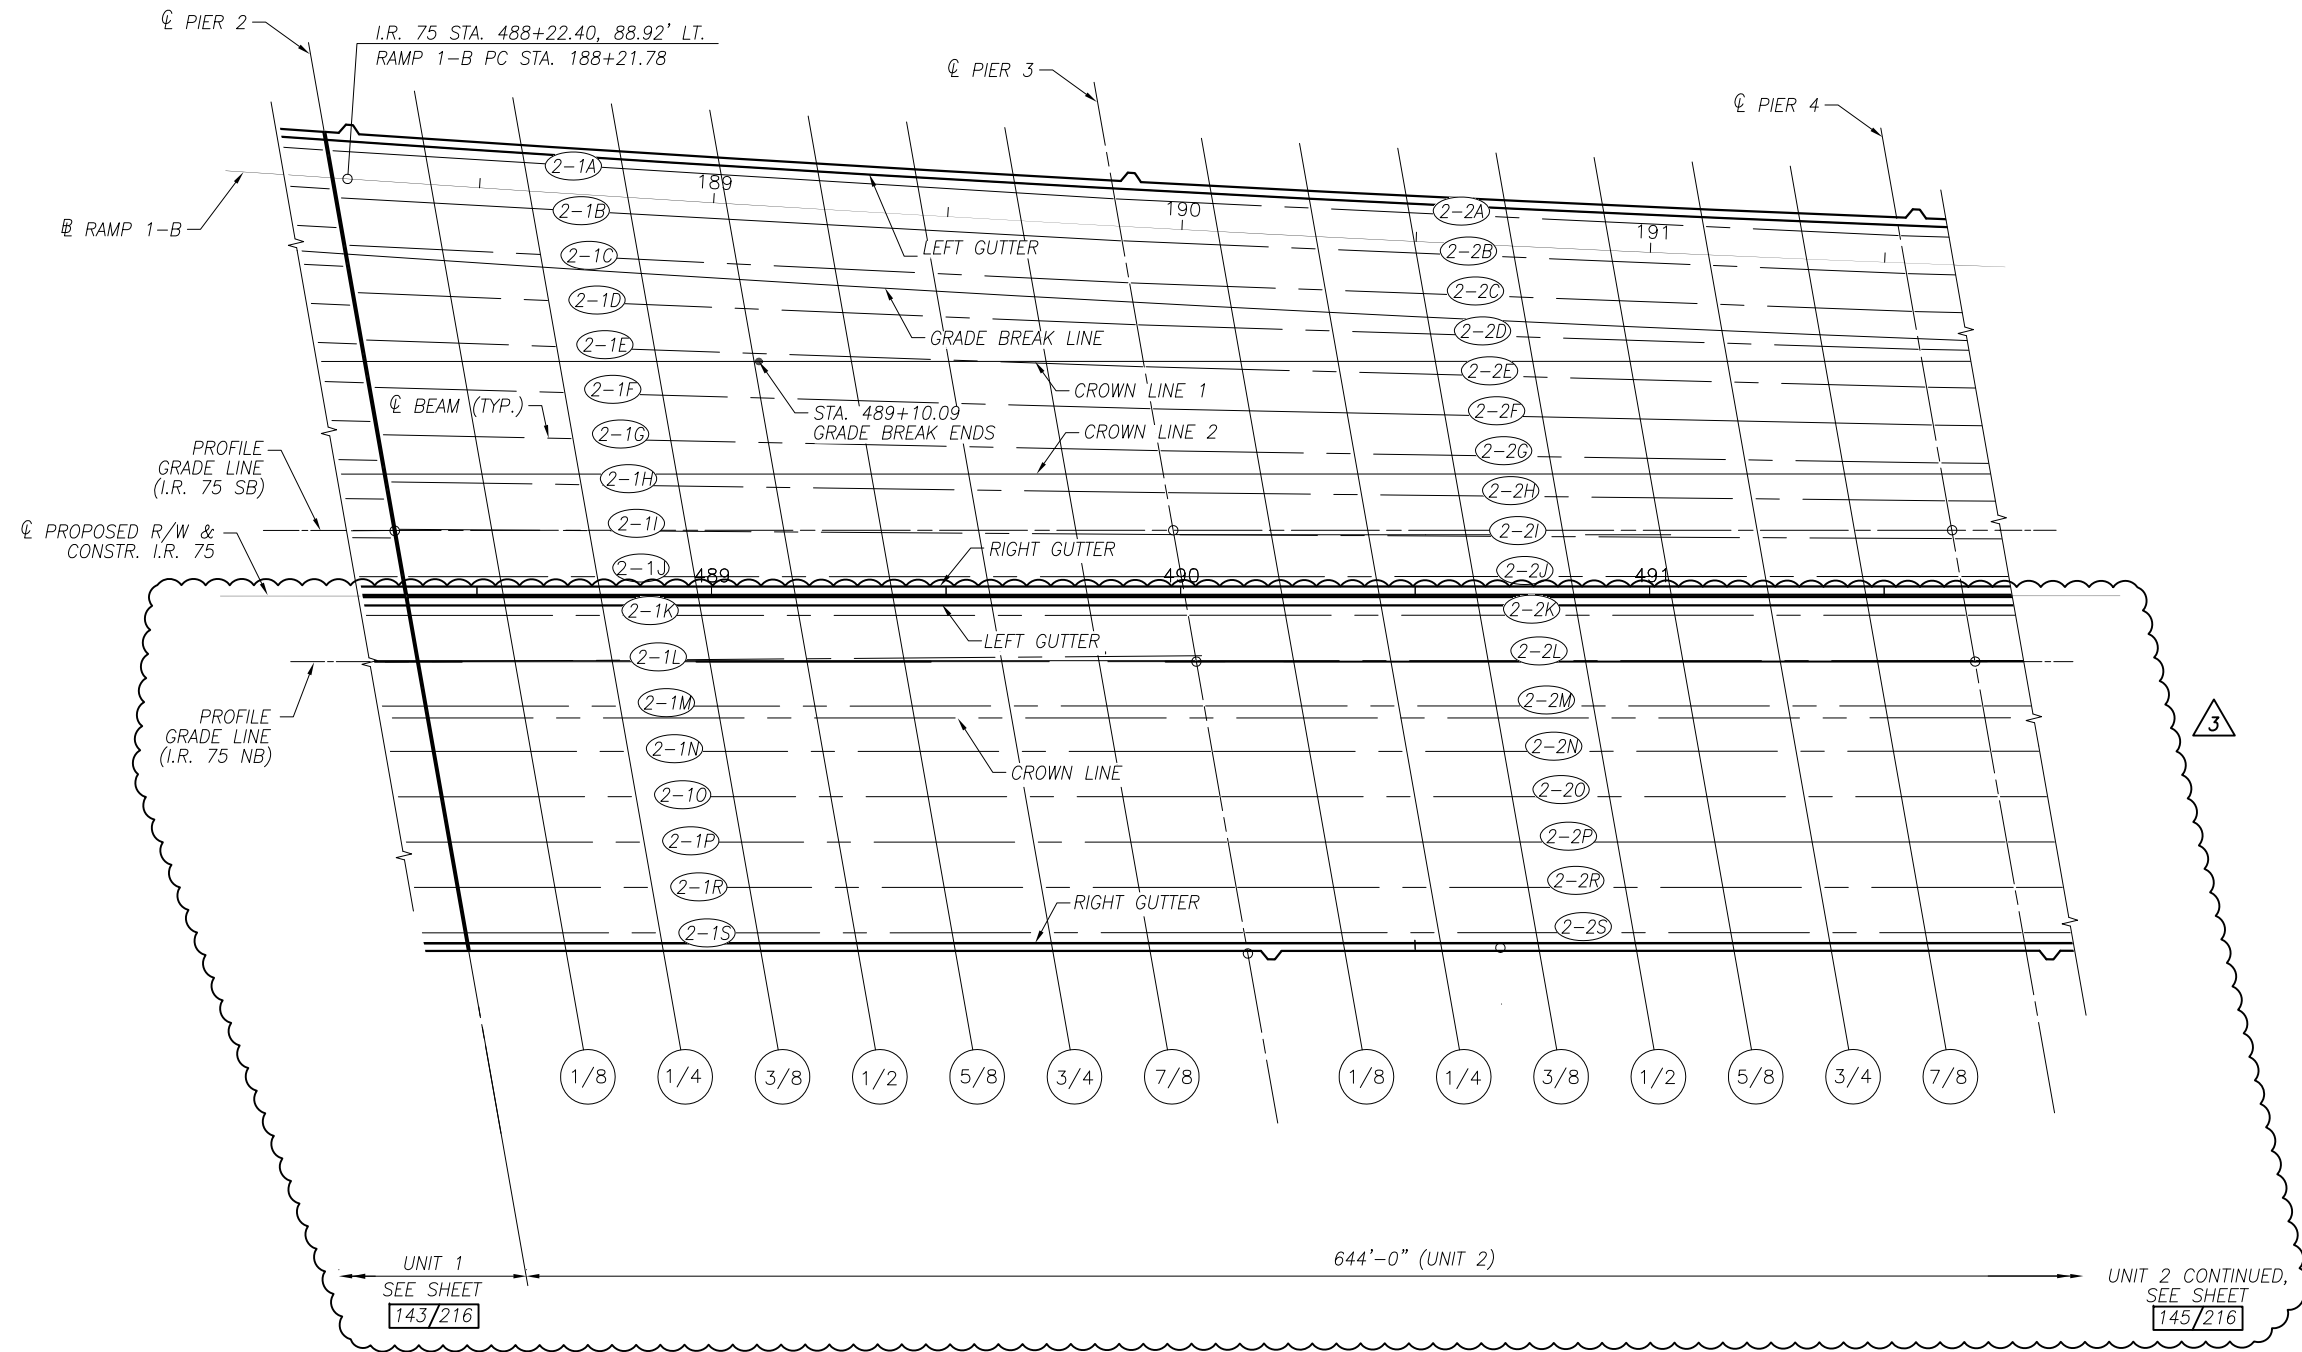


**PLAN (UNIT 2)**  
 NORTHBOUND AND SOUTHBOUND BRIDGES

**NOTES:**  
 1. SEE SHEET 143/216 FOR NOTES.

<p>5/1/2020 JANSSEN &amp; SPAANS ENGINEERING INC. -          RECONFIGURED NORTHBOUND ON RAMP</p>		<p>DESIGN AGENCY          554 WHITE POND DRIVE          AKRON, OHIO 44320-1100  <b>AECOM</b>          (330) 836-9111</p>
<p>DESIGNED          DEB</p>	<p>DRAWN          VFC</p>	<p>DATE          8/18</p>
<p>CHECKED          MRW</p>	<p>REVIEWED          JTH</p>	<p>STRUCTURE FILE NUMBER          4802765/4802767</p>
<p>DECK SURFACE, SCREED AND TOP OF HAUNCH ELEVATIONS PLAN</p>		
<p>BRIDGE NO. LUC-75-0029 L/R          I.R. 75 OVER MAUMEE RIVER</p>		
<p>W00/LUC-75-          30.70/0.00          PID No. 93592</p>		<p>144/216</p>
<p>143/1792</p>		<p>3</p>

Date: Oct 07, 2020, 4:31pm User Name: mlongtin  
 File: P:\11321 - Toledo E Value Engineering\DWGS\BRIDGE\LUC-75-0027 over Maumee River\Sheets\075\_0027C\_S0070.dwg

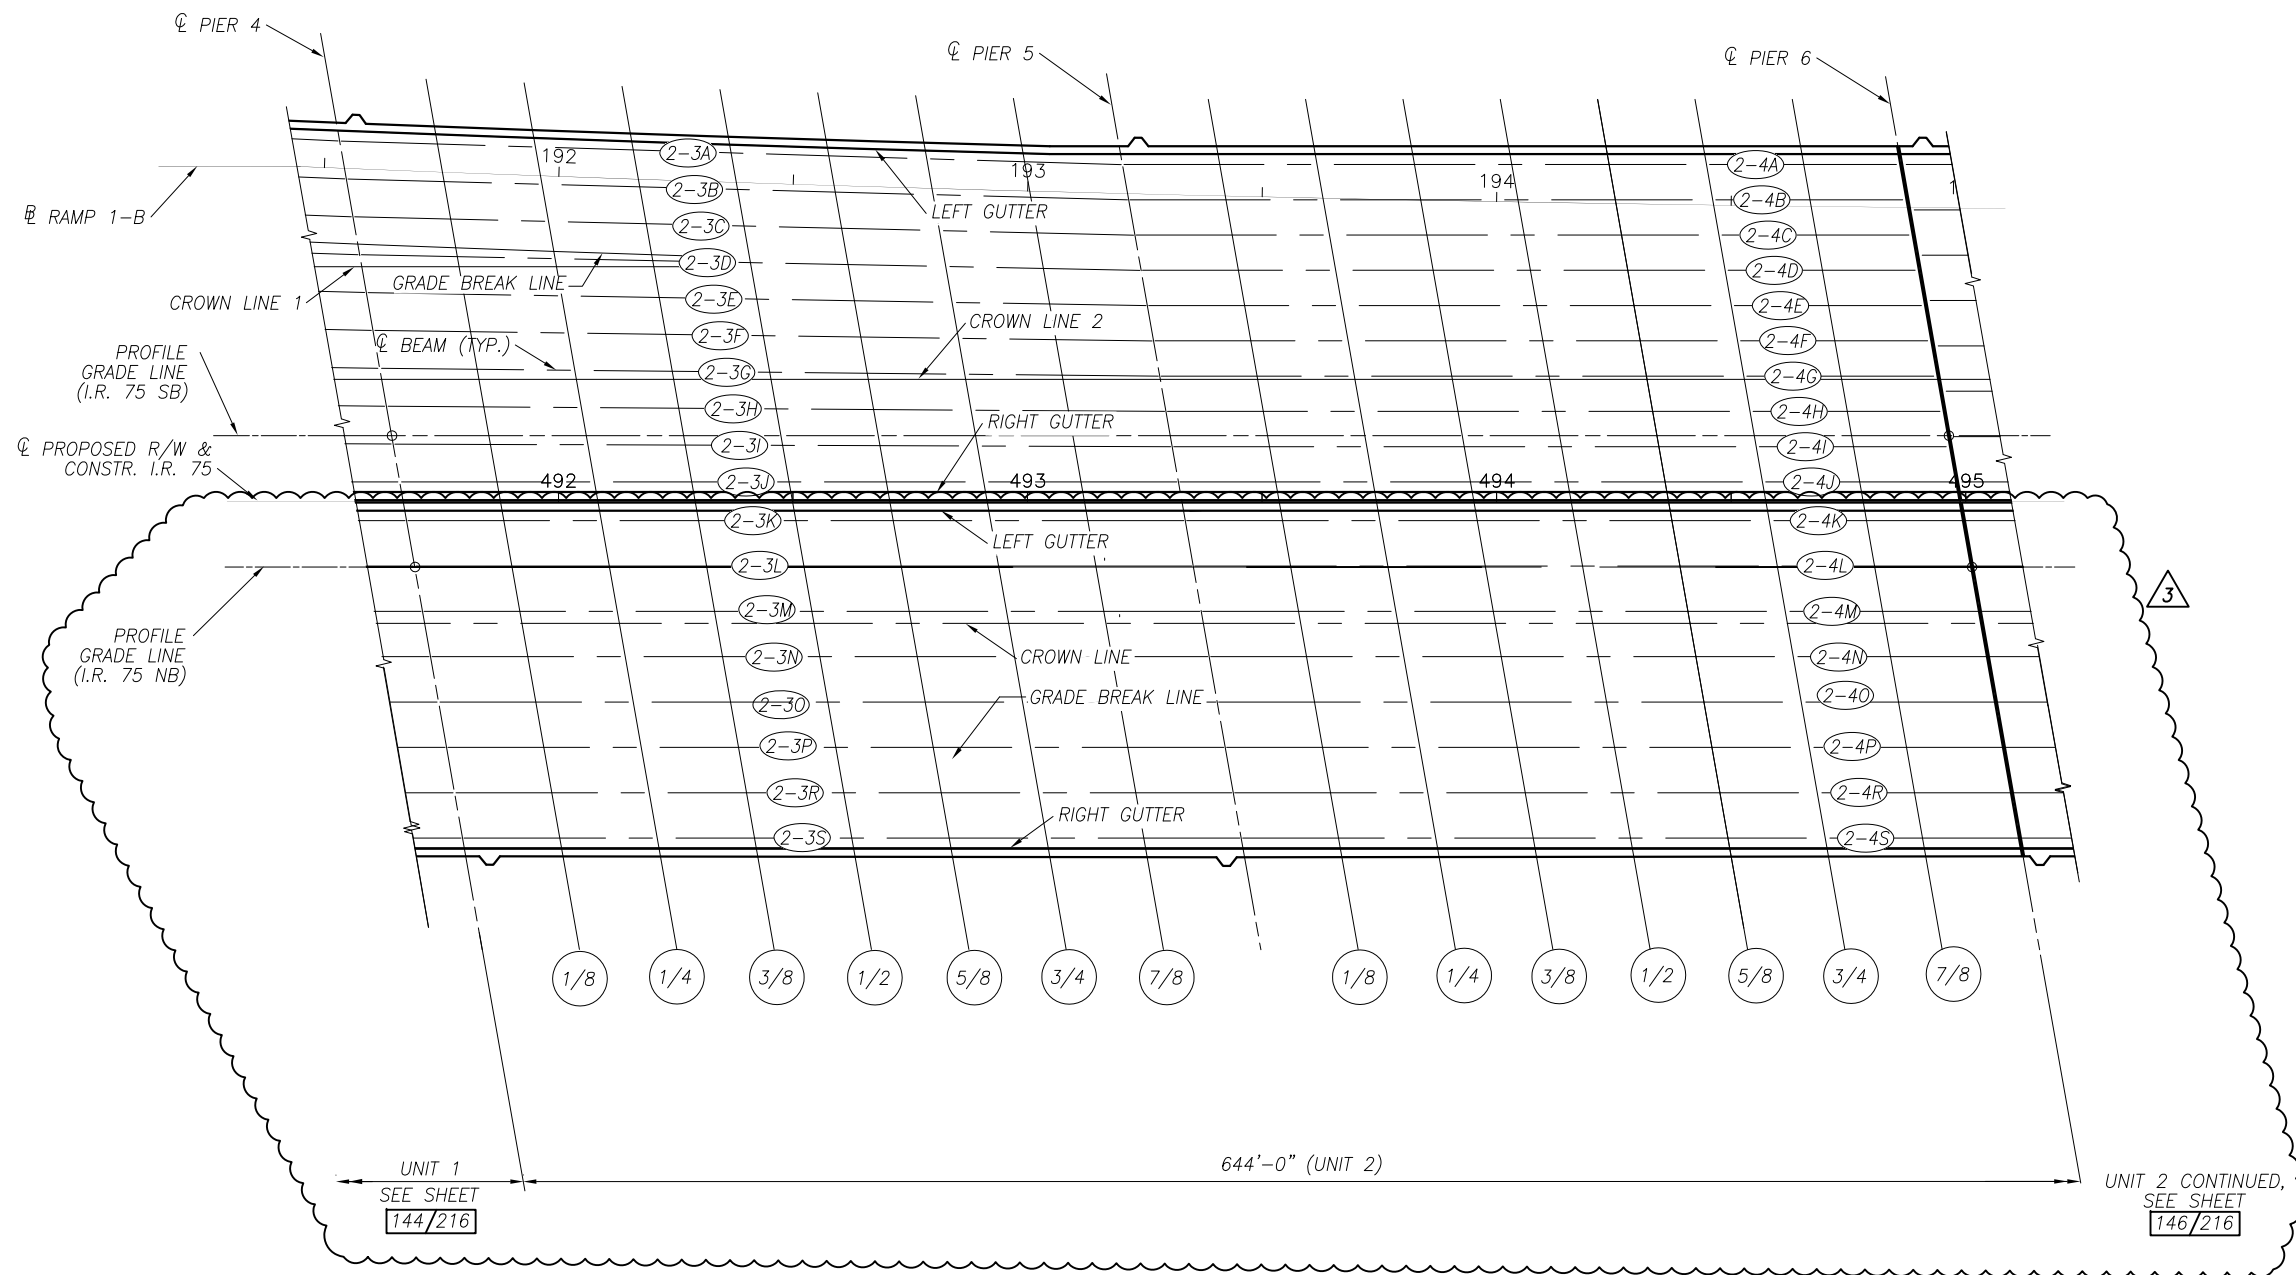


**PLAN (UNIT 2)**  
 NORTHBOUND AND SOUTHBOUND BRIDGES

**NOTES:**  
 1. SEE SHEET 143/216 FOR NOTES.

5/1/2020 JANSSEN & SPAANS ENGINEERING INC. - RECONFIGURED NORTHBOUND ON RAMP		DESIGN AGENCY 554 WHITE POND DRIVE AKRON, OHIO 44320-1100 <b>AECOM</b> (330) 836-9111
DESIGNED DEB	DRAWN VFC	DATE 8/18
CHECKED MRW	REVIEWED JTH	STRUCTURE FILE NUMBER 4802765/4802767
DECK SURFACE, SCREED AND TOP OF HAUNCH ELEVATIONS PLAN		
BRIDGE NO. LUC-75-0029 L/R I.R. 75 OVER MAUMEE RIVER		
W00/LUC-75- 30.70/0.00 PID No. 93592		145/216
1438 1792		146/216

Date: Oct 07, 2020, 4:30pm User Name: mlngtin  
 File: P:\11321 - Toledo E Value Engineering\DWGS\BRIDGE\LUC-75-0027 over Maumee River\Sheets\075\_0027C\_S0070.dwg

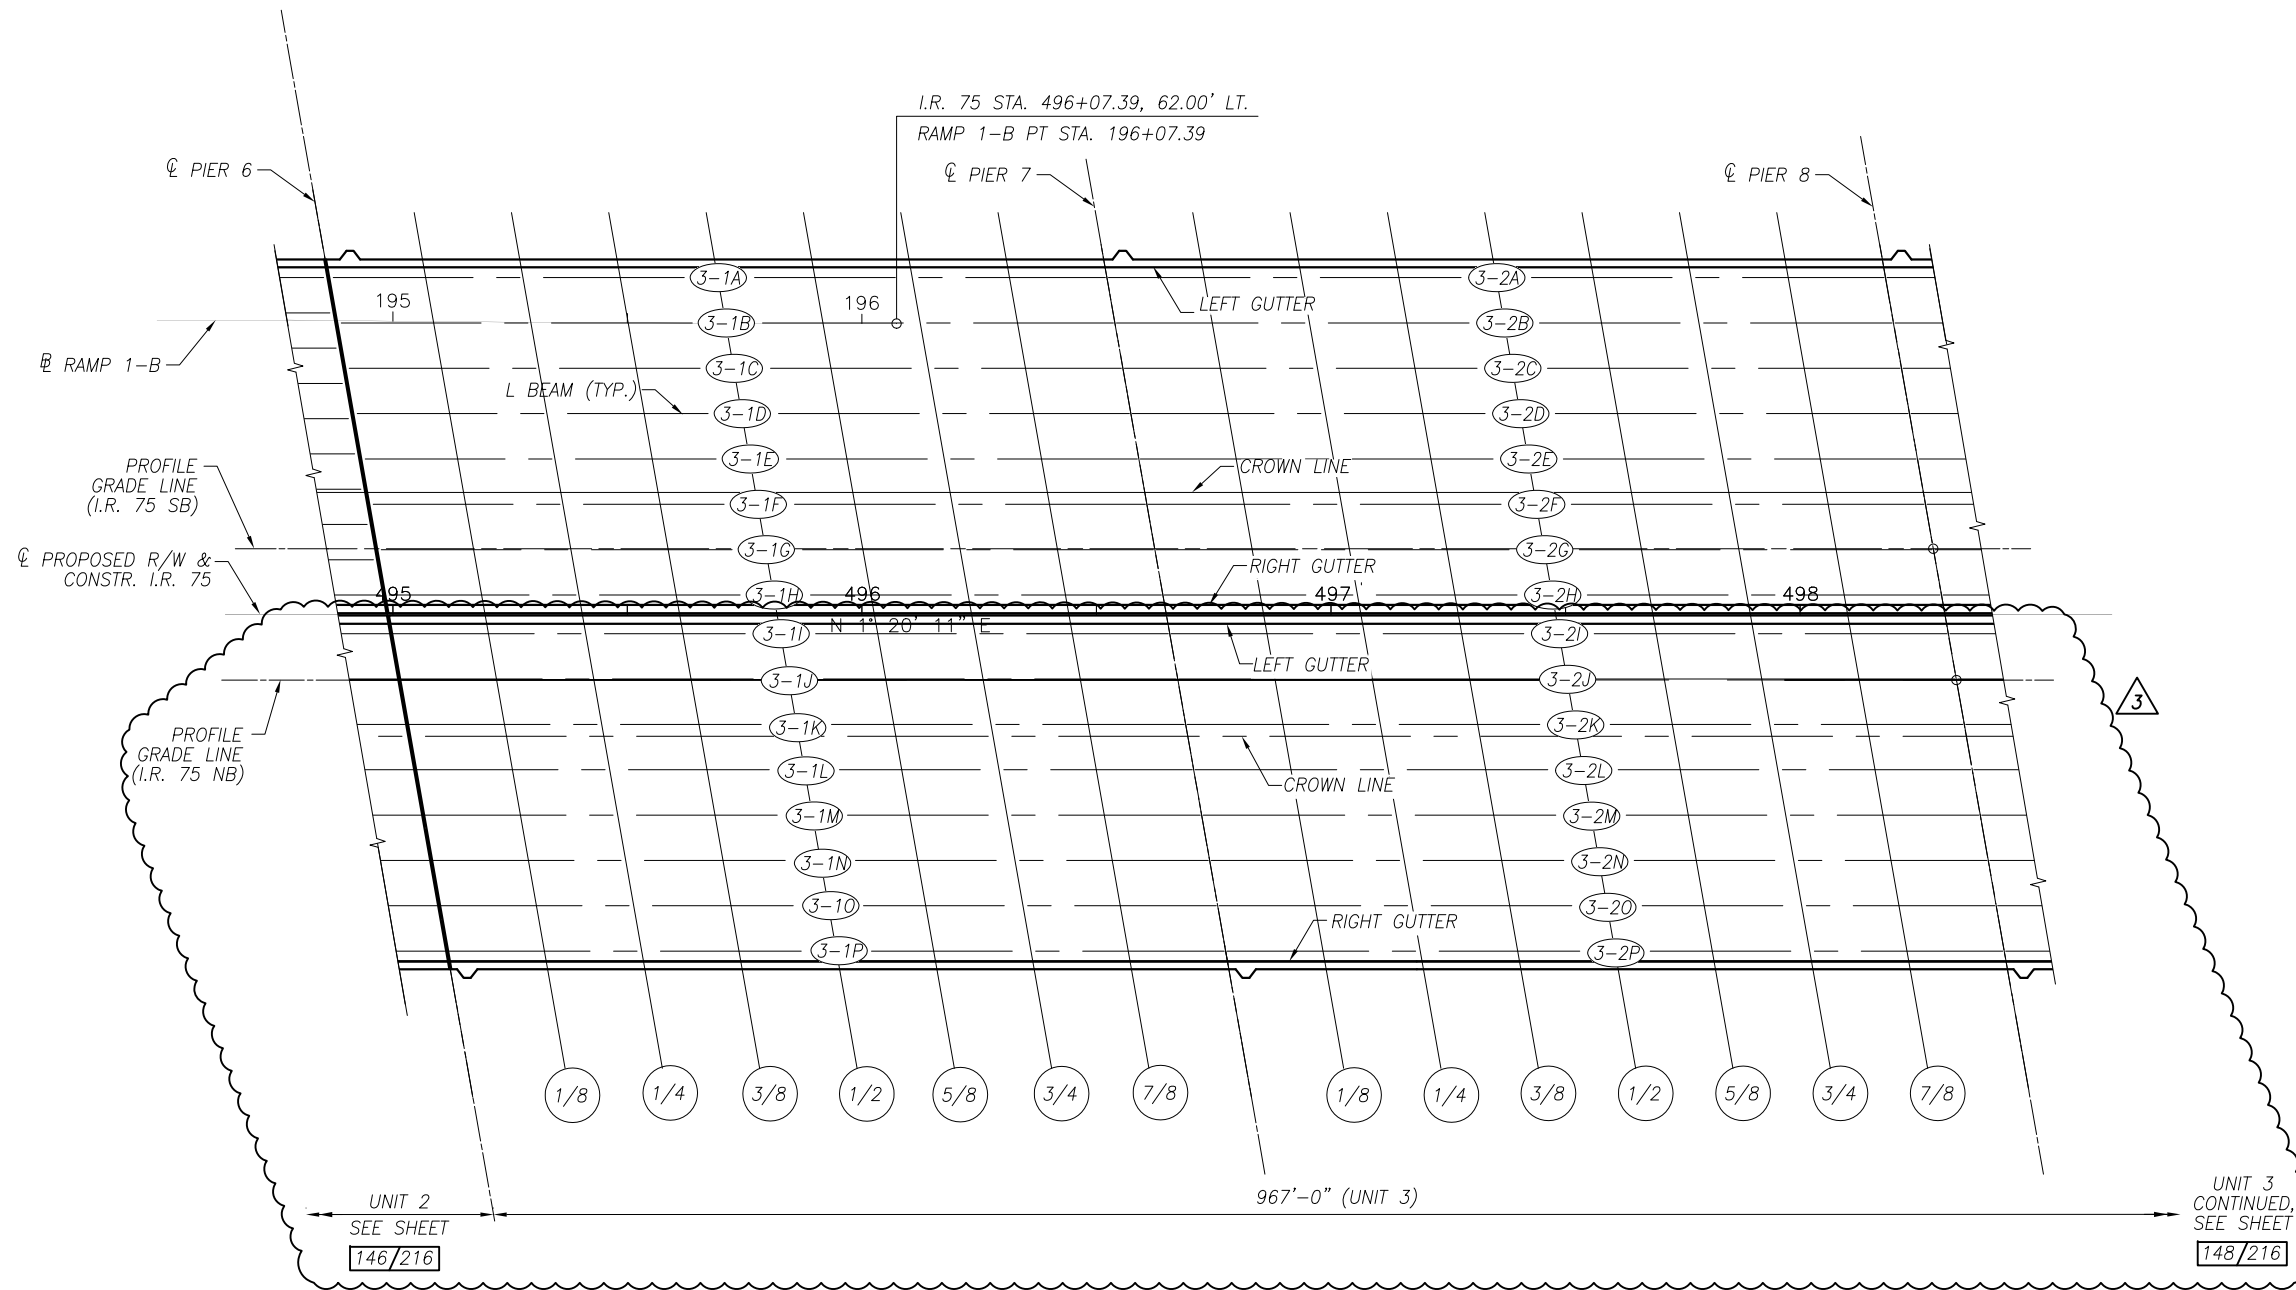


**PLAN (UNIT 3)**  
 NORTHBOUND AND SOUTHBOUND BRIDGES

**NOTE:**  
 1. SEE SHEET 143/216 FOR LEGEND AND NOTES.

5/1/2020 JANSSEN & SPANNS ENGINEERING INC. - RECONFIGURED NORTHBOUND ON RAMP		DESIGN AGENCY <b>AECOM</b> 654 WHITE POND DRIVE AKRON, OHIO 44320-1100 (330) 636-9111
DATE 8/18	REVIEWED JTH	STRUCTURE FILE NUMBER 4802765/4802767
DESIGNED DEB	CHECKED MRW	DRAWN VFC
DECK SURFACE, SCREED AND TOP OF HAUNCH ELEVATIONS PLAN		
BRIDGE NO. LUC-75-0029 L/R I.R. 75 OVER MAUMEE RIVER		
W00/LUC-75- 30.70/0.00 PID No. 93592		146/216
1439 1792		148/216

Date: Oct 07, 2020, 4:30pm User Name: mlangin  
 File: P:\11321 - Toledo E Value Engineering\DWGS\BRIDGE\LUC-75-0027 over Maumee River\Sheets\075\_0027C\_S0070.dwg

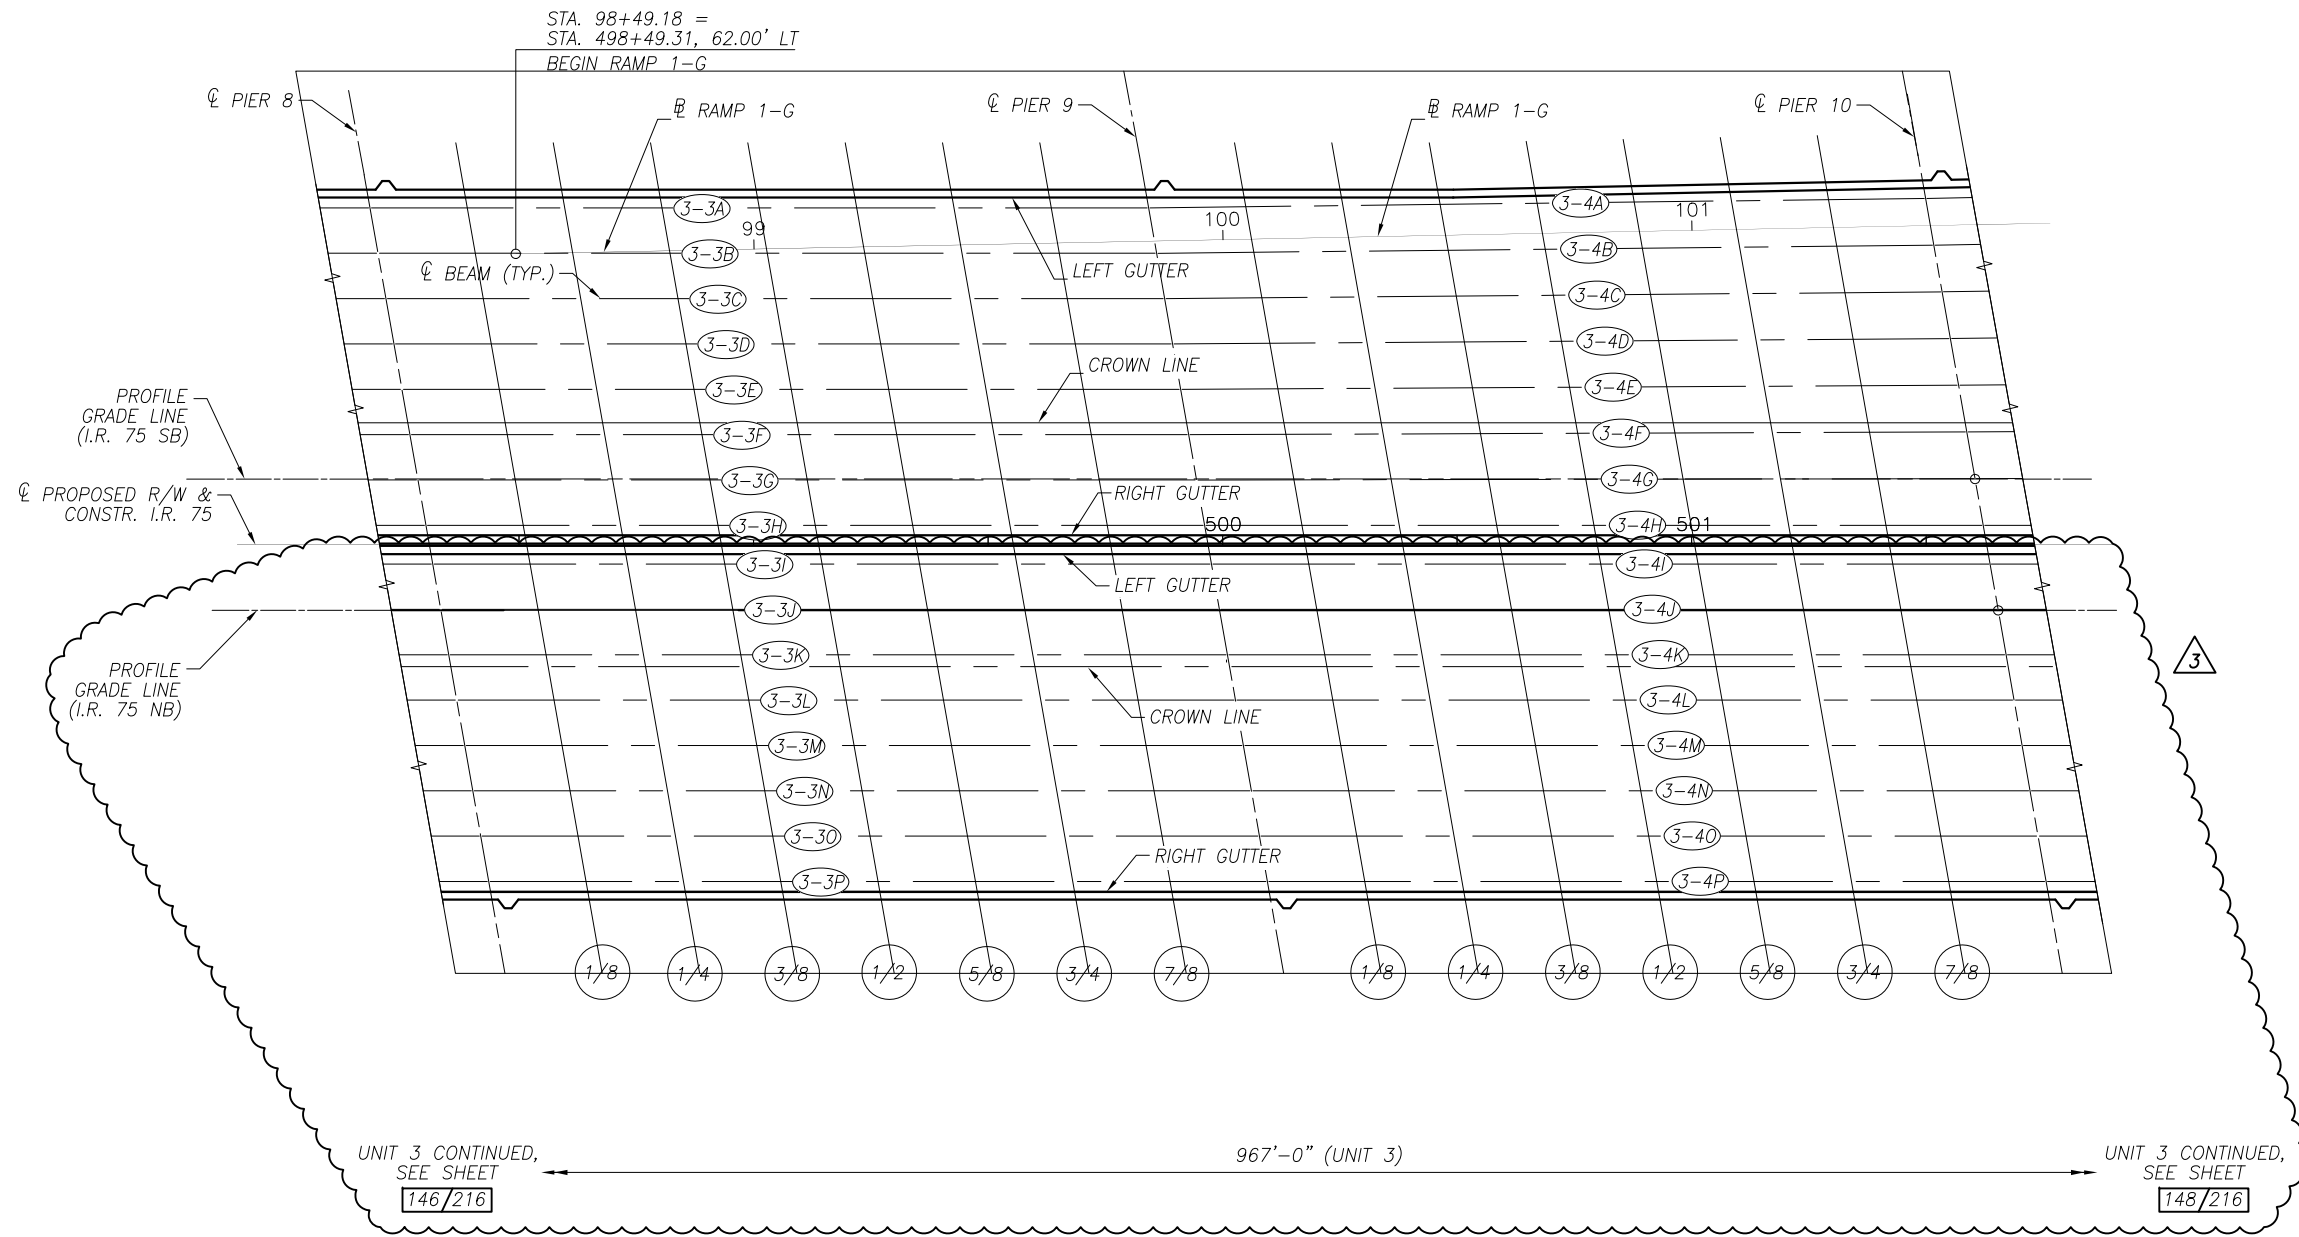

**PLAN (UNIT 3)**  
 NORTHBOUND AND SOUTHBOUND BRIDGES

**NOTE:**  
 1. SEE SHEET 143/216 FOR LEGEND AND NOTES.



3		5/1/2020	JANSSEN & SPAANS ENGINEERING INC. - RECONFIGURED NORTHBOUND ON RAMP
DESIGNED	DEB	CHECKED	MRW
DRAWN	VFC	REVIEWED	JTH
DATE	8/18	DESIGN AGENCY	AECOM
STRUCTURE FILE NUMBER	4802765/4802767	564 WHITE POND DRIVE AKRON, OHIO 44320-1100	(330) 836-9111


DECK SURFACE, SCREED AND TOP OF HAUNCH ELEVATIONS PLAN  
 BRIDGE NO. LUC-75-0029 L/R  
 I.R. 75 OVER MAUMEE RIVER

W00/LUC-75-  
 30.70/0.00  
 PID No. 93592

147/216

1440  
 1792

Date: Oct 07, 2020, 4:30pm User Name: mlngtin  
 File: P:\11321 - Toledo E Value Engineering\DWGS\BRIDGE\LUC-75-0027 over Maumee River\Sheets\075\_0027C\_S0070.dwg

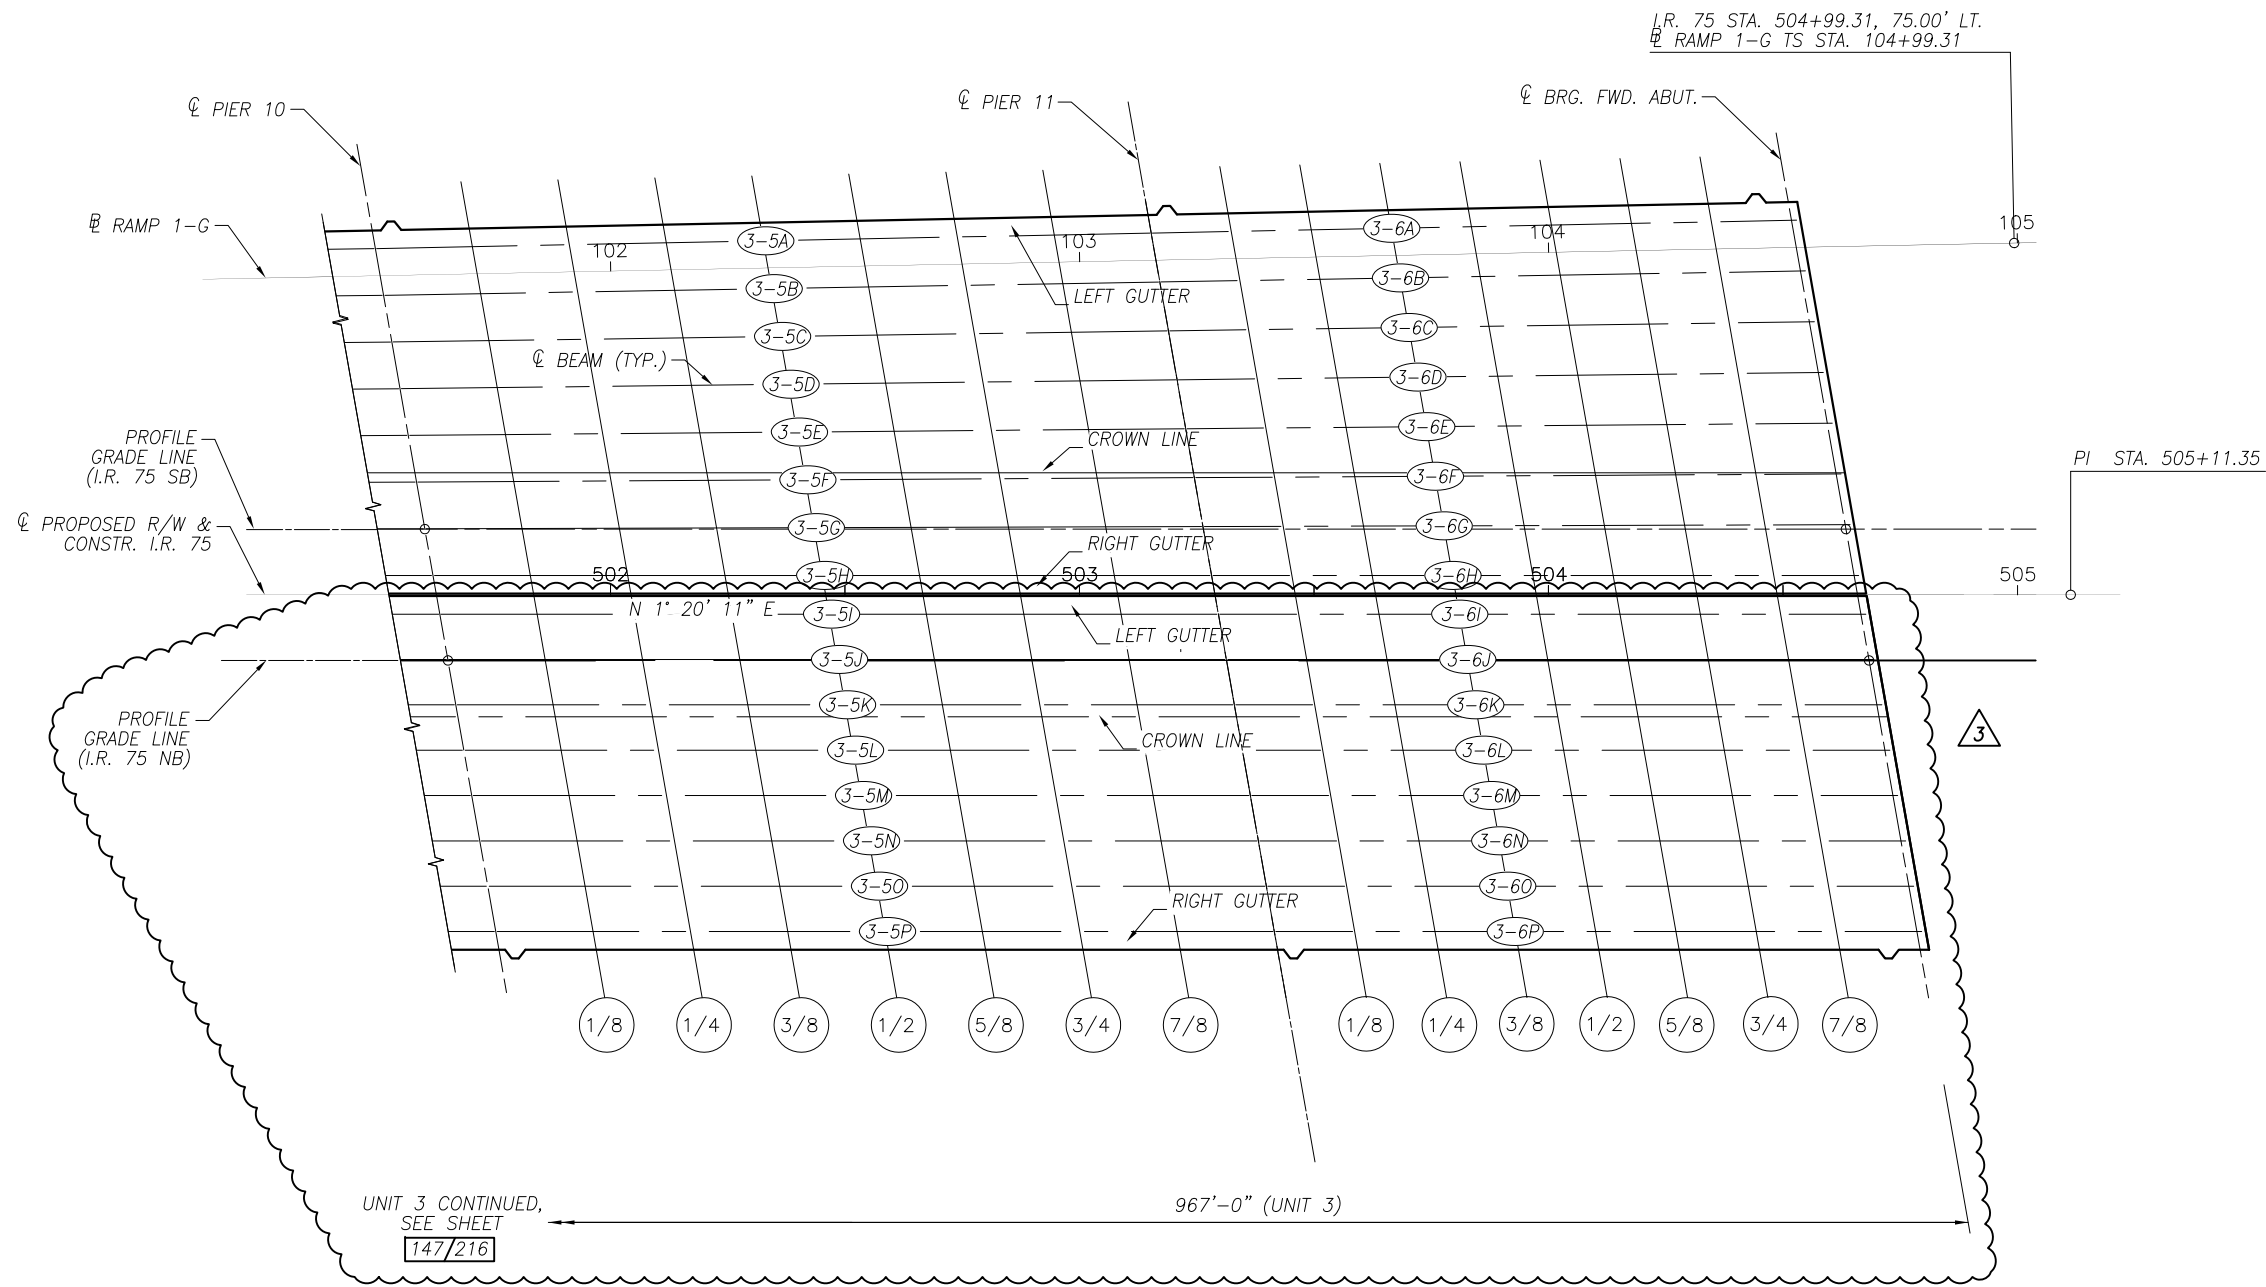

UNIT 3 CONTINUED,  
 SEE SHEET  
 147/216

967'-0" (UNIT 3)


**PLAN (UNIT 3)**  
 NORTHBOUND AND SOUTHBOUND BRIDGES

**NOTE:**  
 1. SEE SHEET 143/216 FOR LEGEND AND NOTES.



5/1/2020 JANSSEN & SPAANS ENGINEERING INC. - RECONFIGURED NORTHBOUND ON RAMP		DESIGN AGENCY 554 WHITE POND DRIVE AKRON, OHIO 44320-1100 <b>AECOM</b> (330) 636-9111
DESIGNED DEB	DRAWN VFC	DATE 8/18
CHECKED MRW	REVIEWED JTH	STRUCTURE FILE NUMBER 4802765/4802767
DECK SURFACE, SCREED AND TOP OF HAUNCH ELEVATIONS PLAN BRIDGE NO. LUC-75-0029 L/R I.R. 75 OVER MAUMEE RIVER		
W00/LUC-75- 30.70/0.00 PID No. 93592		148/216
1441 1792		



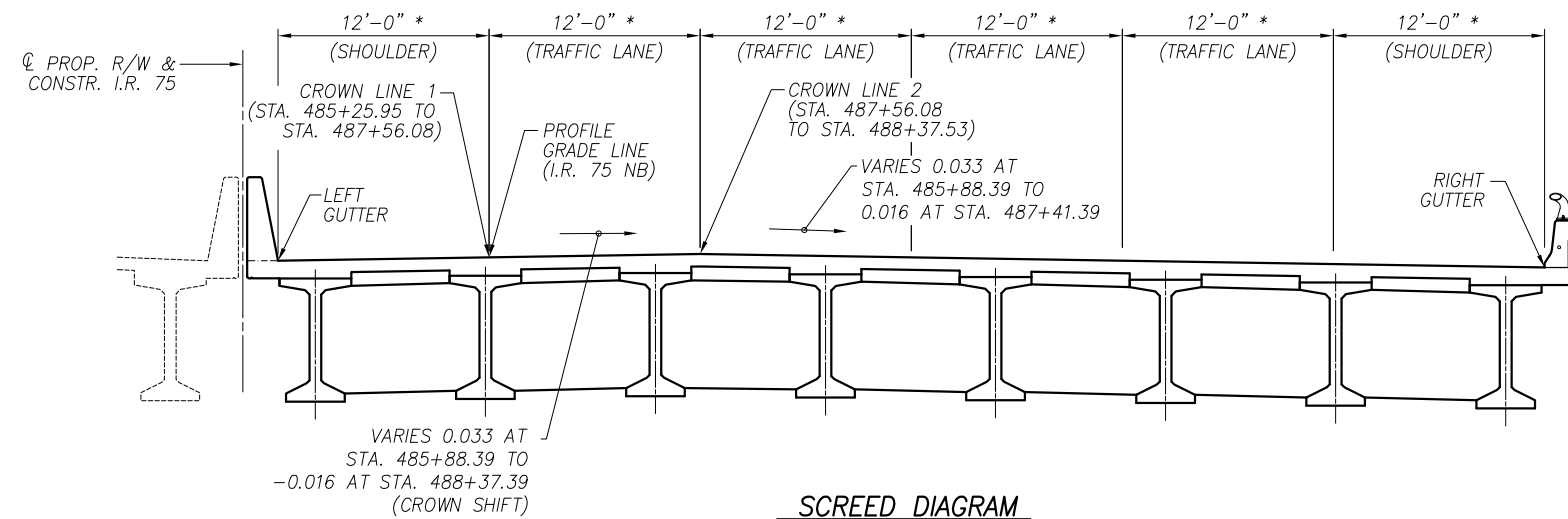

**SCREED DIAGRAM**  
NORTHBOUND BRIDGE - UNIT 1

**LEGEND:**  
\* - MEASURED PERPENDICULAR TO CL PROP. R/W & CONSTR. I.R. 75


**NOTES:**

- SCREED ELEVATIONS SHOWN REPRESENT THE THEORETICAL DECK SURFACE LOCATION PRIOR TO DEFLECTIONS CAUSED BY DECK PLACEMENT AND OTHER ANTICIPATED DEAD LOADS.
- FOR PLAN VIEWS, SEE SHEETS 143/216 THRU 148/216.

SCREED ELEVATIONS (NORTHBOUND BRIDGE - UNIT 1)																		
LOCATION		SPAN 1									CL PIER 1	SPAN 2						
		CL BRG. REAR ABUT.	1/8 POINT	1/4 POINT	3/8 POINT	1/2 POINT	5/8 POINT	3/4 POINT	7/8 POINT	1/8 POINT		1/4 POINT	3/8 POINT	1/2 POINT	5/8 POINT	3/4 POINT	7/8 POINT	CL BRG. PIER 2
LEFT GUTTER	STATION	485+24.19	485+42.32	485+60.45	485+78.58	485+96.71	486+14.84	486+32.96	486+51.09	486+69.22	486+89.81	487+10.39	487+30.98	487+51.56	487+72.15	487+92.73	488+13.32	488+33.90
	OFFSET FROM BL	2.00' RT	2.00' RT	2.00' RT	2.00' RT	2.00' RT	2.00' RT	2.00' RT	2.00' RT	2.00' RT	2.00' RT	2.00' RT	2.00' RT	2.00' RT	2.00' RT	2.00' RT	2.00' RT	2.00' RT
	SCREED ELEVATION	633.37	633.37	633.36	633.34	633.30	633.23	633.14	633.04	632.93	632.97	632.99	632.98	632.94	632.86	632.74	632.59	632.44
PROFILE GRADE / CROWN LINE 1	STATION	485+25.95	485+44.10	485+62.25	485+80.40	485+98.55	486+16.70	486+34.85	486+53.00	486+71.15	486+91.75	487+12.36	487+32.97	487+53.58	487+74.19	487+94.80	488+15.41	488+36.02
	OFFSET FROM BL	14.00' RT	14.00' RT	14.00' RT	14.00' RT	14.00' RT	14.00' RT	14.00' RT	14.00' RT	14.00' RT	14.00' RT	14.00' RT	14.00' RT	14.00' RT	14.00' RT	14.00' RT	14.00' RT	14.00' RT
	SCREED ELEVATION	633.55	633.55	633.55	633.53	633.48	633.42	633.33	633.23	633.12	633.15	633.17	633.17	633.13	633.04	632.92	632.78	632.62
CROWN LINE 2	STATION	485+27.71	485+45.88	485+64.05	485+82.22	486+00.39	486+18.56	486+36.73	486+54.90	486+73.07	486+93.70	487+14.34	487+34.97	487+55.60	487+76.23	487+96.87	488+17.50	488+38.13
	OFFSET FROM BL	26.00' RT	26.00' RT	26.00' RT	26.00' RT	26.00' RT	26.00' RT	26.00' RT	26.00' RT	26.00' RT	26.00' RT	26.00' RT	26.00' RT	26.00' RT	26.00' RT	26.00' RT	26.00' RT	26.00' RT
	SCREED ELEVATION	633.15	633.15	633.15	633.12	633.11	633.09	633.04	632.98	632.91	633.00	633.07	633.11	633.12	633.08	633.01	632.92	632.81
RIGHT GUTTER	STATION	485+34.74	485+52.99	485+71.24	485+89.50	486+07.75	486+26.01	486+44.26	486+62.51	486+80.77	487+01.50	487+22.23	487+42.95	487+63.68	487+84.41	488+05.14	488+25.87	488+46.60
	OFFSET FROM BL	78.06' RT	77.96' RT	77.83' RT	77.63' RT	77.38' RT	77.05' RT	76.69' RT	76.26' RT	75.77' RT	75.18' RT	74.54' RT	74.01' RT	74.01' RT	74.01' RT	74.00' RT	74.00' RT	74.00' RT
	SCREED ELEVATION	631.41	631.42	631.41	631.41	631.52	631.61	631.68	631.73	631.78	631.99	632.18	632.34	632.34	632.31	632.24	632.15	632.01

Date: Oct 09, 2020, 10:15am User Name: mlongtin  
 File: \\scc.com\files\Projects\1321 - Toledo E. Value Engineering\DWGS\BRIDGE\LUC-75-0027 over Maumee River\Sheets\075\_0027C\_SD0027.dwg

5/1/2020 JANSSEN & SPAANS ENGINEERING INC. - RECONFIGURED NORTHBOUND ON RAMP SHEET REPLACED  
 DESIGN AGENCY: JANSSEN & SPAANS ENGINEERING, INC. 9120 HARRISON PARK COURT INDIANAPOLIS, IN 46216  
 DATE: 5/2020  
 STRUCTURE FILE NUMBER: 4802765/4802767  
 DRAWN: WJZ  
 REM: WJZ  
 CHECKED: CBS  
 DESIGNED: WJZ  
 CHECKED: CBS  
 SCREED ELEVATIONS - NORTHBOUND-UNIT 1  
 BRIDGE NO. LUC-75-0029 L/R  
 I.R. 75 OVER MAUMEE RIVER  
 W00/LUC-75-30.70/0.00  
 PID No. 93592  
 154/216  
 1447  
 1792

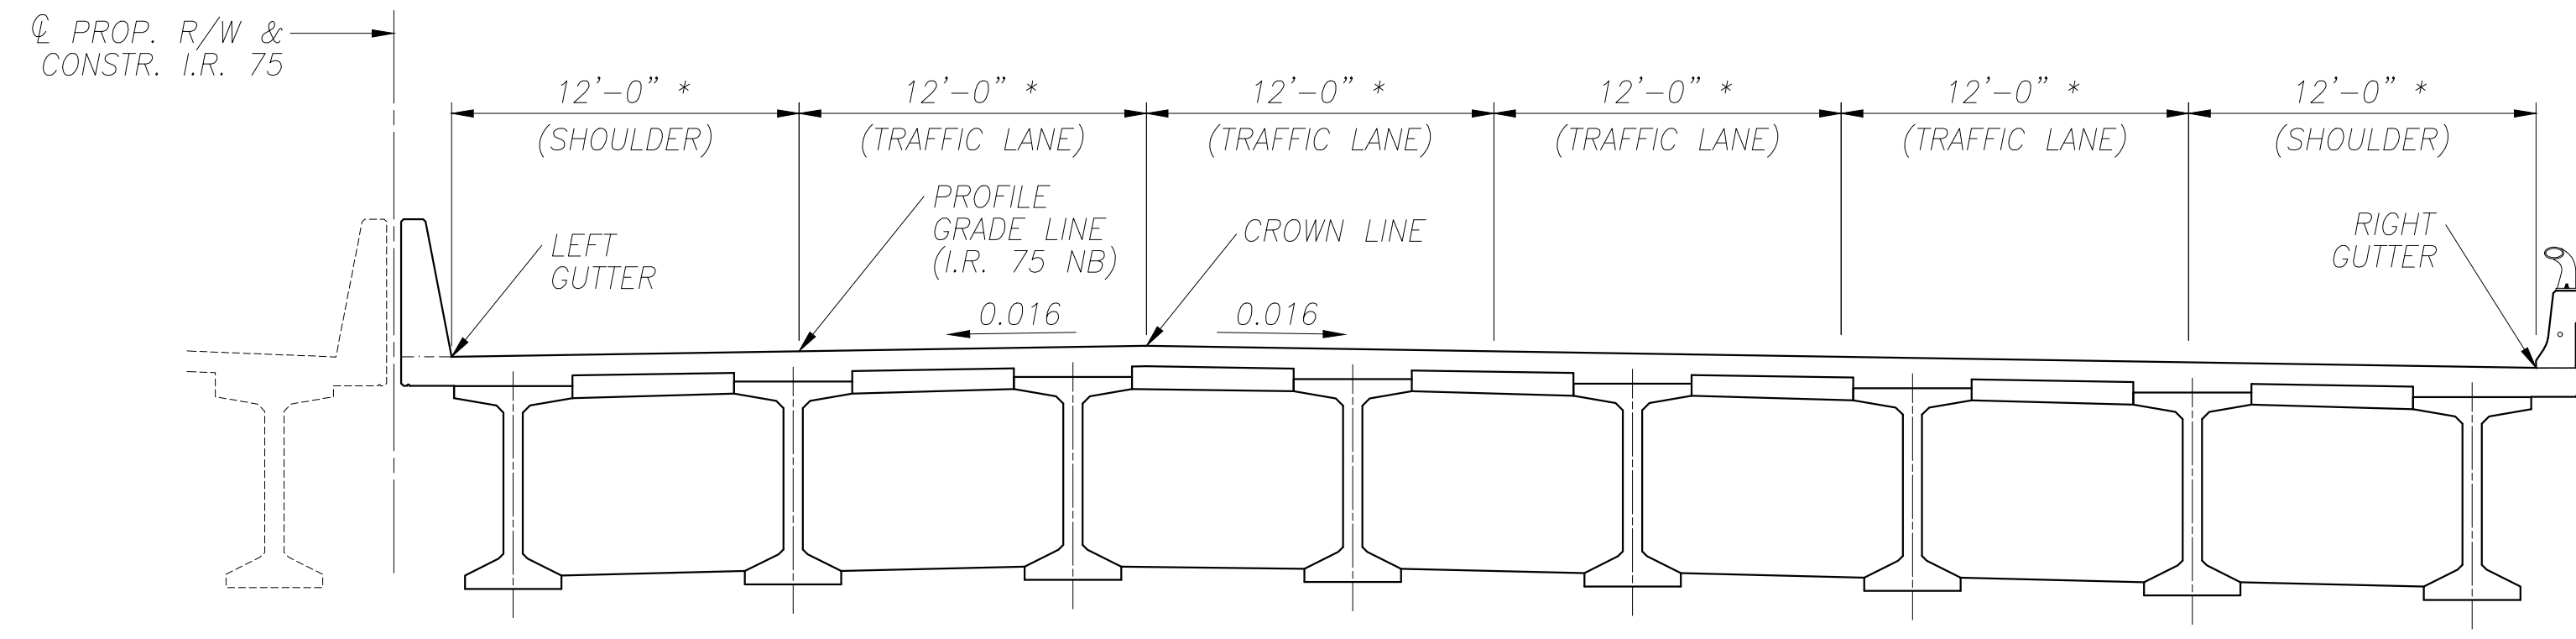

**SCREED DIAGRAM**  
NORTHBOUND BRIDGE - UNIT 2

**LEGEND:**

\* - MEASURED PERPENDICULAR TO CL PROP. R/W & CONSTR. I.R. 75

**NOTES:**

- SCREED ELEVATIONS SHOWN REPRESENT THE THEORETICAL DECK SURFACE LOCATION PRIOR TO DEFLECTIONS CAUSED BY DECK PLACEMENT AND OTHER ANTICIPATED DEAD LOADS.
- FOR PLAN VIEWS, SEE SHEETS [143/216] THRU [148/216].

SCREED ELEVATIONS (NORTHBOUND BRIDGE - UNIT 2)																		
LOCATION		SPAN 3								CL PIER 3	SPAN 4							CL PIER 4
		CL BRG. PIER 2	1/8 POINT	1/4 POINT	3/8 POINT	1/2 POINT	5/8 POINT	3/4 POINT	7/8 POINT		1/8 POINT	1/4 POINT	3/8 POINT	1/2 POINT	5/8 POINT	3/4 POINT	7/8 POINT	
LEFT GUTTER	STATION	488+36.61	488+57.19	488+77.77	488+98.35	489+18.93	489+39.51	489+60.09	489+80.67	490+01.25	490+22.00	490+42.75	490+63.50	490+84.25	491+05.00	491+25.75	491+46.50	491+67.25
	OFFSET FROM BL	2.00' RT	2.00' RT	2.00' RT	2.00' RT	2.00' RT	2.00' RT	2.00' RT	2.00' RT	2.00' RT	2.00' RT	2.00' RT	2.00' RT	2.00' RT	2.00' RT	2.00' RT	2.00' RT	2.00' RT
	SCREED ELEVATION	632.43	632.46	632.48	632.48	632.44	632.35	632.24	632.09	631.93	631.97	631.99	631.98	631.94	631.86	631.74	631.60	631.44
PROFILE GRADE	STATION	488+38.72	488+59.30	488+79.88	489+00.46	489+21.05	489+41.63	489+62.21	489+82.79	490+03.37	490+24.12	490+44.87	490+65.62	490+86.37	491+07.12	491+27.87	491+48.62	491+69.37
	OFFSET FROM BL	14.00' RT	14.00' RT	14.00' RT	14.00' RT	14.00' RT	14.00' RT	14.00' RT	14.00' RT	14.00' RT	14.00' RT	14.00' RT	14.00' RT	14.00' RT	14.00' RT	14.00' RT	14.00' RT	
	SCREED ELEVATION	632.61	632.65	632.67	632.66	632.62	632.54	632.42	632.28	632.12	632.15	632.17	632.17	632.13	632.04	631.93	631.78	631.62
CROWN LINE	STATION	488+40.84	488+61.42	488+82.00	489+02.58	489+23.16	489+43.74	489+64.32	489+84.90	490+05.48	490+26.23	490+46.98	490+67.73	490+88.48	491+09.23	491+29.98	491+50.73	491+71.48
	OFFSET FROM BL	26.00' RT	26.00' RT	26.00' RT	26.00' RT	26.00' RT	26.00' RT	26.00' RT	26.00' RT	26.00' RT	26.00' RT	26.00' RT	26.00' RT	26.00' RT	26.00' RT	26.00' RT	26.00' RT	
	SCREED ELEVATION	632.80	632.83	632.86	632.85	632.81	632.73	632.61	632.46	632.31	632.34	632.36	632.35	632.31	632.23	632.11	631.97	631.81
RIGHT GUTTER	STATION	488+49.30	488+69.88	488+90.46	489+11.04	489+31.62	489+52.21	489+72.79	489+93.37	490+13.95	490+34.70	490+55.45	490+76.20	490+96.95	491+17.70	491+38.45	491+59.20	491+79.95
	OFFSET FROM BL	74.00' RT	74.00' RT	74.00' RT	74.00' RT	74.00' RT	74.00' RT	74.00' RT	74.00' RT	74.00' RT	74.00' RT	74.00' RT	74.00' RT	74.00' RT	74.00' RT	74.00' RT	74.00' RT	
	SCREED ELEVATION	632.01	632.04	632.06	632.06	632.02	631.93	631.81	631.67	631.51	631.55	631.57	631.56	631.52	631.44	631.32	631.17	631.01

Date: Oct 12, 2020, 4:53pm User Name: mbrngtin  
File: \\jbs.com\files\Projects\1321 - Toledo E Value Engineering\DWG\BRIDGE\LUC-75-0027 over Maumee River\Sheets\075\_0027C\_SP028.dwg


5/1/2020 JANSEN & SPAANS ENGINEERING INC. -  
REPLACED SHEET

DESIGNED	WOZ	CHECKED	CBS
DRAWN	REM	REVIS	
REVIEWED	WOZ	DATE	5/20
STRUCTURE FILE NUMBER	4802765/4802767		

SCREED ELEVATIONS - NORTHBOUND - UNIT 2  
BRIDGE NO. LUC-75-0029 L/R  
I.R. 75 OVER MAUMEE RIVER

W00/LUC-75-  
30.70/0.00  
PID No. 93592

DESIGN AGENCY  
JANSEN & SPAANS ENGINEERING, INC.  
9120 HARRISON PARK COURT  
INDIANAPOLIS, IN 46216

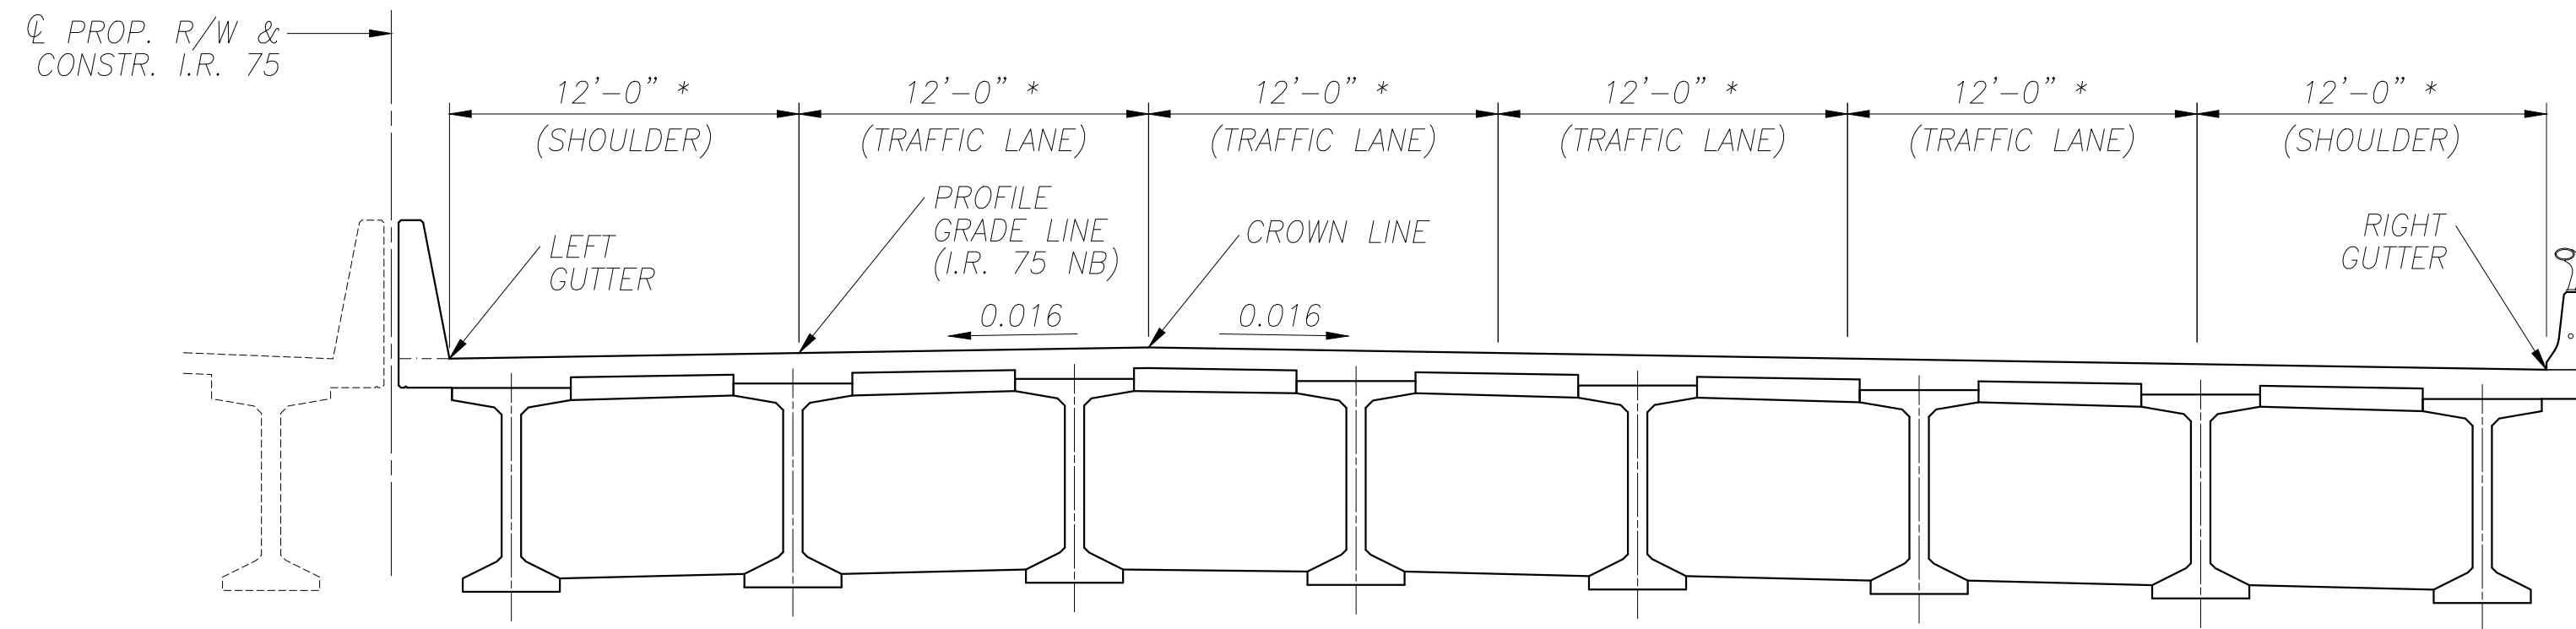

**SCREED DIAGRAM**  
NORTHBOUND BRIDGE - UNIT 2

**LEGEND:**

\* - MEASURED PERPENDICULAR TO CL PROP. R/W & CONSTR. I.R. 75

**NOTES:**

1. SCREED ELEVATIONS SHOWN REPRESENT THE THEORETICAL DECK SURFACE LOCATION PRIOR TO DEFLECTIONS CAUSED BY DECK PLACEMENT AND OTHER ANTICIPATED DEAD LOADS.
2. FOR PLAN VIEWS, SEE SHEETS [143/216] THRU [148/216].

**SCREED ELEVATIONS (NORTHBOUND BRIDGE - UNIT 2)**

LOCATION	CL PIER 4	SPAN 5								CL PIER 5	SPAN 6							
		1/8 POINT	1/4 POINT	3/8 POINT	1/2 POINT	5/8 POINT	3/4 POINT	7/8 POINT	1/8 POINT		1/4 POINT	3/8 POINT	1/2 POINT	5/8 POINT	3/4 POINT	7/8 POINT	CL BRG. PIER 6	
LEFT GUTTER	STATION	491+67.25	491+88.00	492+08.75	492+29.50	492+50.25	492+71.00	492+91.75	493+12.50	493+33.25	493+53.74	493+74.22	493+94.71	494+15.19	494+35.68	494+56.17	494+76.65	494+97.14
	OFFSET FROM BL	2.00' RT	2.00' RT	2.00' RT	2.00' RT	2.00' RT	2.00' RT	2.00' RT	2.00' RT	2.00' RT	2.00' RT	2.00' RT	2.00' RT	2.00' RT	2.00' RT	2.00' RT	2.00' RT	2.00' RT
	SCREED ELEVATION	631.44	631.47	631.49	631.48	631.44	631.36	631.24	631.10	630.94	630.97	630.99	630.99	630.95	630.87	630.75	630.60	630.45
PROFILE GRADE	STATION	491+69.37	491+90.12	492+10.87	492+31.62	492+52.37	492+73.12	492+93.87	493+14.62	493+35.37	493+55.85	493+76.34	493+96.83	494+17.31	494+37.80	494+58.28	494+78.77	494+99.25
	OFFSET FROM BL	14.00' RT	14.00' RT	14.00' RT	14.00' RT	14.00' RT	14.00' RT	14.00' RT	14.00' RT	14.00' RT	14.00' RT	14.00' RT	14.00' RT	14.00' RT	14.00' RT	14.00' RT	14.00' RT	14.00' RT
	SCREED ELEVATION	631.62	631.66	631.68	631.67	631.63	631.55	631.43	631.28	631.12	631.16	631.18	631.17	631.13	631.05	630.93	630.79	630.63
CROWN LINE	STATION	491+71.48	491+92.23	492+12.98	492+33.73	492+54.48	492+75.23	492+95.98	493+16.73	493+37.48	493+57.97	493+78.46	493+98.94	494+19.43	494+39.91	494+60.40	494+80.88	495+01.37
	OFFSET FROM BL	26.00' RT	26.00' RT	26.00' RT	26.00' RT	26.00' RT	26.00' RT	26.00' RT	26.00' RT	26.00' RT	26.00' RT	26.00' RT	26.00' RT	26.00' RT	26.00' RT	26.00' RT	26.00' RT	26.00' RT
	SCREED ELEVATION	631.81	631.84	631.86	631.86	631.81	631.73	631.61	631.47	631.31	631.34	631.37	631.36	631.32	631.24	631.12	630.98	630.82
RIGHT GUTTER	STATION	491+79.95	492+00.70	492+21.45	492+42.20	492+62.95	492+83.70	493+04.45	493+25.20	493+45.95	493+66.43	493+86.92	494+07.40	494+27.89	494+48.38	494+68.86	494+89.35	495+09.83
	OFFSET FROM BL	74.00' RT	74.00' RT	74.00' RT	74.00' RT	74.00' RT	74.00' RT	74.00' RT	74.00' RT	74.00' RT	74.00' RT	74.00' RT	74.00' RT	74.00' RT	74.00' RT	74.00' RT	74.00' RT	74.00' RT
	SCREED ELEVATION	631.01	631.05	631.07	631.06	631.02	630.94	630.82	630.68	630.52	630.55	630.57	630.57	630.53	630.44	630.33	630.18	630.02

Date: Oct 12, 2020, 3:56pm User Name: mbrngtin  
File: \\jse.com\files\projects\1321 - Toledo E Value Engineering\DWGS\BRIDGE\LUC-75-0027 over Maumee River\Sheets\075\_0027C\_SD025.dwg

5/1/2020 JANSSEN & SPAANS ENGINEERING INC. -  
REPLACED SHEET


DESIGNED	WOZ	CBS
DRAWN	REM	CBS
REVIEWED	WOZ	
DATE	5/20	
STRUCTURE FILE NUMBER	4802765/4802767	
DESIGN AGENCY	JANSSEN & SPAANS ENGINEERING, INC. 9120 HARRISON PARK COURT INDIANAPOLIS, IN 46216	

SCREED ELEVATIONS - NORTHBOUND - UNIT 2  
BRIDGE NO. LUC-75-0029 L/R  
I.R. 75 OVER MAUMEE RIVER

W00/LUC-75-  
30.70/0.00  
PID No. 93592

156/216

1449  
1792

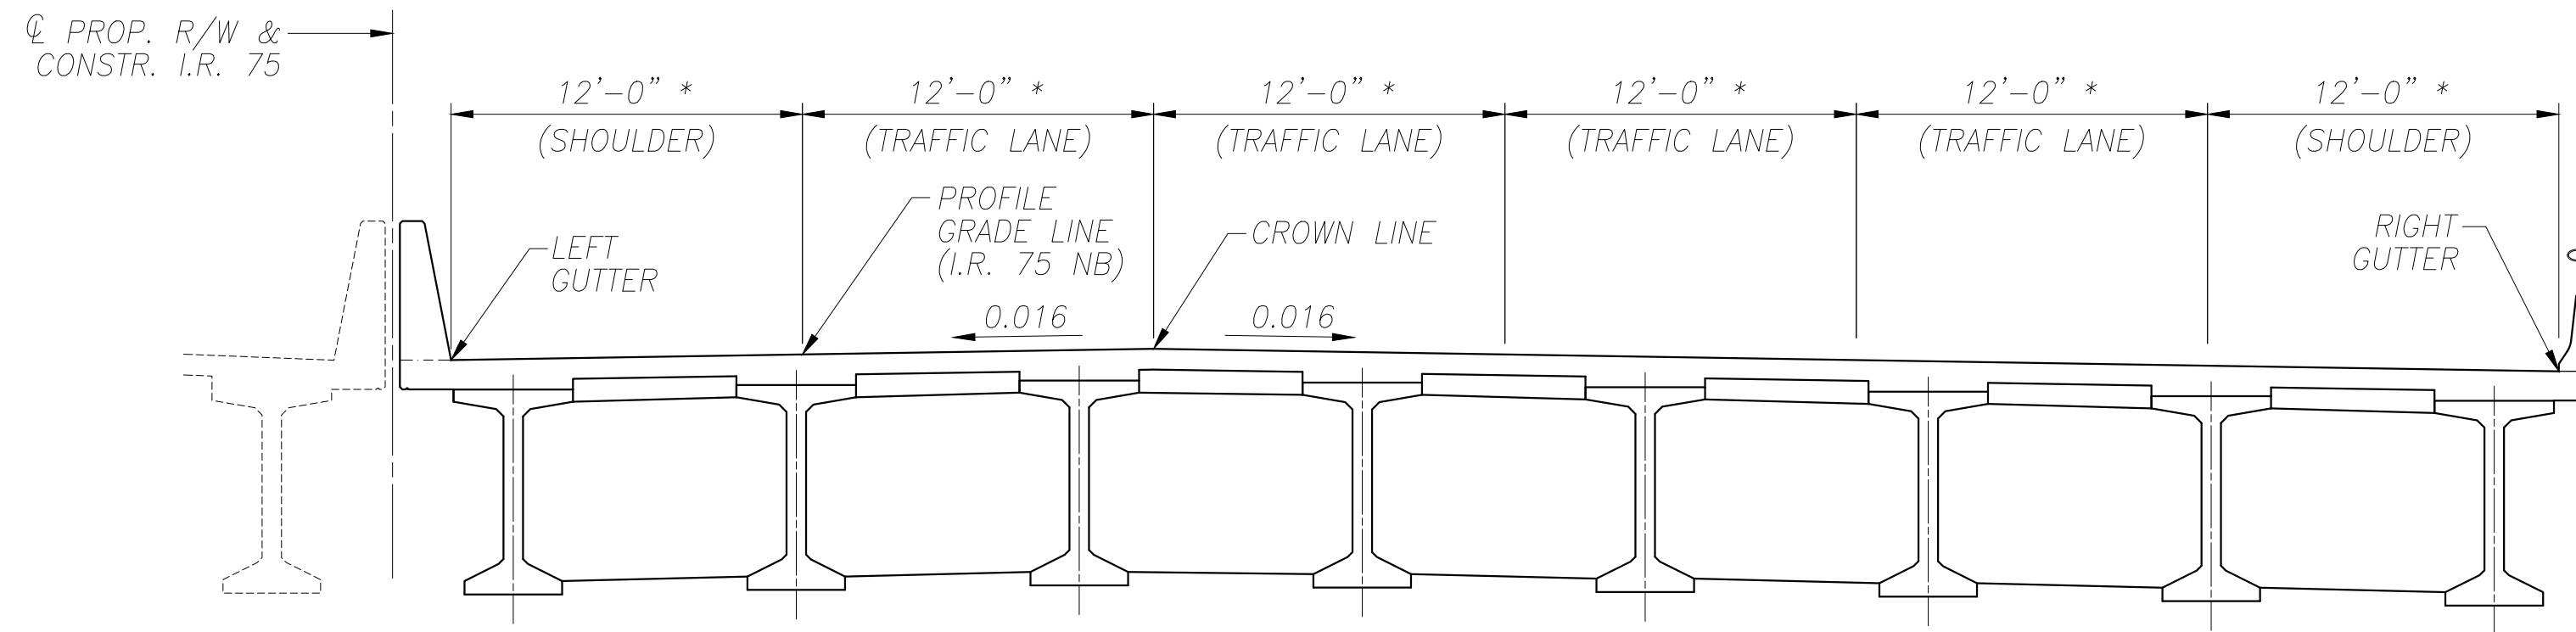

SCREED DIAGRAM  
NORTHBOUND BRIDGE - UNIT 3

LEGEND:

\* - MEASURED PERPENDICULAR TO CL PROP. R/W & CONSTR. I.R. 75

NOTES:

- SCREED ELEVATIONS SHOWN REPRESENT THE THEORETICAL DECK SURFACE LOCATION PRIOR TO DEFLECTIONS CAUSED BY DECK PLACEMENT AND OTHER ANTICIPATED DEAD LOADS.
- FOR PLAN VIEWS, SEE SHEETS 143/216 THRU 148/216.

SCREED ELEVATIONS (NORTHBOUND BRIDGE - UNIT 3)

LOCATION		SPAN 7									SPAN 8							
		CL BRG. PIER 6	1/8 POINT	1/4 POINT	3/8 POINT	1/2 POINT	5/8 POINT	3/4 POINT	7/8 POINT	CL PIER 7	1/8 POINT	1/4 POINT	3/8 POINT	1/2 POINT	5/8 POINT	3/4 POINT	7/8 POINT	CL PIER 8
LEFT GUTTER	STATION	495+01.37	495+21.85	495+42.34	495+62.82	495+83.31	496+03.80	496+24.28	496+44.77	496+65.25	496+86.00	497+06.75	497+27.50	497+48.25	497+69.00	497+89.75	498+10.50	498+31.25
	OFFSET FROM BL	2.00' RT	2.00' RT	2.00' RT	2.00' RT	2.00' RT	2.00' RT	2.00' RT	2.00' RT	2.00' RT	2.00' RT	2.00' RT	2.00' RT	2.00' RT	2.00' RT	2.00' RT	2.00' RT	2.00' RT
	SCREED ELEVATION	630.43	630.47	630.49	630.48	630.44	630.36	630.24	630.10	629.94	629.98	630.00	629.99	629.95	629.87	629.75	629.60	629.44
PROFILE GRADE / CROWN LINE 1	STATION	495+03.48	495+23.97	495+44.46	495+64.94	495+85.43	496+05.91	496+26.40	496+46.88	496+67.37	496+88.12	497+08.87	497+29.62	497+50.37	497+71.12	497+91.87	498+12.62	498+33.37
	OFFSET FROM BL	14.00' RT	14.00' RT	14.00' RT	14.00' RT	14.00' RT	14.00' RT	14.00' RT	14.00' RT	14.00' RT	14.00' RT	14.00' RT	14.00' RT	14.00' RT	14.00' RT	14.00' RT	14.00' RT	14.00' RT
	SCREED ELEVATION	630.62	630.65	630.68	630.67	630.63	630.55	630.43	630.29	630.13	630.16	630.18	630.18	630.13	630.05	629.93	629.79	629.63
CROWN LINE 2	STATION	495+05.60	495+26.09	495+46.57	495+67.06	495+87.54	496+08.03	496+28.51	496+49.00	496+69.48	496+90.23	497+10.98	497+31.73	497+52.48	497+73.23	497+93.98	498+14.73	498+35.48
	OFFSET FROM BL	26.00' RT	26.00' RT	26.00' RT	26.00' RT	26.00' RT	26.00' RT	26.00' RT	26.00' RT	26.00' RT	26.00' RT	26.00' RT	26.00' RT	26.00' RT	26.00' RT	26.00' RT	26.00' RT	26.00' RT
	SCREED ELEVATION	630.81	630.84	630.86	630.86	630.82	630.73	630.62	630.47	630.31	630.35	630.37	630.36	630.32	630.24	630.12	629.97	629.82
RIGHT GUTTER	STATION	495+14.06	495+34.55	495+55.03	495+75.52	495+96.01	496+16.49	496+36.98	496+57.46	496+77.95	496+98.70	497+19.45	497+40.20	497+60.95	497+81.70	498+02.45	498+23.20	498+43.95
	OFFSET FROM BL	74.00' RT	74.00' RT	74.00' RT	74.00' RT	74.00' RT	74.00' RT	74.00' RT	74.00' RT	74.00' RT	74.00' RT	74.00' RT	74.00' RT	74.00' RT	74.00' RT	74.00' RT	74.00' RT	74.00' RT
	SCREED ELEVATION	630.01	630.05	630.07	630.06	630.02	629.94	629.82	629.68	629.52	629.55	629.57	629.57	629.53	629.44	629.33	629.18	629.02

Date: Oct 12, 2020, 3:56pm User Name: mlongtin  
File: \\jps.com\files\Projects\1321 - Toledo E Value Engineering\DWG\BRIDGE\LUC-75-0027 over Maumee River\Sheets\075-0027C\_SP030.dwg

5/1/2020 JANSSEN & SPAANS ENGINEERING INC. -  
REPLACED SHEET  
DESIGN AGENCY  
JANSSEN & SPAANS ENGINEERING, INC.  
9120 HARRISON PARK COURT  
INDIANAPOLIS, IN 46216  
DATE 5/20  
REVIEWED WJZ  
DRAWN REM  
DESIGNED WJZ  
CHECKED CBS  
STRUCTURE FILE NUMBER 4802765/4802767


SCREED ELEVATIONS - NORTHBOUND - UNIT 3  
BRIDGE NO. LUC-75-0029 L/R  
I.R. 75 OVER MAUMEE RIVER

W00/LUC-75-  
30.70/0.00  
PID No. 93592


157/216

1450  
1792


Date: Oct 07, 2020, 4:42pm User Name: mlongtin  
 File: P:\11321 - Toledo E Value Engineering\DWGS\BRIDGE\LUC-75-0027 over Maumee River\Sheets\075\_0027C\_S0039.dwg

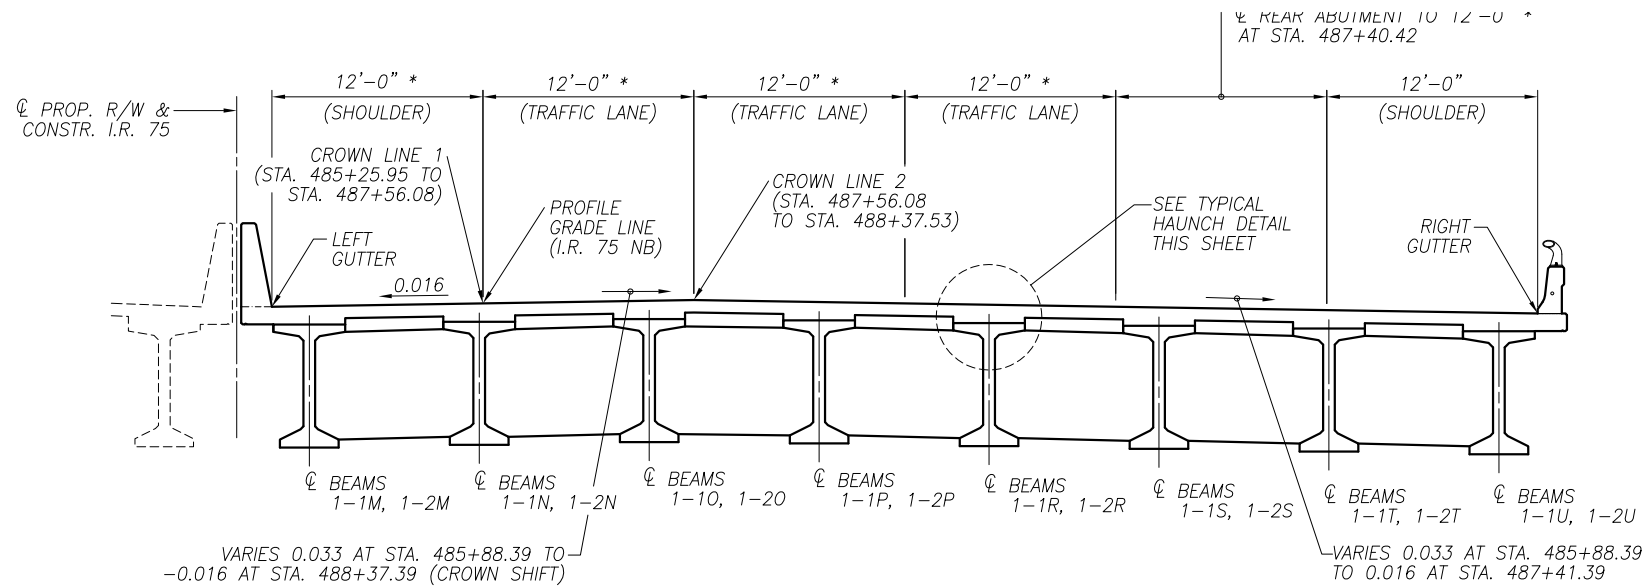


**HAUNCH DIAGRAM**  
 NORTHBOUND BRIDGE - UNIT 1

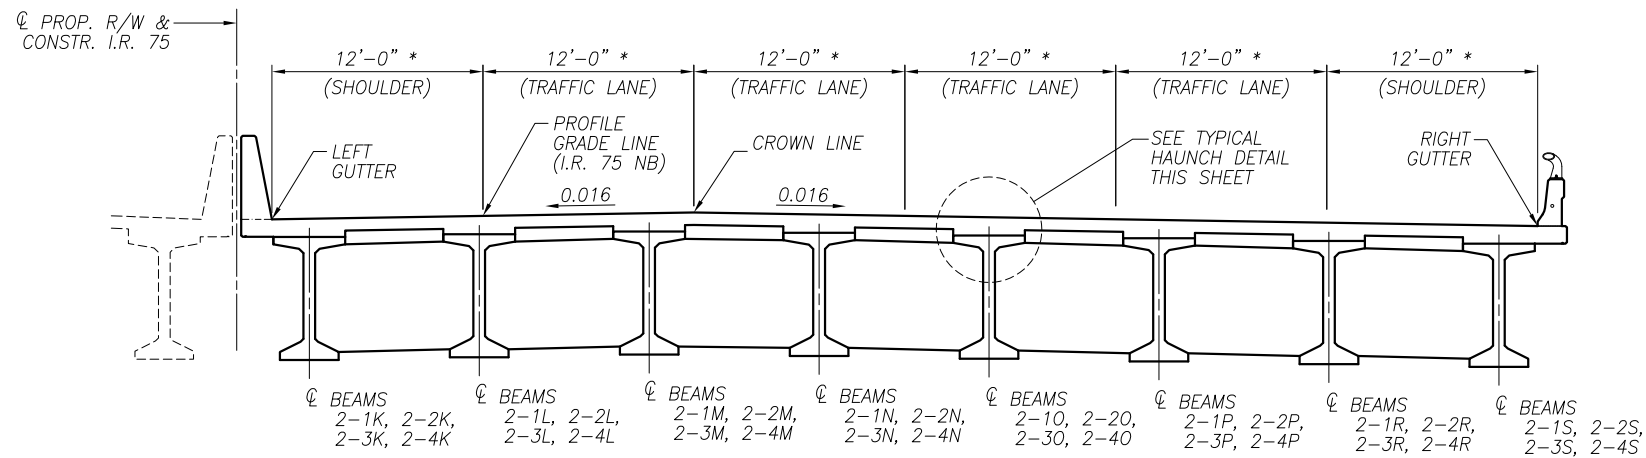

**HAUNCH DIAGRAM**  
 NORTHBOUND BRIDGE - UNIT 2

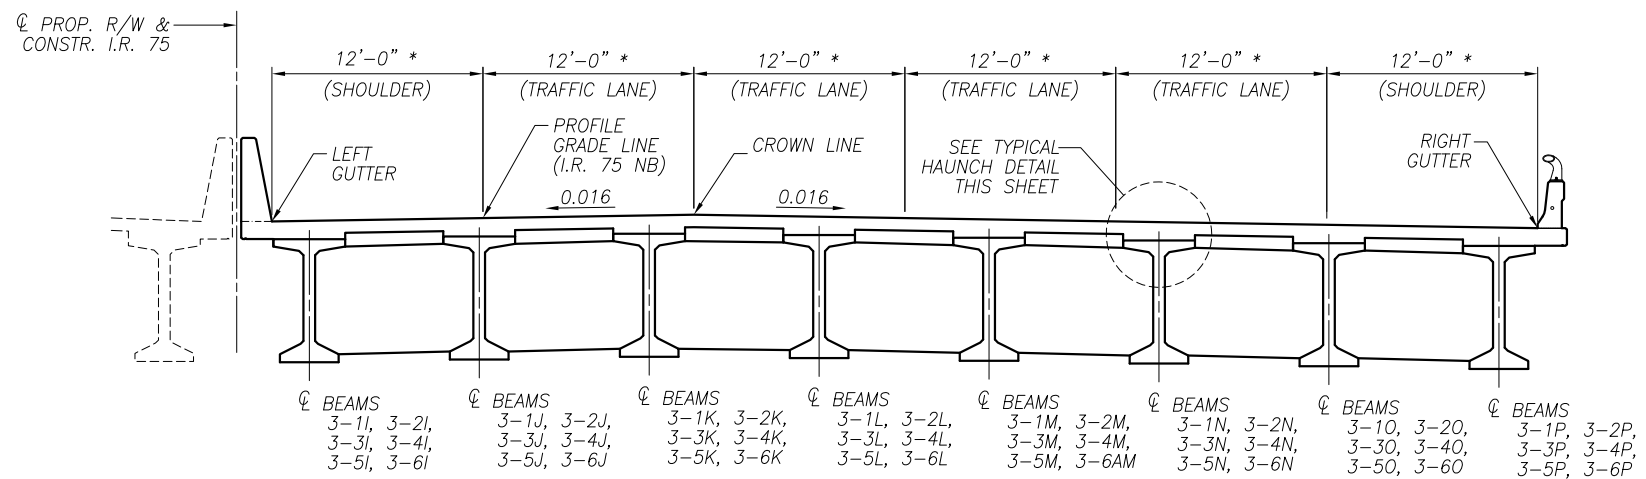

**HAUNCH DIAGRAM**  
 NORTHBOUND BRIDGE - UNIT 3

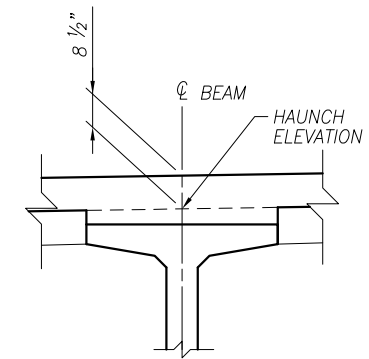

**TYPICAL HAUNCH DETAIL**

**LEGEND:**

\* MEASURED PERPENDICULAR TO  
 @ PROP. R/W & CONSTR. I.R. 75

**NOTES:**

1. TOP OF HAUNCH ELEVATIONS SHOWN REPRESENT THE THEORETICAL LOCATION OF THE BOTTOM OF DECK ABOVE THE BEAM/GIRDER HAUNCH AT @ PRIOR TO DEFLECTIONS CAUSED BY DECK PLACEMENT AND OTHER ANTICIPATED DEAD LOADS.

2. FOR PLAN VIEWS, SEE SHEETS 143/216 THRU 148/216 .

3

5/1/2020 JANSEN & SPAANS ENGINEERING INC. -  
 REPLACED SHEET

DESIGN AGENCY  
**JANSEN & SPAANS ENGINEERING, INC.**  
 9120 HARRISON PARK COURT  
 INDIANAPOLIS, IN 46216

DESIGNED	WOZ	CBS
DRAWN	REM	CBS
REVIEWED	WOZ	
DATE	5/20	
STRUCTURE FILE NUMBER	4802765/4802767	

HAUNCH DIAGRAMS - NORTHBOUND  
 BRIDGE NO. LUC-75-0029 L/R  
 I.R. 75 OVER MAUMEE RIVER

W00/LUC-75-  
 30.70/0.00  
 PID No. 93592

166/216

1459  
 1792

HAUNCH ELEVATIONS (NORTHBOUND BRIDGE - UNIT 1)																		
LOCATION		SPAN 1								CL PIER 1	SPAN 2							
		CL BRG. REAR ABUT.	1/8 POINT	1/4 POINT	3/8 POINT	1/2 POINT	5/8 POINT	3/4 POINT	7/8 POINT		1/8 POINT	1/4 POINT	3/8 POINT	1/2 POINT	5/8 POINT	3/4 POINT	7/8 POINT	CL BRG. PIER 2
BEAMLINE M	STATION	485+24.50	485+42.67	485+60.82	485+78.97	485+97.10	486+15.23	486+33.35	486+51.46	486+69.56	486+90.16	487+10.74	487+31.33	487+51.92	487+72.51	487+93.10	488+13.69	488+34.28
	OFFSET FROM BL	4.13' RT	4.32' RT	4.47' RT	4.55' RT	4.58' RT	4.54' RT	4.46' RT	4.31' RT	4.11' RT	4.15' RT	4.15' RT	4.14' RT	4.14' RT	4.14' RT	4.13' RT	4.13' RT	4.13' RT
	HAUNCH ELEVATION	632.69	632.70	632.69	632.67	632.63	632.56	632.47	632.37	632.25	632.29	632.31	632.30	632.26	632.18	632.06	631.92	631.76
BEAMLINE N	STATION	485+26.01	485+44.17	485+62.33	485+80.49	485+98.63	486+16.76	486+34.89	486+53.00	486+71.11	486+91.72	487+12.33	487+32.94	487+53.55	487+74.16	487+94.76	488+15.37	488+35.98
	OFFSET FROM BL	14.38' RT	14.50' RT	14.57' RT	14.58' RT	14.54' RT	14.43' RT	14.27' RT	14.05' RT	13.78' RT	13.82' RT	13.82' RT	13.81' RT	13.81' RT	13.81' RT	13.80' RT	13.80' RT	13.80' RT
	HAUNCH ELEVATION	632.83	632.83	632.82	632.80	632.76	632.70	632.62	632.52	632.40	632.44	632.46	632.45	632.41	632.33	632.21	632.07	631.91
BEAMLINE O	STATION	485+27.51	485+45.68	485+63.85	485+82.01	486+00.16	486+18.30	486+36.43	486+54.55	486+72.66	486+93.29	487+13.92	487+34.55	487+55.18	487+75.80	487+96.43	488+17.06	488+37.69
	OFFSET FROM BL	24.63' RT	24.67' RT	24.68' RT	24.61' RT	24.50' RT	24.31' RT	24.09' RT	23.79' RT	23.44' RT	23.48' RT	23.48' RT	23.47' RT	23.47' RT	23.47' RT	23.46' RT	23.46' RT	23.46' RT
	HAUNCH ELEVATION	632.81	632.81	632.80	632.77	632.74	632.68	632.60	632.51	632.40	632.43	632.46	632.45	632.41	632.33	632.21	632.07	631.92
BEAMLINE P	STATION	485+29.01	485+47.19	485+65.36	485+83.53	486+01.69	486+19.83	486+37.97	486+56.09	486+74.21	486+94.86	487+15.51	487+36.16	487+56.80	487+77.45	487+98.10	488+18.74	488+39.39
	OFFSET FROM BL	34.88' RT	34.85' RT	34.78' RT	34.64' RT	34.46' RT	34.20' RT	33.90' RT	33.53' RT	33.11' RT	33.15' RT	33.15' RT	33.14' RT	33.14' RT	33.14' RT	33.13' RT	33.13' RT	33.13' RT
	HAUNCH ELEVATION	632.15	632.15	632.14	632.13	632.14	632.14	632.12	632.08	632.04	632.14	632.22	632.28	632.29	632.26	632.19	632.10	631.98
BEAMLINE R	STATION	485+30.51	485+48.70	485+66.88	485+85.05	486+03.21	486+21.36	486+39.51	486+57.64	486+75.76	486+96.43	487+17.10	487+37.76	487+58.43	487+79.10	487+99.76	488+20.43	488+41.10
	OFFSET FROM BL	45.13' RT	45.03' RT	44.89' RT	44.68' RT	44.41' RT	44.08' RT	43.71' RT	43.27' RT	42.78' RT	42.82' RT	42.82' RT	42.81' RT	42.81' RT	42.81' RT	42.80' RT	42.80' RT	42.80' RT
	HAUNCH ELEVATION	631.80	631.81	631.81	631.79	631.82	631.85	631.85	631.84	631.81	631.94	632.04	632.12	632.14	632.10	632.04	631.94	631.82
BEAMLINE S	STATION	485+32.01	485+50.20	485+68.39	485+86.57	486+04.74	486+22.90	486+41.05	486+59.18	486+77.31	486+98.00	487+18.69	487+39.37	487+60.06	487+80.74	488+01.43	488+22.11	488+42.80
	OFFSET FROM BL	55.38' RT	55.21' RT	54.99' RT	54.71' RT	54.37' RT	53.97' RT	53.52' RT	53.01' RT	52.44' RT	52.48' RT	52.48' RT	52.47' RT	52.47' RT	52.47' RT	52.46' RT	52.46' RT	52.46' RT
	HAUNCH ELEVATION	631.46	631.47	631.47	631.46	631.52	631.56	631.58	631.59	631.59	631.74	631.87	631.97	631.98	631.95	631.88	631.78	631.66
BEAMLINE T	STATION	485+33.51	485+51.71	485+69.91	485+88.09	486+06.27	486+24.43	486+42.59	486+60.73	486+78.86	486+99.57	487+20.28	487+40.98	487+61.69	487+82.39	488+03.09	488+23.80	488+44.50
	OFFSET FROM BL	65.63' RT	65.38' RT	65.10' RT	64.74' RT	64.33' RT	63.85' RT	63.34' RT	62.75' RT	62.11' RT	62.15' RT	62.15' RT	62.14' RT	62.14' RT	62.14' RT	62.13' RT	62.13' RT	62.13' RT
	HAUNCH ELEVATION	631.12	631.13	631.13	631.12	631.21	631.28	631.32	631.35	631.37	631.54	631.69	631.82	631.83	631.79	631.72	631.63	631.50
BEAMLINE U	STATION	485+35.01	485+53.22	485+71.42	485+89.61	486+07.80	486+25.97	486+44.13	486+62.27	486+80.41	487+01.14	487+21.87	487+42.59	487+63.31	487+84.04	488+04.76	488+25.48	488+46.21
	OFFSET FROM BL	75.88' RT	75.56' RT	75.20' RT	74.77' RT	74.29' RT	73.74' RT	73.15' RT	72.49' RT	71.78' RT	71.82' RT	71.82' RT	71.81' RT	71.81' RT	71.81' RT	71.80' RT	71.80' RT	71.80' RT
	HAUNCH ELEVATION	630.77	630.79	630.79	630.79	630.91	631.00	631.07	631.12	631.16	631.35	631.52	631.66	631.67	631.64	631.57	631.47	631.34

5/1/2020 JANSSEN & SPAANS ENGINEERING INC. - REPLACED SHEET

DESIGNED	WOZ	CBS
CHECKED	REMOVED	REMOVED
DATE	5/2020	STRUCTURE FILE NUMBER
REVIEWED	WOZ	4802765/4802767
DESIGN AGENCY	JANSSEN & SPAANS ENGINEERING, INC. 9120 HARRISON PARK COURT INDIANAPOLIS, IN 46216	

HAUNCH ELEVATIONS - NORTHBOUND-UNIT 1  
 BRIDGE NO. LUC-75-0029 L/R  
 I.R. 75 OVER MAUMEE RIVER

W00/LUC-75-  
30.70/0.00  
PID No. 93592

NOTES:  
 1. FOR HAUNCH DIAGRAMS AND ADDITIONAL NOTES SEE SHEET 166/216.

Date: Oct 12, 2020, 4:20pm User Name: mlongtin  
 File: \\use.com\files\projects\1321 - Toledo E Value Engineering\DWG\BRIDGE\LUC-75-0027 over Maumee River\Sheets\075\_0027C\_SD041.dwg

HAUNCH ELEVATIONS (NORTHBOUND BRIDGE - UNIT 2)																		
LOCATION		SPAN 3								CL PIER 3	SPAN 4							
		CL BRG. PIER 2	1/8 POINT	1/4 POINT	3/8 POINT	1/2 POINT	5/8 POINT	3/4 POINT	7/8 POINT		1/8 POINT	1/4 POINT	3/8 POINT	1/2 POINT	5/8 POINT	3/4 POINT	7/8 POINT	CL PIER 4
BEAMLINE K	STATION	488+36.98	488+57.56	488+78.14	488+98.72	489+19.30	489+39.88	489+60.47	489+81.05	490+01.63	490+22.38	490+43.13	490+63.88	490+84.63	491+05.38	491+26.13	491+46.88	491+67.63
	OFFSET FROM BL	4.13' RT	4.13' RT	4.13' RT	4.13' RT	4.13' RT	4.13' RT	4.13' RT	4.13' RT	4.13' RT	4.13' RT	4.13' RT	4.13' RT	4.13' RT	4.13' RT	4.13' RT	4.13' RT	4.13' RT
	HAUNCH ELEVATION	631.75	631.79	631.81	631.80	631.76	631.68	631.56	631.42	631.26	631.29	631.31	631.31	631.27	631.18	631.06	630.92	630.76
BEAMLINE L	STATION	488+38.69	488+59.27	488+79.85	489+00.43	489+21.01	489+41.59	489+62.17	489+82.75	490+03.33	490+24.08	490+44.83	490+65.58	490+86.33	491+07.08	491+27.83	491+48.58	491+69.33
	OFFSET FROM BL	13.79' RT	13.79' RT	13.79' RT	13.79' RT	13.79' RT	13.79' RT	13.79' RT	13.79' RT	13.79' RT	13.79' RT	13.79' RT	13.79' RT	13.79' RT	13.79' RT	13.79' RT	13.79' RT	13.79' RT
	HAUNCH ELEVATION	631.90	631.94	631.96	631.95	631.91	631.83	631.71	631.57	631.41	631.44	631.46	631.46	631.42	631.33	631.21	631.07	630.91
BEAMLINE M	STATION	488+40.39	488+60.97	488+81.55	489+02.13	489+22.71	489+43.29	489+63.87	489+84.46	490+05.04	490+25.79	490+46.54	490+67.29	490+88.04	491+08.79	491+29.54	491+50.29	491+71.04
	OFFSET FROM BL	23.46' RT	23.46' RT	23.46' RT	23.46' RT	23.46' RT	23.46' RT	23.46' RT	23.46' RT	23.46' RT	23.46' RT	23.46' RT	23.46' RT	23.46' RT	23.46' RT	23.46' RT	23.46' RT	23.46' RT
	HAUNCH ELEVATION	631.91	631.94	631.96	631.96	631.92	631.83	631.72	631.57	631.41	631.45	631.47	631.46	631.42	631.34	631.22	631.07	630.92
BEAMLINE N	STATION	488+42.09	488+62.68	488+83.26	489+03.84	489+24.42	489+45.00	489+65.58	489+86.16	490+06.74	490+27.49	490+48.24	490+68.99	490+89.74	491+10.49	491+31.24	491+51.99	491+72.74
	OFFSET FROM BL	33.13' RT	33.13' RT	33.13' RT	33.13' RT	33.13' RT	33.13' RT	33.13' RT	33.13' RT	33.13' RT	33.13' RT	33.13' RT	33.13' RT	33.13' RT	33.13' RT	33.13' RT	33.13' RT	33.13' RT
	HAUNCH ELEVATION	631.97	632.01	632.03	632.02	631.98	631.90	631.78	631.64	631.48	631.51	631.53	631.53	631.49	631.40	631.29	631.14	630.98
BEAMLINE O	STATION	488+43.80	488+64.38	488+84.96	489+05.54	489+26.12	489+46.70	489+67.28	489+87.86	490+08.45	490+29.20	490+49.95	490+70.70	490+91.45	491+12.20	491+32.95	491+53.70	491+74.45
	OFFSET FROM BL	42.79' RT	42.79' RT	42.79' RT	42.79' RT	42.79' RT	42.79' RT	42.79' RT	42.79' RT	42.79' RT	42.79' RT	42.79' RT	42.79' RT	42.79' RT	42.79' RT	42.79' RT	42.79' RT	42.79' RT
	HAUNCH ELEVATION	631.81	631.85	631.87	631.86	631.82	631.74	631.62	631.48	631.32	631.35	631.37	631.37	631.33	631.24	631.13	630.98	630.82
BEAMLINE P	STATION	488+45.50	488+66.08	488+86.66	489+07.25	489+27.83	489+48.41	489+68.99	489+89.57	490+10.15	490+30.90	490+51.65	490+72.40	490+93.15	491+13.90	491+34.65	491+55.40	491+76.15
	OFFSET FROM BL	52.46' RT	52.46' RT	52.46' RT	52.46' RT	52.46' RT	52.46' RT	52.46' RT	52.46' RT	52.46' RT	52.46' RT	52.46' RT	52.46' RT	52.46' RT	52.46' RT	52.46' RT	52.46' RT	52.46' RT
	HAUNCH ELEVATION	631.65	631.69	631.71	631.70	631.66	631.58	631.46	631.32	631.16	631.19	631.21	631.21	631.17	631.08	630.97	630.82	630.66
BEAMLINE R	STATION	488+47.21	488+67.79	488+88.37	489+08.95	489+29.53	489+50.11	489+70.69	489+91.27	490+11.85	490+32.60	490+53.35	490+74.10	490+94.85	491+15.60	491+36.35	491+57.10	491+77.85
	OFFSET FROM BL	62.13' RT	62.13' RT	62.13' RT	62.13' RT	62.13' RT	62.13' RT	62.13' RT	62.13' RT	62.13' RT	62.13' RT	62.13' RT	62.13' RT	62.13' RT	62.13' RT	62.13' RT	62.13' RT	62.13' RT
	HAUNCH ELEVATION	631.49	631.53	631.55	631.54	631.50	631.42	631.30	631.16	631.00	631.03	631.05	631.05	631.01	630.92	630.81	630.66	630.50
BEAMLINE S	STATION	488+48.91	488+69.49	488+90.07	489+10.65	489+31.24	489+51.82	489+72.40	489+92.98	490+13.56	490+34.31	490+55.06	490+75.81	490+96.56	491+17.31	491+38.06	491+58.81	491+79.56
	OFFSET FROM BL	71.79' RT	71.79' RT	71.79' RT	71.79' RT	71.79' RT	71.79' RT	71.79' RT	71.79' RT	71.79' RT	71.79' RT	71.79' RT	71.79' RT	71.79' RT	71.79' RT	71.79' RT	71.79' RT	71.79' RT
	HAUNCH ELEVATION	631.33	631.37	631.39	631.38	631.34	631.26	631.14	631.00	630.84	630.87	630.90	630.89	630.85	630.76	630.65	630.50	630.34

5/1/2020 JANSEN & SPAANS ENGINEERING INC. -  
 REPLACED SHEET

DESIGNED WOZ	DRAWN REM	REVIEWED DATE	DESIGN AGENCY DATE
CHECKED CBS	REVISIONS	WOZ 5/20	JANSEN & SPAANS ENGINEERING, INC. 9120 HARRISON PARK COURT INDIANAPOLIS, IN 46216
		STRUCTURE FILE NUMBER 4802765/4802767	

HAUNCH ELEVATIONS - NORTHBOUND - UNIT 2  
 BRIDGE NO. LUC-75-0029 L/R  
 I.R. 75 OVER MAUMEE RIVER

W00/LUC-75-  
 30.70/0.00  
 PID No. 93592

168/216

1461  
 1792

NOTES:  
 1. FOR HAUNCH DIAGRAMS AND ADDITIONAL NOTES SEE SHEET 166/216.

Date: Oct 12, 2020, 3:56pm User Name: mlongtin  
 File: \\usc.com\file\projects\1321 - Toledo E Value Engineering\DWG\BRIDGE\LUC-75-0027 over Maumee River\Sheets\075\_0027C\_SD042.dwg

HAUNCH ELEVATIONS (NORTHBOUND BRIDGE - UNIT 2)																		
LOCATION		CL PIER 4	SPAN 5							CL PIER 5	SPAN 6							
			1/8 POINT	1/4 POINT	3/8 POINT	1/2 POINT	5/8 POINT	3/4 POINT	7/8 POINT		1/8 POINT	1/4 POINT	3/8 POINT	1/2 POINT	5/8 POINT	3/4 POINT	7/8 POINT	CL BRG. PIER 6
BEAMLINE K	STATION	491+67.63	491+88.38	492+09.13	492+29.88	492+50.63	492+71.38	492+92.13	493+12.88	493+33.63	493+54.11	493+74.60	493+95.08	494+15.57	494+36.06	494+56.54	494+77.03	494+97.51
	OFFSET FROM BL	4.13' RT	4.13' RT	4.13' RT	4.13' RT	4.13' RT	4.13' RT	4.13' RT	4.13' RT	4.13' RT	4.13' RT	4.13' RT	4.13' RT	4.13' RT	4.13' RT	4.13' RT	4.13' RT	4.13' RT
	HAUNCH ELEVATION	630.76	630.80	630.82	630.81	630.77	630.68	630.57	630.42	630.26	630.30	630.32	630.31	630.27	630.19	630.07	629.93	629.77
BEAMLINE L	STATION	491+69.33	491+90.08	492+10.83	492+31.58	492+52.33	492+73.08	492+93.83	493+14.58	493+35.33	493+55.82	493+76.30	493+96.79	494+17.27	494+37.76	494+58.25	494+78.73	494+99.22
	OFFSET FROM BL	13.79' RT	13.79' RT	13.79' RT	13.79' RT	13.79' RT	13.79' RT	13.79' RT	13.79' RT	13.79' RT	13.79' RT	13.79' RT	13.79' RT	13.79' RT	13.79' RT	13.79' RT	13.79' RT	13.79' RT
	HAUNCH ELEVATION	630.91	630.94	630.97	630.96	630.92	630.83	630.72	630.57	630.41	630.45	630.47	630.46	630.42	630.34	630.22	630.08	629.92
BEAMLINE M	STATION	491+71.04	491+91.79	492+12.54	492+33.29	492+54.04	492+74.79	492+95.54	493+16.29	493+37.04	493+57.52	493+78.01	493+98.49	494+18.98	494+39.46	494+59.95	494+80.44	495+00.92
	OFFSET FROM BL	23.46' RT	23.46' RT	23.46' RT	23.46' RT	23.46' RT	23.46' RT	23.46' RT	23.46' RT	23.46' RT	23.46' RT	23.46' RT	23.46' RT	23.46' RT	23.46' RT	23.46' RT	23.46' RT	23.46' RT
	HAUNCH ELEVATION	630.92	630.95	630.97	630.96	630.92	630.84	630.72	630.58	630.42	630.45	630.47	630.47	630.43	630.34	630.23	630.08	629.93
BEAMLINE N	STATION	491+72.74	491+93.49	492+14.24	492+34.99	492+55.74	492+76.49	492+97.24	493+17.99	493+38.74	493+59.23	493+79.71	494+00.20	494+20.68	494+41.17	494+61.65	494+82.14	495+02.63
	OFFSET FROM BL	33.13' RT	33.13' RT	33.13' RT	33.13' RT	33.13' RT	33.13' RT	33.13' RT	33.13' RT	33.13' RT	33.13' RT	33.13' RT	33.13' RT	33.13' RT	33.13' RT	33.13' RT	33.13' RT	33.13' RT
	HAUNCH ELEVATION	630.98	631.02	631.04	631.03	630.99	630.90	630.79	630.64	630.48	630.52	630.54	630.53	630.49	630.41	630.29	630.15	629.99
BEAMLINE O	STATION	491+74.45	491+95.20	492+15.95	492+36.70	492+57.45	492+78.20	492+98.95	493+19.70	493+40.45	493+60.93	493+81.42	494+01.90	494+22.39	494+42.87	494+63.36	494+83.84	495+04.33
	OFFSET FROM BL	42.79' RT	42.79' RT	42.79' RT	42.79' RT	42.79' RT	42.79' RT	42.79' RT	42.79' RT	42.79' RT	42.79' RT	42.79' RT	42.79' RT	42.79' RT	42.79' RT	42.79' RT	42.79' RT	42.79' RT
	HAUNCH ELEVATION	630.82	630.86	630.88	630.87	630.83	630.75	630.63	630.48	630.32	630.36	630.38	630.37	630.33	630.25	630.13	629.99	629.83
BEAMLINE P	STATION	491+76.15	491+96.90	492+17.65	492+38.40	492+59.15	492+79.90	493+00.65	493+21.40	493+42.15	493+62.64	493+83.12	494+03.61	494+24.09	494+44.58	494+65.06	494+85.55	495+06.03
	OFFSET FROM BL	52.46' RT	52.46' RT	52.46' RT	52.46' RT	52.46' RT	52.46' RT	52.46' RT	52.46' RT	52.46' RT	52.46' RT	52.46' RT	52.46' RT	52.46' RT	52.46' RT	52.46' RT	52.46' RT	52.46' RT
	HAUNCH ELEVATION	630.66	630.70	630.72	630.71	630.67	630.59	630.47	630.32	630.16	630.20	630.22	630.21	630.17	630.09	629.97	629.83	629.67
BEAMLINE R	STATION	491+77.85	491+98.60	492+19.35	492+40.10	492+60.85	492+81.60	493+02.35	493+23.10	493+43.85	493+64.34	493+84.83	494+05.31	494+25.80	494+46.28	494+66.77	494+87.25	495+07.74
	OFFSET FROM BL	62.13' RT	62.13' RT	62.13' RT	62.13' RT	62.13' RT	62.13' RT	62.13' RT	62.13' RT	62.13' RT	62.13' RT	62.13' RT	62.13' RT	62.13' RT	62.13' RT	62.13' RT	62.13' RT	62.13' RT
	HAUNCH ELEVATION	630.50	630.54	630.56	630.55	630.51	630.43	630.31	630.16	630.00	630.04	630.06	630.05	630.01	629.93	629.81	629.67	629.51
BEAMLINE S	STATION	491+79.56	492+00.31	492+21.06	492+41.81	492+62.56	492+83.31	493+04.06	493+24.81	493+45.56	493+66.04	493+86.53	494+07.02	494+27.50	494+47.99	494+68.47	494+88.96	495+09.44
	OFFSET FROM BL	71.79' RT	71.79' RT	71.79' RT	71.79' RT	71.79' RT	71.79' RT	71.79' RT	71.79' RT	71.79' RT	71.79' RT	71.79' RT	71.79' RT	71.79' RT	71.79' RT	71.79' RT	71.79' RT	71.79' RT
	HAUNCH ELEVATION	630.34	630.38	630.40	630.39	630.35	630.27	630.15	630.00	629.84	629.88	629.90	629.89	629.85	629.77	629.65	629.51	629.35

5/1/2020 JANSSEN & SPAANS ENGINEERING INC. -  
 REPLACED SHEET  
 DESIGN AGENCY  
 JANSSEN & SPAANS ENGINEERING, INC.  
 9120 HARRISON PARK COURT  
 INDIANAPOLIS, IN 46216  
 DATE 5/20  
 REVIEWED  
 STRUCTURE FILE NUMBER 4802765/4802767

DESIGNED  
 WJZ  
 CHECKED  
 CBS

HAUNCH ELEVATIONS - NORTHBOUND-UNIT 2  
 BRIDGE NO. LUC-75-0029 L/R  
 I.R. 75 OVER MAUMEE RIVER

WJZ/LUC-75-  
 30.70/0.00  
 PID No. 93592

169/216  
 1462  
 1792

NOTES:  
 1. FOR HAUNCH DIAGRAM AND ADDITIONAL NOTES SEE SHEET 166/216.



Date: Oct 12, 2020, 3:56pm User Name: mlongtin  
 File: \\jse.com\file\Projects\1321 - Toledo E Value Engineering\DWG\BRIDGE\LUC-75-0027 over Maumee River\Sheets\075\_0027C\_SD043.dwg

LOCATION		SPAN 7									SPAN 8							
		CL BRG. PIER 6	1/8 POINT	1/4 POINT	3/8 POINT	1/2 POINT	5/8 POINT	3/4 POINT	7/8 POINT	CL PIER 7	1/8 POINT	1/4 POINT	3/8 POINT	1/2 POINT	5/8 POINT	3/4 POINT	7/8 POINT	CL PIER 8
BEAMLINE I	STATION	495+01.74	495+22.23	495+42.71	495+63.20	495+83.69	496+04.17	496+24.66	496+45.14	496+65.63	496+86.38	497+07.13	497+27.88	497+48.63	497+69.38	497+90.13	498+10.88	498+31.63
	OFFSET FROM BL	4.13' RT	4.13' RT	4.13' RT	4.13' RT	4.13' RT	4.13' RT	4.13' RT	4.13' RT	4.13' RT	4.13' RT	4.13' RT	4.13' RT	4.13' RT	4.13' RT	4.13' RT	4.13' RT	4.13' RT
	HAUNCH ELEVATION	629.76	629.79	629.81	629.81	629.77	629.69	629.57	629.42	629.27	629.30	629.32	629.31	629.27	629.19	629.07	628.93	628.77
BEAMLINE J	STATION	495+03.45	495+23.93	495+44.42	495+64.90	495+85.39	496+05.88	496+26.36	496+46.85	496+67.33	496+88.08	497+08.83	497+29.58	497+50.33	497+71.08	497+91.83	498+12.58	498+33.33
	OFFSET FROM BL	13.79' RT	13.79' RT	13.79' RT	13.79' RT	13.79' RT	13.79' RT	13.79' RT	13.79' RT	13.79' RT	13.79' RT	13.79' RT	13.79' RT	13.79' RT	13.79' RT	13.79' RT	13.79' RT	13.79' RT
	HAUNCH ELEVATION	629.91	629.95	629.97	629.96	629.92	629.84	629.73	629.58	629.42	629.45	629.47	629.46	629.42	629.34	629.22	629.08	628.92
BEAMLINE K	STATION	495+05.15	495+25.64	495+46.12	495+66.61	495+87.09	496+07.58	496+28.07	496+48.55	496+69.04	496+89.79	497+10.54	497+31.29	497+52.04	497+72.79	497+93.54	498+14.29	498+35.04
	OFFSET FROM BL	23.46' RT	23.46' RT	23.46' RT	23.46' RT	23.46' RT	23.46' RT	23.46' RT	23.46' RT	23.46' RT	23.46' RT	23.46' RT	23.46' RT	23.46' RT	23.46' RT	23.46' RT	23.46' RT	23.46' RT
	HAUNCH ELEVATION	629.91	629.95	629.97	629.96	629.92	629.84	629.72	629.58	629.42	629.46	629.48	629.47	629.43	629.34	629.23	629.08	628.92
BEAMLINE L	STATION	495+06.86	495+27.34	495+47.83	495+68.31	495+88.80	496+09.28	496+29.77	496+50.26	496+70.74	496+91.49	497+12.24	497+32.99	497+53.74	497+74.49	497+95.24	498+15.99	498+36.74
	OFFSET FROM BL	33.13' RT	33.13' RT	33.13' RT	33.13' RT	33.13' RT	33.13' RT	33.13' RT	33.13' RT	33.13' RT	33.13' RT	33.13' RT	33.13' RT	33.13' RT	33.13' RT	33.13' RT	33.13' RT	33.13' RT
	HAUNCH ELEVATION	629.98	630.01	630.04	630.03	629.99	629.91	629.79	629.65	629.49	629.52	629.54	629.54	629.49	629.41	629.29	629.15	628.99
BEAMLINE M	STATION	495+08.56	495+29.05	495+49.53	495+70.02	495+90.50	496+10.99	496+31.47	496+51.96	496+72.45	496+93.20	497+13.95	497+34.70	497+55.45	497+76.20	497+96.95	498+17.70	498+38.45
	OFFSET FROM BL	42.79' RT	42.79' RT	42.79' RT	42.79' RT	42.79' RT	42.79' RT	42.79' RT	42.79' RT	42.79' RT	42.79' RT	42.79' RT	42.79' RT	42.79' RT	42.79' RT	42.79' RT	42.79' RT	42.79' RT
	HAUNCH ELEVATION	629.82	629.85	629.88	629.87	629.83	629.75	629.63	629.49	629.33	629.36	629.38	629.38	629.33	629.25	629.13	628.99	628.83
BEAMLINE N	STATION	495+10.27	495+30.75	495+51.24	495+71.72	495+92.21	496+12.69	496+33.18	496+53.66	496+74.15	496+94.90	497+15.65	497+36.40	497+57.15	497+77.90	497+98.65	498+19.40	498+40.15
	OFFSET FROM BL	52.46' RT	52.46' RT	52.46' RT	52.46' RT	52.46' RT	52.46' RT	52.46' RT	52.46' RT	52.46' RT	52.46' RT	52.46' RT	52.46' RT	52.46' RT	52.46' RT	52.46' RT	52.46' RT	52.46' RT
	HAUNCH ELEVATION	629.66	629.69	629.72	629.71	629.67	629.59	629.47	629.33	629.17	629.20	629.22	629.22	629.17	629.09	628.97	628.83	628.67
BEAMLINE O	STATION	495+11.97	495+32.46	495+52.94	495+73.43	495+93.91	496+14.40	496+34.88	496+55.37	496+75.85	496+96.60	497+17.35	497+38.10	497+58.85	497+79.60	498+00.35	498+21.10	498+41.85
	OFFSET FROM BL	62.13' RT	62.13' RT	62.13' RT	62.13' RT	62.13' RT	62.13' RT	62.13' RT	62.13' RT	62.13' RT	62.13' RT	62.13' RT	62.13' RT	62.13' RT	62.13' RT	62.13' RT	62.13' RT	62.13' RT
	HAUNCH ELEVATION	629.50	629.53	629.56	629.55	629.51	629.43	629.31	629.17	629.01	629.04	629.06	629.06	629.02	628.93	628.81	628.67	628.51
BEAMLINE P	STATION	495+13.67	495+34.16	495+54.65	495+75.13	495+95.62	496+16.10	496+36.59	496+57.07	496+77.56	496+98.31	497+19.06	497+39.81	497+60.56	497+81.31	498+02.06	498+22.81	498+43.56
	OFFSET FROM BL	71.79' RT	71.79' RT	71.79' RT	71.79' RT	71.79' RT	71.79' RT	71.79' RT	71.79' RT	71.79' RT	71.79' RT	71.79' RT	71.79' RT	71.79' RT	71.79' RT	71.79' RT	71.79' RT	71.79' RT
	HAUNCH ELEVATION	629.34	629.38	629.40	629.39	629.35	629.27	629.15	629.01	628.85	628.88	628.90	628.90	628.86	628.77	628.65	628.51	628.35

NOTES:  
 1. FOR HAUNCH DIAGRAM AND ADDITIONAL NOTES SEE SHEET 166/216

3

5/1/2020 JANSSEN & SPAANS ENGINEERING INC. - REPLACED SHEET

DESIGNED	WOZ	30.70/0.00
CHECKED	CBS	
DRAWN	WOZ	
REVIEWED	DATE	5/20
REVISION	WOZ	
STRUCTURE FILE NUMBER		4802765/4802767
DESIGN AGENCY	JANSSEN & SPAANS ENGINEERING, INC. 9120 HARRISON PARK COURT INDIANAPOLIS, IN 46216	


HAUNCH ELEVATIONS - NORTHBOUND - UNIT 3  
 BRIDGE NO. LUC-75-0029 L/R  
 I.R. 75 OVER MAUMEE RIVER

W00/LUC-75-  
 30.70/0.00  
 PID No. 93592


170/216

1463  
 1792


Date: Oct 07, 2020, 4:45pm User Name: mlongtin  
 File: P:\11321 - Toledo E Value Engineering\DWGS\BRIDGE\LUC-75-0027 over Maumee River\Sheets\075\_0027C\_SD056.dwg

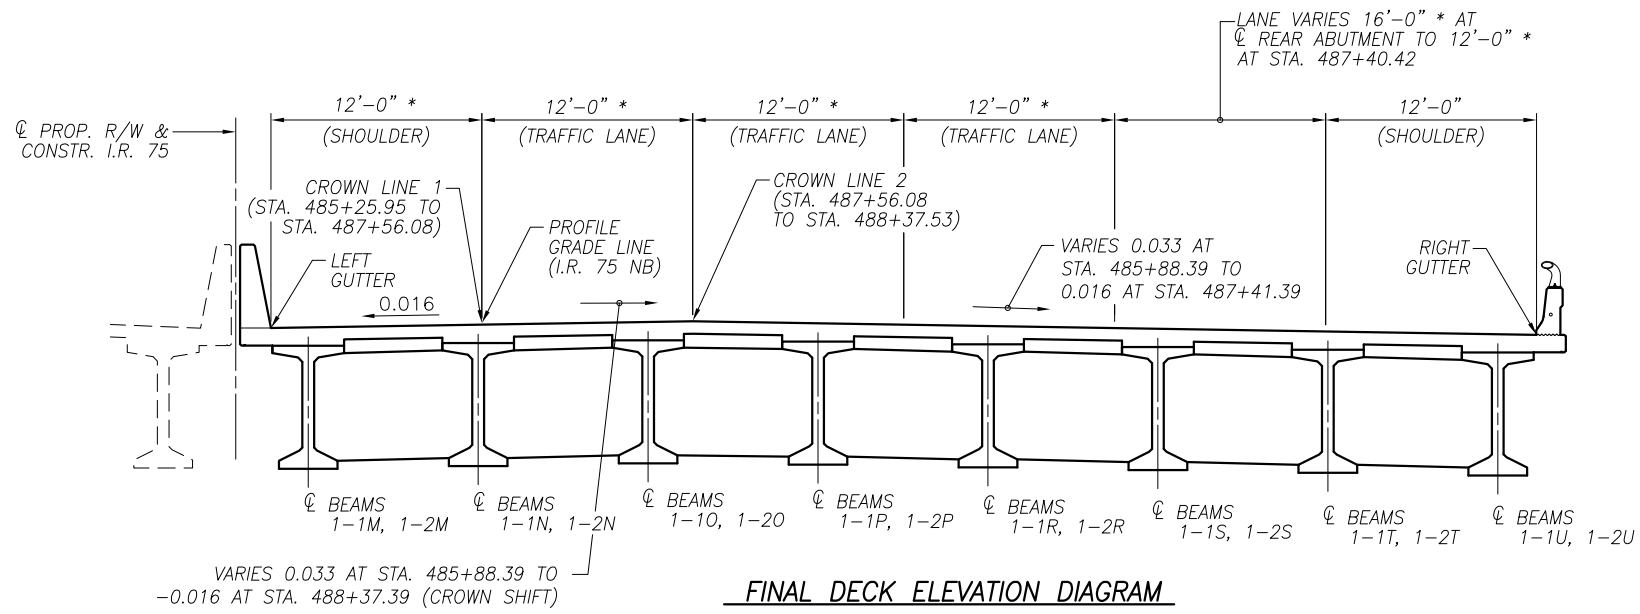

**FINAL DECK ELEVATION DIAGRAM**  
 NORTHBOUND BRIDGE - UNIT 1

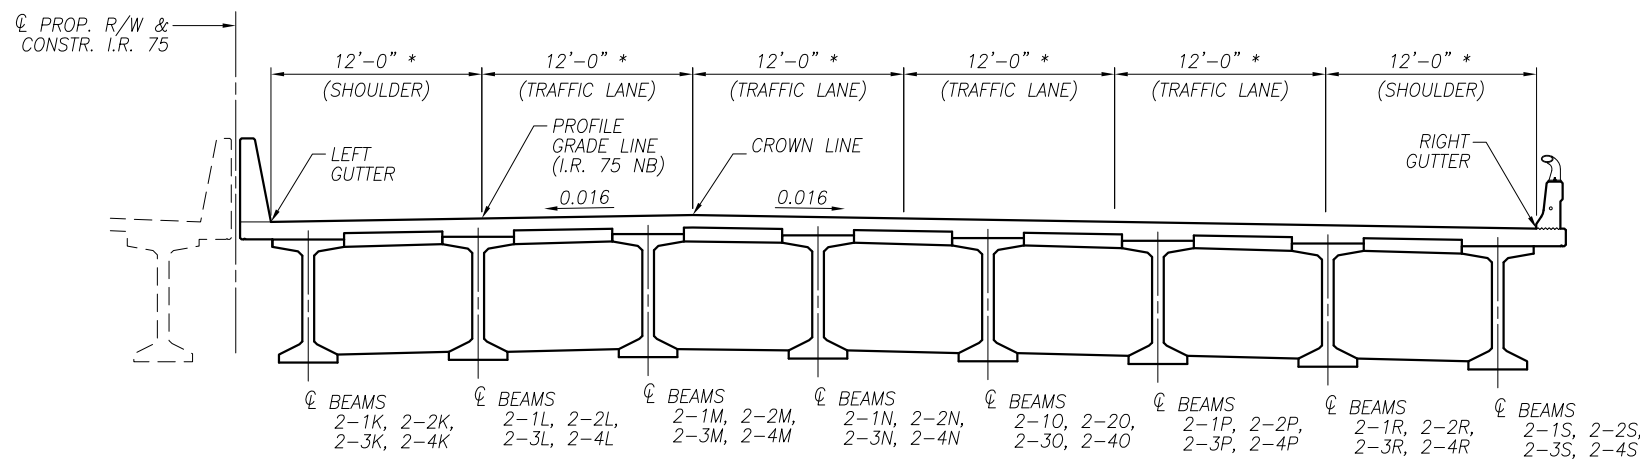

**FINAL DECK ELEVATION DIAGRAM**  
 NORTHBOUND BRIDGE - UNIT 2

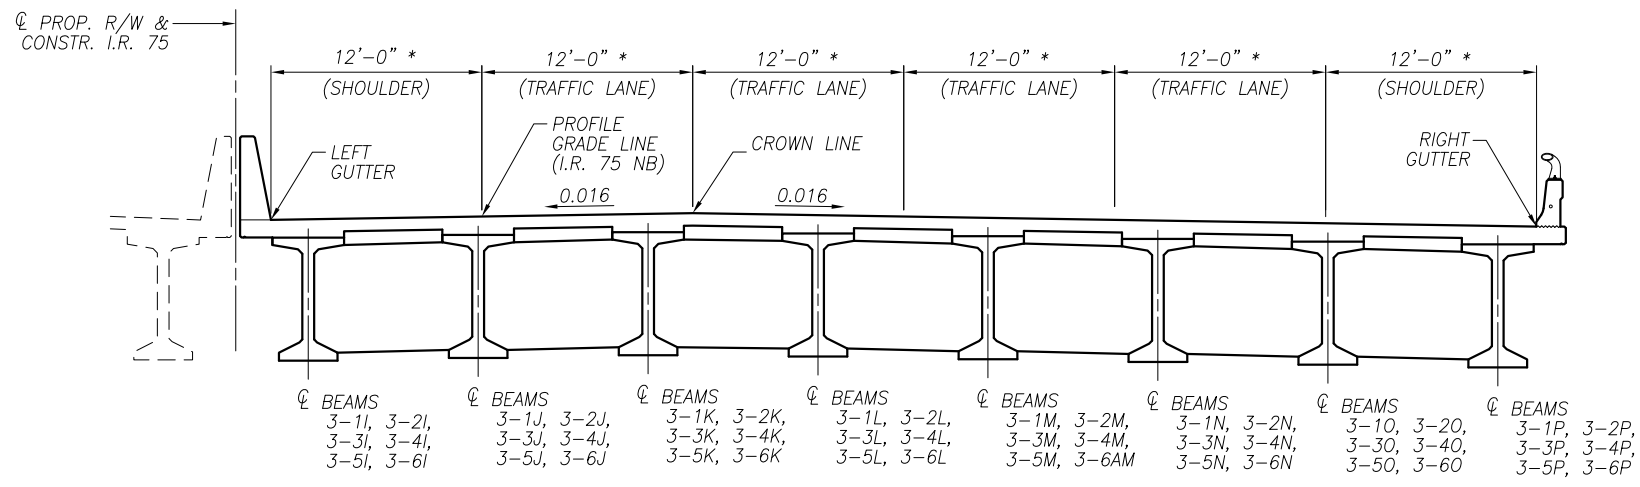

**FINAL DECK ELEVATION DIAGRAM**  
 NORTHBOUND BRIDGE - UNIT 3

**LEGEND:**  
 \* MEASURED PERPENDICULAR TO  
 CL PROP. R/W & CONSTR. I.R. 75

**NOTES:**  
 1. FINAL DECK SURFACE ELEVATIONS SHOWN REPRESENT THE DECK SURFACE LOCATION AFTER ALL ANTICIPATED DEAD LOAD DEFLECTIONS HAVE OCCURED.  
 2. FOR PLAN VIEWS, SEE SHEETS 143/216 THRU 148/216

5/1/2020 JANSSEN & SPAANS ENGINEERING, INC. -  
 RECONFIGURED NORTHBOUND ON RAMP SHEET REPLACED  
 DESIGN AGENCY  
 JANSSEN & SPAANS ENGINEERING, INC.  
 9120 HARRISON PARK COURT  
 INDIANAPOLIS, IN 46216  
 DATE 5/2020  
 W.O.Z. FILE NUMBER 4802765/4802767  
 DRAWN REM W.O.Z. STRUCTURE FILE NUMBER 4802765/4802767  
 DESIGNED W.O.Z. CHECKED CBS

**FINAL DECK ELEVATION DIAGRAMS - NORTHBOUND**  
 BRIDGE NO. LUC-75-0029 L/R  
 I.R. 75 OVER MAUMEE RIVER

W00/LUC-75-  
 30.70/0.00  
 PID No. 93592

183/216  
 1476  
 1792

Date: Oct 12, 2020, 3:57pm User Name: mlongtin  
 File: I:\scc.com\files\Projects\1321 - Toledo E Value Engineering\DWG\BRIDGE\LUC-75-0027 over Maumee River\Sheets\075\_0027C\_SD0057.dwg

FINAL DECK SURFACE ELEVATIONS (NORTHBOUND BRIDGE - UNIT 1)																		
LOCATION		SPAN 1								CL PIER 1	SPAN 2							
		CL BRG. REAR ABUT.	1/8 POINT	1/4 POINT	3/8 POINT	1/2 POINT	5/8 POINT	3/4 POINT	7/8 POINT		1/8 POINT	1/4 POINT	3/8 POINT	1/2 POINT	5/8 POINT	3/4 POINT	7/8 POINT	CL BRG. PIER 2
LEFT GUTTER	STATION	485+24.19	485+42.32	485+60.45	485+78.58	485+96.71	486+14.84	486+32.96	486+51.09	486+69.22	486+89.81	487+10.39	487+30.98	487+51.56	487+72.15	487+92.73	488+13.32	488+33.90
	OFFSET FROM BL	2.00' RT	2.00' RT	2.00' RT	2.00' RT	2.00' RT	2.00' RT	2.00' RT	2.00' RT	2.00' RT	2.00' RT	2.00' RT	2.00' RT	2.00' RT	2.00' RT	2.00' RT	2.00' RT	2.00' RT
	FINAL DECK ELEVATION	633.37	633.31	633.26	633.20	633.15	633.09	633.04	632.98	632.93	632.87	632.81	632.75	632.68	632.62	632.56	632.50	632.44
BEAMLINE M	STATION	485+24.50	485+42.67	485+60.82	485+78.97	485+97.10	486+15.23	486+33.35	486+51.46	486+69.56	486+90.16	487+10.74	487+31.33	487+51.92	487+72.51	487+93.10	488+13.69	488+34.28
	OFFSET FROM BL	4.13' RT	4.32' RT	4.47' RT	4.55' RT	4.58' RT	4.54' RT	4.46' RT	4.31' RT	4.11' RT	4.15' RT	4.15' RT	4.14' RT	4.14' RT	4.14' RT	4.13' RT	4.13' RT	4.13' RT
	FINAL DECK ELEVATION	633.40	633.35	633.30	633.24	633.19	633.13	633.08	633.02	632.96	632.90	632.84	632.78	632.72	632.65	632.59	632.53	632.47
PROFILE GRADE	STATION	485+25.95	485+44.10	485+62.25	485+80.40	485+98.55	486+16.70	486+34.85	486+53.00	486+71.15	486+91.75	487+12.36	487+32.97	487+53.58	487+74.19	487+94.80	488+15.41	488+36.02
	OFFSET FROM BL	14.00' RT	14.00' RT	14.00' RT	14.00' RT	14.00' RT	14.00' RT	14.00' RT	14.00' RT	14.00' RT	14.00' RT	14.00' RT	14.00' RT	14.00' RT	14.00' RT	14.00' RT	14.00' RT	14.00' RT
	FINAL DECK ELEVATION	633.55	633.50	633.44	633.39	633.33	633.28	633.23	633.17	633.12	633.05	632.99	632.93	632.87	632.81	632.75	632.68	632.62
BEAMLINE N	STATION	485+26.01	485+44.17	485+62.33	485+80.49	485+98.63	486+16.76	486+34.89	486+53.00	486+71.11	486+91.72	487+12.33	487+32.94	487+53.55	487+74.16	487+94.76	488+15.37	488+35.98
	OFFSET FROM BL	14.38' RT	14.50' RT	14.57' RT	14.58' RT	14.54' RT	14.43' RT	14.27' RT	14.05' RT	13.78' RT	13.82' RT	13.82' RT	13.81' RT	13.81' RT	13.81' RT	13.80' RT	13.80' RT	13.80' RT
	FINAL DECK ELEVATION	633.54	633.48	633.42	633.37	633.32	633.27	633.22	633.17	633.11	633.05	632.99	632.93	632.87	632.80	632.74	632.68	632.62
BEAMLINE O	STATION	485+27.51	485+45.68	485+63.85	485+82.01	486+00.16	486+18.30	486+36.43	486+54.55	486+72.66	486+93.29	487+13.92	487+34.55	487+55.18	487+75.80	487+96.43	488+17.06	488+37.69
	OFFSET FROM BL	24.63' RT	24.67' RT	24.68' RT	24.61' RT	24.50' RT	24.31' RT	24.09' RT	23.79' RT	23.44' RT	23.48' RT	23.48' RT	23.47' RT	23.47' RT	23.47' RT	23.46' RT	23.46' RT	23.46' RT
	FINAL DECK ELEVATION	633.52	633.46	633.40	633.35	633.30	633.25	633.21	633.16	633.10	633.05	632.99	632.92	632.86	632.80	632.74	632.68	632.62
CROWN LINE	STATION	485+27.71	485+45.88	485+64.05	485+82.22	486+00.39	486+18.56	486+36.73	486+54.90	486+73.07	486+93.70	487+14.34	487+34.97	487+55.60	487+76.23	487+96.87	488+17.50	488+38.13
	OFFSET FROM BL	26.00' RT	26.00' RT	26.00' RT	26.00' RT	26.00' RT	26.00' RT	26.00' RT	26.00' RT	26.00' RT	26.00' RT	26.00' RT	26.00' RT	26.00' RT	26.00' RT	26.00' RT	26.00' RT	26.00' RT
	FINAL DECK ELEVATION	633.15	633.10	633.04	632.99	632.96	632.95	632.94	632.93	632.91	632.90	632.89	632.88	632.86	632.85	632.84	632.82	632.81
BEAMLINE P	STATION	485+29.01	485+47.19	485+65.36	485+83.53	486+01.69	486+19.83	486+37.97	486+56.09	486+74.21	486+94.86	487+15.51	487+36.16	487+56.80	487+77.45	487+98.10	488+18.74	488+39.39
	OFFSET FROM BL	34.88' RT	34.85' RT	34.78' RT	34.64' RT	34.46' RT	34.20' RT	33.90' RT	33.53' RT	33.11' RT	33.15' RT	33.15' RT	33.14' RT	33.14' RT	33.14' RT	33.13' RT	33.13' RT	33.13' RT
	FINAL DECK ELEVATION	632.85	632.80	632.75	632.70	632.69	632.71	632.72	632.73	632.75	632.75	632.75	632.75	632.76	632.75	632.73	632.72	632.71
BEAMLINE R	STATION	485+30.51	485+48.70	485+66.88	485+85.05	486+03.21	486+21.36	486+39.51	486+57.64	486+75.76	486+96.43	487+17.10	487+37.76	487+58.43	487+79.10	487+99.76	488+20.43	488+41.10
	OFFSET FROM BL	45.13' RT	45.03' RT	44.89' RT	44.68' RT	44.41' RT	44.08' RT	43.71' RT	43.27' RT	42.78' RT	42.82' RT	42.81' RT	42.81' RT	42.81' RT	42.81' RT	42.80' RT	42.80' RT	42.80' RT
	FINAL DECK ELEVATION	632.51	632.46	632.41	632.36	632.38	632.42	632.45	632.49	632.52	632.55	632.57	632.57	632.60	632.59	632.58	632.57	632.55
BEAMLINE S	STATION	485+32.01	485+50.20	485+68.39	485+86.57	486+04.74	486+22.90	486+41.05	486+59.18	486+77.31	486+98.00	487+18.69	487+39.37	487+60.06	487+80.74	488+01.43	488+22.11	488+42.80
	OFFSET FROM BL	55.38' RT	55.21' RT	54.99' RT	54.71' RT	54.37' RT	53.97' RT	53.52' RT	53.01' RT	52.44' RT	52.48' RT	52.48' RT	52.47' RT	52.47' RT	52.47' RT	52.46' RT	52.46' RT	52.46' RT
	FINAL DECK ELEVATION	632.17	632.12	632.07	632.03	632.07	632.13	632.19	632.24	632.30	632.35	632.40	632.44	632.44	632.42	632.41	632.40	632.37
BEAMLINE T	STATION	485+33.51	485+51.71	485+69.91	485+88.09	486+06.27	486+24.43	486+42.59	486+60.73	486+78.86	486+99.57	487+20.28	487+40.98	487+61.69	487+82.39	488+03.09	488+23.80	488+44.50
	OFFSET FROM BL	65.63' RT	65.38' RT	65.10' RT	64.74' RT	64.33' RT	63.85' RT	63.34' RT	62.75' RT	62.11' RT	62.15' RT	62.15' RT	62.14' RT	62.14' RT	62.14' RT	62.13' RT	62.13' RT	62.13' RT
	FINAL DECK ELEVATION	631.83	631.78	631.73	631.69	631.77	631.85	631.93	632.01	632.08	632.15	632.22	632.29	632.28	632.27	632.25	632.24	632.21
BEAMLINE U	STATION	485+35.01	485+53.22	485+71.42	485+89.61	486+07.80	486+25.97	486+44.13	486+62.27	486+80.41	487+01.14	487+21.87	487+42.59	487+63.31	487+84.04	488+04.76	488+25.48	488+46.21
	OFFSET FROM BL	75.88' RT	75.56' RT	75.20' RT	74.77' RT	74.29' RT	73.74' RT	73.15' RT	72.49' RT	71.78' RT	71.82' RT	71.82' RT	71.81' RT	71.81' RT	71.81' RT	71.80' RT	71.80' RT	71.80' RT
	FINAL DECK ELEVATION	631.48	631.44	631.40	631.37	631.47	631.57	631.67	631.77	631.87	631.96	632.05	632.14	632.12	632.11	632.10	632.08	632.05
RIGHT GUTTER	STATION	485+34.74	485+52.99	485+71.24	485+89.50	486+07.75	486+26.01	486+44.26	486+62.51	486+80.77	487+01.50	487+22.23	487+42.95	487+63.68	487+84.41	488+05.14	488+25.87	488+46.60
	OFFSET FROM BL	78.06' RT	77.96' RT	77.83' RT	77.63' RT	77.38' RT	77.05' RT	76.69' RT	76.26' RT	75.77' RT	75.18' RT	74.54' RT	74.01' RT	74.01' RT	74.01' RT	74.00' RT	74.00' RT	74.00' RT
	FINAL DECK ELEVATION	631.41	631.36	631.31	631.27	631.37	631.47	631.58	631.68	631.78	631.89	632.00	632.10	632.09	632.08	632.06	632.05	632.01

5/1/2020 JANSSEN & SPAANS ENGINEERING, INC. -  
 REPLACED SHEET

DESIGN AGENCY  
 JANSSEN & SPAANS ENGINEERING, INC.  
 9120 HARRISON PARK COURT  
 INDIANAPOLIS, IN 46216

DRAWN  
 WJZ  
 REM  
 CHECKED  
 CBS

DATE  
 5/2020  
 WJZ  
 STRUCTURE FILE NUMBER  
 4802765/4802767

FINAL DECK ELEVATIONS - NORTHBOUND - UNIT 1  
 BRIDGE NO. LUC-75-0029 L/R  
 I.R. 75 OVER MAUMEE RIVER

WJZ/LUC-75-  
 30.70/0.00  
 PID No. 93592

184/216

1477  
1792

NOTE:  
 1. FOR FINAL DECK ELEVATION DIAGRAMS AND  
 ADDITIONAL NOTES, SEE SHEET 183/216.

FINAL DECK SURFACE ELEVATIONS (NORTHBOUND BRIDGE - UNIT 1)

SPAN 2										SPAN 2 (CONTINUED)											
LOCATION	☉ PIER 1	1/8 POINT	1/4 POINT	3/8 POINT	1/2 POINT	5/8 POINT	3/4 POINT	7/8 POINT	☉ BRG. PIER 2	LOCATION	☉ PIER 1	1/8 POINT	1/4 POINT	3/8 POINT	1/2 POINT	5/8 POINT	3/4 POINT	7/8 POINT	☉ BRG. PIER 2		
LEFT GUTTER	STATION	486+69.24	486+89.99	487+10.74	487+31.49	487+52.24	487+72.99	487+93.74	488+14.50	488+33.31	BEAM 1-2P	STATION	486+74.44	486+95.28	487+16.03	487+36.78	487+57.53	487+78.28	487+99.03	488+19.78	488+38.58
	OFFSET FROM ☉	2.00' RT.	2.00' RT.	2.00' RT.	2.00' RT.	2.00' RT.	2.00' RT.	2.00' RT.	2.00' RT.	2.00' RT.		31.96' RT.	31.97' RT.	31.97' RT.	31.97' RT.	31.97' RT.	31.97' RT.	31.97' RT.	31.97' RT.	31.96' RT.	31.96' RT.
	FINAL DECK EL.	632.53	632.87	632.81	632.74	632.68	632.62	632.56	632.49	632.44		632.69	632.66	632.64	632.62	632.63	632.66	632.68	632.70	632.71	632.71
BEAM 1-2M	STATION	486+69.60	486+89.37	487+11.12	487+31.87	487+52.62	487+73.37	487+94.12	488+14.87	488+33.67	BEAM 1-2R	STATION	486+76.06	486+96.91	487+17.66	487+38.41	487+59.16	487+79.91	488+00.66	488+21.41	488+40.22
	OFFSET FROM ☉	4.11' RT.	4.15' RT.	4.15' RT.	4.14' RT.	4.14' RT.	4.14' RT.	4.13' RT.	4.13' RT.	4.13' RT.		41.22' RT.	41.25' RT.	41.25' RT.	41.25' RT.	41.24' RT.	41.24' RT.	41.24' RT.	41.24' RT.	41.24' RT.	
	FINAL DECK EL.	632.96	632.90	632.84	632.78	632.71	632.65	632.59	632.53	632.47		632.47	632.47	632.47	632.47	632.47	632.51	632.53	632.55	632.56	
BEAM 1-2N	STATION	486+71.21	486+92.01	487+12.81	487+33.51	487+54.26	487+75.01	487+95.76	488+16.51	488+35.31	BEAM 1-2S	STATION	486+77.69	486+98.55	487+19.30	487+40.05	487+60.80	487+81.55	488+02.30	488+23.05	488+41.85
	OFFSET FROM ☉	13.40' RT.	13.43' RT.	13.42' RT.	13.42' RT.	13.41' RT.	13.41' RT.	13.41' RT.	13.40' RT.	13.40' RT.		50.51' RT.	50.52' RT.	50.52' RT.	50.52' RT.	50.52' RT.	50.52' RT.	50.52' RT.	50.52' RT.	50.51' RT.	
	FINAL DECK EL.	633.11	633.04	632.98	632.93	632.86	632.80	632.73	632.67	632.61		632.25	632.28	632.30	632.32	632.34	632.36	632.38	632.40	632.40	
PROFILE GRADE LINE / CROWN LINE 1	STATION	486+71.32	486+92.11	487+12.86	487+33.61	487+54.36	487+75.11	487+95.86	488+16.61	488+35.40	BEAM 1-2T	STATION	486+79.32	487+00.18	487+21.03	487+41.68	487+62.43	487+83.18	488+03.94	488+24.69	488+43.49
	OFFSET FROM ☉	14.00' RT.	14.00' RT.	14.00' RT.	14.00' RT.	14.00' RT.	14.00' RT.	14.00' RT.	14.00' RT.	14.00' RT.		59.77' RT.	59.80' RT.	59.80' RT.	59.80' RT.	59.79' RT.	59.79' RT.	59.79' RT.	59.79' RT.		
	FINAL DECK EL.	633.12	633.05	632.99	632.93	632.87	632.80	632.74	632.68	632.62		632.04	632.07	632.13	632.17	632.19	632.21	632.24	632.26	632.25	
BEAM 1-2O	STATION	486+72.82	486+93.64	487+14.39	487+35.14	487+55.89	487+76.64	487+97.39	488+18.14	488+36.95	RIGHT GUTTER	STATION	486+79.71	487+00.57	487+21.32	487+42.07	487+62.82	487+83.57	488+04.32	488+25.08	488+43.88
	OFFSET FROM ☉	22.67' RT.	22.70' RT.	22.70' RT.	22.69' RT.	22.69' RT.	22.69' RT.	22.68' RT.	22.68' RT.	22.68' RT.		62.00' RT.	62.00' RT.	62.00' RT.	62.00' RT.	62.00' RT.	62.00' RT.	62.00' RT.	62.00' RT.		
	FINAL DECK EL.	632.91	632.86	632.82	632.78	632.77	632.76	632.76	632.76	632.76		632.99	632.04	632.09	632.14	632.16	632.18	632.20	632.22	632.21	
CROWN LINE 2	STATION	486+73.40	486+94.22	487+14.97	487+35.72	487+56.48	487+77.23	487+97.98	488+18.73	488+37.53	RIGHT GUTTER	STATION	486+79.71	487+00.57	487+21.32	487+42.07	487+62.82	487+83.57	488+04.32	488+25.08	488+43.88
	OFFSET FROM ☉	26.00' RT.	26.00' RT.	26.00' RT.	26.00' RT.	26.00' RT.	26.00' RT.	26.00' RT.	26.00' RT.	26.00' RT.		62.00' RT.	62.00' RT.	62.00' RT.	62.00' RT.	62.00' RT.	62.00' RT.	62.00' RT.	62.00' RT.		
	FINAL DECK EL.	632.83	632.79	632.76	632.72	632.73	632.75	632.77	632.79	632.81		632.99	632.04	632.09	632.14	632.16	632.18	632.20	632.22	632.21	

Date: Oct 08, 2020, 4:33pm User Name: mlongtin  
 File: P:\1321 - Toledo E Value Engineering\DWG\BRIDGE\LUC-75-0027 over Maumee River\Sheets\072\_0027C\_S0058.dwg

5/1/2020 JANSSEN & SPAANS ENGINEERING INC. - REPLACED SHEET

FINAL DECK ELEVATIONS - NORTHBOUND-UNIT 1  
 BRIDGE NO. LUC-75-0029 L/R  
 I.R. 75 OVER MAUMEE RIVER

W00/LUC-75-30.70/0.00  
 PID No. 93592

185/216

1478  
1792

NOTE:  
 1. FOR FINAL DECK ELEVATION DIAGRAMS AND  
 ADDITIONAL NOTES, SEE SHEET 183/216

DESIGN AGENCY  
 654 WHITE POND DRIVE  
 AKRON, OHIO 44320-1100  
**AECOM**  
 (330) 836-9111

DATE  
8/18  
REVIEWED  
JTH  
STRUCTURE FILE NUMBER  
4802765/480276

DRAWN  
TMR  
DESIGNED  
DEB  
CHECKED  
MRW

Date: Oct 12, 2020, 3:57pm User Name: mlongtin  
 File: \\bsc.com\files\Projects\1321 - Toledo E Value Engineering\DWG\BRIDGE\LUC-75-0027 over Maumee River\Sheets\075\_0027C\_SD059.dwg

FINAL DECK SURFACE ELEVATIONS (NORTHBOUND BRIDGE - UNIT 2)																		
LOCATION		SPAN 3								CL PIER 3	SPAN 4							CL PIER 4
		CL BRG PIER 2	1/8 POINT	1/4 POINT	3/8 POINT	1/2 POINT	5/8 POINT	3/4 POINT	7/8 POINT		1/8 POINT	1/4 POINT	3/8 POINT	1/2 POINT	5/8 POINT	3/4 POINT	7/8 POINT	
LEFT GUTTER	STATION	488+36.61	488+57.19	488+77.77	488+98.35	489+18.93	489+39.51	489+60.09	489+80.67	490+01.25	490+22.00	490+42.75	490+63.50	490+84.25	491+05.00	491+25.75	491+46.50	491+67.25
	OFFSET FROM BL	2.00' RT	2.00' RT	2.00' RT	2.00' RT	2.00' RT	2.00' RT	2.00' RT	2.00' RT	2.00' RT	2.00' RT	2.00' RT	2.00' RT	2.00' RT	2.00' RT	2.00' RT	2.00' RT	2.00' RT
	FINAL DECK ELEVATION	632.43	632.37	632.30	632.24	632.18	632.12	632.06	632.00	631.93	631.87	631.81	631.75	631.69	631.62	631.56	631.50	631.44
BEAMLINE K	STATION	488+36.98	488+57.56	488+78.14	488+98.72	489+19.30	489+39.88	489+60.47	489+81.05	490+01.63	490+22.38	490+43.13	490+63.88	490+84.63	491+05.38	491+26.13	491+46.88	491+67.63
	OFFSET FROM BL	4.13' RT	4.13' RT	4.13' RT	4.13' RT	4.13' RT	4.13' RT	4.13' RT	4.13' RT	4.13' RT	4.13' RT	4.13' RT	4.13' RT	4.13' RT	4.13' RT	4.13' RT	4.13' RT	4.13' RT
	FINAL DECK ELEVATION	632.46	632.40	632.34	632.28	632.21	632.15	632.09	632.03	631.97	631.90	631.84	631.78	631.72	631.66	631.59	631.53	631.47
PROFILE GRADE	STATION	488+38.72	488+59.30	488+79.88	489+00.46	489+21.05	489+41.63	489+62.21	489+82.79	490+03.37	490+24.12	490+44.87	490+65.62	490+86.37	491+07.12	491+27.87	491+48.62	491+69.37
	OFFSET FROM BL	14.00' RT	14.00' RT	14.00' RT	14.00' RT	14.00' RT	14.00' RT	14.00' RT	14.00' RT	14.00' RT	14.00' RT	14.00' RT	14.00' RT	14.00' RT	14.00' RT	14.00' RT	14.00' RT	14.00' RT
	FINAL DECK ELEVATION	632.61	632.55	632.49	632.43	632.37	632.31	632.24	632.18	632.12	632.06	632.00	631.93	631.87	631.81	631.75	631.68	631.62
BEAMLINE L	STATION	488+38.69	488+59.27	488+79.85	489+00.43	489+21.01	489+41.59	489+62.17	489+82.75	490+03.33	490+24.08	490+44.83	490+65.58	490+86.33	491+07.08	491+27.83	491+48.58	491+69.33
	OFFSET FROM BL	13.79' RT	13.79' RT	13.79' RT	13.79' RT	13.79' RT	13.79' RT	13.79' RT	13.79' RT	13.79' RT	13.79' RT	13.79' RT	13.79' RT	13.79' RT	13.79' RT	13.79' RT	13.79' RT	13.79' RT
	FINAL DECK ELEVATION	632.61	632.55	632.49	632.43	632.36	632.30	632.24	632.18	632.12	632.05	631.99	631.93	631.87	631.81	631.74	631.68	631.62
BEAMLINE M	STATION	488+40.39	488+60.97	488+81.55	489+02.13	489+22.71	489+43.29	489+63.87	489+84.46	490+05.04	490+25.79	490+46.54	490+67.29	490+88.04	491+08.79	491+29.54	491+50.29	491+71.04
	OFFSET FROM BL	23.46' RT	23.46' RT	23.46' RT	23.46' RT	23.46' RT	23.46' RT	23.46' RT	23.46' RT	23.46' RT	23.46' RT	23.46' RT	23.46' RT	23.46' RT	23.46' RT	23.46' RT	23.46' RT	23.46' RT
	FINAL DECK ELEVATION	632.62	632.55	632.49	632.43	632.37	632.31	632.25	632.18	632.12	632.06	632.00	631.93	631.87	631.81	631.75	631.69	631.62
CROWN LINE	STATION	488+40.84	488+61.42	488+82.00	489+02.58	489+23.16	489+43.74	489+64.32	489+84.90	490+05.48	490+26.23	490+46.98	490+67.73	490+88.48	491+09.23	491+29.98	491+50.73	491+71.48
	OFFSET FROM BL	26.00' RT	26.00' RT	26.00' RT	26.00' RT	26.00' RT	26.00' RT	26.00' RT	26.00' RT	26.00' RT	26.00' RT	26.00' RT	26.00' RT	26.00' RT	26.00' RT	26.00' RT	26.00' RT	26.00' RT
	FINAL DECK ELEVATION	632.80	632.74	632.68	632.61	632.55	632.49	632.43	632.37	632.31	632.24	632.18	632.12	632.06	631.99	631.93	631.87	631.81
BEAMLINE N	STATION	488+42.09	488+62.68	488+83.26	489+03.84	489+24.42	489+45.00	489+65.58	489+86.16	490+06.74	490+27.49	490+48.24	490+68.99	490+89.74	491+10.49	491+31.24	491+51.99	491+72.74
	OFFSET FROM BL	33.13' RT	33.13' RT	33.13' RT	33.13' RT	33.13' RT	33.13' RT	33.13' RT	33.13' RT	33.13' RT	33.13' RT	33.13' RT	33.13' RT	33.13' RT	33.13' RT	33.13' RT	33.13' RT	33.13' RT
	FINAL DECK ELEVATION	632.68	632.62	632.56	632.50	632.43	632.37	632.31	632.25	632.19	632.13	632.06	632.00	631.94	631.88	631.81	631.75	631.69
BEAMLINE O	STATION	488+43.80	488+64.38	488+84.96	489+05.54	489+26.12	489+46.70	489+67.28	489+87.86	490+08.45	490+29.20	490+49.95	490+70.70	490+91.45	491+12.20	491+32.95	491+53.70	491+74.45
	OFFSET FROM BL	42.79' RT	42.79' RT	42.79' RT	42.79' RT	42.79' RT	42.79' RT	42.79' RT	42.79' RT	42.79' RT	42.79' RT	42.79' RT	42.79' RT	42.79' RT	42.79' RT	42.79' RT	42.79' RT	42.79' RT
	FINAL DECK ELEVATION	632.52	632.46	632.40	632.34	632.27	632.21	632.15	632.09	632.03	631.97	631.90	631.84	631.78	631.72	631.65	631.59	631.53
BEAMLINE P	STATION	488+45.50	488+66.08	488+86.66	489+07.25	489+27.83	489+48.41	489+68.99	489+89.57	490+10.15	490+30.90	490+51.65	490+72.40	490+93.15	491+13.90	491+34.65	491+55.40	491+76.15
	OFFSET FROM BL	52.46' RT	52.46' RT	52.46' RT	52.46' RT	52.46' RT	52.46' RT	52.46' RT	52.46' RT	52.46' RT	52.46' RT	52.46' RT	52.46' RT	52.46' RT	52.46' RT	52.46' RT	52.46' RT	52.46' RT
	FINAL DECK ELEVATION	632.36	632.30	632.24	632.18	632.12	632.05	631.99	631.93	631.87	631.81	631.74	631.68	631.62	631.56	631.49	631.43	631.37
BEAMLINE R	STATION	488+47.21	488+67.79	488+88.37	489+08.95	489+29.53	489+50.11	489+70.69	489+91.27	490+11.85	490+32.60	490+53.35	490+74.10	490+94.85	491+15.60	491+36.35	491+57.10	491+77.85
	OFFSET FROM BL	62.13' RT	62.13' RT	62.13' RT	62.13' RT	62.13' RT	62.13' RT	62.13' RT	62.13' RT	62.13' RT	62.13' RT	62.13' RT	62.13' RT	62.13' RT	62.13' RT	62.13' RT	62.13' RT	62.13' RT
	FINAL DECK ELEVATION	632.20	632.14	632.08	632.02	631.96	631.89	631.83	631.77	631.71	631.65	631.58	631.52	631.46	631.40	631.33	631.27	631.21
BEAMLINE S	STATION	488+48.91	488+69.49	488+90.07	489+10.65	489+31.24	489+51.82	489+72.40	489+92.98	490+13.56	490+34.31	490+55.06	490+75.81	490+96.56	491+17.31	491+38.06	491+58.81	491+79.56
	OFFSET FROM BL	71.79' RT	71.79' RT	71.79' RT	71.79' RT	71.79' RT	71.79' RT	71.79' RT	71.79' RT	71.79' RT	71.79' RT	71.79' RT	71.79' RT	71.79' RT	71.79' RT	71.79' RT	71.79' RT	71.79' RT
	FINAL DECK ELEVATION	632.04	631.98	631.92	631.86	631.80	631.73	631.67	631.61	631.55	631.49	631.42	631.36	631.30	631.24	631.18	631.11	631.05
RIGHT GUTTER	STATION	488+49.30	488+69.88	488+90.46	489+11.04	489+31.62	489+52.21	489+72.79	489+93.37	490+13.95	490+34.70	490+55.45	490+76.20	490+96.95	491+17.70	491+38.45	491+59.20	491+79.95
	OFFSET FROM BL	74.00' RT	74.00' RT	74.00' RT	74.00' RT	74.00' RT	74.00' RT	74.00' RT	74.00' RT	74.00' RT	74.00' RT	74.00' RT	74.00' RT	74.00' RT	74.00' RT	74.00' RT	74.00' RT	74.00' RT
	FINAL DECK ELEVATION	632.01	631.94	631.88	631.82	631.76	631.70	631.64	631.57	631.51	631.45	631.39	631.33	631.26	631.20	631.14	631.08	631.01

5/1/2020 JANSSEN & SPAANS ENGINEERING INC. -  
 REPLACED SHEET

DESIGNED WOZ	DRAWN REM	REVIEWED WOZ	DATE 5/20
CHECKED CBS	DESIGN AGENCY JANSSEN & SPAANS ENGINEERING, INC. 9120 HARRISON PARK COURT INDIANAPOLIS, IN 46216		
FINAL DECK ELEVATIONS - NORTHBOUND - UNIT 2 BRIDGE NO. LUC-75-0029 L/R I.R. 75 OVER MAUMEE RIVER			
W00/LUC-75- 30.70/0.00 PID No. 93592		186/216	

NOTE:  
 1. FOR FINAL DECK ELEVATION DIAGRAMS AND  
 ADDITIONAL NOTES, SEE SHEET 183/216.

1479  
 1792

FINAL DECK SURFACE ELEVATIONS (NORTHBOUND BRIDGE - UNIT 2)																		
LOCATION		CL PIER 4	SPAN 5							CL PIER 5	SPAN 6							
			1/8 POINT	1/4 POINT	3/8 POINT	1/2 POINT	5/8 POINT	3/4 POINT	7/8 POINT		1/8 POINT	1/4 POINT	3/8 POINT	1/2 POINT	5/8 POINT	3/4 POINT	7/8 POINT	CL BRG. PIER 6
LEFT GUTTER	STATION	491+67.25	491+88.00	492+08.75	492+29.50	492+50.25	492+71.00	492+91.75	493+12.50	493+33.25	493+53.74	493+74.22	493+94.71	494+15.19	494+35.68	494+56.17	494+76.65	494+97.14
	OFFSET FROM BL	2.00' RT	2.00' RT	2.00' RT	2.00' RT	2.00' RT	2.00' RT	2.00' RT	2.00' RT	2.00' RT	2.00' RT	2.00' RT	2.00' RT	2.00' RT	2.00' RT	2.00' RT	2.00' RT	2.00' RT
	FINAL DECK ELEVATION	631.44	631.37	631.31	631.25	631.19	631.12	631.06	631.00	630.94	630.88	630.82	630.75	630.69	630.63	630.57	630.51	630.45
BEAMLINE K	STATION	491+67.63	491+88.38	492+09.13	492+29.88	492+50.63	492+71.38	492+92.13	493+12.88	493+33.63	493+54.11	493+74.60	493+95.08	494+15.57	494+36.06	494+56.54	494+77.03	494+97.51
	OFFSET FROM BL	4.13' RT	4.13' RT	4.13' RT	4.13' RT	4.13' RT	4.13' RT	4.13' RT	4.13' RT	4.13' RT	4.13' RT	4.13' RT	4.13' RT	4.13' RT	4.13' RT	4.13' RT	4.13' RT	4.13' RT
	FINAL DECK ELEVATION	631.47	631.41	631.34	631.28	631.22	631.16	631.10	631.03	630.97	630.91	630.85	630.79	630.73	630.66	630.60	630.54	630.48
PROFILE GRADE	STATION	491+69.37	491+90.12	492+10.87	492+31.62	492+52.37	492+73.12	492+93.87	493+14.62	493+35.37	493+55.85	493+76.34	493+96.83	494+17.31	494+37.80	494+58.28	494+78.77	494+99.25
	OFFSET FROM BL	14.00' RT	14.00' RT	14.00' RT	14.00' RT	14.00' RT	14.00' RT	14.00' RT	14.00' RT	14.00' RT	14.00' RT	14.00' RT	14.00' RT	14.00' RT	14.00' RT	14.00' RT	14.00' RT	14.00' RT
	FINAL DECK ELEVATION	631.62	631.56	631.50	631.44	631.37	631.31	631.25	631.19	631.12	631.06	631.00	630.94	630.88	630.82	630.76	630.69	630.63
BEAMLINE L	STATION	491+69.33	491+90.08	492+10.83	492+31.58	492+52.33	492+73.08	492+93.83	493+14.58	493+35.33	493+55.82	493+76.30	493+96.79	494+17.27	494+37.76	494+58.25	494+78.73	494+99.22
	OFFSET FROM BL	13.79' RT	13.79' RT	13.79' RT	13.79' RT	13.79' RT	13.79' RT	13.79' RT	13.79' RT	13.79' RT	13.79' RT	13.79' RT	13.79' RT	13.79' RT	13.79' RT	13.79' RT	13.79' RT	13.79' RT
	FINAL DECK ELEVATION	631.62	631.56	631.49	631.43	631.37	631.31	631.25	631.18	631.12	631.06	631.00	630.94	630.87	630.81	630.75	630.69	630.63
BEAMLINE M	STATION	491+71.04	491+91.79	492+12.54	492+33.29	492+54.04	492+74.79	492+95.54	493+16.29	493+37.04	493+57.52	493+78.01	493+98.49	494+18.98	494+39.46	494+59.95	494+80.44	495+00.92
	OFFSET FROM BL	23.46' RT	23.46' RT	23.46' RT	23.46' RT	23.46' RT	23.46' RT	23.46' RT	23.46' RT	23.46' RT	23.46' RT	23.46' RT	23.46' RT	23.46' RT	23.46' RT	23.46' RT	23.46' RT	23.46' RT
	FINAL DECK ELEVATION	631.62	631.56	631.50	631.44	631.37	631.31	631.25	631.19	631.13	631.06	631.00	630.94	630.88	630.82	630.76	630.70	630.63
CROWN LINE	STATION	491+71.48	491+92.23	492+12.98	492+33.73	492+54.48	492+75.23	492+95.98	493+16.73	493+37.48	493+57.97	493+78.46	493+98.94	494+19.43	494+39.91	494+60.40	494+80.88	495+01.37
	OFFSET FROM BL	26.00' RT	26.00' RT	26.00' RT	26.00' RT	26.00' RT	26.00' RT	26.00' RT	26.00' RT	26.00' RT	26.00' RT	26.00' RT	26.00' RT	26.00' RT	26.00' RT	26.00' RT	26.00' RT	26.00' RT
	FINAL DECK ELEVATION	631.81	631.75	631.68	631.62	631.56	631.50	631.43	631.37	631.31	631.25	631.19	631.13	631.06	631.00	630.94	630.88	630.82
BEAMLINE N	STATION	491+72.74	491+93.49	492+14.24	492+34.99	492+55.74	492+76.49	492+97.24	493+17.99	493+38.74	493+59.23	493+79.71	494+00.20	494+20.68	494+41.17	494+61.65	494+82.14	495+02.63
	OFFSET FROM BL	33.13' RT	33.13' RT	33.13' RT	33.13' RT	33.13' RT	33.13' RT	33.13' RT	33.13' RT	33.13' RT	33.13' RT	33.13' RT	33.13' RT	33.13' RT	33.13' RT	33.13' RT	33.13' RT	33.13' RT
	FINAL DECK ELEVATION	631.69	631.63	631.57	631.50	631.44	631.38	631.32	631.25	631.19	631.13	631.07	631.01	630.95	630.88	630.82	630.76	630.70
BEAMLINE O	STATION	491+74.45	491+95.20	492+15.95	492+36.70	492+57.45	492+78.20	492+98.95	493+19.70	493+40.45	493+60.93	493+81.42	494+01.90	494+22.39	494+42.87	494+63.36	494+83.84	495+04.33
	OFFSET FROM BL	42.79' RT	42.79' RT	42.79' RT	42.79' RT	42.79' RT	42.79' RT	42.79' RT	42.79' RT	42.79' RT	42.79' RT	42.79' RT	42.79' RT	42.79' RT	42.79' RT	42.79' RT	42.79' RT	42.79' RT
	FINAL DECK ELEVATION	631.53	631.47	631.41	631.34	631.28	631.22	631.16	631.09	631.03	630.97	630.91	630.85	630.79	630.72	630.66	630.60	630.54
BEAMLINE P	STATION	491+76.15	491+96.90	492+17.65	492+38.40	492+59.15	492+79.90	493+00.65	493+21.40	493+42.15	493+62.64	493+83.12	494+03.61	494+24.09	494+44.58	494+65.06	494+85.55	495+06.03
	OFFSET FROM BL	52.46' RT	52.46' RT	52.46' RT	52.46' RT	52.46' RT	52.46' RT	52.46' RT	52.46' RT	52.46' RT	52.46' RT	52.46' RT	52.46' RT	52.46' RT	52.46' RT	52.46' RT	52.46' RT	52.46' RT
	FINAL DECK ELEVATION	631.37	631.31	631.25	631.18	631.12	631.06	631.00	630.93	630.87	630.81	630.75	630.69	630.63	630.56	630.50	630.44	630.38
BEAMLINE R	STATION	491+77.85	491+98.60	492+19.35	492+40.10	492+60.85	492+81.60	493+02.35	493+23.10	493+43.85	493+64.34	493+84.83	494+05.31	494+25.80	494+46.28	494+66.77	494+87.25	495+07.74
	OFFSET FROM BL	62.13' RT	62.13' RT	62.13' RT	62.13' RT	62.13' RT	62.13' RT	62.13' RT	62.13' RT	62.13' RT	62.13' RT	62.13' RT	62.13' RT	62.13' RT	62.13' RT	62.13' RT	62.13' RT	62.13' RT
	FINAL DECK ELEVATION	631.21	631.15	631.09	631.02	630.96	630.90	630.84	630.77	630.71	630.65	630.59	630.53	630.47	630.41	630.34	630.28	630.22
BEAMLINE S	STATION	491+79.56	492+00.31	492+21.06	492+41.81	492+62.56	492+83.31	493+04.06	493+24.81	493+45.56	493+66.04	493+86.53	494+07.02	494+27.50	494+47.99	494+68.47	494+88.96	495+09.44
	OFFSET FROM BL	71.79' RT	71.79' RT	71.79' RT	71.79' RT	71.79' RT	71.79' RT	71.79' RT	71.79' RT	71.79' RT	71.79' RT	71.79' RT	71.79' RT	71.79' RT	71.79' RT	71.79' RT	71.79' RT	71.79' RT
	FINAL DECK ELEVATION	631.05	630.99	630.93	630.86	630.80	630.74	630.68	630.61	630.55	630.49	630.43	630.37	630.31	630.25	630.18	630.12	630.06
RIGHT GUTTER	STATION	491+79.95	492+00.70	492+21.45	492+42.20	492+62.95	492+83.70	493+04.45	493+25.20	493+45.95	493+66.43	493+86.92	494+07.40	494+27.89	494+48.38	494+68.86	494+89.35	495+09.83
	OFFSET FROM BL	74.00' RT	74.00' RT	74.00' RT	74.00' RT	74.00' RT	74.00' RT	74.00' RT	74.00' RT	74.00' RT	74.00' RT	74.00' RT	74.00' RT	74.00' RT	74.00' RT	74.00' RT	74.00' RT	74.00' RT
	FINAL DECK ELEVATION	631.01	630.95	630.89	630.83	630.77	630.70	630.64	630.58	630.52	630.45	630.39	630.33	630.27	630.21	630.15	630.09	630.02

5/1/2020 JANSSEN & SPANNS ENGINEERING INC. 1  
 REPLACED SHEET

DESIGNED	WOZ	CBS
DRAWN	REMOVED	REMOVED
REVIEWED	DATE	5/20
DATE	5/20	
DESIGN AGENCY	JANSSEN & SPANNS ENGINEERING, INC. 9120 HARRISON PARK COURT INDIANAPOLIS, IN 46216	
STRUCTURE FILE NUMBER	4802765/4802767	

FINAL DECK ELEVATIONS - NORTHBOUND - UNIT 2  
 BRIDGE NO. LUC-75-0029 L/R  
 I.R. 75 OVER MAUMEE RIVER

WO/LUC-75-  
 30.70/0.00  
 PID No. 93592

NOTE:  
 1. FOR FINAL DECK ELEVATION DIAGRAMS AND  
 ADDITIONAL NOTES, SEE SHEET 183/216 .

FINAL DECK SURFACE ELEVATIONS (NORTHBOUND BRIDGE - UNIT 2)

SPAN 3											SPAN 3 (CONTINUED)										
LOCATION	☉ PIER 4	1/8 POINT	1/4 POINT	3/8 POINT	1/2 POINT	5/8 POINT	3/4 POINT	7/8 POINT	☉ PIER 5	LOCATION	☉ PIER 4	1/8 POINT	1/4 POINT	3/8 POINT	1/2 POINT	5/8 POINT	3/4 POINT	7/8 POINT	☉ PIER 5		
LEFT GUTTER	STATION	491+67.25	491+88.00	492+08.75	492+29.50	492+50.25	492+71.00	492+91.75	493+12.50	493+33.25	BEAM 2-3P	STATION	491+75.30	491+96.01	492+16.72	492+37.43	492+58.14	492+78.85	492+99.56	493+20.27	493+40.98
	OFFSET FROM ☉	2.00' RT.	2.00' RT.	2.00' RT.	2.00' RT.	2.00' RT.	2.00' RT.	2.00' RT.	2.00' RT.	2.00' RT.		47.68' RT.	47.45' RT.	47.22' RT.	46.99' RT.	46.76' RT.	46.53' RT.	46.30' RT.	46.07' RT.	45.84' RT.	
	FINAL DECK EL.	631.47	631.37	631.31	631.25	631.19	631.13	631.06	631.00	630.94		631.45	631.39	631.33	631.27	631.22	631.16	631.10	631.04	630.98	
BEAM 2-3K	STATION	491+67.62	491+88.37	492+09.12	492+29.87	492+50.62	492+71.37	492+92.12	493+12.87	493+33.62	BEAM 2-3R	STATION	491+76.84	491+97.54	492+18.24	492+38.94	492+59.64	492+80.34	493+01.05	493+21.75	493+42.45
	OFFSET FROM ☉	4.13' RT.	4.13' RT.	4.13' RT.	4.13' RT.	4.13' RT.	4.13' RT.	4.13' RT.	4.13' RT.	4.13' RT.		56.39' RT.	56.12' RT.	55.84' RT.	55.57' RT.	55.29' RT.	55.02' RT.	54.74' RT.	54.46' RT.	54.19' RT.	
	FINAL DECK EL.	631.47	631.41	631.34	631.28	631.22	631.16	631.10	631.03	630.97		631.31	631.25	631.19	631.13	631.07	631.02	630.96	630.90	630.84	
PROFILE GRADE LINE	STATION	491+69.36	491+90.11	492+10.86	492+31.61	492+52.36	492+73.11	492+93.86	493+14.61	493+35.36	GRADE BREAK LINE	STATION	491+76.92	491+97.60	492+18.27	492+38.95	492+59.63	492+80.31	493+00.98	493+21.66	493+42.34
	OFFSET FROM ☉	14.00' RT.	14.00' RT.	14.00' RT.	14.00' RT.	14.00' RT.	14.00' RT.	14.00' RT.	14.00' RT.	14.00' RT.		56.86' RT.	56.45' RT.	56.04' RT.	55.63' RT.	55.21' RT.	54.80' RT.	54.38' RT.	53.97' RT.	53.56' RT.	
	FINAL DECK EL.	631.62	631.56	631.50	631.44	631.37	631.31	631.25	631.19	631.12		631.30	631.24	631.19	631.13	631.08	631.02	630.96	630.91	630.85	
BEAM 2-3L	STATION	491+69.16	491+89.90	492+10.64	492+31.38	492+52.12	492+72.87	492+93.61	493+14.35	493+35.09	BEAM 2-3S	STATION	491+78.37	491+99.07	492+19.07	492+39.77	492+60.47	492+81.17	493+01.87	493+22.57	493+43.27
	OFFSET FROM ☉	12.84' LT.	12.79' LT.	12.74' LT.	12.70' LT.	12.65' LT.	12.61' LT.	12.56' LT.	12.52' LT.	12.47' LT.		65.11' RT.	64.78' RT.	64.45' RT.	64.14' RT.	63.82' RT.	63.50' RT.	63.18' RT.	62.85' RT.	62.53' RT.	
	FINAL DECK EL.	631.60	631.54	631.48	631.42	631.35	631.29	631.23	631.16	631.10		631.16	631.10	631.05	630.99	630.93	630.88	630.82	630.76	630.71	
BEAM 2-3M	STATION	491+70.69	491+91.43	492+12.16	492+32.89	492+53.63	492+74.37	492+95.10	493+15.83	493+36.46	L RAMP 1-D	STATION	491+79.73	491+100.40	492+21.08	492+41.76	492+62.43	492+83.11	493+03.79	493+24.46	493+45.14
	OFFSET FROM ☉	21.55' RT.	21.46' RT.	21.36' RT.	21.27' RT.	21.18' RT.	21.09' RT.	20.99' RT.	20.90' RT.	20.81' RT.		72.75' RT.	72.36' RT.	71.94' RT.	71.53' RT.	71.11' RT.	70.70' RT.	70.29' RT.	69.87' RT.	69.46' RT.	
	FINAL DECK EL.	631.74	631.68	631.61	631.55	631.48	631.42	631.35	631.29	631.23		631.03	630.98	630.92	630.87	630.81	630.76	630.70	630.65	630.59	
CROWN LINE	STATION	491+71.48	491+92.23	492+12.98	492+33.73	492+54.48	492+75.23	492+95.98	493+16.73	493+37.48	BEAM 2-3T	STATION	491+79.91	492+00.59	492+21.28	492+41.97	492+62.65	492+83.34	493+04.02	493+24.71	493+45.39
	OFFSET FROM ☉	26.00' RT.	26.00' RT.	26.00' RT.	26.00' RT.	26.00' RT.	26.00' RT.	26.00' RT.	26.00' RT.	26.00' RT.		73.82' RT.	73.45' RT.	73.08' RT.	72.71' RT.	72.35' RT.	71.98' RT.	71.61' RT.	71.24' RT.	70.88' RT.	
	FINAL DECK EL.	631.81	631.75	631.68	631.62	631.56	631.50	631.43	631.37	631.31		631.02	630.96	630.90	630.85	630.79	630.74	630.68	630.62	630.57	
BEAM 2-3N	STATION	491+72.23	491+92.96	492+13.68	492+34.41	492+55.13	492+75.86	492+96.58	493+17.31	493+38.04	BEAM 2-3U	STATION	491+81.45	492+02.12	492+22.80	492+43.48	492+64.15	492+84.83	493+05.51	493+26.19	493+46.86
	OFFSET FROM ☉	30.26' RT.	30.12' RT.	29.98' RT.	29.85' RT.	29.71' RT.	29.57' RT.	29.43' RT.	29.29' RT.	29.15' RT.		82.53' RT.	82.11' RT.	81.70' RT.	81.29' RT.	80.87' RT.	80.46' RT.	80.05' RT.	79.63' RT.	79.22' RT.	
	FINAL DECK EL.	631.74	631.68	631.62	631.56	631.50	631.44	631.38	631.32	631.26		630.87	630.82	630.76	630.71	630.65	630.60	630.54	630.49	630.43	
BEAM 2-3O	STATION	491+73.77	491+94.48	492+15.20	492+35.92	492+56.64	492+77.35	492+98.07	493+18.79	493+39.51	RIGHT GUTTER	STATION	491+81.83	492+02.51	492+23.19	492+43.86	492+64.54	492+85.22	493+05.90	493+26.57	493+47.25
	OFFSET FROM ☉	38.97' RT.	38.79' RT.	38.60' RT.	38.42' RT.	38.24' RT.	38.05' RT.	37.87' RT.	37.68' RT.	37.50' RT.		84.73' RT.	84.32' RT.	83.90' RT.	83.49' RT.	83.07' RT.	82.66' RT.	82.25' RT.	81.83' RT.	81.42' RT.	
	FINAL DECK EL.	631.59	631.53	631.47	631.42	631.36	631.30	631.24	631.18	631.12		630.78	630.73	630.67	630.62	630.56	630.50	630.45	630.40	630.35	

Date: Oct 08, 2020, 4:34pm User Name: mlongtin  
 File: P:\1321 - Toledo E Value Engineering\DWG\BRIDGE\LUC-75-0027 over Maumee River\Sheets\027\_0027C\_SD0061.dwg

5/1/2020 JANSSEN & SPAANS ENGINEERING INC. -  
 REPLACED SHEET

W00/LUC-75-  
 30.70/0.00  
 PID No. 93592

FINAL DECK ELEVATIONS - NORTHBOUND-UNIT 2

BRIDGE NO. LUC-75-0029 L/R  
 I.R. 75 OVER MAUMEE RIVER

DESIGN AGENCY  
 654 WHITE POND DRIVE  
 AKRON, OHIO 44320-1100  
**AECOM**  
 (330) 836-9111

DATE  
 8/18  
 REVIEWED  
 JTH  
 STRUCTURE FILE NUMBER  
 4802765/480276

DRAWN  
 TMR  
 CHECKED  
 MRW

188/216  
 1481  
 1792

NOTE:  
 1. FOR FINAL DECK ELEVATION DIAGRAM  
 ADDITIONAL NOTES, SEE SHEET 183/216

FINAL DECK SURFACE ELEVATIONS (NORTHBOUND BRIDGE - UNIT 2)

SPAN 4											SPAN 4 (CONTINUED)										
LOCATION	CL PIER 5	1/8 POINT	1/4 POINT	3/8 POINT	1/2 POINT	5/8 POINT	3/4 POINT	7/8 POINT	CL BRG. PIER 6		LOCATION	CL PIER 5	1/8 POINT	1/4 POINT	3/8 POINT	1/2 POINT	5/8 POINT	3/4 POINT	7/8 POINT	CL BRG. PIER 6	
LEFT GUTTER	STATION	493+33.25	493+54.00	493+74.75	493+95.50	494+16.25	494+37.00	494+57.75	494+78.50	494+97.30	STATION	493+40.98	493+61.69	493+82.40	494+03.11	494+23.82	494+44.52	494+65.23	494+85.94	495+04.71	
	OFFSET FROM BEAM	2.00' RT.	2.00' RT.	2.00' RT.	2.00' RT.	2.00' RT.	2.00' RT.	2.00' RT.	2.00' RT.	2.00' RT.	BEAM 2-4P	45.84' RT.	45.61' RT.	45.38' RT.	45.16' RT.	44.93' RT.	44.70' RT.	44.47' RT.	44.24' RT.	44.03' RT.	
	FINAL DECK EL.	630.98	630.88	630.81	630.75	630.69	630.63	630.56	630.50	630.45	FINAL DECK EL.	630.98	630.92	630.86	630.81	630.75	630.69	630.63	630.57	630.52	
BEAM 2-4K	STATION	493+33.62	493+54.37	493+75.12	493+95.87	494+16.62	494+37.37	494+58.12	494+78.87	494+97.67	STATION	493+42.45	493+63.15	493+83.85	494+04.55	494+25.25	494+45.95	494+66.66	494+87.36	495+06.12	
	OFFSET FROM BEAM	4.13' RT.	4.13' RT.	4.13' RT.	4.13' RT.	4.13' RT.	4.13' RT.	4.13' RT.	4.13' RT.	4.13' RT.	BEAM 2-4R	54.19' RT.	53.91' RT.	53.64' RT.	53.36' RT.	53.09' RT.	52.81' RT.	52.53' RT.	52.26' RT.	52.01' RT.	
	FINAL DECK EL.	630.97	630.91	630.85	630.78	630.72	630.66	630.60	630.54	630.48	FINAL DECK EL.	630.84	630.79	630.73	630.67	630.61	630.56	630.50	630.44	630.39	
PROFILE GRADE LINE	STATION	493+35.36	493+56.11	493+76.86	493+97.61	494+18.36	494+39.11	494+59.86	494+80.61	494+99.42	STATION	493+42.34	493+63.01	493+83.69	494+04.37	494+25.05	-	-	-	-	
	OFFSET FROM BEAM	14.00' RT.	14.00' RT.	14.00' RT.	14.00' RT.	14.00' RT.	14.00' RT.	14.00' RT.	14.00' RT.	14.00' RT.	GRADE BREAK LINE	53.56' RT.	53.14' RT.	52.73' RT.	52.31' RT.	51.90' RT.	-	-	-	-	
	FINAL DECK EL.	631.12	631.06	631.00	630.94	630.87	630.81	630.75	630.69	630.63	FINAL DECK EL.	630.85	630.80	630.74	630.69	630.63	-	-	-	-	
BEAM 2-4L	STATION	493+35.09	493+55.83	493+76.58	493+97.32	494+18.06	494+38.80	494+59.54	494+80.29	494+99.08	STATION	493+43.92	493+64.61	493+85.30	494+06.00	494+26.69	494+47.39	494+68.08	494+88.77	495+07.53	
	OFFSET FROM BEAM	12.47' RT.	12.42' RT.	12.38' RT.	12.33' RT.	12.28' RT.	12.24' RT.	12.19' RT.	12.15' RT.	12.11' RT.	BEAM 2-4S	62.53' RT.	62.21' RT.	61.89' RT.	61.57' RT.	61.25' RT.	60.92' RT.	60.60' RT.	60.28' RT.	59.99' RT.	
	FINAL DECK EL.	631.10	631.04	630.97	630.91	630.85	630.79	630.72	630.66	630.60	FINAL DECK EL.	630.71	630.65	630.59	630.53	630.48	630.42	630.36	630.31	630.26	
BEAM 2-4M	STATION	493+36.46	493+57.30	493+78.03	493+98.77	494+19.50	494+40.24	494+60.97	494+81.70	495+00.49	L RAMP 1-D	493+45.14	493+65.82	493+86.50	494+07.17	494+27.85	494+48.53	494+69.20	494+89.88	495+08.62	
	OFFSET FROM BEAM	20.81' RT.	20.72' RT.	20.63' RT.	20.54' RT.	20.44' RT.	20.35' RT.	20.26' RT.	20.17' RT.	20.09' RT.	OFFSET FROM BEAM	69.40' RT.	69.05' RT.	68.63' RT.	68.22' RT.	67.81' RT.	67.39' RT.	66.98' RT.	66.57' RT.	66.19' RT.	
	FINAL DECK EL.	631.23	631.17	631.10	631.04	630.97	630.91	630.85	630.78	630.73	FINAL DECK EL.	630.59	630.54	630.48	630.43	630.37	630.31	630.26	630.20	630.15	
CROWN LINE	STATION	493+37.48	493+58.23	493+78.98	493+99.73	494+20.48	494+41.23	494+61.98	494+82.73	495+01.53	STATION	493+45.39	493+66.08	493+86.76	494+07.45	494+28.13	494+48.82	494+69.50	494+90.19	495+08.93	
	OFFSET FROM BEAM	26.00' RT.	26.00' RT.	26.00' RT.	26.00' RT.	26.00' RT.	26.00' RT.	26.00' RT.	26.00' RT.	26.00' RT.	BEAM 2-4T	70.88' RT.	70.51' RT.	70.14' RT.	69.77' RT.	69.41' RT.	69.04' RT.	68.67' RT.	68.30' RT.	67.97' RT.	
	FINAL DECK EL.	631.31	631.25	631.19	631.12	631.06	631.00	630.94	630.87	630.82	FINAL DECK EL.	630.57	630.51	630.46	630.40	630.34	630.29	630.23	630.17	630.12	
BEAM 2-4N	STATION	493+38.03	493+58.76	493+79.49	494+00.21	494+20.94	494+41.66	494+62.39	494+83.11	495+03.84	STATION	493+46.86	493+67.54	493+88.22	494+08.89	494+29.57	494+50.25	494+70.92	494+91.60	495+10.34	
	OFFSET FROM BEAM	29.16' RT.	29.02' RT.	28.88' RT.	28.74' RT.	28.61' RT.	28.47' RT.	28.33' RT.	28.19' RT.	28.05' RT.	BEAM 2-4U	79.22' RT.	78.81' RT.	78.39' RT.	77.98' RT.	77.57' RT.	77.15' RT.	76.74' RT.	76.33' RT.	75.95' RT.	
	FINAL DECK EL.	631.26	631.20	631.14	631.08	631.02	630.96	630.90	630.84	630.78	FINAL DECK EL.	630.43	630.37	630.32	630.26	630.21	630.15	630.10	630.04	629.99	
BEAM 2-4O	STATION	493+39.51	493+60.22	493+80.94	494+01.66	494+22.38	494+43.09	494+63.81	494+84.52	495+05.23	STATION	493+47.25	493+67.93	493+88.60	494+09.28	494+29.96	494+50.64	494+71.31	494+91.99	495+10.73	
	OFFSET FROM BEAM	37.50' RT.	37.32' RT.	37.13' RT.	36.95' RT.	36.77' RT.	36.58' RT.	36.40' RT.	36.21' RT.	36.05' RT.	RIGHT GUTTER	81.42' RT.	81.01' RT.	80.59' RT.	80.18' RT.	79.76' RT.	79.35' RT.	78.94' RT.	78.52' RT.	78.15' RT.	
	FINAL DECK EL.	631.12	631.06	631.00	630.94	630.88	630.82	630.76	630.71	630.65	FINAL DECK EL.	630.39	630.34	630.28	630.23	630.17	630.12	630.06	630.01	629.96	

Date: Oct 08, 2020, 4:35pm User Name: mlongtin  
 File: P:\1321 - Toledo E Value Engineering\DWG\BRIDGE\LUC-75-0027 over Maumee River\Sheets\027\_0027C\_SD062.dwg

5/1/2020 JANSSEN & SPAANS ENGINEERING INC. -  
 REPLACED SHEET

WOO/LUC-75-  
 30.70/0.00  
 PID No. 93592

FINAL DECK ELEVATIONS - NORTHBOUND-UNIT 2

BRIDGE NO. LUC-75-0029 L/R  
 I.R. 75 OVER MAUMEE RIVER

DESIGN AGENCY  
 DATE 8/18  
 REVIEWED JTH  
 STRUCTURE FILE NUMBER 4802765/480276  
 DRAWN TMR  
 CHECKED MRW



NOTE:  
 1. FOR FINAL DECK ELEVATION DIAGRAM  
 ADDITIONAL NOTES, SEE SHEET 183/216

189/216  
 1482  
 1792



Date: Oct 12, 2020, 3:57pm User Name: mlongtin  
 File: \\bsc.com\files\Projects\1321 - Toledo E. Value Engineering\DWG\BRIDGE\LUC-75-0027 over Maumee River\Sheets\075\_0027C\_SD063.dwg

LOCATION		FINAL DECK SURFACE ELEVATIONS (NORTHBOUND BRIDGE - UNIT 3)																
		SPAN 7									CL PIER 7	SPAN 8						
		CL BRG. PIER 6	1/8 POINT	1/4 POINT	3/8 POINT	1/2 POINT	5/8 POINT	3/4 POINT	7/8 POINT								CL PIER 8	
LEFT GUTTER	STATION	495+01.37	495+21.85	495+42.34	495+62.82	495+83.31	496+03.80	496+24.28	496+44.77	496+65.25	496+86.00	497+06.75	497+27.50	497+48.25	497+69.00	497+89.75	498+10.50	498+31.25
	OFFSET FROM BL	2.00' RT	2.00' RT	2.00' RT	2.00' RT	2.00' RT	2.00' RT	2.00' RT	2.00' RT	2.00' RT	2.00' RT	2.00' RT	2.00' RT	2.00' RT	2.00' RT	2.00' RT	2.00' RT	2.00' RT
	FINAL DECK ELEVATION	630.43	630.37	630.31	630.25	630.19	630.13	630.07	630.00	629.94	629.88	629.82	629.76	629.69	629.63	629.57	629.51	629.44
BEAMLINE I	STATION	495+01.74	495+22.23	495+42.71	495+63.20	495+83.69	496+04.17	496+24.66	496+45.14	496+65.63	496+86.38	497+07.13	497+27.88	497+48.63	497+69.38	497+90.13	498+10.88	498+31.63
	OFFSET FROM BL	4.13' RT	4.13' RT	4.13' RT	4.13' RT	4.13' RT	4.13' RT	4.13' RT	4.13' RT	4.13' RT	4.13' RT	4.13' RT	4.13' RT	4.13' RT	4.13' RT	4.13' RT	4.13' RT	4.13' RT
	FINAL DECK ELEVATION	630.47	630.41	630.34	630.28	630.22	630.16	630.10	630.04	629.98	629.91	629.85	629.79	629.73	629.66	629.60	629.54	629.48
PROFILE GRADE	STATION	495+03.48	495+23.97	495+44.46	495+64.94	495+85.43	496+05.91	496+26.40	496+46.88	496+67.37	496+88.12	497+08.87	497+29.62	497+50.37	497+71.12	497+91.87	498+12.62	498+33.37
	OFFSET FROM BL	14.00' RT	14.00' RT	14.00' RT	14.00' RT	14.00' RT	14.00' RT	14.00' RT	14.00' RT	14.00' RT	14.00' RT	14.00' RT	14.00' RT	14.00' RT	14.00' RT	14.00' RT	14.00' RT	14.00' RT
	FINAL DECK ELEVATION	630.62	630.56	630.50	630.44	630.37	630.31	630.25	630.19	630.13	630.07	630.00	629.94	629.88	629.82	629.75	629.69	629.63
BEAMLINE J	STATION	495+03.45	495+23.93	495+44.42	495+64.90	495+85.39	496+05.88	496+26.36	496+46.85	496+67.33	496+88.08	497+08.83	497+29.58	497+50.33	497+71.08	497+91.83	498+12.58	498+33.33
	OFFSET FROM BL	13.79' RT	13.79' RT	13.79' RT	13.79' RT	13.79' RT	13.79' RT	13.79' RT	13.79' RT	13.79' RT	13.79' RT	13.79' RT	13.79' RT	13.79' RT	13.79' RT	13.79' RT	13.79' RT	13.79' RT
	FINAL DECK ELEVATION	630.62	630.56	630.50	630.44	630.38	630.32	630.25	630.19	630.12	630.06	630.00	629.94	629.88	629.81	629.75	629.69	629.63
BEAMLINE K	STATION	495+05.15	495+25.64	495+46.12	495+66.61	495+87.09	496+07.58	496+28.07	496+48.55	496+69.04	496+89.79	497+10.54	497+31.29	497+52.04	497+72.79	497+93.54	498+14.29	498+35.04
	OFFSET FROM BL	23.46' RT	23.46' RT	23.46' RT	23.46' RT	23.46' RT	23.46' RT	23.46' RT	23.46' RT	23.46' RT	23.46' RT	23.46' RT	23.46' RT	23.46' RT	23.46' RT	23.46' RT	23.46' RT	23.46' RT
	FINAL DECK ELEVATION	630.62	630.56	630.50	630.44	630.38	630.31	630.25	630.19	630.13	630.07	630.01	629.94	629.88	629.82	629.76	629.69	629.63
CROWN LINE	STATION	495+05.60	495+26.09	495+46.57	495+67.06	495+87.54	496+08.03	496+28.51	496+49.00	496+69.48	496+90.23	497+10.98	497+31.73	497+52.48	497+73.23	497+93.98	498+14.73	498+35.48
	OFFSET FROM BL	26.00' RT	26.00' RT	26.00' RT	26.00' RT	26.00' RT	26.00' RT	26.00' RT	26.00' RT	26.00' RT	26.00' RT	26.00' RT	26.00' RT	26.00' RT	26.00' RT	26.00' RT	26.00' RT	26.00' RT
	FINAL DECK ELEVATION	630.81	630.74	630.68	630.62	630.56	630.50	630.44	630.38	630.31	630.25	630.19	630.13	630.06	630.00	629.94	629.88	629.82
BEAMLINE L	STATION	495+06.86	495+27.34	495+47.83	495+68.31	495+88.80	496+09.28	496+29.77	496+50.26	496+70.74	496+91.49	497+12.24	497+32.99	497+53.74	497+74.49	497+95.24	498+15.99	498+36.74
	OFFSET FROM BL	33.13' RT	33.13' RT	33.13' RT	33.13' RT	33.13' RT	33.13' RT	33.13' RT	33.13' RT	33.13' RT	33.13' RT	33.13' RT	33.13' RT	33.13' RT	33.13' RT	33.13' RT	33.13' RT	33.13' RT
	FINAL DECK ELEVATION	630.69	630.63	630.56	630.50	630.44	630.38	630.32	630.26	630.20	630.13	630.07	630.01	629.95	629.88	629.82	629.76	629.70
BEAMLINE M	STATION	495+08.56	495+29.05	495+49.53	495+70.02	495+90.50	496+10.99	496+31.47	496+51.96	496+72.45	496+93.20	497+13.95	497+34.70	497+55.45	497+76.20	497+96.95	498+17.70	498+38.45
	OFFSET FROM BL	42.79' RT	42.79' RT	42.79' RT	42.79' RT	42.79' RT	42.79' RT	42.79' RT	42.79' RT	42.79' RT	42.79' RT	42.79' RT	42.79' RT	42.79' RT	42.79' RT	42.79' RT	42.79' RT	42.79' RT
	FINAL DECK ELEVATION	630.53	630.47	630.40	630.34	630.28	630.22	630.16	630.10	630.04	629.97	629.91	629.85	629.79	629.72	629.66	629.60	629.54
BEAMLINE N	STATION	495+10.27	495+30.75	495+51.24	495+71.72	495+92.21	496+12.69	496+33.18	496+53.66	496+74.15	496+94.90	497+15.65	497+36.40	497+57.15	497+77.90	497+98.65	498+19.40	498+40.15
	OFFSET FROM BL	52.46' RT	52.46' RT	52.46' RT	52.46' RT	52.46' RT	52.46' RT	52.46' RT	52.46' RT	52.46' RT	52.46' RT	52.46' RT	52.46' RT	52.46' RT	52.46' RT	52.46' RT	52.46' RT	52.46' RT
	FINAL DECK ELEVATION	630.37	630.31	630.24	630.18	630.12	630.06	630.00	629.94	629.88	629.81	629.75	629.69	629.63	629.56	629.50	629.44	629.38
BEAMLINE O	STATION	495+11.97	495+32.46	495+52.94	495+73.43	495+93.91	496+14.40	496+34.88	496+55.37	496+75.85	496+96.60	497+17.35	497+38.10	497+58.85	497+79.60	498+00.35	498+21.10	498+41.85
	OFFSET FROM BL	62.13' RT	62.13' RT	62.13' RT	62.13' RT	62.13' RT	62.13' RT	62.13' RT	62.13' RT	62.13' RT	62.13' RT	62.13' RT	62.13' RT	62.13' RT	62.13' RT	62.13' RT	62.13' RT	62.13' RT
	FINAL DECK ELEVATION	630.21	630.15	630.09	630.02	629.96	629.90	629.84	629.78	629.72	629.65	629.59	629.53	629.47	629.41	629.34	629.28	629.22
BEAMLINE P	STATION	495+13.67	495+34.16	495+54.65	495+75.13	495+95.62	496+16.10	496+36.59	496+57.07	496+77.56	496+98.31	497+19.06	497+39.81	497+60.56	497+81.31	498+02.06	498+22.81	498+43.56
	OFFSET FROM BL	71.79' RT	71.79' RT	71.79' RT	71.79' RT	71.79' RT	71.79' RT	71.79' RT	71.79' RT	71.79' RT	71.79' RT	71.79' RT	71.79' RT	71.79' RT	71.79' RT	71.79' RT	71.79' RT	71.79' RT
	FINAL DECK ELEVATION	630.05	629.99	629.93	629.86	629.80	629.74	629.68	629.62	629.56	629.49	629.43	629.37	629.31	629.25	629.18	629.12	629.06
RIGHT GUTTER	STATION	495+14.06	495+34.55	495+55.03	495+75.52	495+96.01	496+16.49	496+36.98	496+57.46	496+77.95	496+98.70	497+19.45	497+40.20	497+60.95	497+81.70	498+02.45	498+23.20	498+43.95
	OFFSET FROM BL	74.00' RT	74.00' RT	74.00' RT	74.00' RT	74.00' RT	74.00' RT	74.00' RT	74.00' RT	74.00' RT	74.00' RT	74.00' RT	74.00' RT	74.00' RT	74.00' RT	74.00' RT	74.00' RT	74.00' RT
	FINAL DECK ELEVATION	630.01	629.95	629.89	629.83	629.77	629.70	629.64	629.58	629.52	629.46	629.40	629.33	629.27	629.21	629.15	629.08	629.02

5/1/2020 JANSSEN & SPAANS ENGINEERING INC. - REPLACED SHEET

DESIGNED	DRAWN	REVIEWED	DATE	DESIGN AGENCY
WOZ	WOZ	WOZ	5/2020	JANSSEN & SPAANS ENGINEERING, INC.
CHECKED	REVIS	REVIS	STRUCTURE FILE NUMBER	9120 HARRISON PARK COURT
CBS			4802765/4802767	INDIANAPOLIS, IN 46216

FINAL DECK ELEVATIONS - NORTHBOUND - UNIT 3  
 BRIDGE NO. LUC-75-0029 L/R  
 I.R. 75 OVER MAUMEE RIVER


W00/LUC-75-30.70/0.00  
 PID No. 93592

190/216


NOTE:  
 1. FOR FINAL DECK ELEVATION DIAGRAMS AND ADDITIONAL NOTES, SEE SHEET 183/216.

1483  
 1792

Date: Oct 07, 2020, 4:55pm User Name: mlongtin  
 File: P:\1321 - Toledo E Value Engineering\DWG\BRIDGE\LUC-75-0027 over Maumee River\Sheets\027C\_MDO01.dwg

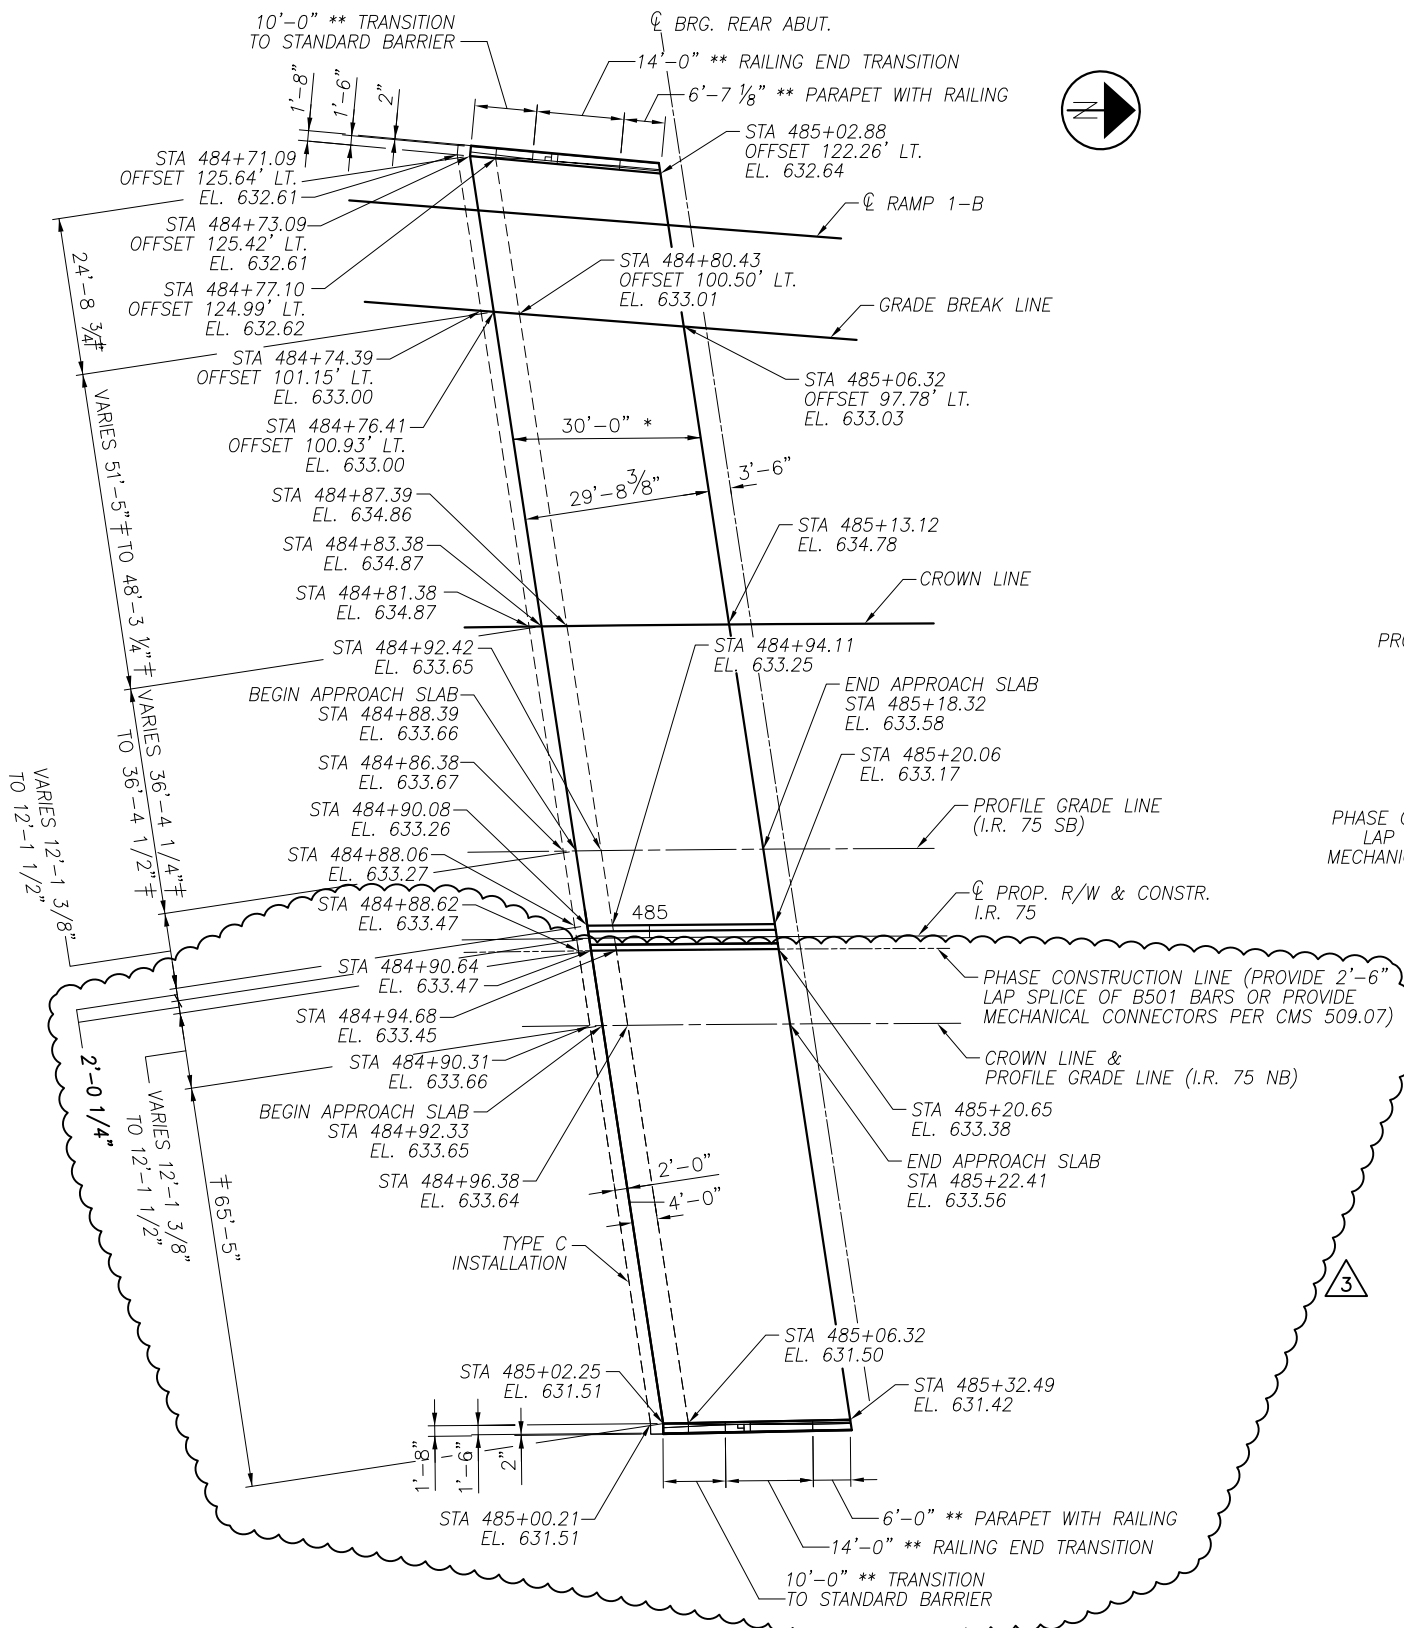

**REAR APPROACH SLAB PLAN**

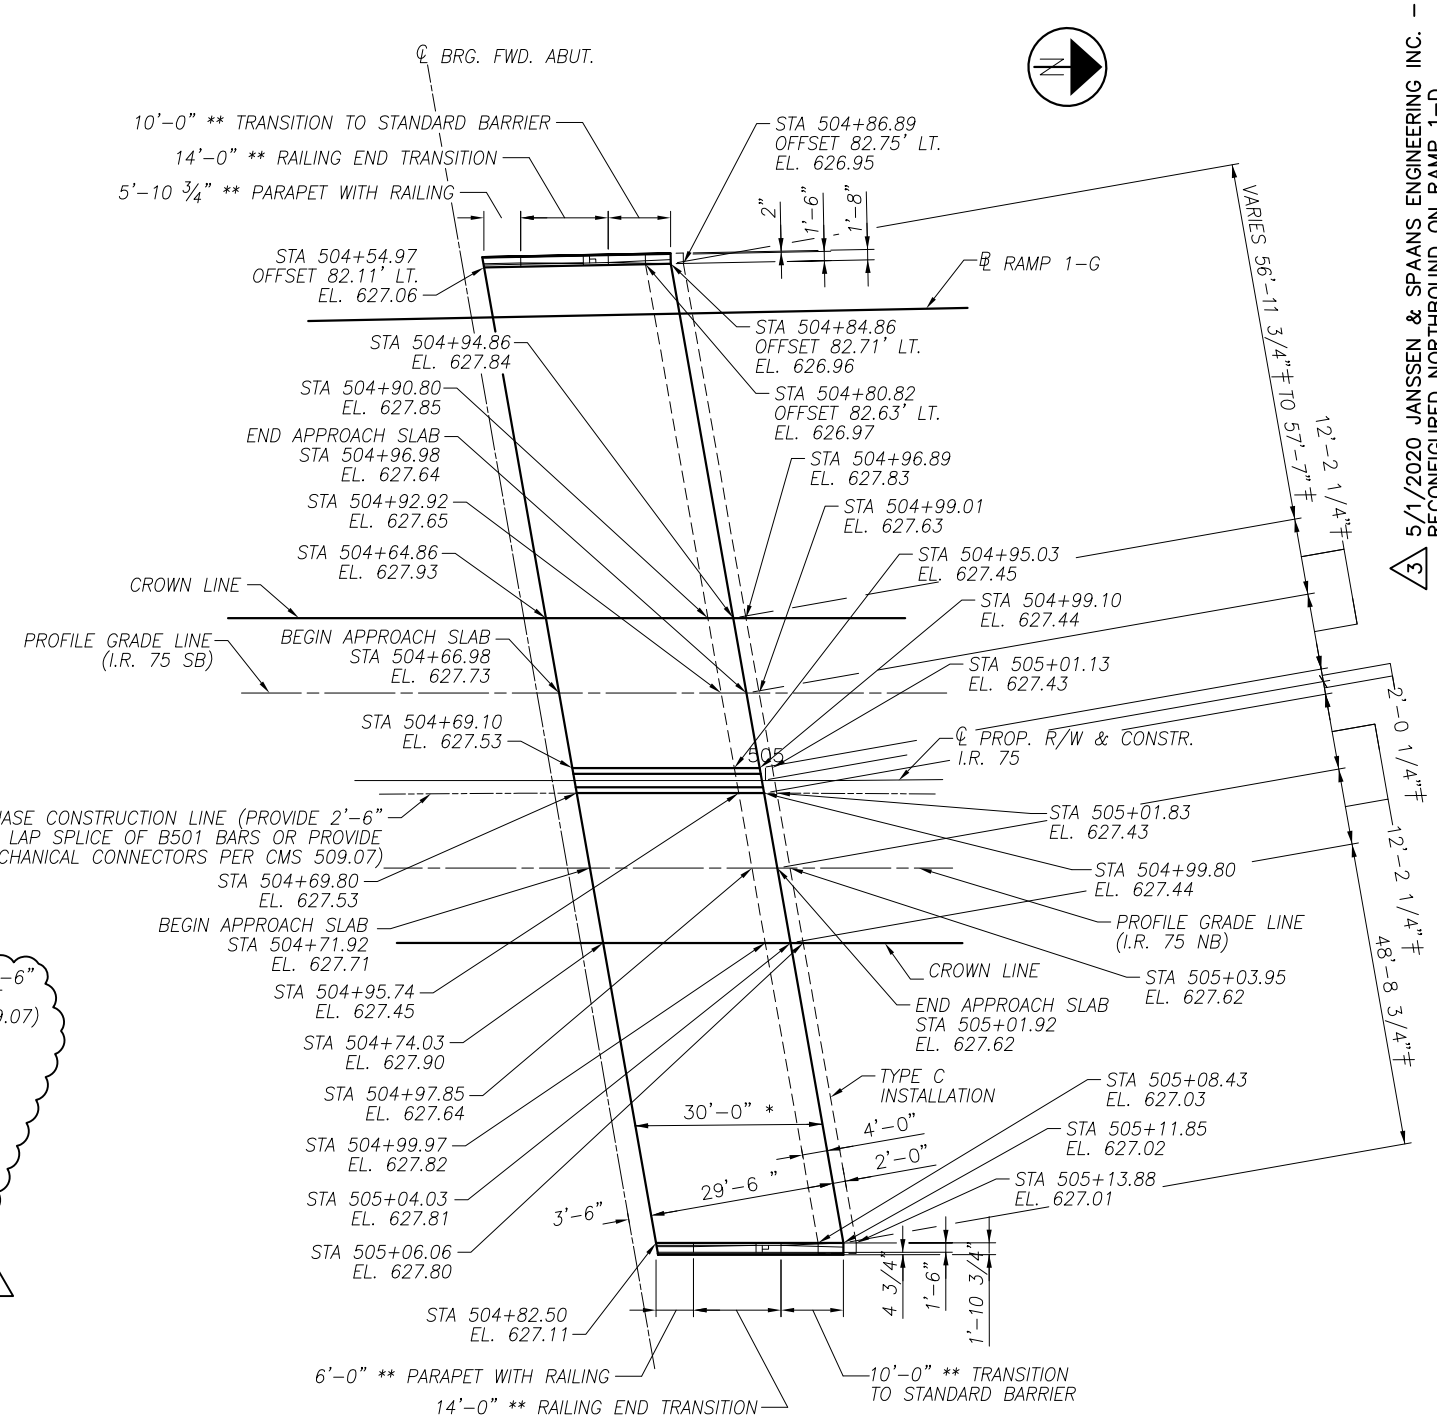

**FORWARD APPROACH SLAB PLAN**

**NOTES:**

1. FOR NOTES AND TYPICAL PARAPET TRANSITION SEE SHEET 195/216.

**LEGEND:**

- \* - MEASURED ALONG  $\phi$  PROP. R/W & CONSTR. I.R. 75
- \*\* - MEASURED ALONG TOE OF PARAPET
- ‡ - MEASURED ALONG EDGES OF APPROACH SLAB (PARALLEL TO  $\phi$  BRG.)


3 5/1/2020 JANNSSEN & SPANNS ENGINEERING INC. -  
 RECONFIGURED NORTHBOUND ON RAMP 1-D

DESIGNED	WOZ	CRC	DRAWN	REM	REVIS	DATE	REVIEWED	DATE	DESIGN AGENCY
			JTH			8/18			JANNSSEN & SPANNS ENGINEERING INC.
									564 WHITE POND DRIVE AKRON, OHIO 44320-1100
									(330) 836-9111


APPROACH SLABS -1 OF 4  
 BRIDGE NO. LUC-75-0029 L/R  
 I.R. 75 OVER MAUMEE RIVER

W00/LUC-75-  
 30.70/0.00  
 PID No. 93592

Date: Oct 07, 2020, 4:58pm User Name: mlongtin  
 File: P:\11321 - Toledo E Value Engineering\DWG\BRIDGE\LUC-75-0027 over Maumee River\Sheets\027C\_M0002.dwg

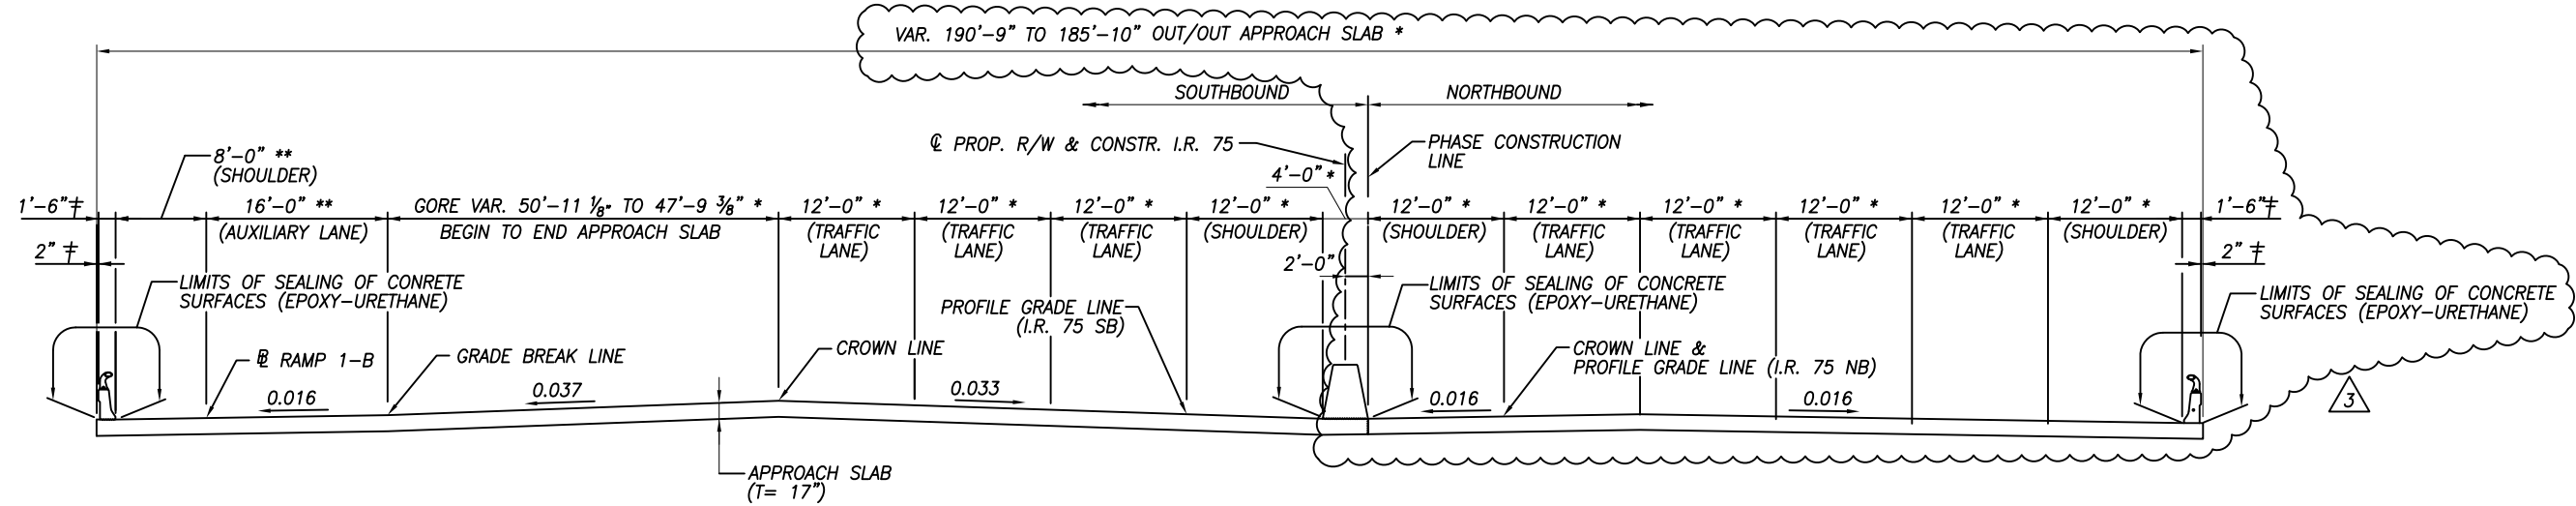

REAR APPROACH SLAB TRANSVERSE SECTION

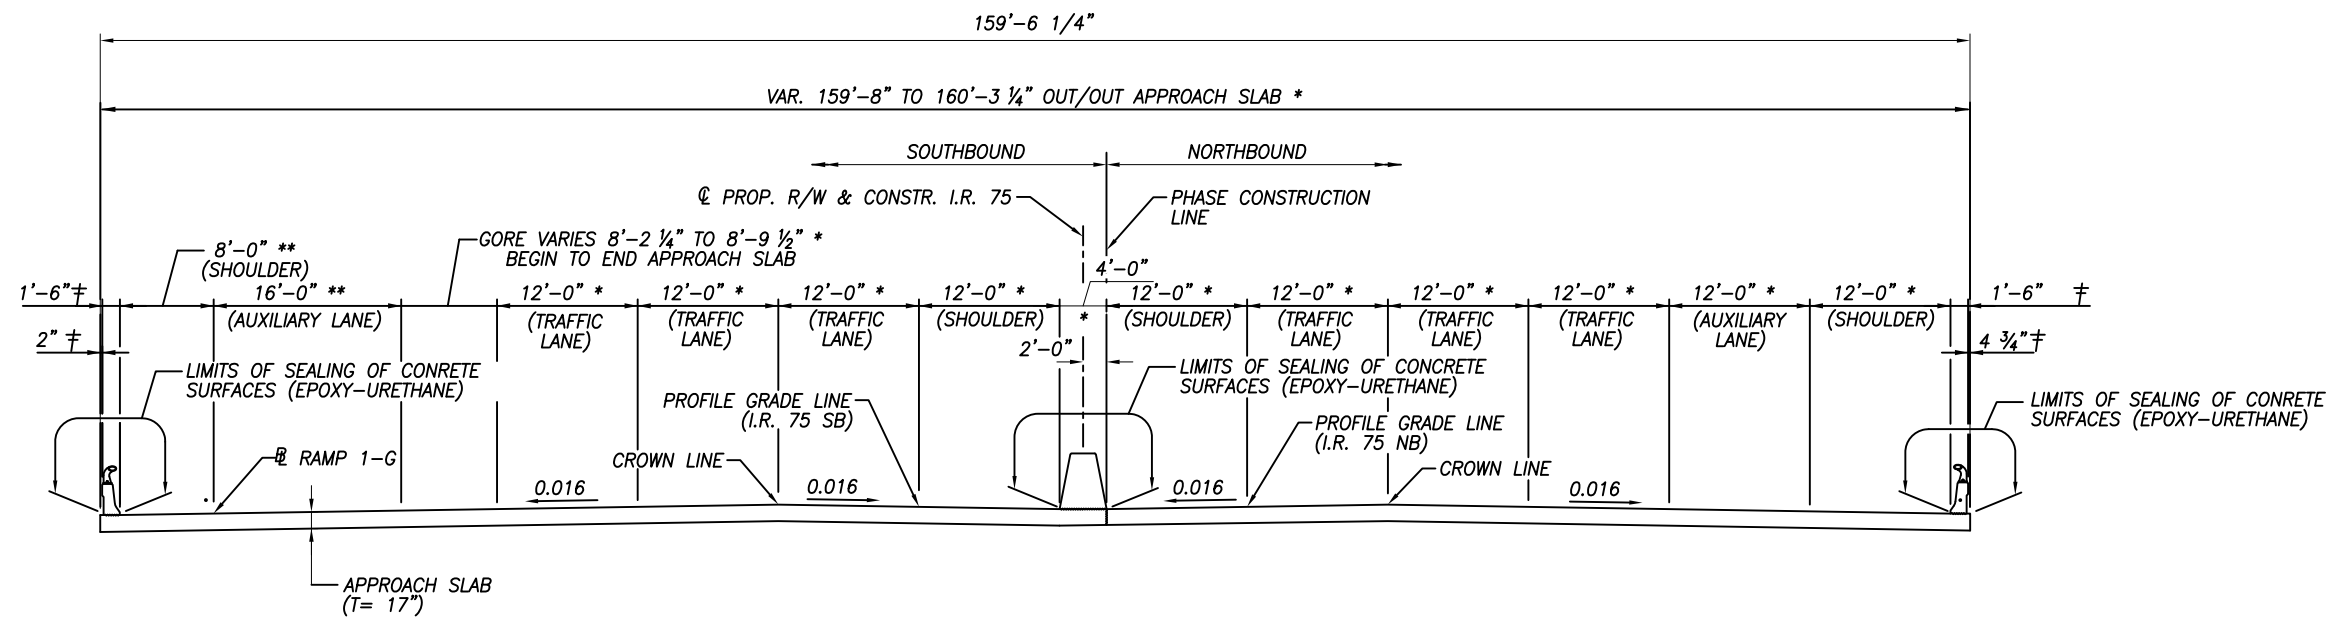

FORWARD APPROACH SLAB TRANSVERSE SECTION

NOTES:  
 1. FOR NOTES, SEE SHEET 195/216.

LEGEND:  
 \* - MEASURED PERPENDICULAR TO  $\phi$  PROP. R/W & CONSTR. I.R. 75  
 \*\* - MEASURED PERPENDICULAR TO BASELINE RAMP 1-B OR 1-G  
 † - BARRIER DIMENSIONS PROVIDED PERPENDICULAR TO EDGE OF DECK

5/1/2020 JANSEN & SPANS ENGINEERING INC.  
 RECONFIGURED NORTHBOUND ON RAMP

DESIGNED	DEB	CHECKED	MRW
DRAWN	VFC	REVIEWED	JTH
DATE	8/18	STRUCTURE FILE NUMBER	4802765/4802767
DESIGN AGENCY	AECOM		
564 WHITE POND DRIVE AKRON, OHIO 44320-1100 (330) 838-9111			

APPROACH SLABS -2 OF 4  
 BRIDGE NO. LUC-75-0029 L/R  
 I.R. 75 OVER MAUMEE RIVER

W00/LUC-75-  
 30.70/0.00  
 PID No. 93592

194/216  
 1487  
 1792

Date: Oct 07, 2020, 4:58pm User Name: mlongtin  
 File: P:\1121 - Toledo E. Value Engineering\DWG\BRIDGE\LUC-75-0027 over Maumee River\Sheets\075\_0027C\_RL001.dwg

MARK	NUMBER					LENGTH	WEIGHT	TYPE	DIMENSIONS						
	SOUTHBOUND		NORTHBOUND		TOTAL				A	B	C	D	E	F	INC
	REAR	FORWARD	REAR	FORWARD											
ABUTMENT															
3	A401	2	2			4	17'-10"	48	36	1'-0"	1'-2"	3'-8"	1'-10"	4'-7"	
	A402	98	68	60	56	282	7'-7"	1,455	2	3'-8"	0'-5"	3'-8"			
	A501 *	19				19	30'-0"	595	STR.						
	A502	57	57	38	38	190	30'-0"	5,945	STR.						
	A503	5				5	19'-8"	103	STR.						
	A504	10				10	20'-0"	209	STR.						
	A505 SER.	1 SER. OF 4				1 SER. OF 4	19'-9" TO 20'-0"	83	STR.						0'-1"
	A506	2	2	2	2	8	4'-3"	35	37	1'-6"	0'-7"	0'-5"	0'-10"	0'-7"	0'-11"
	A507	12	12			24	0'-11"	23	STR.						
	A508	2	2	2	2	8	5'-5"	45	38	2'-2"	0'-6"	0'-3"	2'-4"	0'-9"	
	A509			2	2	2	25'-7"	54	STR.						
	A510 SER.			2 SER. OF 6		2 SER. OF 6	5'-7" TO 23'-6"	184	STR.						3'-7"
	A511			2	2	2	27'-6"	58	19	1'-9"	23'-9"	9'-10"			
3	A512 **			19		19	24'-2"	484	STR.						
	A513		12			12	24'-7"	308	STR.						
	A514 SER.		2 SER. OF 8			2 SER. OF 8	2'-6" TO 22'-6"	209	STR.						2'-10 1/4"
	A515		2			2	27'-6"	57	19	1'-9"	22'-10"	12'-0"			
	A516 *		19			19	15'-10"	314	STR.						
	A517 **				19	19	19'-2"	380	STR.						
3	A601	196		162		358	12'-3"	6,566	2	2'-5"	7'-9"	2'-5"			
	A602	12	12	12	12	48	0'-11"	66	STR.						
	A603	6		6		12	14'-6"	261	33	3'-9"	2'-11"				
	A604	4		4		8	4'-4"	52	1	1'-7"	2'-11"				
	A605		154		112	266	13'-6"	5,394	2	2'-5"	9'-0"	2'-5"			
	A606		4		4	8	4'-6"	54	1	1'-7"	3'-1"				
	A607		6		6	12	15'-4"	276	33	4'-0"	3'-1"				
3	A608	98	68	60	56	282	6'-3"	2,639	2	2'-10"	0'-11"	2'-10"			
	A701	1				1	17'-10"	36	2	6'-6"	5'-3"	6'-6"			
	A702	6				6	17'-4"	213	2	6'-3"	5'-3"	6'-3"			
	A703	6		6		12	17'-6"	429	2	6'-4"	5'-3"	6'-4"			
	A704	12				12	18'-3"	448	2	6'-8"	5'-3"	6'-8"			
	A705	6				6	19'-0"	233	2	7'-1"	5'-3"	7'-1"			
	A706	12				12	19'-6"	478	2	7'-4"	5'-3"	7'-4"			
	A707	6				6	19'-10"	243	2	7'-6"	5'-3"	7'-6"			
	A708	6				6	20'-4"	249	2	7'-9"	5'-3"	7'-9"			
	A709	6				6	20'-0"	245	2	7'-7"	5'-3"	7'-7"			
	A710	6				6	18'-9"	230	2	6'-11"	5'-3"	6'-11"			
	A711	6				6	17'-9"	218	2	6'-5"	5'-3"	6'-5"			
	A712	6		6		12	17'-3"	423	2	6'-2"	5'-3"	6'-2"			
	A713	6				6	16'-10"	206	2	6'-0"	5'-3"	6'-0"			
	A714	13				13	16'-6"	438	2	5'-10"	5'-3"	5'-10"			
	A715	1		13		14	11'-10"	339	2	3'-6"	5'-3"	3'-6"			
	A716	6				6	11'-3"	138	2	3'-2"	5'-3"	3'-2"			
	A717	6		6		12	11'-4"	278	2	3'-3"	5'-3"	3'-3"			
	A718	12				12	12'-0"	294	2	3'-7"	5'-3"	3'-7"			
	A719	6				6	12'-10"	157	2	4'-0"	5'-3"	4'-0"			
	A720	6				6	13'-3"	162	2	4'-2"	5'-3"	4'-2"			
	A721	12				12	13'-9"	337	2	4'-5"	5'-3"	4'-5"			
	A722	12				12	13'-4"	327	2	4'-3"	5'-3"	4'-3"			
	A723	6				6	12'-6"	153	2	3'-10"	5'-3"	3'-10"			
	A724	6				6	11'-6"	141	2	3'-4"	5'-3"	3'-4"			
	A725	6		6		12	10'-10"	266	2	3'-0"	5'-3"	3'-0"			
	A726	6				6	10'-9"	132	2	2'-11"	5'-3"	2'-11"			
	A727	13				13	10'-4"	275	2	2'-9"	5'-3"	2'-9"			
3	A728	98	68	60	56	282	14'-4"	8,252	2	6'-9"	1'-3"	6'-9"			
	A729	98	68	60	56	282	14'-3"	8,204	2	6'-8"	1'-3"	6'-8"			
	A730 **			5		5	15'-2"	155	STR.						

NOTES:  
 FOR BAR SHAPE  
 DIAGRAMS, LEGEND  
 AND NOTES, SEE  
 SHEET 197/216.  
 ABUTMENT REINFORCING  
 TABLE CONTINUES  
 ON SHEET 199/216.

5/1/2020 JANSSEN & SPANNS ENGINEERING INC. -  
 RECONFIGURED NORTHBOUND ON RAMP

DESIGN AGENCY  
 564 WHITE POND DRIVE  
 AKRON, OHIO 44320-1100  
**AECOM**  
 (330) 836-9111

DESIGNED  
 DEB  
 CHECKED  
 MRW

DRAWN  
 VFC  
 REVISED

REVIEWED  
 JTH  
 STRUCTURE FILE NUMBER  
 4802765/4802767

DATE  
 8/18

REINFORCING LIST  
 BRIDGE NO. LUC-75-0029 L/R  
 I.R. 75 OVER MAUMEE RIVER

W00/LUC-75-  
 30.70/0.00  
 PID No. 93592

198/216  
 1491  
 1792

Date: Oct 07, 2020, 4:57pm User Name: mlongtin  
 File: P:\11321 - Toledo E. Value Engineering\DWG\BRIDGE\LUC-75-0027 over Maumee River\Sheets\07\_0027C\_RL002.dwg

MARK	NUMBER				TOTAL	LENGTH	WEIGHT	TYPE	DIMENSIONS							
	SOUTHBOUND		NORTHBOUND						A	B	C	D	E	F	INC	
	REAR	FORWARD	REAR	FORWARD												
ABUTMENT (CONTINUED)																
A731 *	6				6	30'-0"	368	STR.								
A732	16		10		26	30'-0"	1,594	STR.								
A733	2				2	25'-0"	102	STR.								
A734	2				2	26'-4"	108	STR.								
A735 SER.	1 SER. OF 5				1 SER. OF 5	15'-0" TO 16'-0"	158	STR.								0'-3"
3 A736 **			6		6	27'-4"	335	STR.								
A737			1		1	11'-3"	23	3	1'-3"	3'-11"						
A738			1		1	11'-5"	23	3	1'-3"	4'-0"						
A739 SER.			1 SER. OF 6		1 SER. OF 6	12'-9" TO 18'-1"	189	3	1'-3"	4'-8" TO 7'-4"						0'-6 3/8"
A740			13		13	15'-6"	412	2	7'-4"	1'-3"	7'-4"					
A741 SER.			1 SER. OF 6		1 SER. OF 6	10'-6" TO 15'-10"	161	2	4'-10" TO 7'-6"	1'-3"	4'-10" TO 7'-6"					0'-6 3/8"
A742 SER.			1 SER. OF 5		1 SER. OF 5	17'-3" TO 21'-4"	198	2	8'-2" TO 10'-3"	1'-3"	8'-2" TO 10'-3"					0'-6 1/4"
3 A743			2		2	22'-0"	90	2	10'-7"	1'-3"	10'-7"					
A744			23		23	15'-0"	704	2	5'-1"	5'-3"	5'-1"					
A745			6		6	15'-10"	194	2	5'-6"	5'-3"	5'-6"					
A746			6		6	16'-4"	200	2	5'-9"	5'-3"	5'-9"					
A747			13		13	18'-0"	478	2	6'-7"	5'-3"	6'-7"					
3 A748			23		23	8'-10"	415	2	2'-0"	5'-3"	2'-0"					
A749			6		6	9'-6"	117	2	2'-4"	5'-3"	2'-4"					
A750			6		6	10'-3"	126	2	2'-8"	5'-3"	2'-8"					
A751	5				5	17'-6"	179	STR.								
A752 *	5				5	5'-0"	51	1	1'-2"	4'-0" *						
A753	40				40	15'-3"	1,247	1	1'-2"	14'-3"						
A754	10				10	10'-9"	220	1	1'-2"	9'-9"						
3 A755			5		5	15'-1"	154	STR.								
A756			25		25	14'-0"	715	1	1'-2"	13'-0"						
A757			5		5	5'-8"	58	2	1'-2"	3'-8"	1'-2"					
A801	15	99	30	56	200	30'-0"	16,020	STR.								
A802 *	10				10	30'-0"	801	STR.								
A803 SER.	2 SER. OF 5				2 SER. OF 5	27'-6" TO 29'-6"	761	STR.								0'-6"
3 A804	85	60	52	49	246	5'-1"	3,362	18	2'-11"	1'-0"	1'-0"					
A805 **			10		10	30'-1"	809	STR.								
A806 * SER.		2 SER. OF 6			2 SER. OF 6	12'-4" TO 14'-0"	422	STR.								0'-4"
A807		20			20	18'-11"	1,010	STR.								
A808		20			20	13'-5"	716	2	2'-5"	9'-0"	2'-5"					
A809 **				28	28	23'-8"	1,769	STR.								
A810		20			20	16'-10"	899	2	8'-0"	1'-3"	8'-0"					
A811		68		56	124	21'-1"	6,980	2	8'-0"	5'-6"	8'-0"					
A812		2			2	17'-2"	92	2	8'-2"	1'-3"	8'-2"					
A813 SER.		1 SER. OF 6			1 SER. OF 6	18'-10" TO 25'-6"	355	2	9'-0" TO 12'-4"	1'-3"	9'-0" TO 12'-4"					0'-8"
A814 SER.		1 SER. OF 6			1 SER. OF 6	27'-6" TO 34'-2"	494	2	13'-4" TO 16'-8"	1'-3"	13'-4" TO 16'-8"					0'-8"
A815 SER.		1 SER. OF 4			1 SER. OF 4	35'-8" TO 39'-8"	402	2	17'-5" TO 19'-5"	1'-3"	17'-5" TO 19'-5"					0'-8"
A816		2			2	40'-6"	216	2	19'-10"	1'-3"	19'-10"					
A817		7			7	27'-5"	512	2	11'-2"	5'-6"	11'-2"					
A818		6		7	13	27'-9"	963	2	11'-4"	5'-6"	11'-4"					
A819		6		6	12	28'-1"	900	2	11'-6"	5'-6"	11'-6"					
A820		6			6	28'-3"	453	2	11'-7"	5'-6"	11'-7"					

NOTES:  
 FOR BAR SHAPE  
 DIAGRAMS, LEGEND  
 AND NOTES, SEE  
 SHEET 197/216.  
 ABUTMENT REINFORCING  
 TABLE CONTINUES  
 ON SHEET 200/216.

5/1/2020 JANSSEN & SPAANS ENGINEERING INC. -  
 RECONFIGURED NORTHBOUND ON RAMP

DESIGNED	DEB	CHECKED	MRW
DRAWN	VFC	REVISED	
REVIEWED	JTH	STRUCTURE FILE NUMBER	4802765/4802767
DATE	8/18	DESIGN AGENCY	AECOM

564 WHITE POND DRIVE  
 AKRON, OHIO 44320-1100  
 (330) 836-9111

REINFORCING LIST  
 BRIDGE NO. LUC-75-0029 L/R  
 I.R. 75 OVER MAUMEE RIVER

WOO/LUC-75-  
 30.70/0.00  
 PID No. 93592

199/216  
 1492  
 1792

Date: Oct 07, 2020, 4:57pm User Name: mlongtin  
 File: P:\11321 - Toledo E. Value Engineering\DWGS\BRIDGE\LUC-75-0027 over Maumee River\Sheets\075\_0027C\_RL003.dwg

MARK	NUMBER				TOTAL	LENGTH	WEIGHT	TYPE	DIMENSIONS						
	SOUTHBOUND		NORTHBOUND						A	B	C	D	E	F	INC
	REAR	FORWARD	REAR	FORWARD											
ABUTMENT (CONTINUED)															
A821		6		6	12	28'-5"	910	2	11'-8"	5'-6"	11'-8"				
A822		6		6	12	28'-9"	921	2	11'-10"	5'-6"	11'-10"				
A823		12		6	18	29'-1"	1,398	2	12'-0"	5'-6"	12'-0"				
A824		6		13	19	28'-11"	1,467	2	11'-11"	5'-6"	11'-11"				
A825		13			13	28'-7"	992	2	11'-9"	5'-6"	11'-9"				
A826				12	12	29'-3"	937	2	12'-1"	5'-6"	12'-1"				
A827 *		16			16	15'-10"	676	STR.							
A828		5			5	17'-0"	227	STR.							
A829		15			15	13'-2"	527	1	1'-4"	15'-1"					
A830		5			5	28'-1"	375	2	1'-4"	25'-10"	1'-4"				
A831		5			5	6'-1"	81	2	1'-4"	3'-10"	1'-4"				
A832 *		5			5	21'-2"	283	STR.							
A833 **				5	5	12'-4"	165	STR.							
A834				5	5	16'-1"	215	2	1'-4"	13'-5"	1'-4"				
A835				5	5	6'-0"	80	2	1'-4"	3'-9"	1'-4"				
A836				15	15	15'-0"	601	1	1'-4"	13'-11"					
A837				5	5	16'-9"	224	STR.							
A901	4		4		8	5'-6"	150	STR.							
A902	10		10		20	4'-3"	289	1	1'-7"	2'-11"					
A903		4		4	8	5'-9"	156	STR.							
A904		10		10	20	4'-5"	300	1	1'-7"	3'-1"					
A1001		12			12	19'-10"	1,024	STR.							
ABUTMENT - WEIGHTS (LBS.)															
SUBTOTAL	27,376	36,748	20,730	23,999											
							TOTAL		108,853						

3

3

NOTES:  
 FOR BAR SHAPE  
 DIAGRAMS, LEGEND  
 AND NOTES, SEE  
 SHEET 197/216.

5/1/2020 JANSSEN & SPANNS ENGINEERING INC. -  
 RECONFIGURED NORTHBOUND ON RAMP

DESIGNED DEB	DRAWN VFC	REVIEWED JTH	DATE 8/18	DESIGN AGENCY AECOM
CHECKED MRW	REVISED	STRUCTURE FILE NUMBER 4802765/4802767		564 WHITE POND DRIVE AKRON, OHIO 44320-1100 (330) 836-9111

REINFORCING LIST  
 BRIDGE NO. LUC-75-0029 L/R  
 I.R. 75 OVER MAUMEE RIVER

WOO/LUC-75-  
 30.70/0.00  
 PID No. 93592

200/216

1493  
 1792

Date: Oct 08, 2020, 4:38pm User Name: mlongtin  
 File: P:\1321 - Toledo E Value Engineering\DWG\BRIDGE\LUC-75-0027 over Maumee River\Sheets\025\_0027C\_RL010.dwg

MARK	NUMBER											LENGTH	WEIGHT	TYPE	DIMENSIONS					
	PIER 1NB-	PIER 2NB-	PIER 3NB-	PIER 4NB-	PIER 5NB-	PIER 6NB-	PIER 7NB-	PIER 8NB-	PIER 9NB-	PIER 10NB-	PIER 11NB-				TOTAL	A	B	C	D	E
PIERS - NORTHBOUND																				
PSP401 THRU PSP406 (NOT USED ON NB BRIDGE)																				
PSP407										3			3	17'-5"	1,389	27	4 1/2"	4'-6"	17'-5"	
PSP408 (NOT USED ON NB BRIDGE)																				
PSP409												3	16'-5"	1,314	27	4 1/2"	4'-6"	16'-5"		
PSP410 AND PSP411 (NOT USED ON NB BRIDGE)																				
PSP412	3											3	19'-11"	1,576	27	4 1/2"	4'-6"	19'-11"		
PSP413		3										3	19'-8"	1,565	27	4 1/2"	4'-6"	19'-8"		
PSP414			3	3								6	18'-10"	2,991	27	4 1/2"	4'-6"	18'-10"		
PSP415					3							3	18'-3"	1,451	27	4 1/2"	4'-6"	18'-3"		
PSP416						3						3	17'-8"	1,408	27	4 1/2"	4'-6"	17'-8"		
PSP417								3				3	16'-10"	1,345	27	4 1/2"	4'-6"	16'-10"		
PSP418											3	3	15'-11"	1,277	27	4 1/2"	4'-6"	15'-11"		
PSP419												3	15'-5"	1,239	27	4 1/2"	4'-6"	15'-5"		
P501	52	52	50	50	50	52	52	52	52	52	52	566	30'-0"	17,710	STR.					
P502	22											22	11'-5"	1,048	2	3'-4"	5'-0"	3'-4"		
P503 AND P504 (NOT USED ON NB BRIDGE)																				
P505	408		408	408								1,224	16'-8"	21,277	2	6'-10"	3'-3"	6'-10"		
P506						9	7	6	6	6	7	41	16'-3"	695	14	3'-4"	7'-2"	1'-10"	1'-10"	3'-4"
P507 THRU P511 (NOT USED ON NB BRIDGE)																				
P512						9						9	16'-9"	157	14	3'-4"	7'-8"	1'-10"	1'-10"	3'-4"
P513		4			88							92	19'-4"	1,855	STR.					
P514 THRU P518 (NOT USED ON NB BRIDGE)																				
P519							7	6	6	6	7	32	16'-7"	554	14	3'-4"	7'-2"	1'-10"	1'-10"	3'-4"
P520								22	22	22		66	10'-11"	750	2	3'-4"	4'-6"	3'-4"		
P521								408	408	408		1,224	15'-10"	20,214	2	6'-6"	3'-1"	6'-6"		
P522 AND P523 (NOT USED ON NB BRIDGE)																				
P524						22						22	13'-11"	319	2	3'-4"	7'-6"	3'-4"		
P525						408						408	17'-4"	7,376	2	6'-6"	4'-7"	6'-6"		
P526							86	86	86	86	86	344	25'-9"	9,240	STR.					
P527			22	22	22							66	10'-11"	751	2	3'-4"	4'-6"	3'-4"		
P528							22				22	44	11'-11"	546	2	3'-4"	5'-6"	3'-4"		
P529							376				376	752	16'-6"	12,942	2	6'-7"	3'-7"	6'-7"		
P530 THRU P533 (NOT USED ON NB BRIDGE)																				
P534 SER	4 SER OF 4	4 SER OF 4	4 SER OF 4	4 SER OF 4	2 SER OF 4	4 SER OF 4	4 SER OF 4	4 SER OF 4	4 SER OF 4	4 SER OF 4	4 SER OF 4	34 SER OF 4	25'-0" TO 26'-0"	3,617	STR.					4"
PSP535	3	3	3	3	3	3	3	3	3	3	3	33	7'-0"	14,915	27	3"	4'-6"	7'-0"		
P536 SER	(NOT USED ON NB BRIDGE)																			
P537	(NOT USED ON NB BRIDGE)																			
P538	(NOT USED ON NB BRIDGE)																			
P539 SER	(NOT USED ON NB BRIDGE)																			
P540	(NOT USED ON NB BRIDGE)																			
P541		408										408	18'-5"	7,837	2	7'-5"	3'-10"	7'-5"		
P542 SER	(NOT USED ON NB BRIDGE)																			
P543	(NOT USED ON NB BRIDGE)																			
P544	(NOT USED ON NB BRIDGE)																			
P545	(NOT USED ON NB BRIDGE)																			
P546	(NOT USED ON NB BRIDGE)																			
P547 SER	(NOT USED ON NB BRIDGE)																			
P548 SER	(NOT USED ON NB BRIDGE)																			
P549						88						88	26'-0"	2,386	STR.					
P550 SER						4 SER OF 4						4 SER OF 4	25'-0" TO 26'-0"	426	STR.					4"
P551							86					86	26'-2"	2,347	STR.					
P596	6	7	6	6	6							31	16'-9"	542	14	3'-4"	7'-8"	1'-10"	1'-10"	3'-4"
P597	6	7	6	6	6							31	16'-3"	504	14	3'-4"	7'-2"	1'-10"	1'-10"	3'-4"

NOTES:  
 FOR BAR SHAPE DIAGRAMS, LEGEND AND NOTES, SEE SHEET 197/216.  
 PIERS - NORTHBOUND TABLE CONTINUES ON SHEET 205/216.

5/1/2020 JANSSEN & SPAANS ENGINEERING INC. - REPLACED SHEET

DESIGNED WOZ	CHECKED CRG	DRAWN KRO	REVIEWED JTH	DATE 8/18	DESIGN AGENCY JANSSEN & SPAANS ENGINEERING, INC. 9120 HARRISON PARK COURT INDIANAPOLIS, IN 46216
REINFORCING LIST			STRUCTURE FILE NUMBER 4802765/4802767		
BRIDGE NO. LUC-75-0029 L/R I.R. 75 OVER MAUMEE RIVER					
WOO/LUC-75-30.70/0.00 PID No. 93592					
204/216					
(1497/1792)					

Date: Oct 08, 2020, 4:39pm User Name: mlongin  
 File: P:\11321 - Toledo E Value Engineering\DWG\BRIDGE\LUC-75-0027 over Maumee River\Sheets\07\_0027C\_RL011.dwg

MARK	NUMBER											LENGTH	WEIGHT	TYPE	DIMENSIONS						
	PIER 1NB-	PIER 2NB-	PIER 3NB-	PIER 4NB-	PIER 5NB-	PIER 6NB-	PIER 7NB-	PIER 8NB-	PIER 9NB-	PIER 10NB-	PIER 11NB-				TOTAL	A	B	C	D	E	R
PIERS - NORTHBOUND (CONTINUED)																					
P552 SER												4 SER OF 4								4"	
P553	(NOT USED ON NB BRIDGE)																				
P554	30	30	30	30	30	30	30	30	30	30	30	330	14'-9"	5,077	42	4'-6"	14'-4"	4"			
P555 THRU P557 (NOT USED ON NB BRIDGE)																					
P558	36											36	6'-5"	241	2	10"	5'-0"	10"			
P559	20	9										59	12'-6"	378	1	10"	11'-10"				
P560 (NOT USED ON NB BRIDGE)																					
P561 THRU P563 (NOT USED ON NB BRIDGE)																					
P564								5	5	5		15	15'-4"	240	2	10"	13'-11"	10"			
P565	(NOT USED ON NB BRIDGE)																				
P566	(NOT USED ON NB BRIDGE)																				
P567		22										22	12'-5"	285	2	3'-4"	6'-0"	3'-4"			
P568 (NOT USED ON NB BRIDGE)																					
P569	20	20	20	20	30							130	11'-8"	1,582	1	10"	11'-0"				
P573			36	36	36			36	36	36		216	5'-11"	1,333	2	10"	4'-6"	10"			
P574										36		36	8'-11"	335	2	10"	7'-6"	10"			
P578		5					3	20	20	20	20	108	13'-0"	1,464	1	10"	12'-4"				
P579	5	5	5	5	5	6	5				5	41	15'-7"	666	2	10"	14'-2"	10"			
P580											36	72	6'-11"	519	2	10"	5'-6"	10"			
P581 AND P582 (NOT USED ON NB BRIDGE)																					
P583			5	5	5							15	15'-11"	239	2	10"	14'-6"	10"			
P584 THRU P593 (NOT USED ON NB BRIDGE)																					
P594					40							40	32'-0"	1335	STR						
P595 SER.					2 SER OF 4							2 SER OF 4	31'-0" TO 32'-0"	263	STR.					4"	
P596	6	7	6	6	6							31	17'-1"	552	14	3'-7"	7'-6"	1'-10"	1'-10"	3'-7"	
P597	6	7	6	6	6							31	16'-9"	542	14	3'-7"	7'-2"	1'-10"	1'-10"	3'-7"	
P598	88	92	82	82	82							386	26'-0"	10,468	STR						
P599		36										36	7'-5"	278	2	10"	6'-0"	10"			
P601 (NOT USED ON NB BRIDGE)																					
P602					480							480	17'-5"	12,557	2	7'-3"	3'-3"	7'-3"			
P603 THRU P606 (NOT USED ON NB BRIDGE)																					
P607								6				6	18'-8"	168	33	5'-9"	3'-0"				
P608								8				16	4'-4"	104	1	1'-7"	2'-11"				
P609 THRU P613 (NOT USED ON NB BRIDGE)																					
P614											8	8	4'-5"	53	1	1'-7"	3'-0"				
P615											6	6	18'-10"	170	33	5'-9"	3'-1"				
P901 AND P903 (NOT USED ON NB BRIDGE)																					
P904 (NOT USED ON NB BRIDGE)																					
P905								4			4	8	5'-9"	156	STR.						
P906								20				20	4'-3"	289	1	1'-7"	2'-11"				
P907 THRU P910 (NOT USED ON NB BRIDGE)																					
P911											20	20	4'-4"	295	1	1'-7"	3'-0"				

NOTES:  
 FOR BAR SHAPE DIAGRAMS, LEGEND AND NOTES, SEE SHEET 197/216.  
 PIERS - NORTHBOUND TABLE CONTINUES ON SHEET 206/216.

5/11/2020 JANSSEN & SPAANS ENGINEERING INC. - REPLACED SHEET

DESIGN AGENCY  
 JANSSEN & SPAANS ENGINEERING, INC.  
 9120 HARRISON PARK COURT  
 INDIANAPOLIS, IN 46216

DATE 8/18  
 REVIEWED JTH  
 STRUCTURE FILE NUMBER 4802765/4802767

DRAWN KRO  
 CHECKED WJZ  
 REVISIONS  
 REINFORCING LIST  
 BRIDGE NO. LUC-75-0029 L/R  
 I.R. 75 OVER MAUMEE RIVER

W00/LUC-75-30.70/0.00  
 PID No. 93592  
 205/216  
 1498  
 1792



Date: Oct 08, 2020, 4:39pm User Name: mlongtin  
 File: P:\11321 - Toledo E Value Engineering\DWG5\BRIDGE\LUC-75-0027 over Maumee River\Sheets\075\_0027C\_RL004.dwg

MARK	NUMBER											LENGTH	WEIGHT	TYPE	DIMENSIONS							
	PIER 1NB-	PIER 2NB-	PIER 3NB-	PIER 4NB-	PIER 5NB-	PIER 6NB-	PIER 7NB-	PIER 8NB-	PIER 9NB-	PIER 10NB-	PIER 11NB-				TOTAL	A	B	C	D	E	R	INC
PIERS - NORTHBOUND (CONTINUED)																						
P1001 (NOT USED ON NB BRIDGE)																						
P1002 THRU P1008 (NOT USED ON NB BRIDGE)																						
P1009 THRU P1015 (NOT USED ON NB BRIDGE)																						
P1016							40		40		40	120	29'-6"	15,233	STR.							
P1017 THRU P1018 (NOT USED ON NB BRIDGE)																						
P1019						40						40	30'-8"	5,278	STR.							
P1020 THRU P1021 (NOT USED ON NB BRIDGE)																						
P1022	72	72	72	72	52			32	52	52	52	54	550	33'-0"	78,099	STR.						
P1023 THRU P1027 (NOT USED ON NB BRIDGE)																						
P1028						60							60	36'-8"	9,467	STR.						
P1029 (NOT USED ON NB BRIDGE)																						
P1030						20	16	16	16	16	16		100	22'-10"	9,825	STR.						
P1031 (NOT USED ON NB BRIDGE)																						
P1032**					42								42	27'-11"	5,045	16	25'-6"					
P1033 AND P1034 (NOT USED ON NB BRIDGE)																						
P1035**					42								42	29'-11"	5,407	16	27'-6"					
P1036 THRU P1053 (NOT USED ON NB BRIDGE)																						
P1054**										42			42	24'-10"	4,488	16	23'-5"					
P1055**										42			42	26'-10"	4,849	16	25'-5"					
P1056 AND P1057 (NOT USED ON NB BRIDGE)																						
P1058**	42												42	28'-5"	5,136	16	27'-0"					
P1059**	42												42	30'-5"	5,497	16	29'-0"					
P1060**		42											42	26'-8"	4,819	16	25'-3"					
P1061**		42											42	28'-8"	5,181	16	27'-3"					
P1062**			42	42									84	27'-2"	9,819	16	25'-9"					
P1063**			42	42									84	29'-2"	10,542	16	27'-9"					
P1064**						42							42	26'-1"	4,714	16	24'-8"					
P1065**						42							42	28'-1"	5,075	16	26'-8"					
P1066**								33					33	25'-8"	3,645	16	24'-3"					
P1067**								33					33	27'-8"	3,929	16	26'-3"					
P1068**									42				42	25'-3"	4,563	16	23'-10"					
P1069**									42				42	27'-3"	4,925	16	25'-10"					
P1070**											42		42	24'-4"	4,398	16	22'-11"					
P1071**												42	42	26'-4"	4,759	16	24'-11"					
P1072**												33	33	23'-11"	3,396	16	22'-6"					
P1073**												33	33	25'-11"	3,680	16	24'-6"					
P1074 AND P1075 (NOT USED ON NB BRIDGE)																						
P1076								44					44	88	29'-9"	11,265	STR.					
P1077 THRU P1084 (NOT USED ON NB BRIDGE)																						
P1085					20								20	39'-0"	3,356	STR.						
P1086	16	16	16	16	16								80	28'-0"	9,639	STR.						
P1087	20	20	20	20	20								100	32'-0"	13,770	STR.						
													TOTAL	443,416								

NOTES:  
 FOR BAR SHAPE  
 DIAGRAMS, LEGEND  
 AND NOTES, SEE  
 SHEET 197/216.

5/1/2020 JANSSEN & SPAANS ENGINEERING INC. -  
 3 REPLACED SHEET

REINFORCING LIST BRIDGE NO. LUC-75-0029 L/R I.R. 75 OVER MAUMEE RIVER	DESIGN AGENCY JANSSEN & SPAANS ENGINEERING, INC. 9120 HARRISON PARK COURT INDIANAPOLIS, IN 46216	DATE 8/18	REVIEWED JTH STRUCTURE FILE NUMBER 4802765/4802767
W00/LUC-75- 30.70/0.00 PID No. 93592	206/216	1499 1792	

Date: Oct 07, 2020, 4:57pm User Name: mlongtin  
 File: P:\11321 - Toledo E Value Engineering\DWG\BRIDGE\LUC-75-0027 over Maumee River\Sheets\075\_0027C\_RL012.dwg

MARK	NUMBER				LENGTH	WEIGHT	TYPE	DIMENSIONS					
	UNIT 1	UNIT 2	UNIT 3	TOTAL				A	B	C	D	E	R
<b>END DIAPHRAGMS - SOUTHBOUND</b>													
D401	12	30	40	82	14'-10"	813	24	0'-4"	7'-2"			0'-2"	
D402	12	30	40	82	3'-7"	196	41	1'-6"	0'-9"	0'-2"			
D403	44	108	140	292	6'-0"	1,170	2	0'-8"	4'-10"	0'-8"			
D404	66	135	245	446	17'-11"	5,338	6	2'-4"	7'-4"	0'-8"			
D405	264	198	210	672	10'-6"	4,713	2	4'-6"	1'-9"	4'-6"			
D501	16	16	16	48	3'-10"	192	2	1'-6"	1'-1"	1'-6"			
D502	16	16	16	48	4'-4"	217	2	1'-9"	1'-1"	1'-9"			
D601	132			132	8'-5"	1,669	STR.						
D602	66		84	150	9'-6"	2,140	STR.						
D603	30			30	26'-4"	1,187	STR.						
D604	66			66	7'-4"	727	STR.						
D605	24	24		48	26'-0"	1,874	STR.						
D606		54		54	9'-2"	743	STR.						
D607		162		162	6'-7"	1,602	STR.						
D608		18	18	36	25'-6"	1,379	STR.						
D609		108		108	8'-1"	1,311	STR.						
D610		108		108	7'-2"	1,163	STR.						
D611			294	294	8'-9"	3,864	STR.						
D612			84	84	9'-0"	1,136	STR.						
D613			18	18	28'-3"	764	STR.						
D614			42	42	9'-11"	626	STR.						
D801	44			44	7'-11"	930	2	1'-4"	5'-8"	1'-4"			
D802	27			27	8'-11"	643	2	1'-4"	6'-8"	1'-4"			
D803	3			3	6'-9"	54	2	1'-4"	4'-6"	1'-4"			
D804	3	6		9	6'-5"	154	2	1'-4"	4'-2"	1'-4"			
D805	5			5	27'-10"	372	STR.						
D806	27			27	6'-11"	499	2	1'-4"	4'-8"	1'-4"			
D807	33			33	12'-0"	1,057	20	4'-3"	2'-2"	1'-3"	5'-7"	2'-5"	
D808	33			33	12'-0"	1,057	20	4'-3"	2'-2"	1'-3"	5'-3"	3'-0"	
D809	6			6	4'-4"	69	2	1'-4"	2'-1"	1'-4"			
D810	4	4		8	27'-6"	587	STR.						
D811	33			33	10'-10"	955	20	4'-3"	2'-2"	1'-3"	4'-6"	2'-0"	
D812	33			33	10'-11"	962	20	4'-3"	2'-2"	1'-6"	4'-2"	2'-4"	
D813		21		21	8'-6"	477	2	1'-4"	6'-3"	1'-4"			
D814		54		54	11'-9"	1,694	20	4'-3"	2'-2"	1'-3"	5'-3"	2'-7"	
D815		6		6	4'-0"	64	2	1'-4"	1'-9"	1'-4"			
D816		21		21	6'-2"	346	2	1'-4"	3'-11"	1'-4"			
D817		3	3	6	27'-2"	435	STR.						
D818		27		27	10'-1"	727	20	4'-3"	2'-2"	1'-3"	3'-9"	1'-9"	
D819		27		27	10'-1"	727	20	4'-3"	2'-2"	1'-3"	3'-8"	2'-0"	
D820		36		36	7'-5"	713	2	1'-4"	5'-2"	1'-4"			
D821		36		36	6'-8"	641	2	1'-4"	4'-5"	1'-4"			
D822		36		36	6'-3"	601	2	1'-4"	4'-0"	1'-4"			
D823			14	14	6'-0"	224	2	1'-4"	3'-9"	1'-4"			
D824			20	20	8'-2"	436	2	1'-4"	5'-11"	1'-4"			
D825			71	71	8'-4"	1,580	2	1'-4"	6'-1"	1'-4"			
D826			28	28	8'-7"	642	2	1'-4"	6'-4"	1'-4"			
D827			28	28	9'-1"	679	2	1'-4"	6'-10"	1'-4"			
D828			21	21	11'-5"	640	20	4'-3"	2'-2"	1'-3"	5'-0"	2'-4"	
D829			21	21	11'-7"	650	20	4'-3"	2'-2"	1'-3"	5'-0"	2'-7"	
D830			21	21	9'-6"	533	2	1'-4"	7'-3"	1'-4"			
D831			21	21	12'-2"	682	20	4'-3"	2'-2"	1'-3"	5'-8"	2'-7"	
D832			21	21	12'-1"	678	20	4'-3"	2'-2"	1'-3"	5'-6"	2'-10"	
D833			3	3	30'-0"	240	STR.						
<b>TOTAL</b>						<b>53,572</b>							

MARK	NUMBER				LENGTH	WEIGHT	TYPE	DIMENSIONS					
	UNIT 1	UNIT 2	UNIT 3	TOTAL				A	B	C	D	E	R
<b>END DIAPHRAGMS - NORTHBOUND</b>													
D401	8	24	40	72	14'-10"	713	24	0'-4"	7'-2"			0'-2"	
D402	8	24	40	72	3'-7"	172	41	1'-6"	0'-9"	0'-2"			
D403	28	84	140	252	6'-0"	1,010	2	0'-8"	4'-10"	0'-8"			
D404	42	126	245	413	17'-11"	4,943	6	2'-4"	7'-4"	0'-8"			
D405	168	168	196	532	10'-6"	3,731	2	4'-6"	1'-9"	4'-6"			
D501	16	16	16	48	3'-10"	192	2	1'-6"	1'-1"	1'-6"			
D502	16	16	16	48	4'-4"	217	2	1'-9"	1'-1"	1'-9"			
D601	84	252		336	8'-10"	4,458	STR.						
D602 THRU D607 (NOT USED ON NB BRIDGE)													
D608			18	18	28'-3"	764	STR.						
D609 (NOT USED ON NB BRIDGE)													
D610 (NOT USED ON NB BRIDGE)													
D611	42	84	378	504	8'-9"	6,624	STR.						
D612 THRU D614 (NOT USED ON NB BRIDGE)													
D615	12			12	38'-6"	693	STR.						
D616 THRU D621 (NOT USED ON NB BRIDGE)													
D622			18	18	26'-10"	725	STR.						
D623			84	84	8'-11"	1,125	STR.						
D624			42	42	9'-4"	589	STR.						
D625	12	24		36	36'-9"	1987	STR.						
D801	28	84		112	8'-4"	2,491	2	1'-4"	6'-1"	1'-4"			
D802	15		15	30	8'-11"	714	2	1'-4"	6'-8"	1'-4"			
D803 THRU D815 (NOT USED ON NB BRIDGE)													
D816	6	12	16	34	6'-2"	560	2	1'-4"	3'-11"	1'-4"			
D817			3	3	27'-2"	218	STR.						
D818 THRU D820 (NOT USED ON NB BRIDGE)													
D821	6		6	12	6'-8"	214	2	1'-4"	4'-5"	1'-4"			
D822 THRU D824 (NOT USED ON NB BRIDGE)													
D825	15	30	145	190	8'-4"	4,227	2	1'-4"	6'-1"	1'-4"			
D826 THRU D828 (NOT USED ON NB BRIDGE)													
D829			21	21	11'-7"	650	20	4'-3"	2'-2"	1'-3"	5'-0"	2'-7"	
D830 THRU D835 (NOT USED ON NB BRIDGE)													
D836	42		21	63	11'-11"	2,005	20	4'-3"	2'-2"	1'-3"	5'-5"	2'-6"	
D837			21	21	11'-11"	668	20	4'-3"	2'-2"	1'-3"	5'-4"	2'-9"	
D838	42	84		126	11'-4"	3,813	20	4'-3"	2'-2"	1'-3"	4'-11"	2'-3"	
D839 THRU D841 (NOT USED ON NB BRIDGE)													
D842	3	6		9	28'-2"	677	STR.						
D843 THRU D846 (NOT USED ON NB BRIDGE)													
D847		3	3	6	28'-7"	458	STR.						
D848 AND D849 (NOT USED ON NB BRIDGE)													
D850			21	21	11'-7"	649	20	4'-3"	2'-2"	1'-3"	5'-1"	2'-5"	
<b>TOTAL</b>						<b>45,287</b>							

ALL NORTHBOUND DIAPHRAGM REINFORCEMENT TO BE GRADE 75 ksi

NOTES:  
 FOR BAR SHAPE DIAGRAMS, LEGEND  
 AND NOTES, SEE SHEET 197/216

DESIGN AGENCY JANSSEN & SPAANS ENGINEERING, INC.  
 9120 HARRISON PARK COURT  
 INDIANAPOLIS, IN 46216  
 DATE 5/20  
 STRUCTURE FILE NUMBER 4802765/4802767  
 REVIEWED WJZ  
 DRAWN TLH  
 CHECKED CBS  
 DESIGNED WJZ  
 REINFORCING LIST  
 BRIDGE NO. LUC-75-0029 L/R  
 I.R. 75 OVER MAUMEE RIVER  
 WOO/LUC-75-30.70/0.00  
 PID No. 93592  
 207/216  
 1500  
 1792

Date: Oct 08, 2020, 4:40pm User Name: mlongtin  
 File: P:\1321 - Toledo E Value Engineering\DWG\BRIDGE\LUC-75-0027 over Maumee River\Sheets\027\_0027C\_RL015.dwg

	NUMBER				LENGTH	WEIGHT	TYPE	DIMENSIONS			
	UNIT 1	UNIT 2	UNIT 3	TOTAL				A	B	C	INC
SLAB - NORTHBOUND											
S401			539	1,752	30'-0"	35,110	STR.				
S402 THRU S405 (NOT USED ON NB BRIDGE)											
S406			100		9'-0"	601	STR.				
S407			177		11'-6"	1,360	STR.				
S408		600		1,524	28'-0"	28,505	STR.				
S409			77		12'-6"	643	STR.				
S410	59				19'-6"	769	STR.				
S411	59				8'-7"	338	STR.				
S412	892	3,624	4,111			27,854	39	1'-8?"	0'-4"	0'-8"	
S413		140		140		452	39	1'-8?"	0'-4"	0'-10"	
S5001 (NOT USED ON NB BRIDGE)											
S5002		165		165	24'-0"		STR.				
S5003 THRU S5009 (NOT USED ON NB BRIDGE)											
S5010	1,250	2,329	4,410	7,989	30'-0"	249,000					
S5011 (NOT USED ON NB BRIDGE)											
S5012		193		193	33'-0"	6,643	STR.				
S5013 THRU S5016 (NOT USED ON NB BRIDGE)											
S5017 SER.		1 SER. OF 5		1 SER. OF 5	4'-11" TO 18'-3"	60	STR.				3'-4"
S5018 THRU S5024 (NOT USED ON NB BRIDGE)											
S5025			228	228	22'-9"	5,410	STR.				
S5026 THRU S5040 (NOT USED ON NB BRIDGE)											
S5041	89	137		226	11'-6"	2,711	STR.				
S5042 THRU S5045 (NOT USED ON NB BRIDGE)											
S5046	1,050	484		1,534	23'-7"	37,732	STR.				
S5047			221	221	25'-0"	5,763	STR.				
S5048 THRU S5051 (NOT USED ON NB BRIDGE)											
S5052		370		370	29'-6"	11,384	STR.				
S5053	525			525	21'-8"	11,864	STR.				
S5054 THRU S5059 (NOT USED ON NB BRIDGE)											
S5060		484		484	28'-6"	14,387	STR.				
S5061 THRU S5069 (NOT USED ON NB BRIDGE)											
S5070			1,255	1,255	24'-9"	32,397	STR.				
S5071 (NOT USED ON NB BRIDGE)											
S5072			1,521	1,521	25'-2"	39,925	STR.				
S5073 THRU S5086 (NOT USED ON NB BRIDGE)											
S5087		193		193	35'-0"	7,045	STR.				
S5088 THRU S5090 (NOT USED ON NB BRIDGE)											
S5091		137	102	239	14'-6"	3,615	STR.				
S5092		822	1,224	2,046	28'-10"	57,262	STR.				
S5093			102	102	14'-9"	1,569	STR.				
S5094 (NOT USED ON NB BRIDGE)											
S5095 SER.		2 SER. OF 5		2 SER. OF 5	5'-11" TO 19'-3"	131					3'-4"
S5096 SER.			1 SER. OF 8	1 SER. OF 8	3'-7" TO 28'-2"		STR.				3'-4"
S5097 (NOT USED ON NB BRIDGE)											
S5098	89	822		911		20,904	STR.				
S5099	1,051				19'-6"	21,376	STR.				
S5100 SER.			1 SER. OF 7		2'-1" TO 22'-1"	88	STR.				3'-4"
S5101				1,247	20'-10"	27,096	STR.				
S5102 SER.			1 SER. OF 10	1 SER. OF 10	1'-2" TO 28'-2"	153	STR.				3'-0"
S5103 SER.			1 SER. OF 6		3'-3" TO 19'-11"	73	STR.				3'-4"
S5104 SER.			1 SER. OF 5	1 SER. OF 5	5'-9" TO 19'-1"	65	STR.				3'-4"

MARK	NUMBER				LENGTH	WEIGHT	TYPE	DIMENSIONS			
	UNIT 1	UNIT 2	UNIT 3	TOTAL				A	B	C	INC
SLAB - NORTHBOUND (CONTINUED)											
S5105 SER.	3 SER. OF 6			3 SER. OF 6	3'-7" TO 20'-3"	224	STR.				3'-4"
S5106 SER.			1 SER. OF 8	1 SER. OF 8	3'-7" TO 24'-7"	118	STR.				
S5107 SER.			1 SER. OF 9	1 SER. OF 9	5'-1" TO 29'-1"	160	STR.				3'-0"
S5108 SER.			1 SER. OF 9	1 SER. OF 9	2'-5" TO 29'-1"	148	STR.				3'-4"
S5109 SER.	1 SER. OF 5			1 SER. OF 5	3'-1" TO 16'-5"						3'-4"
S5110 SER.	1 SER. OF 7			1 SER. OF 7	6'-4" TO 16'-5"	119	STR.				3'-4"
S5111 SER.	1 SER. OF 4			1 SER. OF 4	10'-0" TO 16'-2"	47	STR.				3'-4"
S5112 SER.	1 SER. OF 7			1 SER. OF 7	6'-10" TO 26'-10"	123	STR.				3'-4"
S5113 SER.	1 SER. OF 5			1 SER. OF 5	3'-7" TO 16'-11"	53	STR.				3'-4"
S5114				994	26'-10"	27,819	STR.				
S5115				165	34'-7"	5,952	STR.				
S5116		1,081	332	1,413	25'-9"	37,949	STR.				
S5117		77		77	23'-1"	1,854	STR.				
S5118		193	1,246	1,439	31'-1"	46,652	STR.				
S5119		436		436	32'-6"	14,779	STR.				
S5120				436	30'-4"	13,794	STR.				
S5121				436	31'-9"	14,438	STR.				
S5122 SER.		1 SER. OF 9		1 SER. OF 9	2'-3" TO 26'-3"	134	STR.				3'-0"
S5123 SER.	1 SER. OF 7			1 SER. OF 7	4'-10" TO 22'-10"	101	STR.				3'-0"
S5124 SER.	1 SER. OF 10			1 SER. OF 10	3'-6" TO 27'-9"	188	STR.				3'-0"
S5125 SER.	1 SER. OF 7			1 SER. OF 7	5'-5" TO 23'-5"		STR.				3'-0"
S5126 SER.	1 SER. OF 7			1 SER. OF 7	7'-9" TO 27'-9"	130	STR.				3'-4"
S5127 SER.	1 SER. OF 7			1 SER. OF 7	5'-2" TO 25'-2"	111	STR.				3'-4"
S5128 SER.	1 SER. OF 8			1 SER. OF 8	2'-3" TO 25'-7"	116	STR.				3'-4"
S5129		789		789	20'-8"	17,007	STR.				
S5130 SER.	1 SER. OF 10			1 SER. OF 10	3'-9" TO 30'-0"	176	STR.				2'-11"
S5131 SER.	1 SER. OF 8			1 SER. OF 8	6'-1" TO 26'-6"	136	STR.				2'-11"
S5132 SER.	1 SER. OF 7			1 SER. OF 7	7'-0" TO 24'-6"	115	STR.				2'-11"

5/1/2020 JANSSEN & SPANNS ENGINEERING INC. -  
 RECONFIGURED NORTHBOUND ON RAMP THIS SHEET  
 TO BE REPLACED WITH SHEET 210A

DESIGNED DEB	CHECKED MRW	DRAWN VFC	REVIEWED JTH	DATE 8/18
REINFORCING LIST BRIDGE NO. LUC-75-0029 L/R I.R. 75 OVER MAUMEE RIVER				
W00/LUC-75- 30.70/0.00 PID No. 93592				
210/216				



564 WHITE POND  
 AKRON, OHIO 44333  
 (330) 836-9111


FOR THE PURPOSE OF  
 DIAGNOSIS AND  
 AND NOT FOR  
 SHEET 197/216  
 SLAB REINFORCING  
 TABLE CONTINUES  
 ON SHEET 211/216.

Date: Nov 24, 2020, 1:53pm User Name: mlongtin  
 File: \\uss.com\files\Projects\1321 - Toledo E Value Engineering\DWGS\BRIDGE\LUC-75-0027 over Maumee River\Sheets\075\_0027C\_RL015\_R1.dwg

MARK	NUMBER				LENGTH	WEIGHT	TYPE	DIMENSIONS											
	UNIT 1	UNIT 2	UNIT 3	TOTAL				A	B	C	D	E	F	INC					
SLAB - NORTHBOUND																			
S412	1984	3200	4111	9295	4'-10"	30,010	39	1'-8 1/2"	4"	8"									
S414	2441	5169	7536	15,146	60'-0"	607,052	STR.												
S415			183	183	59'-3"	7243	STR.												
S416		183		183	39'-7"	4,839	STR.												
S417	183			183	27'-3"	3,331	STR.												
S418	688			688	23'-8"	10,877	STR.												
S419	306			306	20'-10"	4,258	STR.												
S420	496	3,156	4,608	8,290	19'-6"	107,986	STR.												
S421	1,680	3,540	5,168	10,388	9'-6"	65,922	16	9'-0"											
S5010	144	192	288	624	30'-0"	19,525	STR.												
S5146	8	8	24	40	3'-2"	132	STR.												
S5147	8	8	24	40	8'-10"	369	9	4 1/2"	3'-2"	2'-9"	3'-2"								
S5148	4	4	12	20	8'-1"	169	21	1'-3"	1'-10"	0'-6"	2'-4"								
S5149	630	1,357	1,956	3,943	4'-9"	17,820	37	1'-7 1/4"	7 1/2"	0'-5"	1'-0"	7 1/2"	11 3/4"						
S5150	636	716	1,047	2,099	13'-0"	28,460	35	7 1/2"	1'-5"	1'-0"	4'-7"								I.R.=3"
S601	112	318	530	960	30'-0"	43,258	STR.	2											
S702	18	48	22	88	14'-8"	2,638	2	10'-11"	5"	3'-8"									
S708	27	72	99	198	7'-9"	3,137	STR.												
S901	78	225	375	678	60'-0"	138,312	STR.												
S902	78	225	375	678	46'-2"	106,423	STR.												
TOTAL						1,201,761	2												


ALL NORTHBOUND SLAB REINFORCEMENT TO BE GRADE 75 ksi

BAR SHAPE DIAGRAMS

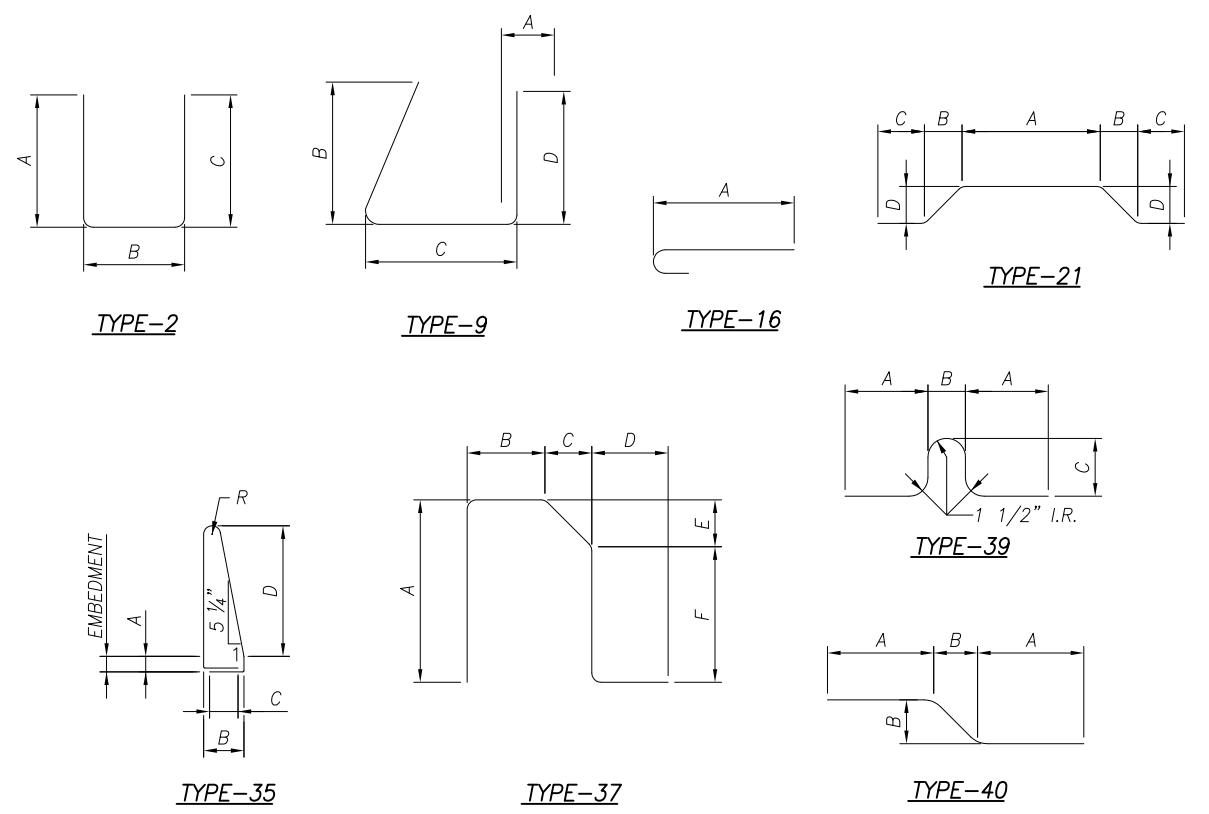

NOTES:

- 1. BAR DIMENSIONS SHOWN ARE OUT TO OUT UNLESS OTHERWISE INDICATED.
- 2. ALL REINFORCING IS TO BE EPOXY COATED.
- 3. THE BAR SIZE NUMBER IS SPECIFIED ON THE PLANS IN THE BAR MARK COLUMN. THE FIRST DIGIT WHERE THREE DIGITS ARE USED, AND THE FIRST TWO DIGITS WHERE FOUR ARE USED, INDICATES THE BAR SIZE NUMBER (WITH EXCEPTION FOR ALL "S" SLAB BARS, ONLY THE FIRST DIGIT OF THE FOUR DIGIT NUMBER INDICATES THE BAR SIZE NUMBER).

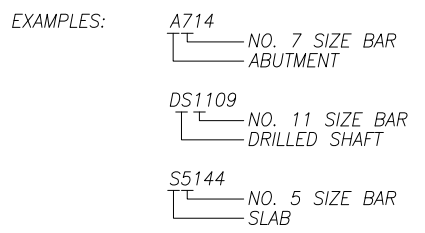

11/23/2020 JANSSEN & SPAANS ENGINEERING INC.  
 - REVISED REINFORCING OVER PIERS.  
 5/11/2020 JANSSEN & SPAANS ENGINEERING INC. - RECONFIGURED  
 NORTHBOUND ON RAMP, THIS SHEET TO REPLACE SHEETS 210 & 211.  
 DESIGN AGENCY: JANSSEN & SPAANS ENGINEERING, INC.  
 9120 HARRISON PARK COURT  
 INDIANAPOLIS, IN 46216  
 DATE: 5/2020  
 W.O.Z. STRUCTURE FILE NUMBER: 4802765/4802767  
 DRAWN: REM  
 CHECKED: CBS  
 REVIEWED: W.O.Z.

REINFORCING LIST  
 BRIDGE NO. LUC-75-0029 L/R  
 I.R. 75 OVER MAUMEE RIVER

WOO/LUC-75-  
 30.70/0.00  
 PID No. 93592

MARK	NUMBER				LENGTH	WEIGHT	TYPE	DIMENSIONS								
	UNIT 1	UNIT 2	UNIT 3	TOTAL				A	B	C	D	E	F	INC		
<b>SLAB - NORTHBOUND (CONTINUED)</b>																
S5133 SER.		1 SER. OF 8		1 SER. OF 8	8'-2" TO 28'-7"	153	STR.									2'-11"
S5134 SER.		1 SER. OF 6		1 SER. OF 6	5'-6" TO 22'-2"	87	STR.									
S5135 SER.		1 SER. OF 5	1 SER. OF 5	2 SER. OF 5	5'-2" TO 18'-6"	123	STR.									3'-4"
S5136 SER.		1 SER. OF 8		1 SER. OF 8	1'-1" TO 24'-5"	106	STR.									3'-4"
S5137			447	447	33'-6"	15,618	STR.									
S5138			282	282	24'-7"	7,231	STR.									
S5139 SER.			1 SER. OF 9	1 SER. OF 9	1'-2" TO 25'-2"	124	STR.									3'-0"
S5140 SER.			1 SER. OF 10	1 SER. OF 10	4'-10" TO 31'-10"	191	STR.									3'-0"
S5141 SER.			1 SER. OF 8	1 SER. OF 8	4'-0" TO 25'-0"		STR.									3'-0"
S5142 SER.			1 SER. OF 7	1 SER. OF 7	4'-0" TO 25'-0"	109	STR.									3'-4"
S5143 SER.			1 SER. OF 9	1 SER. OF 9	3'-3" TO 29'-11"	156	STR.									3'-4"
S5144	24	56		168	2'-9"	482	40	1'-0"	0'-7"							
S5145	12	28		84	9'-6"	832	STR.									
S5146		18		14	3'-2"	145	STR.									
S5147			28		8'-10"	405	9	0'-4 1/2"	3'-2"	2'-9"	3'-2"					
S5148			14		8'-1"	185	21	1'-3"	1'-10"	0'-6"	2'-4"					
S5149	67	255	1,956	3,928	19'-9"	19,440	37	1'-7/4"	0'-7 1/2"	0'-5"	1'-0"	0'-7/2"	0'-11 3/4"			
S5150		716	1,047	2,099		28,460	35	0'-7 1/2"	1'-5"	1'-0"	4'-7"					I.R.=3"
S5151	(NOT USED ON NB BRIDGE)															
S5152	36	370	314	940	2'-9"											
S5153	(NOT USED ON NB BRIDGE)															
S5154			5	5	22'-0"											
S5155	5			5	9'-6"	50										
S5156	5			5	9'-9"	51										
S5157		5		5	22'-6"	117	STR.									
S5158		5		5	26'-5"	138	STR.									
S5159			5	5	26'-0"	136	STR.									
S701	(NOT USED ON NB BRIDGE)															
S702	1,069	2,375	3,472	6,916	14'-8"	207,332	2	10'-11"	0'-5"							
S703	1,056			1,056	34'-3"	73,927	STR.									
S704 THRU S705	(NOT USED ON NB BRIDGE)															
S706		5,139	5,184	10,323	33'-11"	715,649	STR.									
S707			1,296	1,296	32'-11"	87,197	STR.									
S708	27	63	99	189	7'-9"	2,994	STR.									
<b>SLAB - NORTHBOUND WEIGHTS (LBS.)</b>																
SUBTOTAL	229,556	794,244	980,687													
						<b>TOTAL</b>	<b>2,004,487</b>									

5/1/2020 JANSSEN & SPANNS ENGINEERING INC. -  
 RECONFIGURED NORTHBOUND ON RAMP THIS SHEET  
 TO BE REPLACED WITH SHEET 210A

DESIGNED	DEB	CHECKED	MRW
DRAWN	VFC	REVIEWED	JTH
DATE	8/18	STRUCTURE FILE NUMBER	4802765/4802767
DESIGN AGENCY	AECOM		
564 WHITE POND AKRON, OHIO 44333 (330) 836-9111			

REINFORCING LIST  
 BRIDGE NO. LUC-75-0029 L/R  
 I.R. 75 OVER MAUMEE RIVER

W00/LUC-75-  
 30.70/0.00  
 PID No. 93592

Date: Oct 07, 2020, 4:56pm User Name: mlongtin  
 File: P:\11221 - Toledo E Value Engineering\DWG\BRIDGE\LUC-75-0027 over Maumee River\Sheets\02\_0027C\_RL017\_RL.dwg

MARK	NUMBER				LENGTH	WEIGHT	TYPE	DIMENSIONS				
	UNIT 1	UNIT 2	UNIT 3	TOTAL				A	B	C	D	E
BARRIERS - SOUTHBOUND												
R501	642	1,347	1,956	3,945	5'-5"	22,288	38	2'-2"	0'-6"	0'-3"	2'-4"	0'-9"
R502	44	96	140	280	30'-0"	8,761	STR.					
R503	4			4	17'-3"	72	STR.					
R504	90	96	84	270	13'-8"	3,849	STR.					
R505	72	216	360	648	7'-2"	4,844	STR.					
R506	6			6	3'-7"	22	STR.					
R507	6			6	8'-6"	53	STR.					
R508		4		4	19'-3"	80	STR.					
R509		12	6	18	8'-5"	158	STR.					
R510		72	144	216	12'-4"	2,778	STR.					
R511			4	4	29'-2"	122	STR.					
R512			6	6	9'-6"	59	STR.					
R513	4	16	28	48	8'-1"	405	21	1'-3"	1'-10"	0'-6"	2'-4"	
R514	4	16	28	48	3'-3"	163	2	0'-7"	2'-4"	0'-7"		
R601	44	96	204	344	30'-0"	15,501	STR.					
R602	4			4	29'-7"	178	STR.					
R603	56			56	14'-7"	1,226	STR.					
R604	108	324	480	912	7'-2"	9,818	STR.					
R605	72			72	13'-4"	1,442	STR.					
R606	15	16	14	45	13'-8"	924	STR.					
R607	1			1	3'-7"	5	STR.					
R608	1			1	8'-6"	13	STR.					
R609		4		4	39'-11"	240	STR.					
R610		72		72	13'-3"	1,433	STR.					
R611		48		48	12'-7"	907	STR.					
R612		48		48	12'-6"	901	STR.					
R613		72	72	144	13'-1"	2,830	STR.					
R614		2	1	3	8'-5"	38	STR.					
R615			4	4	25'-0"	150	STR.					
R616		12	120	132	12'-4"	2,445	STR.					
R617			48	48	12'-3"	883	STR.					
R618			48	48	12'-2"	877	STR.					
R619			56	56	13'-0"	1,093	STR.					
R620			1	1	9'-6"	14	STR.					
TOTAL						84,572						

MARK	NUMBER				LENGTH	WEIGHT	TYPE	DIMENSIONS				
	UNIT 1	UNIT 2	UNIT 3	TOTAL				A	B	C	D	E
BARRIERS - NORTHBOUND												
R501	630	1,357	1,956	3,943	5'-5"	22,276	38	2'-2"	0'-6"	0'-3"	2'-4"	0'-9"
R504	90	96	84	270	13'-8"	3,849	STR.					
R505	72	216	360	648	7'-2"	4,844	STR.					
R506	6			6	3'-7"	22	STR.					
R507	6			6	8'-6"	53	STR.					
R509		72		72	12'-4"	926	STR.					
R510			12	12	8'-5"	105	STR.					
R512			6	6	9'-6"	59	STR.					
R513	8	12	28	48	8'-1"	405	21	1'-3"	1'-10"	0'-6"	2'-4"	
R514	8	12	28	48	3'-3"	163	2	0'-7"	2'-4"	0'-7"		
R517			144	144	12'-4"	1,852	STR.					
R518			6	6	8'-5"	53	STR.					
R521	28	56	80	164	52'-9"	9,023	STR.					
R604	108	324	540	972	7'-2"	10,463	STR.					
R606	15	16	16	47	13'-8"	965	STR.					
R607	1	1		2	3'-7"	11	STR.					
R608	1		1	1	8'-6"	13	STR.					
R614		2	1	3	8'-5"	38	STR.					
R622	56			56	14'-3"	1,199	STR.					
R623			56	56	13'-1"	1,100	STR.					
R626		96		96	12'-2"	1,754	STR.					
R627		72	72	144	13'-0"	2,812	STR.					
R628		12	24	36	12'-4"	667	STR.					
R631			1	1	9'-6"	14	STR.					
R632	28	56	80	164	56'-0"	13,794	STR.					
R633	64			64	14'-8"	1,410	STR.					
TOTAL						77,871						

ALL NORTHBOUND BARRIER REINFORCEMENT TO BE GRADE 75 ksi

NOTES:  
 FOR BAR SHAPE  
 DIAGRAMS, LEGEND  
 AND NOTES, SEE  
 SHEET [197/216].

5/1/2020 JANSSEN & SPAANS ENGINEERING INC. -  
 RECONFIGURED NORTHBOUND ON RAMP

DESIGNED	DRAWN	REVIEWED	DATE
DEB	VFC	JTH	8/18
CHECKED	REVISED	STRUCTURE FILE NUMBER	4802765/4802767
MRW			

DESIGN AGENCY  
 564 WHITE POND DRIVE  
 AKRON, OHIO 44320-1100  
**AECOM**  
 (330) 836-9111

REINFORCING LIST  
 BRIDGE NO. LUC-75-0029 L/R  
 I.R. 75 OVER MAUMEE RIVER

WOO/LUC-75-  
 30.70/0.00  
 PID No. 93592

212/216

1505  
 1792

Date: Oct 07, 2020, 4:46pm User Name: mlongin  
 File: P:\11321 - Toledo E. Value Engineering\DWGS\BRIDGE\LUC-75-0027 over Maumee River\Sheets\07\_0027C\_RL006.dwg

MARK	NUMBER												LENGTH	WEIGHT	TYPE	DIMENSIONS					
	PIER 1NB-	PIER 2NB-	PIER 3NB-	PIER 4NB-	PIER 5NB-	PIER 6NB-	PIER 7NB-	PIER 8NB-	PIER 9NB-	PIER 10NB-	PIER 11NB-	TOTAL				A	B	C	D	E	R
<b>DRILLED SHAFTS - NORTHBOUND</b>																					
3	DSSP501	3	3	3	3	3	3	3	3	3	3	3	33	13'-3"	26,944	27	0'-3"	4'-6"	13'-3"		
	DSSP502	(NOT USED ON NB BRIDGE)																			
	DSSP601 *	3											3	31'-2"	9,829	27	0'-3"	5'-6"	31'-2"		
	DSSP601 **	3											3	31'-2"	9,829	27	0'-3"	5'-6"	31'-2"		
3	DSSP602 *		3										3	32'-5"	7,083	27	0'-4"	5'-0"	32'-5"		
	DSSP602 **		3										3	32'-5"	7,083	27	0'-4"	5'-0"	32'-5"		
	DSSP603 *			3									3	32'-2"	9,206	27	0'-3"	5'-0"	32'-2"		
	DSSP603 **			3									3	32'-2"	9,206	27	0'-3"	5'-0"	32'-2"		
	DSSP604 *				3								3	31'-8"	9,066	27	0'-3"	5'-0"	31'-8"		
	DSSP604 **				3								3	31'-8"	9,066	27	0'-3"	5'-0"	31'-8"		
	DSSP605 *					3							3	30'-11"	9,752	27	0'-3"	5'-6"	30'-11"		
	DSSP605 **					3							3	30'-11"	9,752	27	0'-3"	5'-6"	30'-11"		
	DSSP606 *						3						3	32'-7"	7,038	27	0'-4"	5'-0"	32'-7"		
	DSSP606 **						3						3	32'-7"	7,038	27	0'-4"	5'-0"	32'-7"		
	DSSP607 *							3					3	32'-0"	6,916	27	0'-4"	5'-0"	32'-0"		
	DSSP607 **							3					3	32'-0"	6,916	27	0'-4"	5'-0"	32'-0"		
	DSSP608 *								3				3	31'-7"	9,958	27	0'-3"	5'-6"	31'-7"		
	DSSP608 **								3				3	31'-7"	9,958	27	0'-3"	5'-6"	31'-7"		
	DSSP609 *									3			3	31'-9"	10,009	27	0'-3"	5'-6"	31'-9"		
	DSSP609 **									3			3	31'-9"	10,009	27	0'-3"	5'-6"	31'-9"		
	DSSP610 *										3		3	33'-6"	10,548	27	0'-3"	5'-6"	33'-6"		
	DSSP610 **										3		3	33'-6"	10,548	27	0'-3"	5'-6"	33'-6"		
	DSSP611 *											3	3	33'-4"	7,194	27	0'-4"	5'-0"	33'-4"		
	DSSP611 **											3	3	33'-4"	7,194	27	0'-4"	5'-0"	33'-4"		
	DS1001 *	42	42	42	42	42	42	33	42	42	42	33	444	14'-3"	27,225	STR.					
	DS1002 *	42	42	42	42	42	42	33	42	42	42	33	444	16'-3"	31,846	STR.					
3	DS1101 **	66	60	69	69	66	60	60	66	66	66	60	708	30'-0"	112,848	STR.					
	DS1102 **	66	60	69	69	66	60	60	66	66	66	60	708	32'-0"	120,371	STR.					
	DS1103 *	66		69									135	32'-4"	23,191	STR.					
	DS1104 *	66											66	30'-4"	10,637	STR.					
	DS1105 *		60										60	34'-10"	11,104	STR.					
	DS1106 *		60										60	32'-10"	10,467	STR.					
	DS1107 *			69									69	34'-4"	12,586	STR.					
	DS1108 *				69								69	33'-4"	12,220	STR.					
	DS1109 *				69								69	31'-4"	11,487	STR.					
	DS1110 *					66							66	31'-11"	11,192	STR.					
	DS1111 *					66							66	29'-11"	10,491	STR.					
	DS1112 *						60						60	35'-3"	11,237	STR.					
	DS1113 *						60		66				126	33'-3"	22,259	STR.					
	DS1114 *							60					60	34'-1"	10,865	STR.					
	DS1115 *							60					60	32'-1"	10,228	STR.					
	DS1116 *								66				66	33'-6"	11,747	STR.					
	DS1117 *								66				66	31'-6"	11,046	STR.					
	DS1118 *									66			66	37'-0"	12,974	STR.					
	DS1119 *									66			66	35'-0"	12,273	STR.					
	DS1120 *										60		60	36'-9"	11,715	STR.					
	DS1121 *											60	60	34'-9"	11,078	STR.					
	DS1122 *								66				66	31'-3"	10,958	STR.					
														<b>TOTAL</b>	<b>762,187</b>						

DRILLED SHAFT REINFORCING IS FOR INFORMATION ONLY.

3

NOTES:  
 FOR BAR SHAPE  
 DIAGRAMS, LEGEND  
 AND NOTES, SEE  
 SHEET 197/216.

5/1/2020 JANSSEN & SPAANS ENGINEERING INC. - QUANTITIES REVISED  
 DESIGN AGENCY  
 564 WHITE BOND DRIVE  
 AKRON, OHIO 44320-1100  
**AECOM**  
 (330) 636-9111  
 DESIGNER: JTH  
 DATE: 8/18  
 STRUCTURE FILE NUMBER: 4802765/4802767  
 DRAWN: TMR  
 REVIEWED: JTH  
 CHECKED: MRW  
 REINFORCING LIST  
 BRIDGE NO. LUC-75-0029 L/R  
 I.R. 75 OVER MAUMEE RIVER  
 WOO/LUC-75-  
 30.70/0.00  
 PID No. 93592  
 214/216  
 1507  
 1792

Date: Oct 07, 2020, 4:47pm User Name: mlongtin  
 File: P:\11321 - Toledo E Value Engineering\DWGS\BRIDGE\LUC-75-0027 over Maumee River\Sheets\075\_0027C\_RL021.dwg

MARK	NUMBER				LENGTH	WEIGHT	TYPE	DIMENSIONS					
	UNIT 1	UNIT 2	UNIT 3	TOTAL				A	B	C	D	E	R
<b>INTERMEDIATE DIAPHRAGMS - SOUTHBOUND</b>													
1401	616	1,152	1,449	3,217	12'-9"	27,399	3	0'-6"	5'-8"				
1701 **	924			924	6'-10"	12,906	STR.						
1702	154			154	11'-4"	3,567	20	4'-3"	2'-2"	1'-3"	4'-10"	2'-4"	
1703	154			154	11'-6"	3,620	20	4'-3"	2'-2"	1'-3"	4'-10"	2'-10"	
1704 **		1,728		1,728	6'-8"	23,547	STR.						
1705		288		288	11'-4"	6,672	20	4'-3"	2'-2"	1'-3"	4'-8"	2'-9"	
1706		288		288	11'-3"	6,623	20	4'-3"	2'-2"	1'-3"	4'-5"	3'-0"	
1707 **			1,932	1,932	7'-2"	28,301	STR.						
1708			322	322	11'-8"	7,679	20	4'-3"	2'-2"	1'-3"	5'-2"	2'-7"	
1709			322	322	11'-8"	7,679	20	4'-3"	2'-2"	1'-3"	5'-1"	2'-9"	
				<b>TOTAL</b>		<b>127,993</b>							

INTERMEDIATE DIAPHRAGM REINFORCING IS FOR INFORMATION ONLY.

MARK	NUMBER				LENGTH	WEIGHT	TYPE	DIMENSIONS					
	UNIT 1	UNIT 2	UNIT 3	TOTAL				A	B	C	D	E	R
<b>INTERMEDIATE DIAPHRAGMS - NORTHBOUND</b>													
1401	392	896	1,288	2,576	12'-9"	21,940	3	0'-6"	5'-8"				
1701 THRU 1712 (NOT USED ON NB BRIDGE)													
1713 **	588	1,344	1,932	3,864	7'-0"	55,286	STR.						
1716	196	448	322	966	11'-6"	22,707	20	4'-3"	2'-2"	1'-3"	5'-0"	2'-5"	
1717	196	448	322	966	11'-5"	22,542	20	4'-3"	2'-2"	1'-3"	4'-10"	2'-8"	
				<b>TOTAL</b>		<b>122,475</b>							

INTERMEDIATE DIAPHRAGM REINFORCING IS FOR INFORMATION ONLY.

3

**NOTES:**  
 FOR BAR SHAPE  
 DIAGRAMS, LEGEND  
 AND NOTES, SEE  
 SHEET [197/216].

**REINFORCING LIST**  
 BRIDGE NO. LUC-75-0029 L/R  
 I.R. 75 OVER MAUMEE RIVER

W00/LUC-75-  
 30.70/0.00  
 PID No. 93592

215 / 216

1508  
 1792

5/1/2020 JANSSEN & SPANNS ENGINEERING INC. -  
 RECONFIGURED NORTHBOUND ON RAMP, TABLE UP-DATED  
 DESIGN AGENCY  
 564 WHITE POND DRIVE  
 AKRON, OHIO 44320-1100  
 (330) 836-9111  
**AECOM**  
 4802765/4802767  
 DATE 8/18  
 JTH  
 STRUCTURE FILE NUMBER  
 4802765/4802767  
 REVIEWED VFC  
 DRAWN VFC  
 DESIGNED DEB  
 CHECKED MRW  
 REVISIONS