

Field Notes

PROJECT NO. P402230034

BRIDGE NO. LUC-2-1862

DATE _____


SHEET _____

CREW _____

TRANSYSTEMS

- ① Bearing - beginning to be undermined with slight loss of bearing area and anchor bolts with up to 50% section loss throughout
- ② Bearing - masonry plate overhangs beam seat by 1/2"

N

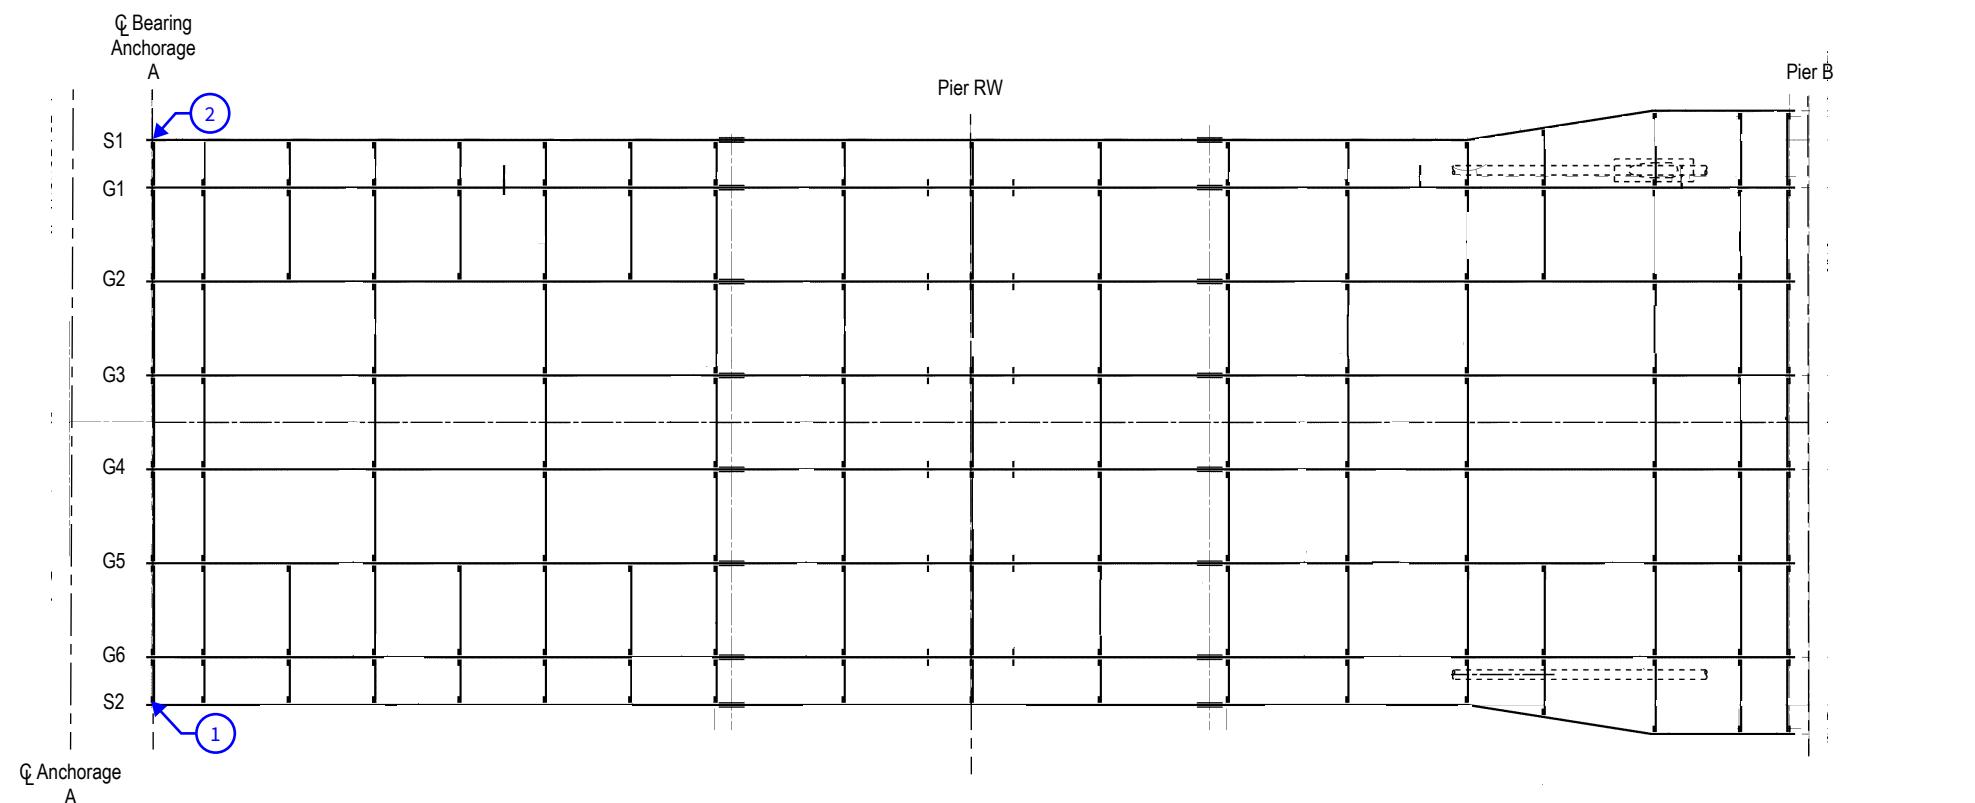

Span RW-2

Span RW-1

REVISION DATE CREW

REVISION DATE CREW

REVISION DATE CREW

REVISION DATE CREW

Span RW - Framing Plan