

O.D.O.T. DISTRICT 2 SURVEY OFFICE (USE ONLY)

PERSONNEL

REFERENCE NO. 21BA

NOTES ASTON
H.C. NIESE
R.C. PRESTON-COLVIN


DATE 5/6/24
WEATHER BREEZY
TEMP. 65°

ROUTE SR 2
COUNTY FULTON
TOWNSHIP GERMAN
SECTION 24

DWG BY BARRIERE PID 107708

TYPE MONUMENT MAG NAIL/WASHER
ON SURFACE - BELOW ON
OFFSET $\oslash$ PAVEMENT ON

T 7 N R 5 E

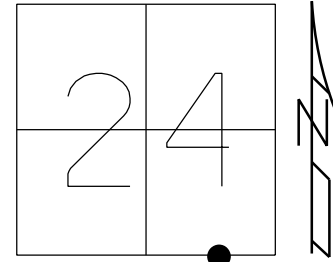

STATION: 481+89.78

HORIZ.DATUM: NAD83('11)/FUL OCCS GEOID: NAVD88 ('18)

GRID: NORTHING: 688487.823 EASTING: 1493782.892

LDP: NORTHING: 343926.461 EASTING: 140973.988

RECORD:
FD MAG/WASH
REF21BA
5/6/24, TDN
SET MAG/WASH
9/20/24, TDN

