

O.D.O.T. DISTRICT 2 SURVEY OFFICE (USE ONLY)

PERSONNEL

REFERENCE NO. 21CA

NOTES ASTON  
H.C. NIESE  
R.C. PRESTON-COLVIN

DATE 5/6/24  
WEATHER CALM  
TEMP. 75°

ROUTE SR 2  
COUNTY FULTON  
TOWNSHIP GERMAN  
SECTION 24


DWG BY BARRIERE PID 107708

T 7 N R 5 E

TYPE MONUMENT MAG NAIL/WASHER

ON SURFACE - BELOW ON

OFFSET  $\varnothing$  PAVEMENT 0.5' LT

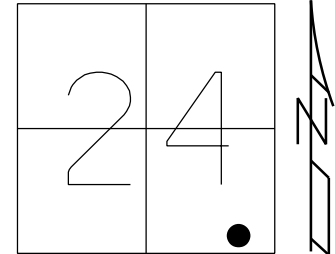

STATION: \_\_\_\_\_

HORIZ.DATUM: NAD83('11)/FUL OCCS GEOID: NAVD88 ('18)

GRID: NORTHING: 688489.349 EASTING: 1494317.481

LDP: NORTHING: 343938.096 EASTING: 141508.479

RECORD:  
FD MAG/W  
REF21CA  
5/6/24, TDN  
SET MAG/WASHER  
SET BY GPS  
9/20/24, TDN

