

O.D.O.T. DISTRICT 2 SURVEY OFFICE (USE ONLY)

PERSONNEL

REFERENCE NO. 21CB

NOTES ASTON  
H.C. NIESE  
R.C. PRESTON-COLVIN

DATE 5/6/24  
WEATHER WINDY  
TEMP. 75°

ROUTE SR 2  
COUNTY FULTON  
TOWNSHIP GERMAN  
SECTION 24


DWG BY BARRIERE PID 107708

T 7 N R 5 E

TYPE MONUMENT MAG NAIL/WASHER

ON SURFACE - BELOW ON

OFFSET  $\varnothing$  PAVEMENT ON

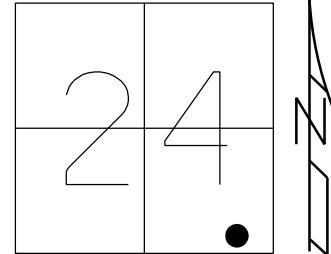

STATION: \_\_\_\_\_

HORZ.DATUM: NAD83('11)/FUL OCCS GEOID: NAVD88 ('18)

GRID: NORTHING: 688495.142 EASTING: 1494549.216

LDP: NORTHING: 343948.271 EASTING: 141740.076

RECORD:  
FD MAG/W  
REF21CB  
5/6/24, TDN  
SET MAG/WASHER  
SET BY GPS  
NEWREF21CB  
6/23/25, TDN

