

O.D.O.T. DISTRICT 2 SURVEY OFFICE (USE ONLY)

PERSONNEL

REFERENCE NO. 21CD

NOTES ASTON
H.C. NIESE
R.C. PRESTON-COLVIN


DATE 5/6/24
WEATHER WINDY
TEMP. 75°

ROUTE SR 2
COUNTY FULTON
TOWNSHIP GERMAN
SECTION 24

DWG BY BARRIERE PID 107708

T 7 N R 5 E

TYPE MONUMENT MAG NAIL/WASHER
ON SURFACE - BELOW ON
OFFSET $\varnothing$ PAVEMENT ON

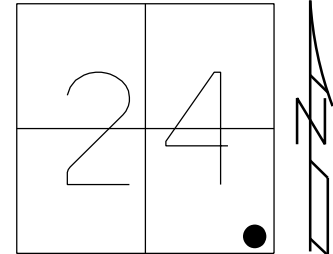

STATION: 484+62

HORZ.DATUM: NAD83('11)/FUL OCCS GEOID: NAVD88 ('18)

GRID: NORTHING: 688501.140 EASTING: 1494798.251

LDP: NORTHING: 343958.978 EASTING: 141988.965

RECORD:
FD MAG/WASHER
REF21CD
5/6/24, TDN
SET MAG/WASH
6/23/25, TDN

