

O.D.O.T. DISTRICT 2 SURVEY OFFICE (USE ONLY)

PERSONNEL

REFERENCE NO. 22A

NOTES ASTON
H.C. NIESE
R.C. PRESTON-COLVIN


DATE 5/6/24
WEATHER WINDY
TEMP. 65°

ROUTE SR 2
COUNTY FULTON
TOWNSHIP CLINTON
SECTION 19

DWG BY BARRIERE PID 107708

TYPE MONUMENT MAG NAIL/WASHER
ON SURFACE - BELOW ON
OFFSET $\varnothing$ PAVEMENT 0.6' RT

T 7 N R 6 E

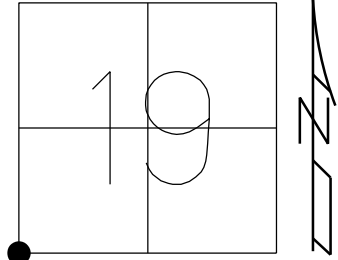

STATION: 496+32

HORIZ.DATUM: NAD83('11)/FUL OCCS GEOID: NAVD88 ('18)

GRID: NORTHING: 688462.800 EASTING: 1495113.678

LDP: NORTHING: 343926.607 EASTING: 142305.077

RECORD:
FD MAG SPIKE
REF22A
5/6/24, TDN

