


O.D.O.T. DISTRICT 2 SURVEY OFFICE (USE ONLY)


PERSONNEL _____ REFERENCE NO. 55A SHEET 28 OF 28
 NOTES HUSS DATE 7/24/00 ROUTE US 20
 H.C. CORDES WEATHER CLOUDY COUNTY FULTON
 R.C. KARGER TEMP. 72° TOWNSHIP AMBOY
 _____ SECTION 24
 _____ T 9 S R 4 E

TYPE MONUMENT _____ P.K./WASHER _____
 ON SURFACE - ~~BELOW~~ _____ ON _____
~~LEFT~~ - ☉ PAV'T - ~~RIGHT~~ _____ ON _____
 _____ TO _____ EDGE PAVEMENT
 S.L.M. 1473+94.45
 GRID: NORTHING: 733554.166 EASTING: 1591785.500

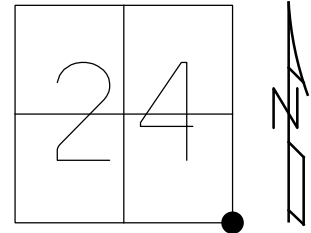

55 TO 55A = 57.51'



RECORD:
 SET P.K./WASHER
 6-22-01, BVD
 FD R.R. SPIKE 4' DOWN
 REFA1
 10-21-15, JFO
 MONBOX FD
 W/ 1" IPIN
 NEWREFA55
 4-12-17, JFO

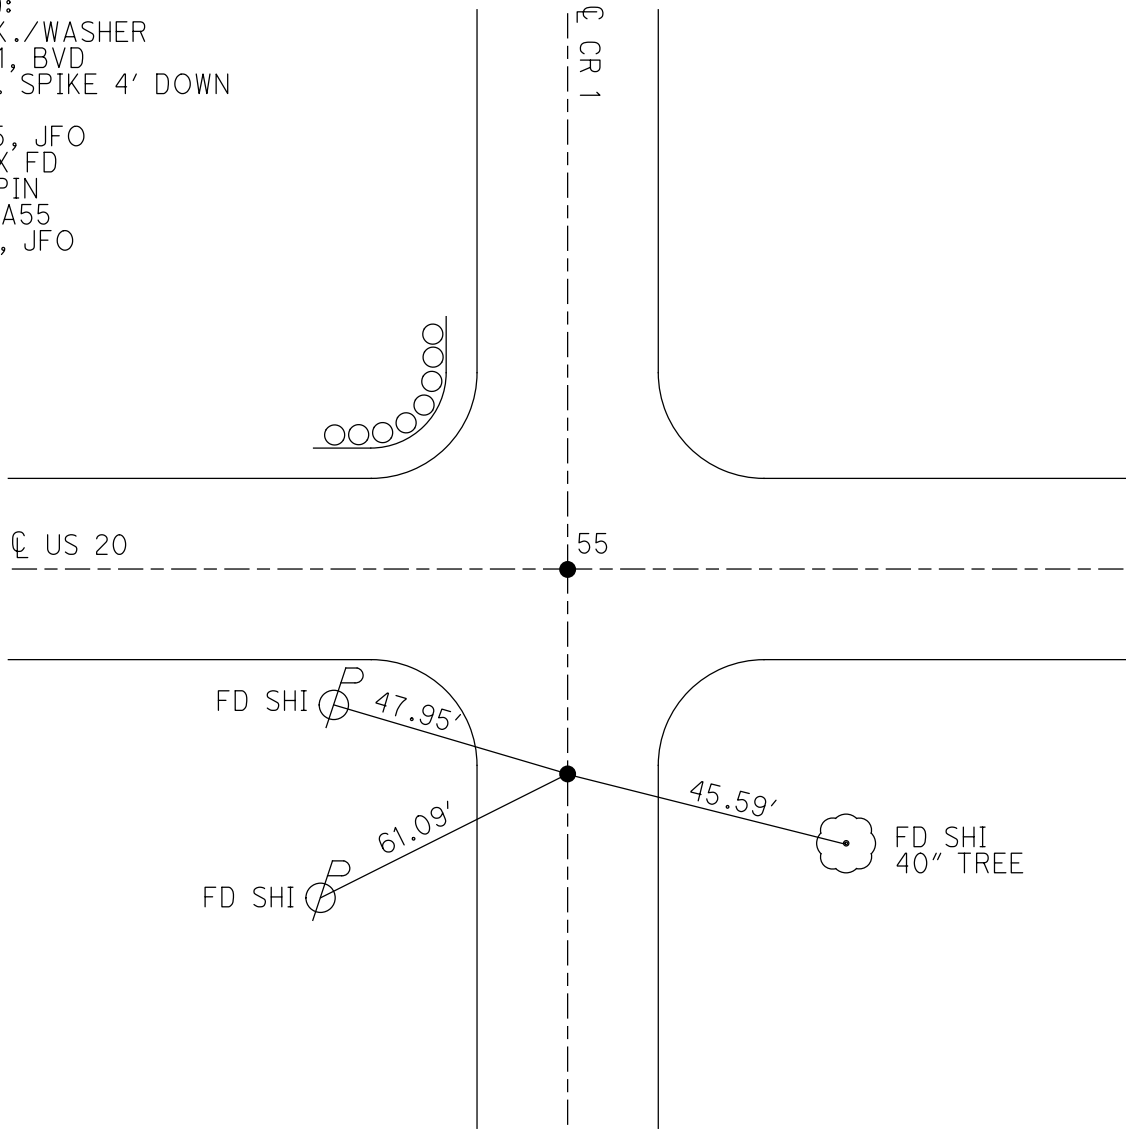

O.D.O.T. DISTRICT 2 SURVEY OFFICE

PERSONNEL	REFERENCE NO. <u>55A</u>	SHEET <u>27</u> OF <u>27</u>
NOTES <u>HUSS</u>	DATE <u>7/24/00</u>	ROUTE <u>US 20</u>
H.C. <u>CORDES</u>	WEATHER <u>CLOUDY</u>	COUNTY <u>FULTON</u>
R.C. <u>KARGER</u>	TEMP. <u>72°</u>	TOWNSHIP <u>AMBOY</u>
		SECTION <u>24</u>
		T <u>9</u> S R <u>4</u> E

TYPE MONUMENT P.K./WASHER
 ON SURFACE - ~~BELOW~~ ON
 LEFT - ☉ PAV'T - RIGHT _____
 _____ TO _____ EDGE PAVEMENT
 S.L.M. 1472+59
 Grid: Northing: _____ Easting: _____

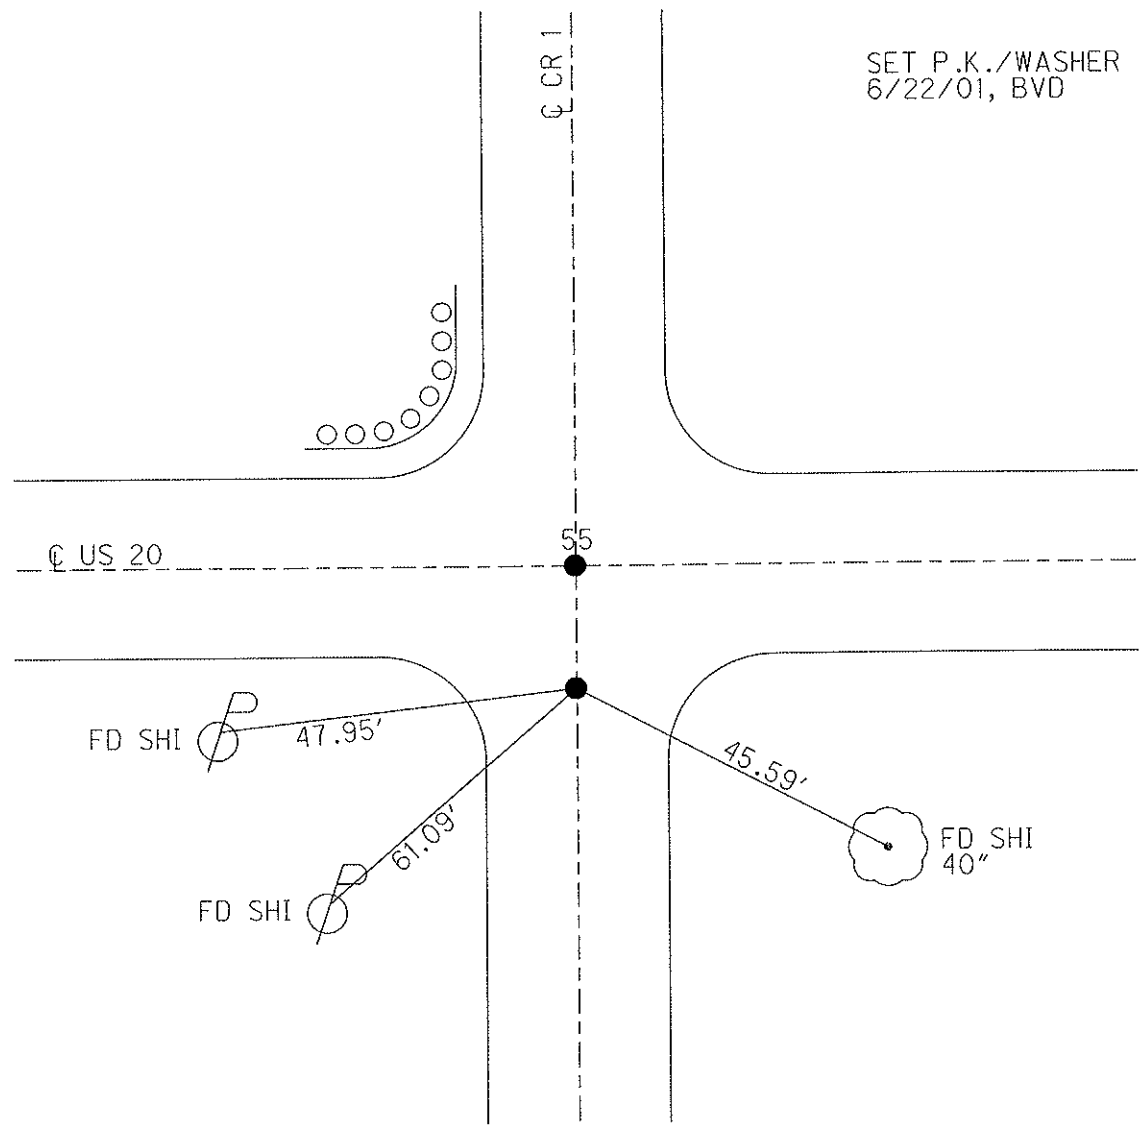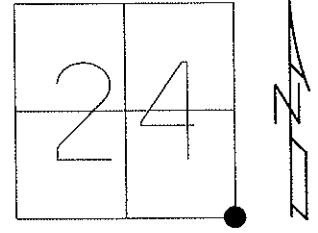

O.D.O.T. DISTRICT 2 SURVEY OFFICE

PERSONNEL _____

REFERENCE NO. 55

SHEET 20 OF 20

NOTES Huss

H.C. CORDS

DATE 7-24-00

ROUTE US 20

R.C. KARGER

WEATHER Cloudy

COUNTY Fulton

TEMP. +72°F

TOWNSHIP Ambony

SECTION 24

T9 S R 4 E



TYPE MONUMENT PK& WASHERS

ON SURFACE - BELOW YES

LEFT- & PAV'T. - RIGHT _____

TO EDGE PAVEMENT

S.L.M. 1389+69.6 1472+59

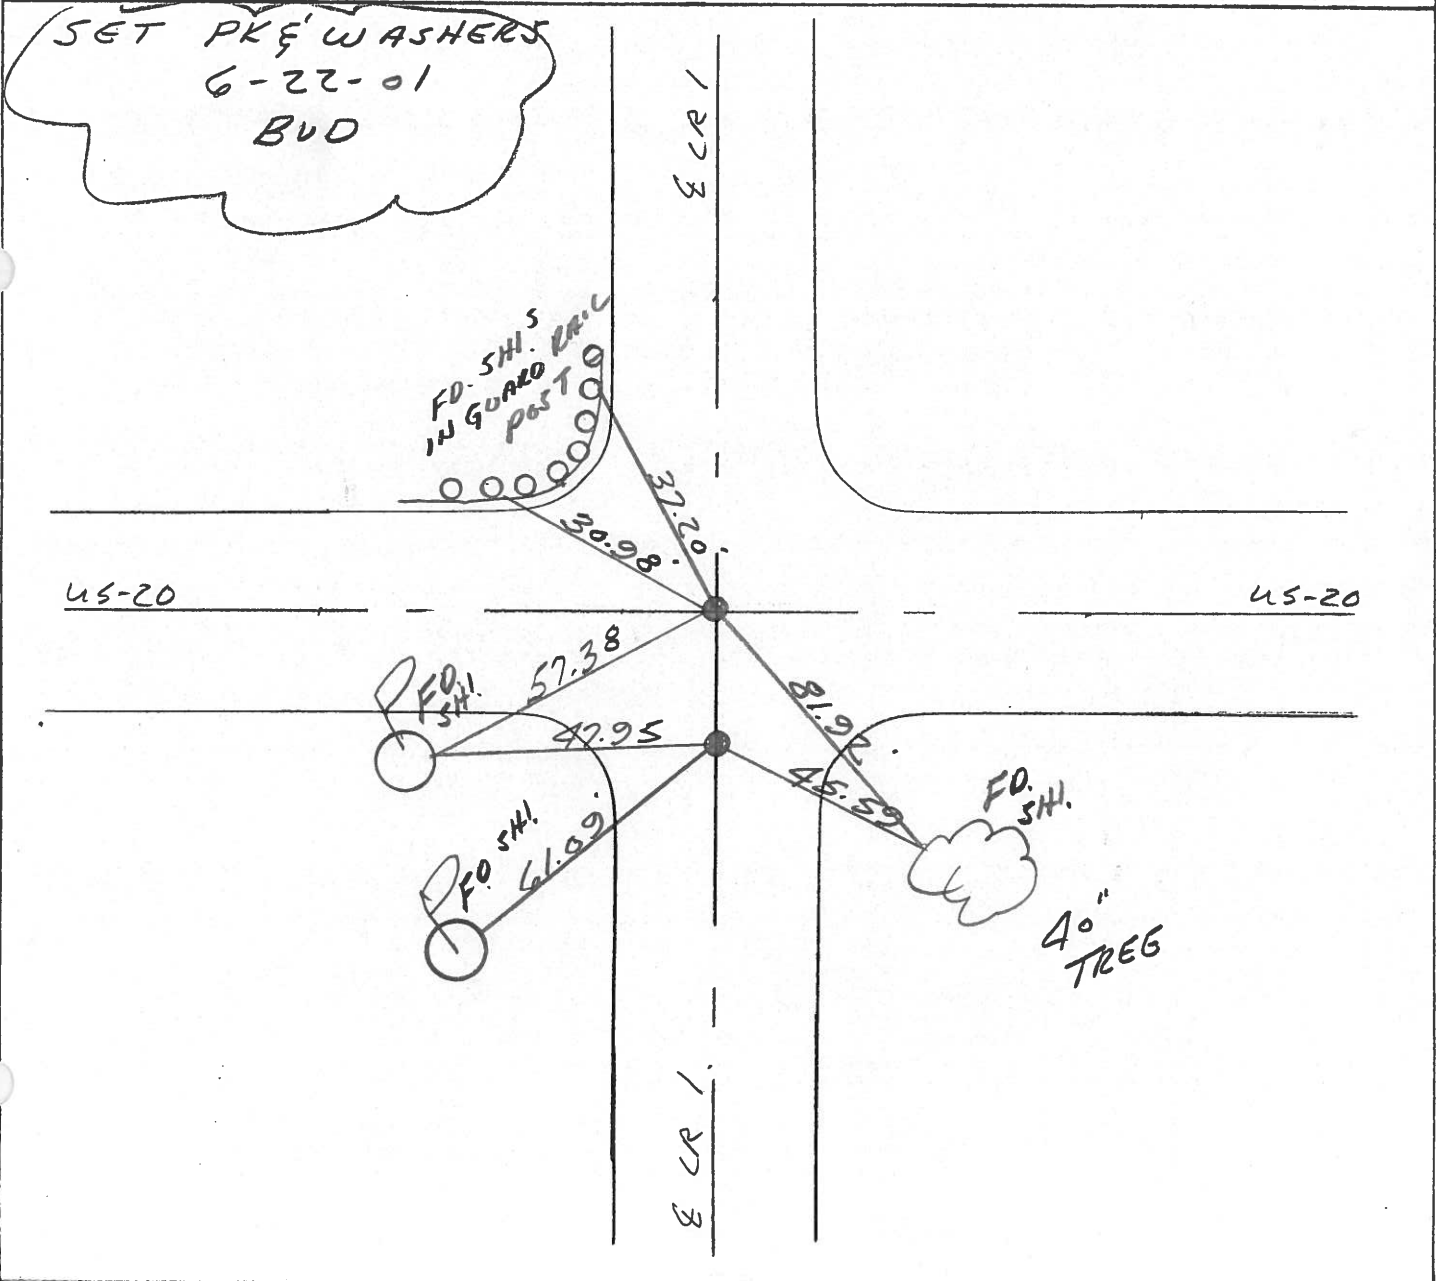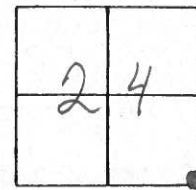

O.D.O.T. DISTRICT 2 SURVEY OFFICE

Sht. 26 of

County Fulton US# 20

Date 14 May 1979

Township Amboy


Weather Fair

Section 24

Temp. 65°


T N, R E

Personnel 1. Stone
R. Michalak
P. Houser
D. Curtis
D. Brunata

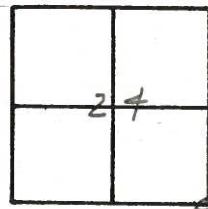

REF. NO. 55

SE Cor, Sec. 24

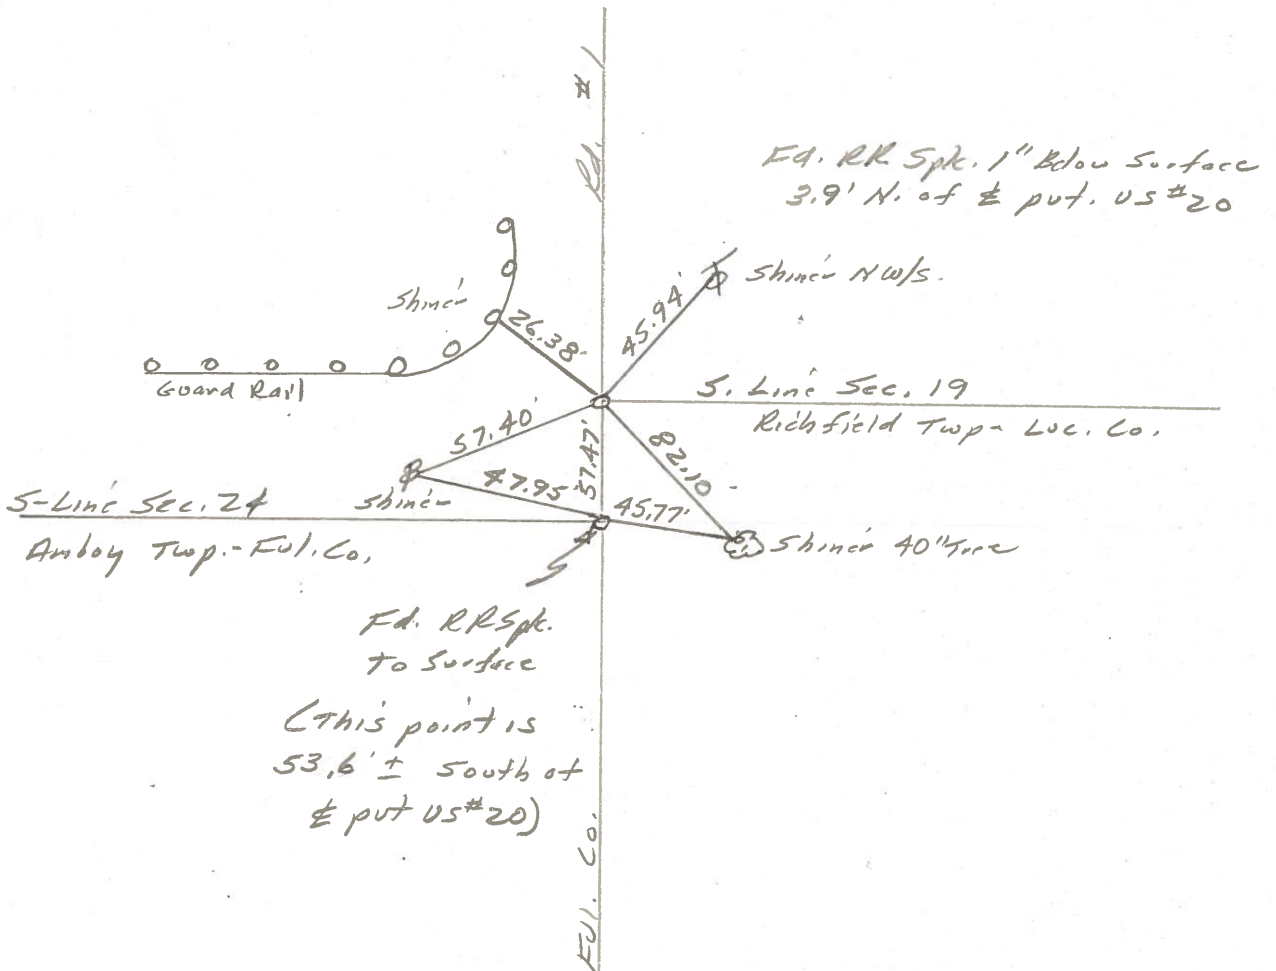

PERSONNEL TITLE PERSONNEL TITLE
 Tomsic _____
 Neuser _____
 Grana ta _____

COUNTY Fulton DATE MAR. 20, 1977
 S. R. U.S. 20 WEATHER _____
 SEC. AMBOY TWP. TEMP. _____

DESCRIPTION LEFT CENTER LINE RIGHT JOB NO.

