

O.D.O.T. DISTRICT 2 SURVEY OFFICE (USE ONLY)

PERSONNEL

REFERENCE NO. 25 A

SHEET 8 OF 35

NOTES RHOADES

DATE 4/23/21

ROUTE SR 109

H.C. O'DONNELL

WEATHER CLOUDY

COUNTY FULTON

R.C. RHOADES

TEMP. 46°

TOWNSHIP PIKE

SECTION 2

DWG BY NIESE

PID PAVE TRAIN

T 7 N R 7 E

TYPE MONUMENT MAG/WASHER

ON SURFACE - ~~BELOW~~ ON

OFFSET CL PAVEMENT 2.6' ~~LT~~ : RT

7.0' TO RT EDGE PAVEMENT


STATION: 515+64.32

HORIZ.DATUM: NAD83(2011)

GEOID: 2018


GRID: NORTHING: 707135.124

EASTING: 1547985.971

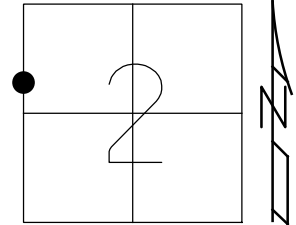

RECORD: P.I.
STA 515+40.04
 $\Delta = 20^\circ 27' \text{ LT}$
 $D=10'$
 $T=122.52'$
 $L=245.00'$
 $E=1.31'$
 $Rc=5729.58'$
SET P.K./WASHER
10/01/90, MB
SET P.K./WASHER
11/20/96
FD P.K./WASHER
6/12/12
3/04/13, MC
FD MAG/WASHER
REFA25
4/23/21, JFO
8/26/21, JFO
1/11/23, TDN

FD SHI
GR POSTS

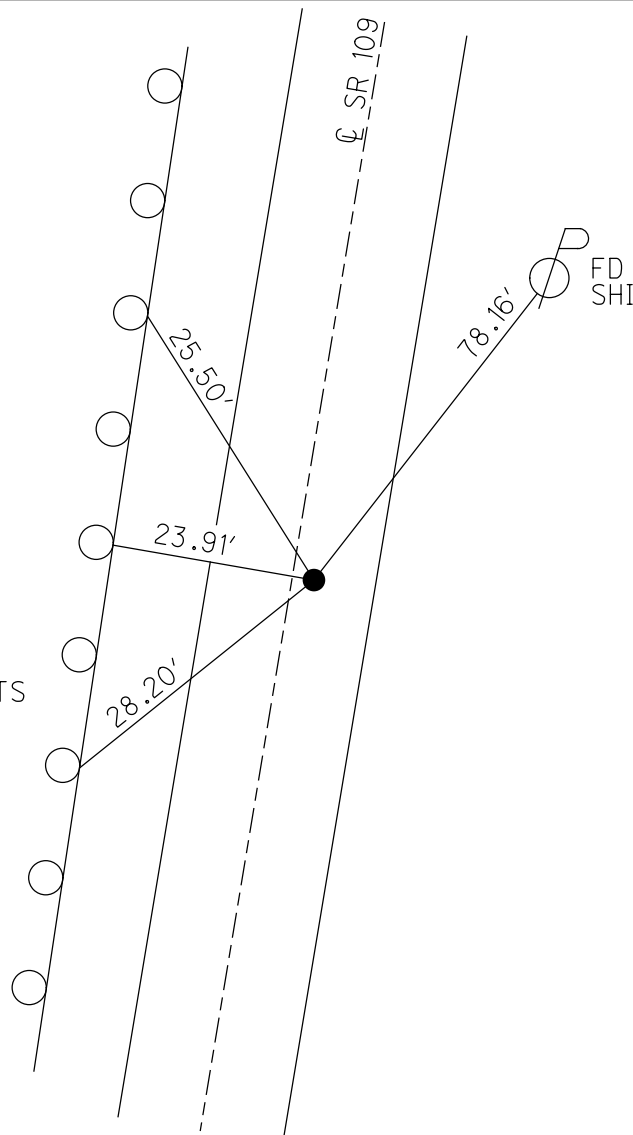

O.D.O.T. DISTRICT 2 SURVEY OFFICE (USE ONLY)

PERSONNEL

REFERENCE NO. 25 A

SHEET 8 OF 35

NOTES RHOADES DATE 4/23/21
H.C. O'DONNELL WEATHER CLOUDY
R.C. RHOADES TEMP. 46°

ROUTE SR 109
COUNTY FULTON
TOWNSHIP PIKE
SECTION 2
T 7 N R 7 E

DWG BY NIESE PID PAVE TRAIN

TYPE MONUMENT MAG/WASHER

ON SURFACE - ~~BELOW~~ ON

OFFSET Q PAVEMENT 2.6' ~~LT~~ : RT

7.0' TO RT EDGE PAVEMENT


STATION: 515+64.32

HORIZ.DATUM: NAD83(2011)

GEOID: 2018


GRID: NORTHING: 707135.124

EASTING: 1547985.971

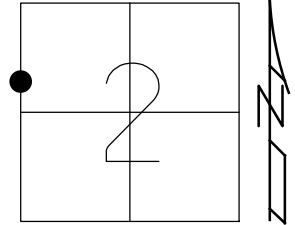

RECORD: P.I.
STA 515+40.04
 $\Delta = 20^\circ 27' \text{ LT}$
D=10'
T=122.52'
L=245.00'
E=1.31'
Rc=5729.58'
SET P.K./WASHER
10/01/90, MB
SET P.K./WASHER
11/20/96
FD P.K./WASHER
6/12/12
3/04/13, MC
FD MAG/WASHER
REFA25
4/23/21, JFO
8/26/21, JFO

FD SHI
GR POSTS

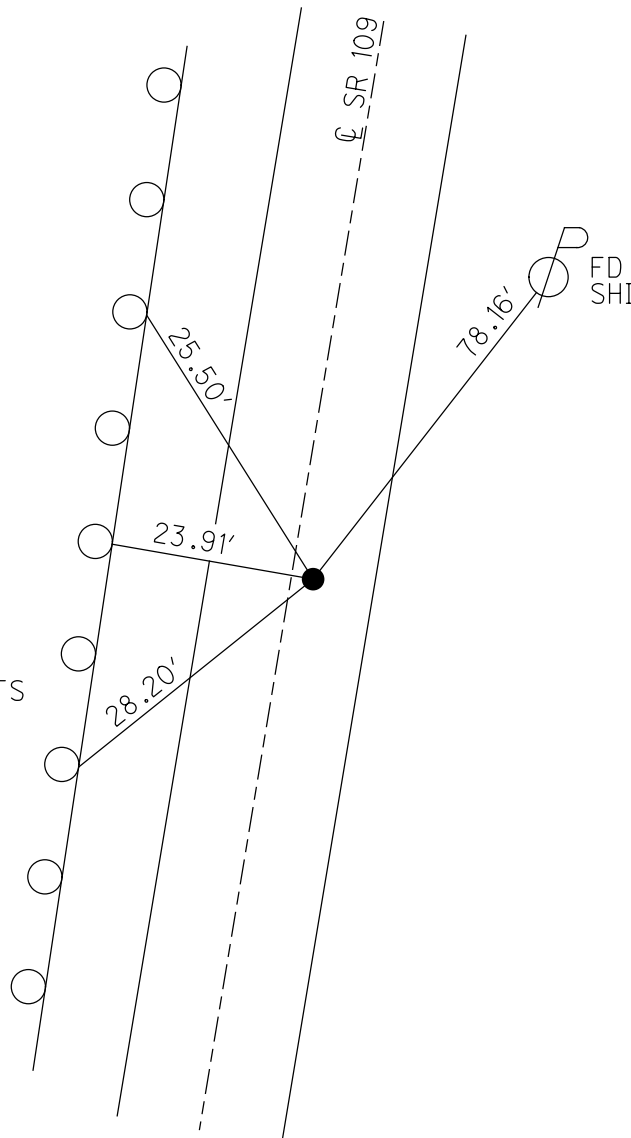

O.D.O.T. DISTRICT 2 SURVEY OFFICE (USE ONLY)

PERSONNEL

REFERENCE NO. 25-B

SHEET 9 OF 35

NOTES HUSS
H.C. HUSS
R.C. CANTERBURY
COUTCHER

DATE 06-12-12
WEATHER FAIR
TEMP. 76°

ROUTE SR 109
COUNTY FULTON
TOWNSHIP PIKE
SECTION 2
T 7 N R 7 E

TYPE MONUMENT PK/WASHER


ON SURFACE - BELOW ON

LEFT - Q PAV'T - RIGHT 2.6'

7.0' TO RT EDGE PAVEMENT

S.L.M. 516+73


Grid: Northing: 707135.108 Easting: 1547985.928

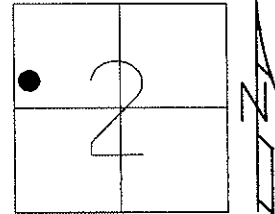

RECORD:
PI STA 515+40.04
 $\Delta=20^{\circ}27'$ LT
D=10
T=122.52'
L=245.00'
E=1.31
Rc=5729.58'

10-01-90 SET PK/WASHER, MB
11-20-96 SET PK/WASHER
IN LEVELING COURSE

06-12-12 GPS REF B25
03-04-13 GPS FIN B25, MC

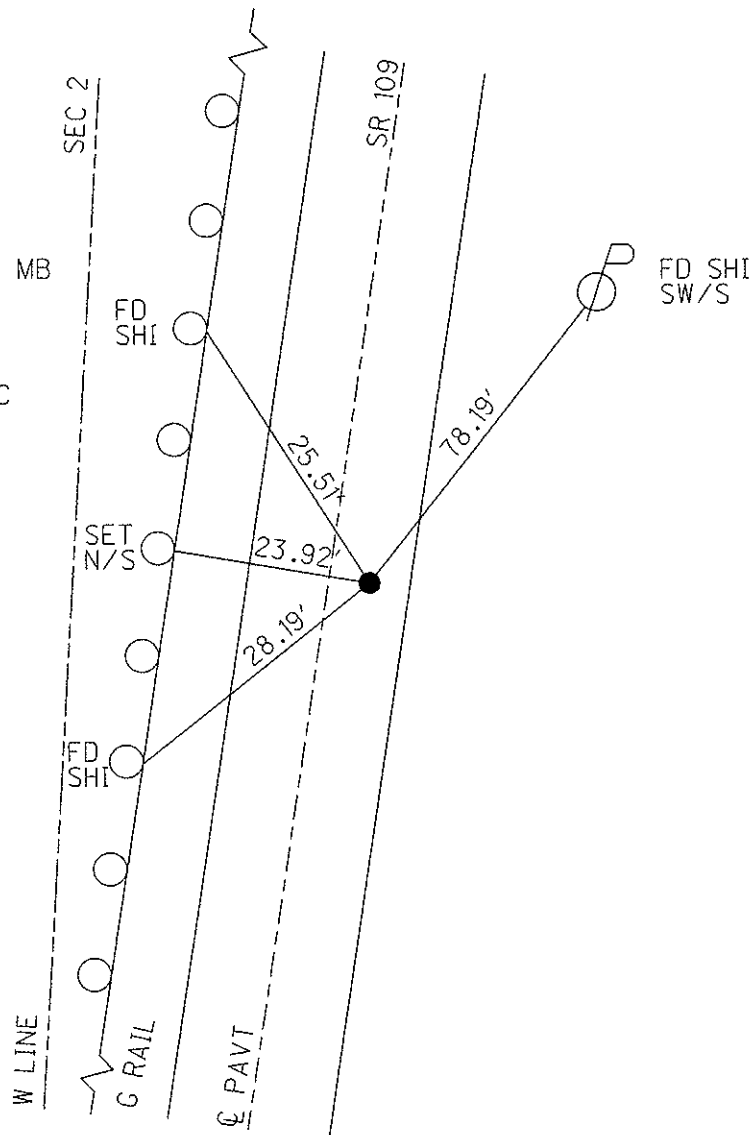

O.D.O.T. DISTRICT 2 SURVEY OFFICE

PERSONNEL

REFERENCE NO. 25-2A SHEET 7 OF 28

NOTES CANTERBURY

H.C. ROUSOS

R.C. LOEHRKE

DATE 8-20-96

WEATHER FAIR / BREEZY

TEMP. +85°

ROUTE 109

COUNTY FULTON

TOWNSHIP PIKE

SECTION 2

T 7 N R 7 E

Set PK. / WASHER
10-6-97
C.L.

TYPE MONUMENT SM. R.R. SPIKE


ON SURFACE - BELOW YES

LEFT - CL PAV'T. - RIGHT 0.96

1.87 TO RT EDGE PAVEMENT

S.L.M. 15+719.540

515+73

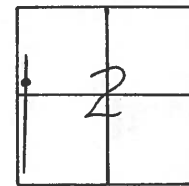

RECORD

PI STA 515+40.04

$\Delta = 20^\circ 27' LT$

$D = 10$

$I = 122.52'$

$E = 245.00'$


$E = 1.31$

$R = 5729.58'$

SET PK. / WASHER
10-1-90
MIB

Fd $\frac{3}{4}$ " I. Pipe
4 Down

SET PK/WASHER IN LEVELING
COURSE 11/20/96.
FAIR
+28°F

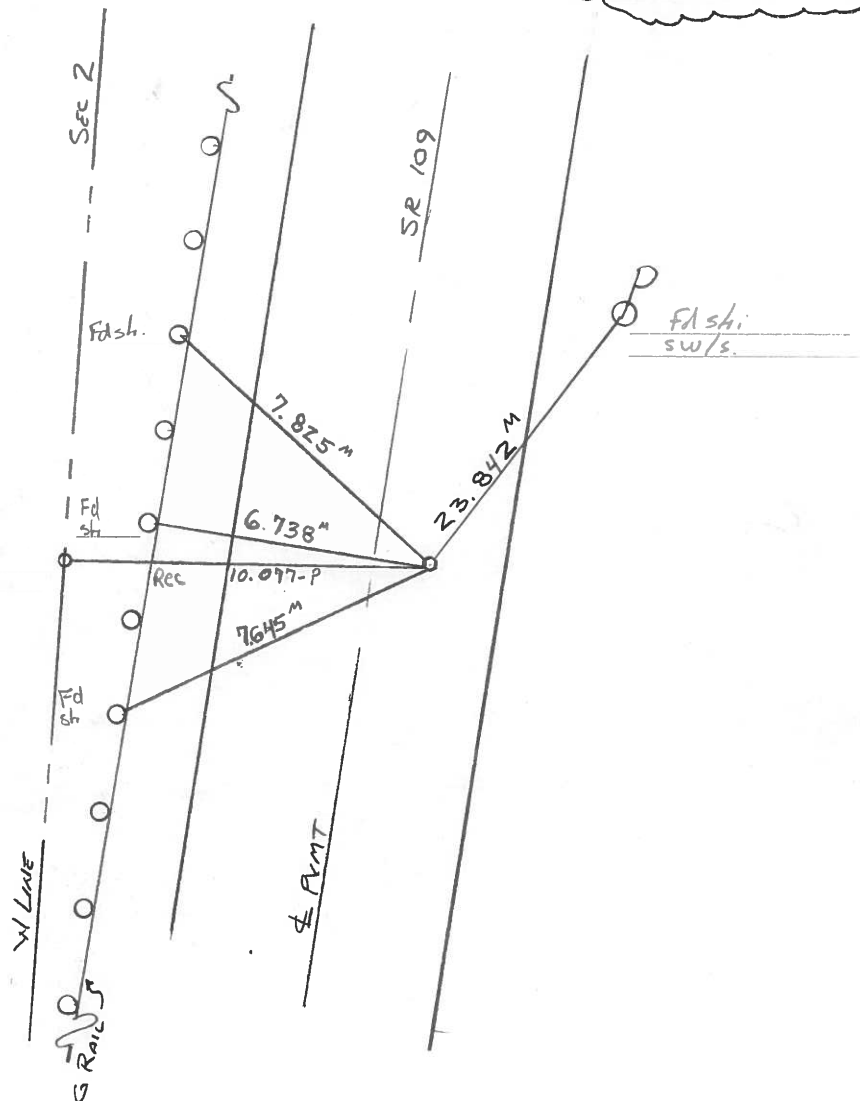

O.D.O.T. DISTRICT 2 SURVEY OFFICE

PERSONNEL

REFERENCE NO. 25-A

SHEET OF

NOTES BARNHISEL

H.C.

R.C. HOFFMAN

DATE 8-31-90

WEATHER Clear

TEMP. +72°

ROUTE 109

COUNTY Fulton

TOWNSHIP PIKE

SECTION 2

T 7 N R 7 E


TYPE MONUMENT Sm RR Spk

ON SURFACE - BELOW yes

LEFT - & PAV'T. - RIGHT 2.9

6.6 TO RT EDGE PAVEMENT

S.L.M. 515+71

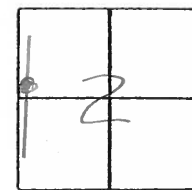

Record

P.I. STA: 515+40.04

$\Delta = 20^\circ - 27' \text{ LT}$

$D = 1^\circ$


$T = 122.52'$

$L = 245.00'$

$E = 1.31$

$R = 5729.58'$

Set P.R. & Washer
10-1-90
MB

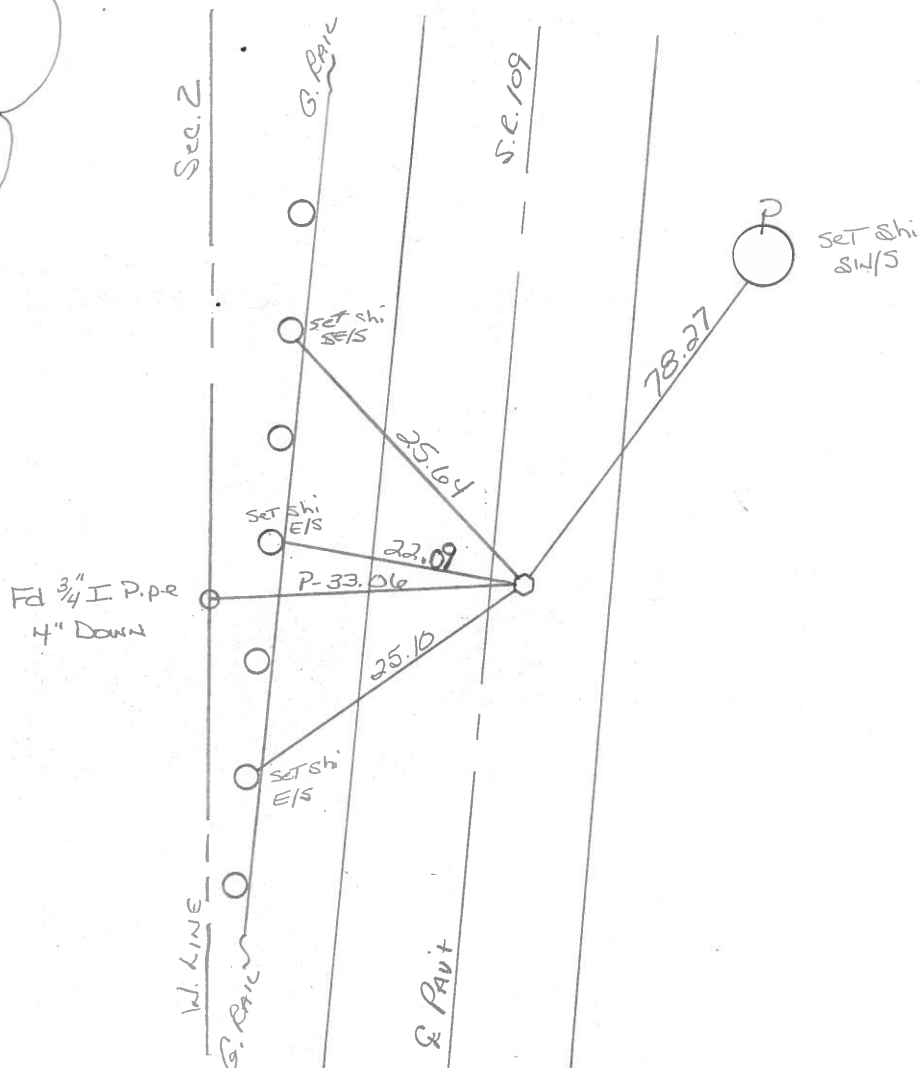

O.D.O.T. DISTRICT 2 SURVEY OFFICE

SHEET 4 OF

County Fulton S.R. 109

Township PIKE

Section 2

T N, R E

Personnel I. Stone

P. Neuse


R. Michalski

D. Curtis


Date 11 April 84

Weather Fair

Temp. 48°

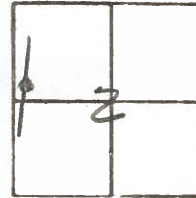

REF. No. 25-A

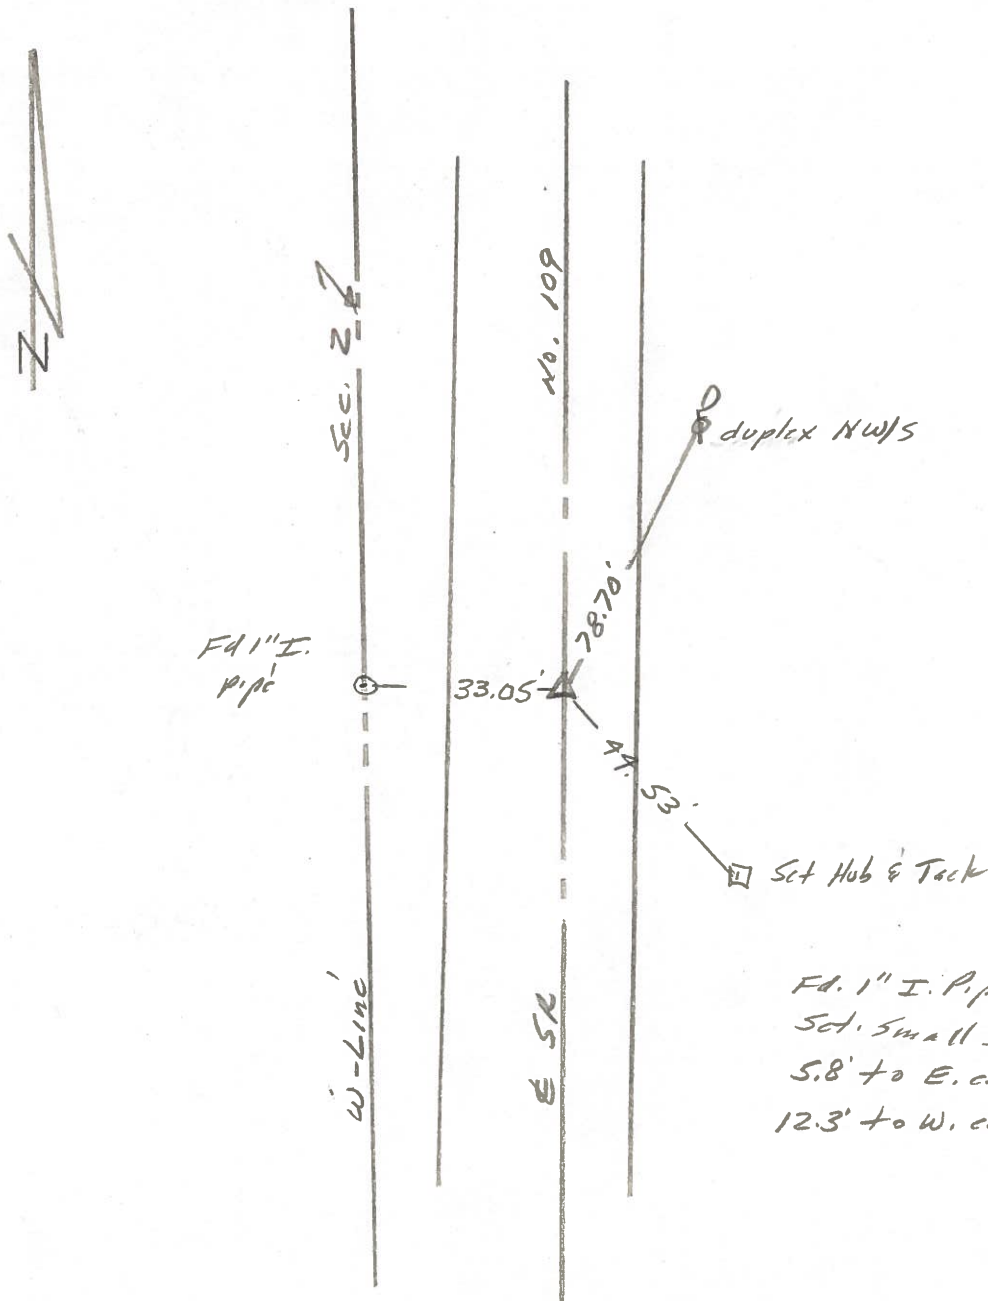

O.D.O.T. DISTRICT 2 SURVEY OFFICE

SHEET 2 OF 3

County Fulton S.R. 109

Township PIKE

Section 2-3

T.N., R.E

Personnel L. Stone

P. Neuse

R. Michalak


D. Curtis

Date 6 Jan. 82


Weather Cloudy

Temp. 35°

34	35
3	2

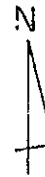

REF NO. 25-A

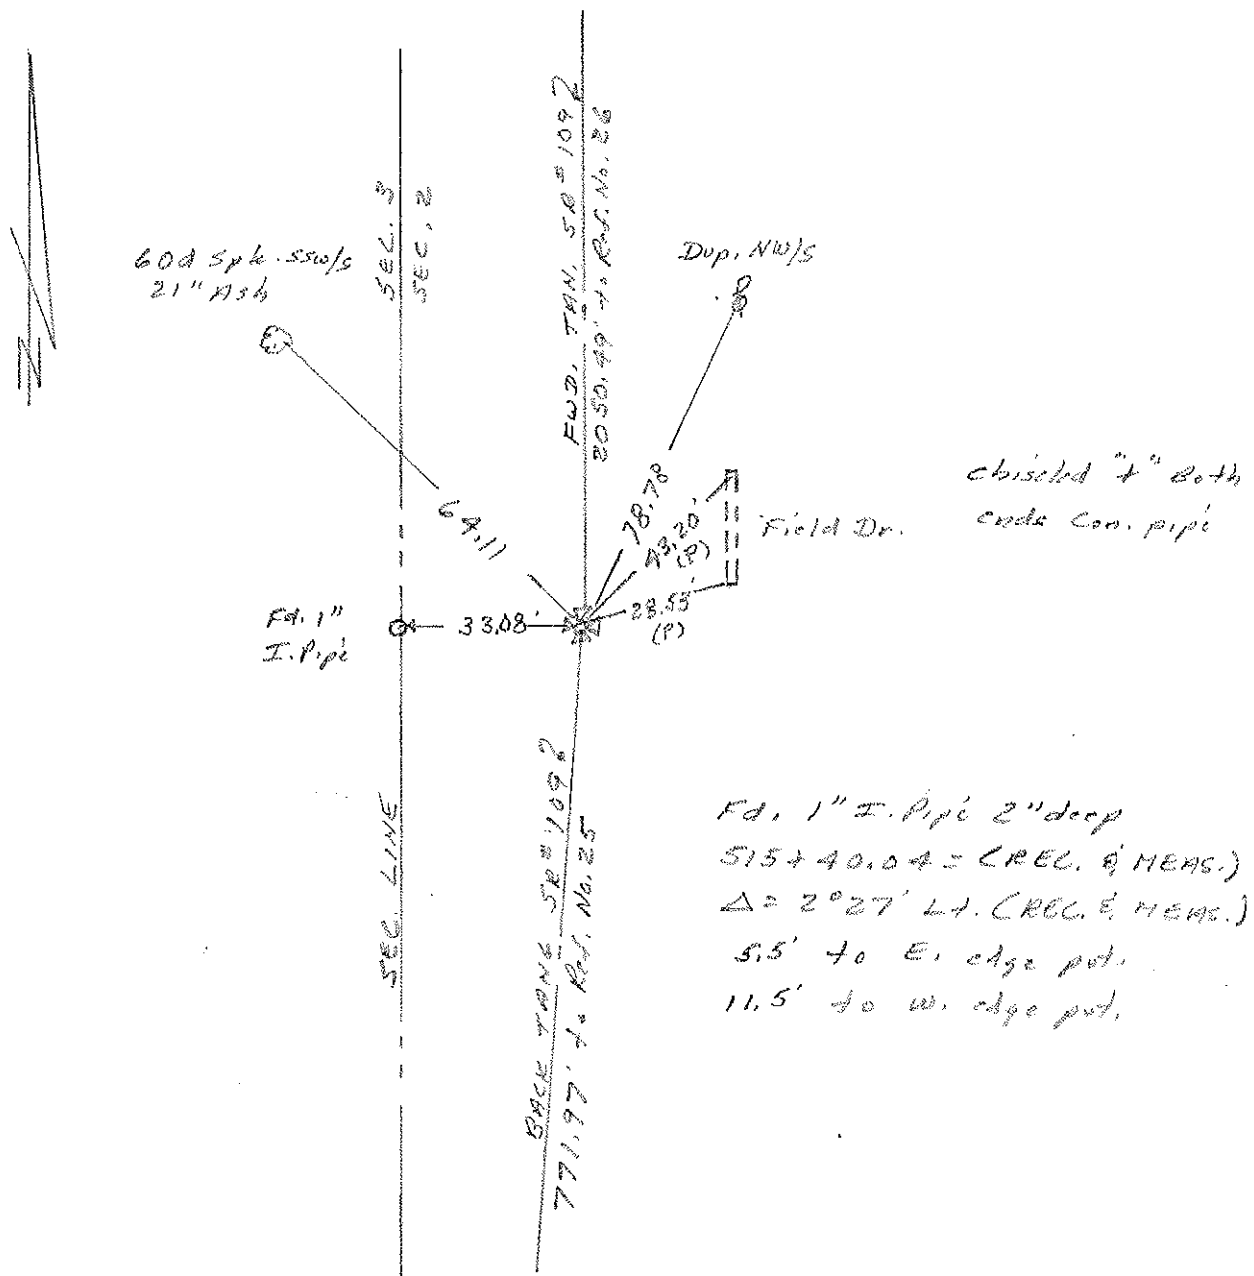

PERSONNEL TITLE PERSONNEL TITLE

Red Beach
W. KnapeCOUNTY FultonDATE JAN-Feb 1977S. R. 109

WEATHER

SEC. PIKE

TEMP.

DESCRIPTION

CONTROL POINTS

JOB NO.


LEFT

CENTER LINE

RIGHT

Found 3/4" Pipe
1970

26

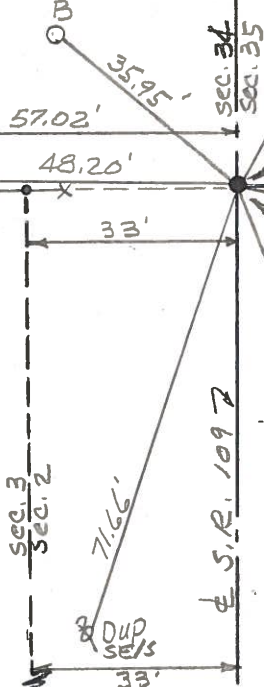

ABCD & E are 4" steel
marker pipes for
PANHANDLE EASTERN
PIPE LINE




PI Sta. 535+90.49
 $\Delta = 0^\circ 03' \text{ RT.}$

Found PK 6' off sets
6' E & S
Found 1" pipe 2" below surface
set 19 of 1970 over Cor. Sta.
PI Sta. 535+90.49
Cor. Stone Sec 34 & 35

Near sides

SEE NEW TIES

PI Sta. 515+40.04

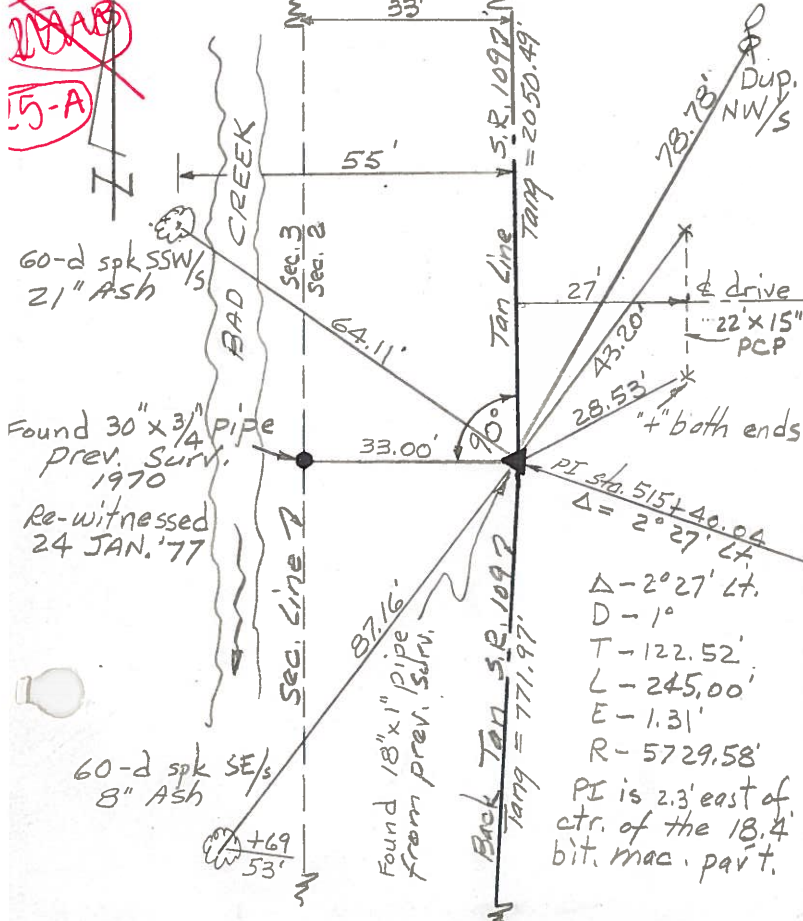

60-d spk SSW/S
21" Ash

Found 30" x 3/4" Pipe
Prev. Surv.
1970
Re-witnessed
24 JAN. '77

60-d spk SE/S
8" Ash

Found 18"x1" pipe
from prev. Surv.


Back Tan S.R. 109
Tang = 771.97'

PI Sta. 515+40.04
 $\Delta = 2^\circ 27' \text{ LT.}$

$\Delta - 2^\circ 27' \text{ LT.}$
D - 1"
T - 122.52'
L - 245.00'
E - 1.31'
R - 5729.58'

PI is 2.3' east of
ctr. of the 18.4
bit. mac. part.

27

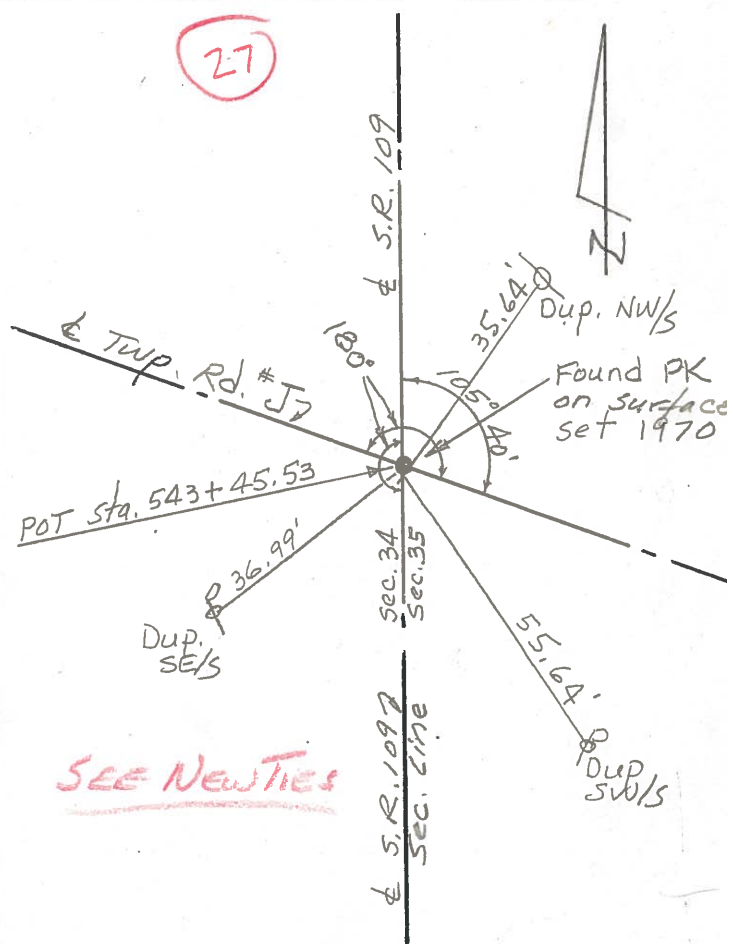

27
Twp. Rd. # J7

POT Sta. 543+45.53

Sec. 34
Sec. 35

Sec. 34
Sec. 35

SEE NEW TIES

PERSONNEL	TITLE	PERSONNEL	TITLE	COUNTY	DATE
Red Beach				FULTON	OCT-NOV. '70
Newcomb				S. R. 109	WEATHER
Knappe				SEC. PIKE TWP	TEMP.
Wise					
ALIGNMENT & CONTROLS				JOB NO.	

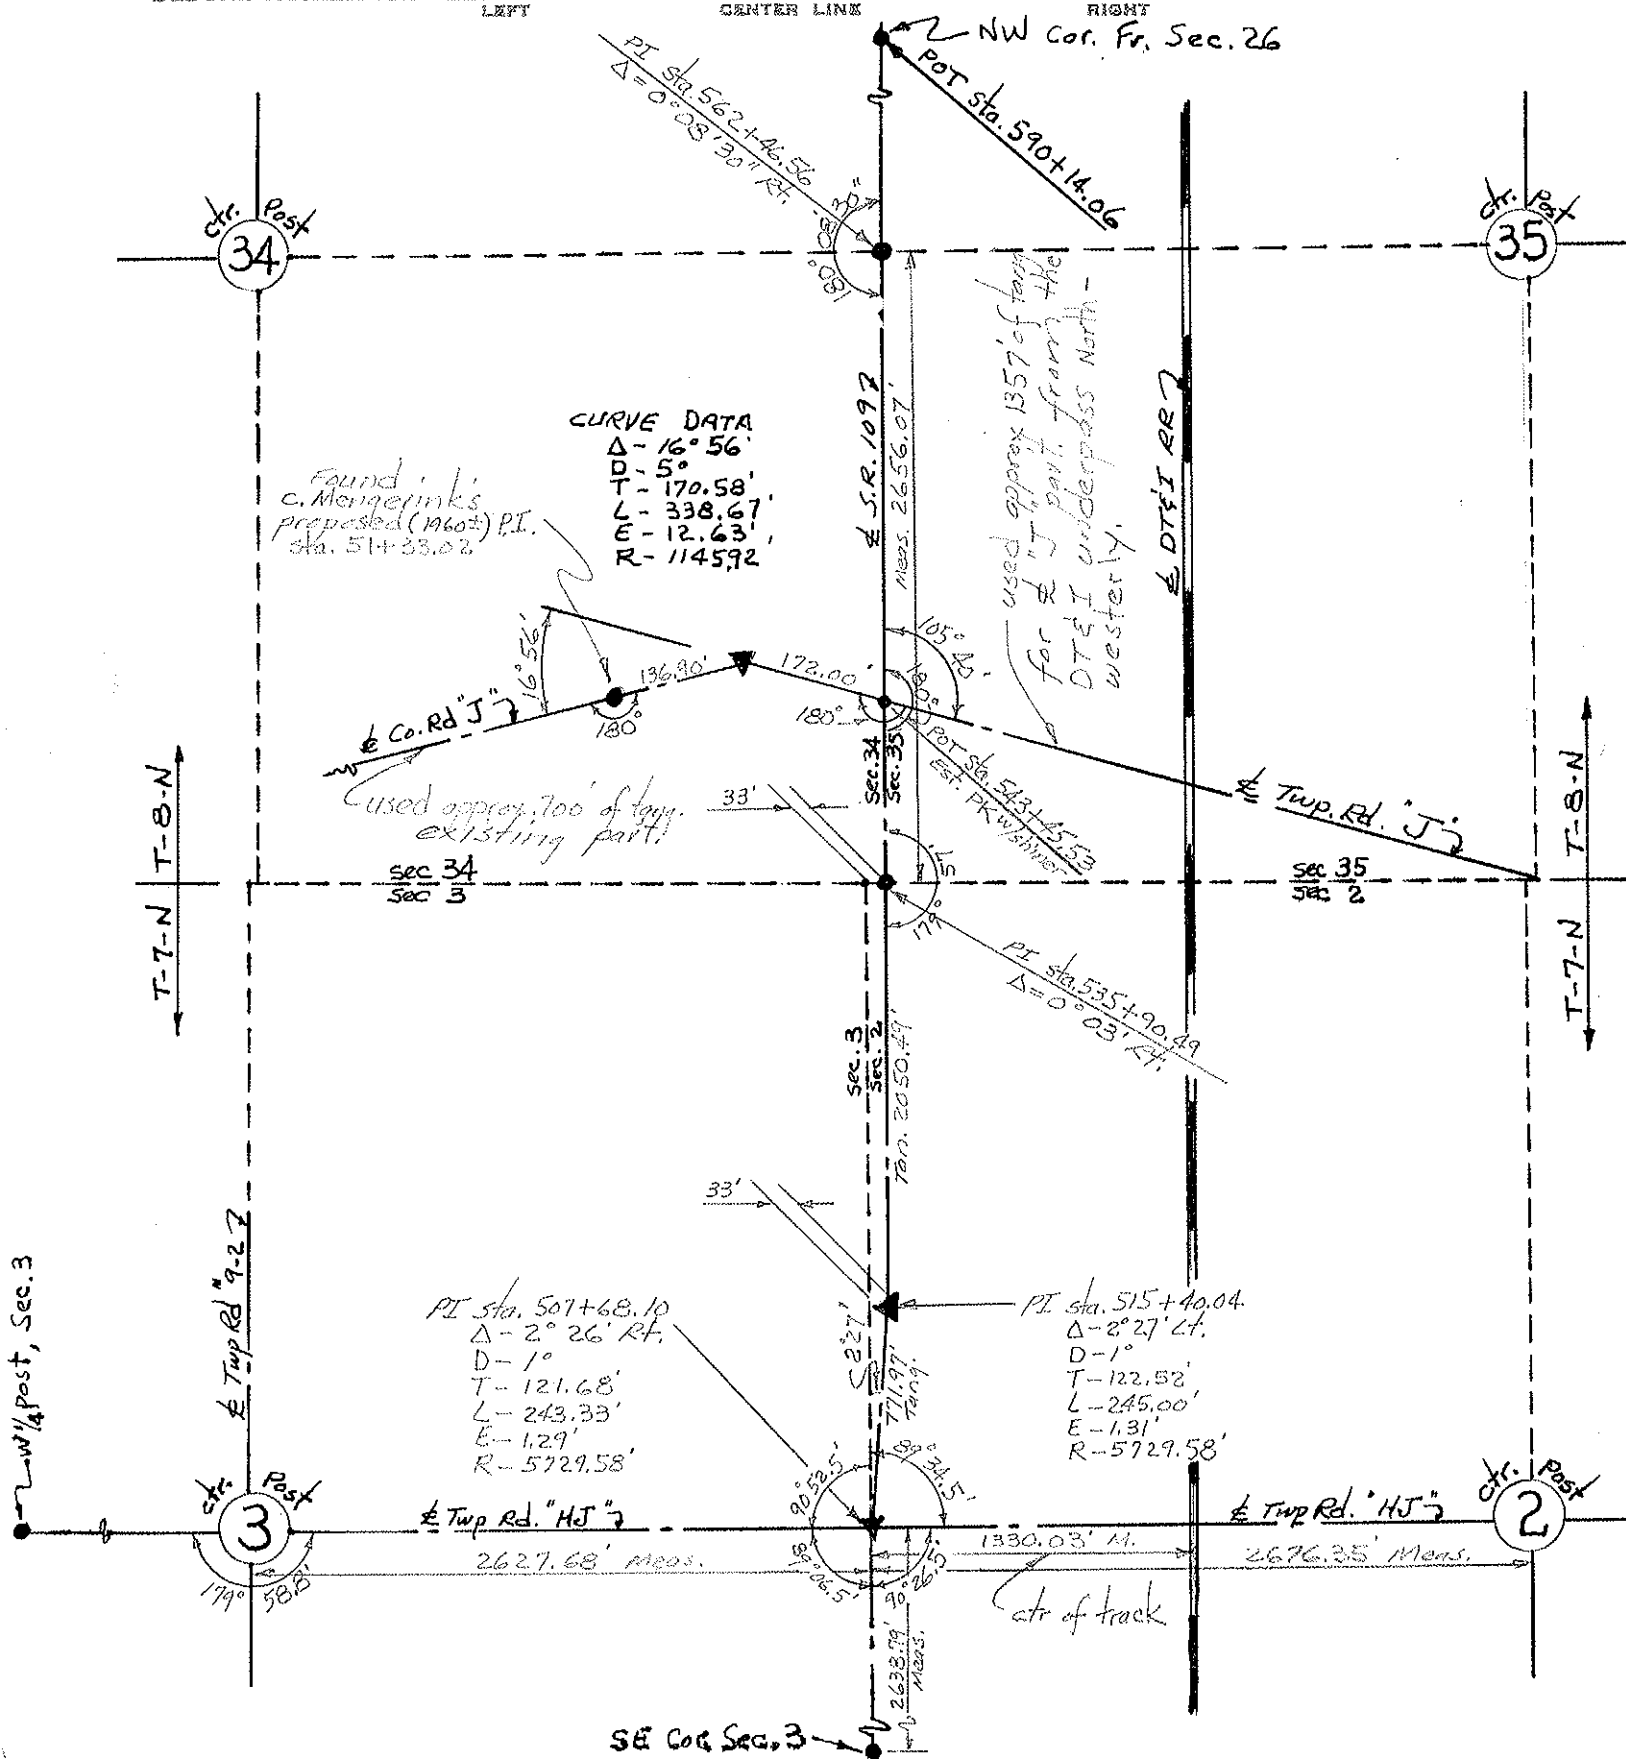

ODOT DISTRICT 2 SURVEY OFFICE

SHEET 4 OF

County Fulton S.R. 109

Township PIKE

Section 2

T N, R E

Personnel L. Stone

P. Nourse


R. Michalek

D. Curtis

Date 11 April 84

Weather Fair

Temp. 48°

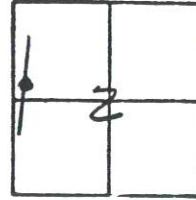

REF. No. 25-A

