

O.D.O.T. DISTRICT 2 SURVEY OFFICE (USE ONLY)

PERSONNEL

REFERENCE NO. 28

SHEET 11 OF 35

NOTES RHOADES

DATE 4/23/21

ROUTE SR 109

H.C. O'DONNELL

WEATHER CLOUDY

COUNTY FULTON

R.C. RHOADES

TEMP. 46°

TOWNSHIP PIKE

DWG BY NIESE

PID PAVE TRAIN

SECTION 35

T 8 N R 7 E

TYPE MONUMENT MAG/WASHER

ON SURFACE - ~~BELOW~~ ON

OFFSET Q PAVEMENT 0.8' LT : ~~RT~~

9.3' TO LT EDGE PAVEMENT


STATION: 549+91.55

HORZ.DATUM: NAD83(2011)

GEOID: 2018

GRID: NORTHING: 710561.775

EASTING: 1548048.826

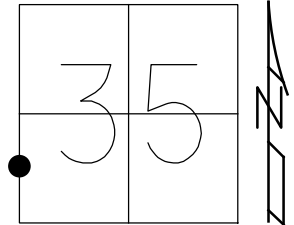

RECORD:

SET P.K./WASHER

11/20/96, MRC

FD P.K./WASHER

6/12/12, SAH

SET MAG/WASHER

2/28/13, MC


FD MAG/WASHER

3/5/13, MC

REF28

4/23/21, JFO

8/26/21, JFO

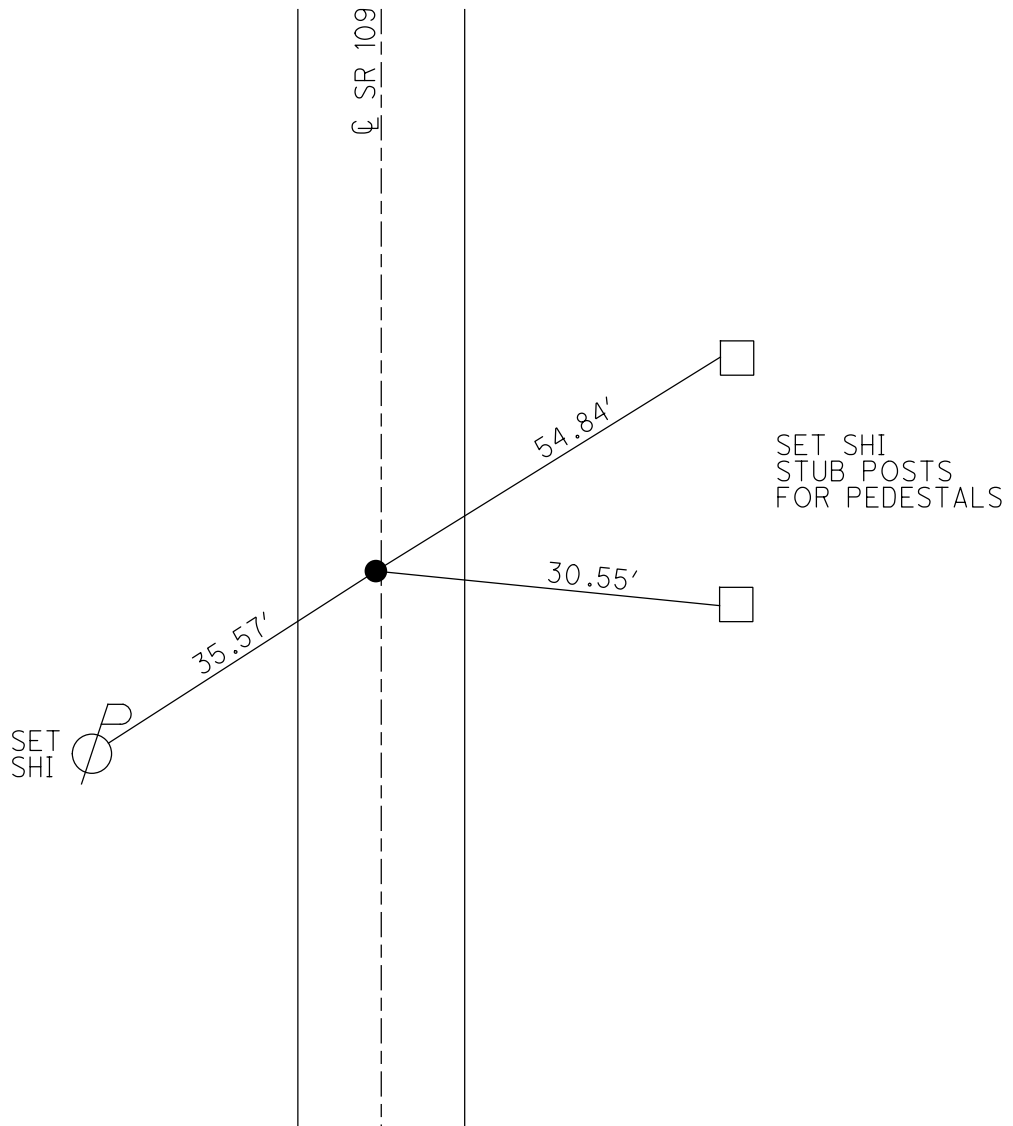


O.D.O.T. DISTRICT 2 SURVEY OFFICE (USE ONLY)

PERSONNEL	REFERENCE NO. <u>28</u>	SHEET <u>12</u> OF <u>35</u>
NOTES <u>HUSS</u>	DATE <u>06-12-12</u>	ROUTE <u>SR 109</u>
H.C. <u>HUSS</u>	WEATHER <u>FAIR</u>	COUNTY <u>FULTON</u>
R.C. <u>CANTERBURY</u>	TEMP. <u>74°</u>	TOWNSHIP <u>PIKE</u>
<u>COUTCHER</u>		SECTION <u>35</u>
		T <u>8</u> N R <u>7</u> E


TYPE MONUMENT PK/WASHER
 ON SURFACE - BELOW ON
 LEFT - Q PAV'T - RIGHT 0.8'
9.3' TO LT EDGE PAVEMENT
 S.L.M. 549+95

Grid: Northing: 710561.764 Easting: 1548048.763

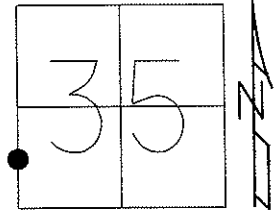

11-20-96 SET PK/WASHER
 IN LEVELING COURSE, MRC
 02-28-13 SET MAG/WASHER, MC

06-12-12 GPS REF 28
 03-05-13 FPS FIN 28, MC

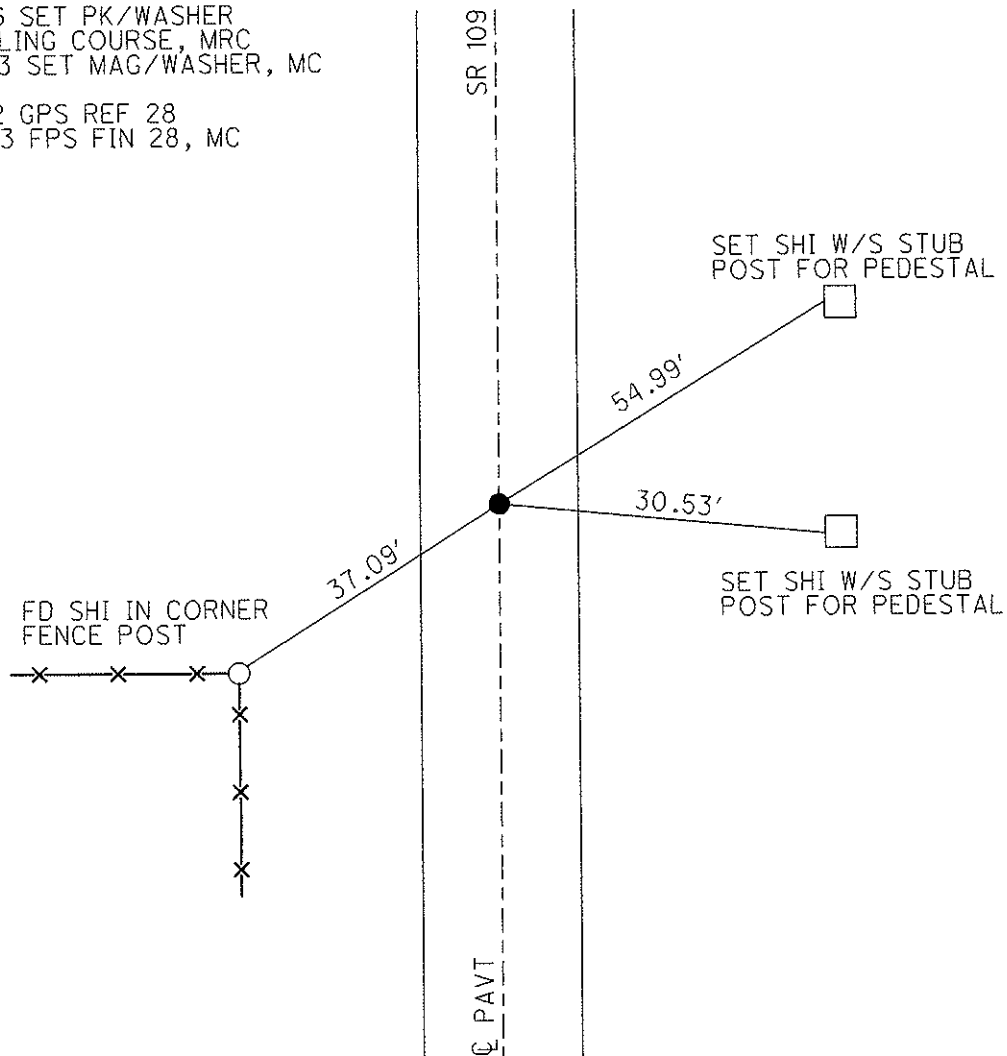

O.D.O.T. DISTRICT 2 SURVEY OFFICE

PERSONNEL

REFERENCE NO. 28

SHEET 10 OF 28

NOTES CANTERBURY

H.C. ROUSOS

R.C. LOEHRKE

DATE 8-20-96

WEATHER FAIR

TEMP. +85°

ROUTE S.R. 109

COUNTY FULTON

TOWNSHIP PIKE

SECTION 35

T. 8 N. R 7 E

Reset 10-2-97
C.L.


TYPE MONUMENT P.K. & WASHER

ON SURFACE - BELOW YES


LEFT - & PAV'T. - RIGHT O.Z. LT &

2.79 TO LT EDGE PAVEMENT

S.L.M. 16+759.690 (549+95)

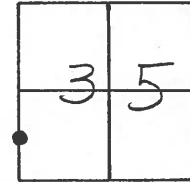

SET P.K. / WASHER IN LEVELING
COURSE 11/20/96. MRC

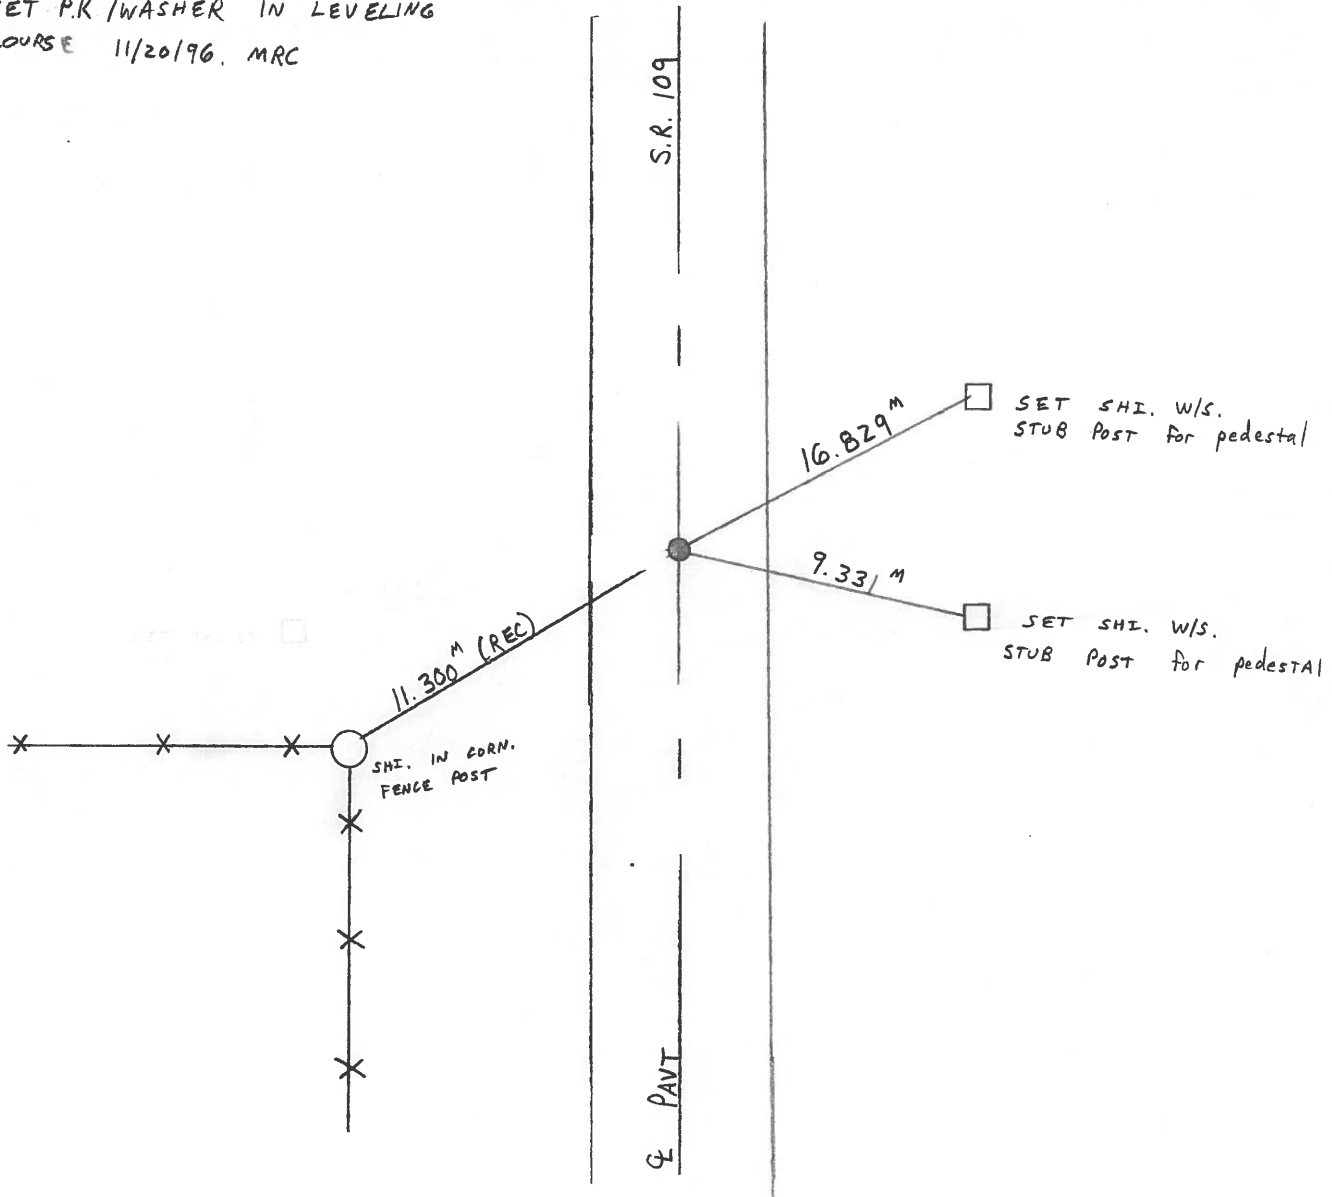

O.D.O.T. DISTRICT 2 SURVEY OFFICE

PERSONNEL

REFERENCE NO. 28

SHEET OF

NOTES BARNHISEL

H.C. " "

R.C. HOFFMAN

DATE 8-31-90

WEATHER Clear

TEMP. +75°

ROUTE 109

COUNTY Fulton

TOWNSHIP Pike

SECTION 35

T 8 N R 7 E


TYPE MONUMENT P.K. NAIL

ON SURFACE - BELOW yes


LEFT - & PAV'T. - RIGHT yes

9.6 TO RT EDGE PAVEMENT

S.L.M. 549+95

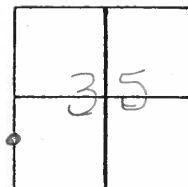

Set P.K. & Washer
10-1-90
mB

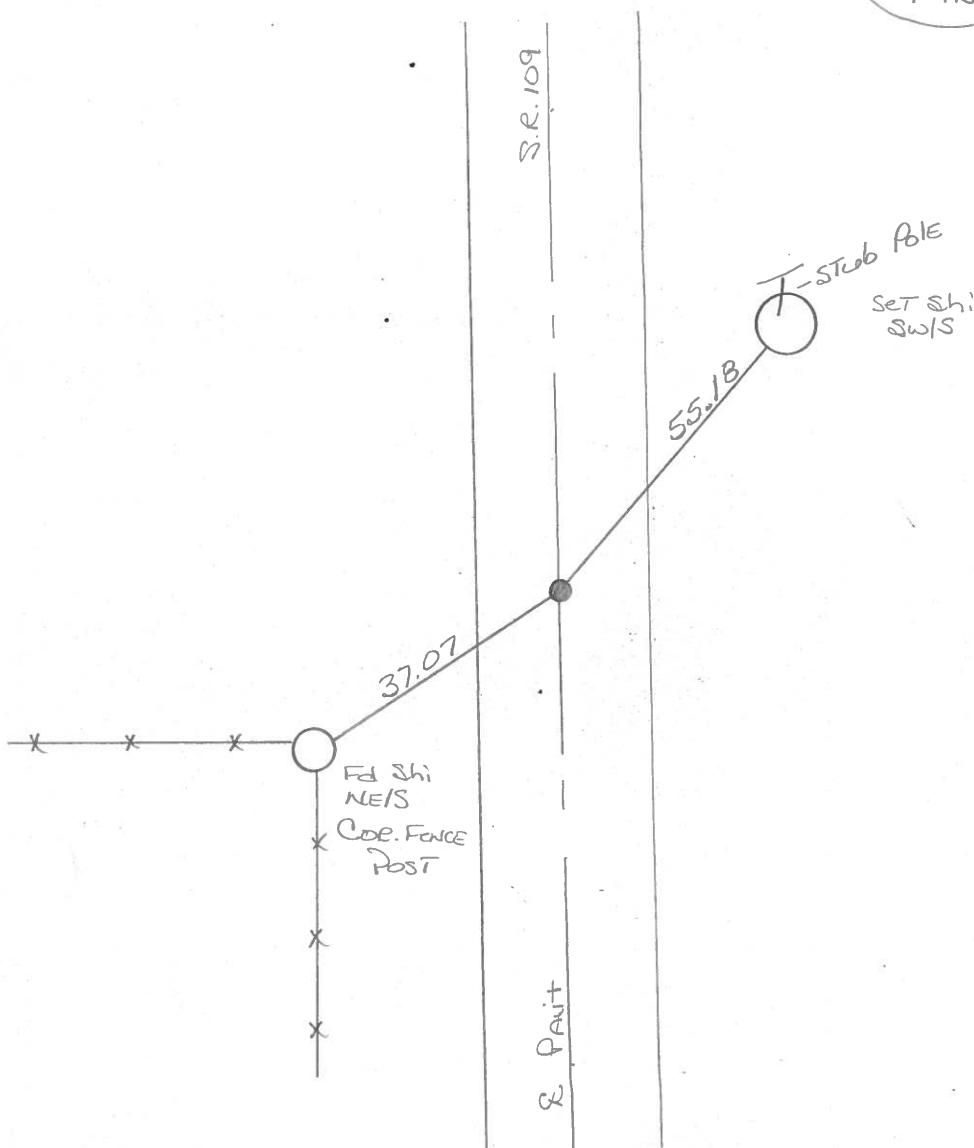

Q.D.O.T. DISTRICT 2 SURVEY OFFICE

SHEET 7 OF

County Fulton S.R. 109

Township PIKE

Section 35

T N, R E

Personnel I. Stone

P. Neuser


R. Michalek

D. Curtis


Date 11 April 84

Weather Fair

Temp. 49°

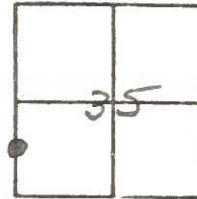

REF. NO. 28

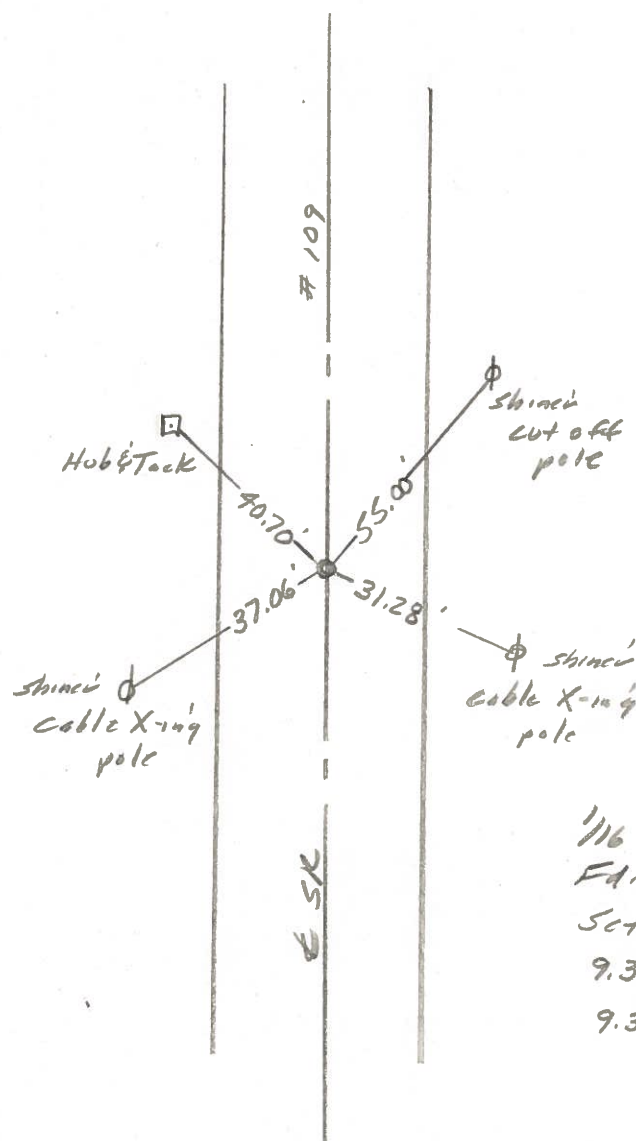

1/16 Cor. Sec. 35
 Ed. RR Spt. 1" deep
 Set PK Nail
 9.3' to E. edge put.
 9.3' to W. edge put.

Q.D.O.T. DISTRICT 2 SURVEY OFFICE

SHEET 7 OF

County Fulton S.R. 109

Township PIKE

Section 35


T N, R E

Personnel I. Stone
P. Neuser
R. Michalak
D. Curtis

Date 11 April 84

Weather Fair


Temp. 49°

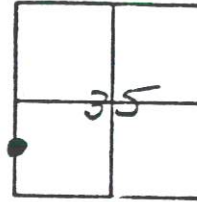

REF. NO. 28



549+95
 ON L
 9.6 LTED

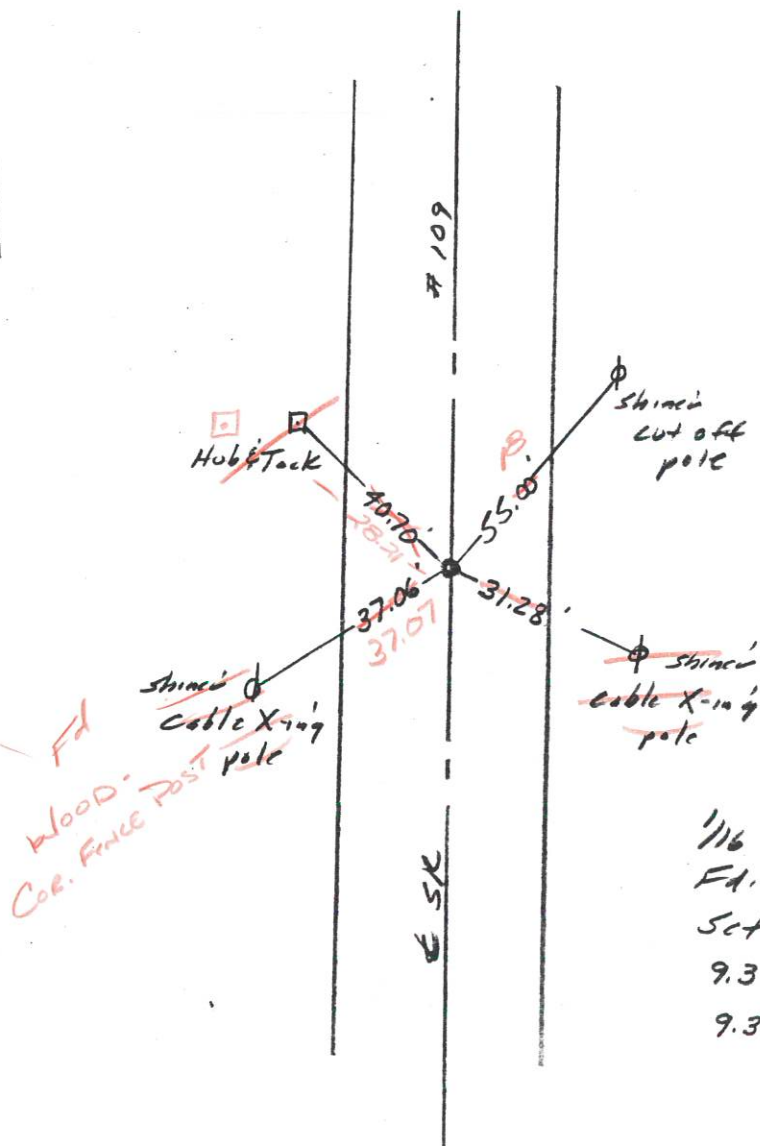

1/16 Cor. Sec. 35
 Fd. RRSpt. 1" deep
 Set PK Nail
 9.3' to E. edge put.
 9.3' to W. edge put.

ROAD "8-1" + $\frac{1}{4}$ $\frac{1}{4}$ line

TITLE

Crew Chief

SEC. 35 T- 8-N R- 7-E

Red Men

CORNER C.P. $\frac{1}{4}$ $\frac{1}{4}$ line TWP. Pike


Red Man

DATE 5-1-80 WEATHER Sunny 60°

DESCRIPTION

Rewitnessed RR spike on $\frac{1}{4}$ $\frac{1}{4}$ line Sta 67+75.88
on re-established Rd / R/W $\frac{1}{4}$

References Checked 4-2-86
STANLEY, HARRIS
RR Spike With Cut"
SET HARROW TOOTH ARMED
RESURFACING 11-19-86 25

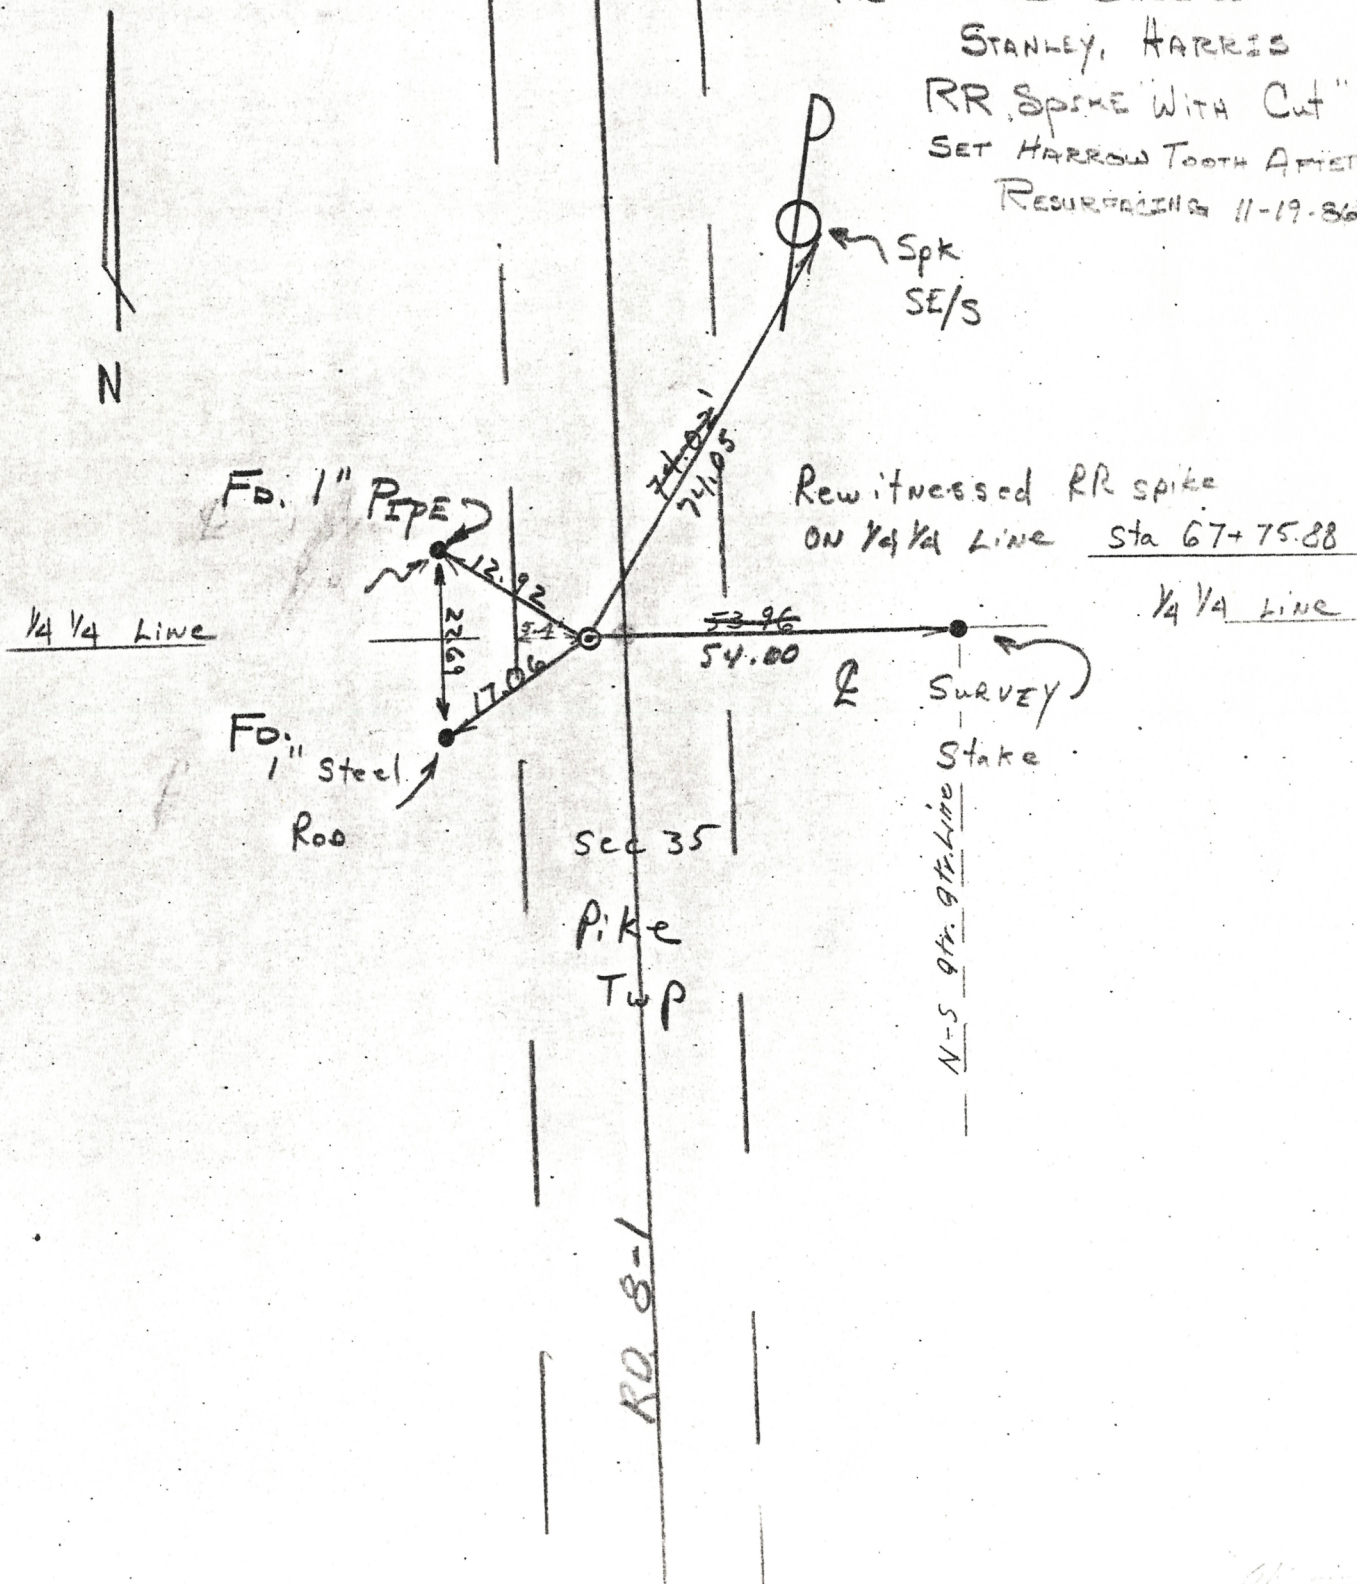

PERSONNEL	TITLE	PERSONNEL	TITLE	COUNTY	DATE	WEATHER	TEMP.
Tomsen		Granata		Fulton	July-18-73	clear	85°
Nevers				S. R. 109			
Vango				SEC.			
Boyle							

DESCRIPTION MON. JOB NO. 024610

