

# O.D.O.T. DISTRICT 2 SURVEY OFFICE (USE ONLY)

PERSONNEL

REFERENCE NO. 37-A

SHEET 30 OF 35

NOTES HARBAUGH

DATE 06-25-12

ROUTE SR 109

H.C. HUSS

WEATHER FAIR

COUNTY FULTON

R.C. COUTCHER

TEMP. 68°

TOWNSHIP ROYALTON

SECTION 26

T 9 S R 3 E

TYPE MONUMENT SHANK


ON SURFACE - BELOW ON

LEFT - Q PAV'T - RIGHT 0.6'

9.5' TO LT EDGE PAVEMENT


S.L.M. 748+75

Grid: Northing: 730160.138 Easting: 1548923.802

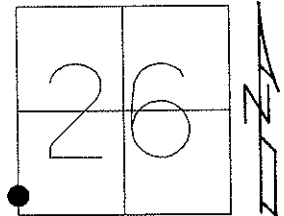

11-23-96 SET PK/WASHER  
IN FINAL COURSE, MRC  
09-29-97 RESET PK/WASHER, CL  
03-04-13 RESET MAG/WASHER, MC

06-25-12 GPS REF A37  
03-04-13 GPS FIN A37

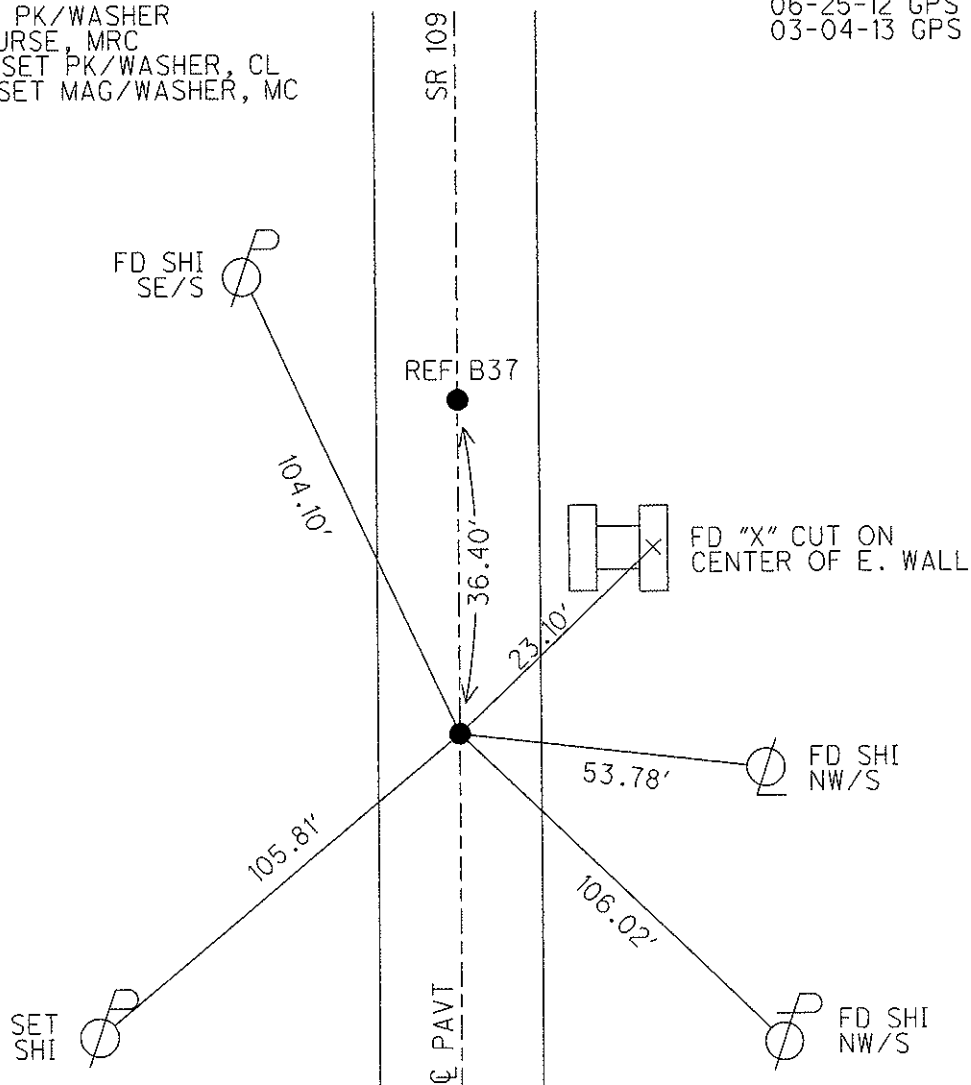

O.D.O.T. DISTRICT 2 SURVEY OFFICE

## PERSONNEL

REFERENCE NO. 37 A & B

SHEET 26 OF 28

NOTES CANTERBURY

H.C. Rousos

R.C. CANTERBURY

DATE 9-3-96

WEATHER FAIR

TEMP. +80°

Reset 9-29-97

C.L.

ROUTE S.R. 109

COUNTY FULTON

TOWNSHIP ROYALTON

SECTION 26

T 9 S R 3 E



TYPE MONUMENT PK/WASHER PK/WASHER

ON SURFACE - ~~BELOW~~ YES YES

LEFT - & PAV'T. - RIGHT ON 2 ON 2

2.82  
2.82 TO LT EDGE PAVEMENT

S.L.M. ZZ + 813.600      ZZ + 824.680

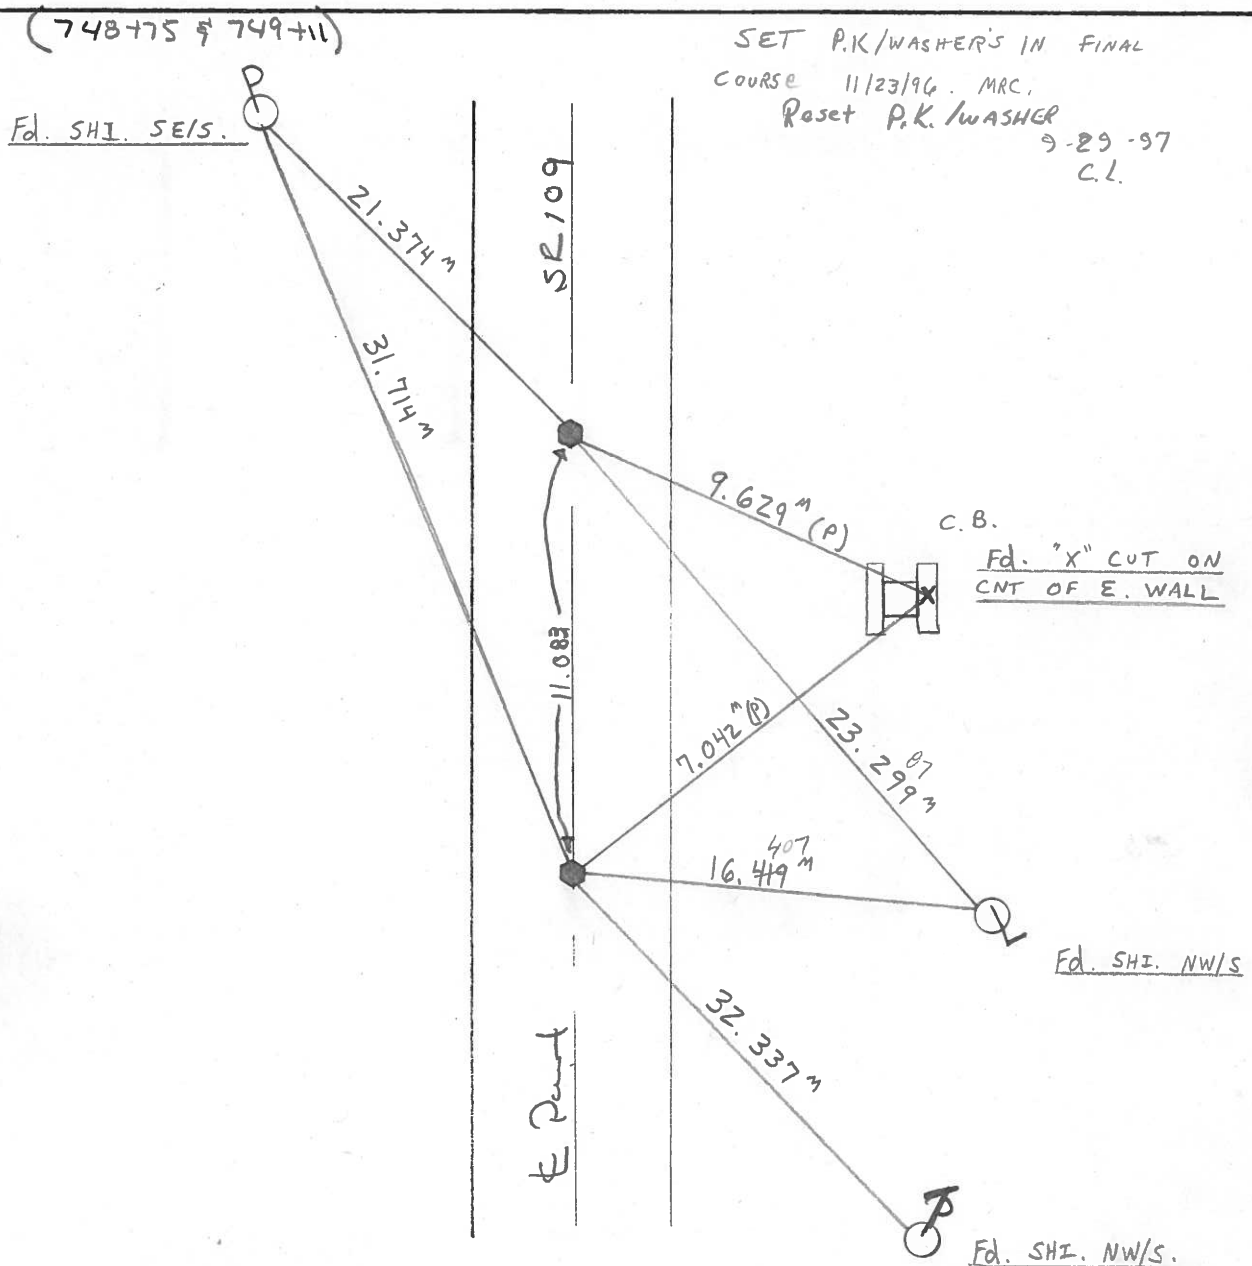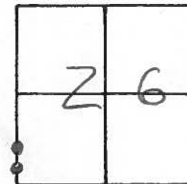

# O.D.O.T. DISTRICT 2 SURVEY OFFICE

PERSONNEL

REFERENCE NO. 37A & B

SHEET      OF     

NOTES BARNHISEL

H.C. " "

R.C. HOFFMAN

DATE 9-4-90

WEATHER CLEAR

TEMP. +85°

ROUTE 109

COUNTY FULTON

TOWNSHIP COALTON

SECTION 26

T 9 S R 3 E

PT. A

PT. B


TYPE MONUMENT P.K. NAIL P.K. NAIL

ON SURFACE - BELOW YES YES

LEFT- & PAV'T. - RIGHT ON R 0.5 LT


10.0 TO LT EDGE PAVEMENT

S.L.M. 748+75 & 749+11

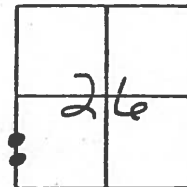

Set P.K. NAILS

10-1-90  
mB

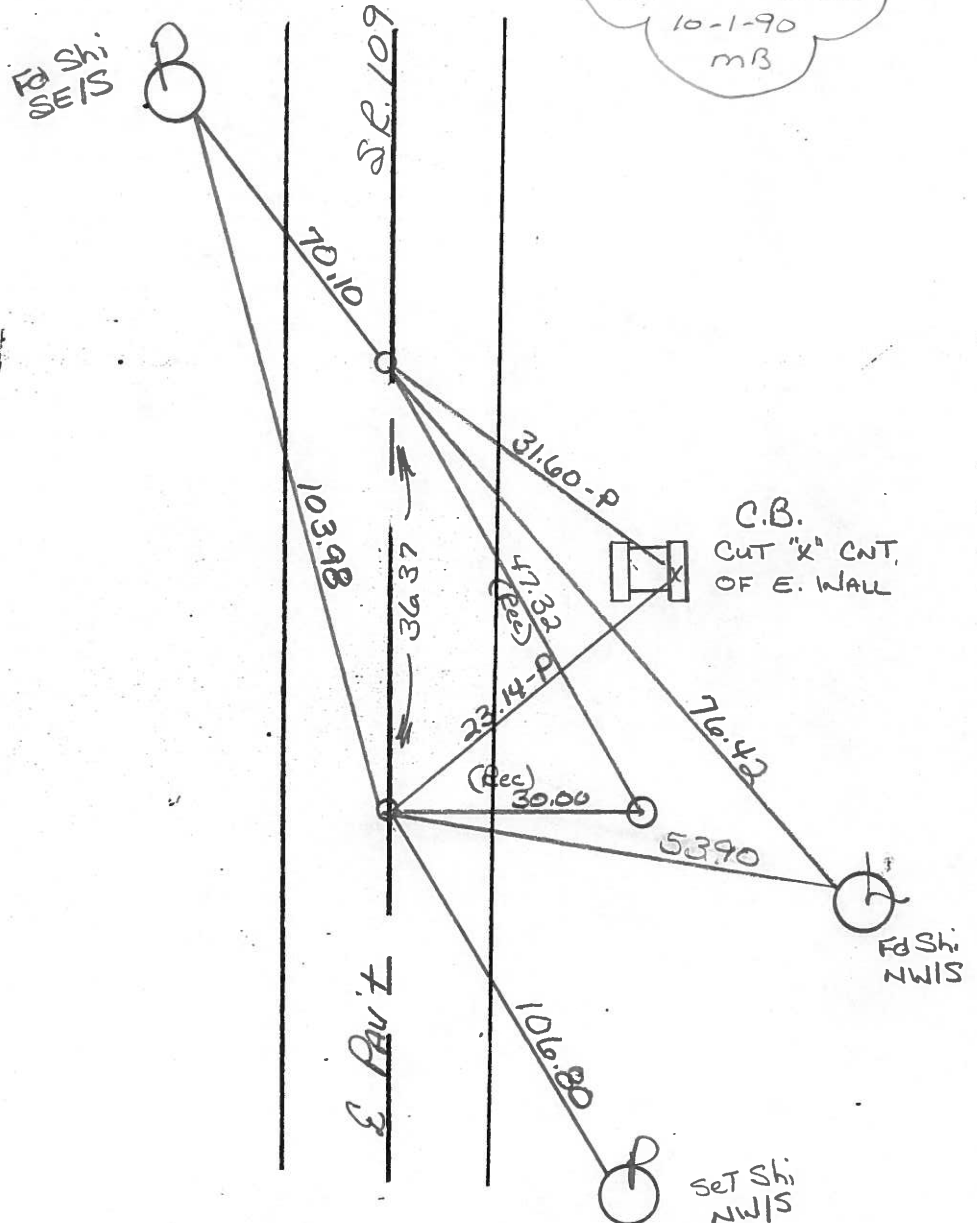

County Fulton S.R. 109

Township Royalton

Section 26

T.N., R.E

Personnel I. Stone

P. Neuser


R. Michalek

D. Curtis


Date 12 April 84

Weather Sunny

Temp. 55°

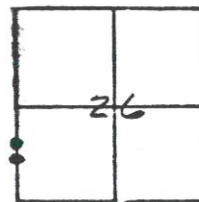

REF. NO.

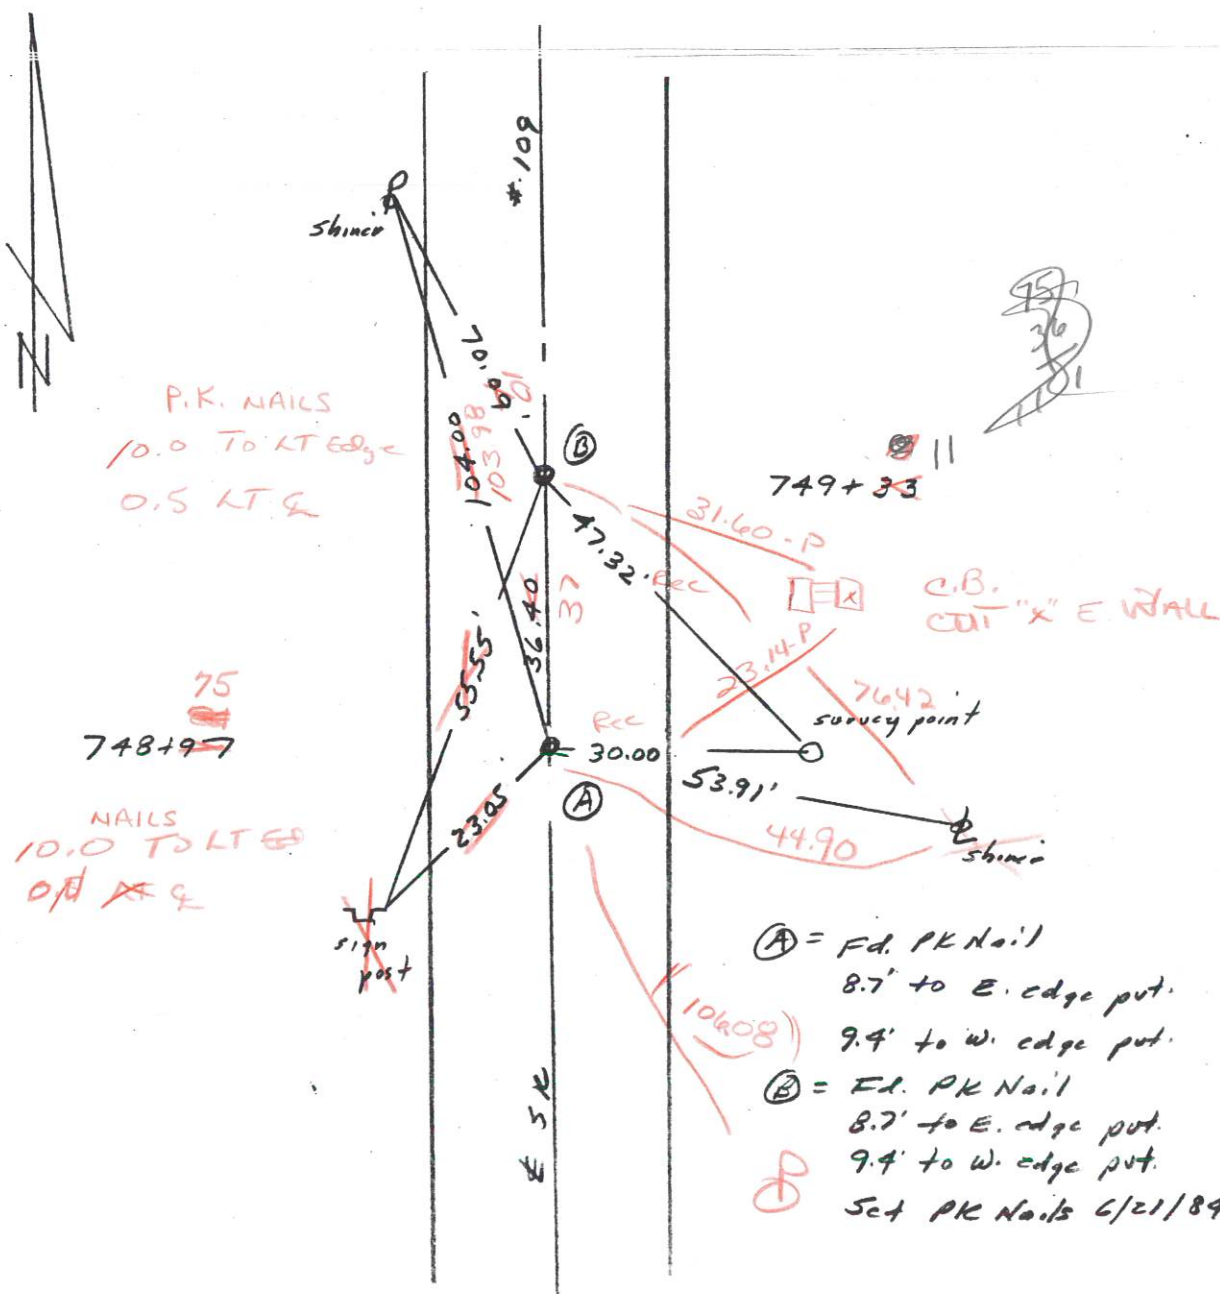

# Q.D.O.T. DISTRICT 2 SURVEY OFFICE

SHEET 23 OF       

County Fulton S.R. 109

Township Royalton

Section 26

T N, R E

Personnel I. Stone

P. Neuser


R. Michalek

D. Curtis


Date 12 April 84

Weather Sunny

Temp. 55°

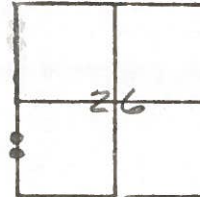

REF. NO. 37 A  
37 B

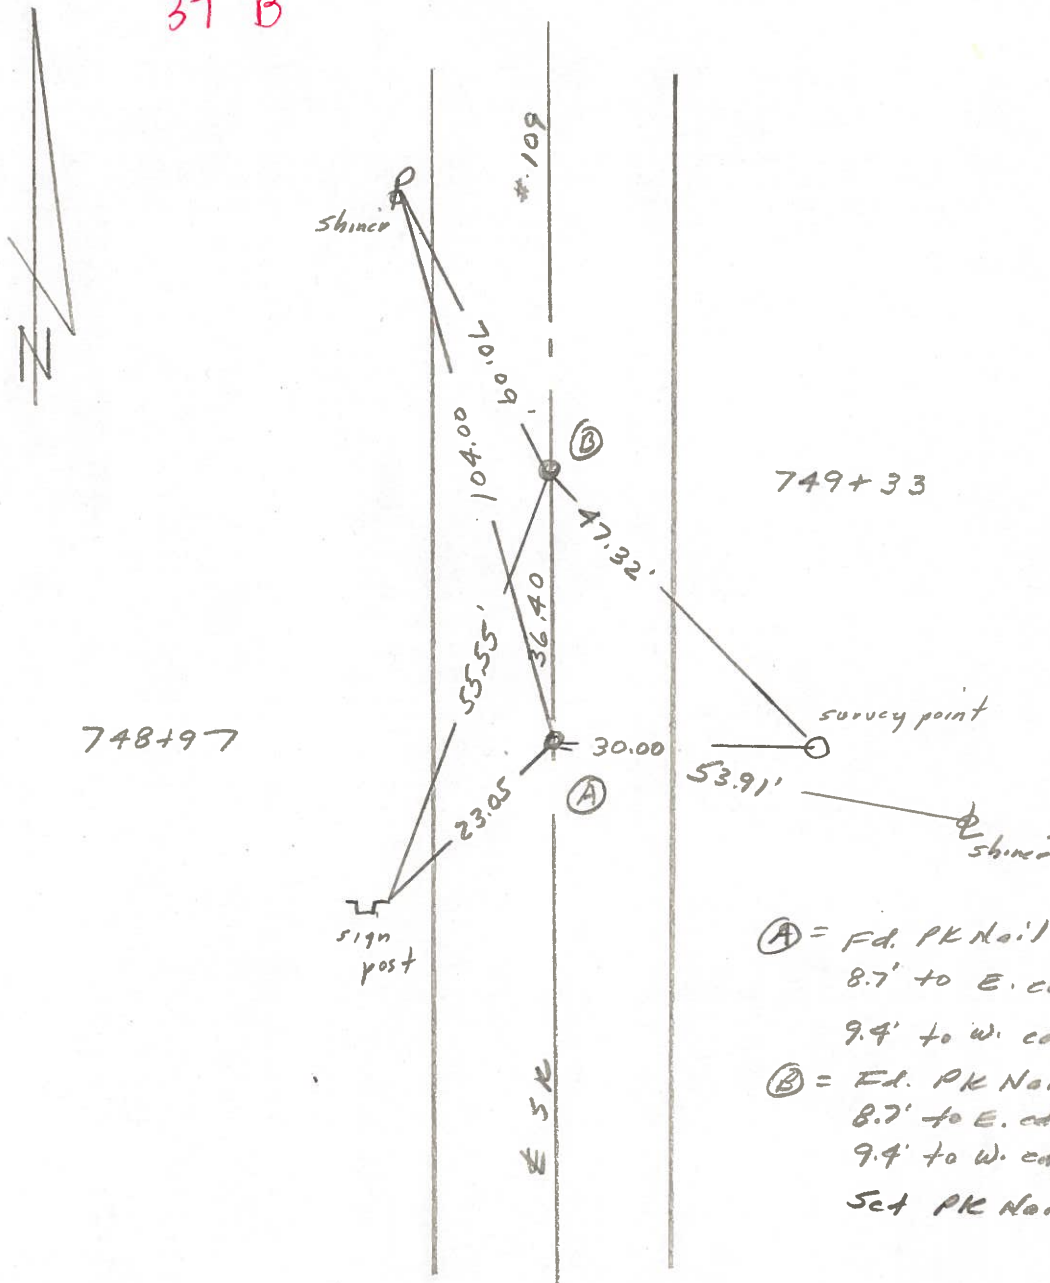

- (A) = Fd. PK Nail  
8.7' to E. edge put.  
9.4' to W. edge put.
- (B) = Fd. PK Nail  
8.7' to E. edge put.  
9.4' to W. edge put.
- Set PK Nails 6/21/84