

O.D.O.T. DISTRICT 2 SURVEY OFFICE (USE ONLY)

PERSONNEL

REFERENCE NO. 38-A

SHEET 33 OF 35

NOTES HARBAUGH

DATE 06-25-12

ROUTE SR 109

H.C. HUSS

WEATHER WINDY

COUNTY FULTON

R.C. COUTCHER

TEMP. 70°

TOWNSHIP ROYALTON

SECTION 26

T 9 S R 3 E

TYPE MONUMENT PK/WASHER


ON SURFACE - BELOW ON

LEFT - Q PAV'T - RIGHT 1.5'

9.0' TO LT. EDGE PAVEMENT


S.L.M. 779+50

Grid: Northing: 733230.281 Easting: 1548905.517

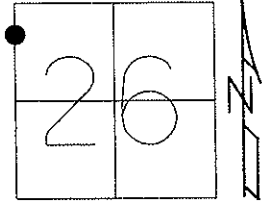

11-23-96 SET PK/WASHER
IN FINAL COURSE, MRC
09-29-97 RESET PK/WASHER, CL
03-04-13 RESET MAG/WASHER, MC

06-25-12 GPS REF A38, SAC
03-04-13 GPS FIN A38, MC

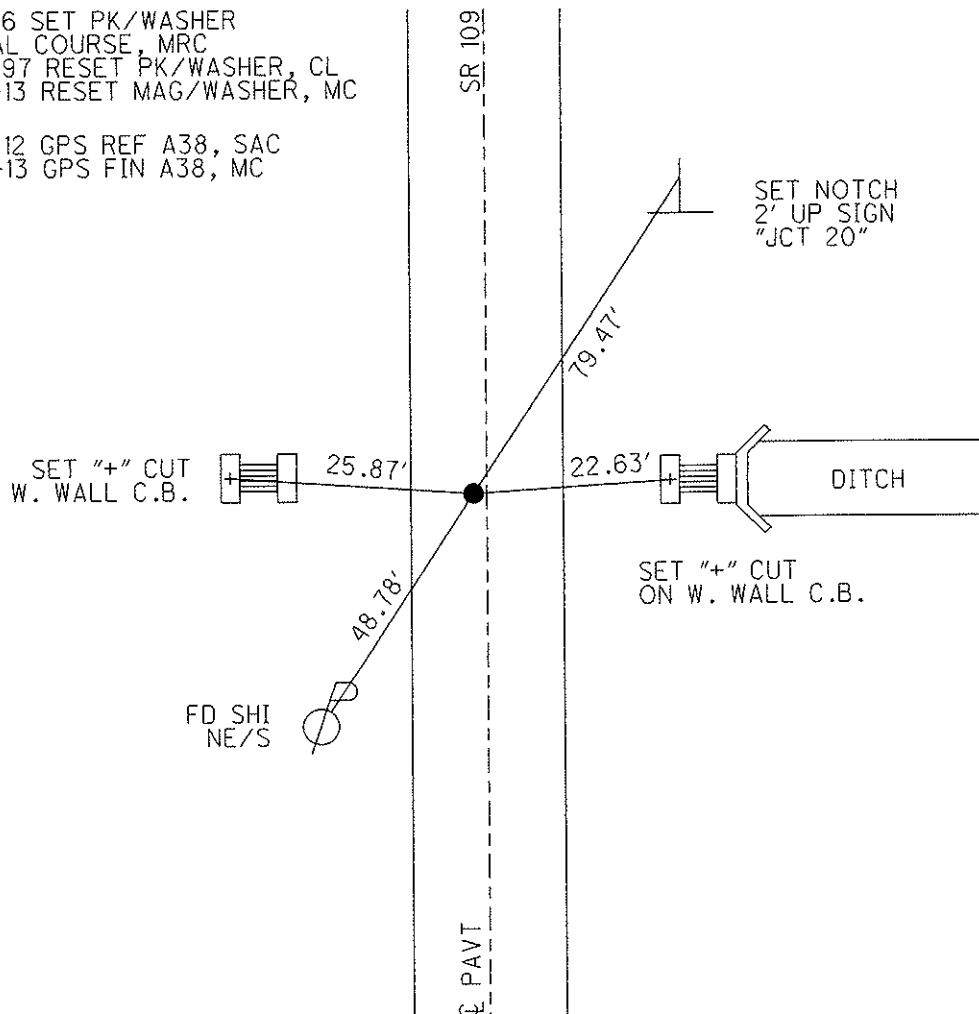

O.D.O.T. DISTRICT 2 SURVEY OFFICE

PERSONNEL

REFERENCE NO. 38-A

SHEET 28 OF 28

NOTES CANTERBURY

H.C. ROUSOS

R.C. CANTERBURY

DATE 9-3-96

WEATHER FAIR

TEMP. +80°

ROUTE S.R. 109

COUNTY FULTON

TOWNSHIP ROYALTON

SECTION 26

T 9 S R 3 E

Reset 9-29-97

C.L.


TYPE MONUMENT P.K. / WASHER

ON SURFACE - BELOW yes

LEFT - Q PAV'T. - RIGHT 0.36 LT Q

2.53 TO LT EDGE PAVEMENT

S.L.M. 23 + 750 (779 + 50)

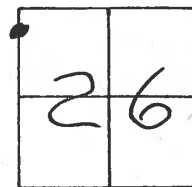

SET P.K. / WASHER IN FINAL

COURSE. 11/23/96. MRC

Reset P.K. / WASHER

9-29-97

Fd. "t" CUT
E. WALL C.B.



6.795' (P)



Fd shi
NE/S

S.R. 109

Q PAVT

7.950' (P)



Fd "X" CUT
ON E. WALL
C.B.

DITCH

O.D.O.T. DISTRICT 2 SURVEY OFFICE

PERSONNEL

REFERENCE NO. 38-A

SHEET OF

NOTES BARNHISEL

H.C. " "

R.C. HOFFMAN

DATE 9-4-90

WEATHER CLEAR

TEMP. +85°

ROUTE 109

COUNTY Fulton

TOWNSHIP ROYALTON

SECTION 26

T 9 S R 3 E


TYPE MONUMENT Sm RR Spk

ON SURFACE - BELOW yes


LEFT- & PAV'T. - RIGHT 1.3



9.8 TO LT EDGE PAVEMENT

S.L.M. 279+50

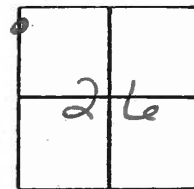

Set P.K. & Washer
10-1-90
mB

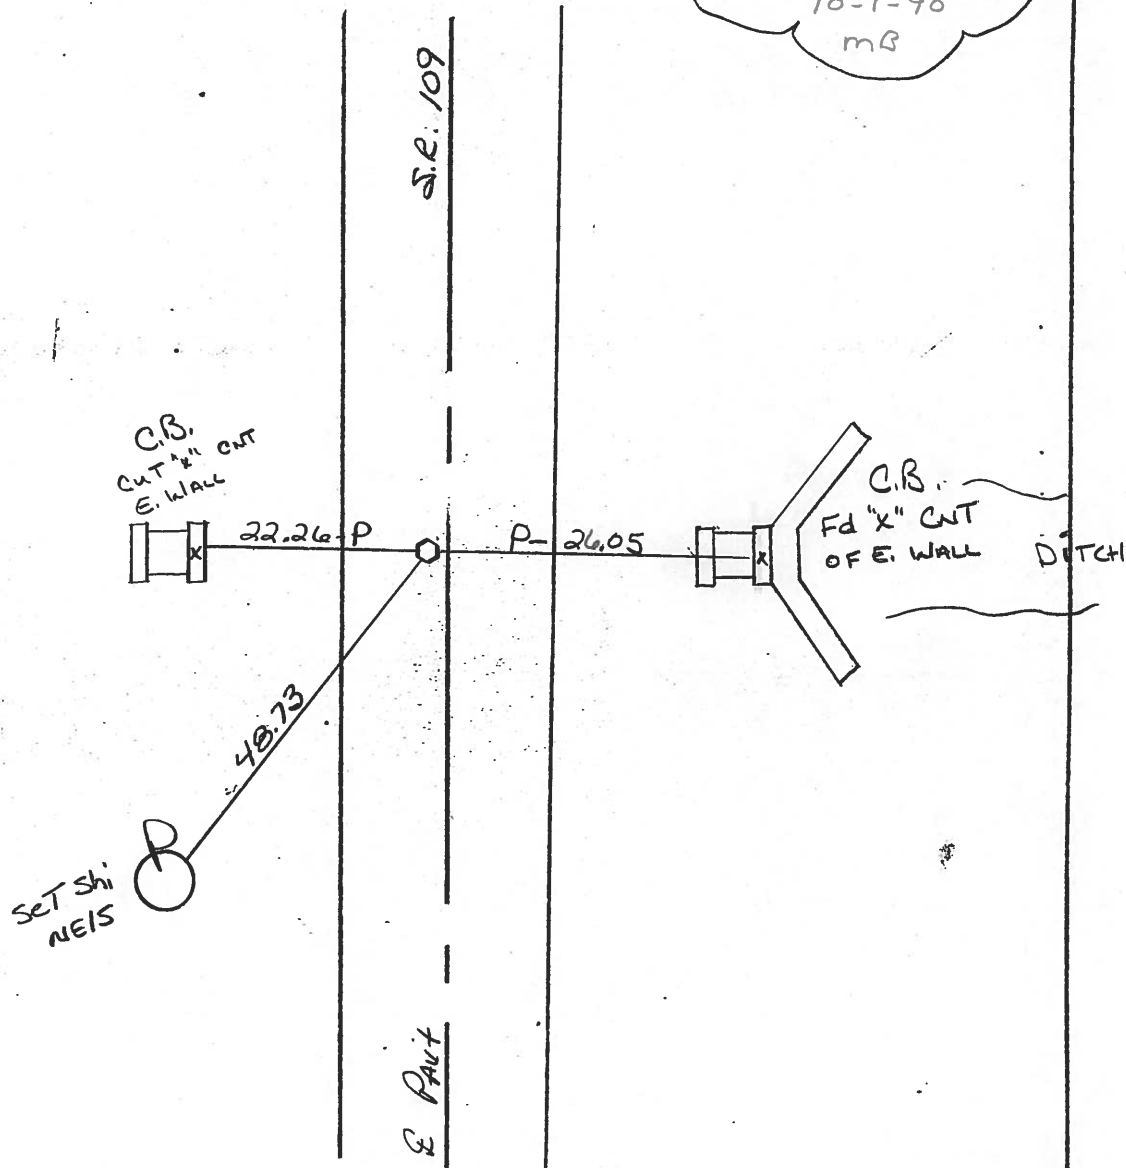

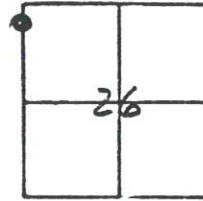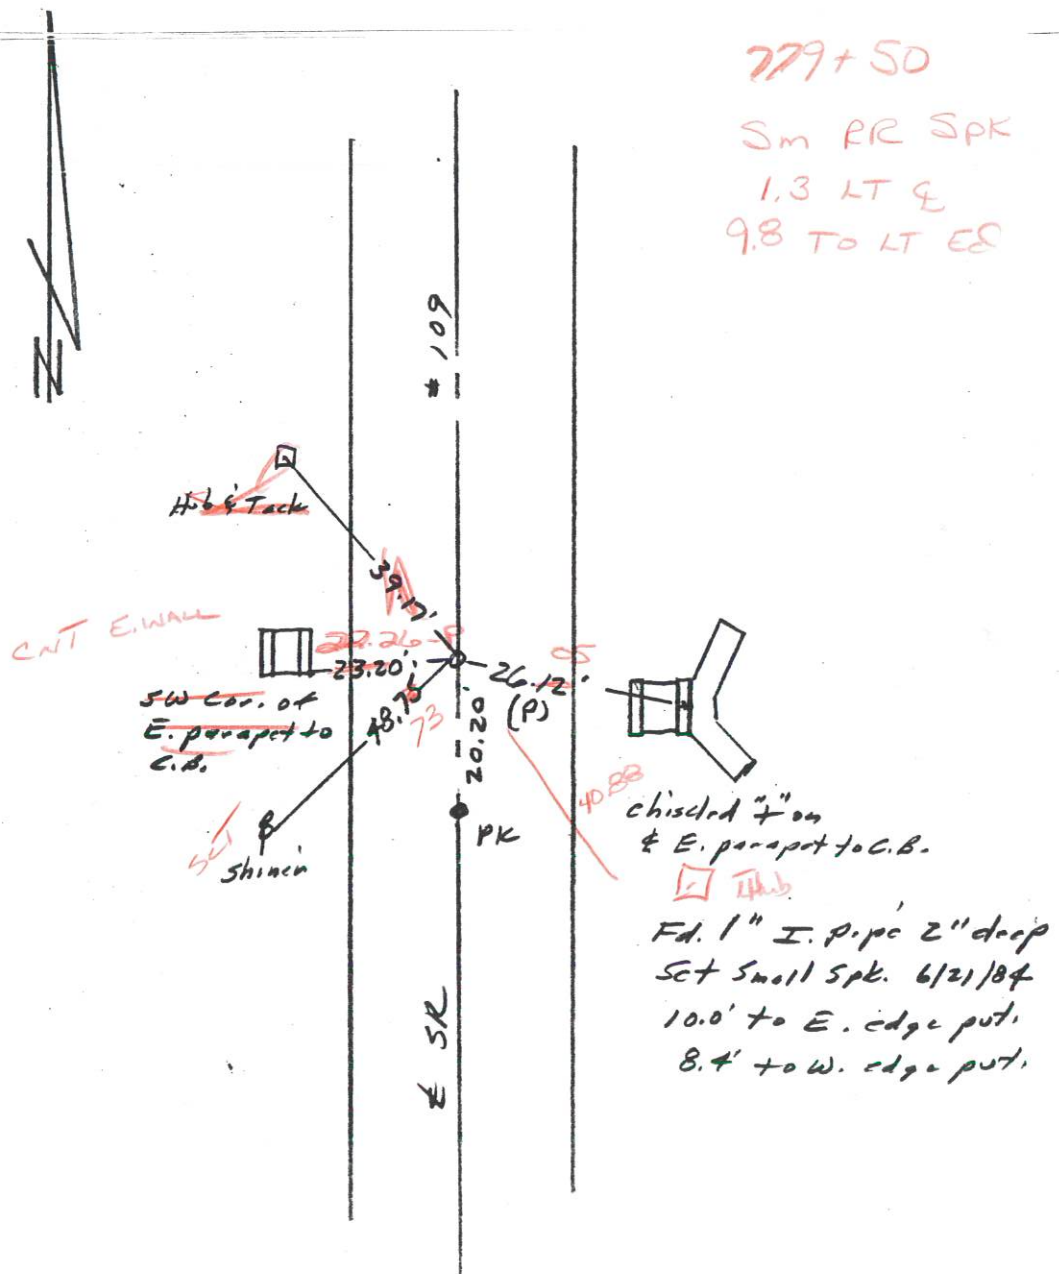County Fulton S.R. 109Township RoyaltonSection 26T N, R EPersonnel I. StoneP. NeuseR. MichalakD. CurtisDate 12 April 84Weather SunnyTemp. 55°REF. NO. 38-A

County Fulton S.R. 109

Township Royalton

Section 26

T N, R E

Personnel L. Stone

P. Newson


R. Michalski

D. Curtis


Date 12 April 84

Weather Sunny

Temp. 55°

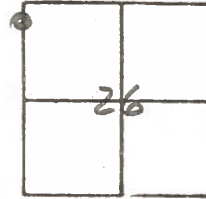


REF. NO. 38-A

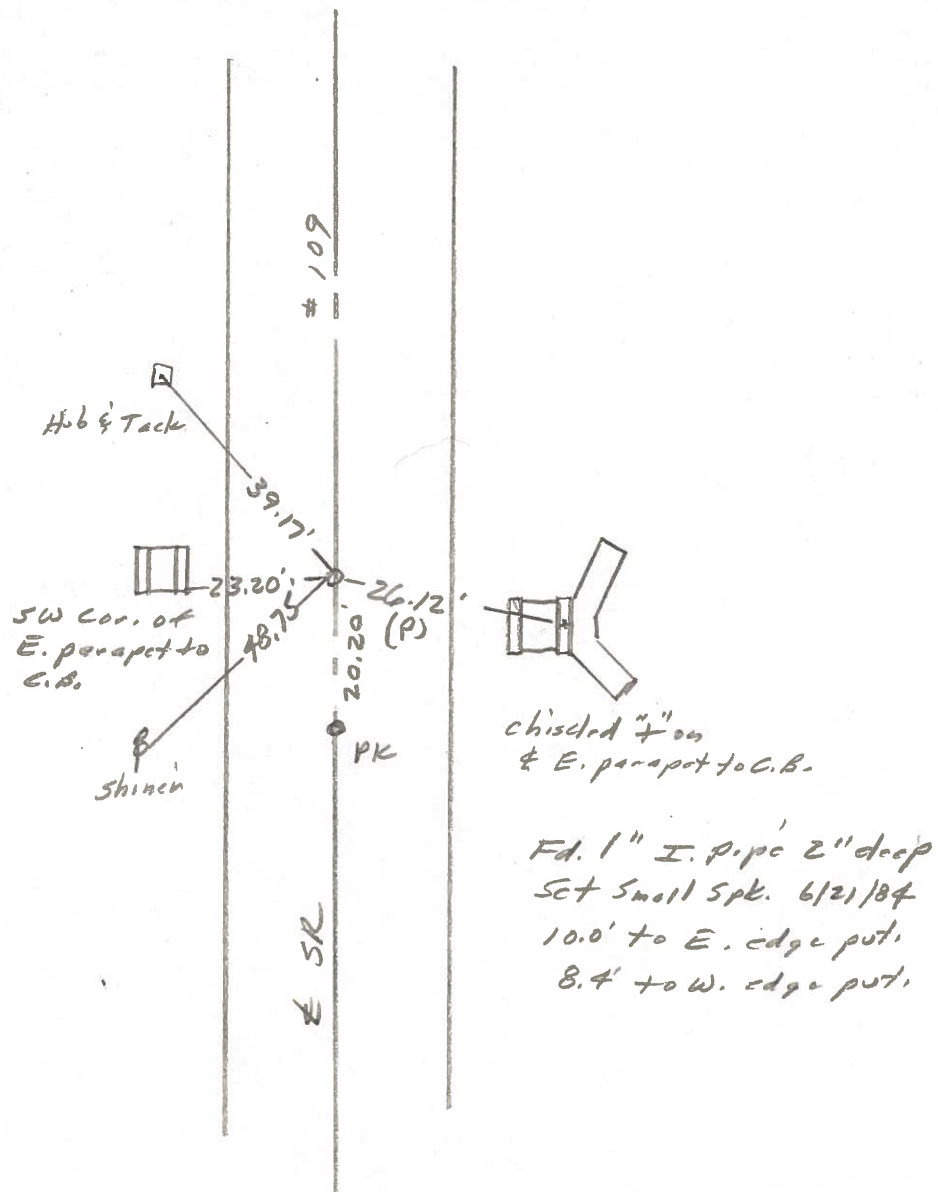

PERSONNEL Red Beach TITLE Armbruster COUNTY Fulton DATE 1963
Knope Mahler S. R. 109 WEATHER _____
 SEC. 14.89-18.02 TEMP. _____

DESCRIPTION ALIGNMENT & PROPERTY LINES JOB NO. _____

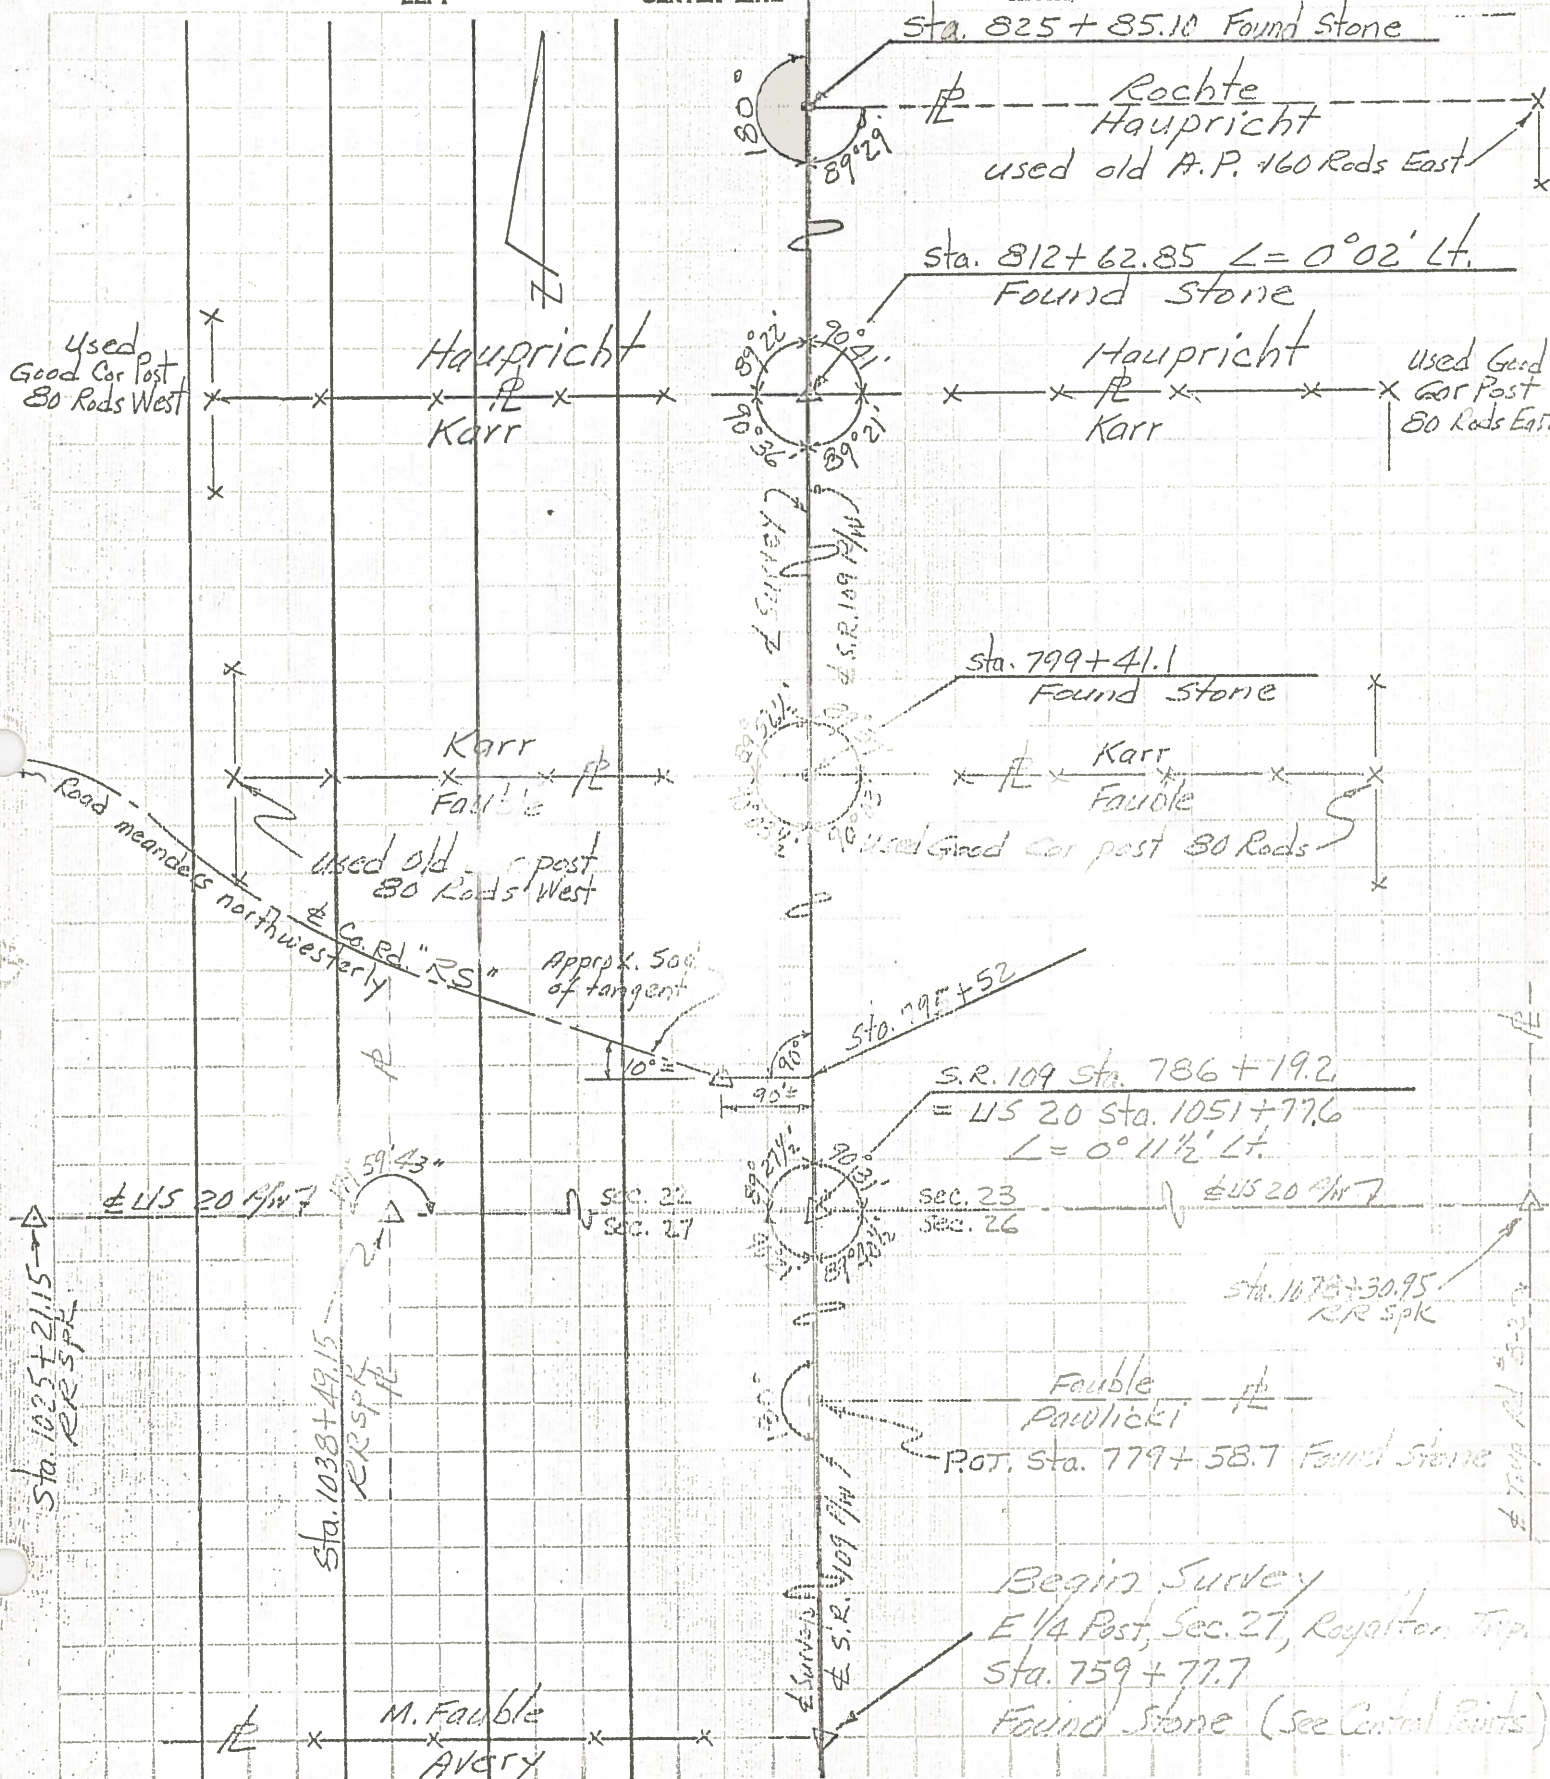

PERSONNEL TITLE PERSONNEL TITLE

COUNTY Fulton DATE Dec 1962S. R. 109 WEATHERSEC. 14.89-18.02 TEMP.

DESCRIPTION

CONTROL

POINTS

JOB NO.

LEFT

CENTER LINE

RIGHT

