


O.D.O.T. DISTRICT 2 SURVEY OFFICE (USE ONLY)


PERSONNEL	REFERENCE NO.	<u>6</u>	SHEET	<u>13</u>	OF	<u>50</u>
NOTES	NIESE	DATE	<u>4/27/22</u>	ROUTE	<u>SR 120</u>	
H.C.	O'DONNELL	WEATHER	<u>WINDY</u>	COUNTY	<u>FULTON</u>	
R.C.	PARADYSZ	TEMP.	<u>42°</u>	TOWNSHIP	<u>ROYALTON</u>	
	AUBLE			SECTION	<u>7</u>	
DWG BY	<u>RHOADES</u>	PID	<u>99582</u>	T <u>9</u> N R <u>3</u> E		

TYPE MONUMENT MAG/WASHER
ON SURFACE - ~~BELOW~~ ON
OFFSET Q PAVEMENT 0.4' LT : RT
10.3' TO LT EDGE PAVEMENT
STATION: 174+73

HORZ. DATUM: NAD83 2011 GEOID: NAVD88 2012A
GRID: NORTHING: 744417.613 EASTING: 1527654.291

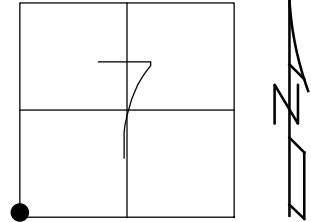

RECORD: 1926 PLAN
STA. 174+73.15
FD IPIN
SET MAG/WASHER
12/22/03, DCH
FD MAG/WASHER
5/23/11, RJL
FD MAG/WASHER
REF6
5/7/19, JLL
9/23/20, JFO
2/26/21, JMR
SET MAG/WASHER
7/27/22, TDN

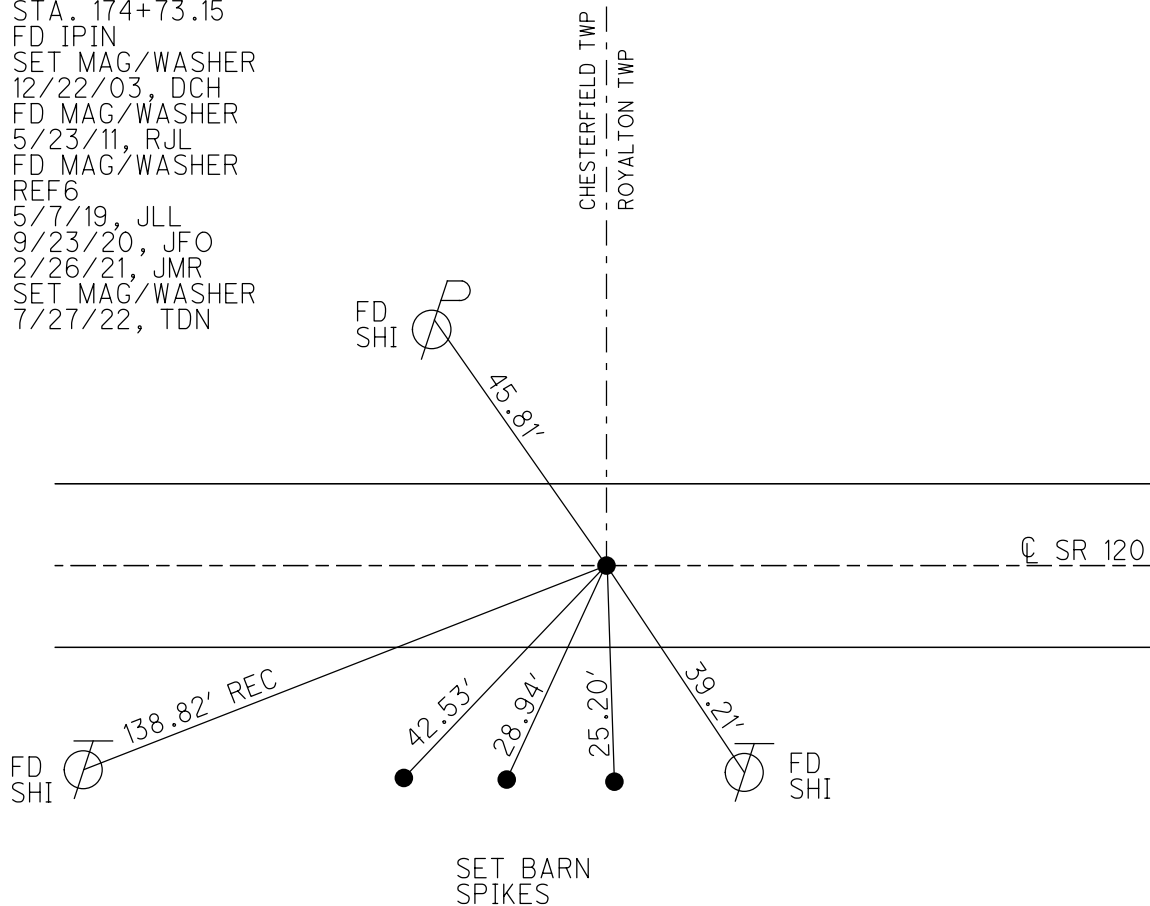


O.D.O.T. DISTRICT 2 SURVEY OFFICE (USE ONLY)


PERSONNEL _____ REFERENCE NO. 6 SHEET 12 OF 47
NOTES NIESE DATE 2/26/21 ROUTE SR 120
H.C. RHOADES WEATHER FAIR COUNTY FULTON
R.C. _____ TEMP. 30° TOWNSHIP ROYALTON
DWG BY NIESE PID PAVETRAIN SECTION 7
T 9 N R 3 E

TYPE MONUMENT MAG/WASHER
ON SURFACE - ~~BELOW~~ ON
OFFSET CL PAVEMENT 0.4' ~~LT~~ : RT
10.3' TO LT EDGE PAVEMENT
STATION: 174+73

HORZ. DATUM: NAD83 2011 GEOID: NAVD88 2012A
GRID: NORTHING: 744417.599 EASTING: 1527654.290

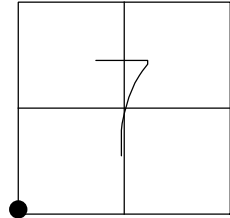

RECORD: 1926 PLAN
FD IPIN
STA. 174+73.15
SET MAG/WASHER
12/22/03, DCH
FD MAG/WASHER
5/23/11, RJL
FD MAG/WASHER
REF6
9/23/20, JFO
2/26/21, JMR

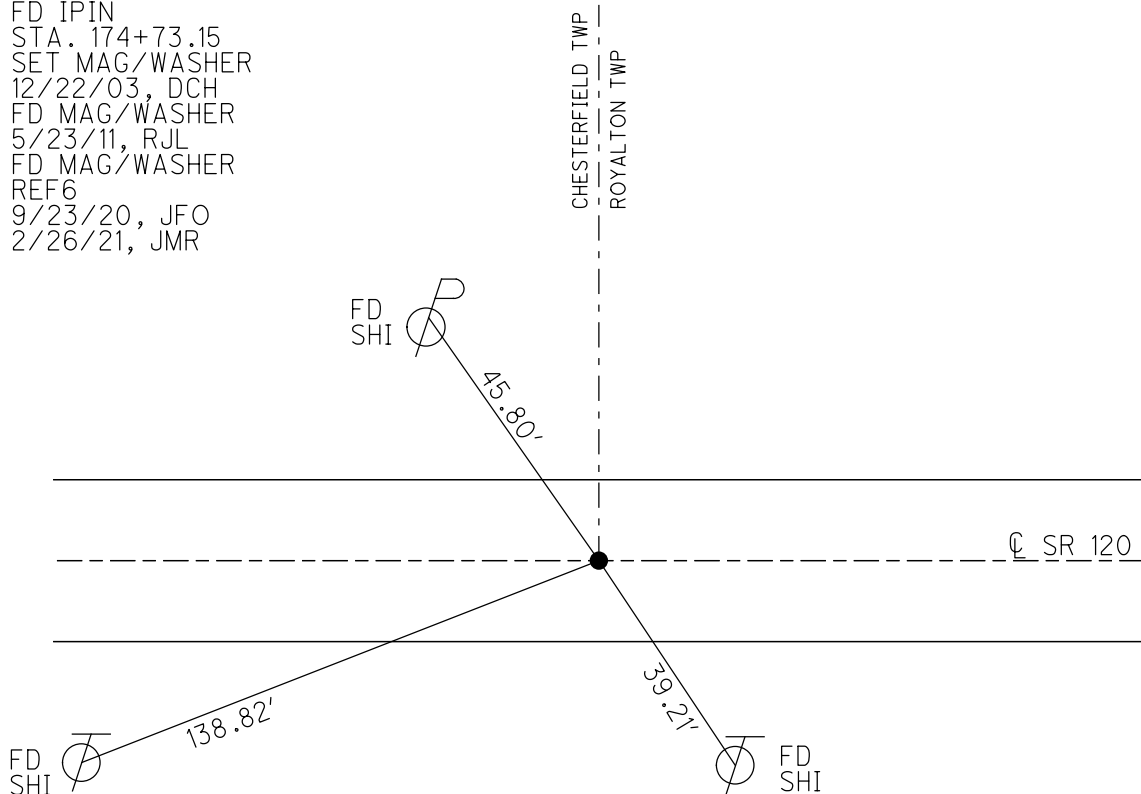


O.D.O.T. DISTRICT 2 SURVEY OFFICE (USE ONLY)


PERSONNEL	REFERENCE NO.	<u>6</u>	SHEET	<u>12</u>	OF	<u>47</u>
NOTES	<u>RHOADES</u>	DATE	<u>9/23/20</u>	ROUTE	<u>SR 120</u>	
H.C.	<u>O'DONNELL</u>	WEATHER	<u>SUNNY</u>	COUNTY	<u>FULTON</u>	
R.C.	<u>AUBLE</u>	TEMP.	<u>52°</u>	TOWNSHIP	<u>ROYALTON</u>	
				SECTION	<u>7</u>	
DWG BY	<u>RHOADES</u>	PID	<u>PAVETRAIN</u>	T <u>9</u> N R <u>3</u> E		

TYPE MONUMENT MAG/WASHER
ON SURFACE - ~~BELOW~~ ON
OFFSET CL PAVEMENT 0.4' ~~LT~~ : RT
10.3' TO LT EDGE PAVEMENT
STATION: 174+73

HORZ. DATUM: NAD83 2011 GEOID: NAVD88 2012A
GRID: NORTHING: 744417.599 EASTING: 1527654.290

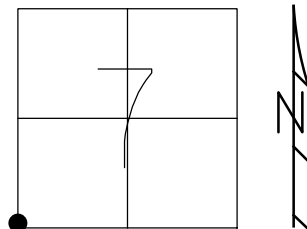

RECORD: 1926 PLAN
FD IPIN
STA. 174+73.15
SET MAG/WASHER
12/22/03, DCH
FD MAG/WASHER
5/23/11, RJL
FD MAG/WASHER
REF6
9/23/20, JFO

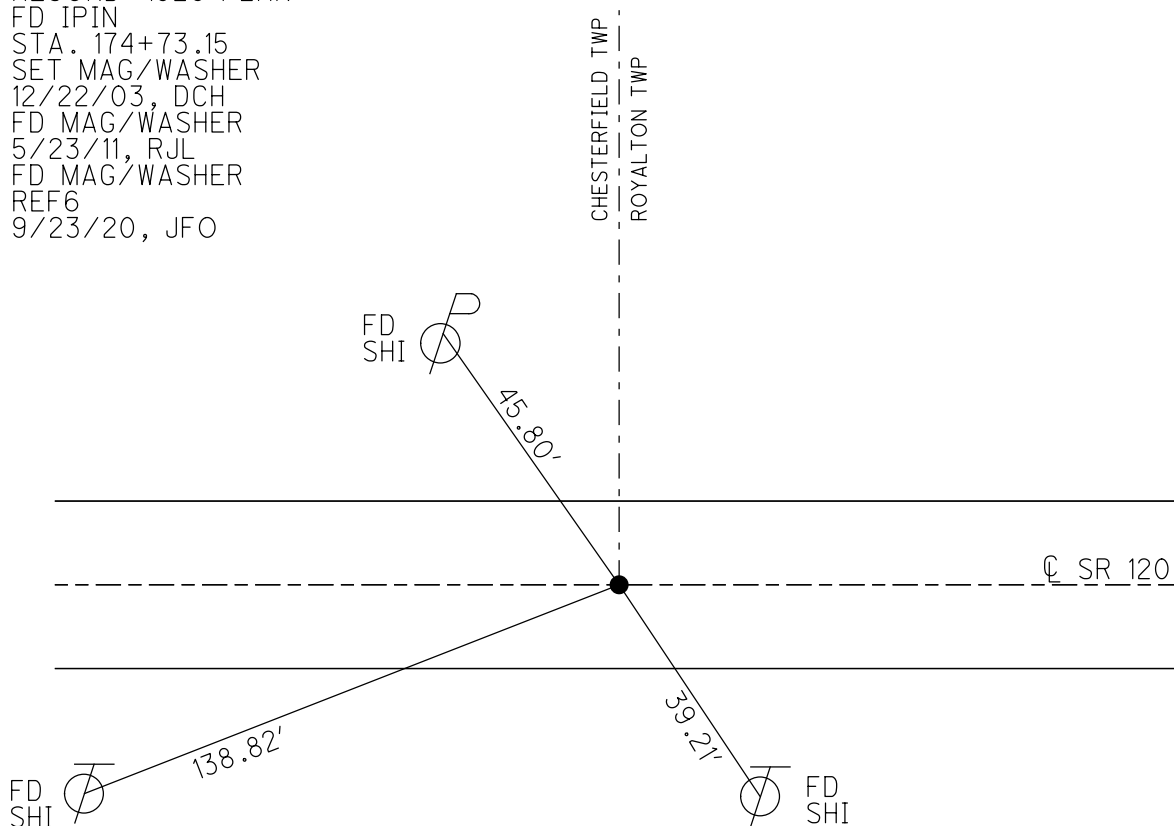

O.D.O.T. DISTRICT 2 SURVEY OFFICE

PERSONNEL

REFERENCE NO. 6

SHEET 12 OF 45

NOTES FINGER

DATE 5/23/11

ROUTE SR 120

H.C. LUMBREZER

WEATHER SUNNY

COUNTY FULTON

R.C. MOSER

TEMP. 70°

TOWNSHIP ROYALTON

SECTION 7,12,13,18

T 9 N R 3 E

TYPE MONUMENT MAG NAIL/WASHER

ON SURFACE - ~~BELOW~~ ON


~~LEFT~~ - Q PAV'T - RIGHT 0.4'

10.3' TO LT EDGE PAVEMENT

S.L.M. 174+73

Grid: Northing: 744417.575 Easting: 1527654.220

12	7
13	18

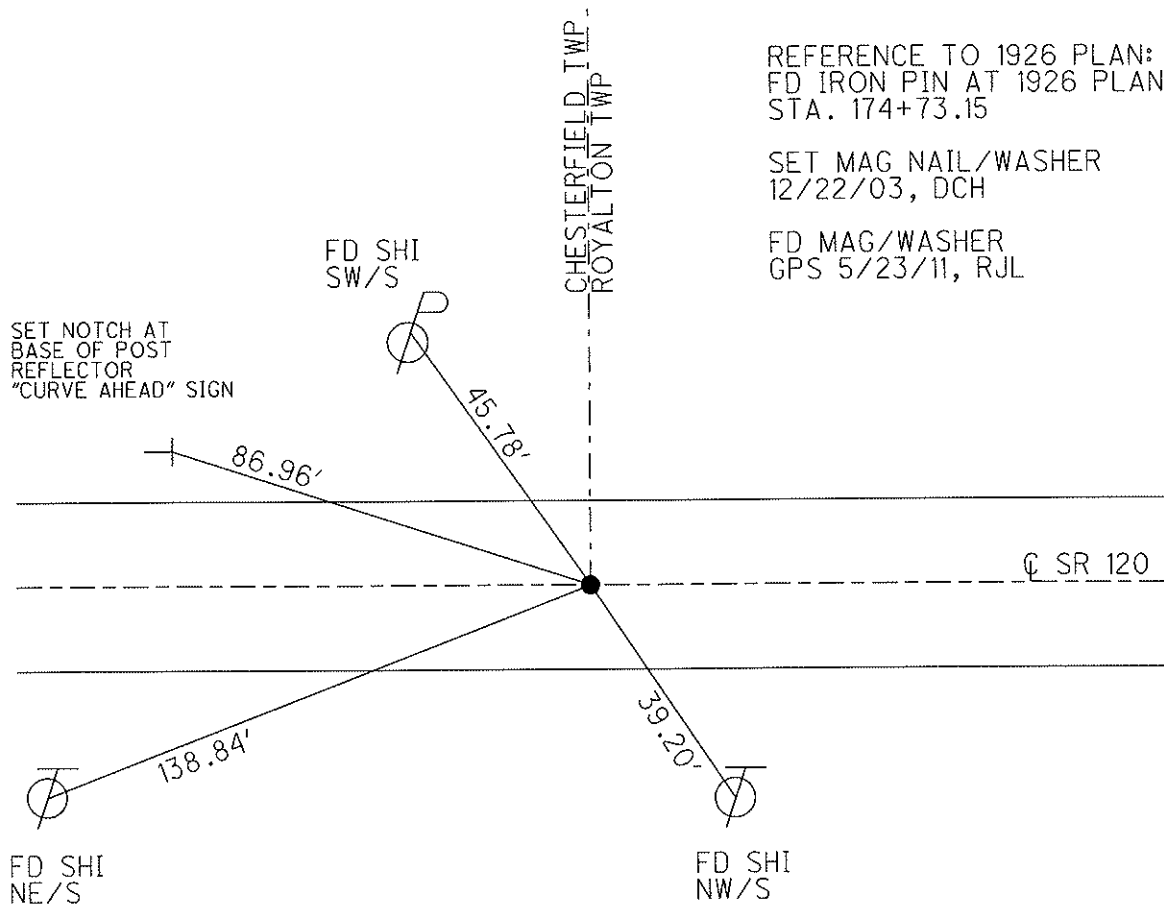

O.D.O.T. DISTRICT 2 SURVEY OFFICE

PERSONNEL

REFERENCE NO. 6

SHEET 10 OF 12

NOTES HOMAN

DATE 12-22-03

ROUTE SR 120

H.C. HOMAN

WEATHER CLOUDY

COUNTY FULTON

R.C. BALLMER

TEMP. 39°

TOWNSHIP ROYALTON

SECTION 12, 7, 13, 18

T 9 S R 3 E

TYPE MONUMENT 1" IRON PIN

~~ON SURFACE~~ - BELOW 6 1/2"

~~LEFT - & PAVT - RIGHT~~ ON

TO EDGE PAVEMENT

S.L.M. 174+73


12	7
13	18



Reference to 1926 PLAN

FD. IRON PIN at 1926 PLAN station 174+73.15

SET MAG NAIL
& WASHER
12-22-03
DCH

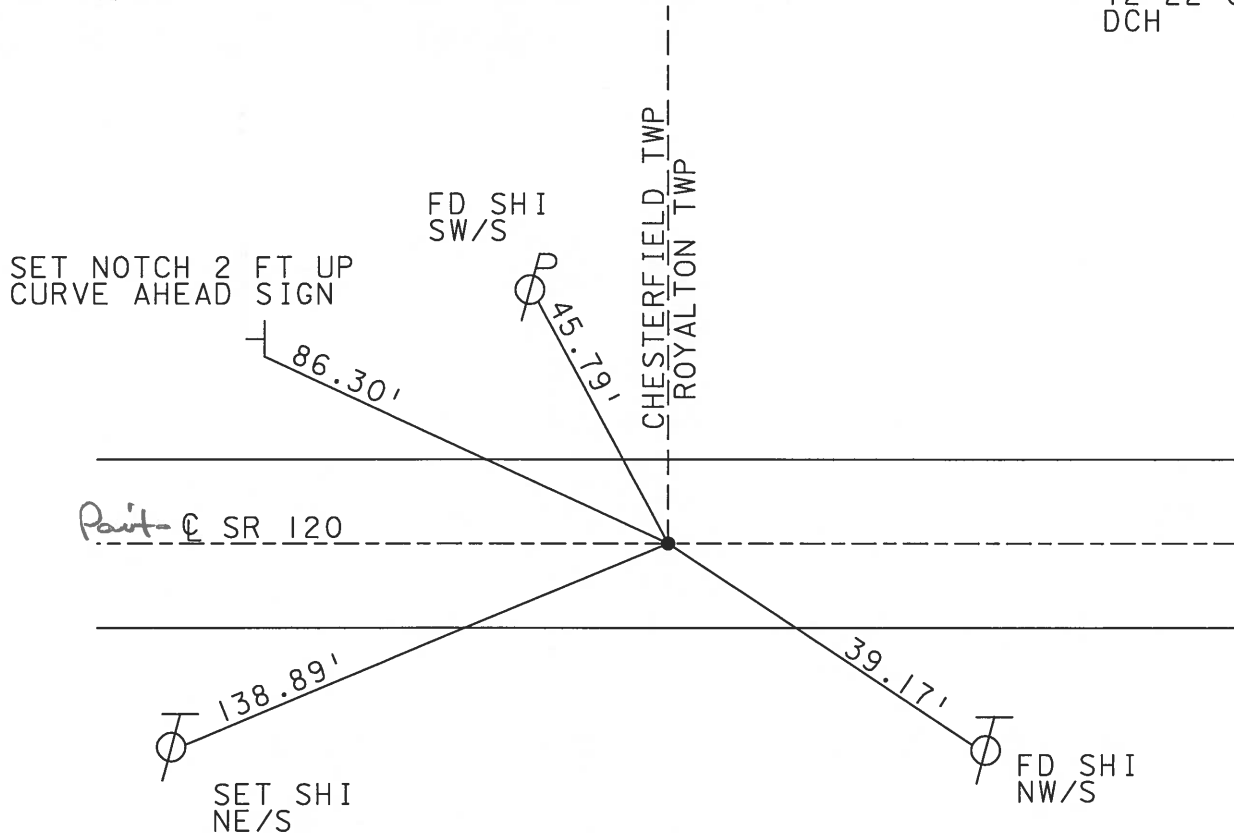

O.D.O.T. DISTRICT 2 SURVEY OFFICE

PERSONNEL

REFERENCE NO. 6

SHEET 8 OF

NOTES 1. Stone

H.C. D. Curtis

R.C. J. Householder

DATE 12 June 90

WEATHER Cloudy

TEMP. 68°

ROUTE SR#120

COUNTY Fulton

TOWNSHIP Royalton

SECTION 12-7-13-18

T R

TYPE MONUMENT PK Nail

ON SURFACE - BELOW Surface

LEFT- & PAV'T. - RIGHT


 TO EDGE PAVEMENT

S.L.M. 174+72

12	7
13	18



Set PK Nail 8-8-90 IRS

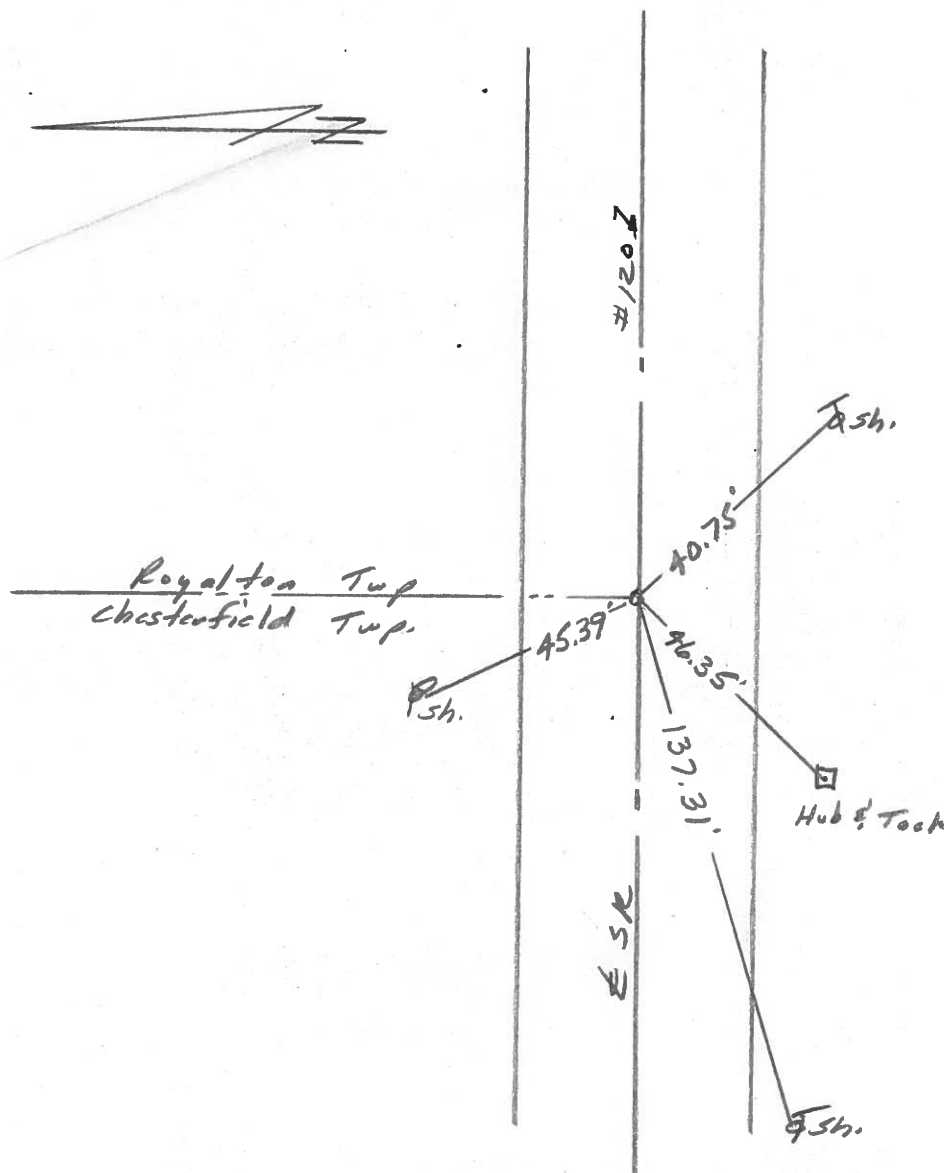

SHEET 8 OF 20

Date 29 Aug. 83

Weather Warm

Temp. 83

12	7
13	18

N
A

12


7

13

18

SLM STA. 174+83

REF. NO. 6

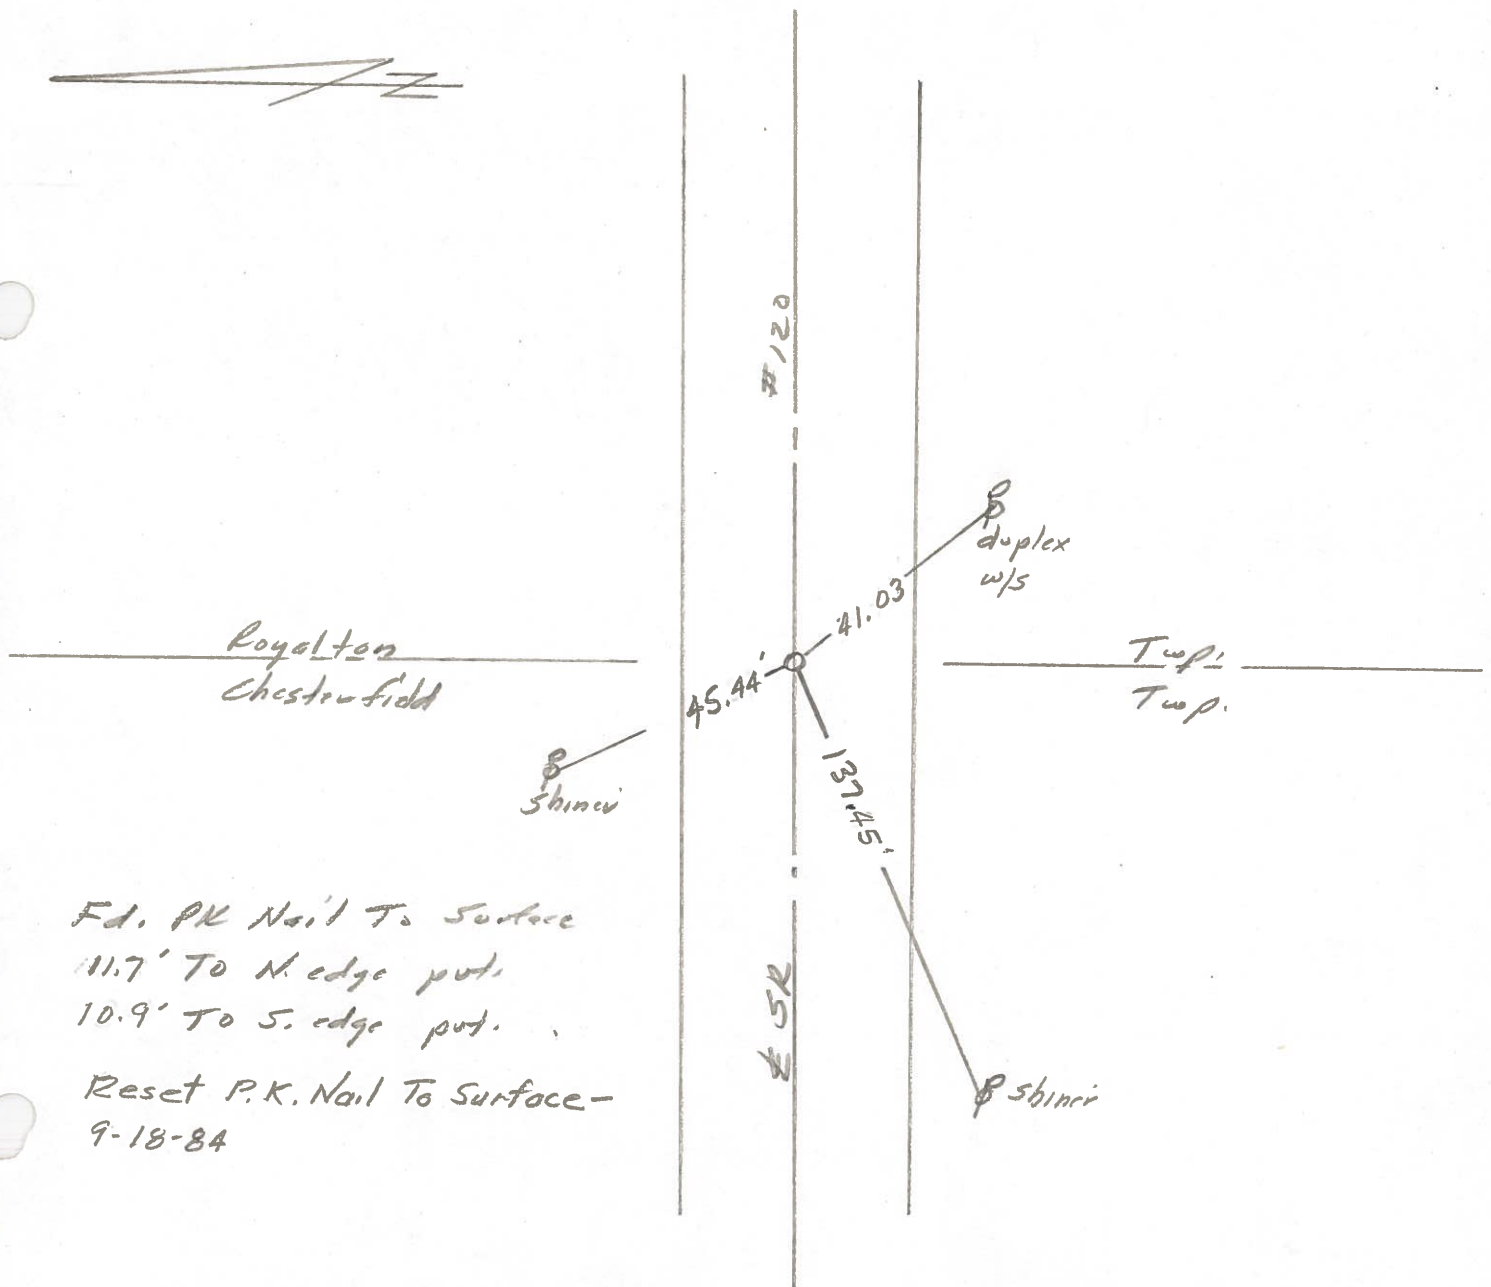

PERSONNEL	TITLE	PERSONNEL	TITLE	COUNTY	DATE	WEATHER
TOMASIC				Fulton	JUNE 28, 1973	
GRANATA				S. R. 120		
NALLYO				SEC. Chesterfield Twp		

DESCRIPTION	LEFT	CENTER LINE	RIGHT	JOB NO.
-------------	------	-------------	-------	---------

