

O.D.O.T. DISTRICT 2 SURVEY OFFICE (USE ONLY)

PERSONNEL

REFERENCE NO. 39 D

SHEET 4 OF 14

NOTES NIESE

DATE 4-23-21

ROUTE US 20 A

H.C. AUBLE

WEATHER WINDY

COUNTY FULTON

R.C. NIESE

TEMP. 50°

TOWNSHIP YORK

SECTION 13

DWG BY AUBLE

PID 101295

T 7 N R 7 E

TYPE MONUMENT MAG NAIL

ON SURFACE - ~~BELOW~~ ON

OFFSET \varnothing PAVEMENT 1.4' LT : ~~RT~~

- TO - EDGE PAVEMENT


STATION: 1034+81

HORZ. DATUM: NAD83(2011)


GEOID: 12A

GRID: NORTHING: 698397.399

EASTING: 1555749.754

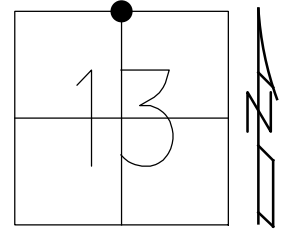

RECORD:
 SET MAG/WASHER
 12/29/03, RGN
 FD MAG NAIL
 REFD39
 1-21-20, JLL
 SET MAG/WASHER
 10-7-21, DSA

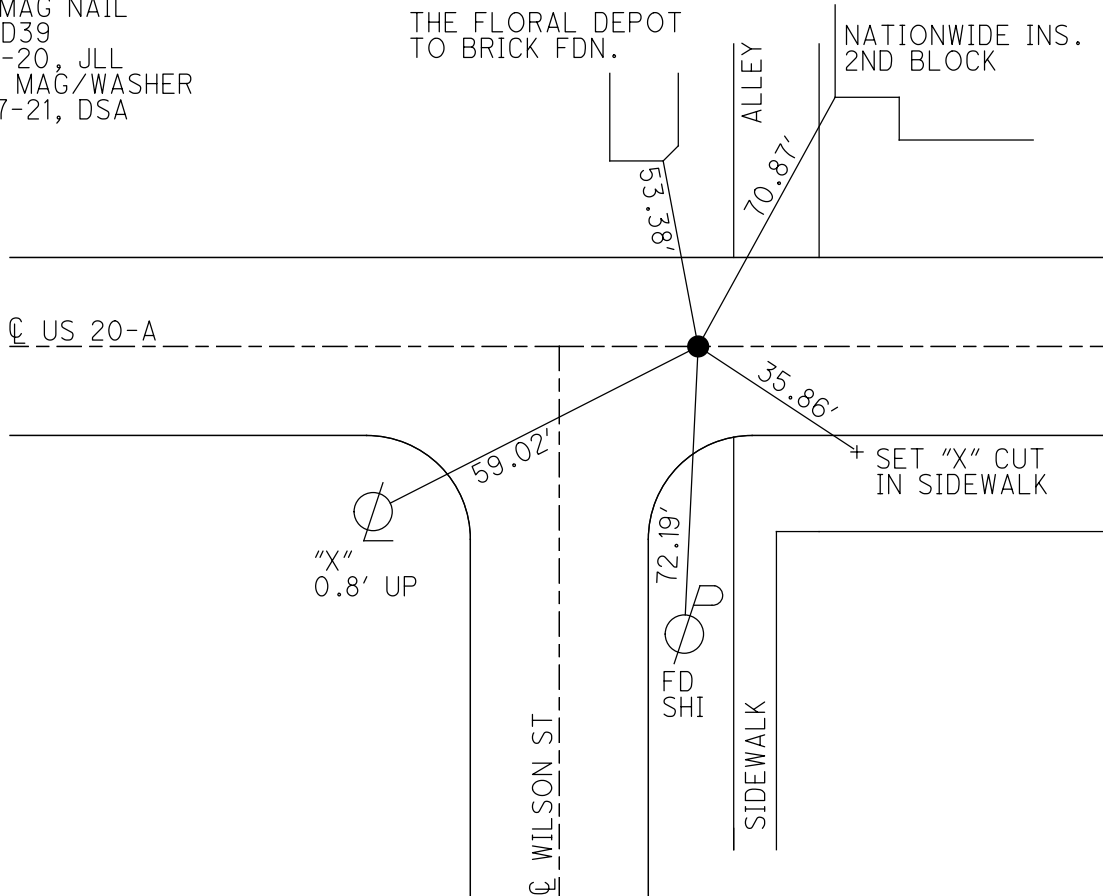

O.D.O.T. DISTRICT 2 SURVEY OFFICE (USE ONLY)

PERSONNEL

REFERENCE NO. 39 D

SHEET 4 OF 14

NOTES CANTERBURY

DATE 8/14/03

ROUTE US 20 A

H.C. NUHFER

WEATHER SUNNY

COUNTY FULTON

R.C. ZEBROWSKI

TEMP. 80°

TOWNSHIP YORK

SECTION 13

DWG BY NIESE PID

T 7 N R 7 E

TYPE MONUMENT SMALL RAILROAD SPIKE

ON SURFACE - BELOW ON


OFFSET C PAVEMENT 0.4' LT: RT

- TO - EDGE PAVEMENT


STATION: 1034+81

HORZ. DATUM: - GEOID: -

GRID: NORTHING: - EASTING: -

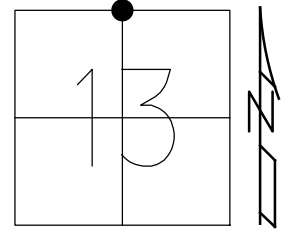

RECORD:
SET MAG/WASHER
12/29/03, RGN

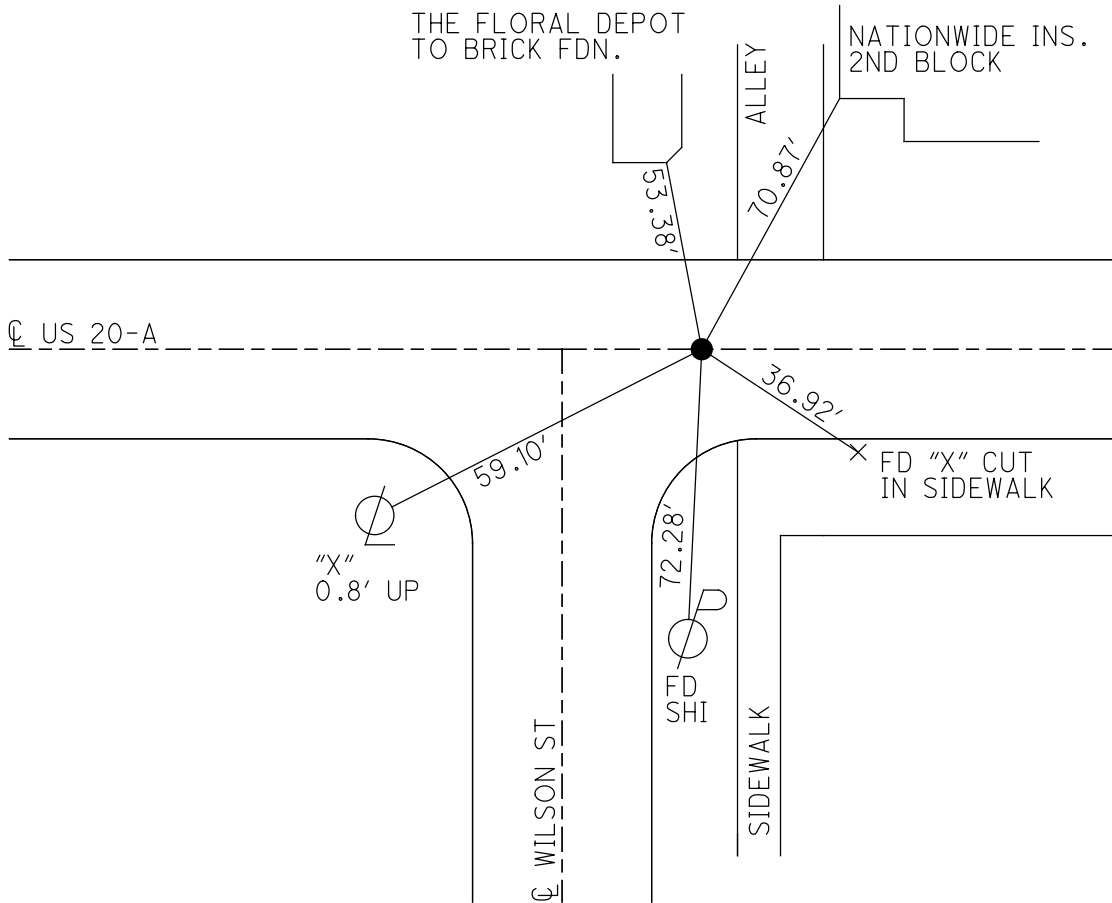

O.D.O.T. DISTRICT 2 SURVEY OFFICE

PERSONNEL _____

REFERENCE NO. 39-D

SHEET 5 OF 11

NOTES CANTERBURY

H.C. NUMBER

R.C. ZEBROWSKI

DATE 8-14-03

WEATHER SUNNY

TEMP. +80°

ROUTE U.S. 20-A

COUNTY Fulton

TOWNSHIP York

SECTION 13

T. 7 N. R. 7 E.


TYPE MONUMENT SMALL RAILROAD SPIKE

ON SURFACE - BELOW SURFACE


LEFT - 0.4' RIGHT 0.4'

TO EDGE PAVEMENT

S.L.M. 1034181

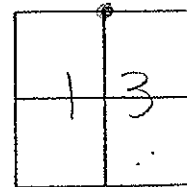

SET MAGNAIL/WASHER
12-29-03

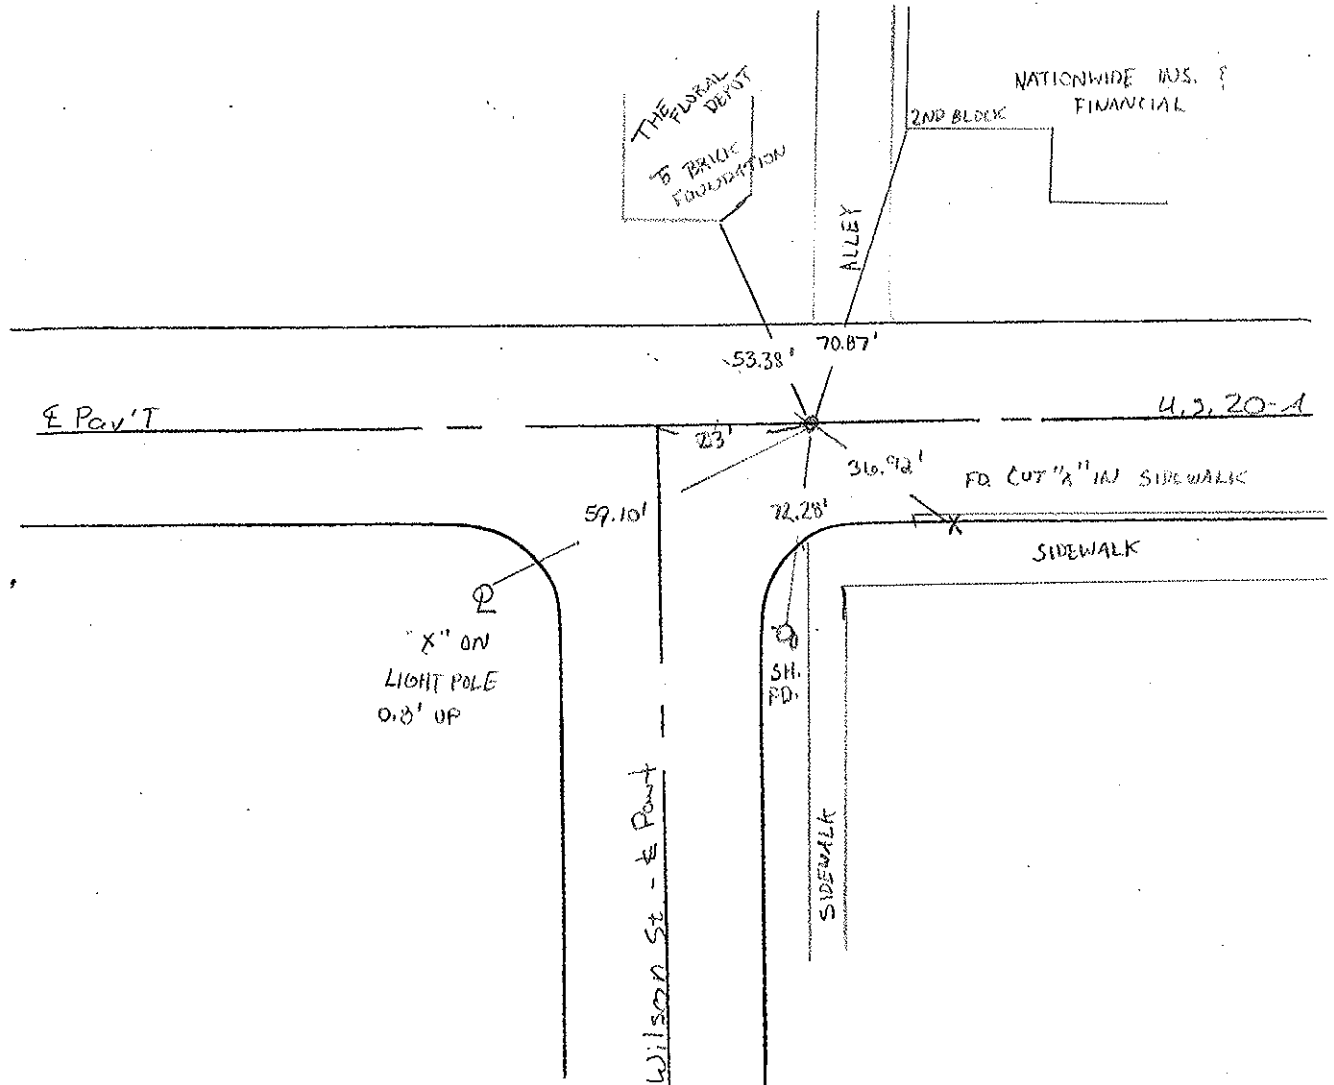

O.D.O.T. DISTRICT 2 SURVEY OFFICE

PERSONNEL

REFERENCE NO. 39-D

SHEET 19 OF 24

NOTES 1. Stone

H.C. D. Curtis

DATE 17 Sept. 86

ROUTE US #20-A

R.C. J. Householder

WEATHER Cool

COUNTY Fulton

TEMP. 60°

TOWNSHIP York

SECTION 13

T R


TYPE MONUMENT 1" I. rod

ON SURFACE - BELOW 4" deep


LEFT- & PAV'T. - RIGHT

 TO EDGE PAVEMENT

S.L.M. 1034+81

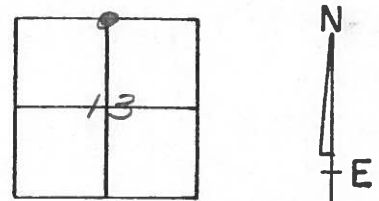

SET SM. R.R. SPK. TO SURFACE
5-13-88

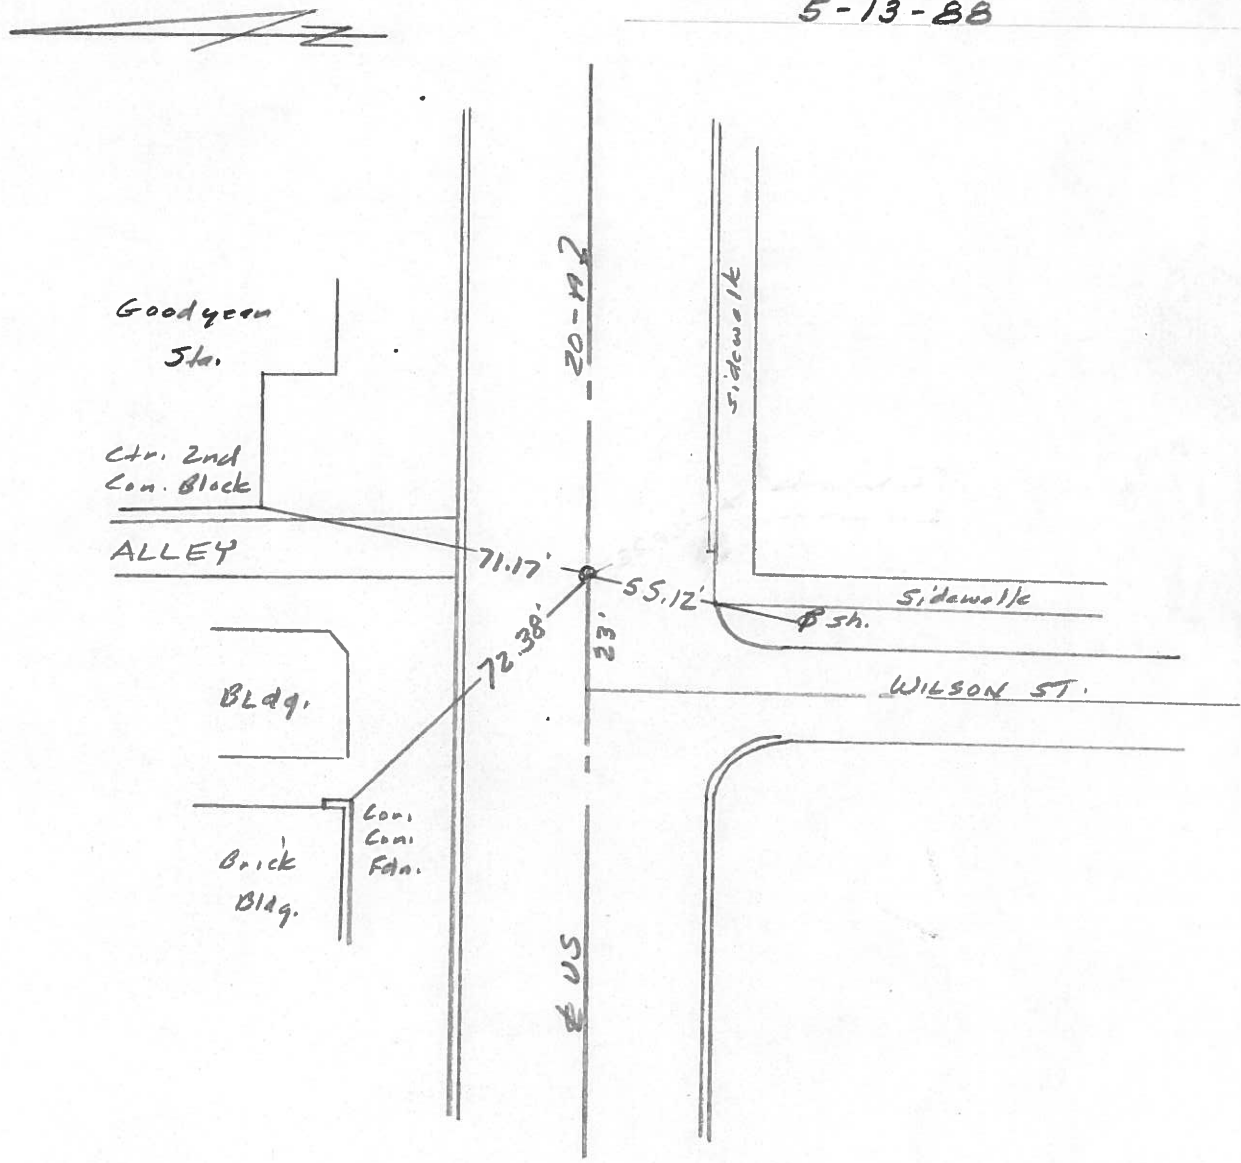

PERSONNEL	TITLE	PERSONNEL	TITLE
W. Denno		D. GRANATA	
D. Curtis		P. NEUSER	
J. Miller		A. VANYO	

COUNTY Fulton DATE June 9, 1971

S. R. 20-A WEATHER Sunny, Mild

SEC. _____ TEMP. 75°

DESCRIPTION References to control points JOB NO. _____

