

O.D.O.T. DISTRICT 2 SURVEY OFFICE (USE ONLY)

PERSONNEL

REFERENCE NO. 4

SHEET OF

NOTES RHODES

DATE 7/7/21

ROUTE US 6

H.C. AUBLE

WEATHER FAIR

COUNTY HENRY

R.C. NIESE

TEMP. 77°

TOWNSHIP RIDGEVILLE

SECTION 32

DWG BY BARRIERE

PID 101274

T 6 N R 5 E

TYPE MONUMENT MONBOX W/ 1" IPIN

ON SURFACE - BELOW ON

OFFSET $\mathcal{C}$ PAVEMENT ON LT : RT

 TO EDGE PAVEMENT

STATION: 72+67

HORZ.DATUM: NAD83 2011


GEOID: 18

GRID: NORTHING: 652033.630

EASTING: 1470833.475


LDP: NORTHING:

EASTING:

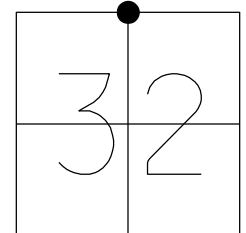

RECORD: P.I.
STA 72+63.84
FD SM R.R. SPIKE
4/14/97, BWC
SET P.K./WASHER
6/26/97, BWC
FD MAG SPIKE
REF4
7/7/21, DSA
FD MONBOX W/ 1" IPIN
NEWREF4
12/12/22, TDN

$\mathcal{C}$ US 6

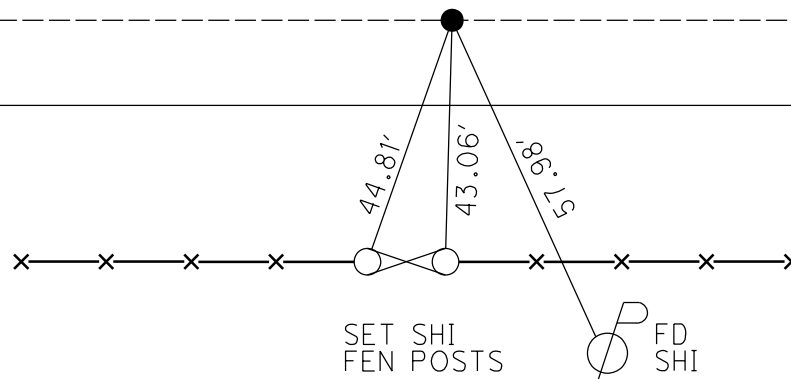

O.D.O.T. DISTRICT 2 SURVEY OFFICE (USE ONLY)

PERSONNEL

REFERENCE NO. 4

SHEET 5 OF 7

NOTES CORDES

DATE 4/14/97

ROUTE US 6

H.C. LOEHRKE

WEATHER SUN

COUNTY HENRY

R.C. MOSER
HUSS

TEMP. 32°

TOWNSHIP RIDGEVILLE

DWG BY NIESE

PID _____

SECTION 32

T 6 N R 5 E

TYPE MONUMENT SM.R.R.SPIKE

ON SURFACE - ~~BELOW~~ ON

OFFSET CL PAVEMENT ON LT : RT

12.3' TO RT EDGE PAVEMENT


STATION: 72+67

HORZ.DATUM: _____

GEOID: _____


GRID: NORTHING: _____

EASTING: _____

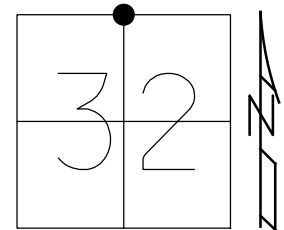

RECORD: P.I.
STA 72+63.84
FD SM R.R. SPIKE
4/14/97, BWC
SET P.K./WASHER
6/26/97, BWC

CL US 6

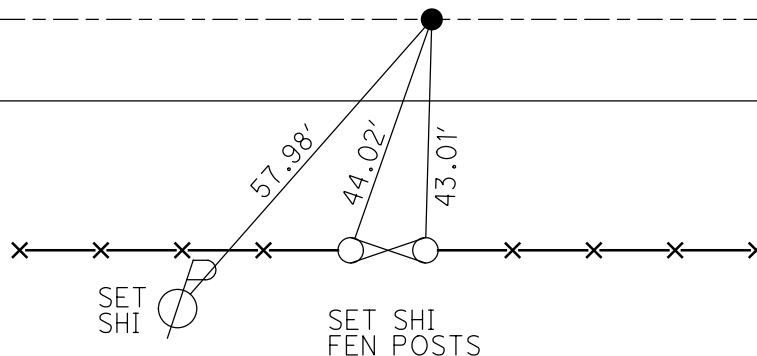

O.D.O.T. DISTRICT 2 SURVEY OFFICE

PERSONNEL

REFERENCE NO. 4

SHEET 4 OF 7

NOTES CORDS

H.C. LOENKE

R.C. MOSEK

A HUSS

DATE 4-14-97

WEATHER SUN

TEMP. +4°C

ROUTE 6

COUNTY HENRY

TOWNSHIP RIDGEMINE

SECTION 29

T. 6 N. R. 5 E.


TYPE MONUMENT SM IR SPIKE

ON SURFACE - ~~DEMON~~ YES

~~PAV'T.~~ PAV'T. YES


3.75m TO RT EDGE PAVEMENT

S.L.M. 2+215

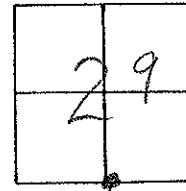

REC PI
STA: 72+63.84

SET PK &
WASHER
6-26-97
BWC

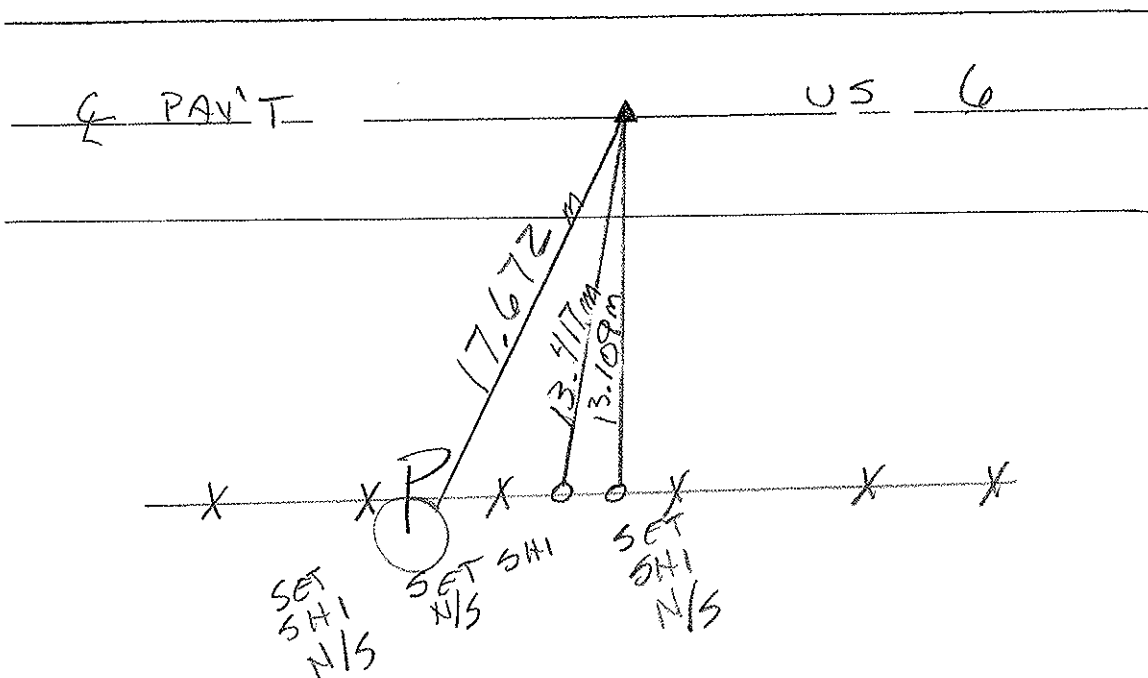

O.D.O.T. DISTRICT 2 SURVEY OFFICE

PERSONNEL

REFERENCE NO. 4

SHEET OF

NOTES HOFFMAN

H.C. LOEHKE

R.C. BARNHISEL

DATE 5-17-85

WEATHER cloudy

TEMP. 60°

ROUTE U.S. 6

COUNTY HENRY

TOWNSHIP RIDGEVILLE

SECTION 29

T 6 N R 5 E


TYPE MONUMENT R.R. SPIKE Set small RR. spike

~~ON SURFACE~~ - BELOW 1 1/2" 6-13-85 SURV

LEFT- & PAW'T. - RIGHT ON R


12.0 TO RT EDGE PAVEMENT

S.L.M. 72+63

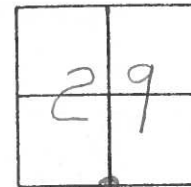

P.I. STA 72+63.84

R. R. RT & R/W U.S. 6

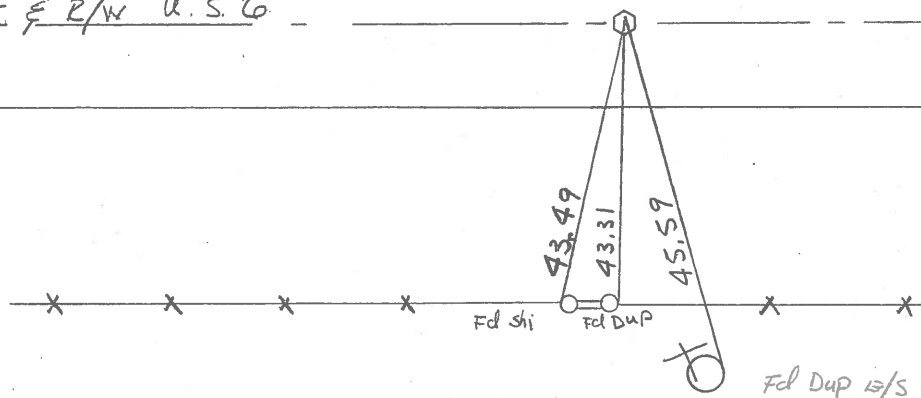

PERSONNEL TITLE PERSONNEL TITLE

COUNTY HenryDATE 12-13-60

Hoover

Ruffer

Delventhal

Young

Mohler

S. R. 6WEATHER Cloudy

SEC.

TEMP. 15°


DESCRIPTION

LEFT

CENTER LINE


RIGHT

③

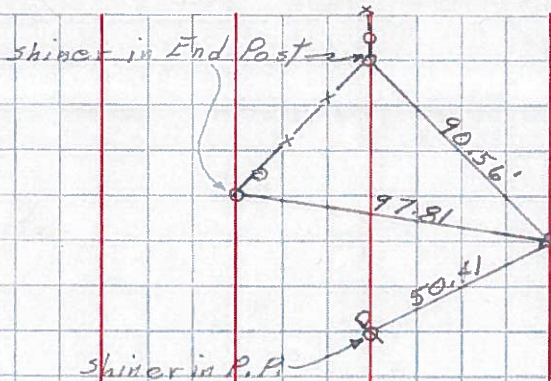

Sta. 46+19.55 ✓
 Found R.R. Spk.
 Int. Twp. Rd. 24

④

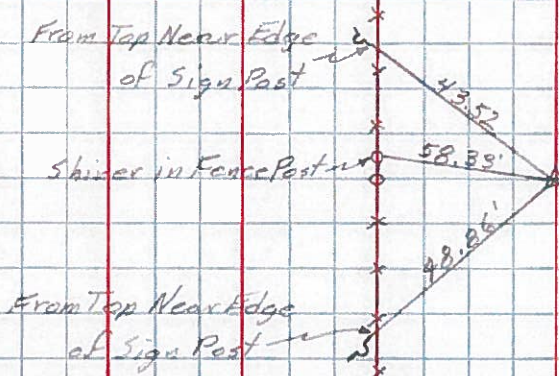

Sta. 72+63.84
 Found R.R. Spk.

PERSONNEL	TITLE	PERSONNEL	TITLE	COUNTY	DATE
				Henry	Jan 1951
				S. R. #384	WEATHER
				SEC.	TEMP.
DESCRIPTION	LEFT	CENTER LINE	RIGHT	JOB NO.	


10/9/56

WILLIAMS-HENRY Co Line

Sta 701+20.00 = Sta. 0+00

Found Stone Sta 701+20.00

Established Tacked Hub 20.94 North

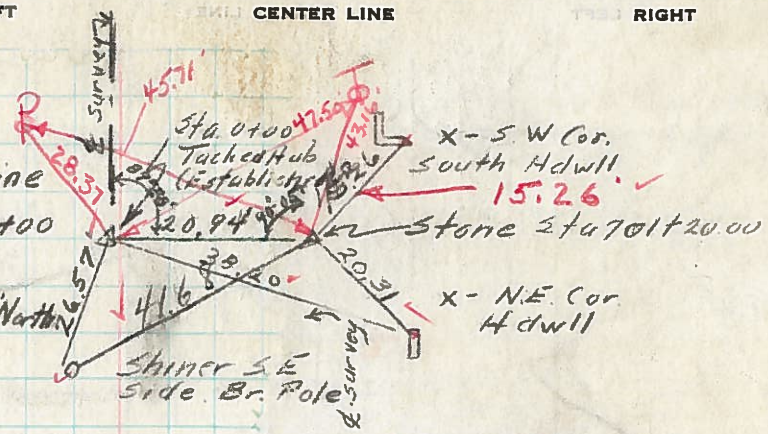


Recorded
Mon. book
He. Co.

10/9/56

Sta. 19+87.65

L = 0° 00'

Found Stone

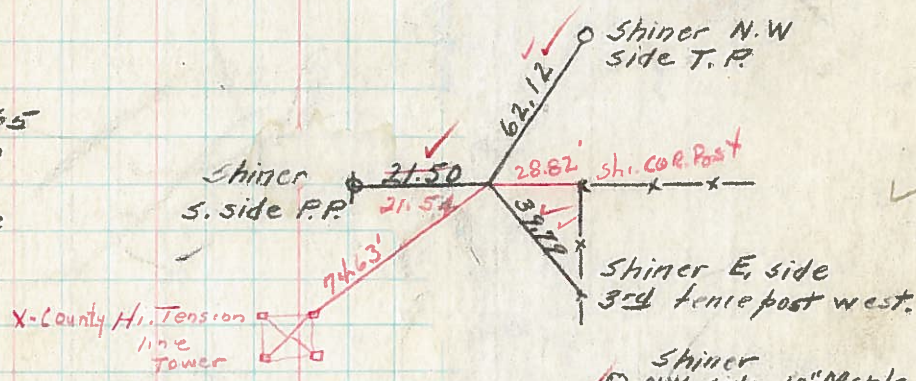


10/9/56

Sta. 46+19.55

L = 0° 10' Lt

Found I. P. over Stone

S.R. #384 & Twp. Rd #24

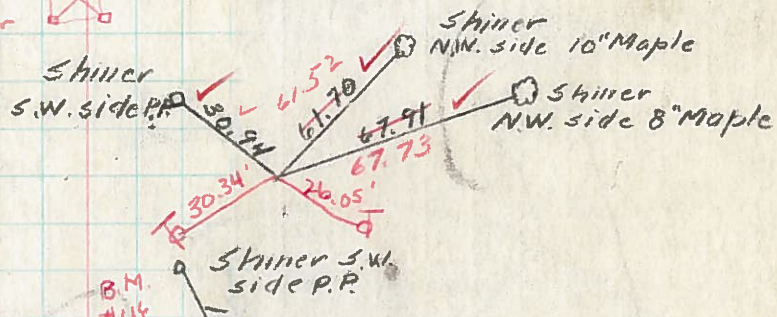


10/9/56

Sta. 72+63.84

L = 0° 08' Lt.

Found Stone

Set R.R. Spk.

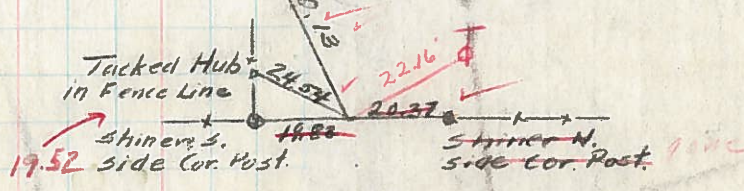

10/9/56

Sta. 99+17.62

L = 0° 8' Rt.

Established Tacked Hub.

Set R.R. Spk

S.R. #384 & S.R. #66

