

O.D.O.T. DISTRICT 2 SURVEY OFFICE (USE ONLY)

PERSONNEL

REFERENCE NO. 5

SHEET OF

NOTES RHODES

DATE 7/7/21

ROUTE US 6

H.C. AUBLE

WEATHER FAIR

COUNTY HENRY

R.C. NIESE

TEMP. 77°

TOWNSHIP RIDGEVILLE

DWG BY BARRIERE

PID 101274

SECTION 32

T 6 N R 5 E

TYPE MONUMENT MONBOX W/ 1" IPIN

ON SURFACE - BELOW ON

OFFSET Q PAVEMENT ON LT : RT

 TO EDGE PAVEMENT

STATION: 98+69.13

HORZ.DATUM: NAD83 2011

GEOID: 18


GRID: NORTHING: 651967.553

EASTING: 1473435.125


LDP: NORTHING:

EASTING:

29	28
32	33

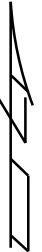

RECORD:
FD RR SPIKE 1 1/2"
BELOW SURFACE
10/22/84, SWH
SET PK/WASHER
6/13/85, SH
FD MAG/SPIKE
REF5
7/7/21, DSA
FD MONBOX W/ 1" IPIN
NEWREF5
12/12/22, TDN

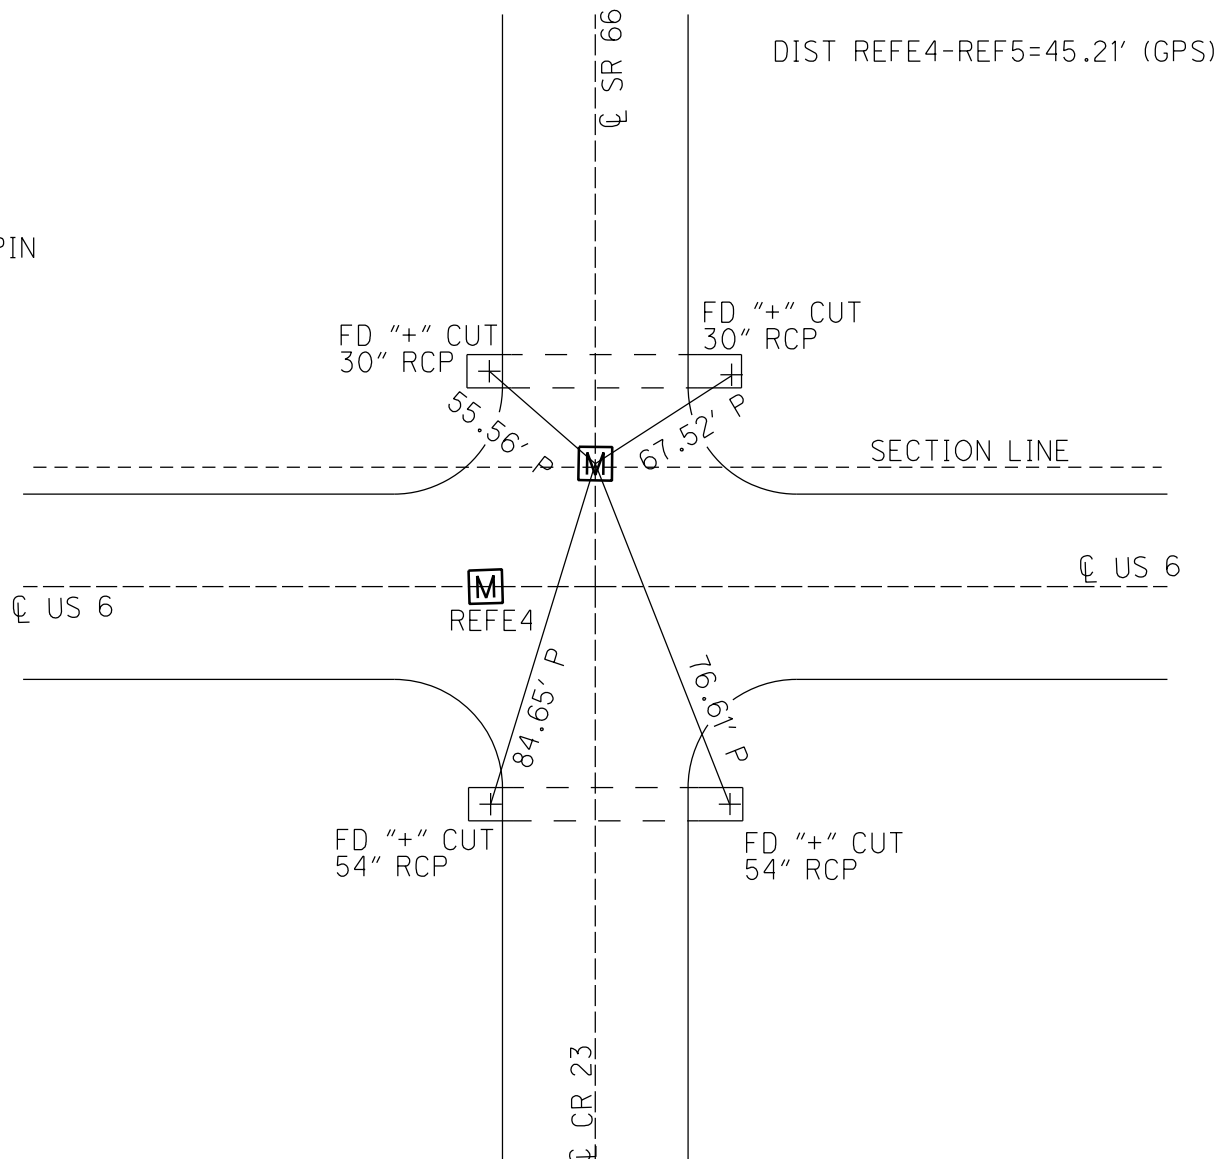

County HENRY S.R. 66Township BRIDGEVILLE

Section _____

T6N, R5E

Personnel LoftmanRef # 5 us 6 LOEMRE H.C.# 1 HOUSEHOLDER R.C.Date 7-6-84Weather P. CLEARTemp. 70°

29	28
32	33



Fd R.R. SPK 1 1/2" below surface
on E. part SR 66 North

SLM = 151+70


5.2' N. of N.E.P. of U.S. 6

SET SM. RR SPK.

10-22-84

S.W.H.

Set P.K./WASHER
6-13-85 SWH

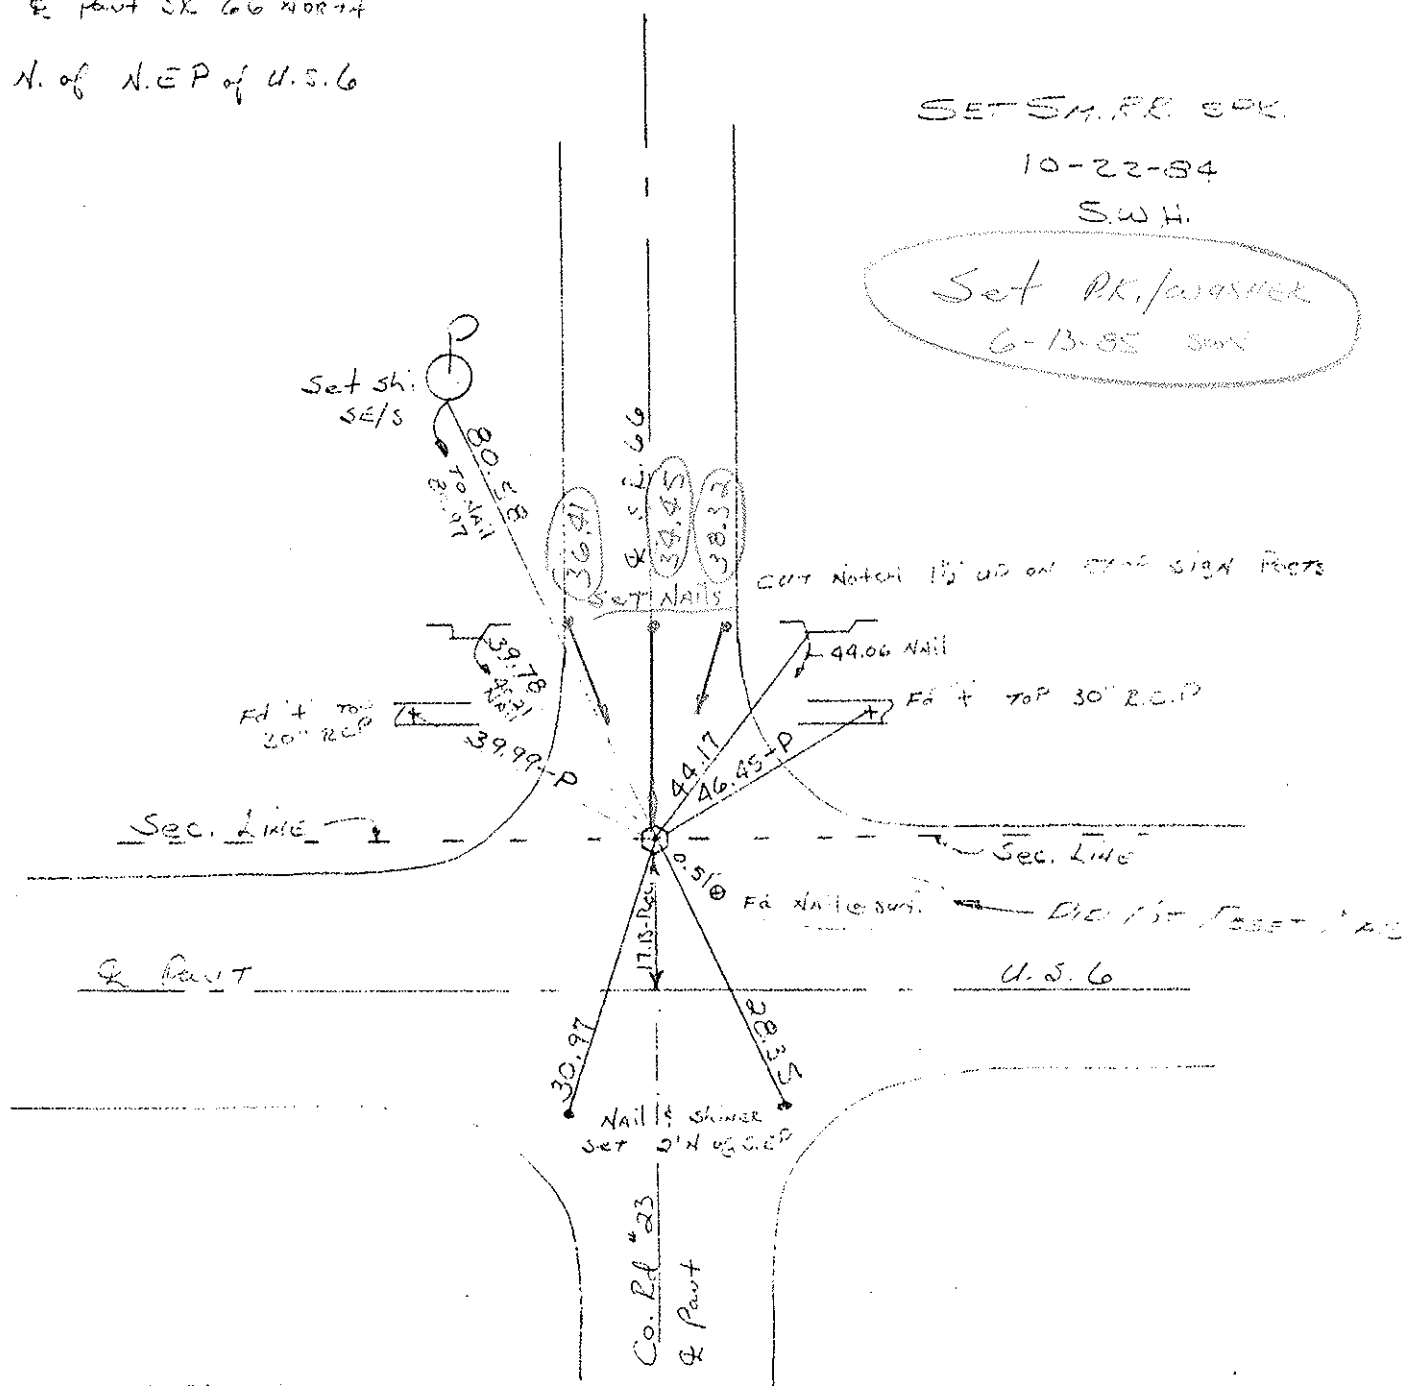

PERSONNEL TITLE PERSONNEL TITLE

Red Beach

W. Knappe

D. Boyle

J. Bagdonas

COUNTY HENRY

DATE 8 July 74

S. R. US 6

WEATHER

SEC. Ridgerville Twp.



TEMP

DESCRIPTION

CONTROL

POINTS

JOB NO.

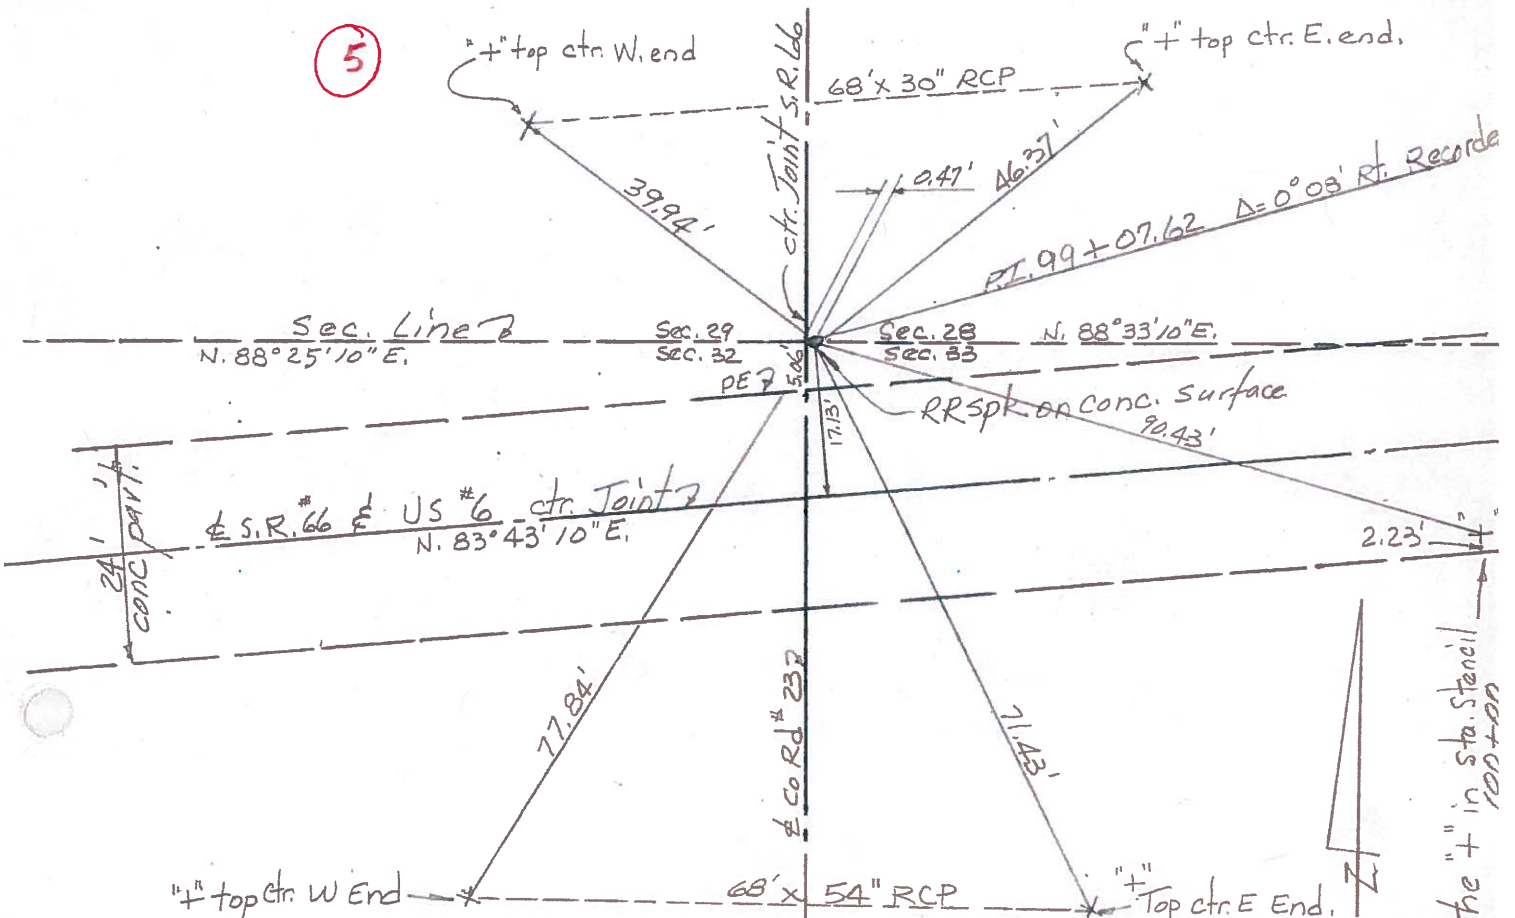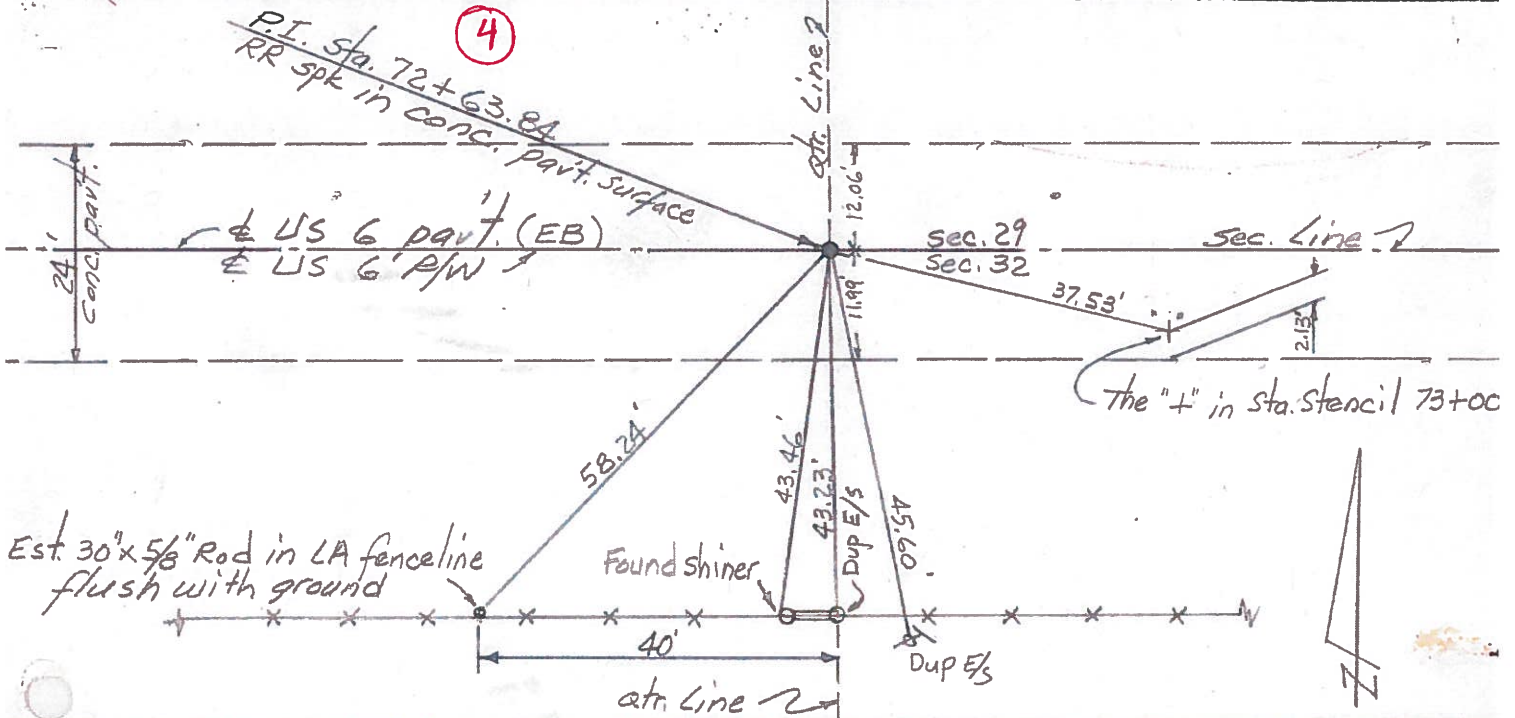

PERSONNEL TITLE PERSONNEL TITLE

COUNTY Henry DATE Jan 1951S. R. 384 WEATHER _____

SEC. _____ TEMP. _____

DESCRIPTION _____ JOB NO. _____

LEFT

CENTER LINE

RIGHT

10/9/56

Sta. 125+50.64

 $L = 0^{\circ} 11' 30''$ Lt

Found Small Stone

Set R.R. Spk

Shiner
S. side 24" BasswoodShiner SE
side 20" MapleShiner NE
side TP

10/9/56

Sta. 151+92.72

 $L = 0^{\circ} 02'$ Lt

Found I.P. over Stone

Set Nail & Shi

X-NE Cor.
N. Hdwall.X-S.E. Cor.
S. Hdwall.Near side
Pump 1' from ground.

10/9/56

Sta. 178+49.81

 $L = 0^{\circ} 10'$ Lt

Established Tacked Hub

(from old ties)

Set R.R. Spk.

Shiner NW
side TPShiner N.
side Cor PostIron post sign stk
TopTacked Hub
1' W of 1st fence post west.

GONE

Sta 188+56.43

 L

Established R.R. Spk

Face
Gas Pipe
Gas valve

Shiner N.W.

Gone Conc. R/R Markers

85" HP

P.K. Nail

Shiner N.E. side
38" LocustNote:
Nail & Shi
8.0' E of P.K.

Note: Found Stone on qtr qtr line 316.87 East of R.R. Spk
at Sta 188+56.43. - Stone is 4' south of con post