

O.D.O.T. DISTRICT 2 SURVEY OFFICE (USE ONLY)

PERSONNEL

REFERENCE NO. 6

SHEET OF

NOTES RHODES

DATE 7/7/21

ROUTE US 6

H.C. AUBLE

WEATHER FAIR

COUNTY HENRY

R.C. NIESE

TEMP. 77°

TOWNSHIP RIDGEVILLE

DWG BY BARRIERE

PID 101274

SECTION 38

T 6 N R 5 E

TYPE MONUMENT MONBOX W/ 1" IPIN

ON SURFACE - BELOW ON

OFFSET $\odot$ PAVEMENT ON LT : RT

 TO EDGE PAVEMENT

STATION: 125+66

HORZ.DATUM: NAD83 2011


GEOID: 18

GRID: NORTHING: 651934.377

EASTING: 1476116.697


LDP: NORTHING:

EASTING:

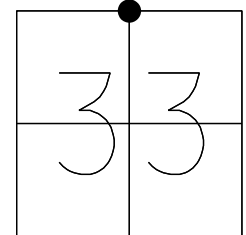

RECORD: P.I.
STA 125+50.64
 $\Delta = 0^\circ 11.5'$ LT

FD SM R.R. SPIKE
4/14/97, BWC
SET SM R.R. SPIKE
6/26/97, BWC
FD MAG SPIKE
REF6
7/7/21, DSA
FD MONBOX W/ 1" IPIN
NEWREF6
12/12/22, TDN

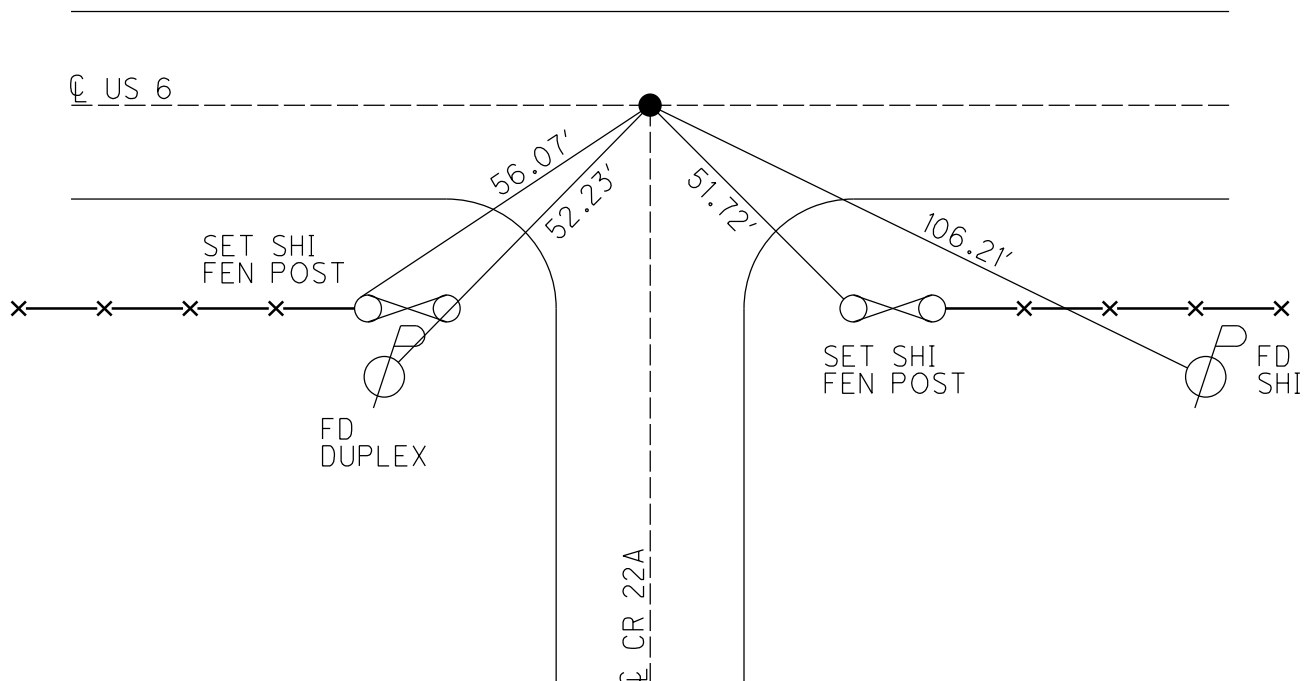

O.D.O.T. DISTRICT 2 SURVEY OFFICE (USE ONLY)

PERSONNEL

REFERENCE NO. 6

SHEET 6 OF 7

NOTES CORDES
H.C. MOSER
R.C. HUSS
LOEHRKE

DATE 4/14/97
WEATHER SUN
TEMP. 32°

ROUTE US 6
COUNTY HENRY
TOWNSHIP RIDGEVILLE
SECTION 31

DWG BY NIESE PID

T 6 N R 5 E

TYPE MONUMENT SM.R.R.SPIKE

ON SURFACE - ~~BELOW~~ ON


OFFSET CL PAVEMENT ON LT : RT

12.4' TO RT EDGE PAVEMENT


STATION: 125+66

HORZ.DATUM: GEOID:

GRID: NORTHING: EASTING:

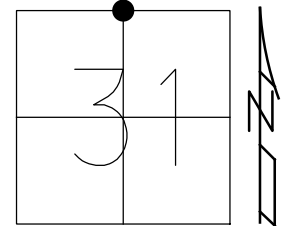

RECORD: P.I.
STA 125+50.64
 $\Delta = 0^\circ 11.5'$ LT
FD SM R.R. SPIKE
4/14/97, BWC
SET SM R.R. SPIKE
6/26/97, BWC

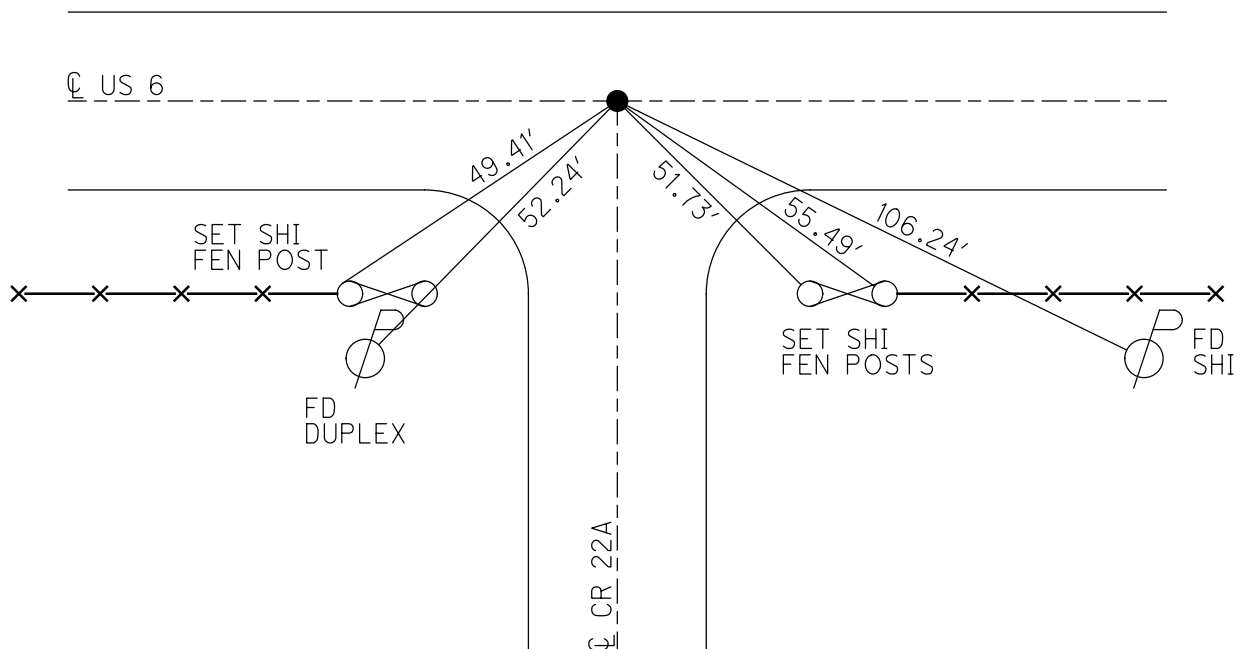

O.D.O.T. DISTRICT 2 SURVEY OFFICE

PERSONNEL

REFERENCE NO. 6

SHEET 5 OF 7

NOTES CORPES

H.C. MOSER

R.C. HUSS

P LOEHKE

DATE 4-14-97

WEATHER SUN

TEMP. +4°C

ROUTE 6

COUNTY HENRY

TOWNSHIP RIDGEVILLE

SECTION 28

T. 6 N. R. 5 E.

TYPE MONUMENT SM RR SPIKE


ON SURFACE - ~~BELOW~~ YES

~~LEFT~~ & PAV'T. - ~~RIGHT~~ YES

3.78m TO RT EDGE PAVEMENT


S.L.M. 3+830

125+66 (2.37)

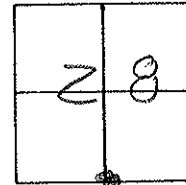

RECORD PI
STA: 125+50.64
Δ 0°-11.5' LT

SET SMALL
R/R SPIKE
6-26-97
BWC

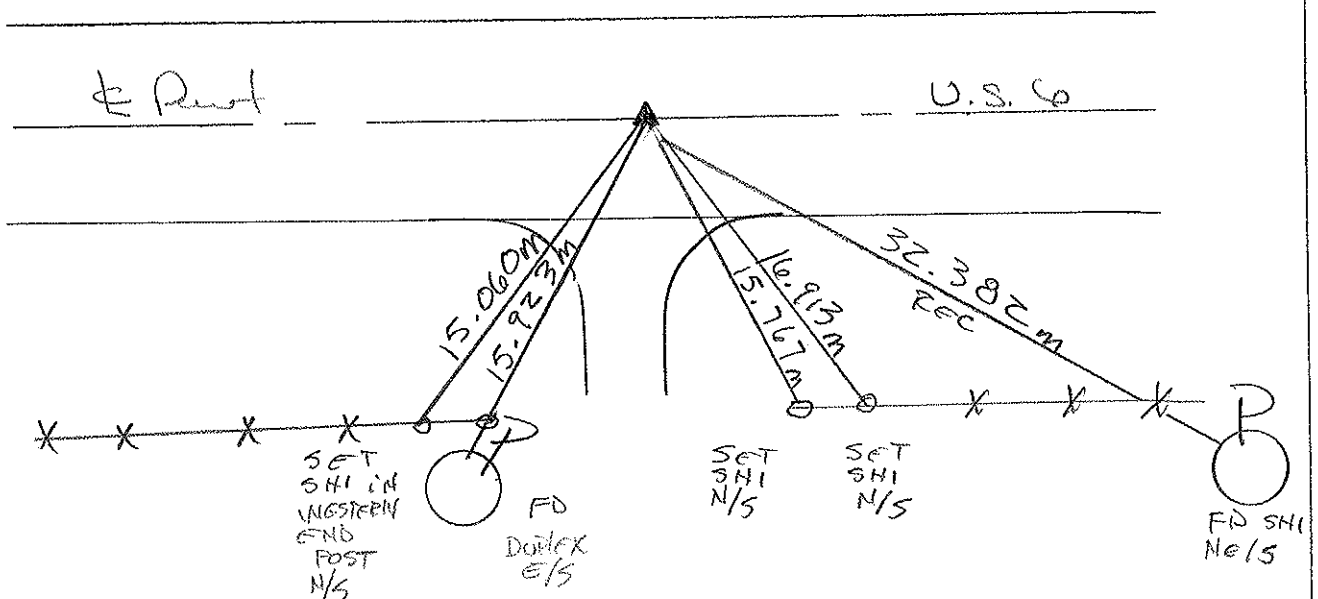

O.D.O.T. DISTRICT 2 SURVEY OFFICE

PERSONNEL

REFERENCE NO. 6

SHEET OF

NOTES Hoffman R.C.

H.C. BARNHISEL

R.C.

DATE 5-6-85

WEATHER Cloudy

TEMP. 65°

ROUTE U.S. 6

COUNTY HENRY

TOWNSHIP EDGEVILLE

SECTION 28

T 6 N R 5 E

TYPE MONUMENT R.R. SPK


ON SURFACE - BELOW 2"

LEFT- & PAV'T. - RIGHT ON R

R.O. TO RT. EDGE PAVEMENT

S.L.M. 125+ 52

Set small R.R. SPK
6-13-85 SWH

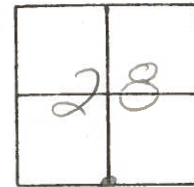


P.I. STA 125+ 50.64

$\Delta = 0^\circ 11.5'$ Lt Recorded

Left Part U.S. 6

Sec Line

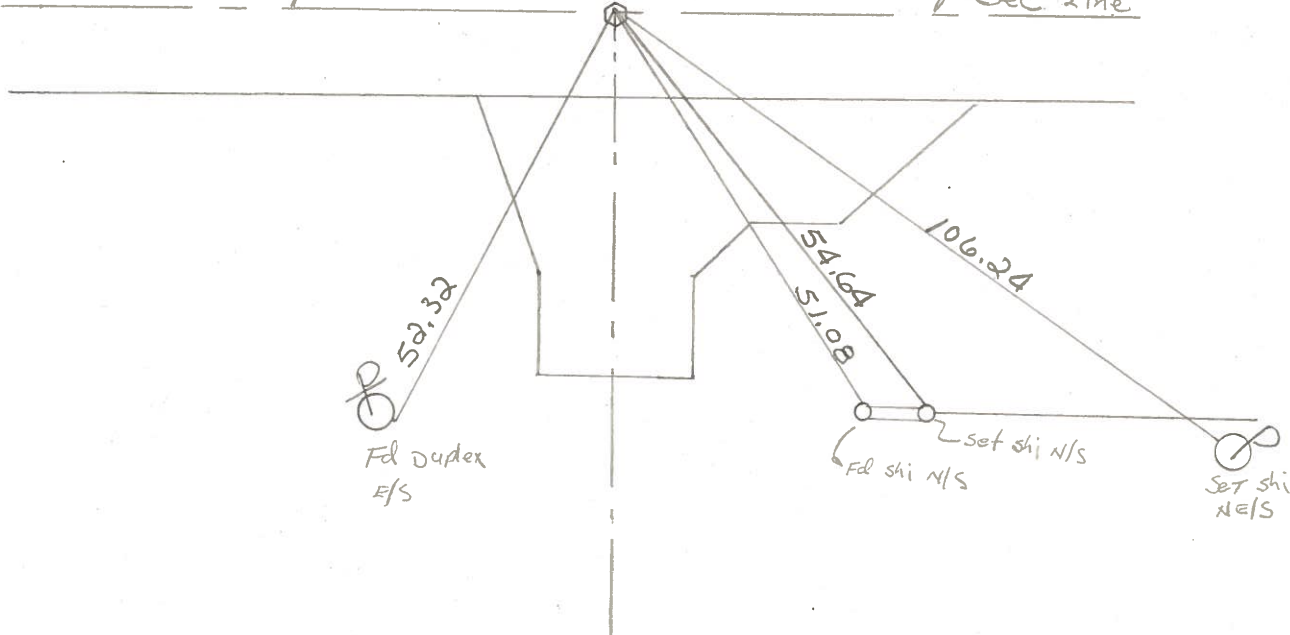

PERSONNEL TITLE PERSONNEL TITLE

COUNTY HENRY DATE 9 July '74Red BeachW. KnappeS. R. US 6

WEATHER



D. BoyleSEC. Ridgeville Twp TEMPJ. Bagdonas

DESCRIPTION

CONTROL

POINTS

JOB NO.

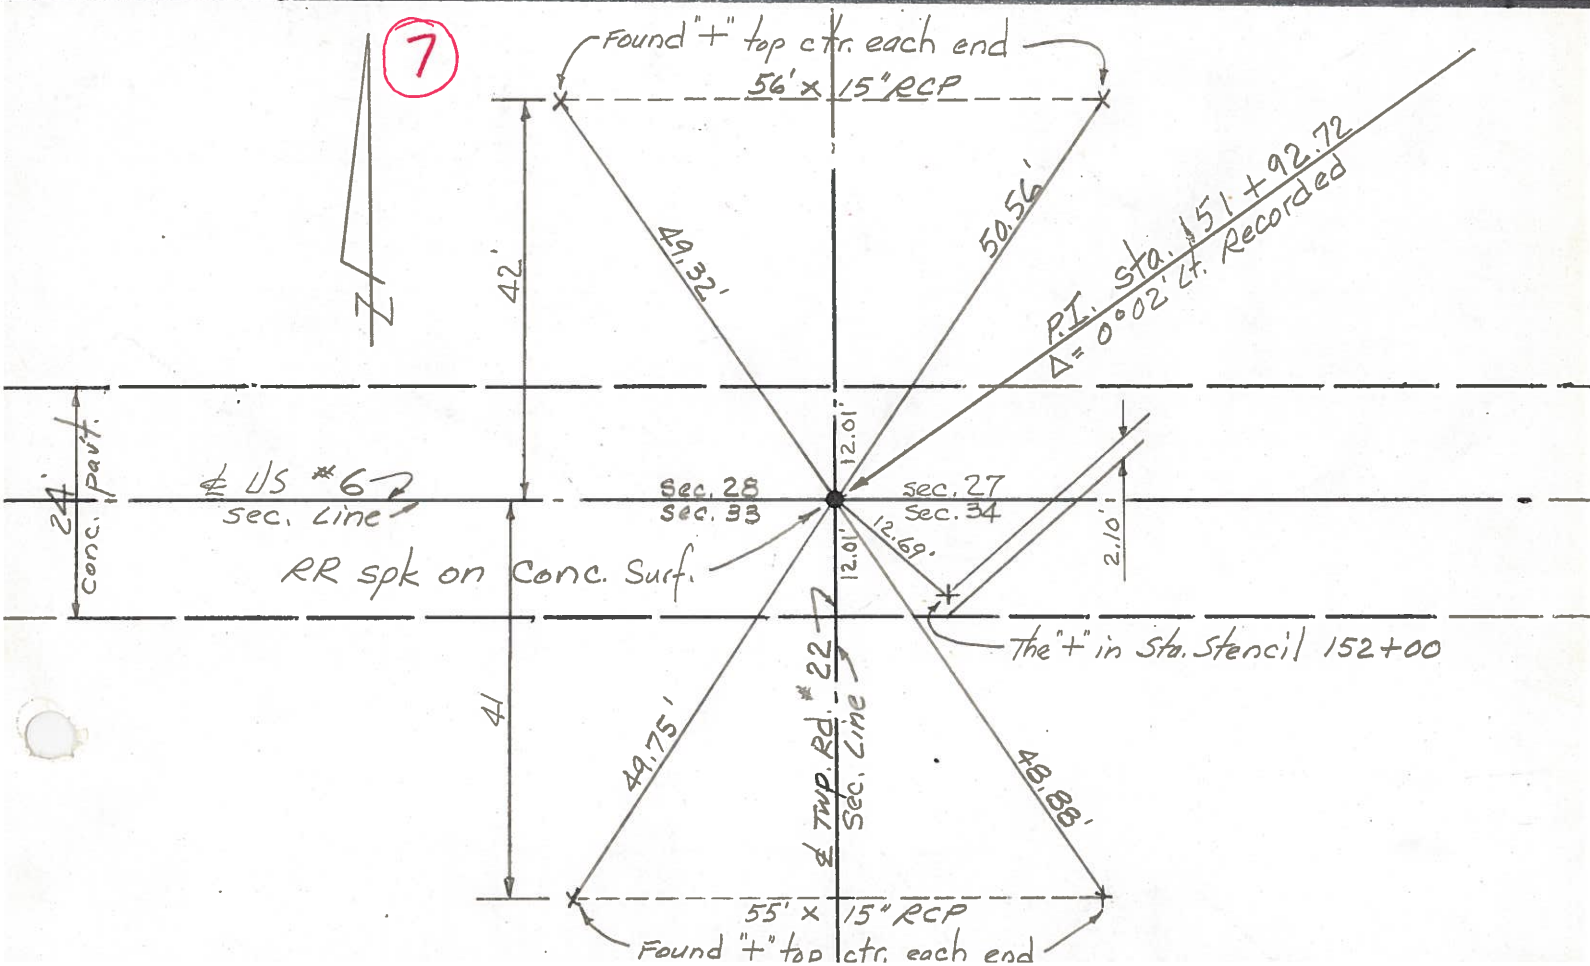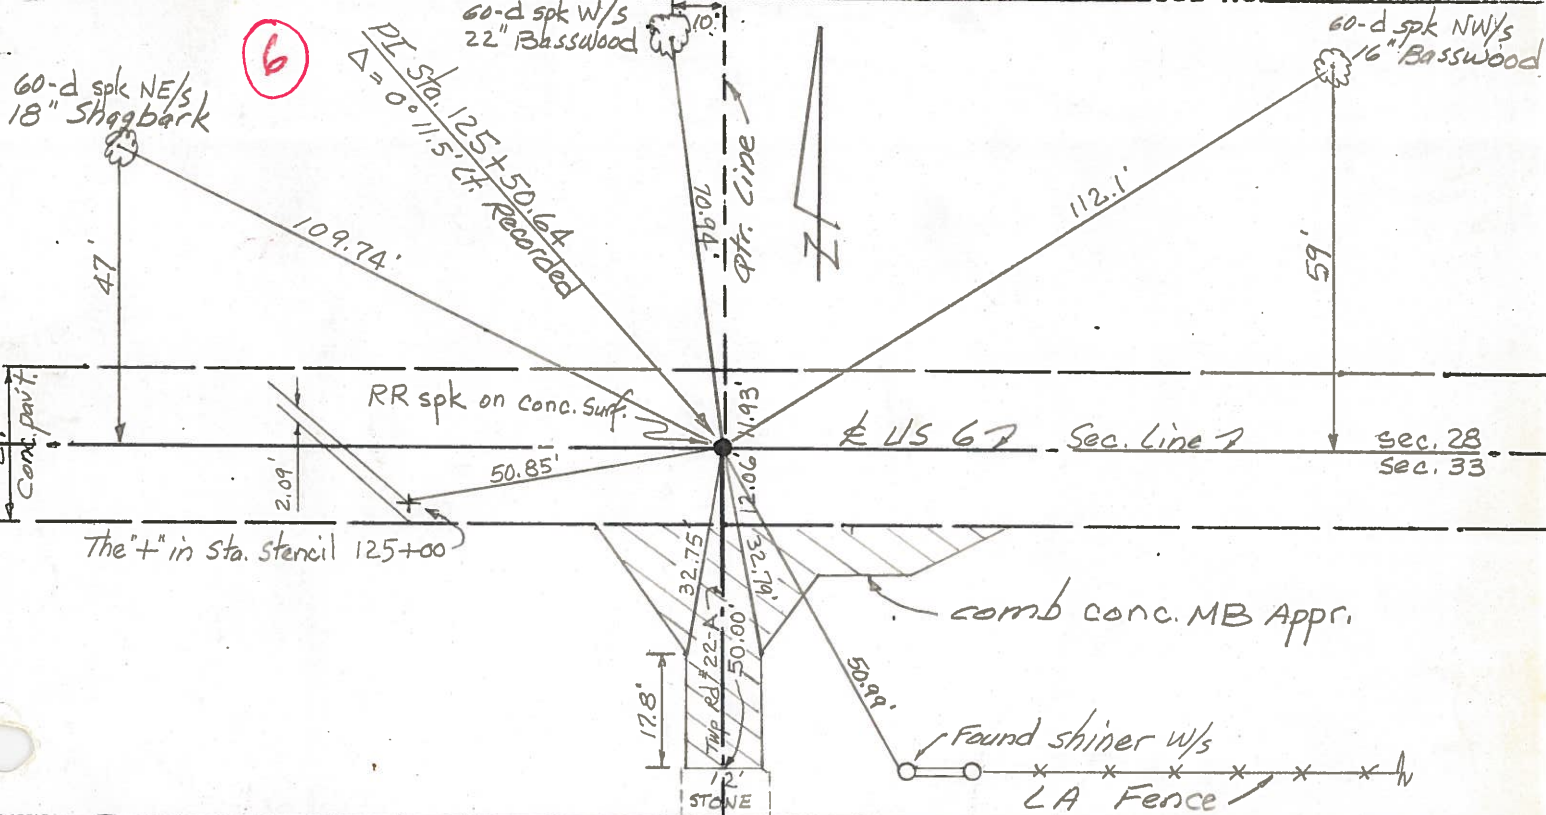

PERSONNEL TITLE PERSONNEL TITLE

COUNTY Henry DATE Jan 1951S. R. 384 WEATHER _____

SEC. _____ TEMP. _____

DESCRIPTION _____ JOB NO. _____

LEFT

CENTER LINE

RIGHT

10/9/56

Sta. 125+50.64

 $L = 0^{\circ} 11' 30''$ Lt

Found Small Stone

Set R.R. Spk

Shiner
S. side 24" Basswood

61.45

Shiner SE
side 20" Maple

47.84

Shiner NE
side TP

10/9/56

Sta. 151+92.72

 $L = 0^{\circ} 02'$ Lt

Found I.P. over Stone

Set Nail & Shi

X-NE Cor.
N. Hdwall.X-S.E. Cor.
S. Hdwall.

26.26

22.74

Near side
Pump 1' from ground.

44.70

10/9/56

Sta. 178+49.81

 $L = 0^{\circ} 10'$ Lt

Established Tacked Hub

(from old ties)

Set R.R. Spk.

Tacked
Hub

R.R. Spk.

19.42

Shiner NW
side TP

56.26

Shiner N.
side Cor Post

18.93

Iron post sign stk
Top

38.47

Tacked Hub

1' W of 1st fence post west.

GONE

25.98

30.05

P.K. Nail

18.00

Shiner N.E. side
38" Locust

Sta 188+56.43

 L

Established R.R. Spk

Shiner N.W.

35.93

85" HP

85" HP

Note: Found Stone on qtr qtr line 316.87 East of R.R. Spk
at Sta 188+56.43. - Stone is 4' south of cor post