



O.D.O.T. DISTRICT 2 SURVEY OFFICE (USE ONLY)

PERSONNEL	REFERENCE NO. <u>8</u>	SHEET <u> </u> OF <u> </u>
NOTES <u>RHODES</u>	DATE <u>7/7/21</u>	ROUTE <u>US 6</u>
H.C. <u>AUBLE</u>	WEATHER <u>FAIR</u>	COUNTY <u>HENRY</u>
R.C. <u>NIESE</u>	TEMP. <u>77°</u>	TOWNSHIP <u>RIDGEVILLE</u>
		SECTION <u>27</u>
DWG BY <u>BARRIERE</u>	PID <u>101274</u>	T <u>6</u> N R <u>5</u> E
TYPE MONUMENT <u>MONBOX W/ 1" IPIN</u>		
ON SURFACE - BELOW <u>ON</u>		
OFFSET $\mathcal{Q}$ PAVEMENT <u>ON</u> LT : RT		
<u> </u> TO <u> </u> EDGE PAVEMENT		
STATION: <u>178+70.38</u>		
HORZ.DATUM: <u>NAD83 2011</u>	GEOID: <u>18</u>	
GRID: NORTHING: <u>651848.026</u>	EASTING: <u>1481413.679</u>	
LDP: NORTHING: <u> </u>	EASTING: <u> </u>	

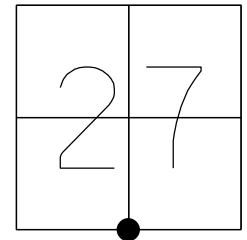

RECORD: P.I.
STA. 178+49.81

FD R.R.SPIKE
ON CONC. SURFACE
7/9/74, BEACH
FD SM.R.R.SPIKE
4/14/97, CL
SET P.K./WASHER
6/26/97, BWC
FD NAIL
SR6-REF8
3/7/16, JFO
FD MAG SPIKE
REF8
7/7/21, DSA
FD MONBOX W/ 1" IPIN
NEWREF8
12/12/22, TDN

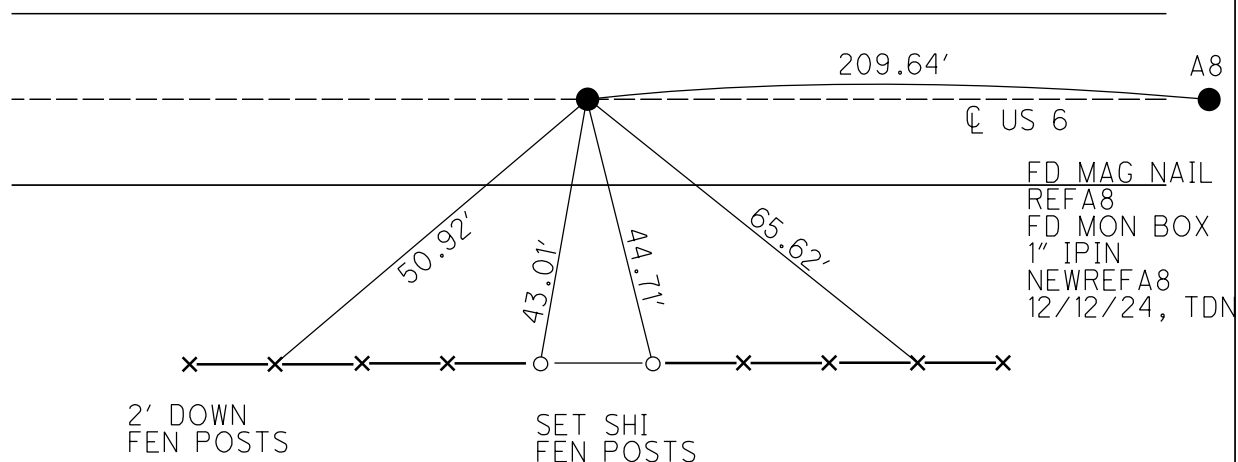

O.D.O.T. DISTRICT 2 SURVEY OFFICE (USE ONLY)

PERSONNEL

REFERENCE NO. 8

SHEET 1 OF 37

NOTES CORDES

DATE 4/14/97

ROUTE US 6

H.C. LOEHRKE

WEATHER SUNNY

COUNTY HENRY

R.C. MOSER

TEMP. 45°

TOWNSHIP RIDGEVILLE

HUSS

SECTION 27

T 6 N R 5 E

TYPE MONUMENT SM.R.R.SPIKE


ON SURFACE - ~~BELOW~~ ON

LEFT - CL PAV'T - RIGHT ON


12.3' TO RT EDGE PAVEMENT

S.L.M. 178+70.38

Grid: Northing: 651847.985 Easting: 1481413.697

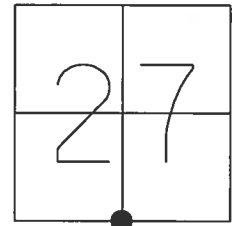

RECORD: P.I.
STA. 178+49.81
FD R.R.SPIKE
ON CONC. SURFACE
7/9/74, BEACH
FD SM.R.R.SPIKE
4/14/97, CL
SET P.K./WASHER
6/26/97, BWC
FD NAIL
SR6-REF8
3/7/16, JFO

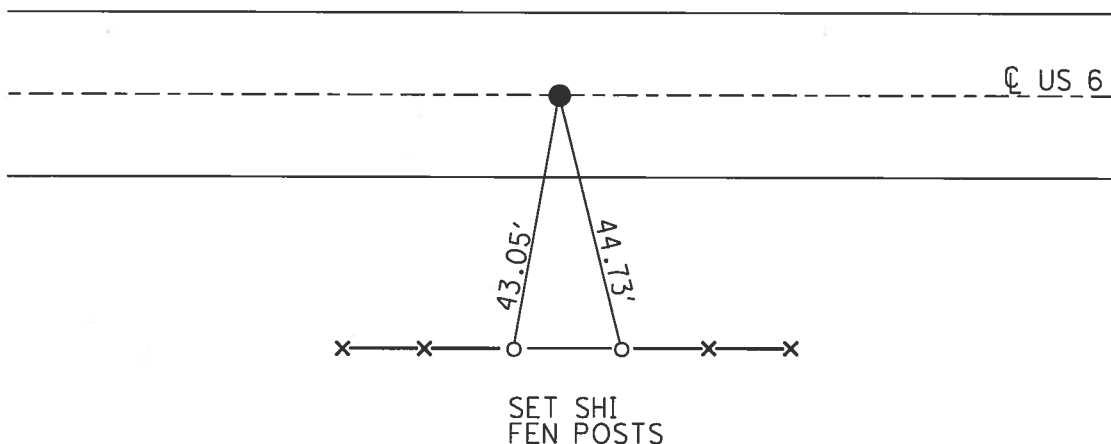

O.D.O.T. DISTRICT 2 SURVEY OFFICE

PERSONNEL

REFERENCE NO. 8

SHEET 7 OF 7

NOTES CORDES

H.C. LOENKE

R.C. MOSEK

NUSS

DATE 4-14-97

WEATHER SUN

TEMP. +17°C

ROUTE 6

COUNTY HENRY

TOWNSHIP RIDGEVILLE

SECTION 27

T 6 N R 5 E


TYPE MONUMENT SM IR SPIKE

ON SURFACE - ~~NO~~ YES

~~PAV'T.~~ YES

3.75m TO RT EDGE PAVEMENT

S.L.M. 5+446 178+67 (3,38)

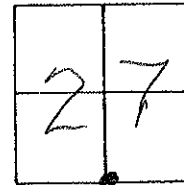


RECORD PI

STA: 178+49.81

SET PK &
WASHER

6-26-97

BWC

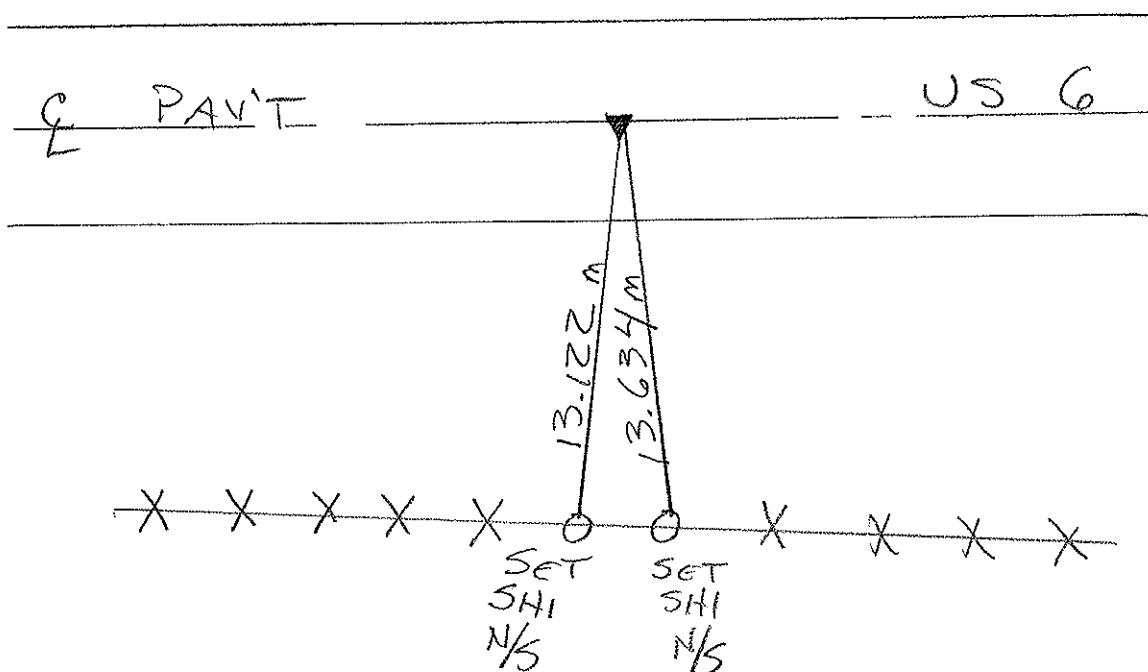

O.D.O.T. DISTRICT 2 SURVEY OFFICE

PERSONNEL

REFERENCE NO. 8

SHEET OF

NOTES Hoffman R.C.

H.C. BARNHISEL

R.C.

DATE 5-6-85

WEATHER Cloudy

TEMP. 65°

ROUTE U.S. 6

COUNTY HENRY

TOWNSHIP Ridgelyville

SECTION 27

T 6 N R 5 E

TYPE MONUMENT R.R. SPK


Set small R.R. SPK
6-13-85 SWL

ON SURFACE - BELOW 1 1/2'


LEFT- & PAV'T. - RIGHT oxl &

D.O.T. RT. EDGE PAVEMENT

S.L.M. 178+52

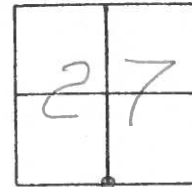

P.I. Sta 178+49.81

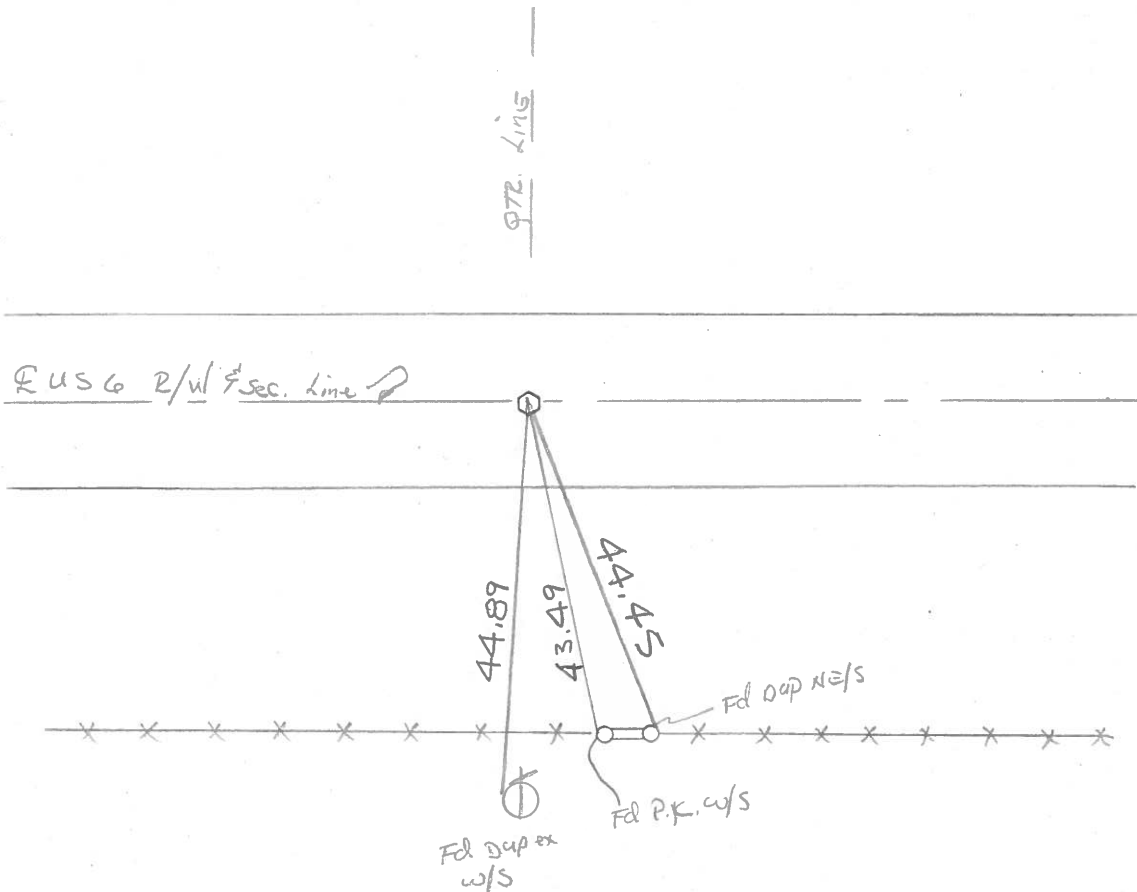

PERSONNEL TITLE PERSONNEL TITLE

Red Beach

W. Knappe

D. Boyle

J. Bagdonas

COUNTY HENRY

DATE 9 July 74

S. R. US 6

WEATHER

SEC. Ridgeville TWP

TEMP

DESCRIPTION


CONTROL POINTS

JOB NO.

PI Sta. 178+49.81
RR spk on conc. surface

8


str. line

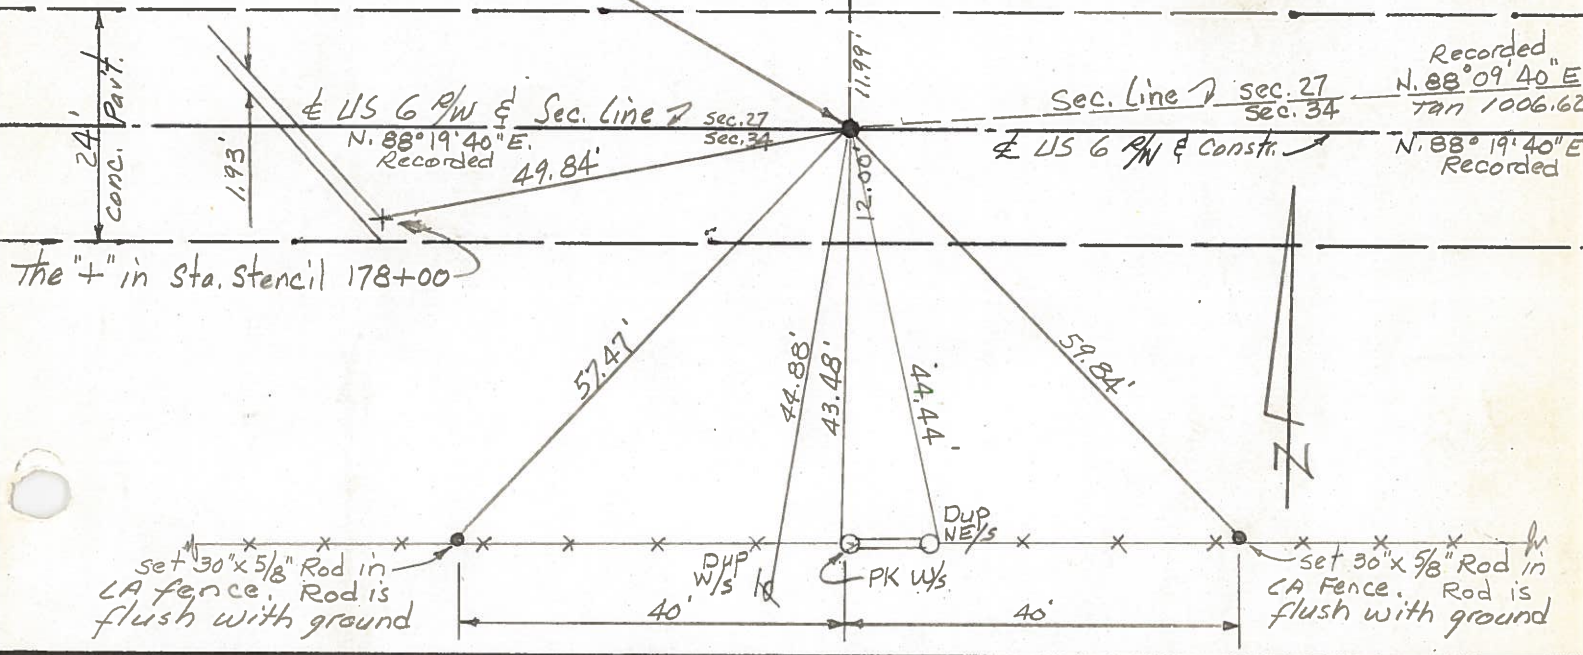

The "+" in Sta. Stencil 178+00

9

POT Sta. 197+00

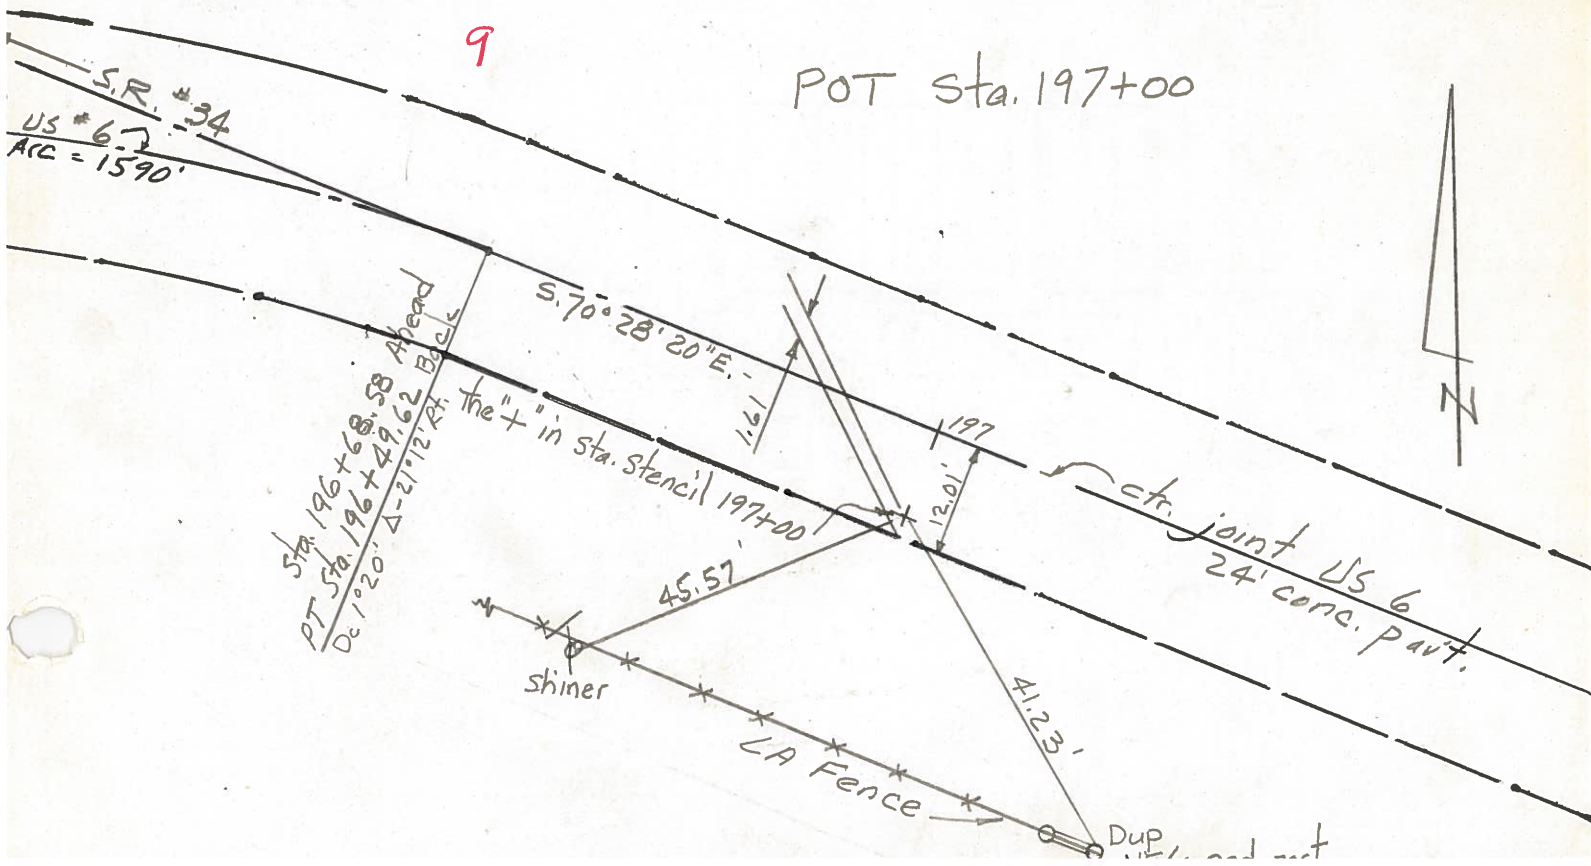

Sta. 196+68.58 Ahead
PT Sta. 196+49.62 Back
Dc 120' Δ-21° 12' RT

the "+" in Sta. Stencil 197+00

shiner

LA Fence

Dup. and rest

PERSONNEL

TITLE

PERSONNEL

TITLE

Beach
Armbruster
Knappe
Mehler

COUNTY

HENRY

DATE

Oct. '63

S. R.

US# 6

WEATHER

SEC.


TEMP.

DESCRIPTION

CONTROL POINTS


JOB NO.

S 1/4 Post Stone, Sec. 36
Ridgeville Twp.

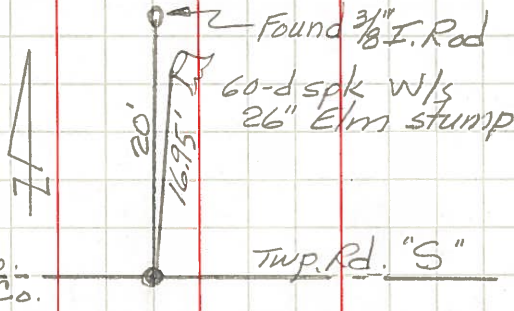


Found Stone 3" below surface
Stone is 3' North of ctr of 12' gravel Rd.

NE cor., W 1/2, NE 1/4, Sec. 36, Ridgeville Twp.

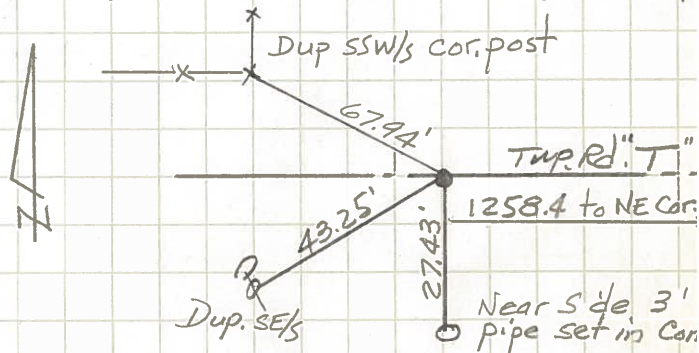


Found 2" I. Pipe (Recorded) 2 3/4" below
pav't surface
Pipe on North edge of 16' Bit. Mac. Pav

W 1/4 Post Stone, Sec. 36
Ridgeville Twp.

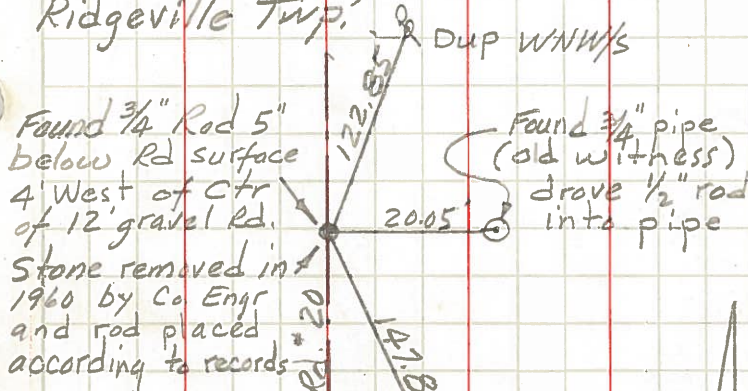

N 1/4 Post Stone, Sec. 36, Ridgeville Twp.

Found stone 9 1/4" below pav't surface
Stone has good E & W ridge — putchise
mark midway on ridge
Found 3/4" pipe on south side of stone and 8"
below pav't surface.

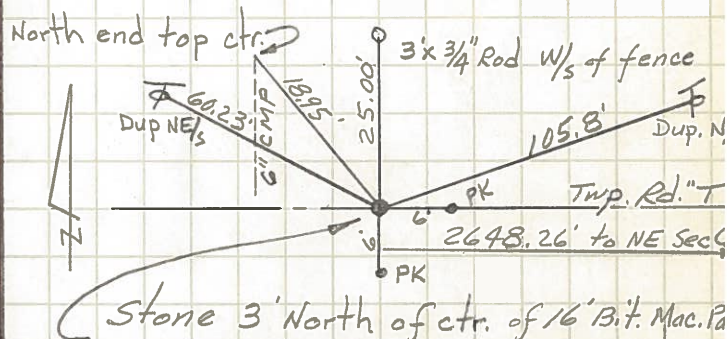


(Stone 3' North of ctr. of 16' Bit. Mac. Pav)


NW Cor., Sec. 36 Ridgeville Twp

NE Cor., Sec. 35 Ridgeville Twp

Found stone 16 1/2" below pav't surface (Bit. M)
Found flat stone with tile on top of Cor. Sto
as recorded.

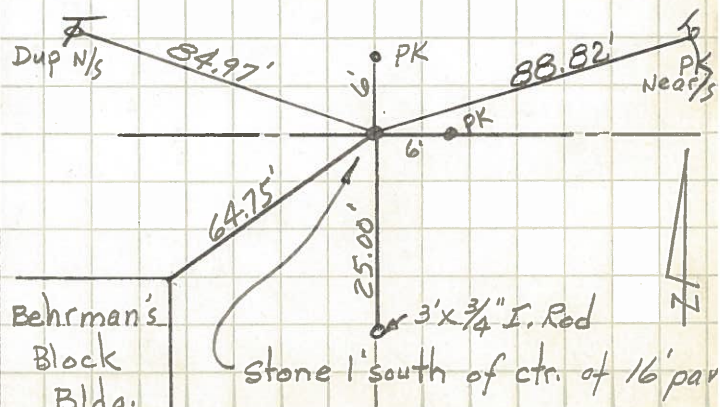

Behrman's
Block
Bldg.

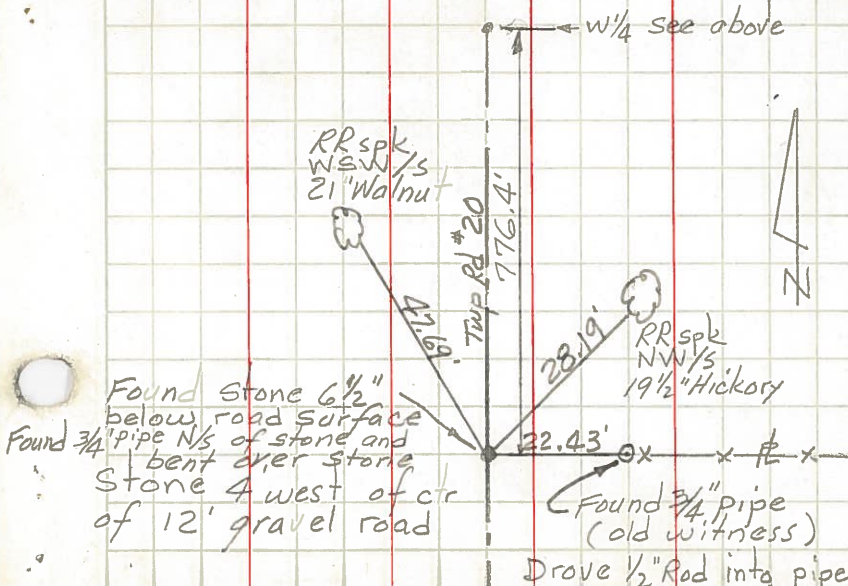

Found Stone 6 1/2" below road surface
Found 3/4" pipe N/S of stone and bent over stone
Stone 4 west of ctr of 12' gravel road
Found 3/4" pipe (old witness)
Drove 1/2" Rod into pipe

PERSONNEL TITLE PERSONNEL TITLE

COUNTY Henry DATE Jan 1951S. R. 384 WEATHER _____

SEC. _____ TEMP. _____

DESCRIPTION _____ JOB NO. _____

LEFT

CENTER LINE

RIGHT

10/9/56

Sta. 125+50.64

 $L = 0^{\circ} 11' 30''$ Lt

Found Small Stone

Set R.R. Spk

Shiner
S. side 24" Basswood

61.45

Shiner SE
side 20" Maple

47.84

Shiner NE
side TPX-NE Cor.
N. Hdwall.X-S.E. Cor.
S. Hdwall.

10/9/56

Sta. 151+92.72

 $L = 0^{\circ} 02'$ Lt

Found I.P. over Stone

Set Nail & Shi

Near side
Pump 1' from ground.

10/9/56

Sta. 178+49.81

 $L = 0^{\circ} 10'$ Lt

Established Tacked Hub

(from old ties)

Set R.R. Spk.

Tacked
Hub

R.R. Spk.

Shiner NW
side TPShiner N.
side Cor PostIron post sign stk
Top

Tacked Hub

1' W of 1st fence post west.

GONE

Sta 188+56.43

 L

Established R.R. Spk

Face
Gas Pipe
Gas valve

Gone

Conc. R/R Markers

30.05

35.93

Shiner N.W.

85" HP

18.00

Shiner N.E. side
38" LocustNote:
Nail & Shi
8.0' E of P.K.

Note: Found Stone on qtr qtr line 316.87 East of R.R. Spk
at Sta 188+56.43. - Stone is 4' south of con post