

O.D.O.T. DISTRICT 2 SURVEY OFFICE (USE ONLY)

PERSONNEL	REFERENCE NO. <u>10</u>	SHEET <u>2</u> OF <u>47</u>
NOTES <u>BARNHISEL</u>	DATE <u>4/5/00</u>	ROUTE <u>US 6</u>
H.C. <u>CANTERBURY</u>	WEATHER <u>WINDY</u>	COUNTY <u>HENRY</u>
R.C. <u>BARNHISEL</u>	TEMP. <u>45°</u>	TOWNSHIP <u>RIDGEVILLE</u>
		SECTION <u>34</u>
		T <u>6</u> N R <u>5</u> E


TYPE MONUMENT 1/2" IPIPE

~~ON SURFACE~~ - BELOW 6"


LEFT - ℄ PAV'T - ~~RIGHT~~ 1.0', 14.5' W OF ℄ N
12.7' TO RT EDGE PAVEMENT

S.L.M. 206+18.40

Grid: Northing: 651172.009 Easting: 1484050.943

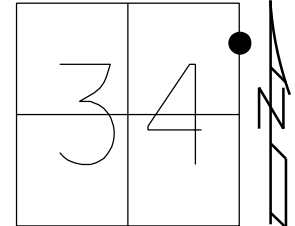

RECORD: P.I.
 STA. 205+98.25
 FD 1/2" IPIPE
 ATOP BOLT
 3/17/77, BEACH
 FD 1/2" IPIPE
 6" DOWN
 4/5/00, MB
 SET P.K./WASHER
 10/23/00, MDB
 FD MONBOX W/ 1" IPIN
 SR6-REF10
 3/7/16, JFO

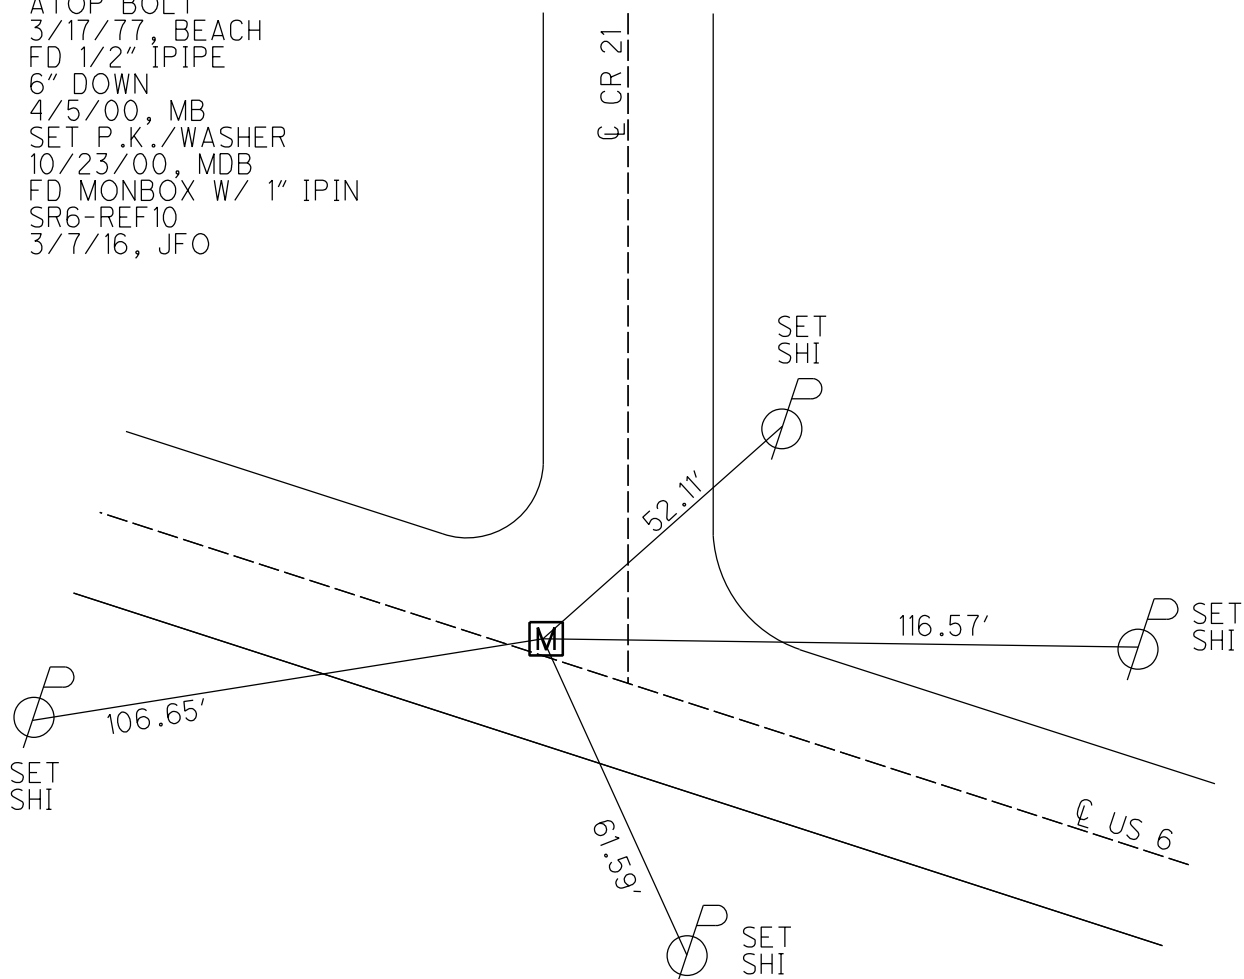

O.D.O.T. DISTRICT 2 SURVEY OFFICE (USE ONLY)

PERSONNEL

REFERENCE NO.

10

SHEET

2

OF 37

NOTES

BARNHISEL

DATE

4/5/00

ROUTE

US 6

H.C.

CANTERBURY

WEATHER

WINDY

COUNTY

HENRY

R.C.

BARNHISEL

TEMP.

45°

TOWNSHIP

RIDGEVILLE

SECTION

34

T 6 N R 5 E

TYPE MONUMENT

1/2" IPIPE

~~ON SURFACE~~

- BELOW

6"

LEFT - $\odot$ PAV'T - ~~RIGHT~~ 1.0', 14.5' W OF $\odot$ N

12.7' TO RT EDGE PAVEMENT


S.L.M. 206+18.40

Grid: Northing:

651172.009

Easting:

1484050.943

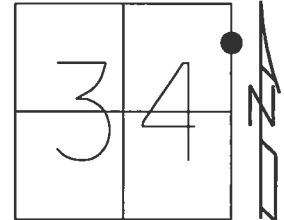

RECORD: P.I.

STA. 205+98.25

FD 1/2" IPIPE

ATOP BOLT

3/17/77, BEACH

FD 1/2" IPIPE

6" DOWN

4/5/00, MB


SET P.K./WASHER

10/23/00, MDB

FD MONBOX W/ 1" IPIN

SR6-REF10

3/7/16, JFO

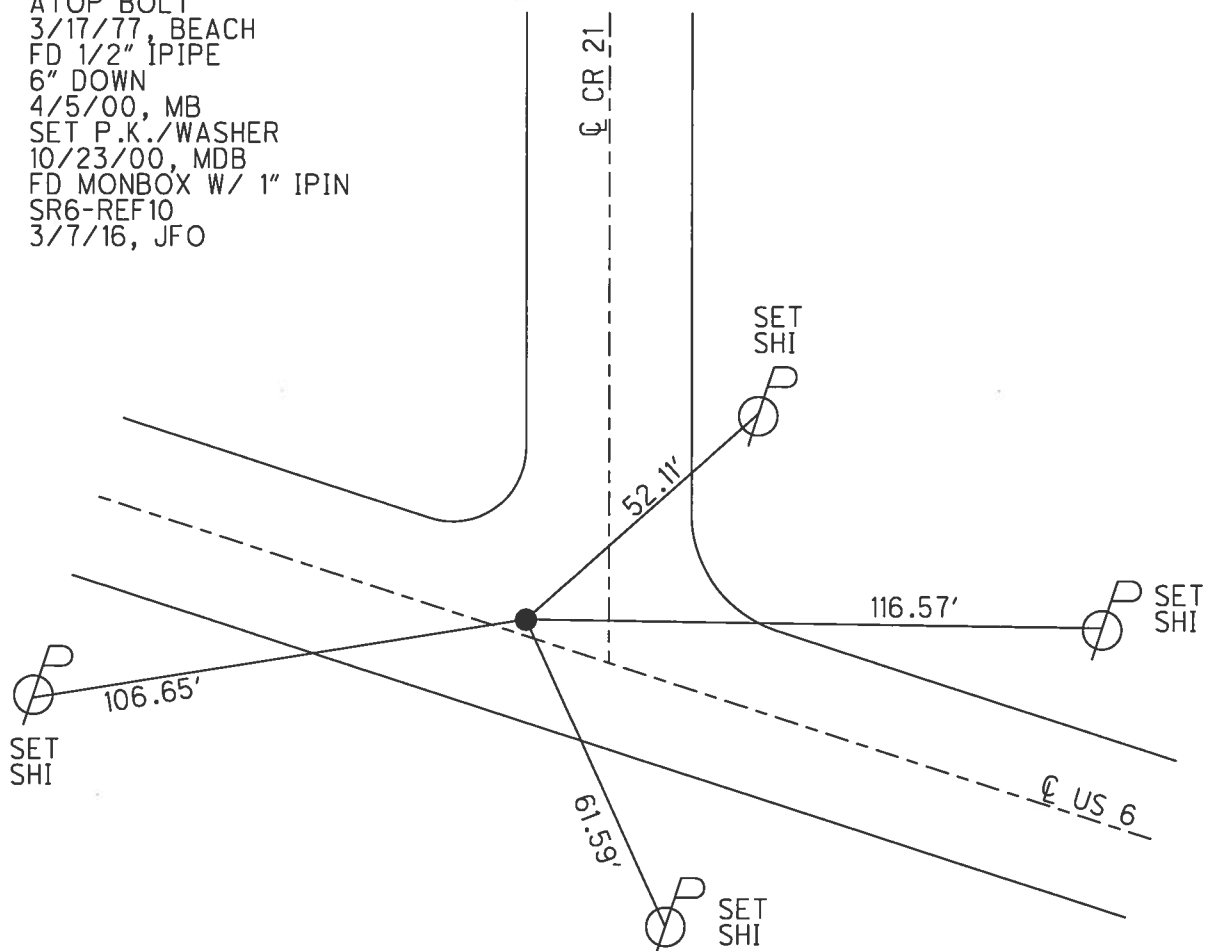

O.D.O.T. DISTRICT 2 SURVEY OFFICE

PERSONNEL

REFERENCE NO. 10

SHEET 5 OF 6

NOTES M. BARNHISEL

H.C. M. CANTERBURY

R.C. M. BARNHISEL

DATE 4.5-00

WEATHER Windy

TEMP. 146° F

ROUTE U.S. 6

COUNTY Henry

TOWNSHIP Ridgeville

SECTION 34 & 35

T6 N R 5 E


TYPE MONUMENT 1/2" I.P. PIPE

~~ON SURFACE~~ - BELOW 6"

LEFT - ~~PAV'T~~ - RIGHT 1.0' U.S. 6 & 14.5' WEST OF Q.C.D. 21

12.7 TO RT EDGE PAVEMENT

S.L.M. 205+98.25

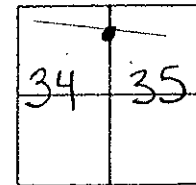


RECORD P.I. STA. 205+98.25

Reset PR/washer

10-23-00

MDB

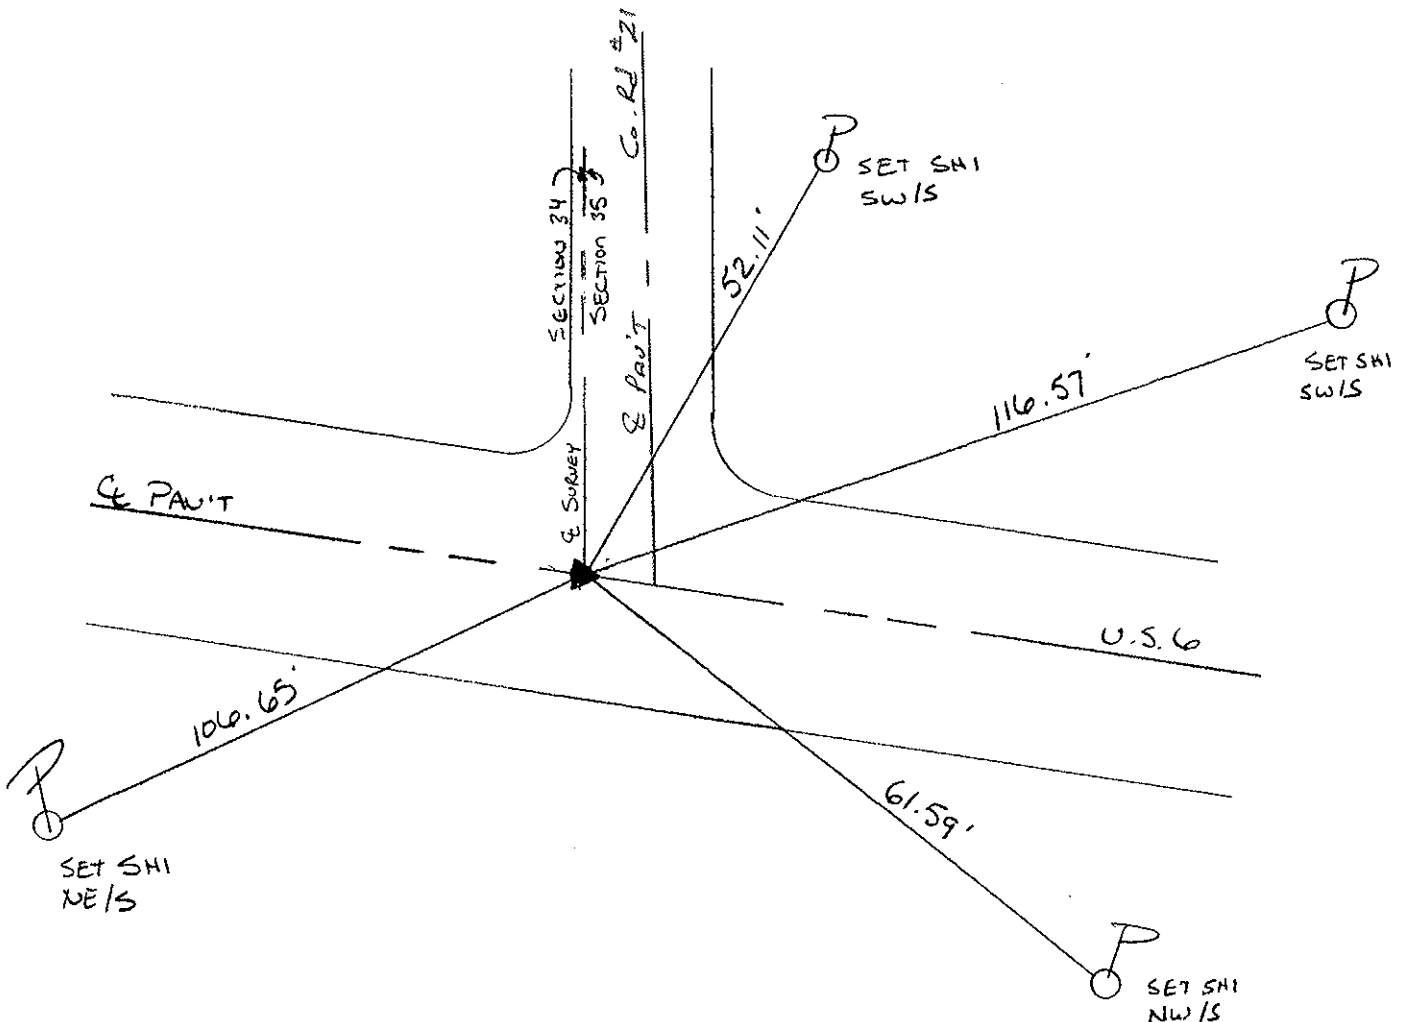

PERSONNEL TITLE PERSONNEL TITLE

Red Beach
W. Knappe

COUNTY HENRY DATE 17 Mar 77


S. R. US 6 WEATHER

SEC. Ridgerville Twp. TEMP

DESCRIPTION

CONTROL POINTS


JOB NO.

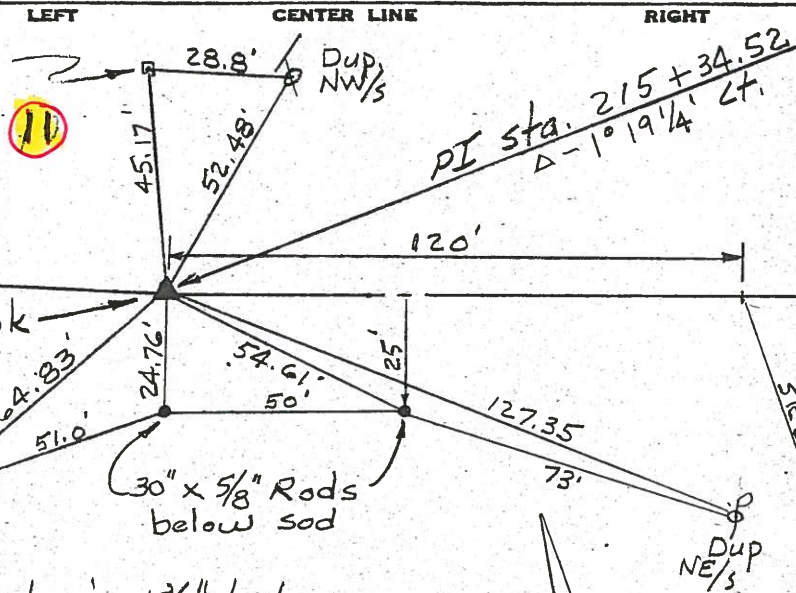Found old witness
Tacked hub
below sodTied in
w/ culvert

Found RR spk

The RR spk is $1\frac{3}{4}$ " below
the pavt surface.
The RR spk is 2.0' south
of ctr. of the 24' Bit. Mac. pavt.

36'
ZEHRS
FERTILIZER
Bldg
180'

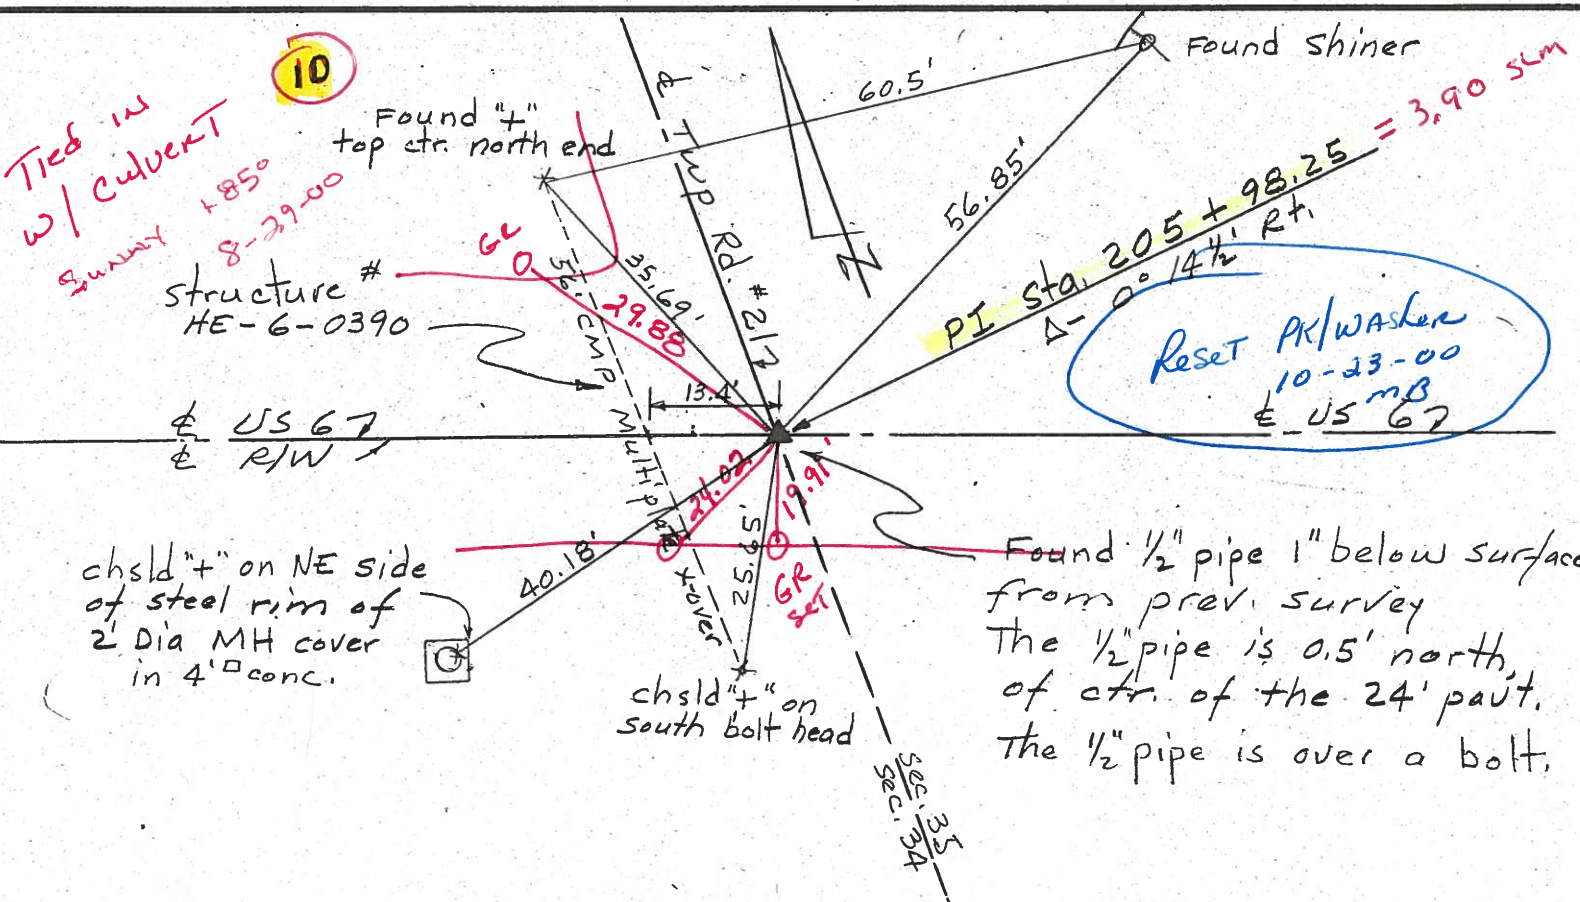Tied in
w/ culvert

10

Structure #
HE-6-0390US 67
R/W

chld "+" on NE side
of steel rim of
2' Dia MH cover
in 4' conc.

chld "+" on
south bolt head

Found $\frac{1}{2}$ " pipe 1" below surface
from prev. survey
The $\frac{1}{2}$ " pipe is 0.5' north
of ctr. of the 24' pavt.
The $\frac{1}{2}$ " pipe is over a bolt,

Reset PK/washer
10-23-00
US 67

PERSONNEL TITLE PERSONNEL TITLE

Beach

COUNTY Henry

DATE Dec '63

Armbruster

S. R. US#6

WEATHER

Knape

SEC. Ridgerville Twp.

TEMP.

Mohler

Hoff

DESCRIPTION

CONTROL POINTS

JOB NO.


LEFT

CENTER LINE



RIGHT

POT Sta. 178+49.84


⑧

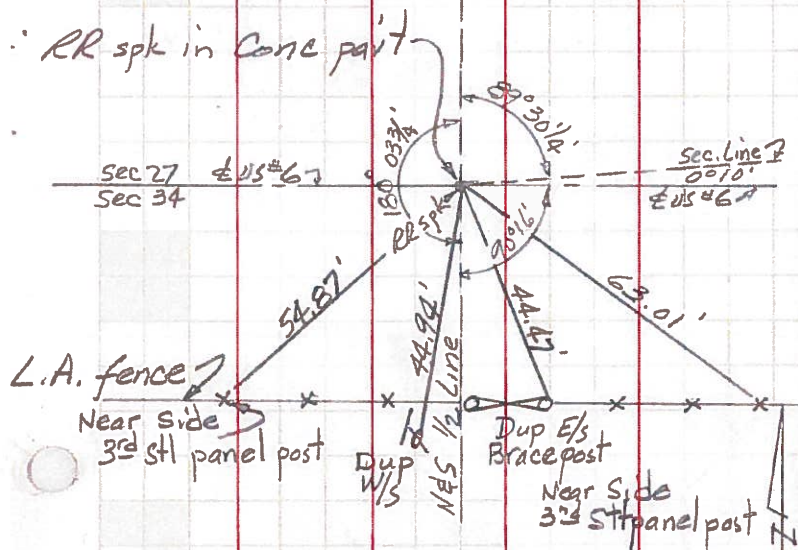P.I. Sta. 205+98.25 $\Delta = 0^\circ 14' 1/2$ Rt

⑩

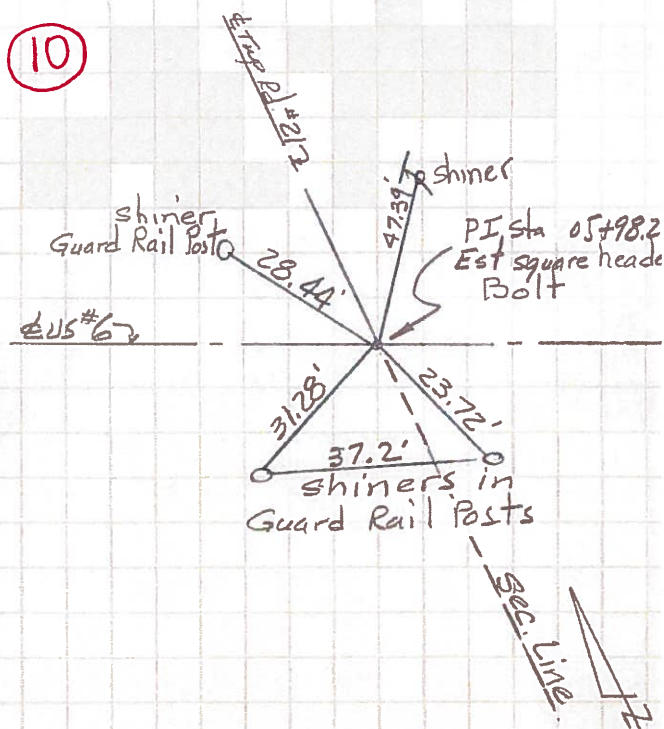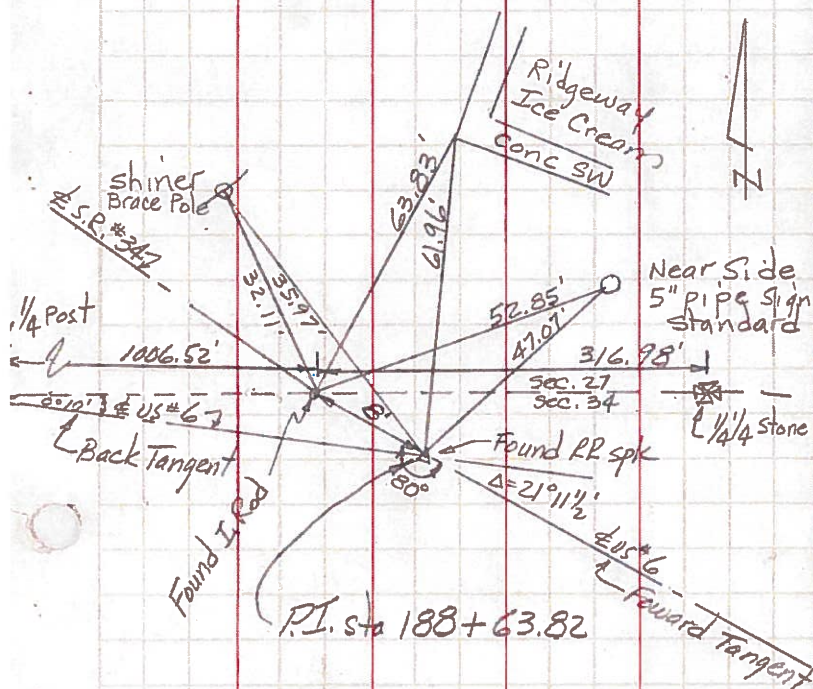P.I. Sta. 188+63.82 $\Delta = 21^\circ 11' 1/2$ RtP.I. Sta. 215+34.52 $\Delta = 1^\circ 19' 1/4$ Lt

⑪

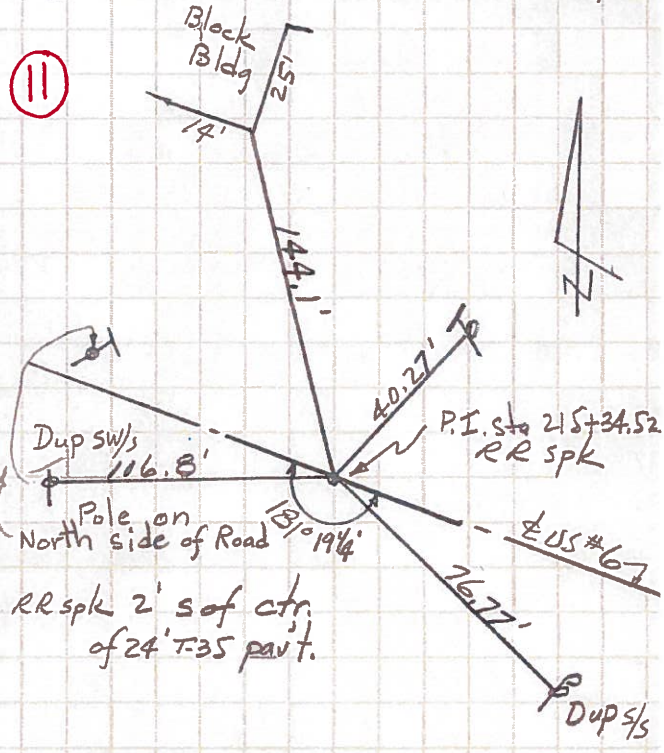

PERSONNEL TITLE PERSONNEL TITLE

COUNTY HENRY

DATE DEC. '63

Red Beach
Armbruster & Son

S. R. US #6

WEATHER

Knappe
Mohler
Hoff

SEC. NE 1/4, Sec. 34

TEMP.

DESCRIPTION

RIDGEVILLE TWP

T-6-N R-5-E

JOB NO.

LEFT

CENTER LINE

RIGHT

KNAPPE'S KNURSERY

- A, B, C - Found stones from recorded references.
 D - Found 1 3/4" steel rod extending 4' above ground.
 E - Found RR spk.
 F - Found Iron rod.
 G, H - Found P.K.s Est. by Newt Smith.
 J - Found 1/2" I. Pipe from recorded references.
 L - Used I. pipe A.P. embedded in N/ of tree.
 M - Est. Bolt on E Sur. & N&S Sec. Line.
 N - point on line CL and forward tangent.
 P - Found RR Spk in conc. pavt.


LEICHTY

Established line BM by reconstructing
 Helberg's 1931 Surv. (Dep. Co. Surveyor)
 See Vol 4 p. 40, Co. Engr. Records

MARTIN BRANDT

BENECKE

YUNGMAN

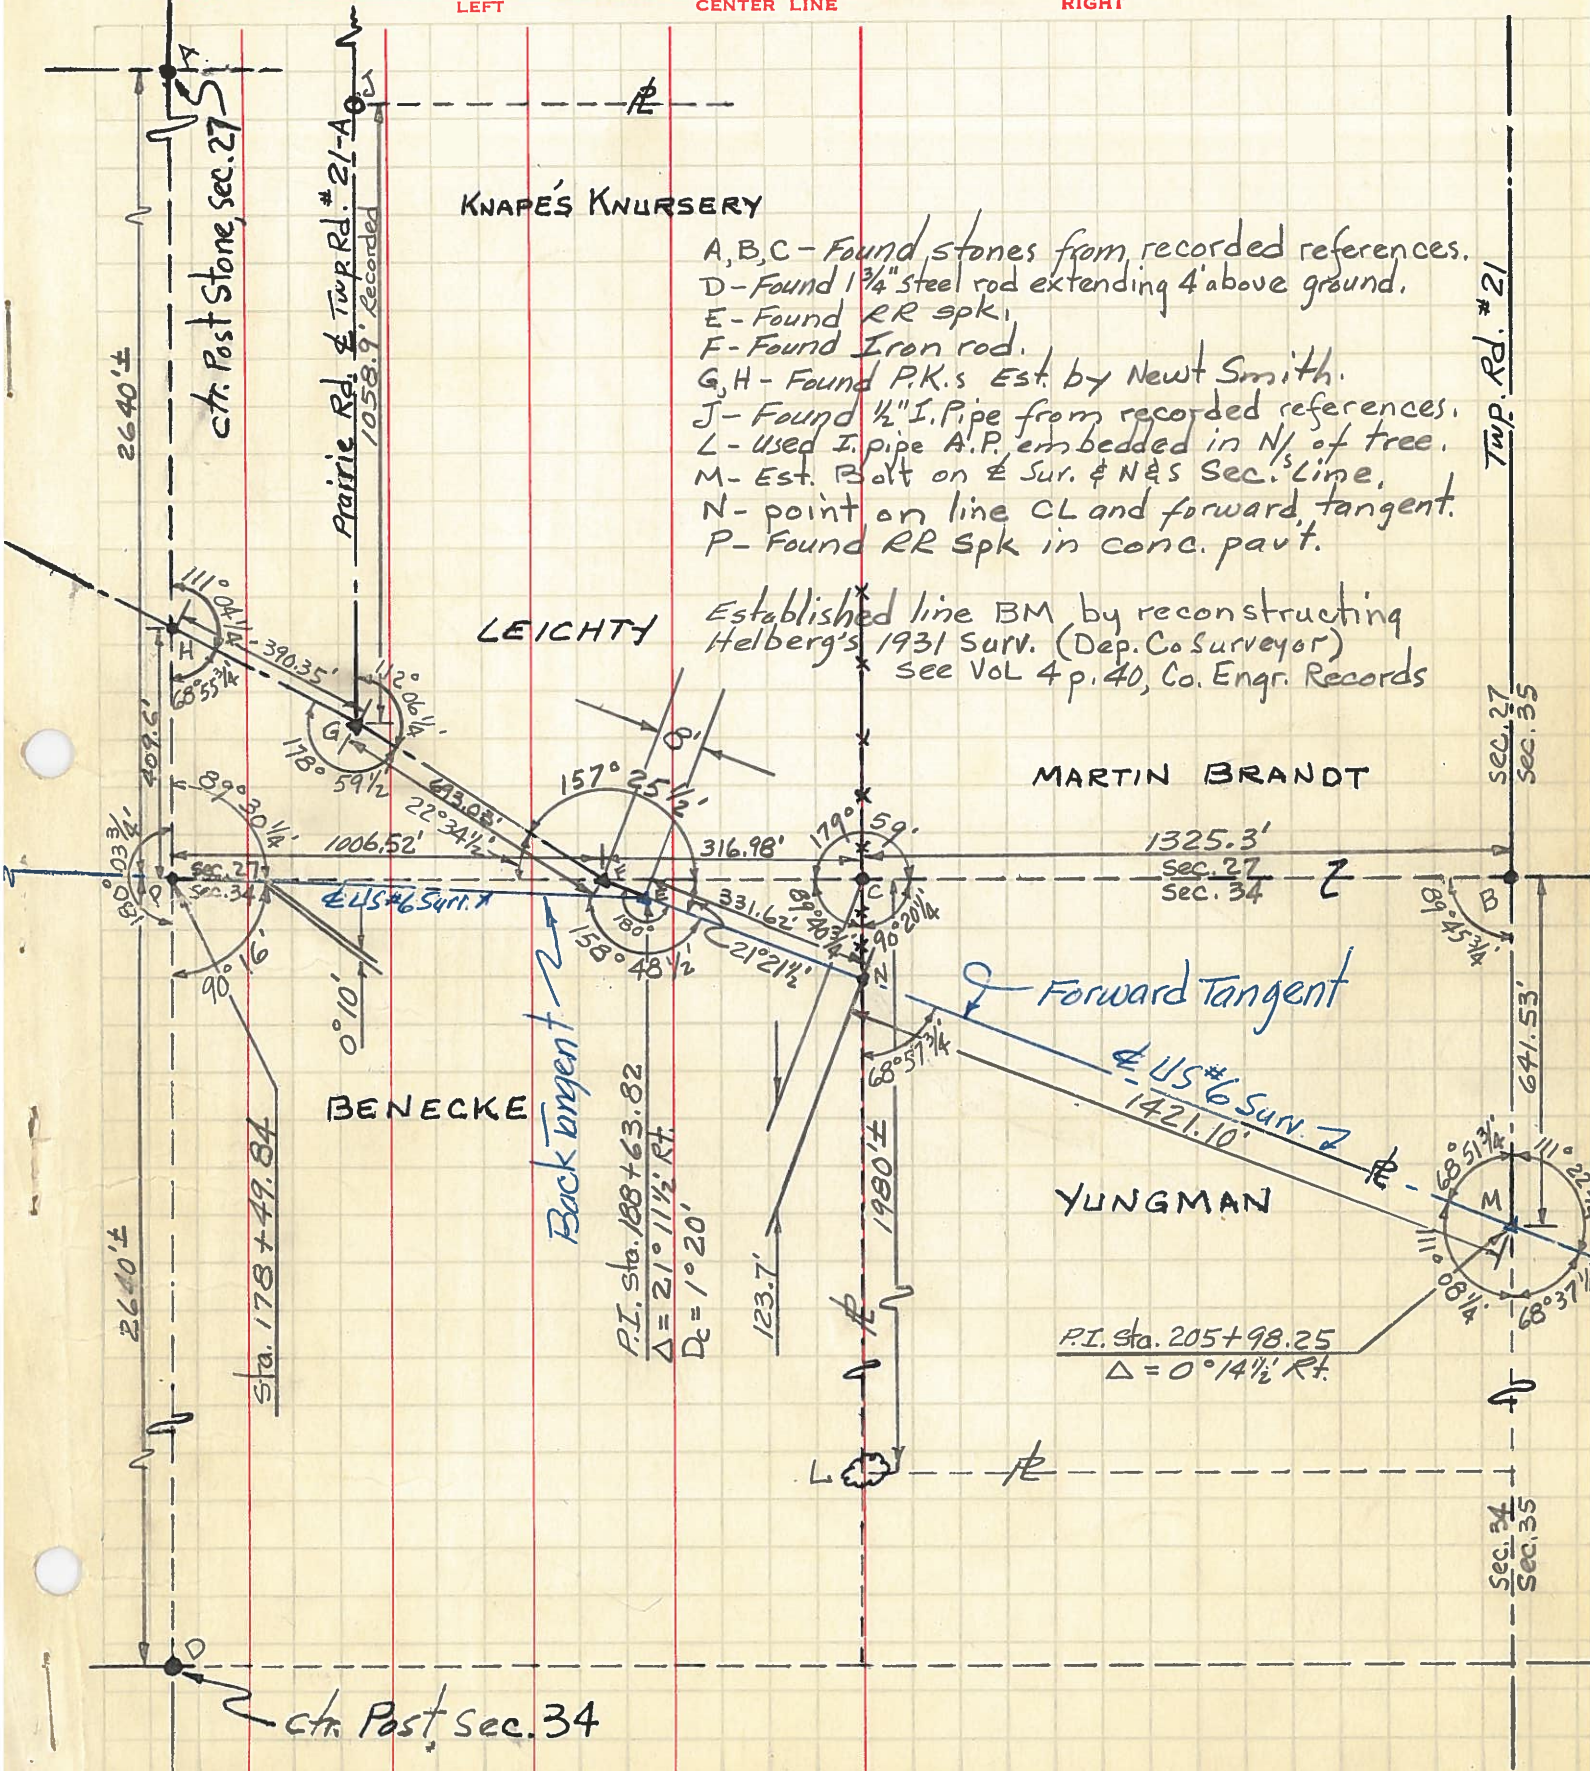

PERSONNEL TITLE PERSONNEL TITLE

Knappe
Mohler
Germann

COUNTY Henry

DATE August 11, 1960

S. R. U.S. 6

WEATHER Clear

SEC. _____

TEMP. 80°

DESCRIPTION


LEFT

CENTER LINE

RIGHT


JOB NO. _____

(10)

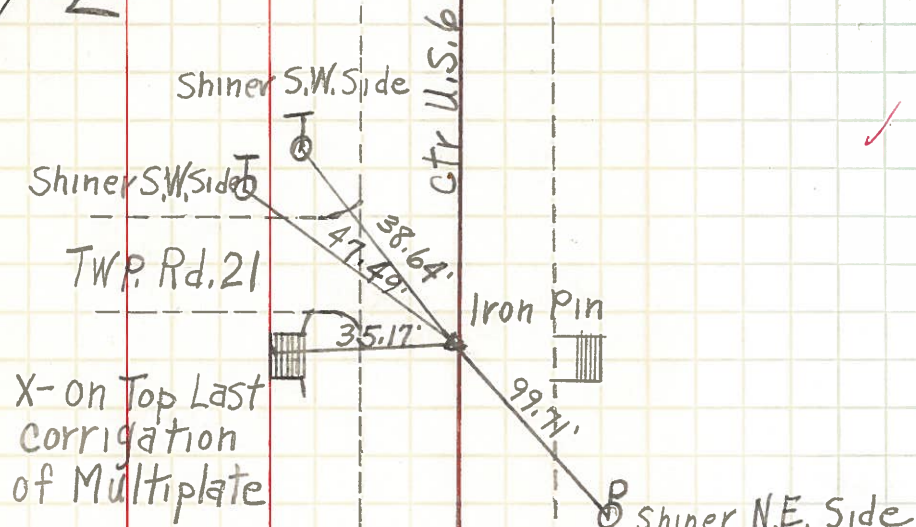

Intersection Twp. Rd. 21 and U.S. 6 Set R.R. SpK. 10/24/60

(24)

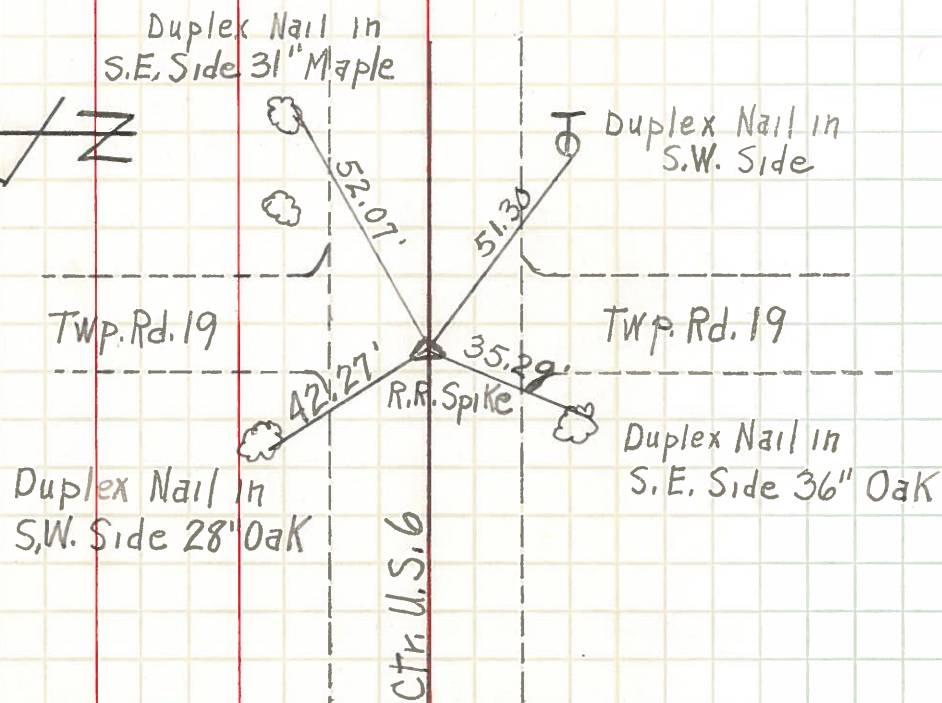

Intersection Twp. Rd. 19 and U.S. 6 Set R.R. SpK. 10/24/60

PERSONNEL	TITLE	PERSONNEL	TITLE	COUNTY	DATE
Louys				He	2-8-52
Beach				S. R.	284 & 6
Passafium				SEC.	
Hoover H & R.					WEATHER
					TEMP.

DESCRIPTION _____ JOB NO. _____

