

O.D.O.T. DISTRICT 2 SURVEY OFFICE (USE ONLY)

PERSONNEL

REFERENCE NO. 4

SHEET 6 OF 29

NOTES MOSER

DATE 9/9/09

ROUTE SR 18

H.C. GOLDBERG

WEATHER CLOUDY

COUNTY HENRY

R.C. MOSER

TEMP. 80°

TOWNSHIP FLATROCK

SECTION 32

DWG BY NIESE PID NO PID

T 4 N R 6 E

TYPE MONUMENT P.K./WASHER

ON SURFACE - ~~BELOW~~ ON

OFFSET CL PAVEMENT 7.3' ~~LT~~ : RT

2.5' TO RT EDGE PAVEMENT


STATION: 74+67

HORZ.DATUM: NAD83(2011)


GEOID: 2012A

GRID: NORTHING: 582547.464

EASTING: 1501002.843

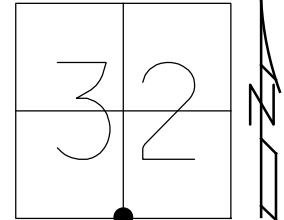

RECORD:  
FOUND 5/8" IPIPE 3" DOWN  
FOUND STONE 16" DOWN  
SET P.K.NAIL  
1976  
FD P.K./WASHER  
SV105  
9/9/09, KPM  
SET MAG/WASHER  
10/6/09  
FD MAG/WASHER  
REF4  
8/6/19, JFO

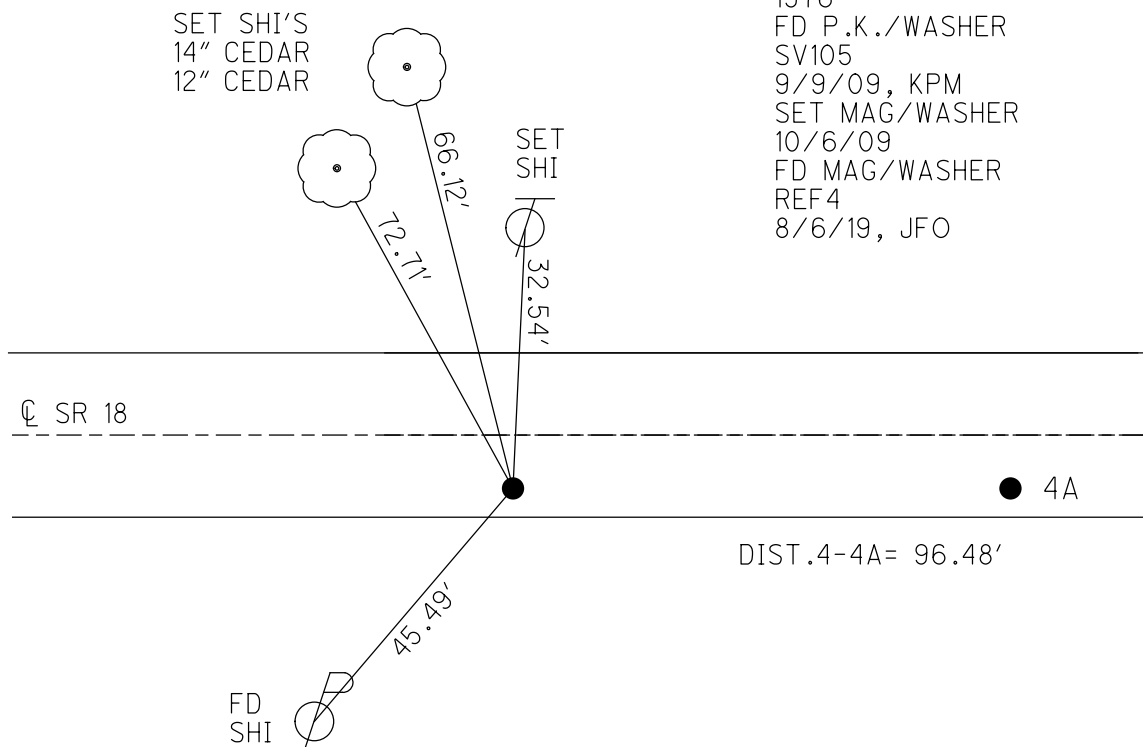


# O.D.O.T. DISTRICT 2 SURVEY OFFICE

|                      |                        |                                    |
|----------------------|------------------------|------------------------------------|
| PERSONNEL            | REFERENCE NO. <u>4</u> | SHEET <u>6</u> OF <u>29</u>        |
| NOTES <u>MOSER</u>   | DATE <u>9-9-09</u>     | ROUTE <u>SR 18</u>                 |
| H.C. <u>GOLDBERG</u> | WEATHER <u>CLOUDY</u>  | COUNTY <u>HENRY</u>                |
| R.C. <u>MOSER</u>    | TEMP. <u>+80°</u>      | TOWNSHIP <u>Flatrock- Pleasant</u> |
|                      |                        | SECTION <u>32 - 5</u>              |


TYPE MONUMENT PK WASHERS  
 ON SURFACE - ~~BELOW~~ YES  
~~LEFT - C PAV'T~~ - RIGHT 7.3'  
2.5' TO RT EDGE PAVEMENT  
 S.L.M. 74 + 67 (SV 105)

T 4 N R 6 E  
3

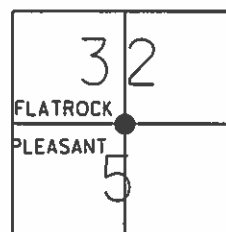

Grid: Northing: 582547.433 Easting: 1501002.786

Record: S1/4 section 32 Flatrock  
 Found 5/8" i-pipe 3" deep. Found stone 16" deep.  
 Placed P.K. at surface overpipe Henry Co. 1976  
 Set Mag/Washer 10-6-09

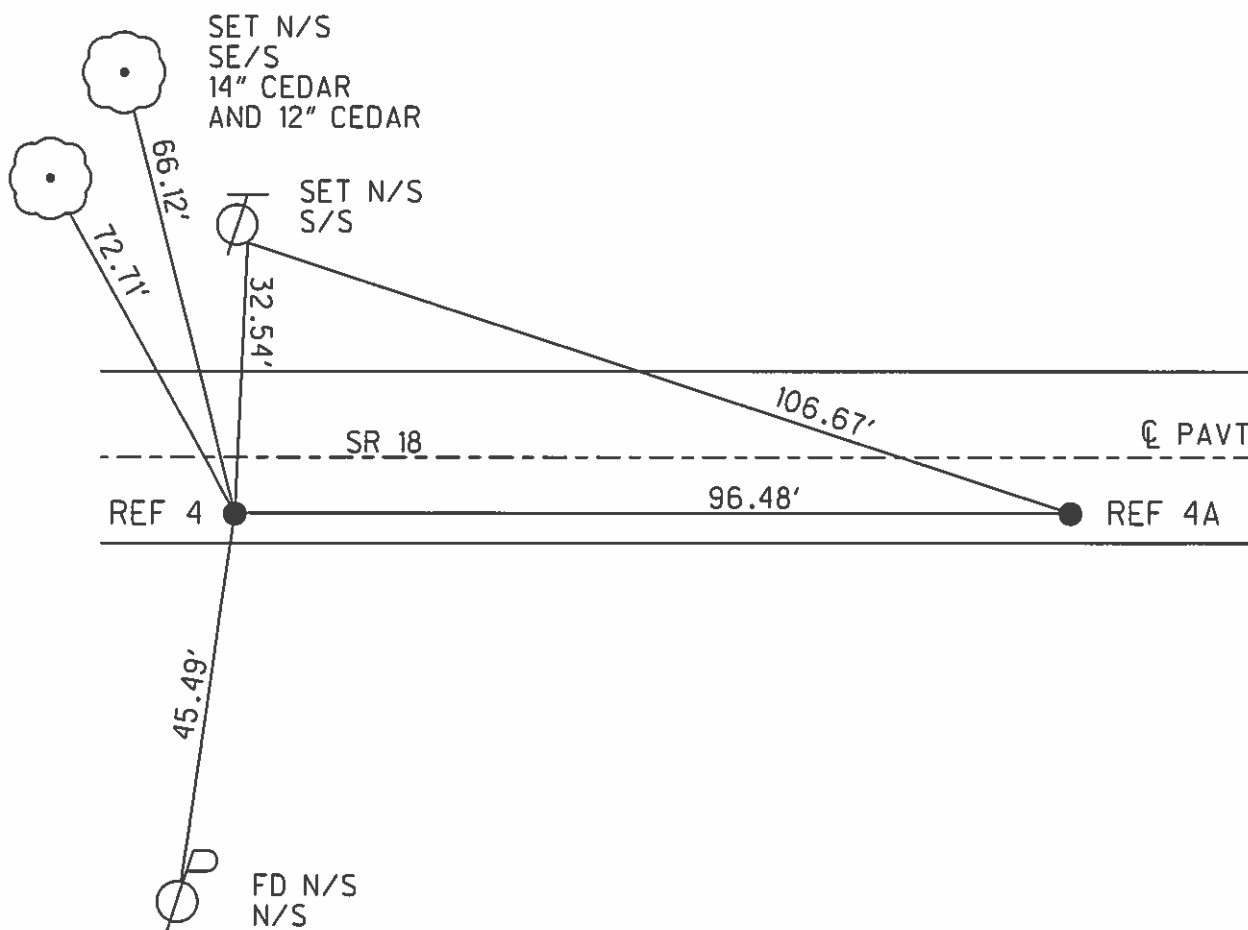

# O.D.O.T. DISTRICT 2 SURVEY OFFICE

PERSONNEL

REFERENCE NO. 4-4A

SHEET 4 OF 11

NOTES YAW RUSEN

H.C. HUSS

R.C. MOSEER

DATE 5-30-95

WEATHER CLOUDY

TEMP. +55°F

ROUTE SR-18

COUNTY Henry

TOWNSHIP Flat Rock-Pleasant

SECTION 32 - 5

T 4 N 6 R 3 E


TYPE MONUMENT PK & WASHERS

ON SURFACE - BELOW YES


LEFT- & PAV'T. - RIGHT SEE BELOW

SEE TO BELOW EDGE PAVEMENT

S.L.M. 74 + 67 - 75 + 63

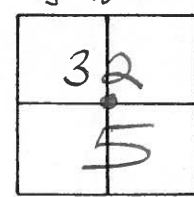

SET PK & WASHERS  
8-28-95  
BVD

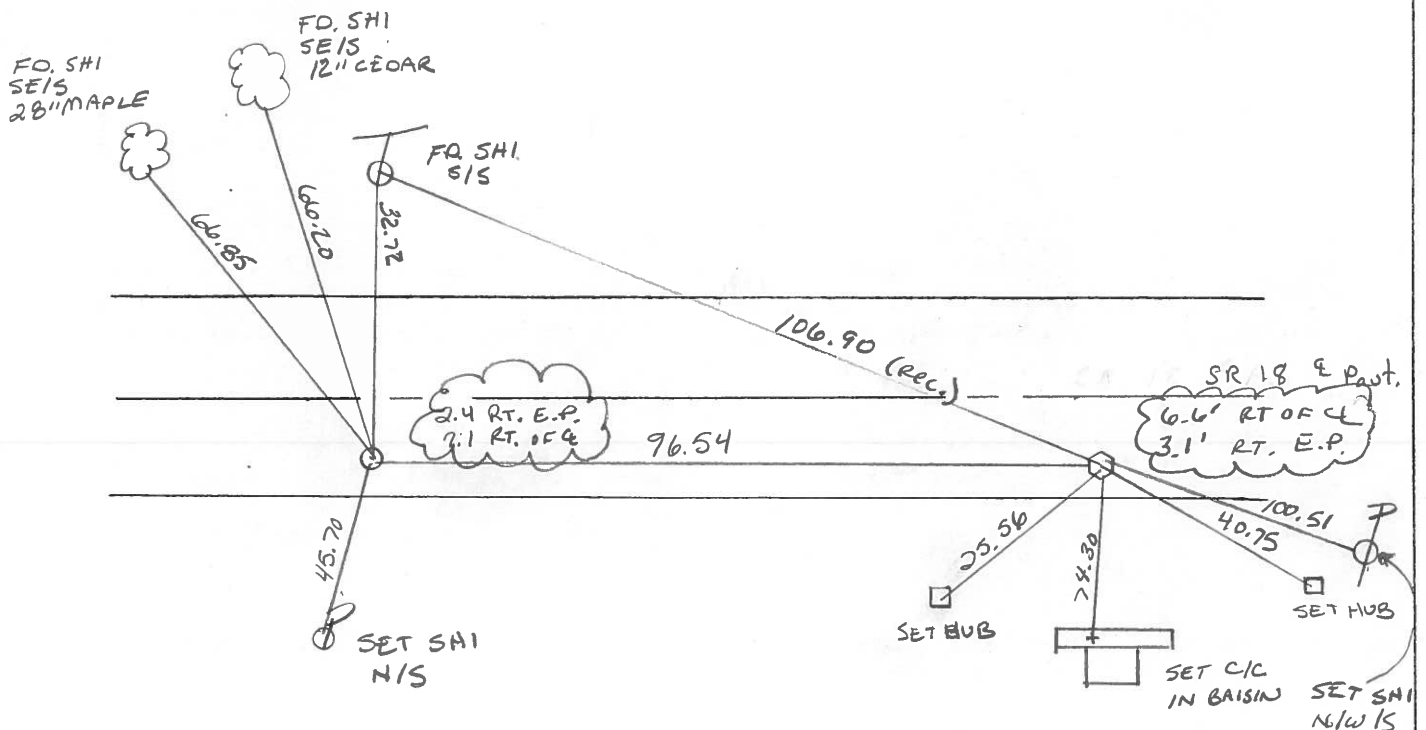

Record:

S 1/4 Sec 32 Flatrock  
Found 5/8" I Pipe 3" deep  
Found Stone 16" Deep  
Placed P.K. @ surface over pipe  
Henry Co. 1976

Record:

N 1/4 Sec 5 Pleasant  
Placed RR spk. over stones  
First Stone 4" deep  
Second Stone 14 1/2" deep  
Henry Co. 1976

# O.D.O.T. DISTRICT 2 SURVEY OFFICE

PERSONNEL

REFERENCE NO. 4 - 4A

SHEET      OF     

NOTES BARNHISEL

H.C. Loehrke

R.C. SOCKMAN

DATE Aug 11, 1986

WEATHER SUNNY

TEMP. +75°


ROUTE SR 18

COUNTY HENRY

TOWNSHIP FLAT ROCK - PLEASANT

SECTION 32 - 5

T. 4 N. R 6 E.  
T. 3 N.

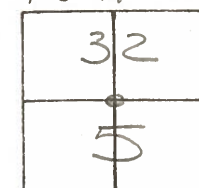

TYPE MONUMENT Sm RR Spk


ON SURFACE - BELOW 1"

LEFT & PAV'T. - RIGHT 6.6 - 6.0'

2.5 TO RT EDGE PAVEMENT

S.L.M. 74 + 59 - 75 + 55

Set Sm RR Spk's  
6-10-87  
MOB

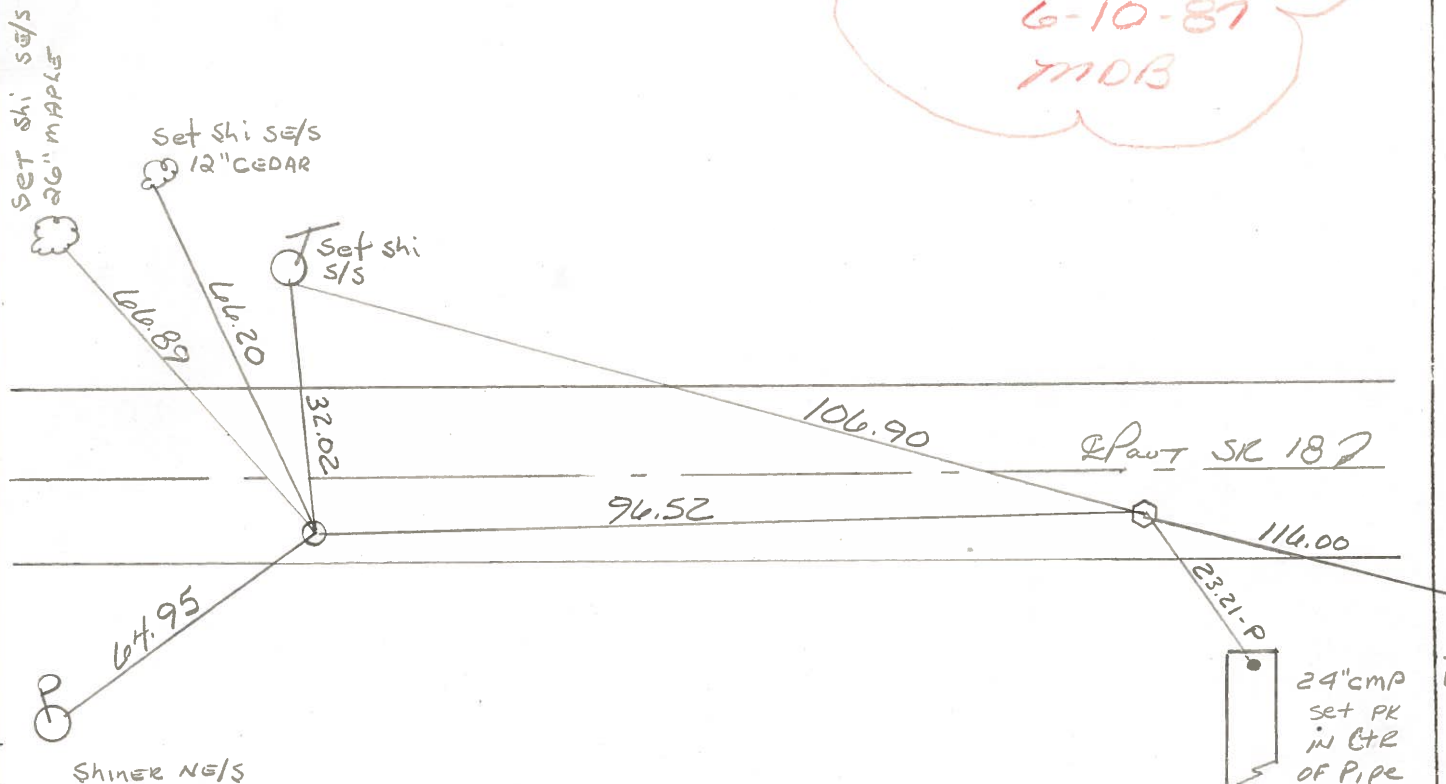

RECORD:

S 1/4 SEC 32 FLAT ROCK

FOUND 5/8" I. PIPE 3" DEEP

FOUND STONE 16" DEEP

PLACED P.K. @ SURFACE OVER PIPE

HENRY COUNTY 1976

RECORD:

N 1/4 SEC 5 PLEASANT

PLACED R.R. SPK OVER STONE

FIRST STONE 4" DEEP

SECOND STONE 14 1/2" DEEP

HENRY COUNTY 1976

# HENRY COUNTY ENGINEER'S OFFICE CORNER STONE RECOVERY PROGRAM

Sht. 2 of  
S.R. 18

TOWNSHIP FLATRICK

DATE 6-17-76

SECTION 32

WEATHER WARM & CLEAR

T 4 N, R 6 E

TEMP                     


PERSONNEL J.G.

B.B.

M.S.

S.S.

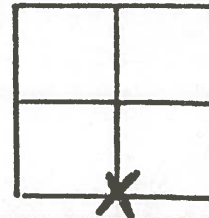


3 4-4A



26" Maple  
Nail & Shiner

Nail & shiner  
SE/S

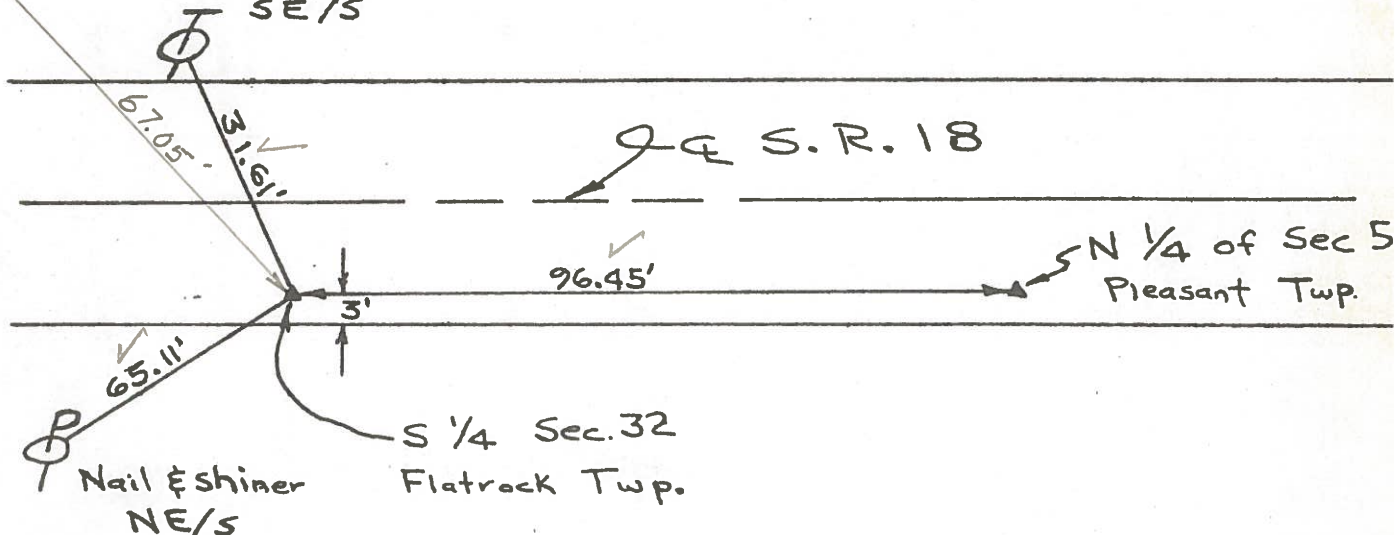

Found  $\frac{5}{8}$ "  $\phi$  Iron pipe on East side of stone angled over top center of stone. Stone is 3' north of south edge of S.R. 18. Pipe is 3" deep and stone is 16" deep. Placed P.K. nail over pipe. Also placed P.K. nails 6' N & 6' W. Stone lies 96.45' west of Pleasant Twp stone.

Copied:

Painted: 8-76

From ... 0 30

# HENRY COUNTY ENGINEER'S OFFICE CORNER STONE RECOVERY PROGRAM

Sht. 3 of  
S.R. 18

TOWNSHIP PLEASANT

SECTION 5



T3N, R6E

PERSONNEL JG  
BB  
MS  
SS

DATE 6-15-76

WEATHER CLEAR & WARM

TEMP \_\_\_\_\_

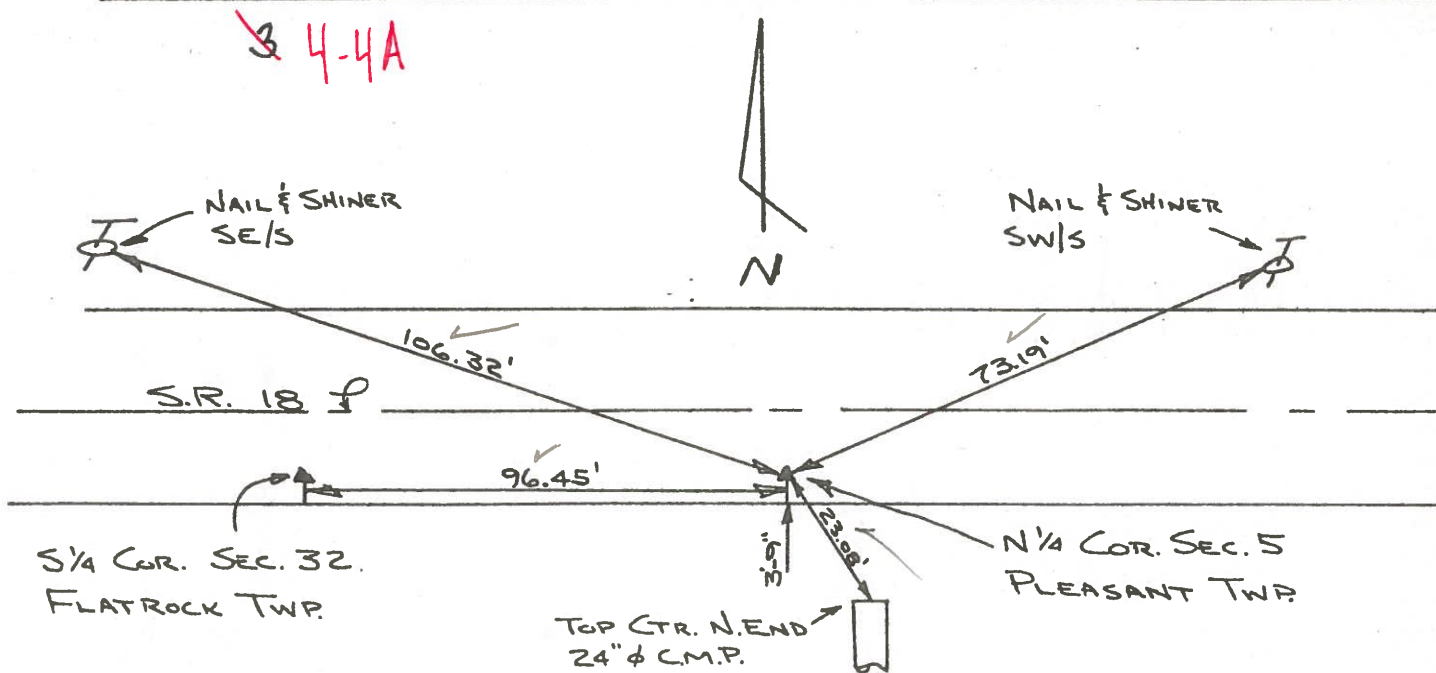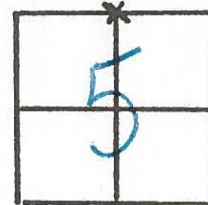

## NOTE:

FOUND P.K. & SHINER OVER CHISELED 'X' IN STONE. STONE WAS 4" DEEP AND OVER ANOTHER STONE. SECOND STONE WAS 14 1/2" DEEP. P.K. & SHINER WERE 3" S.E. OF HIGH POINT OF LOWER STONE. REMOVED TOP STONE AND PLACED CTR. PUNCH R.R. SPK. OVER STONE. STONE IS 3'-9" NORTH OF SOUTH EDGE S.R. 18. P.K.'S 6' N. & 6' E.

Copied:

Painted: 8-76

Form CSR-1 9-76

| PERSONNEL   | TITLE | PERSONNEL   | TITLE | COUNTY                       | DATE        | WEATHER          | TEMP. |
|-------------|-------|-------------|-------|------------------------------|-------------|------------------|-------|
| W. Denno    |       |             |       | Henry                        | July 30, '7 | Warm             | 80° ± |
| R. Michglok |       |             |       | S. R.                        | 18          |                  |       |
| D. Curtis   |       |             |       | SEC.                         |             |                  |       |
| DESCRIPTION |       |             |       | References To Control Points |             | JOB NO. 02999(0) |       |
| LEFT        |       | CENTER LINE |       | RIGHT                        |             |                  |       |

