

O.D.O.T. DISTRICT 2 SURVEY OFFICE (USE ONLY)

PERSONNEL

REFERENCE NO. 9

SHEET 16 OF 29

NOTES MOSER DATE 9/10/09

H.C. GOLDBERG WEATHER SUNNY

R.C. PIETKOWSKI TEMP. 75°

ROUTE SR 18

COUNTY HENRY

TOWNSHIP FLATROCKSECTION 35

DWG BY NIESE PID NO PID

T_4_N R_6_E

TYPE MONUMENT P.K./WASHER

ON SURFACE - ~~BELOW~~ ON _____

OFFSET @ PAVEMENT 3.0' ~~LT~~ : RT


7.0' TO RT EDGE PAVEMENT

STATION: 207+80

HORZ.DATUM: NAD83(2011)

GEOID: 2012A

GRID: NORTHING: 582388.474

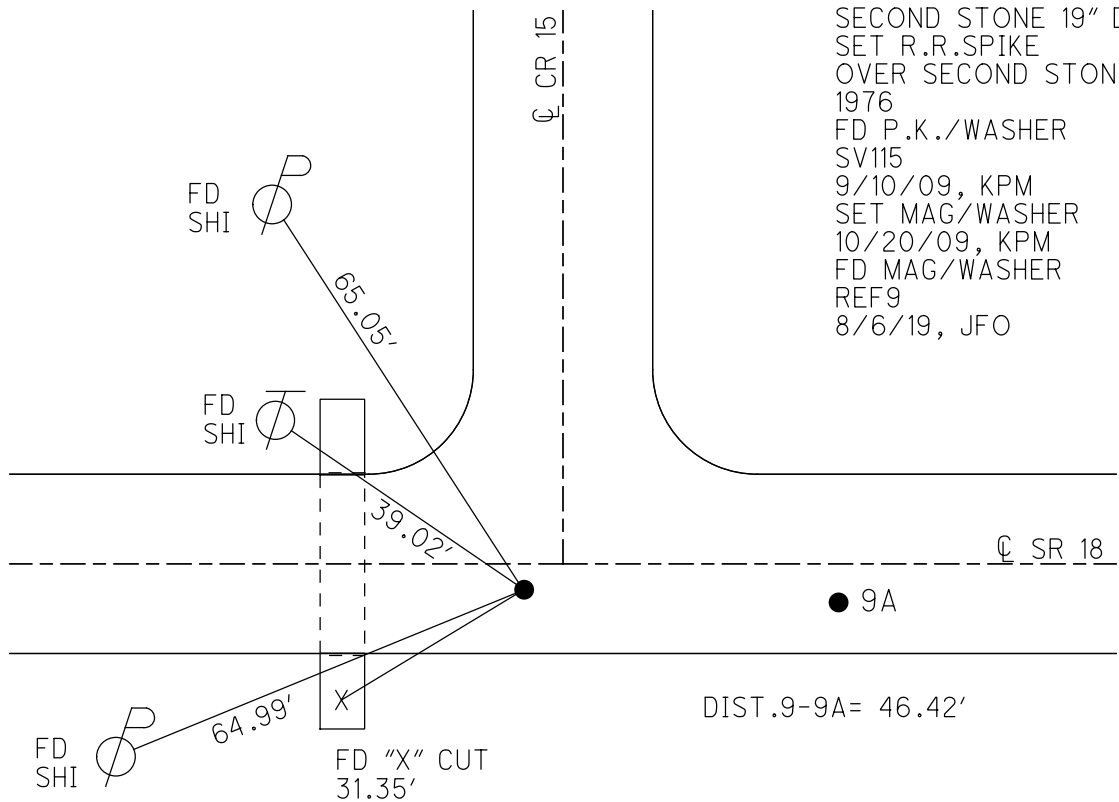EASTING: 1514269.530

RECORD:

FD 2 STONES

FIRST STONE 6" DOWN

SECOND STONE 19" DOWN

SET R.R.SPIKE

OVER SECOND STONE

1976

FD P.K./WASHER

SV115

9/10/09, KPM

SET MAG/WASHER

10/20/09, KPM

FD MAG/WASHER

REF9

8/6/19, JFO

O.D.O.T. DISTRICT 2 SURVEY OFFICE (USE ONLY)

PERSONNEL

REFERENCE NO. 9

SHEET 16 OF 29

NOTES

MOSER

DATE 09-10-09

ROUTE SR 18

H.C.

GOLDBERG

WEATHER SUNNY

COUNTY HENRY

R.C.

PIETKOWSKI

TEMP. +75°

TOWNSHIP PLEASANT

SECTION 35-2

T 4 N R 6 E


TYPE MONUMENT PK/WASHER

ON SURFACE - ~~BELOW~~ ON SURFACE

~~LEFT - C PAV'T~~ - RIGHT 3.0'

7.0' TO RT. EDGE PAVEMENT


S.L.M. 207+80 (SV115)

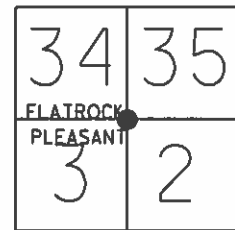

Grid: Northing: 582388.339 Easting: 1514269.463

Record: Fd. 2 stones First
6" deep second 19" deep placed
R.R. spk at surface over second stone
Henry Co. 1976. SW Cor Sec 35 flatrock twp.

SET MAG/WASHER
10-20-09 KPM

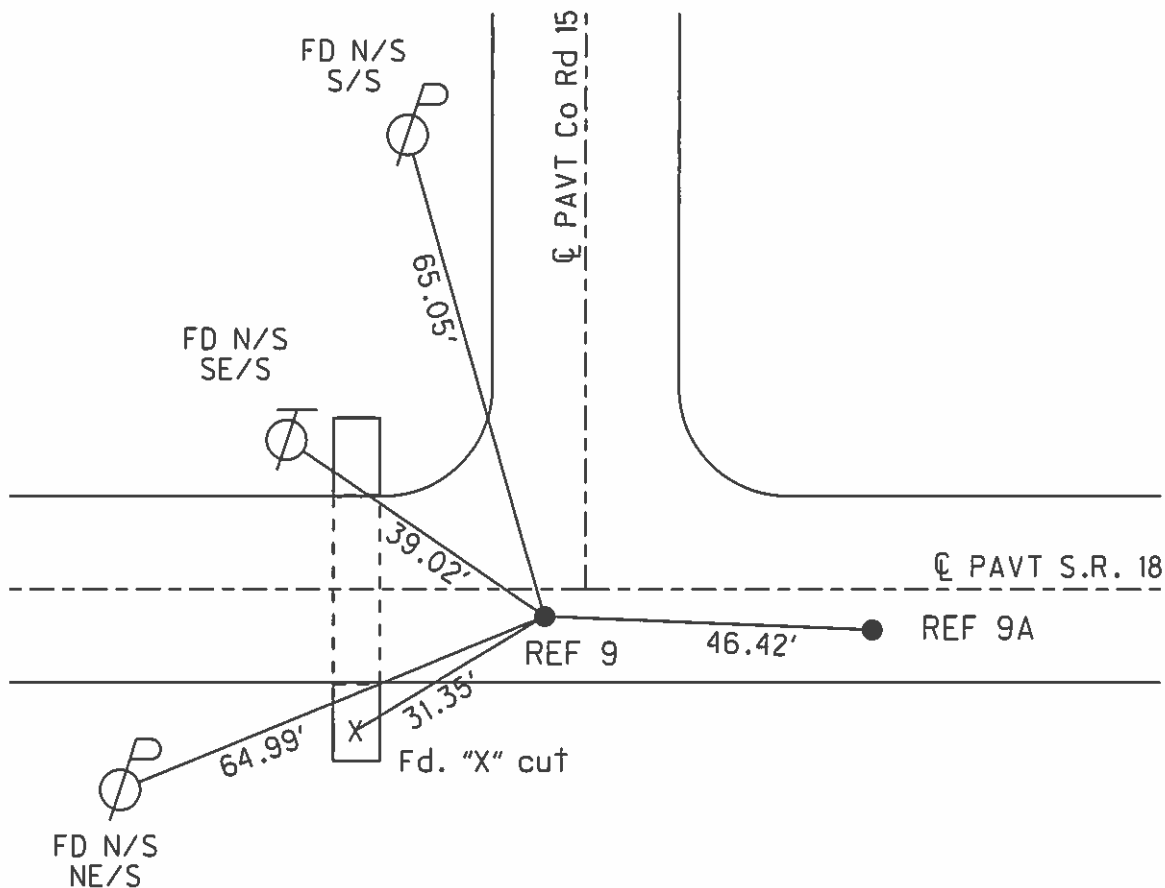

O.D.O.T. DISTRICT 2 SURVEY OFFICE

PERSONNEL

REFERENCE NO. 9-9A

SHEET 9 OF 11

NOTES Huss

H.C. VANDUSEN

R.C. HUSS

DATE 6-1-95

WEATHER CLOUDY / DRIZZLE

TEMP. +65° F

ROUTE SR 18

COUNTY HENRY

TOWNSHIP FLAT ROCK - PLEASANT

SECTION 35 - 2

T4 NR 6 E

T3N



TYPE MONUMENT PK'S WASHERS

ON SURFACE - ~~BELOW~~ yes - yes

~~LEFT - C~~ PAW T. - RIGHT 3.3' ~ 3.4'

5.8 TO ^{RT}RT EDGE PAVEMENT

S.L.M. 207 + 80 ~ 208 + 27

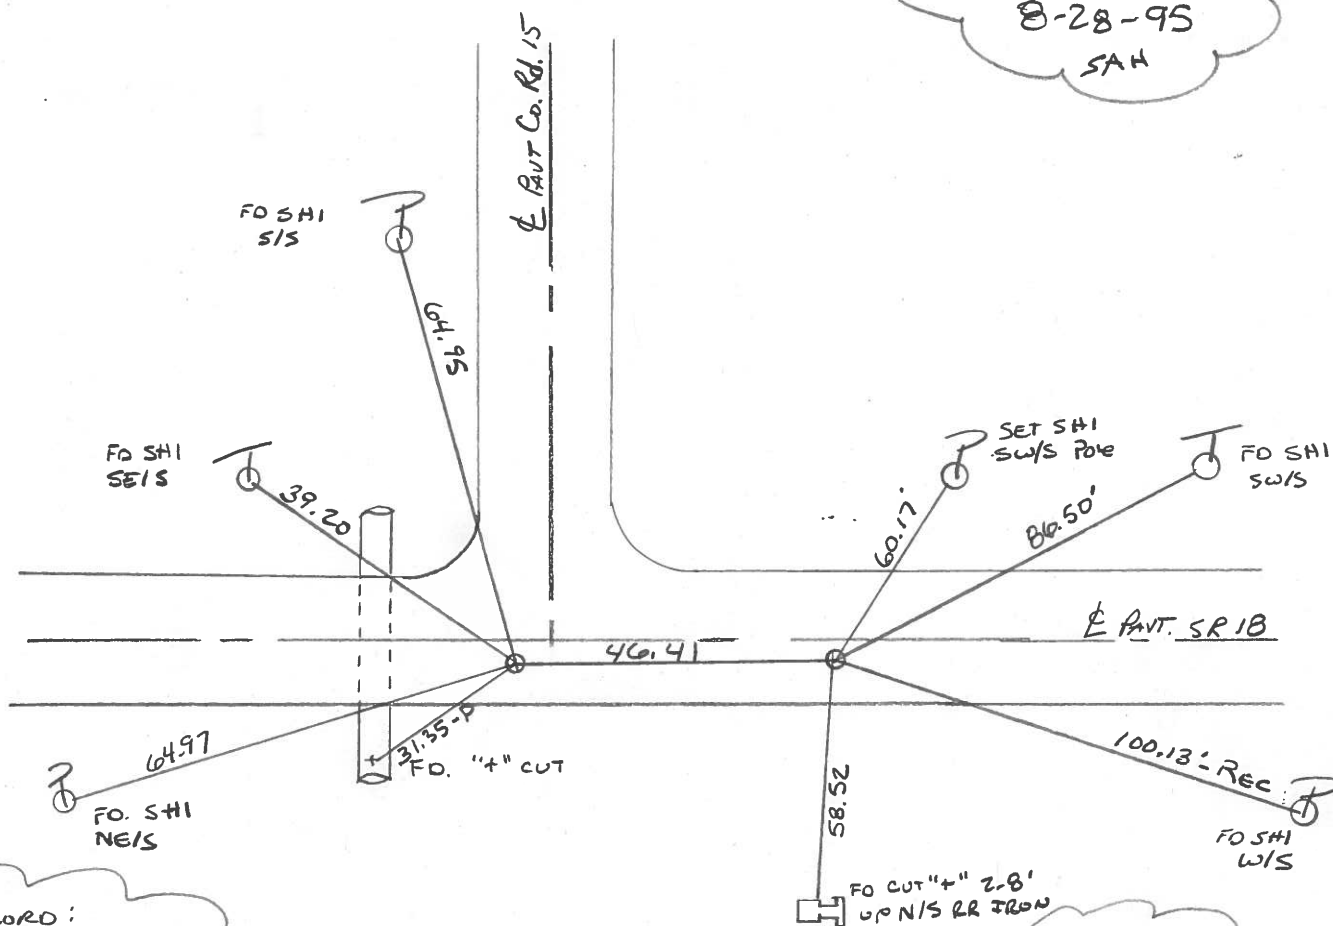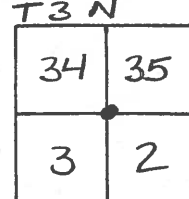

RECORD:

FD. 2 STONES
FIRST 6" DEEP
SECOND 19" DEEP
PLAID R.R. SPK @
SURFACE OVER SECOND STONE
HENRY COUNTY 1976
SW COR SEC. 35
FLAT ROCK TWP

RECORD

N.W. COR SEC 2
PLEASANT TWP
Fd. 5/8" I. PIPE OVER STONE
STONE IS 18" DEEP
PLACED R.R. SPIKE OVER
STONE
HENRY CO. 1976

O.D.O.T. DISTRICT 2 SURVEY OFFICE

PERSONNEL

REFERENCE NO. 9-9A

SHEET OF

NOTES BARNHISEN

H.C. Loehrke

R.C. SOCKMAN

DATE Aug 12, 1986

WEATHER SUNNY

TEMP. +82°

ROUTE SR 18

COUNTY HENRY

TOWNSHIP FLATROCK - PLEASANT

SECTION 35 - 2

T4 N R 6 E
T3 N

34	35
3	2



TYPE MONUMENT R.R. SPIKE - R.R. SPIKE


ON SURFACE - ~~BELOW~~ yes - yes

LEFT - ~~C~~ PAV'T. - RIGHT 2.8' - 2.9'

6.2' TO RT. EDGE PAVEMENT

6.0' RT. 207+55 - 208+01

S.L.M. 207+55 - 208+01

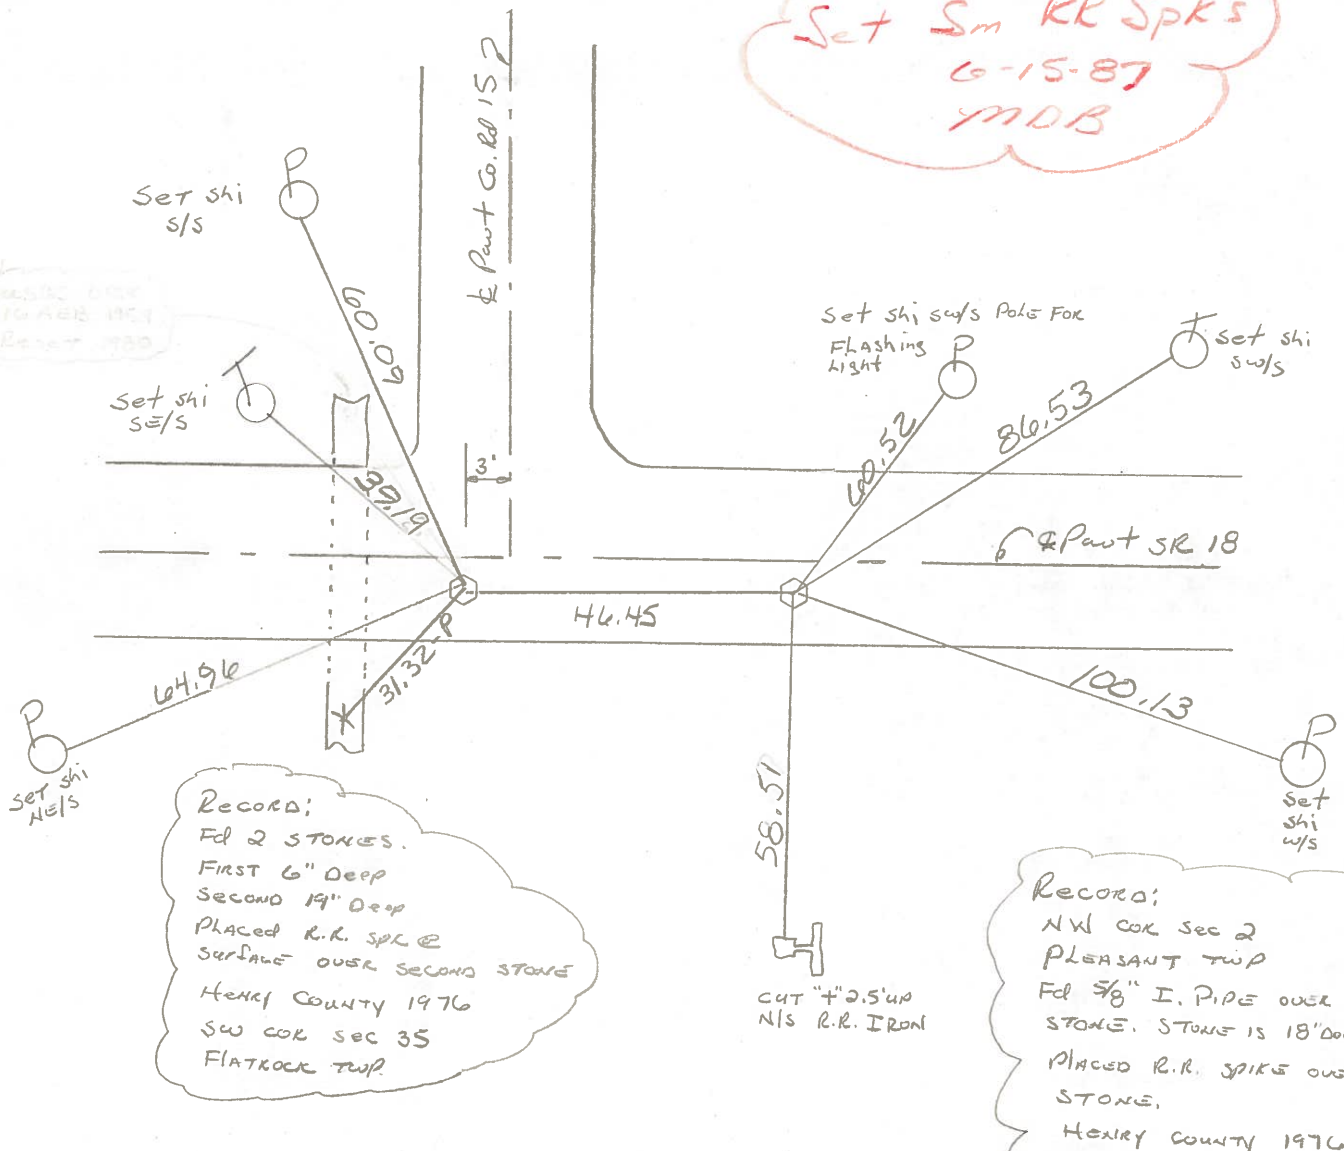

HENRY COUNTY ENGINEER'S OFFICE CORNER STONE RECOVERY PROGRAM

Sht. 3 of
SR-18

TOWNSHIP FLATROCK

DATE 6-4-76


SECTION 35

WEATHER _____

T4N, R6E

TEMP _____

PERSONNEL J.G.
B.B.
R.S.
S.S.
M.S.

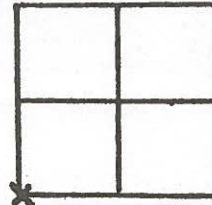

9-9A

8

Co. Rd. 15

Duplex on
5/5 of Guard Rail Posts

Nail & Shiner
on SE/5

Duplex on
N/5 G.R. Posts

Nail & Shiner
on NW/5

SR. 18

N.W. Cor of Sec. 2
Pleasant Twp.

NOTES:

Stone is 19" deep & is 2'-4" South of E SR. 18
Placed Ctr. Punched R.R. Spike over Ctr. of Stone

Found P.K. & Shiner 5" south of stone. Stone was over
another Stone, First Stone was 6" deep & badly fractured
(Removed it) Second Stone was 19" deep Stone was flat
& Ctr Punched R.R. Spike was Placed over Ctr. of Stone.


Copied:

Painted: 8-76

Form CSR-1 9-76


PERSONNEL	TITLE	PERSONNEL	TITLE	COUNTY	DATE	WEATHER	TEMP.
Stone				Henry	18 Oct. 74	Cool	70°
Denno				S. R. #18			
Michalak				SEC. Pleasant Twp.			
Curtis							

DESCRIPTION Alignment LEFT CENTER LINE RIGHT JOB NO.

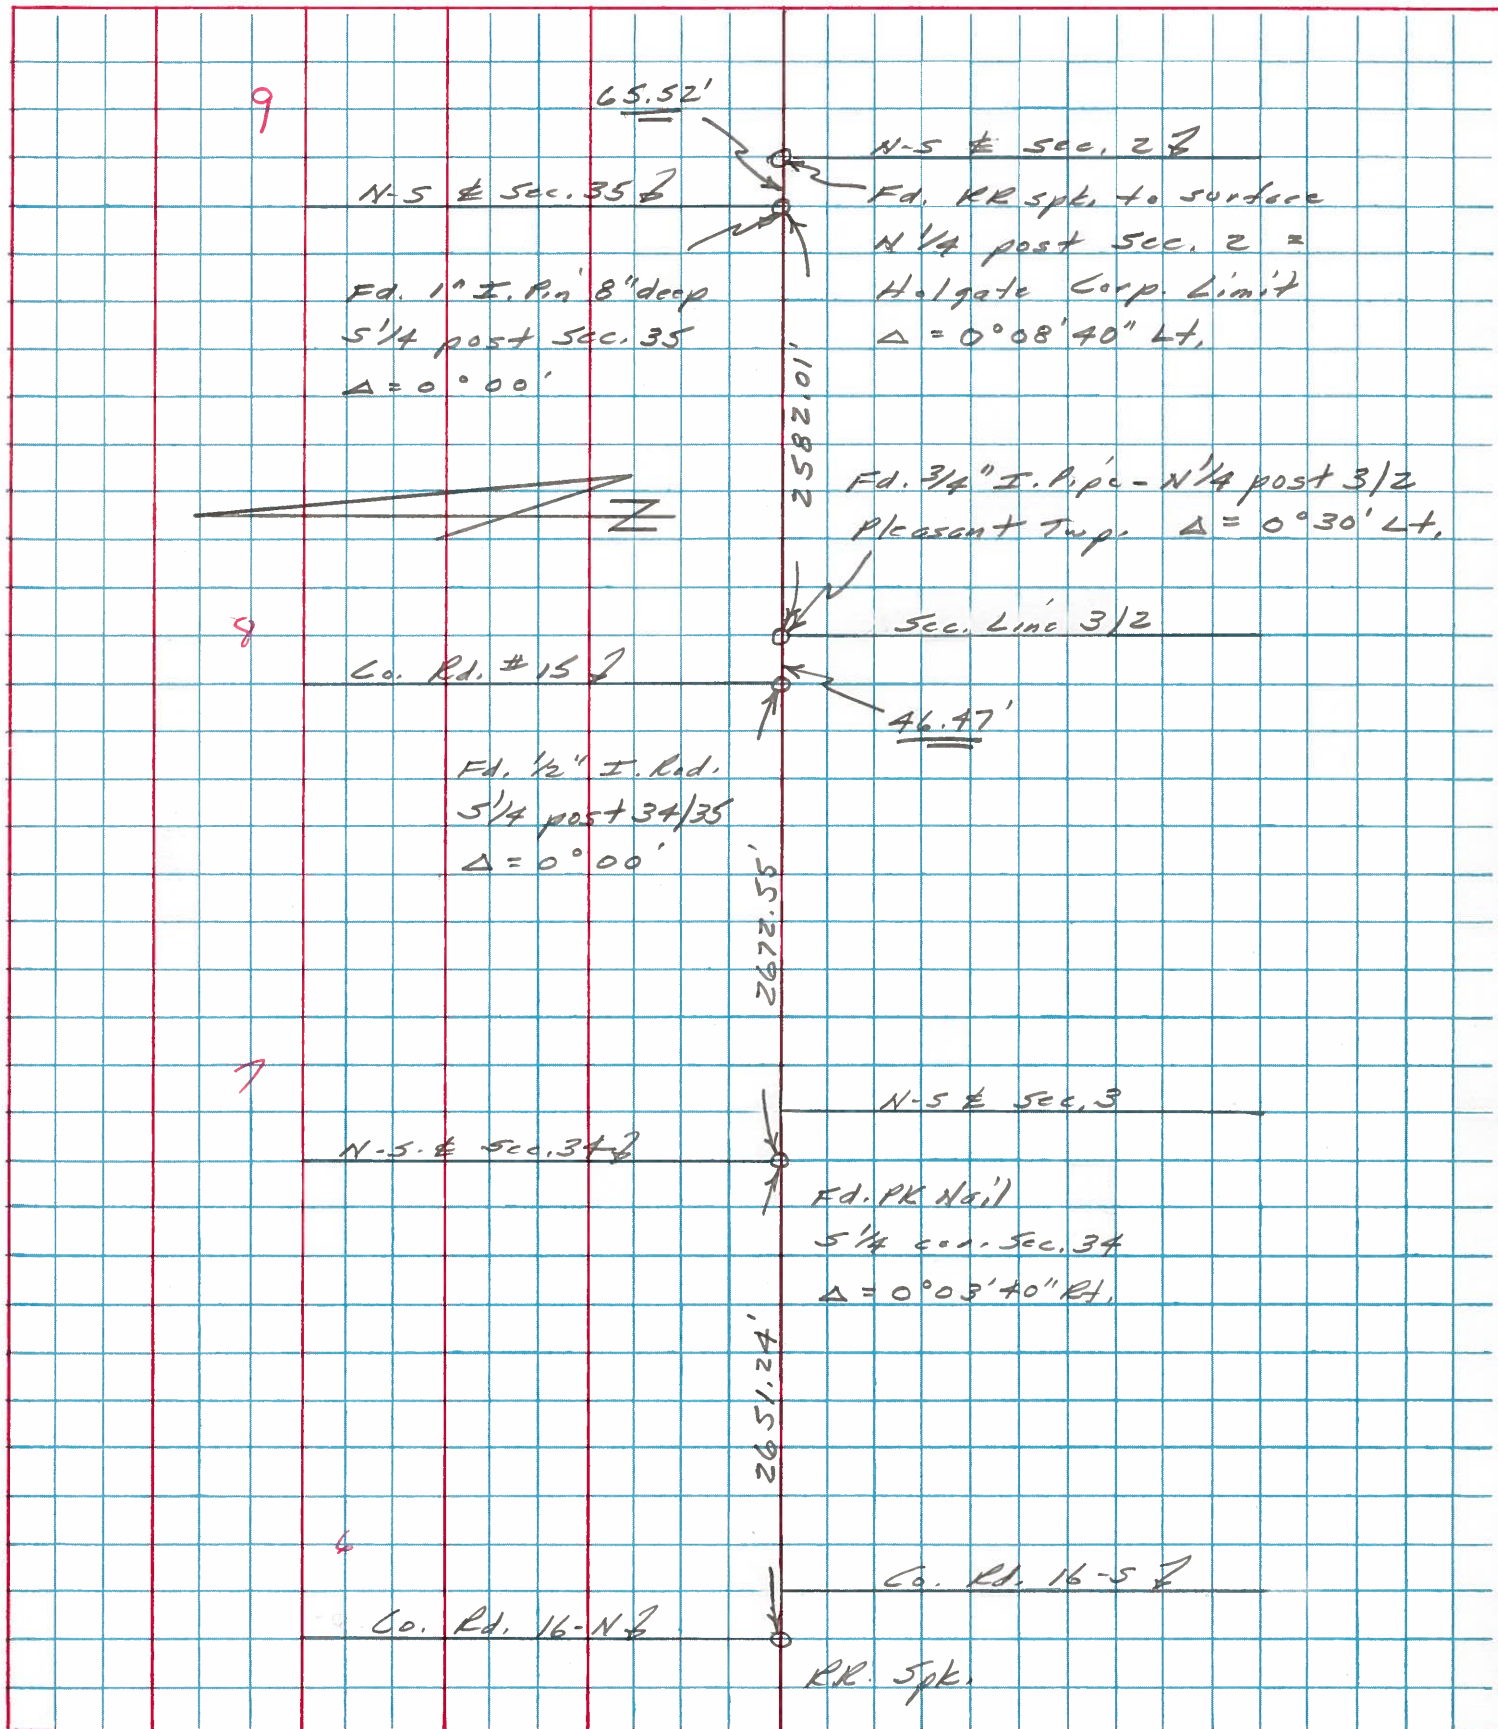

PERSONNEL	TITLE	PERSONNEL	TITLE	COUNTY	DATE	WEATHER	TEMP.
W. Denna				Henry	July 30, '74	Warm	75° F
B. Micholok				S. R.	18		
D. Curtis				SEC.			

DESCRIPTION References To Control Points JOB NO. 02999(10)

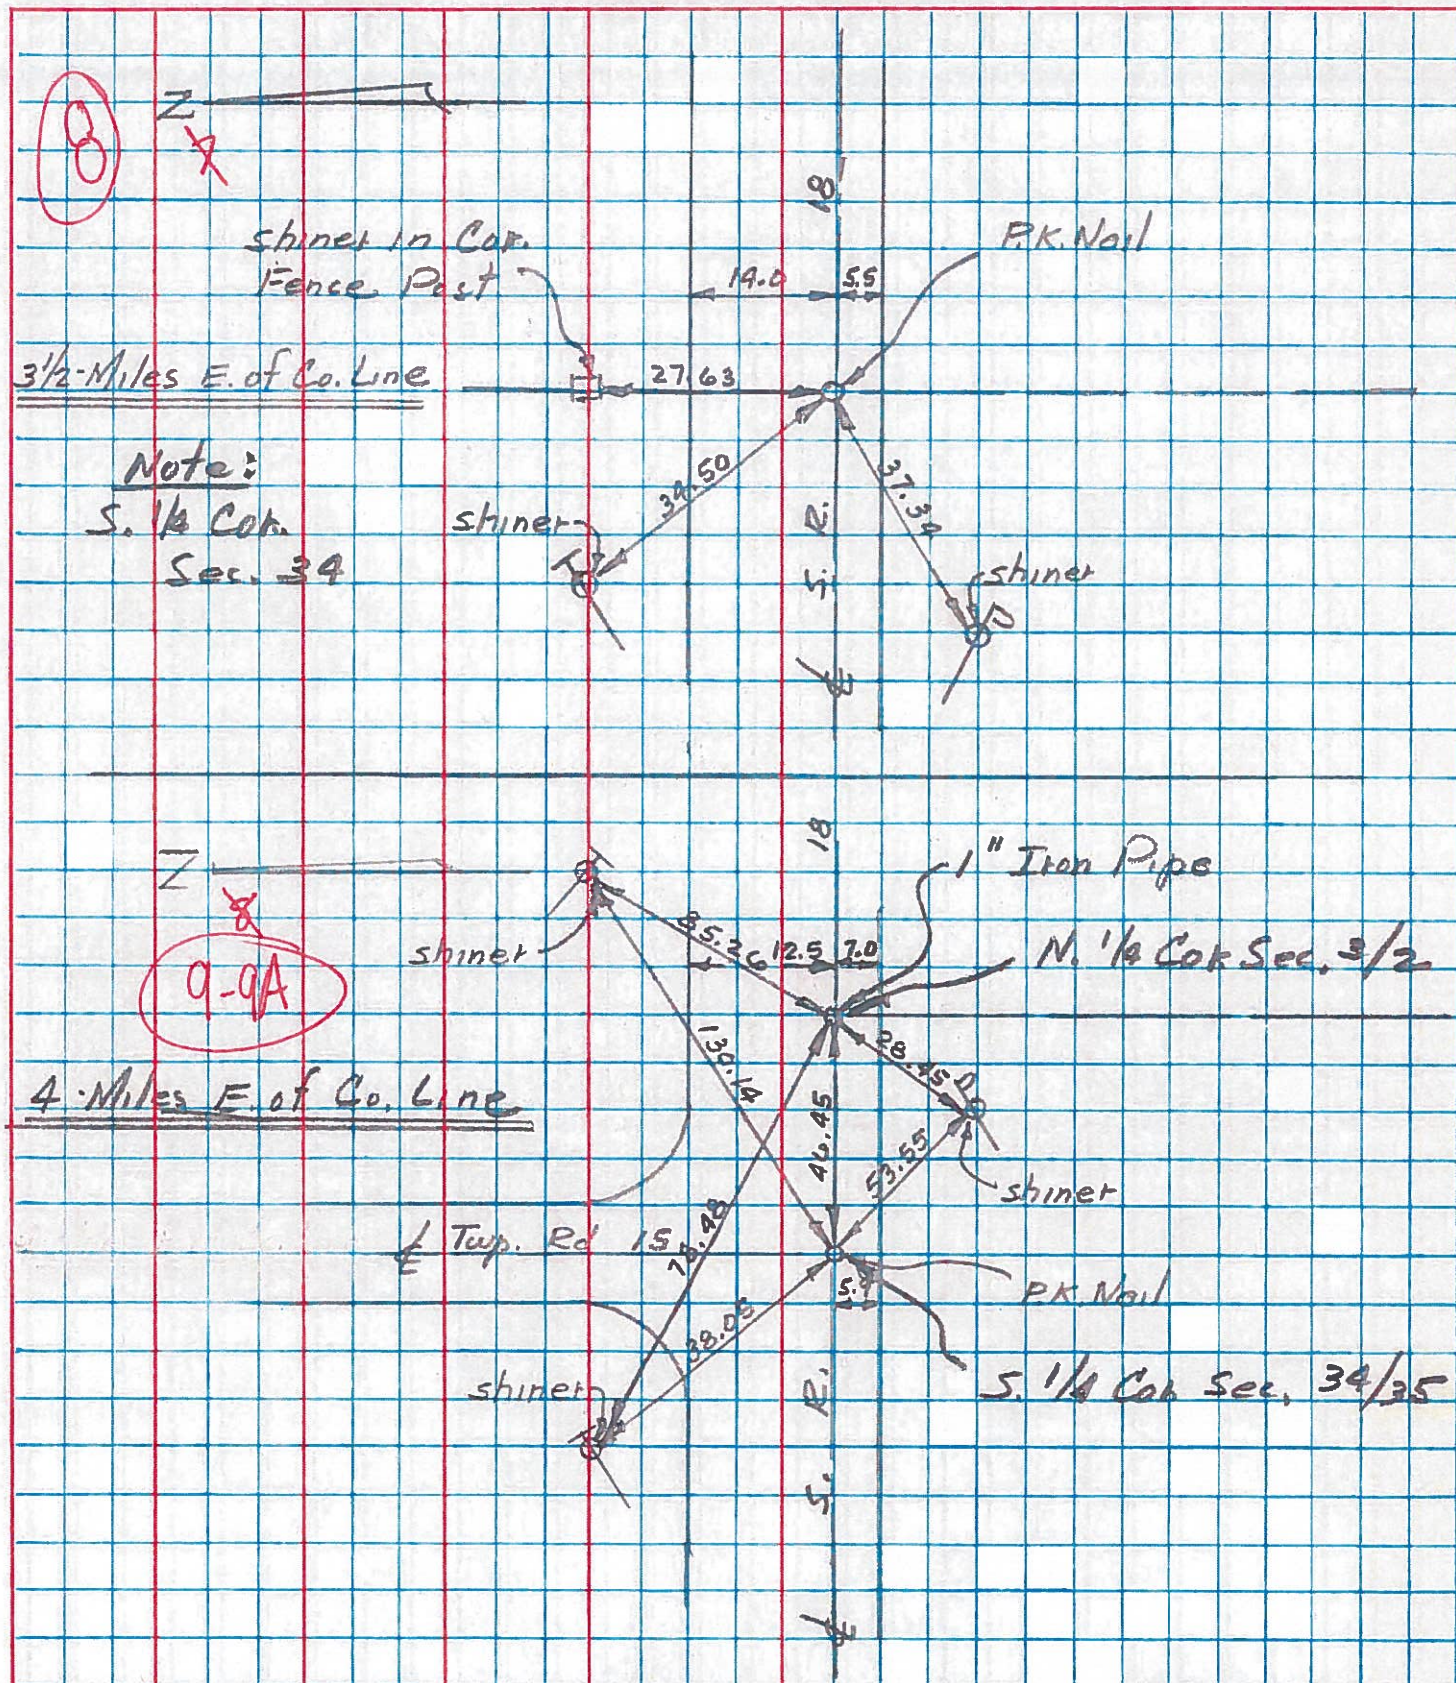

PERSONNEL	TITLE	PERSONNEL	TITLE
1	2	3	4
5	6	7	8
9	10	11	12
13	14	15	16
17	18	19	20
21	22	23	24
25	26	27	28
29	30	31	32
33	34	35	36
37	38	39	40
41	42	43	44
45	46	47	48
49	50	51	52
53	54	55	56
57	58	59	60
61	62	63	64
65	66	67	68
69	70	71	72
73	74	75	76
77	78	79	80
81	82	83	84
85	86	87	88
89	90	91	92
93	94	95	96
97	98	99	100

COUNTY HENRY DATE 1 Aug 73


S. R. 18 WEATHER

SEC. 4 & 5 Pleasant Trip TEMP

DESCRIPTION

CONTROL POINTS

ON BO

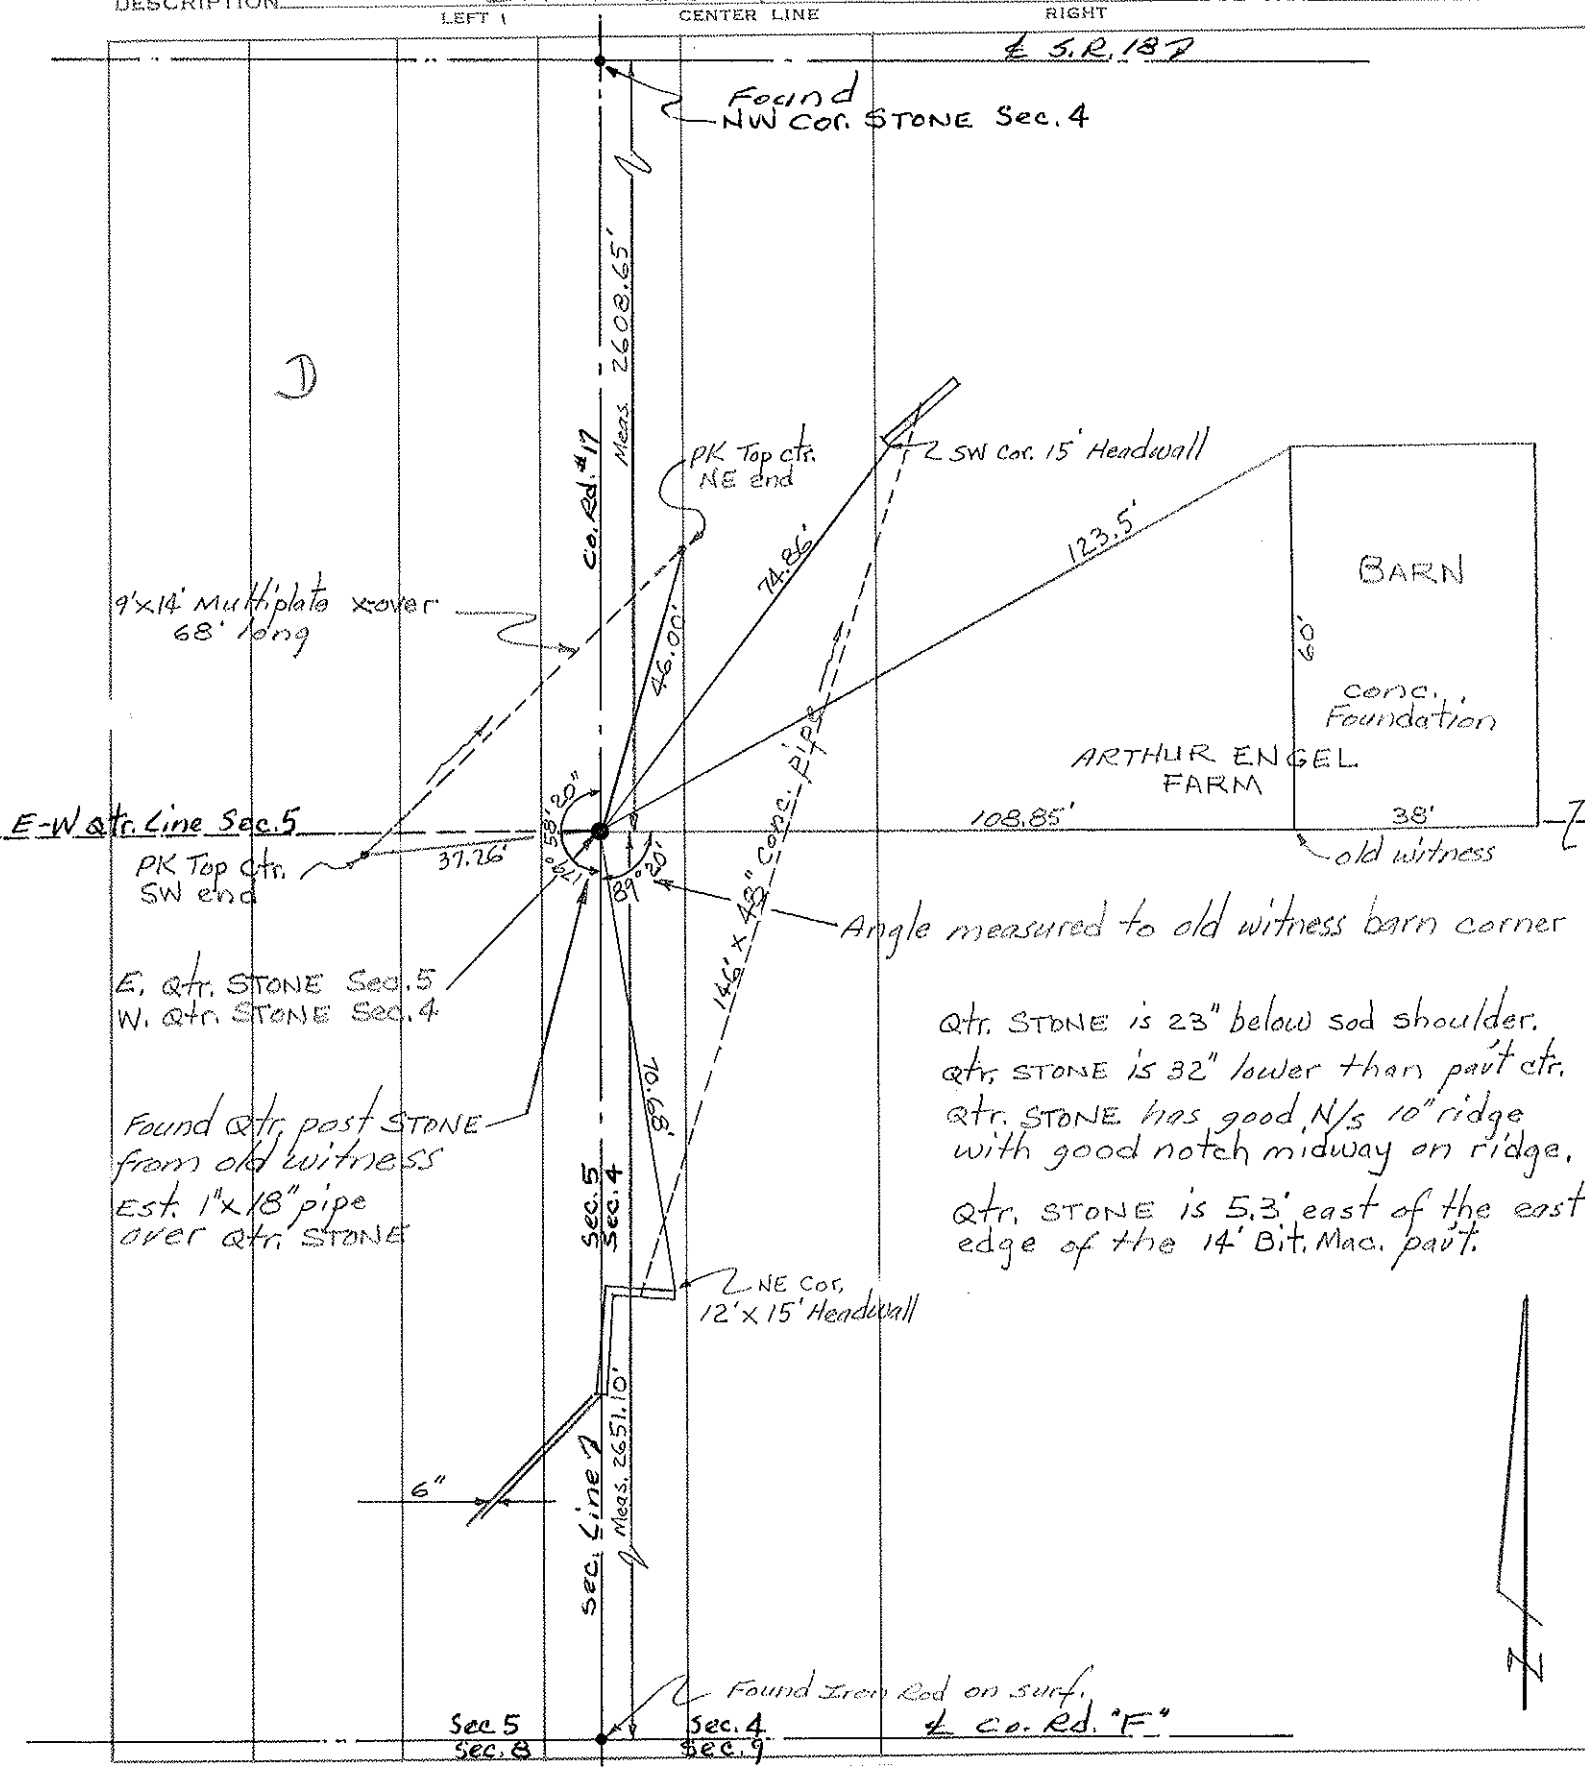

PERSONNEL TITLE PERSONNEL TITLE

Red Beach
Newcomb
Knape
Mead

COUNTY HENRY

DATE Aug 73

S. R. 18

WEATHER

SEC. 5, H. 318 Sec. N

TEMP.

DESCRIPTION CONTROL POINTS

JOB NO.

