

O.D.O.T. DISTRICT 2 SURVEY OFFICE (USE ONLY)

PERSONNEL

REFERENCE NO. 11

SHEET 21 OF 29

NOTES MOSER

DATE 9/10/09

ROUTE SR 18

H.C. GOLDBERG

WEATHER SUNNY

COUNTY HENRY

R.C. PIETKOWSKI

TEMP. 75°

TOWNSHIP FLATROCK

DWG BY NIESE

PID NO PID

SECTION 36

T 4 N R 6 E

TYPE MONUMENT P.K./WASHER

ON SURFACE - ~~BELOW~~ ON

OFFSET Q PAVEMENT ON ~~LT~~ : ~~RT~~

9.8' TO RT EDGE PAVEMENT


STATION: 260+96

HORZ.DATUM: NAD83(2011)


GEOID: 2012A

GRID: NORTHING: 582372.329

EASTING: 1519578.933

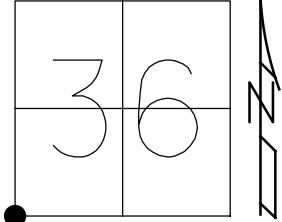

RECORD:
FD HUB AND R.R.SPIKE
5" DOWN
OVER STONE
SET P.K.NAIL
1976
FD P.K./WASHER
SV120
9/10/09, KPM
SET MAG/WASHER
10/20/09, KPM
FD MAG/WASHER
UNCOVERED
8/6/19, JFO

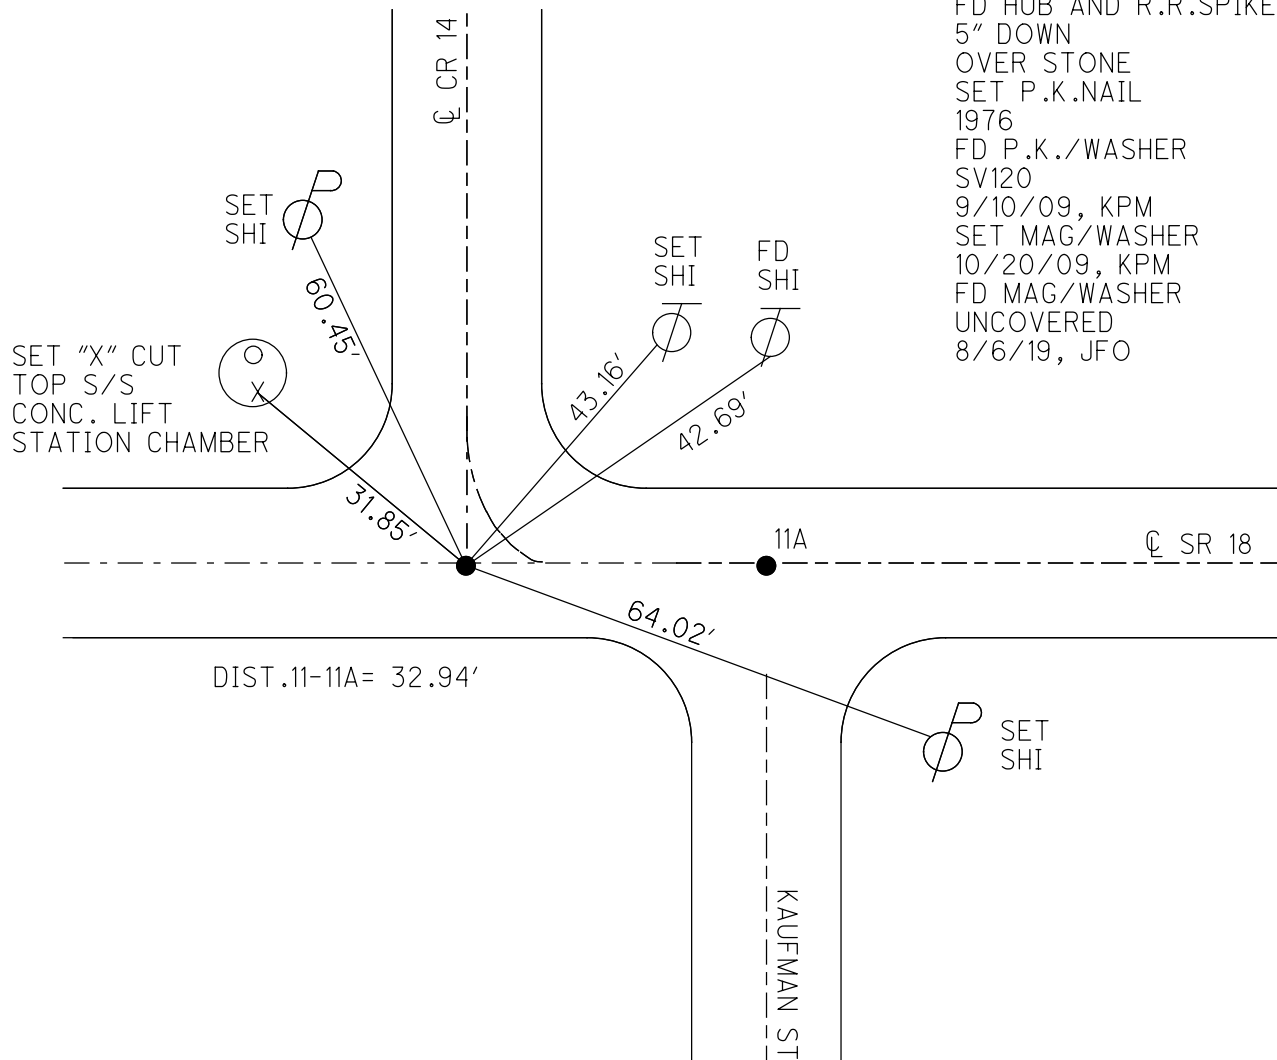

O.D.O.T. DISTRICT 2 SURVEY OFFICE (USE ONLY)

PERSONNEL

REFERENCE NO. 11

SHEET 21 OF 29

NOTES MOSER

DATE 09-10-09

ROUTE SR 18

H.C. GOLDBERG

WEATHER SUNNY

COUNTY HENRY

R.C. PIETKOWSKI

TEMP. +75°

TOWNSHIP PLEASANT

SECTION 36 - 1

T 4 N R 6 E

TYPE MONUMENT PK/WASHER

ON SURFACE - ~~BELOW~~ ON SURFACE

~~LEFT~~ - C PAV'T - ~~RIGHT~~ ON CENTER

9.8' TO RT. EDGE PAVEMENT

S.L.M. 260+96 (SV120)


Grid: Northing: 582372.343 Easting: 1519578.898

35	36
FLATROCK PLEASANT	
2	1



Record: S.W. Cor. Sec.36
Flatrock twp. Fd. HUB 5"
deep and RR SPK over stone
Placed PK Nail over stone
Henry Co. 1976

SET MAG/WASHER
10-20-09 KPM

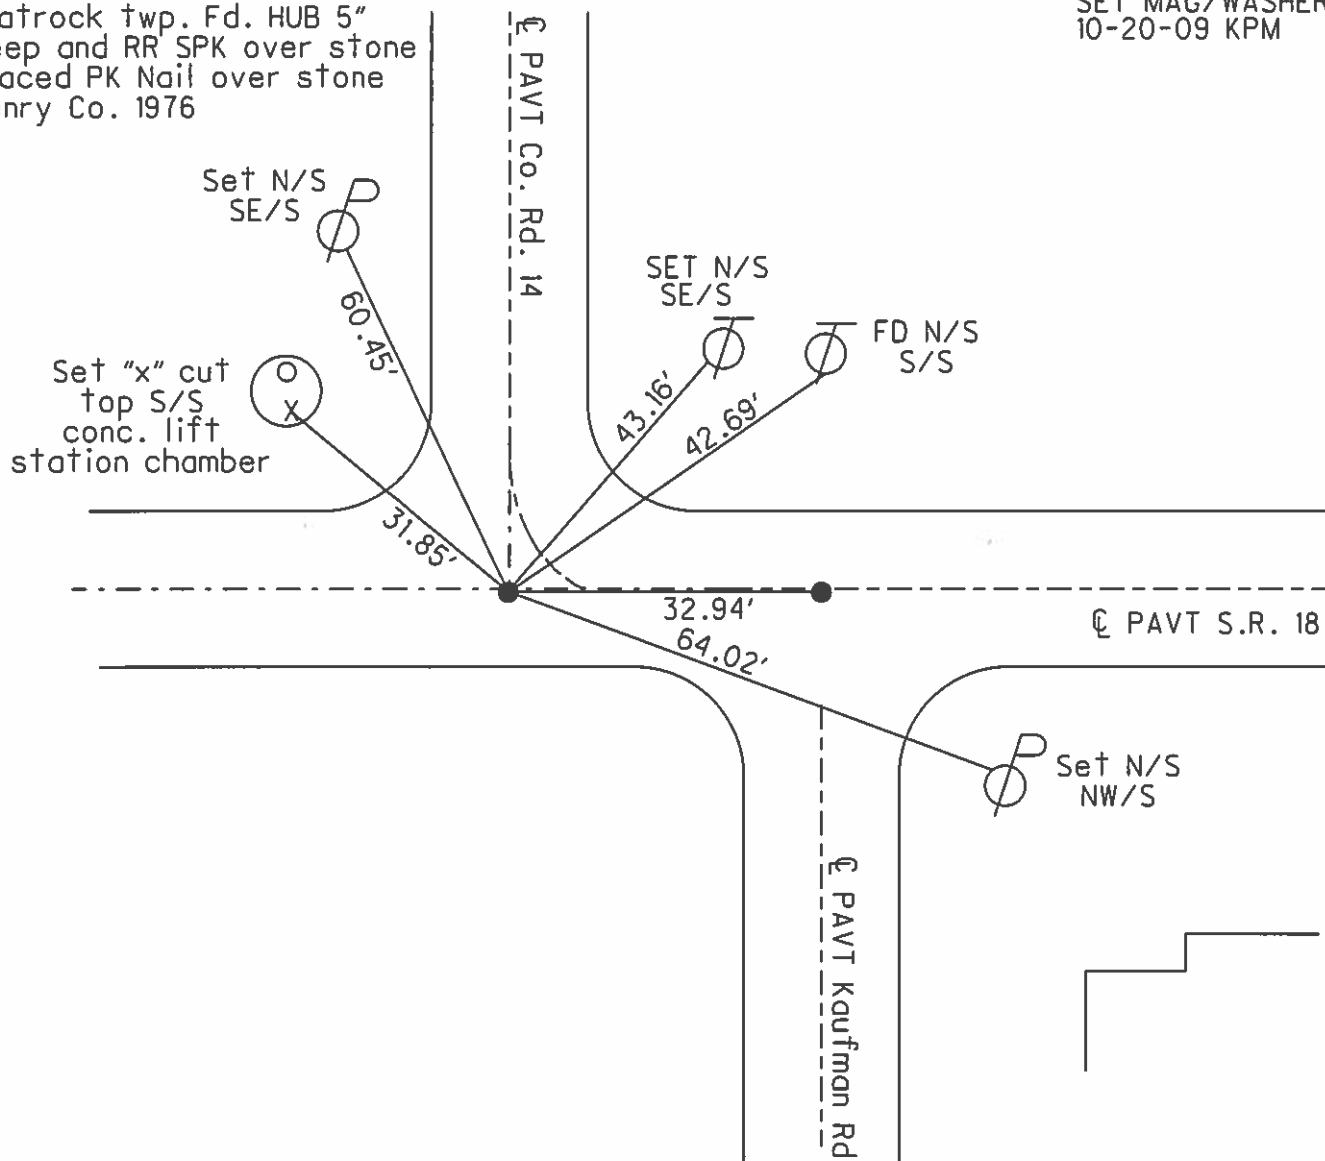

O.D.O.T. DISTRICT 2 SURVEY OFFICE

PERSONNEL

REFERENCE NO. 10 FA

SHEET 11 OF 11

NOTES HUSS

H.C. VAW DUSEN

R.C. HUSS

DATE 6-1-95

WEATHER CLOUDY DRIZZLE

TEMP. +65° F

ROUTE S.R. 18

COUNTY HENRY

TOWNSHIP FLATROCK - PLEASANT

SECTION 36-1

T 4 N R 6 E

T 5 N

35	36
2	1



TYPE MONUMENT PK'S & WASHERS
ON SURFACE - BELOW YES ~ YES
LEFT - & PAV'T. - RIGHT 0.6' RT ~ &
9.4
10.0 RT TO EDGE PAVEMENT
S.L.M. 260+96 ~ 261+29

4.94

11-11A

RECORD

N.W. COR SEC 1

PLEASANT TWP.

NO STONE, JUST IRON
PIN PLACED PK. OVER PIN
I. PIN 6 1/2" DEEP
HENRY COUNTY 1976

FO 1/4" CUT
TOP S/S
CONC. LIFT
STATION CHAMBER

FO SHI
SEIS

FO SHI
S/S

E PAUT S.R. 18

E PAUT S.R. 18

N.E. CORN.
OF HOUSE
FOAM.

NE CORN OF
PORCH FOAM.
2nd BRICK DOWN


N.W. COR.
HOUSE FOAM.

RECORD?

SW COR. SEC 36
FLATROCK TWP.
FO. HUB 5" DEEP
E.R.R. SPIKE OVER STONE
PLACED P.K. NAIL OVER STONE
HENRY CO. 1976

E PAVEMENT KAUFMAN RD.

66-52 REC.

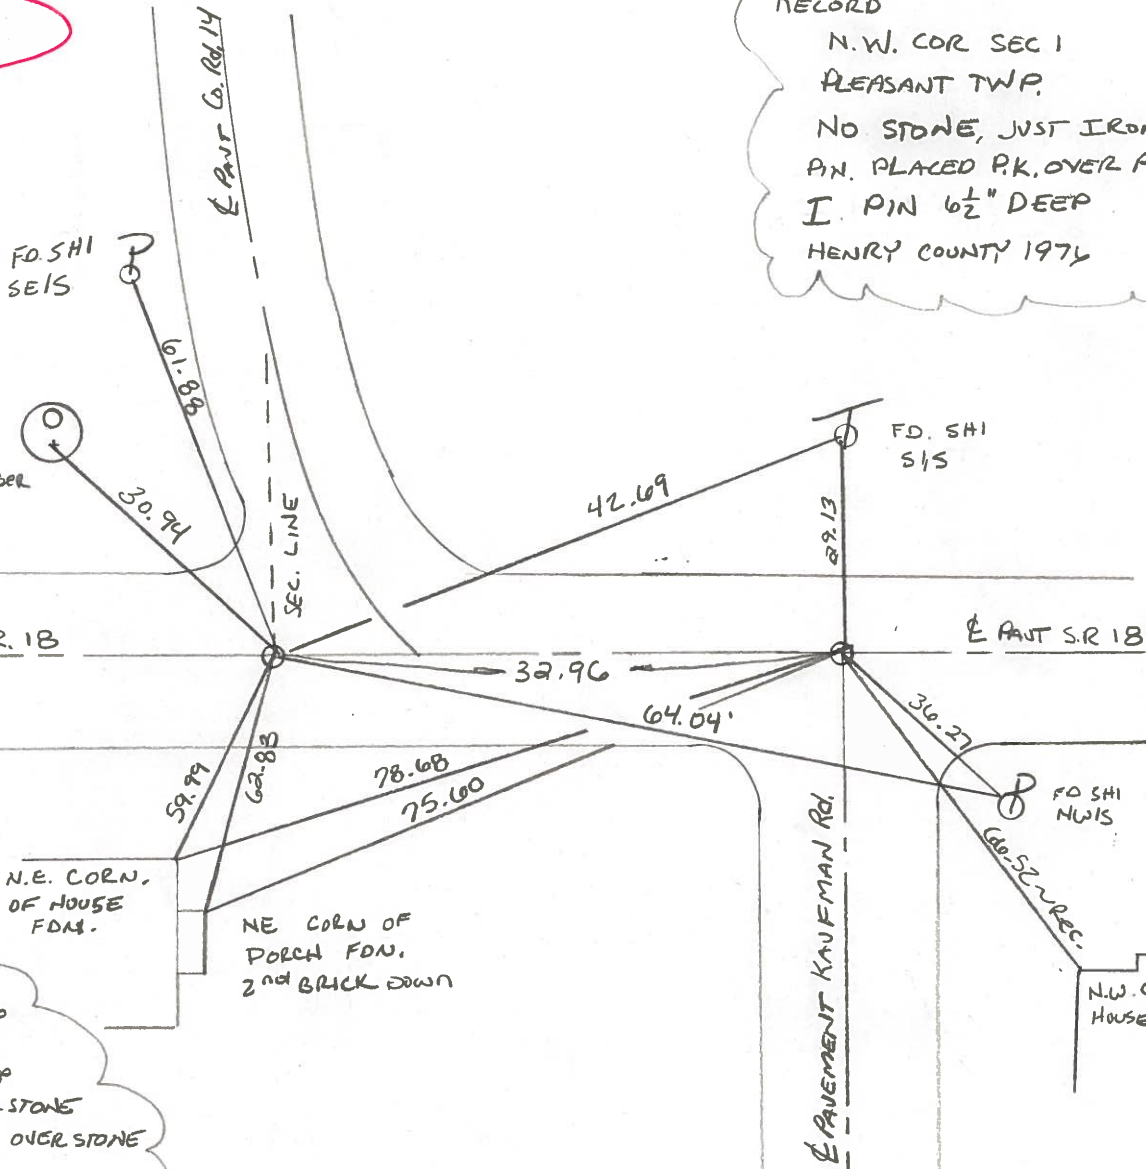

O.D.O.T. DISTRICT 2 SURVEY OFFICE

PERSONNEL

REFERENCE NO. 11- 11A

SHEET OF

NOTES BARNHISEL

H.C. Loehrke

R.C. SOCKMAN

DATE Aug 12, 1986

WEATHER SUNNY

TEMP. +82°

ROUTE SR 18

COUNTY HENRY

TOWNSHIP FLATROCK - PLEASANT

SECTION 36 - 1


T4 N R 6 E
T3 N

35	36
2	1



TYPE MONUMENT RR Spk - PK
ON SURFACE - BELOW yes 1/2" Down
~~LEFT - & PAV'T. - RIGHT~~ yes
10.2 TO R+EDGE PAVEMENT
S.L.M. 260+65 + 260+98

Set Sm RR Spk's
6-15-87
MOB

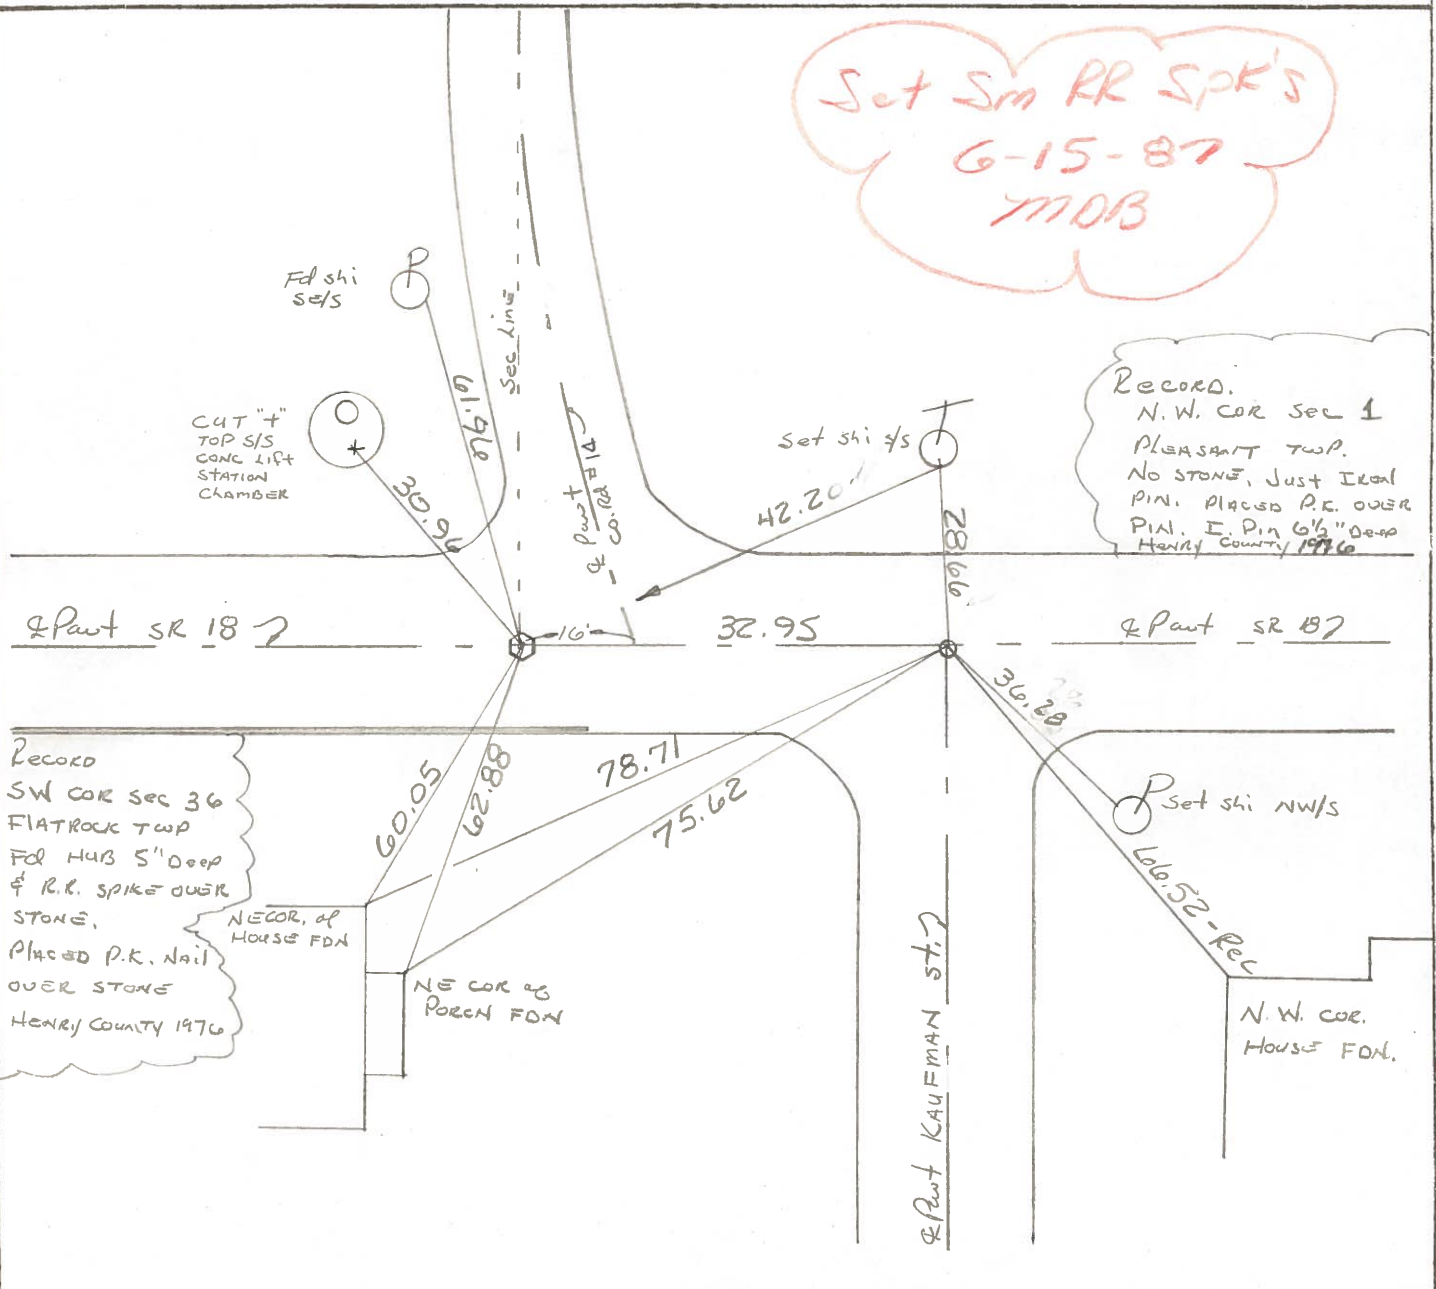

Record
SW COR SEC 36
FLATROCK TWP
FD HUB 5" Deep
& R.R. SPIKE OVER
STONE.
Placed P.K. Nail
OVER STONE
HENRY COUNTY 1976

NE COR. of
HOUSE FDN

NE COR of
POREN FDN

Record.
N.W. COR SEC 1
PLEASANT TWP.
NO STONE, Just IRON
PIN. Placed P.K. OVER
PIN. E. Pin 6 1/2" Deep
HENRY COUNTY 1976

N.W. COR.
HOUSE FDN.

Pavt KAUFMAN ST.

HENRY COUNTY ENGINEER'S OFFICE CORNER STONE RECOVERY PROGRAM

Sht. 10 of
S.R. 1

TOWNSHIP Flatrock

SECTION 36



T4N, R6E

PERSONNEL JG
BB
MS
RS
SS

DATE 6-4-76

WEATHER Clear & Warm

TEMP

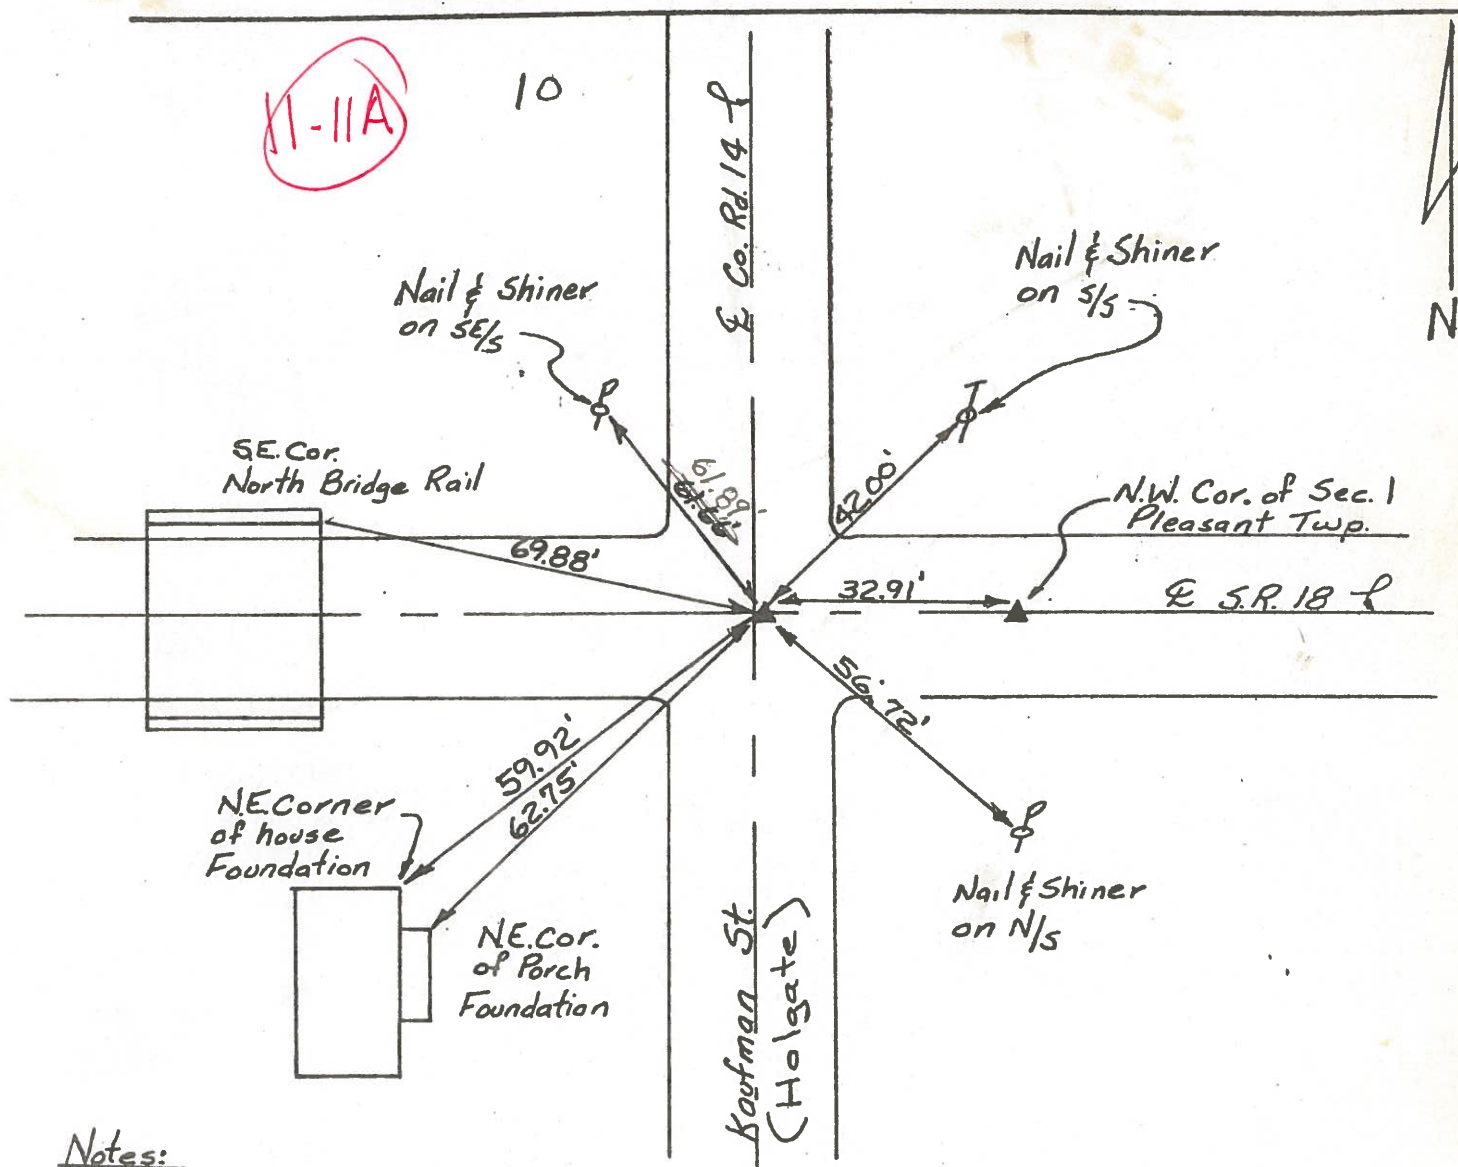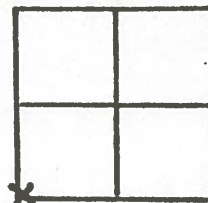

Notes:

Found 1 1/2" x 15" Round Wooden hub Angled over top of Stone, hub was on East side of Stone & 5" deep, Also found R.R. Spike over North side of Stone Removed hub & Spike & Placed P.K. Nail over Stone. Placed P.K.'s 6' N. & E.

Copied:

Painted:

Form CSR-1 9-76

PERSONNEL	TITLE	PERSONNEL	TITLE	COUNTY	DATE	WEATHER	TEMP.
W. Denno				Henry	Aug. 19, '74	Warm	85°
R. Michalak				S. R. 18			
O. Curtis				SEC.			
DESCRIPTION				References To Control Points		JOB NO. 02999101	
LEFT		CENTER LINE		RIGHT			

