


O.D.O.T. DISTRICT 2 SURVEY OFFICE (USE ONLY)

PERSONNEL	REFERENCE NO. <u>15</u>	SHEET <u>8</u> OF <u>31</u>	
NOTES	DATE <u>6/26/08</u>	ROUTE <u>SR 18</u>	
H.C. <u>MOSE</u>	WEATHER <u>CLEAR</u>	COUNTY <u>HENRY</u>	
R.C. <u>NUHFER</u>	TEMP. <u>83°</u>	TOWNSHIP <u>MARION</u>	
		SECTION <u>6</u>	
		T <u>3</u> N R <u>7</u> E	


TYPE MONUMENT SM.R.R.SPIKE
 ON SURFACE - ~~BELOW~~ ON
~~LEFT~~ - CL PAV'T - RIGHT 1.7'
7.7' TO RT EDGE PAVEMENT
 S.L.M. 366+66

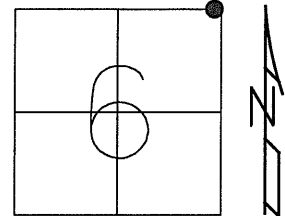

GRID: NORTHING: 582235.933 EASTING: 1530176.965

RECORD:
 SET SM.R.R.SPIKE
 6/13/89, MDB
 FD SM.R.R.SPIKE
 1/10/07, SAH
 REF15
 6/27/08, KPM
 SET MAG/WASHER
 5/21/09, SAH
 FD MAG/WASHER
 REF15
 6/17/16, JMR

NOTE: MONROE TWP
 SEC 31 SE/COR

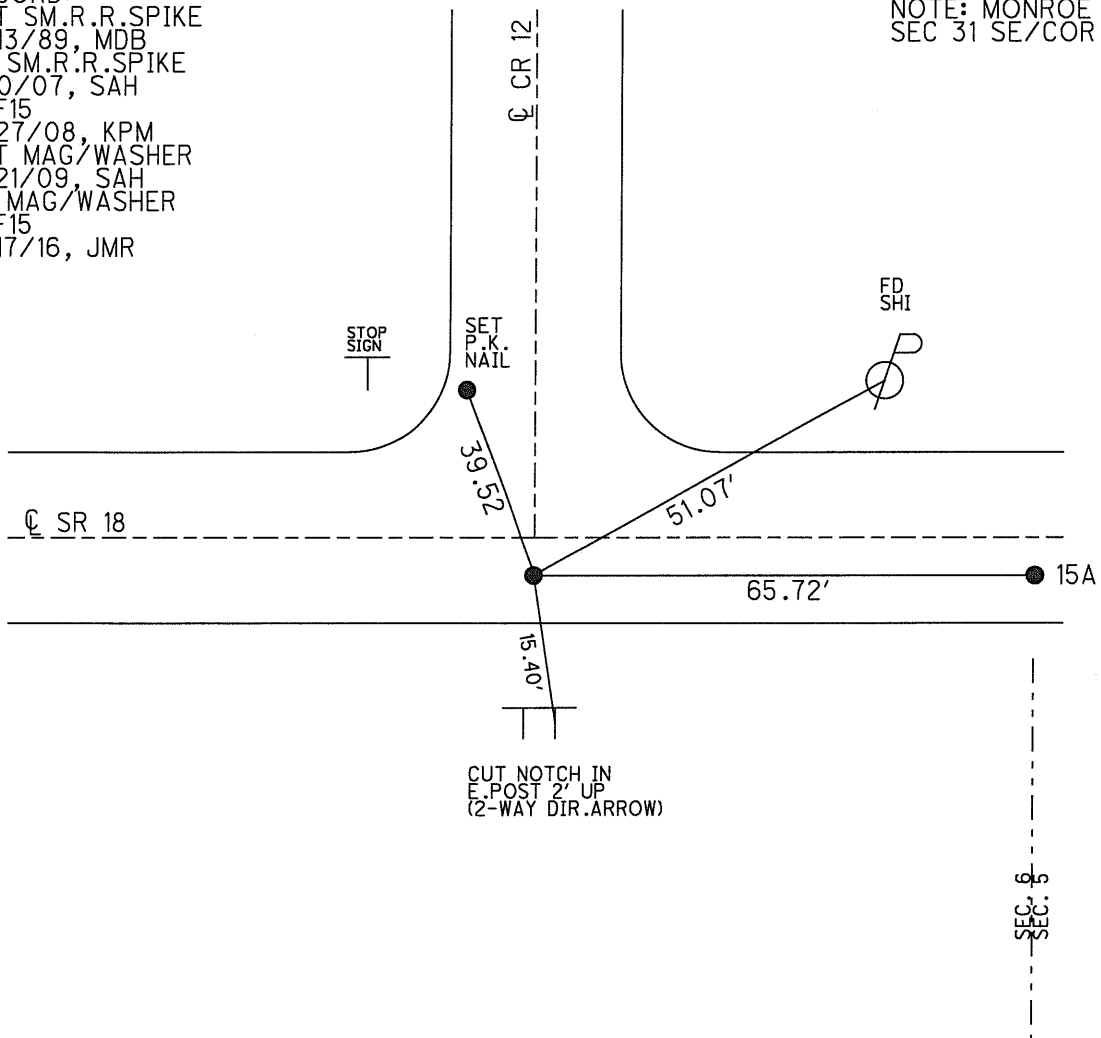

O.D.O.T. DISTRICT 2 SURVEY OFFICE (USE ONLY)

PERSONNEL

REFERENCE NO. 15

SHEET 8 OF 31

NOTES NUHFER

DATE 6/26/08

ROUTE SR 18

H.C. MOSER

WEATHER CLEAR

COUNTY HENRY

R.C. NUHFER

TEMP. 83°

TOWNSHIP MARION

SECTION 6

T 3 N R 7 E

TYPE MONUMENT SM.R.R.SPIKE

ON SURFACE - ~~BELOW~~ ON


~~LEFT~~ - Q PAV'T - RIGHT 1.7'

7.7' TO RT EDGE PAVEMENT

S.L.M. 366+66

Grid: Northing: 582235.929 Easting: 1530176.898

31	32
6	5

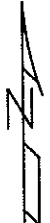


SET SM.R.R.SPIKE
6/13/89, MDB

FD SM.R.R.SPIKE
SAH, 1/10/07

GPS, REF 15
KPM, 6/27/08

SET MAG/WASHER
5/21/09, SAH

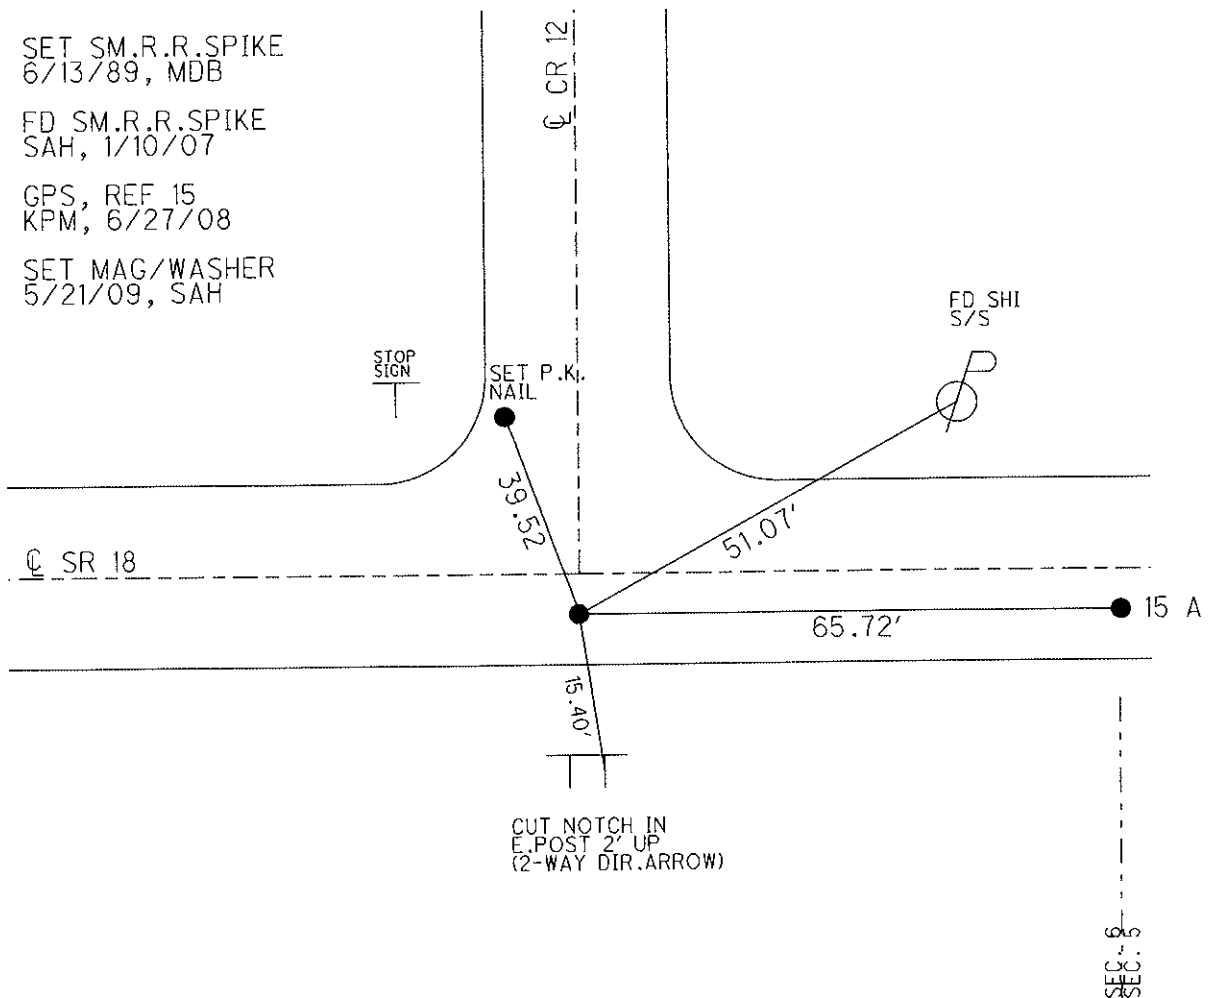

O.D.O.T. DISTRICT 2 SURVEY OFFICE

PERSONNEL

REFERENCE NO. 15

SHEET 2 OF

NOTES BARNHISEL

H.C. " " "

R.C. Loehke

DATE 3-30-89

WEATHER cloudy - RAIN

TEMP. +40°

ROUTE SR 18

COUNTY HENRY

TOWNSHIP MARION

SECTION 5

T. 3 N R 7 E

TYPE MONUMENT

ON SURFACE - BELOW

LEFT - ~~C~~ PAV'T. - RIGHT 1.6' - 1.7'


8.1 TO RT EDGE PAVEMENT

S.L.M. 366+66 - 367+27

31	32
6	5



Set Sm RR Spt's
6-13-89
M.D.B.

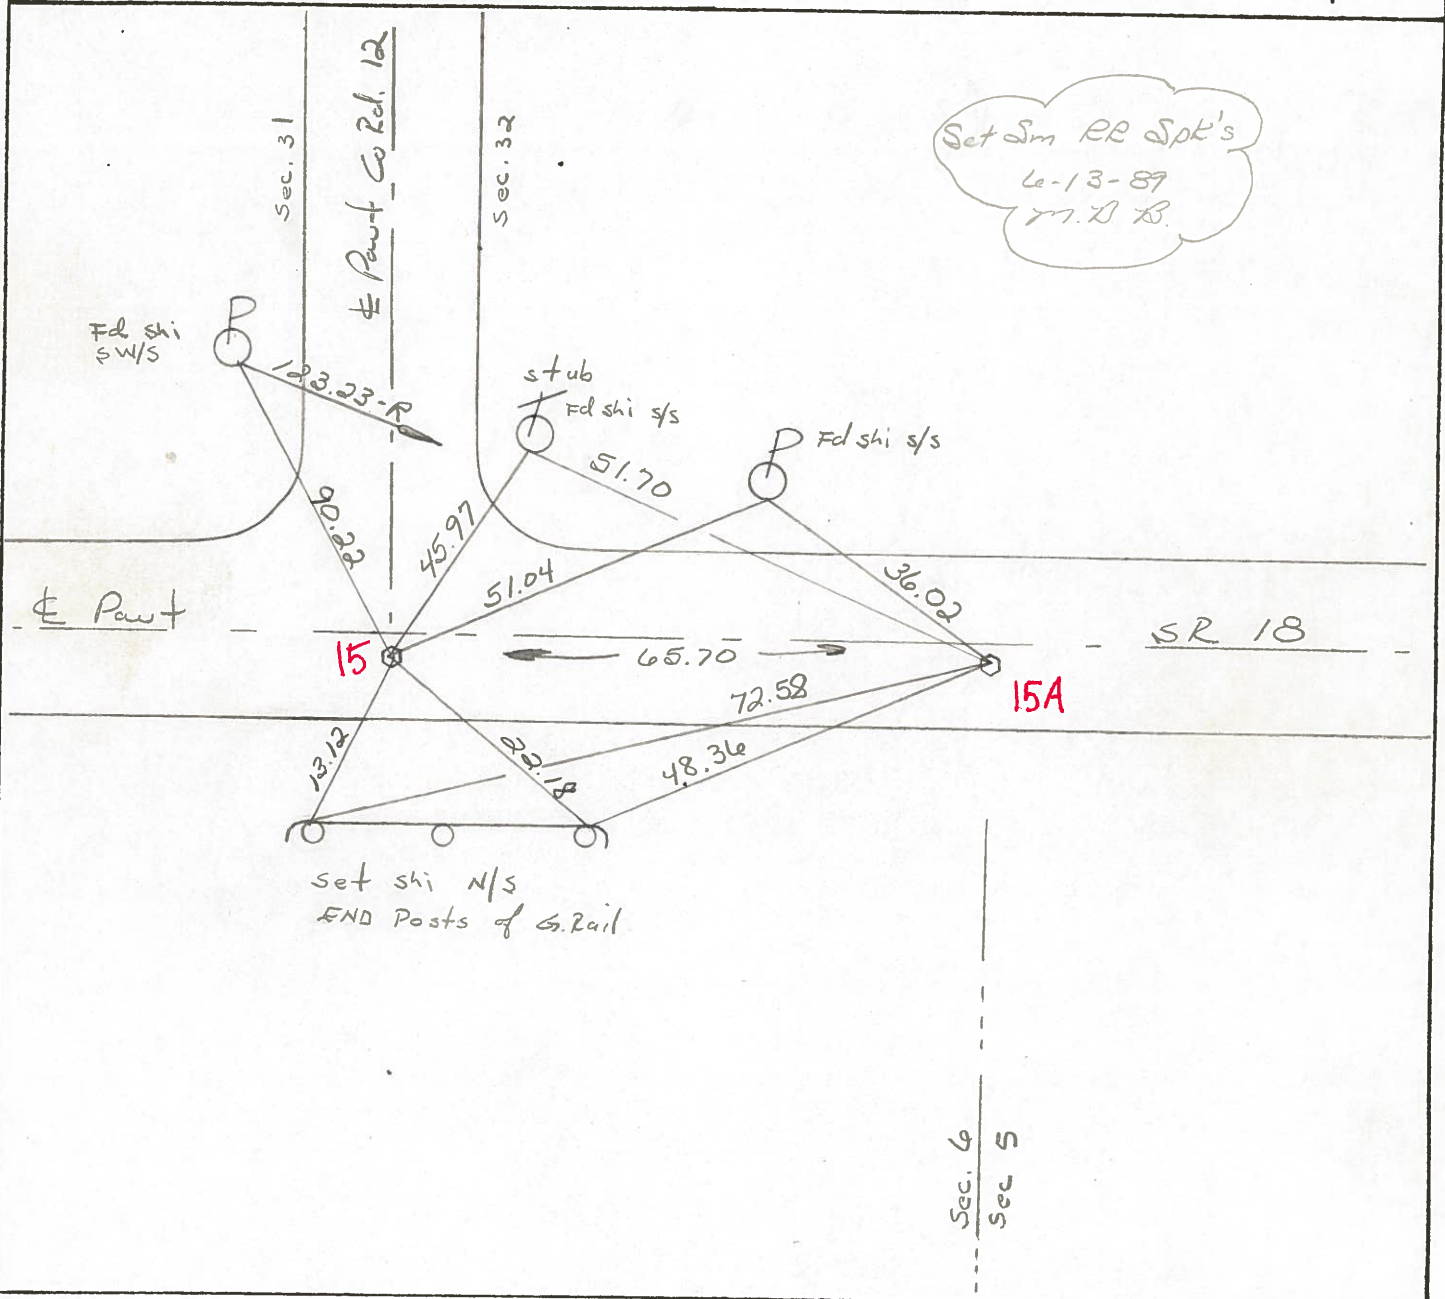


County HENRY S.R. 18Date 5-28-81Township MARIONWeather CLEARSection 5Temp. +70°

T3N, R7E

Personnel S. HoffmanC. LoehrkeJ. Householder


#15

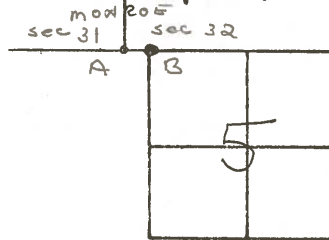

P.T. A. Fd. R.R. SPK @ SURFACE
 SET. P.K. 7.8' S Edge PAVT
 \$WASHER — N. Edge PAVT

PROJECT STA $\pm 366 + 84$

P.T. B Fd. R.R. SPK @ SURFACE
 11.6' N. EDGE PAVT
 8.1' S. EDGE PAVT
 SET SMALL R.R. SPK.

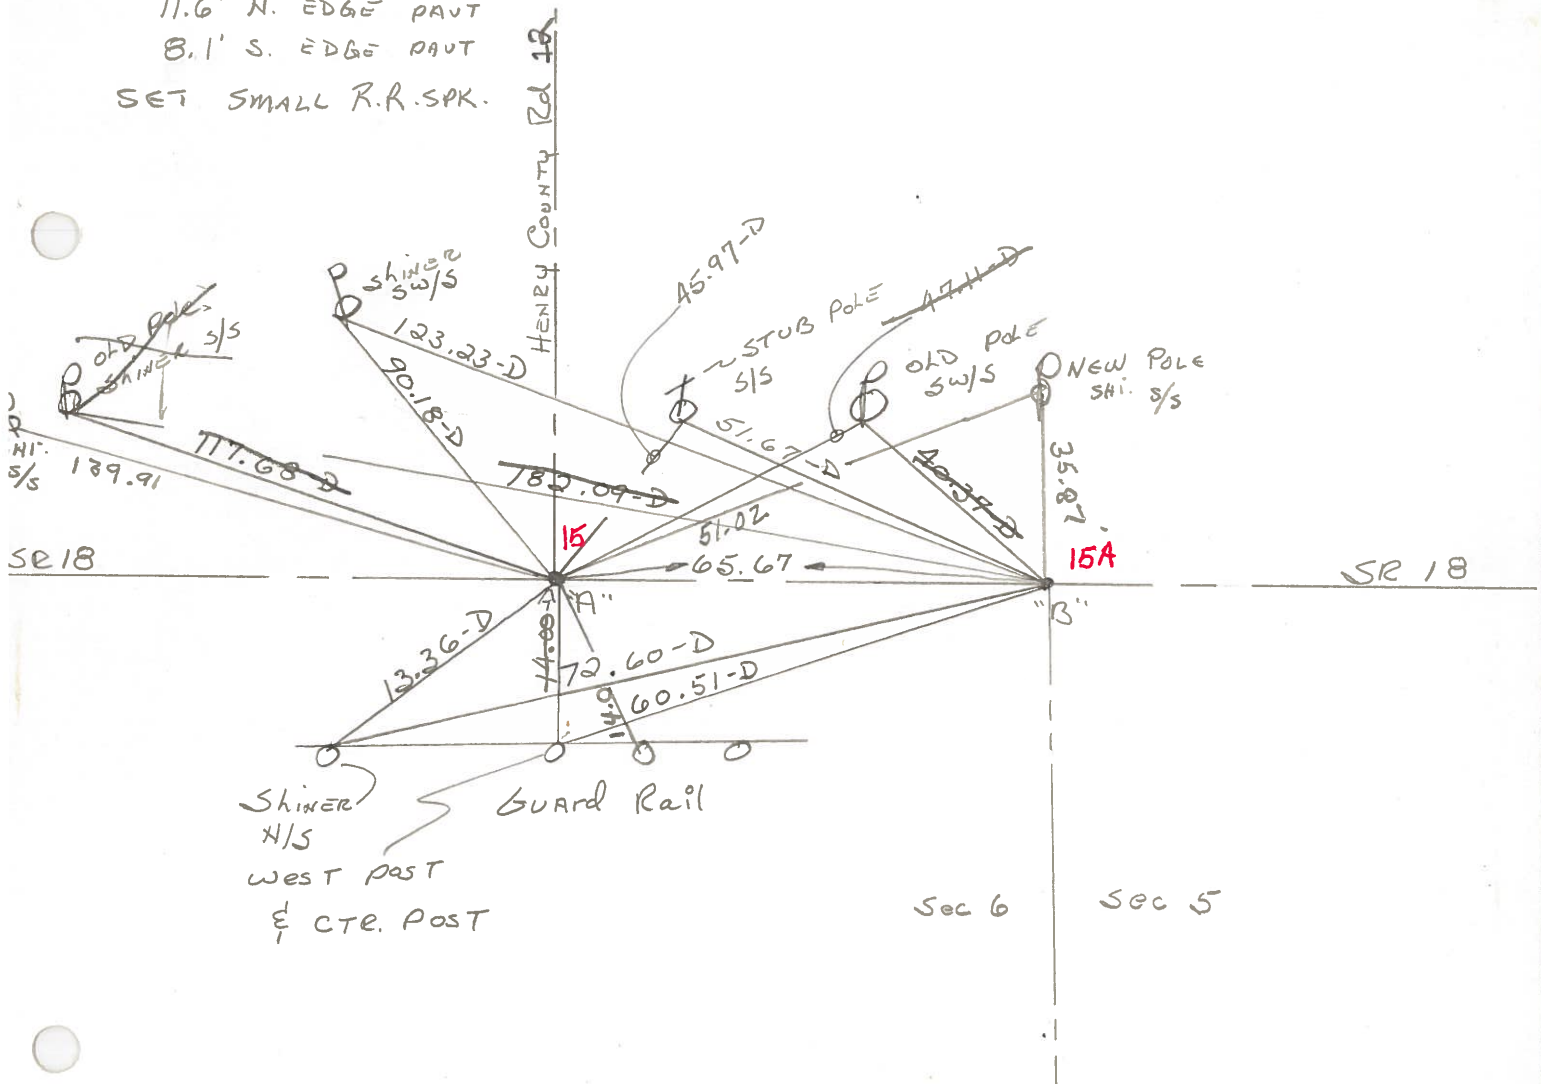PROJECT STA $\pm 367 + 50$ 

COUNTY HENRY S.R. 18


T N , R E

TOWNSHIP MARION

SECTION 5

15

16

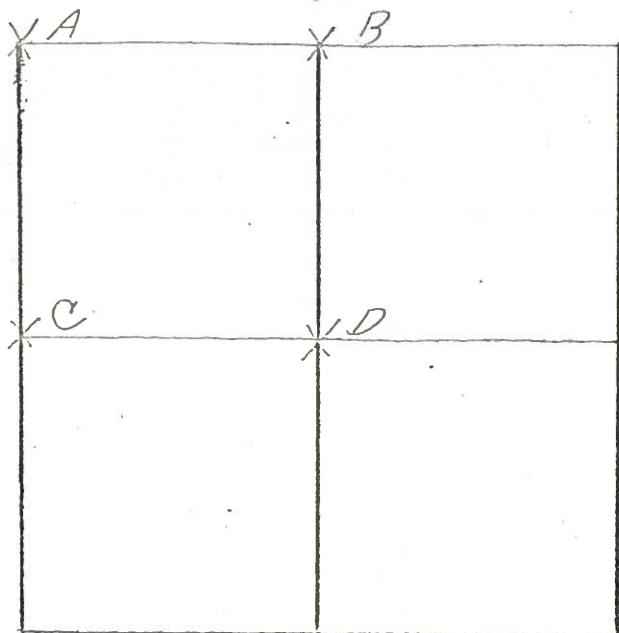

6-19-79
RW. JJ, GM

A- FOUND STONE (8"X11X8") 19"
BELOW ROAD SURFACE. PLACED
CENTER PUNCHED R.R. SPIKE ON
SURFACE ON SOUTH LINE OF
SEC. 32, MONROE TWP. R.R. SPIKE
IS 0.22' SOUTH OF TOP CENTER
OF STONE P.K.'S 6' S. & W.
STONE IS 6.9' N. OF S. EDGE OF

18' PAVEMENT

40.36' N.W. TO DUPLEX SW/S POWER POLE

82.70' S. TO DUPLEX N/S POWER POLE

65.66' W. TO

6-20-79 RW. JJ, GM

B- FOUND WOOD POST (APPROX 3" DIA) 21" BELOW ROAD SURFACE AND
2 SMALL STONES ON E/S AND W/S OF POST, PLACED CENTER PUNCHED
R.R. SPIKE ON SURFACE ON THE SOUTH LINE OF SEC. 32, MONROE TWP.
R.R. SPIKE IS 0.21' SOUTH OF WOOD POST, P.K.'S 6' SOUTH AND EAST,
POST IS 7.5' N. OF S. EDGE OF 18' PAVEMENT.


102.61' W.N.W. TO NAIL & SHINER S/S POWER POLE

26.24' S. S.E. TO DUPLEX N/S WOOD POST

48.25' W. TO S 1/4 POST SEC. 32, MONROE TWP.

PERSONNEL	TITLE	PERSONNEL	TITLE	COUNTY	DATE
Stone				Henry	29 Oct. 74
Dennis				S. R. #18	WEATHER Cloudy
Michalak				SEC. Monroe - Marion Twp.	TEMP. 60°
Curtis					

DESCRIPTION Alignment LEFT CENTER LINE RIGHT JOB NO.

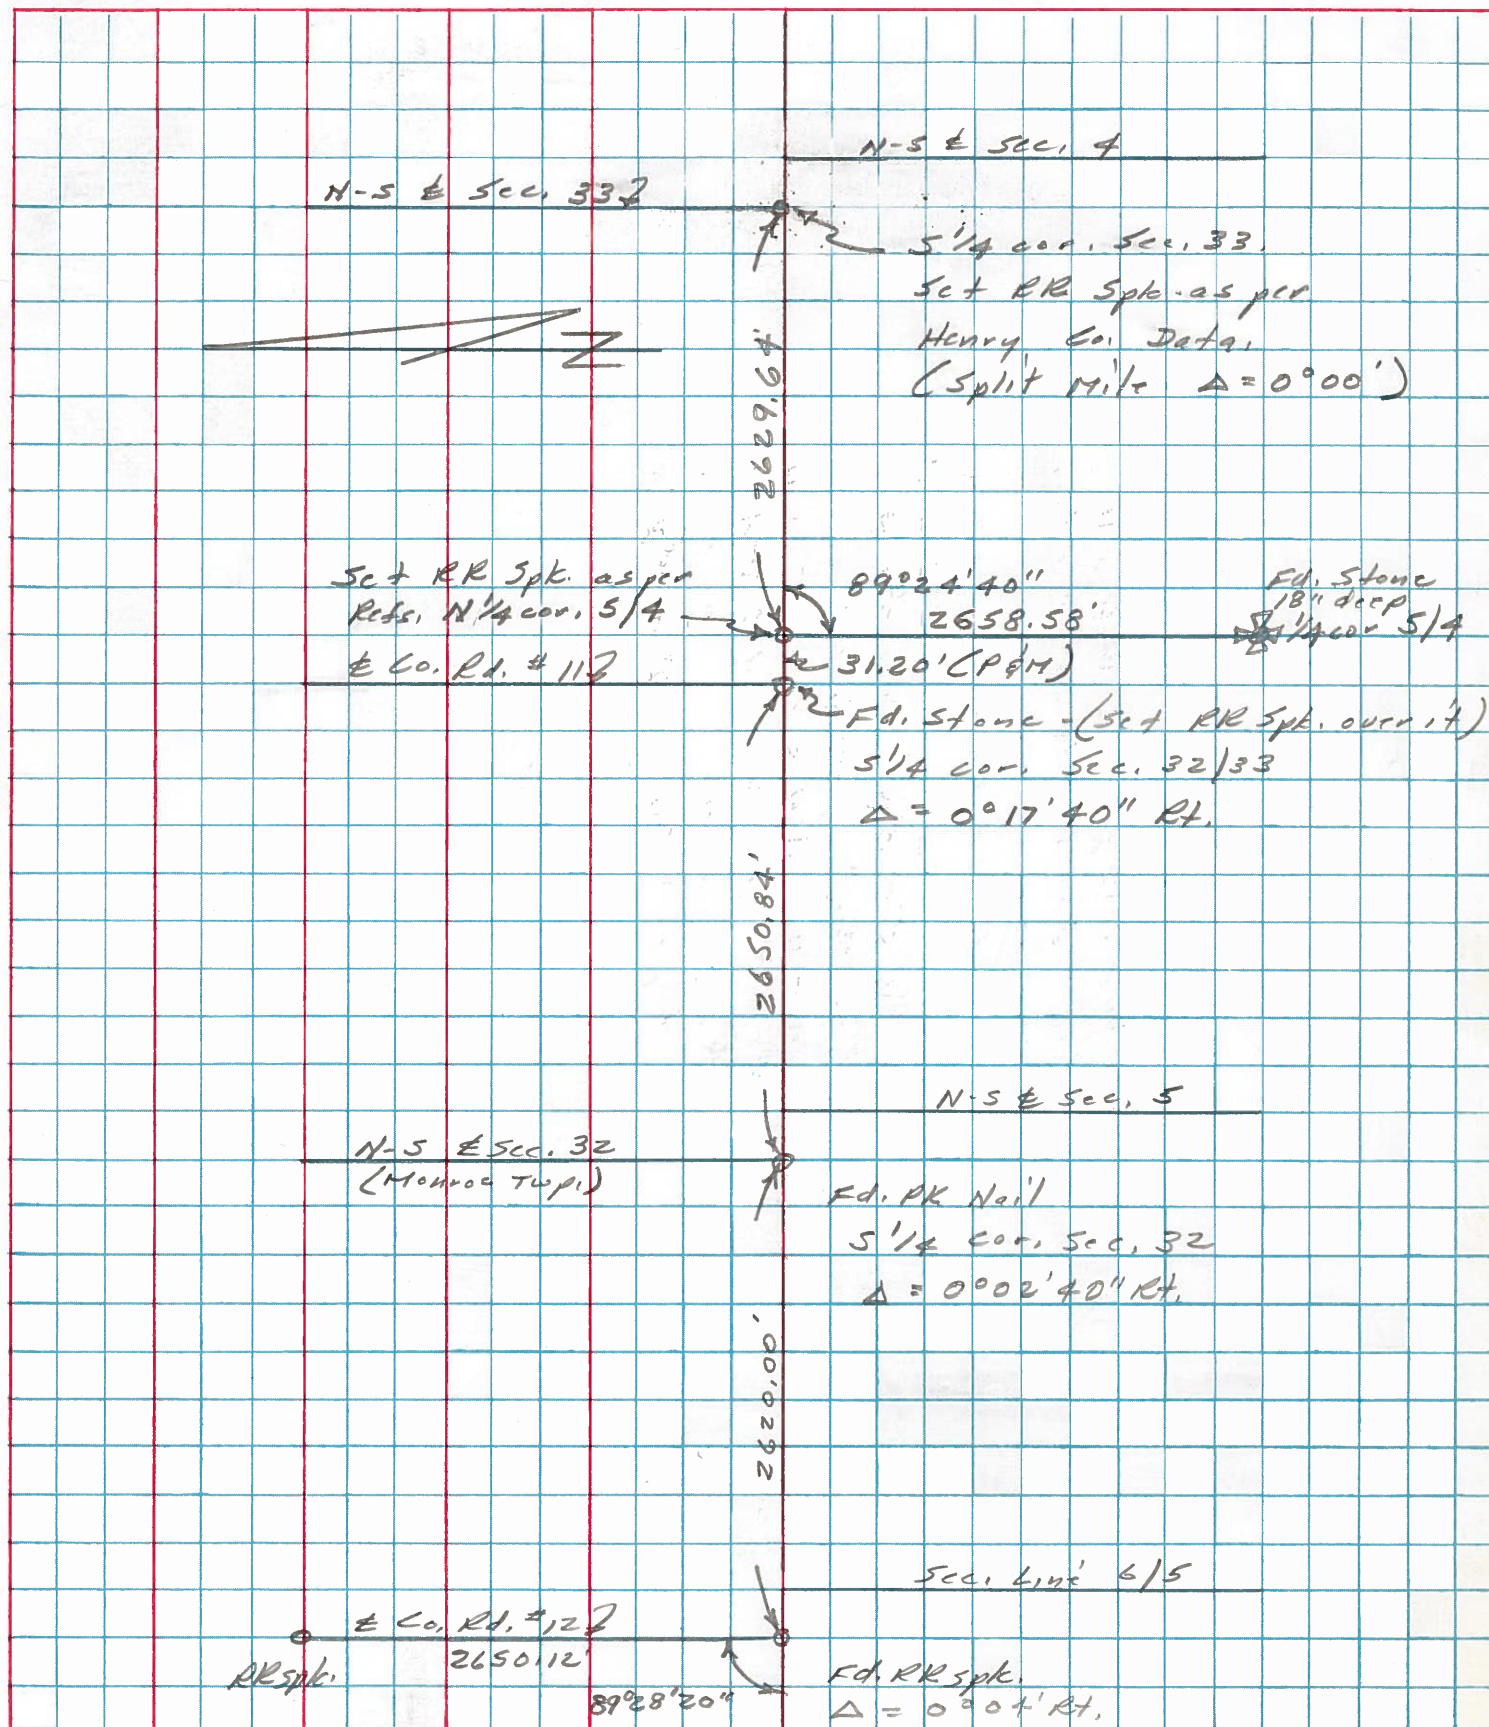

PERSONNEL	TITLE	PERSONNEL	TITLE	COUNTY	DATE	WEATHER	TEMP.	JOB NO.
W. Denno				Henry	Oct. 3, '18	Warm	90°	02999101
R. Michalak				S. R.	18			
D. Curtis				SEC.				
DESCRIPTION				References To Control Points				
LEFT		CENTER LINE		RIGHT				

