

O.D.O.T. DISTRICT 2 SURVEY OFFICE (USE ONLY)

PERSONNEL

REFERENCE NO. 29 A

SHEET 4 OF 13

NOTES AUBLE

DATE 7/7/23

ROUTE SR 18

H.C. AUBLE

WEATHER CLEAR

COUNTY HENRY

R.C. RHOADES

TEMP. 76°

TOWNSHIP BARTLOW

DWG BY RHOADES PID R/W

SECTION 7

T 3 N R 8 E

TYPE MONUMENT P.K.NAIL, D.N.F.

ON SURFACE - BELOW -

OFFSET \odot PAVEMENT - LT : RT

2' LT TO LT EDGE PAVEMENT



STATION: 715+03

HORZ.DATUM: NAD83 2011

GEOID: NAVD88 2018

GRID: NORTHING: _____

EASTING: _____

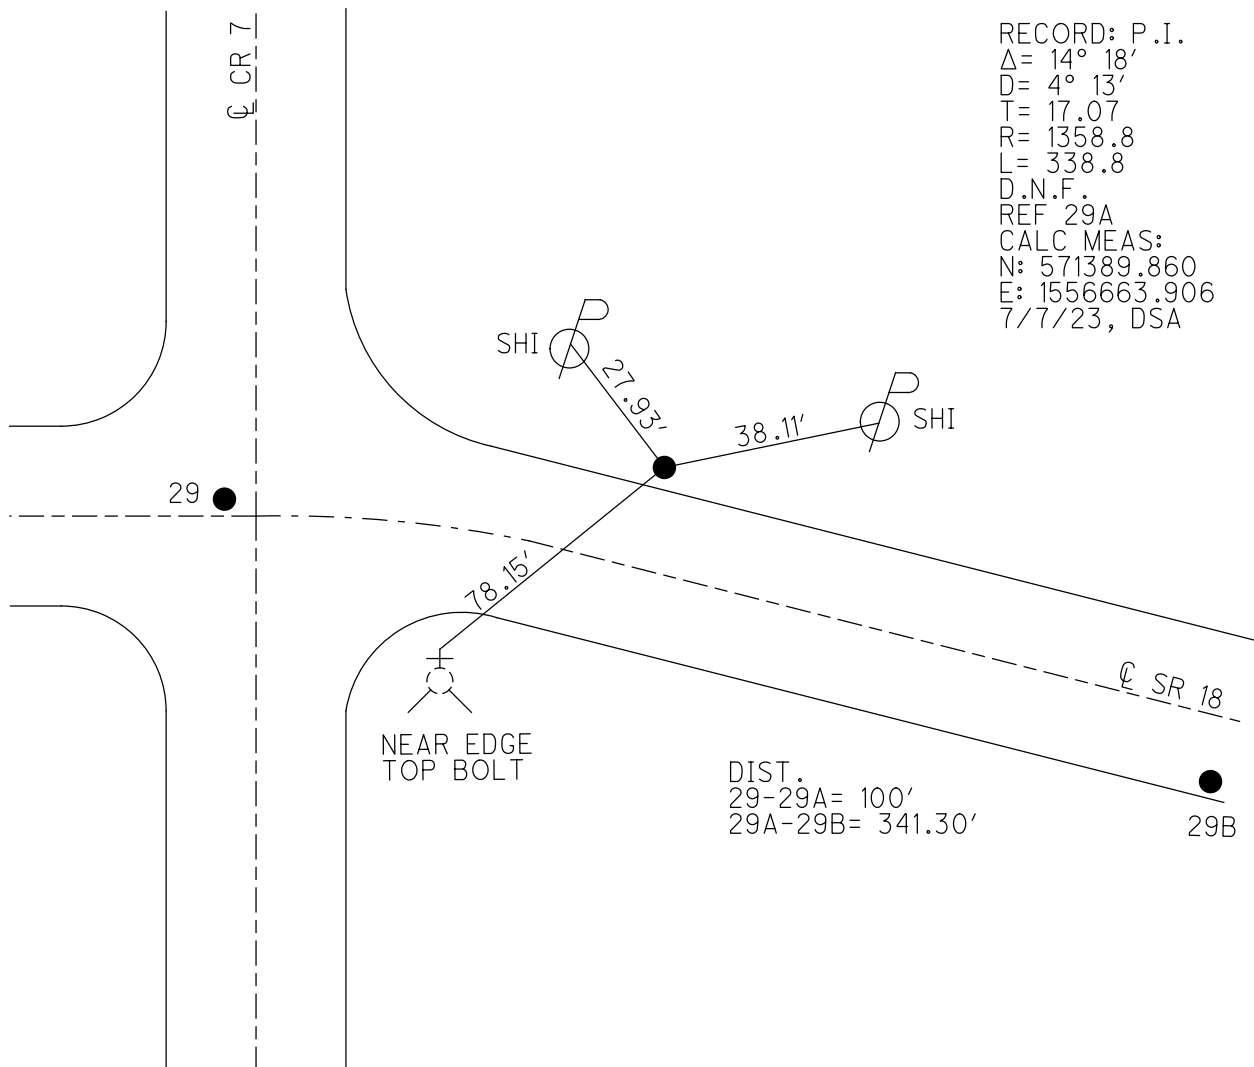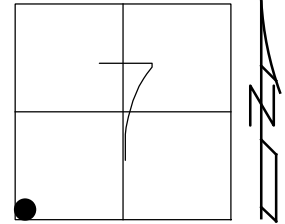

O.D.O.T. DISTRICT 2 SURVEY OFFICE

PERSONNEL

REFERENCE NO. 29 A+B

SHEET 8 OF 13

NOTES HUSS

H.C. VAN DUSEN

DATE 8-4-86

ROUTE SR-18

R.C. MOSER

WEATHER SUNNY

COUNTY Henry

TEMP. +84° F

TOWNSHIP Bartlow

SECTION 7

T 3 N R 8 E


TYPE MONUMENT Sm. RR SPIK

ON SURFACE - BELOW YES

~~LEFT~~ - PAV'T. - RIGHT 8.7

1.7 TO RT EDGE PAVEMENT


S.L.M. 718+41

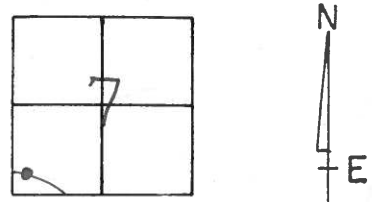

SET PK/WASHER
SAH 9-7-95

Recorded:
Set Stake as per 1931
plan 4.5' to S. edge
of pav.

Recorded:
Set Sm. RR, Spk.
10-14-86
M.O.B.

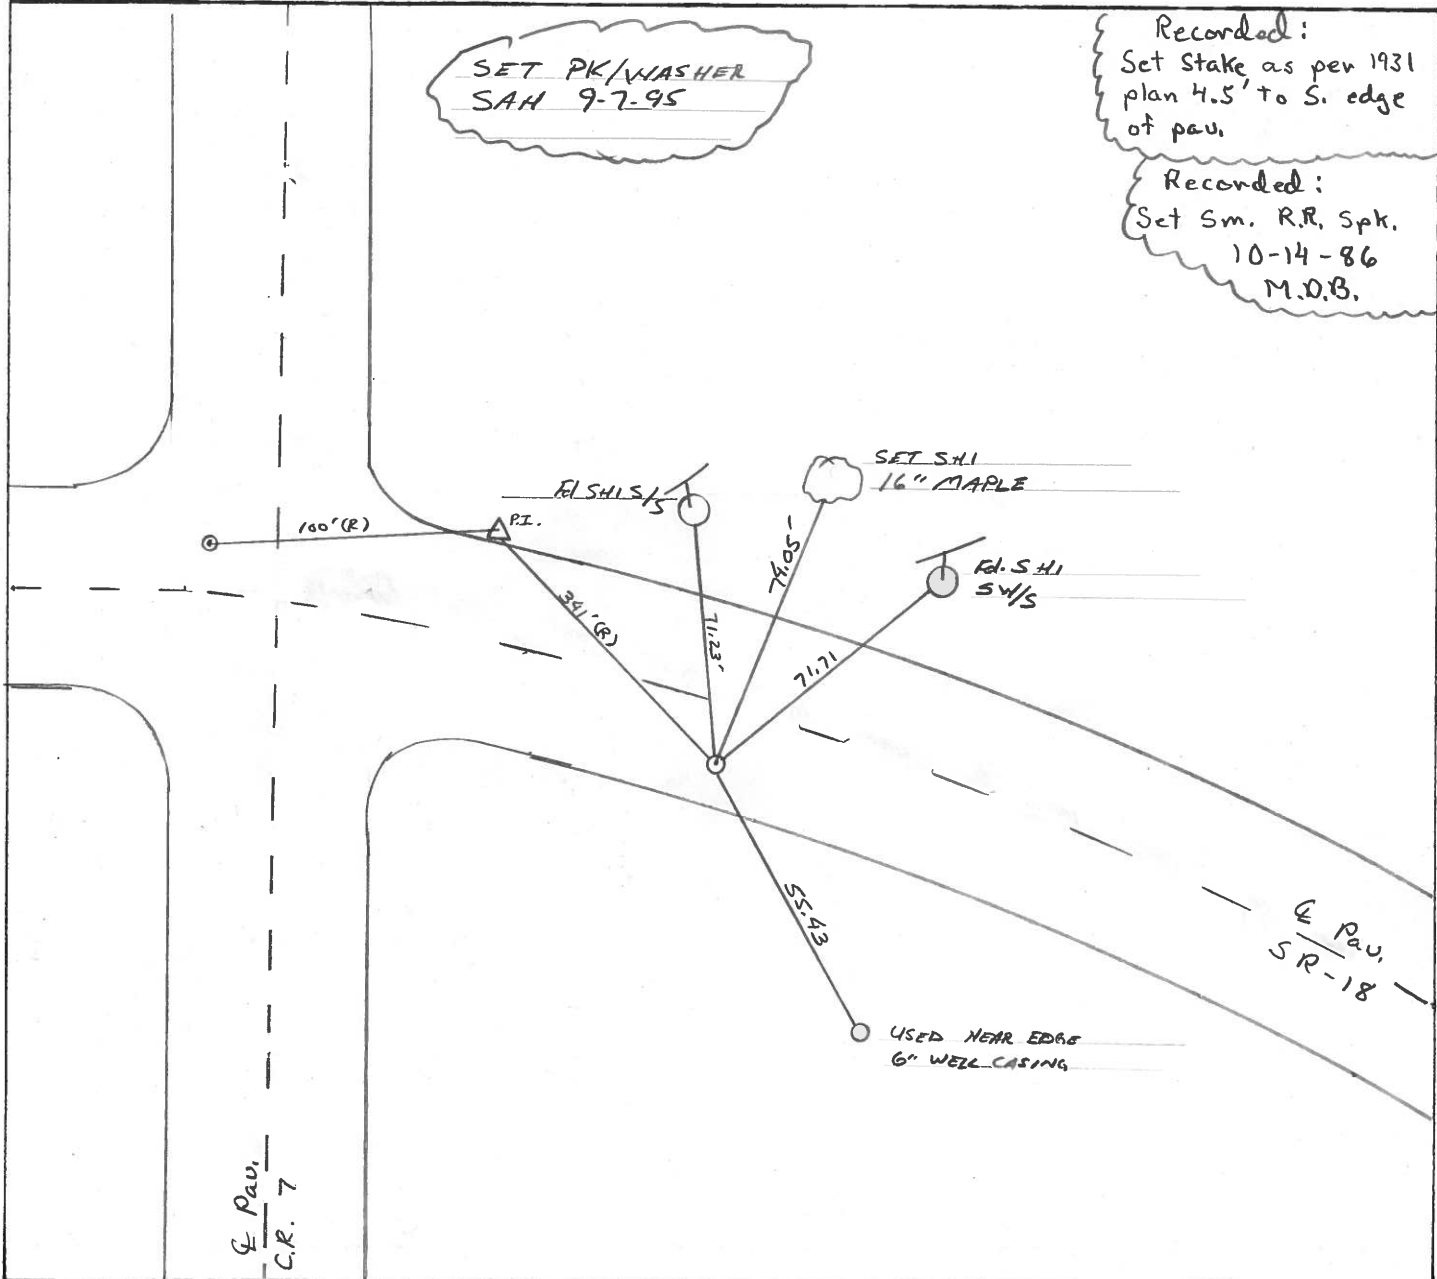

E Pav.
C.R. 7

E Pav.
SR-18

USED NEAR EDGE
6" WELL CASING

O.D.O.T. DISTRICT 2 SURVEY OFFICE

PERSONNEL

REFERENCE NO. 29-A+B SHEET OF

NOTES BARNHISEL

H.C. Loehrke

R.C. Sockman

DATE Aug 4, 1986

WEATHER SUNNY

TEMP. +84°

ROUTE SR 18

COUNTY HENRY

TOWNSHIP BARTLOW

SECTION 7

T 3 N R 8 E



TYPE MONUMENT 5m RR SPK

ON SURFACE - BELOW YES

LEFT - & PAV'T. - RIGHT 5.5


4.5 TO R+ EDGE PAVEMENT

S.L.M. 718+00

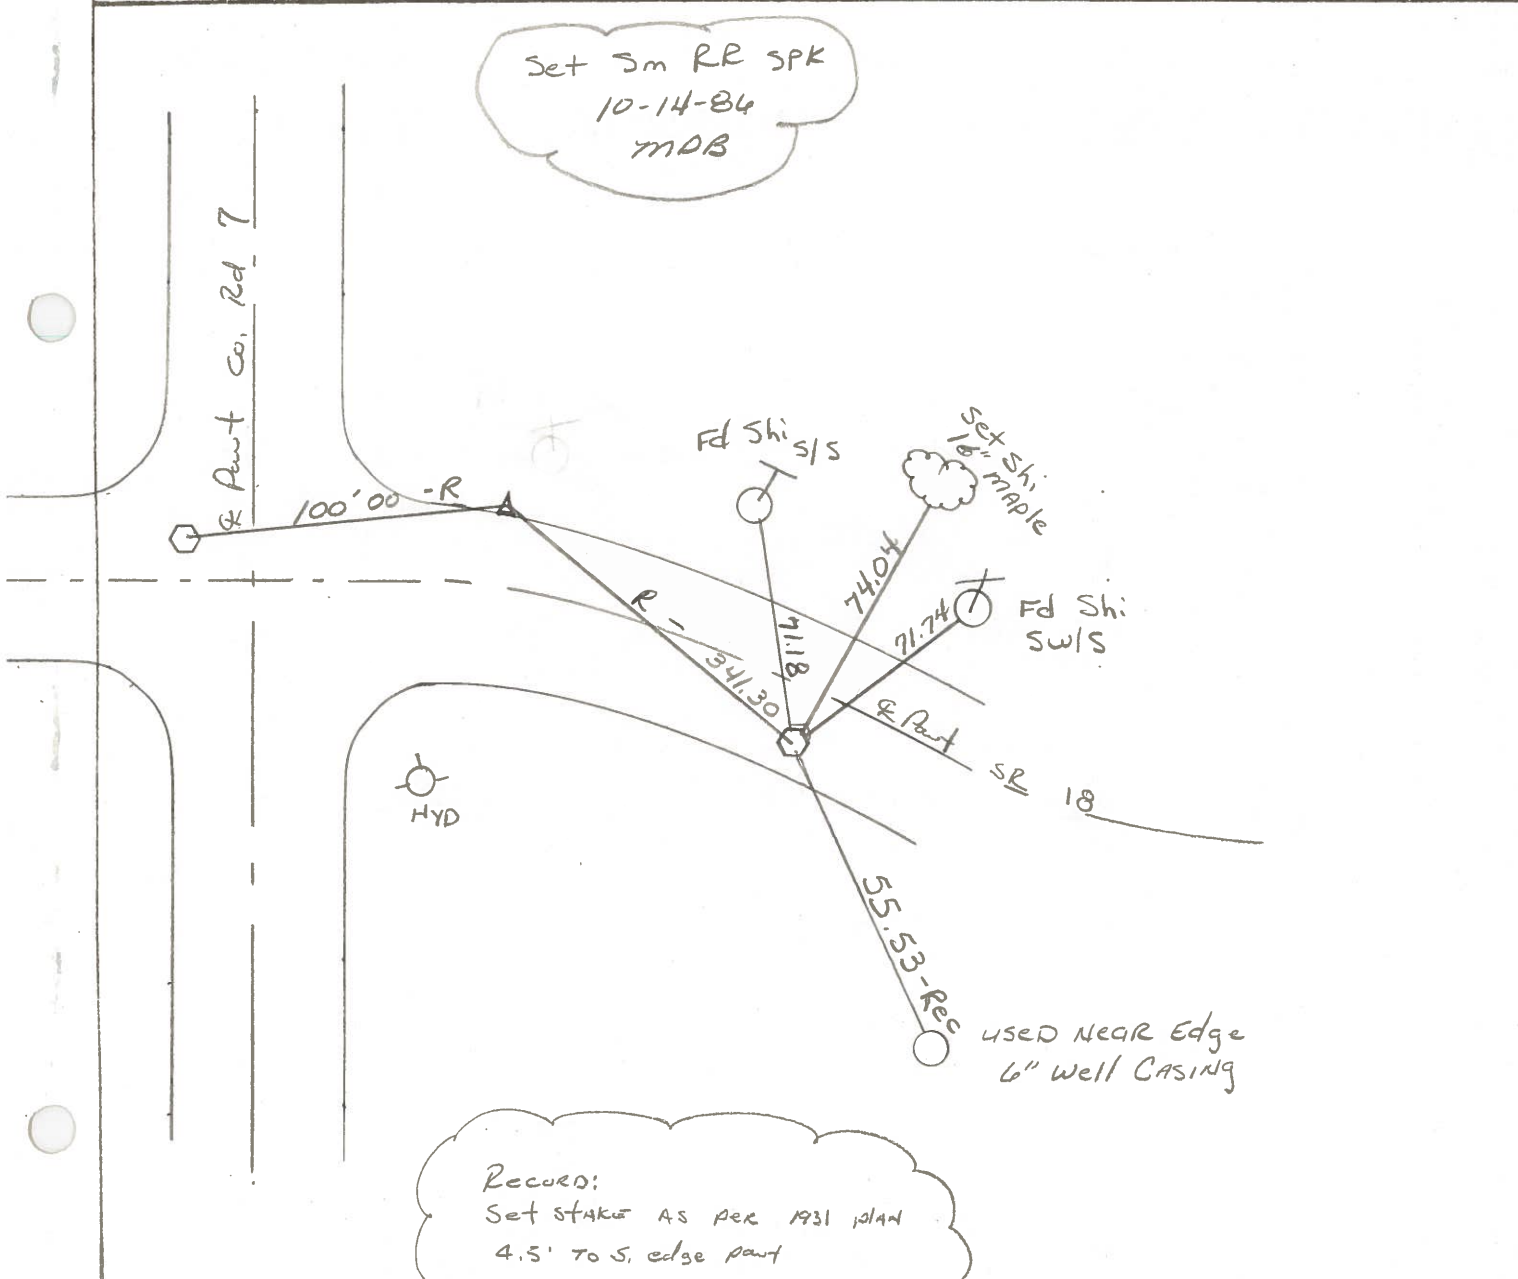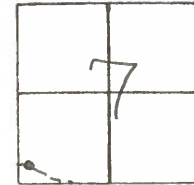

PERSONNEL	TITLE	PERSONNEL	TITLE	COUNTY	DATE
Stone				Henry	23 May 79
Deano				S. R. #18	WEATHER Clear
Curtis				SEC. Marion Twp.	TEMP. 65°
Michalak					


DESCRIPTION Refs. to Control Points JOB NO. 02999(0)

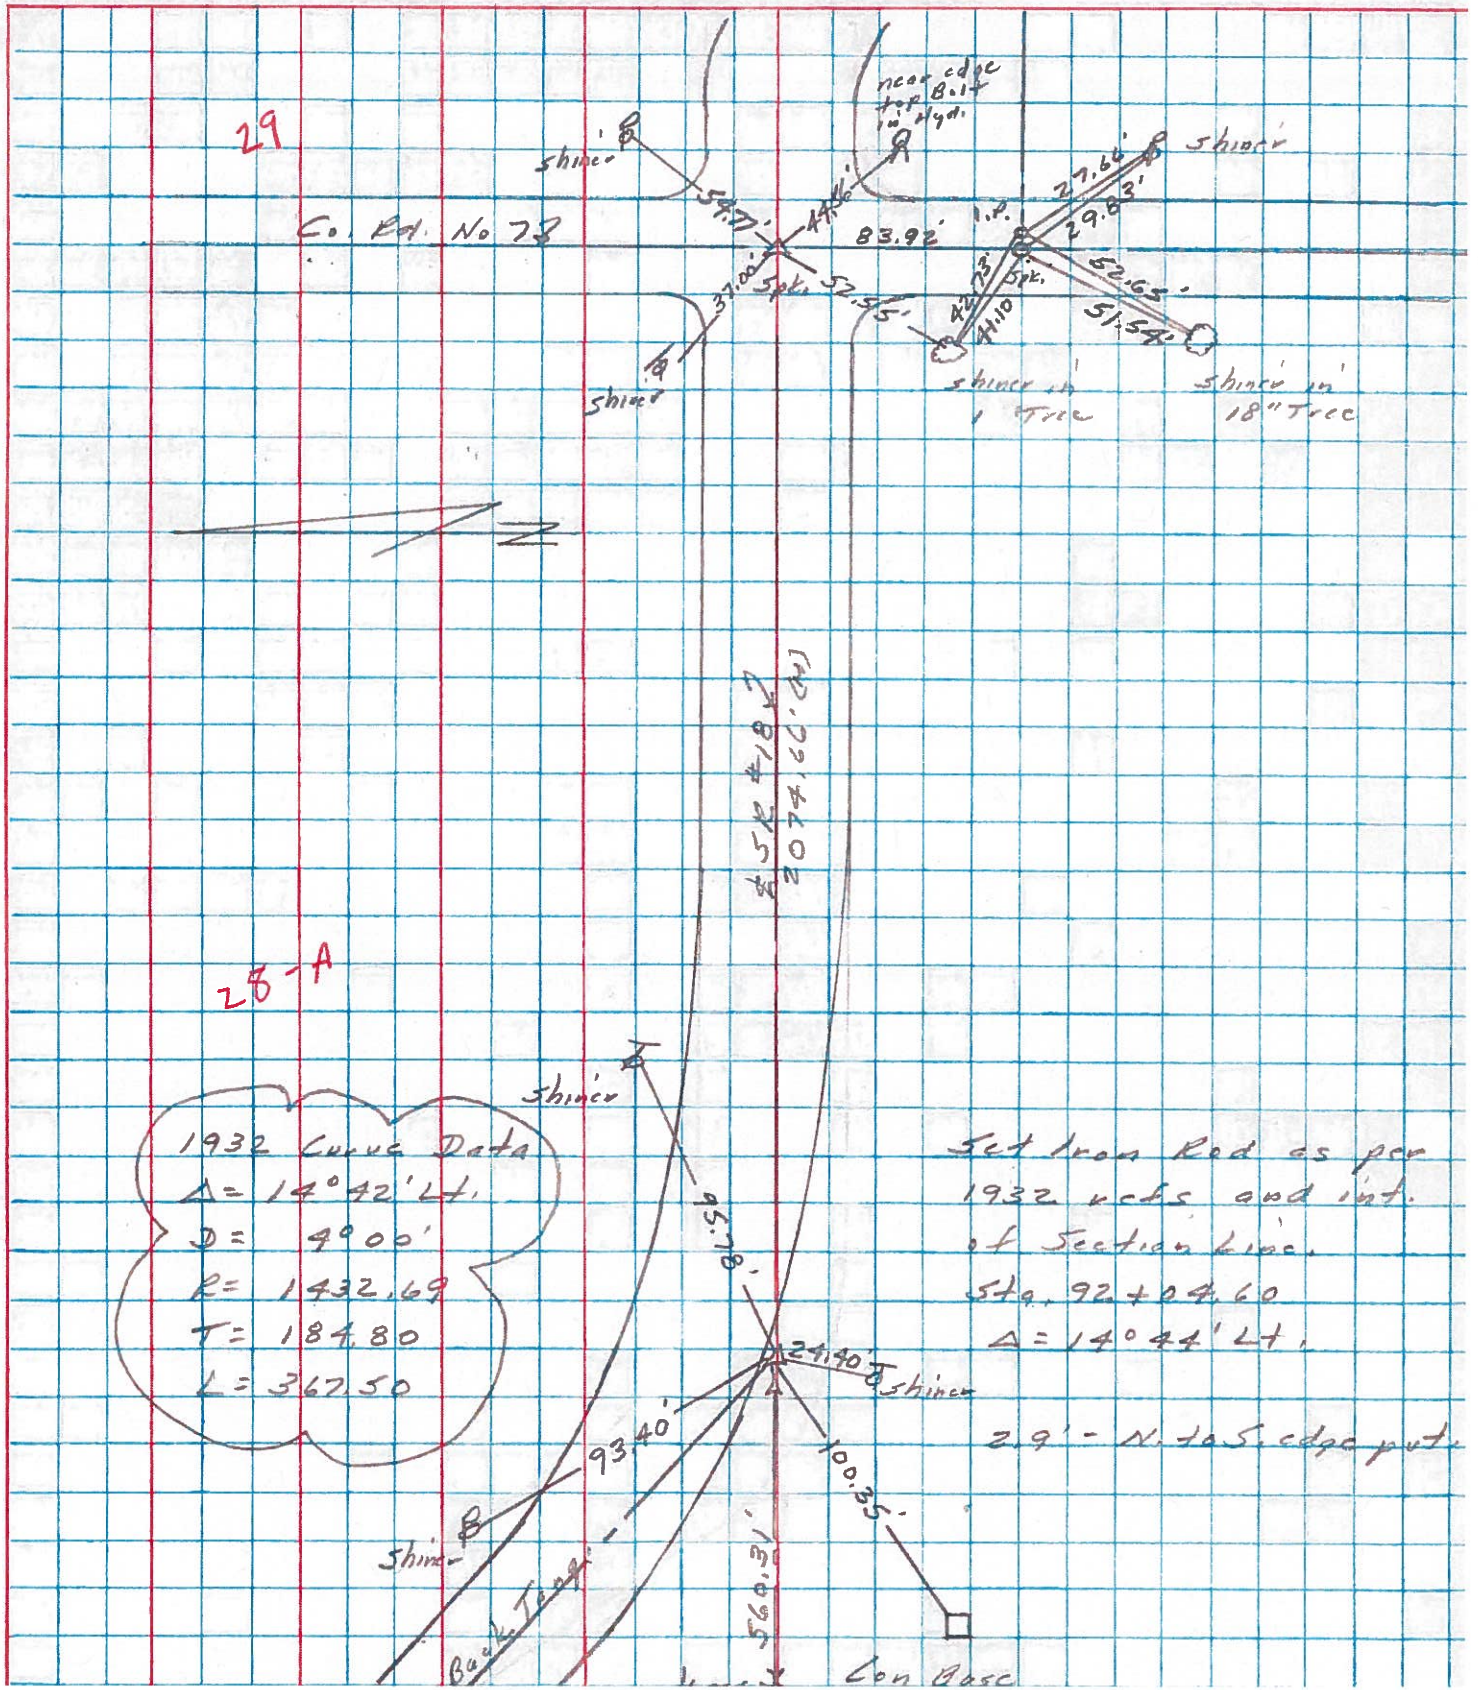

PERSONNEL	TITLE	PERSONNEL	TITLE
Stone			
Michalak			
Dennis			
Curtis			

COUNTY Henry DATE 23 April 74
 S. R. #18 WEATHER Cloudy
 SEC. Marion Twp. TEMP. 45°

DESCRIPTION Alignment JOB NO. 02799 (e)

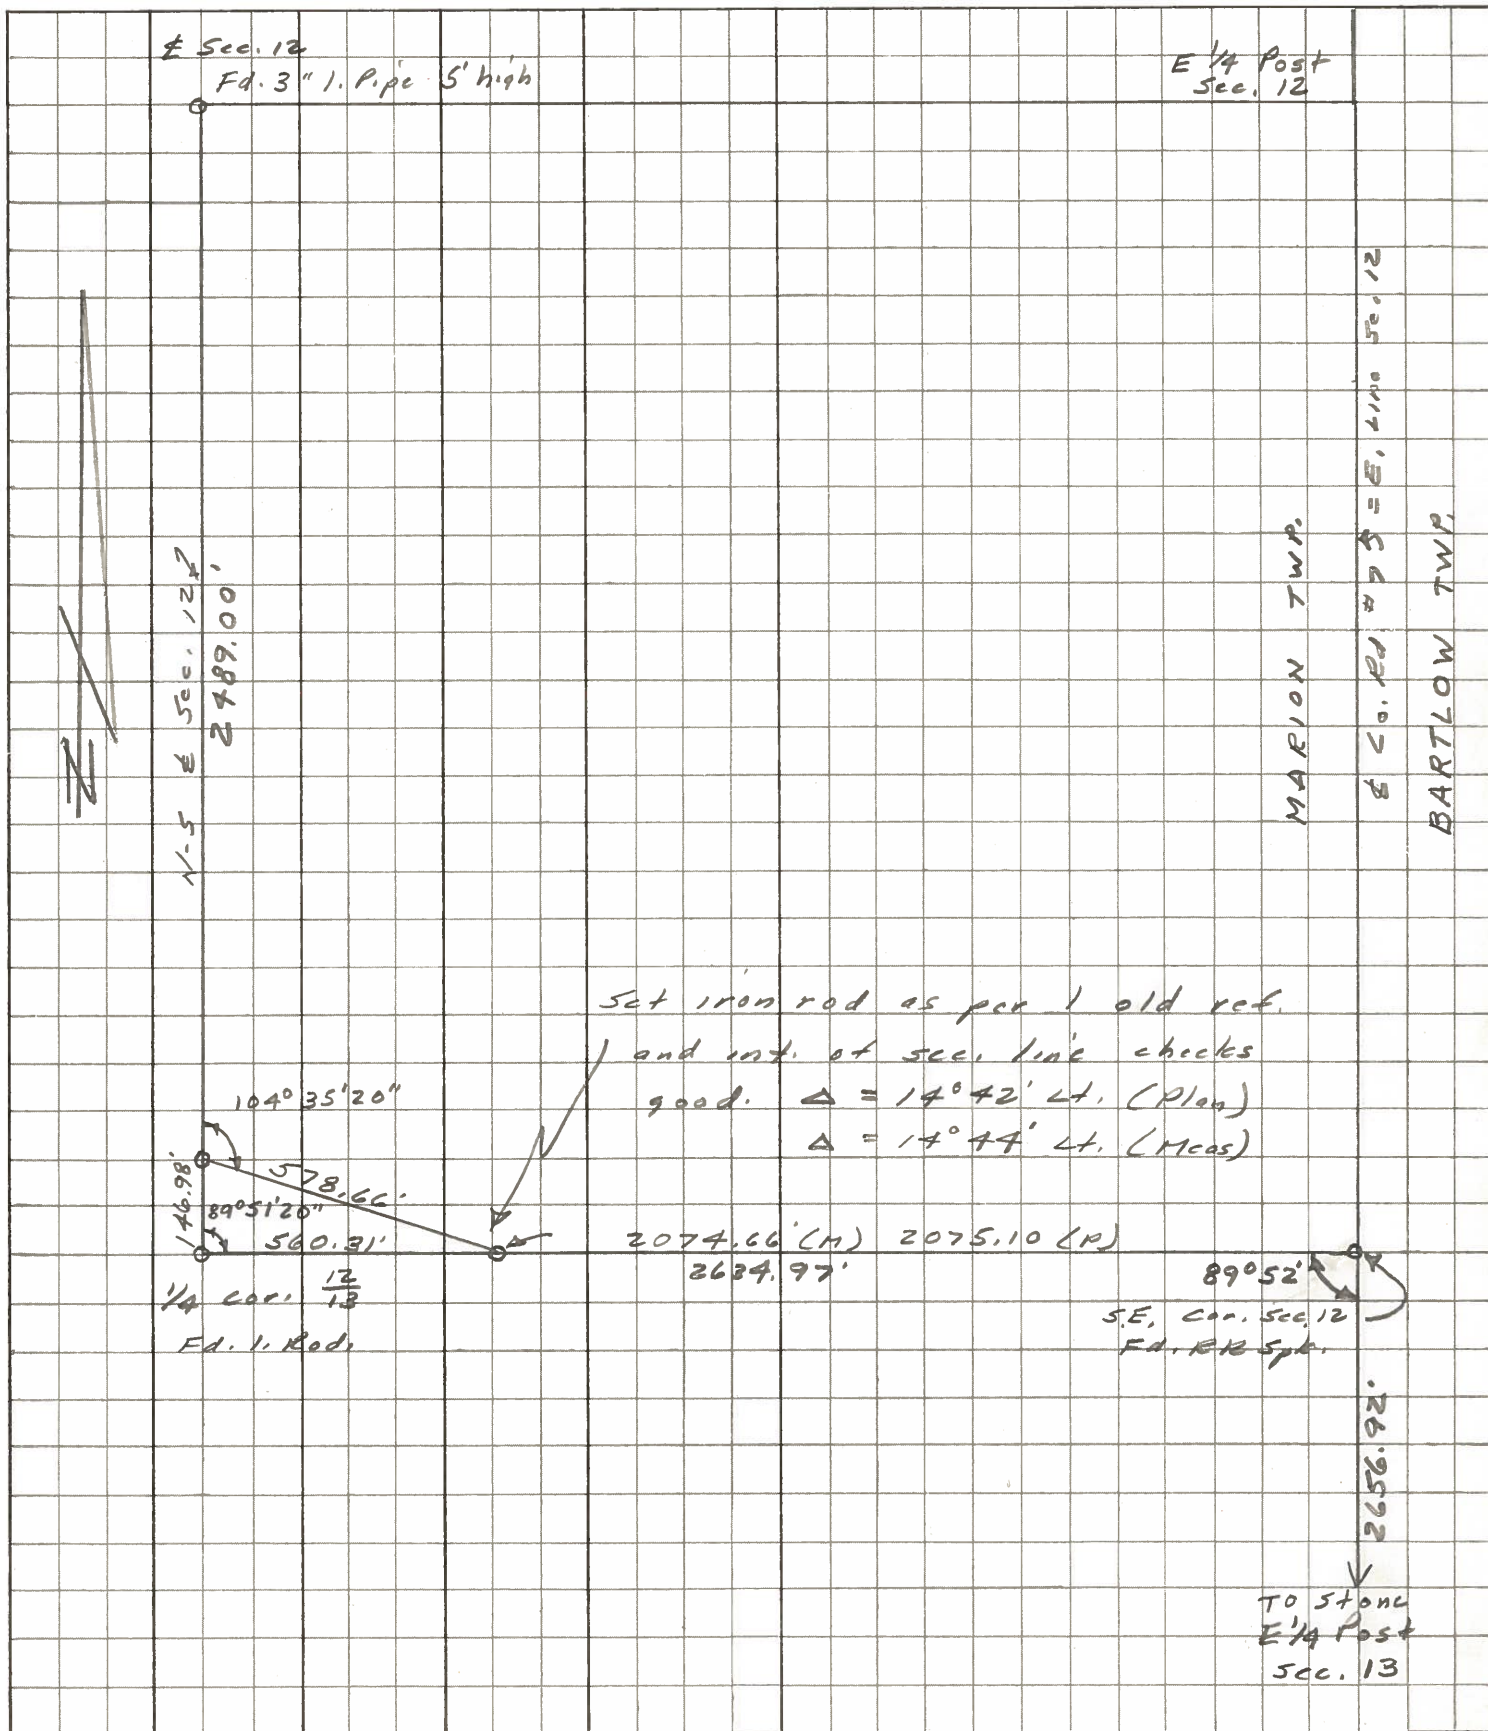

PERSONNEL TITLE PERSONNEL TITLE

Stone
 Michalak
 Deane
 Curtis

COUNTY Henry DATE 8 May 79

S. R. #18 WEATHER Cool

SEC. Bartlow Twp TEMP. 57°

DESCRIPTION

Alignment

JOB NO. 02999(10)

LEFT

CENTER LINE

RIGHT

