


O.D.O.T. DISTRICT 2 SURVEY OFFICE (USE ONLY)


PERSONNEL _____ REFERENCE NO. 39 SHEET 3 OF 17
 NOTES AUBLE DATE 5/18/21 ROUTE SR 18
 H.C. NIESE WEATHER CLEAR COUNTY HENRY
 R.C. O'DONNELL TEMP. 64° TOWNSHIP BARTLOW
 DWG BY NIESE PID PAVETRAIN SECTION 15
 T 3 N R 8 E

TYPE MONUMENT MAG/WASHER
 ON SURFACE - ~~BELOW~~ ON
 OFFSET CL PAVEMENT ON LT : RT
10.0' TO RT EDGE PAVEMENT
 STATION: 947+60.70

HORIZ.DATUM: NAD83(2011) GEOID: NAVD88 2012A
 GRID: NORTHING: 565908.365 EASTING: 1575187.813

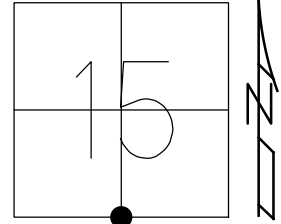

RECORD:
 RSPK SET BY HENRY CO.
 ENGINEER'S OFFICE WAS
 REMOVED DURING PAVING
 PROJECT
 FD LG SPIKE
 9/25/02, MB
 FD P.K./WASHER
 11/16/12, SDC
 11/20/12, SDC
 4/14/14, TMR
 4/15/14, TMR
 SET MAG/WASHER
 7/25/14, EBW
 FD MAG/WASHER
 7/29/14, JMR
 FD MAG/WASHER
 REF39
 5/18/21, JFO
 9/3/21, TDN


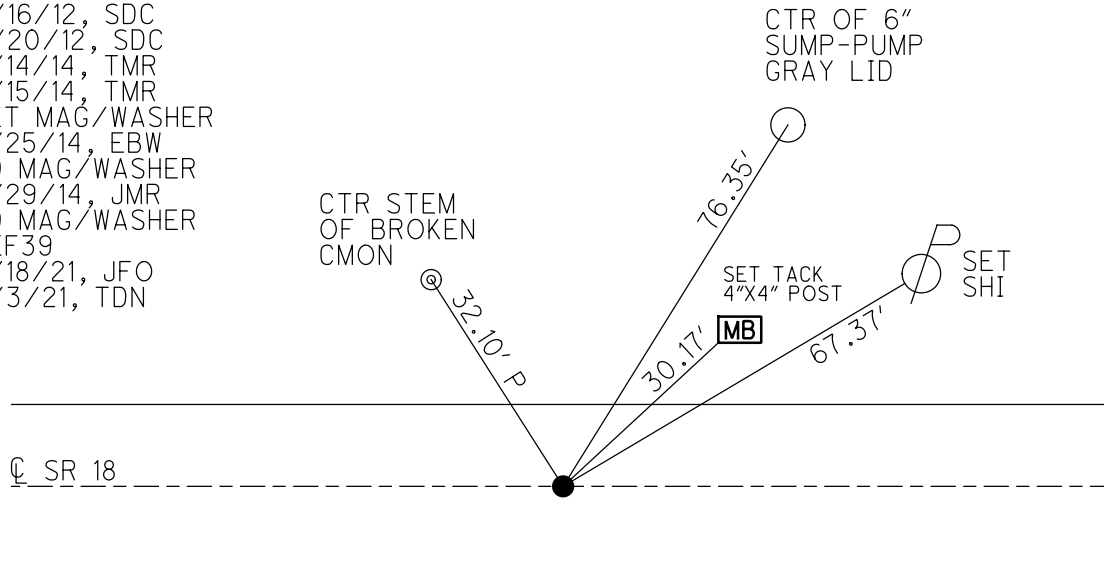


O.D.O.T. DISTRICT 2 SURVEY OFFICE (USE ONLY)

PERSONNEL _____ REFERENCE NO. 39 SHEET 2 OF 16
 NOTES RHOADES DATE 4/14/14 ROUTE SR 18
 H.C. ROUSOS WEATHER CLOUDY COUNTY HENRY
 R.C. RHOADES TEMP. 58° TOWNSHIP BARTLOW
 SECTION 15
 T 3 N R 8 E

TYPE MONUMENT PK/WASHER
 ON SURFACE - ~~BELOW~~ ON
 LEFT - Q PAV'T - RIGHT ON
10.0' TO RT EDGE PAVEMENT
 S.L.M. 947+60.7

Grid: Northing: 565908.339 Easting: 1575187.783

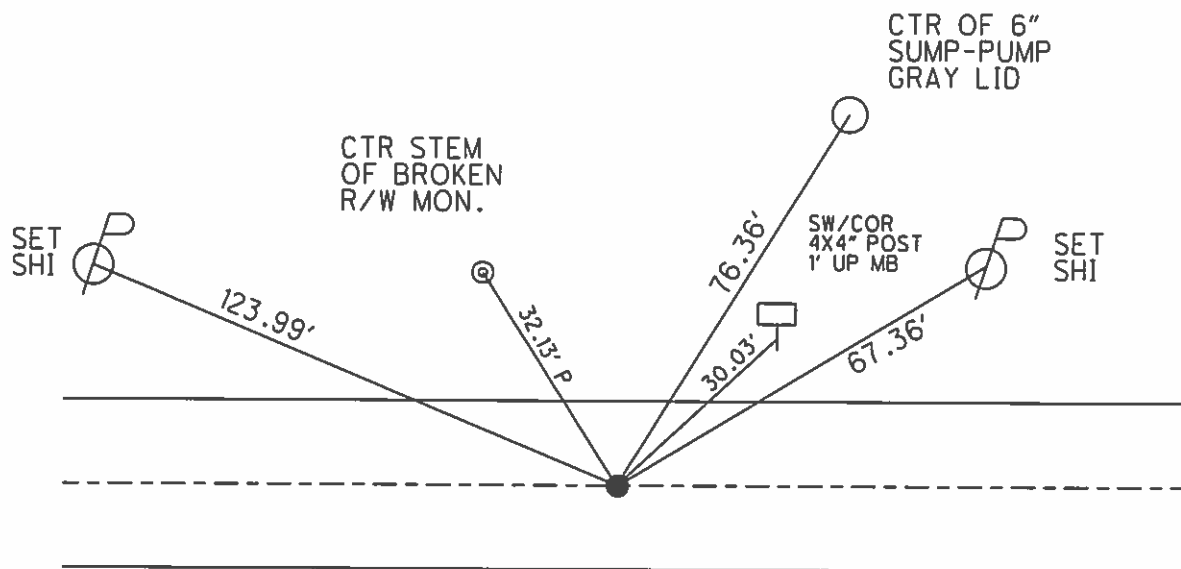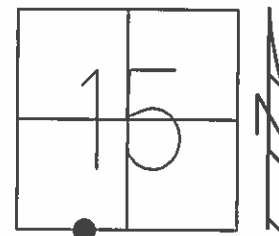

NOTE:
 RSPK SET BY HENRY CO.
 ENGINEER'S OFFICE WAS
 REMOVED DURING PAVING
 PROJECT. 9/25/02

RECORD:
 FD LG SPIKE
 9/25/02, MB

GPS, CL39
 11/20/12, SDC

SET MAG/WASHER
 7/25/14, EBW

FD PK/WASHER
 11/16/12, SDC

GPS, REF39
 4/15/14, TMR

GPS, NEWREF39
 7/29/14, JMR

O.D.O.T. DISTRICT 2 SURVEY OFFICE

PERSONNEL

REFERENCE NO. 39

SHEET 3 OF 3

NOTES Barnhisel

H.C. Canterbury

R.C. Barnhisel

DATE 9-25-02

WEATHER Sunny

TEMP. +70°

ROUTE 18

COUNTY Henry

TOWNSHIP Bartlow

SECTION 15

T 3 N 8 E


TYPE MONUMENT Lg Spike

ON SURFACE - ~~BELOW~~ on surface


~~LEFT - C~~ PAV'T. - ~~RIGHT~~

10' TO RT EDGE PAVEMENT

S.L.M. 948+22

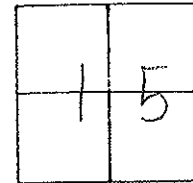

Mag Nail Removed,
Railroad Spike Reset
Date _____

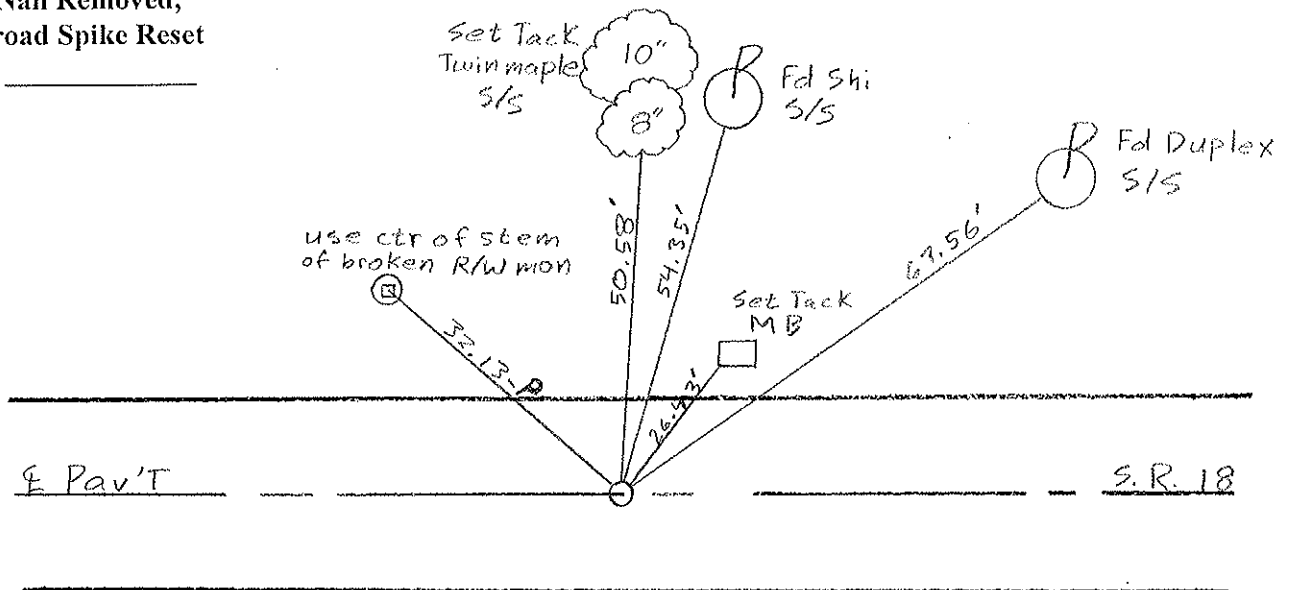

Railroad Spike Set by Henry Co.
Engineer's Office was Removed
During Paving Project
Date 9-25-02

O.D.O.T. DISTRICT 2 SURVEY OFFICE

PERSONNEL

REFERENCE NO. 39

SHEET 3 OF 3

NOTES BARNHISEL

H.C. KUSZ

R.C. BARNHISEL

OTTO

DATE 7-22-93

WEATHER SUNNY

TEMP. +70°

ROUTE 18

COUNTY HENRY

TOWNSHIP BARTLOW

SECTION 15

T 3 N R 8 E


TYPE MONUMENT Sm. RR Spk

ON SURFACE - BELOW YES

~~LEFT~~ - PAV'T. - ~~RIGHT~~ YES

10.4 TO RT EDGE PAVEMENT

S.L.M. 948+22

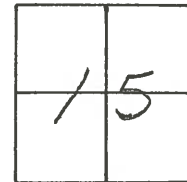

Reset PK & WASHER
10-13-93
MB

USE CTR OF STEM
OF BROKEN P/W MON

SET TACK
S/S
TWIN
maple

SET SH.
S/S

Fd Duplex
S/S

MAIL BOX SET TACK

E PAV'T

S.R. 18

R.R. SPIKE
@ SURFACE
~~100~~ A24

Now
3" down

O.D.O.T. DISTRICT 2 SURVEY OFFICE

PERSONNEL

REFERENCE NO. 39

SHEET OF

NOTES Hoffman

H.C. BARNHISEL

R.C. LOCHRIE

DATE 5-15-85

WEATHER Cloudy

TEMP. 70°

ROUTE SR 18

COUNTY HENRY

TOWNSHIP BARTLOW

SECTION 15

T 3 N R 8 E


TYPE MONUMENT R.R. SPIKE

ON SURFACE - BELOW 1 1/2"


~~LEFT - & PAW'T. - RIGHT~~ ON &

9.9 TO RT. EDGE PAVEMENT

S.L.M. 949+41

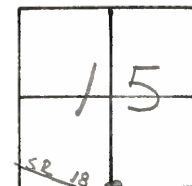

Set 5m / RR SPK
6-27-85
MDB

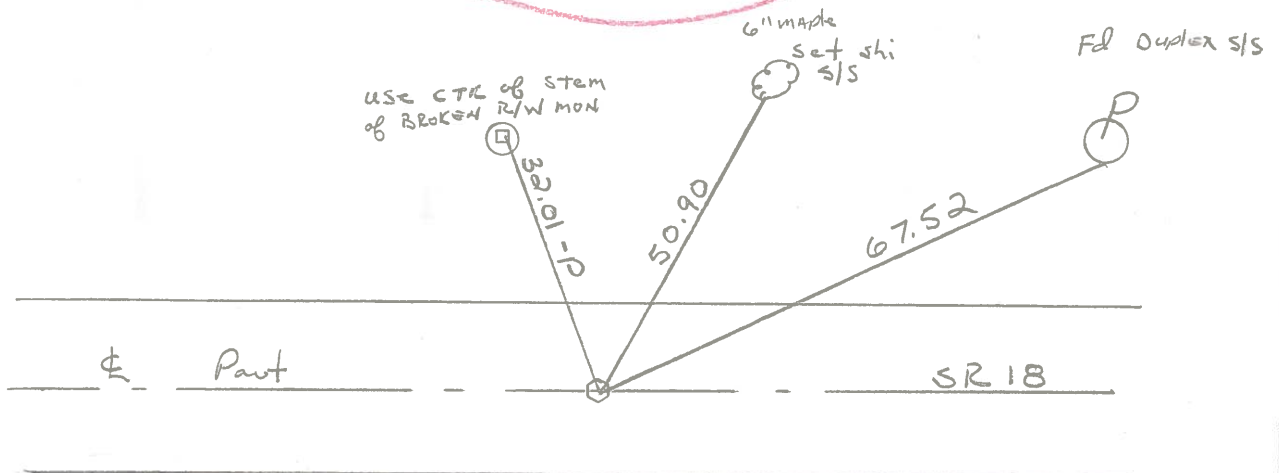

PERSONNEL	TITLE	PERSONNEL	TITLE	COUNTY	DATE
Stone				Henry	8 Oct. 74
Michalak				S. R. #18	WEATHER Cool
Danno				SEC. Barlow Twp.	TEMP. 50°
Curtis					
DESCRIPTION	Refs to Control Points			JOB NO.	
	LEFT	CENTER LINE	RIGHT		

