

O.D.O.T. DISTRICT 2 SURVEY OFFICE (USE ONLY)

PERSONNEL

REFERENCE NO. 40

SHEET 4 OF 17

NOTES AUBLE

DATE 5/18/21

ROUTE SR 18

H.C. NIESE

WEATHER CLEAR

COUNTY HENRY

R.C. O'DONNELL

TEMP. 64°

TOWNSHIP BARTLOW

SECTION 15

DWG BY NIESE PID PAVETRAIN

T 3 N R 8 E

TYPE MONUMENT MAG/WASHER

ON SURFACE - ~~BELOW~~ ON

OFFSET CL PAVEMENT 5.7' ~~LT~~ : RT

- TO - EDGE PAVEMENT


STATION: 974+10

HORIZ.DATUM: NAD83(2011)

GEOID: NAVD88 2012A

GRID: NORTHING: 565906.445

EASTING: 1577837.113

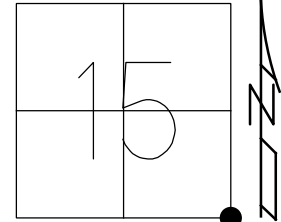

RECORD:

FD P.K./WASHER

8/6/01, MB

FD P.K. SHANK

11/16/12, SDC

11/20/12, SDC

4/14/14, TMR

4/15/14, TMR

SET MAG/WASHER

7/25/14, EBW

7/29/14, JMR

FD MAG SHANK,

PULLED,

SET MAG/WASHER


REF40

5/18/21, JFO

FD MAG/WASHER

9/3/21, TDN

NOTE: 5.6' W OF CR 3

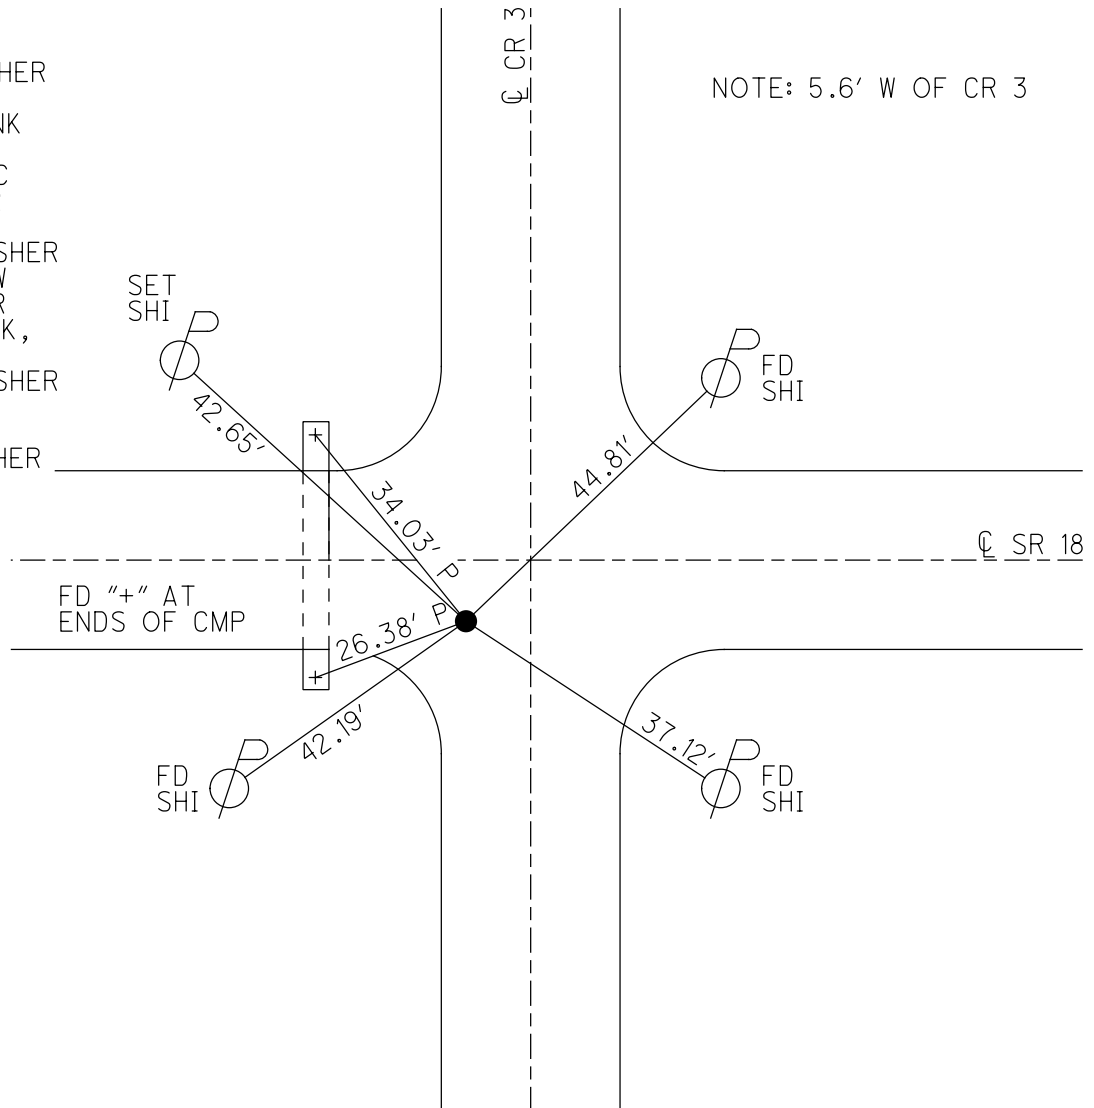

O.D.O.T. DISTRICT 2 SURVEY OFFICE (USE ONLY)

PERSONNEL

REFERENCE NO. 40

SHEET 3 OF 16

NOTES RHOADES

DATE 4/14/14

ROUTE SR 18

H.C. ROUSOS

WEATHER CLOUDY

COUNTY HENRY

R.C. RHOADES

TEMP. 58°

TOWNSHIP BARTLOW

SECTION 23

T 3 N R 8 E

TYPE MONUMENT PK SHANK


ON SURFACE - ~~BELOW~~ ON

~~LEFT~~ - CL PAV'T - RIGHT 5.7', 5.6' W.OF CR 3

- TO - EDGE PAVEMENT

S.L.M. 974+10

Grid: Northing: 565906.471 Easting: 1577837.095

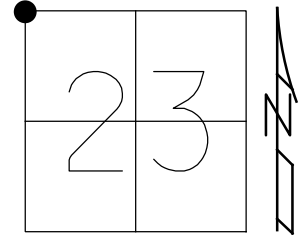

RECORD:

FD PK/WASHER
8/6/01, MB


GPS, CL40
11/20/12, SDC

FD PK SHANK
11/16/12, SDC

GPS, REF40
4/15/14, TMR

SET MAG/WASHER
7/25/14, EBW

GPS, NEWREF40
7/29/14, JMR

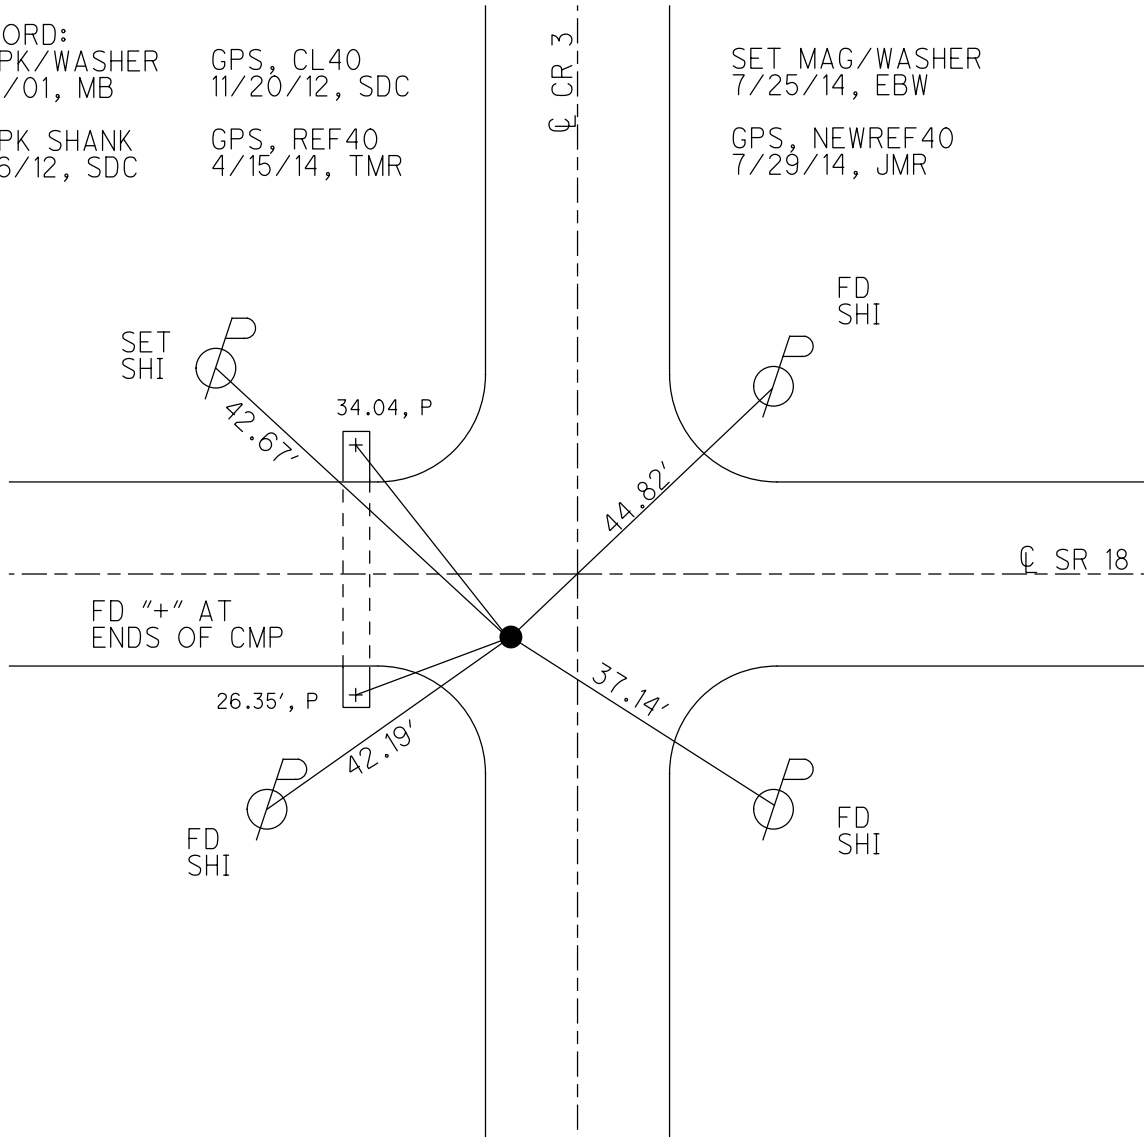

O.D.O.T. DISTRICT 2 SURVEY OFFICE

PERSONNEL

REFERENCE NO. 40

SHEET 1 OF 14

NOTES CANTERBURY

H.C. BARNHISEL

R.C. MOSE

DATE 8/6/01

WEATHER SUN

TEMP. +93°

ROUTE 18

COUNTY HENRY

TOWNSHIP BARTLOW

SECTION 23

T 3 N R 8 E

TYPE MONUMENT P.K. & WASHER



ON SURFACE - BELOW SURFACE

LEFT - & PAV'T. - RIGHT 5.7' RT &

TO - EDGE PAVEMENT

S.L.M. 974 + 08

5.6' W. OF CO. RD. "3" S.

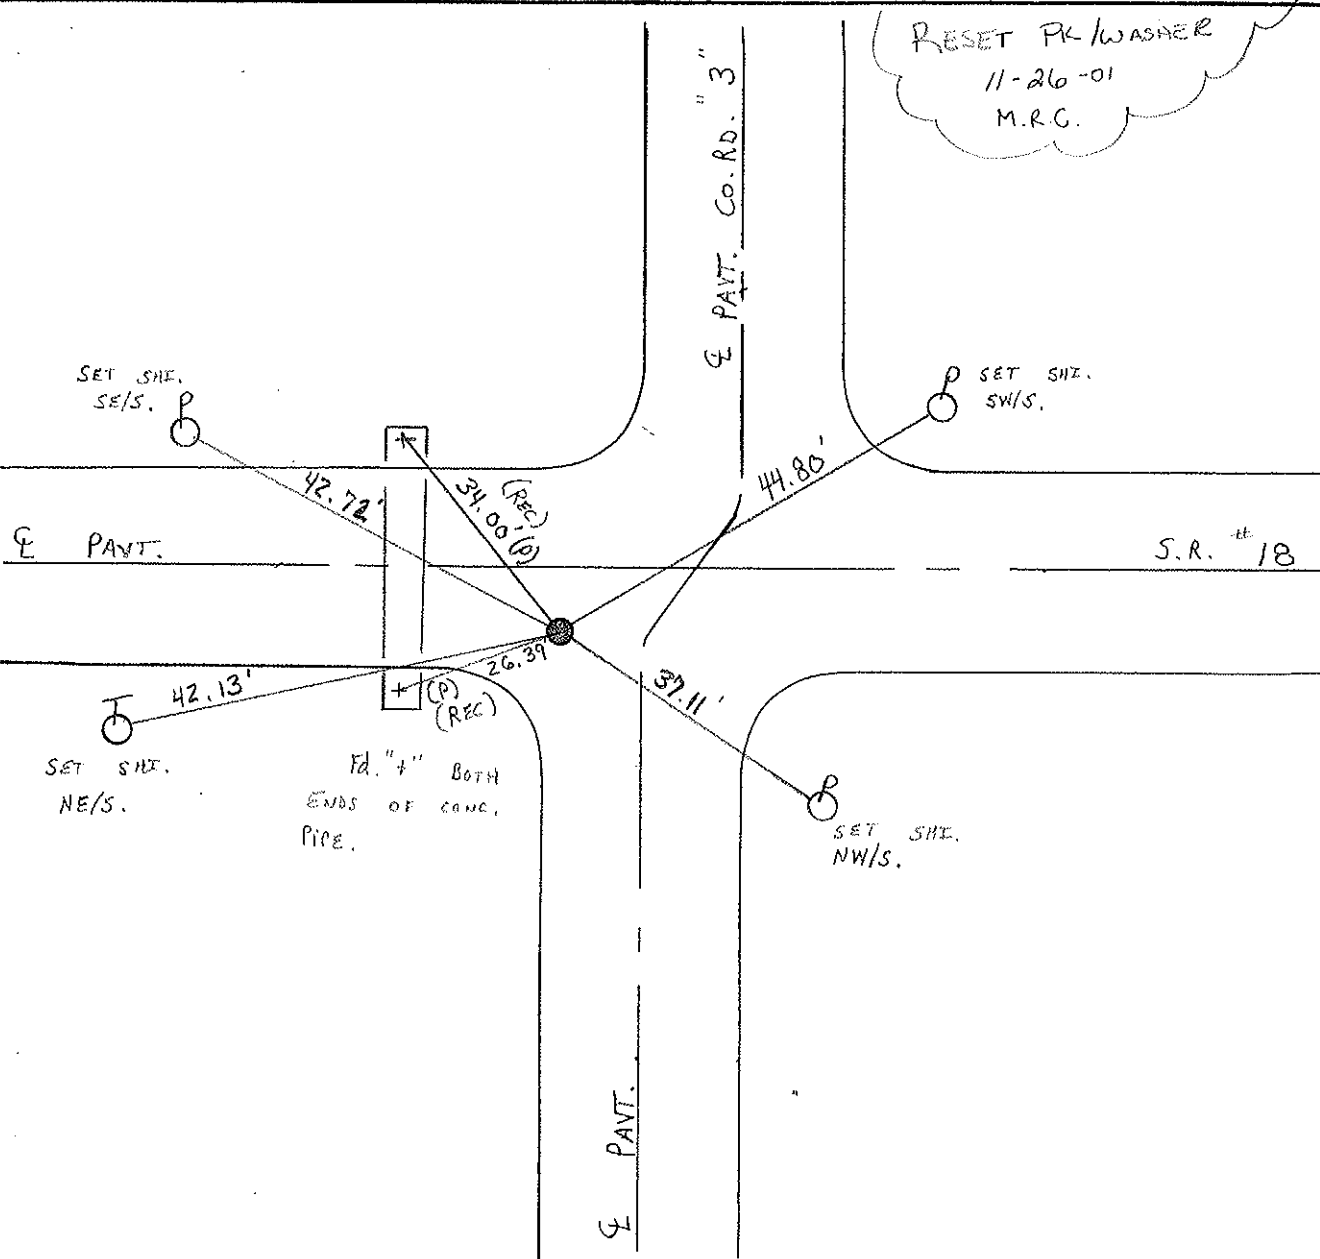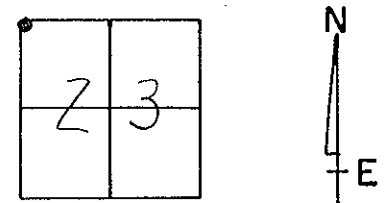

Resurveyed 2001

O.D.O.T. DISTRICT 2 SURVEY OFFICE

PERSONNEL

REFERENCE NO. 46

SHEET OF

NOTES BARNHISEL

H.C. " "

R.C. HOFFMAN

DATE 10-19-90

WEATHER cloudy

TEMP. +43°

ROUTE 18

COUNTY HENRY

TOWNSHIP BARTLOW

SECTION 23

T 3 N R 8 E

TYPE MONUMENT P.K. / Washer

ON SURFACE - BELOW yes


LEFT - CL PAV'T. - RIGHT Lo.1

— TO — EDGE PAVEMENT


S.L.M. 974+08

7.3 W. OF E Co. Rd. N.

3.3 W. OF E Co. Rd. S.

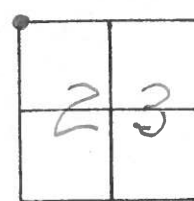

Set P.K. / Washer
11-13-90
MB

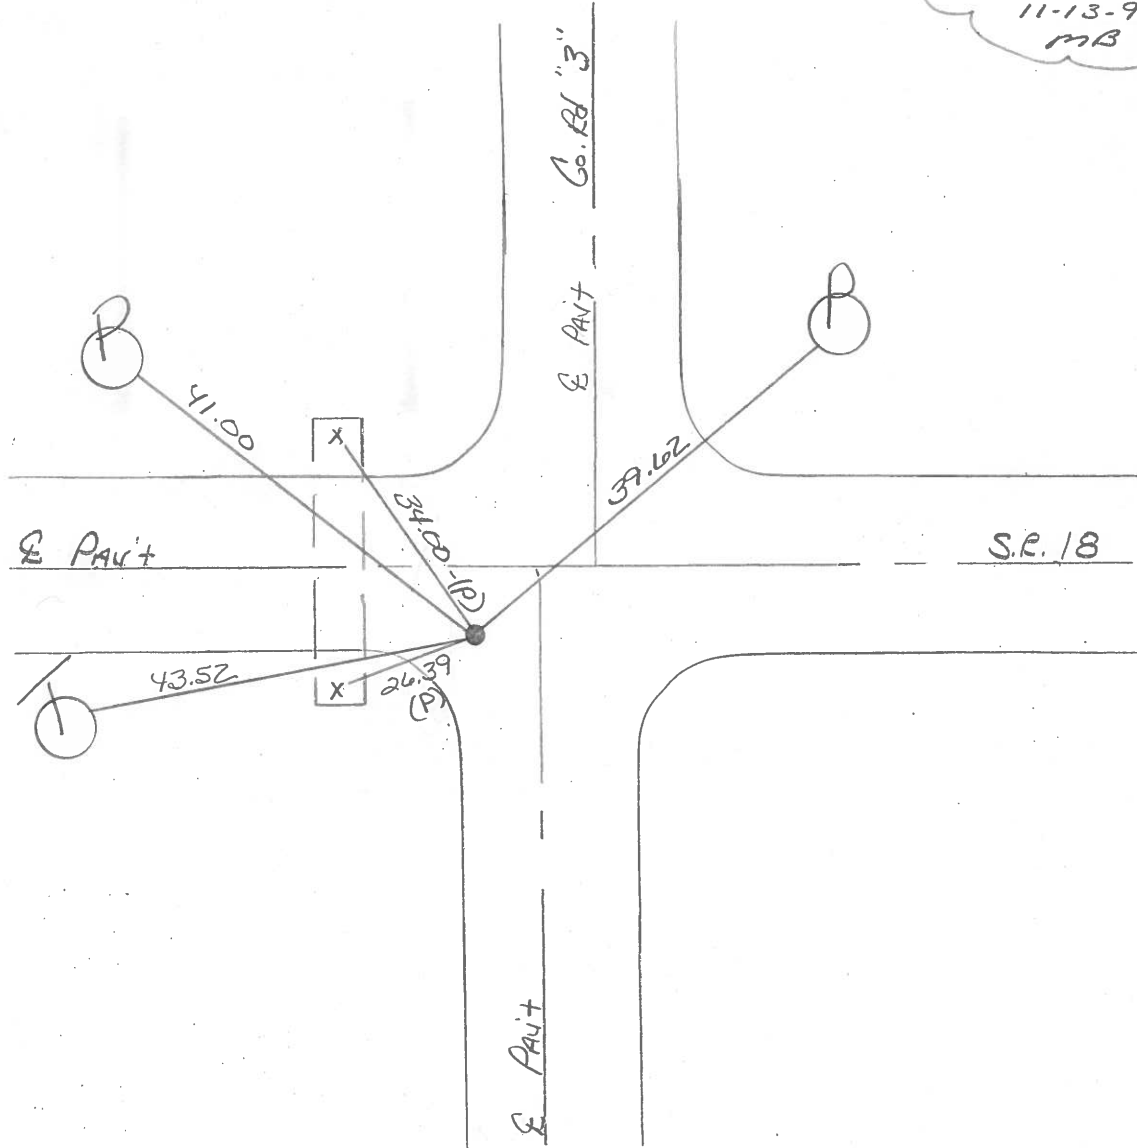

County HENRY S.R. 18Township BARTLOW

Section _____

T3N, R8EPersonnel HOFFMANLOEHRKEHOUSEHOLDERBARNHISEL

#40

Date April 7, 83Weather OVERCASTTemp. +45°

15	14
22	23



Fd SMALL R.R. SPK @ SURFACE

6.0' Rt of & PAUT SR 18

8.0' West of & PAUT Co. Rd "3" N


4.0' " of & " " " "3" S

SET P.K./WASHER

9-20-83


C.L.

SLM 974+11

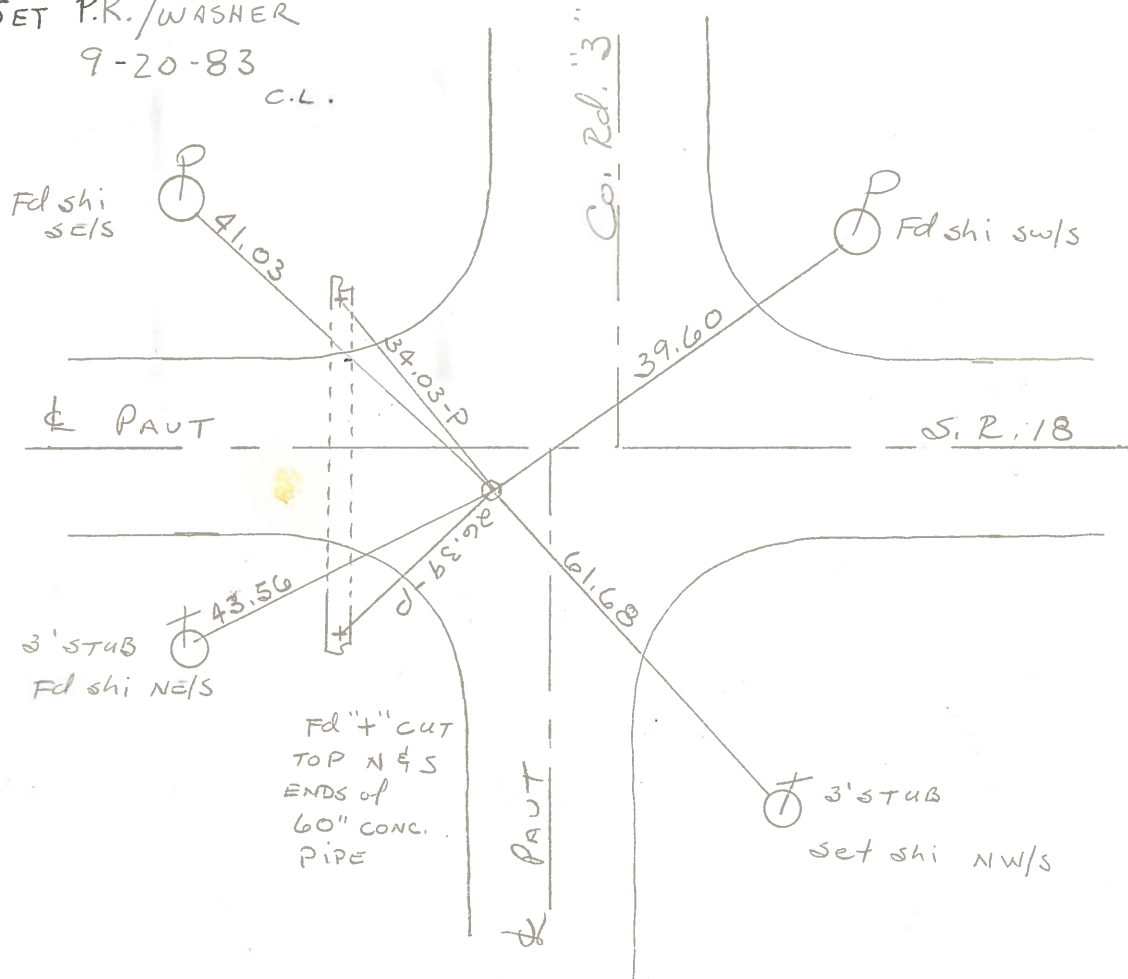

PERSONNEL	TITLE	PERSONNEL	TITLE	COUNTY	DATE	WEATHER	TEMP.
Stone				Henry	26 Aug. 79	Mild	72°
Michalek				S. R. #18			
Dennis				SEC. Bartlow Twp.			
Curtis							

DESCRIPTION Alignment LEFT CENTER LINE RIGHT JOB NO. 02999(9)

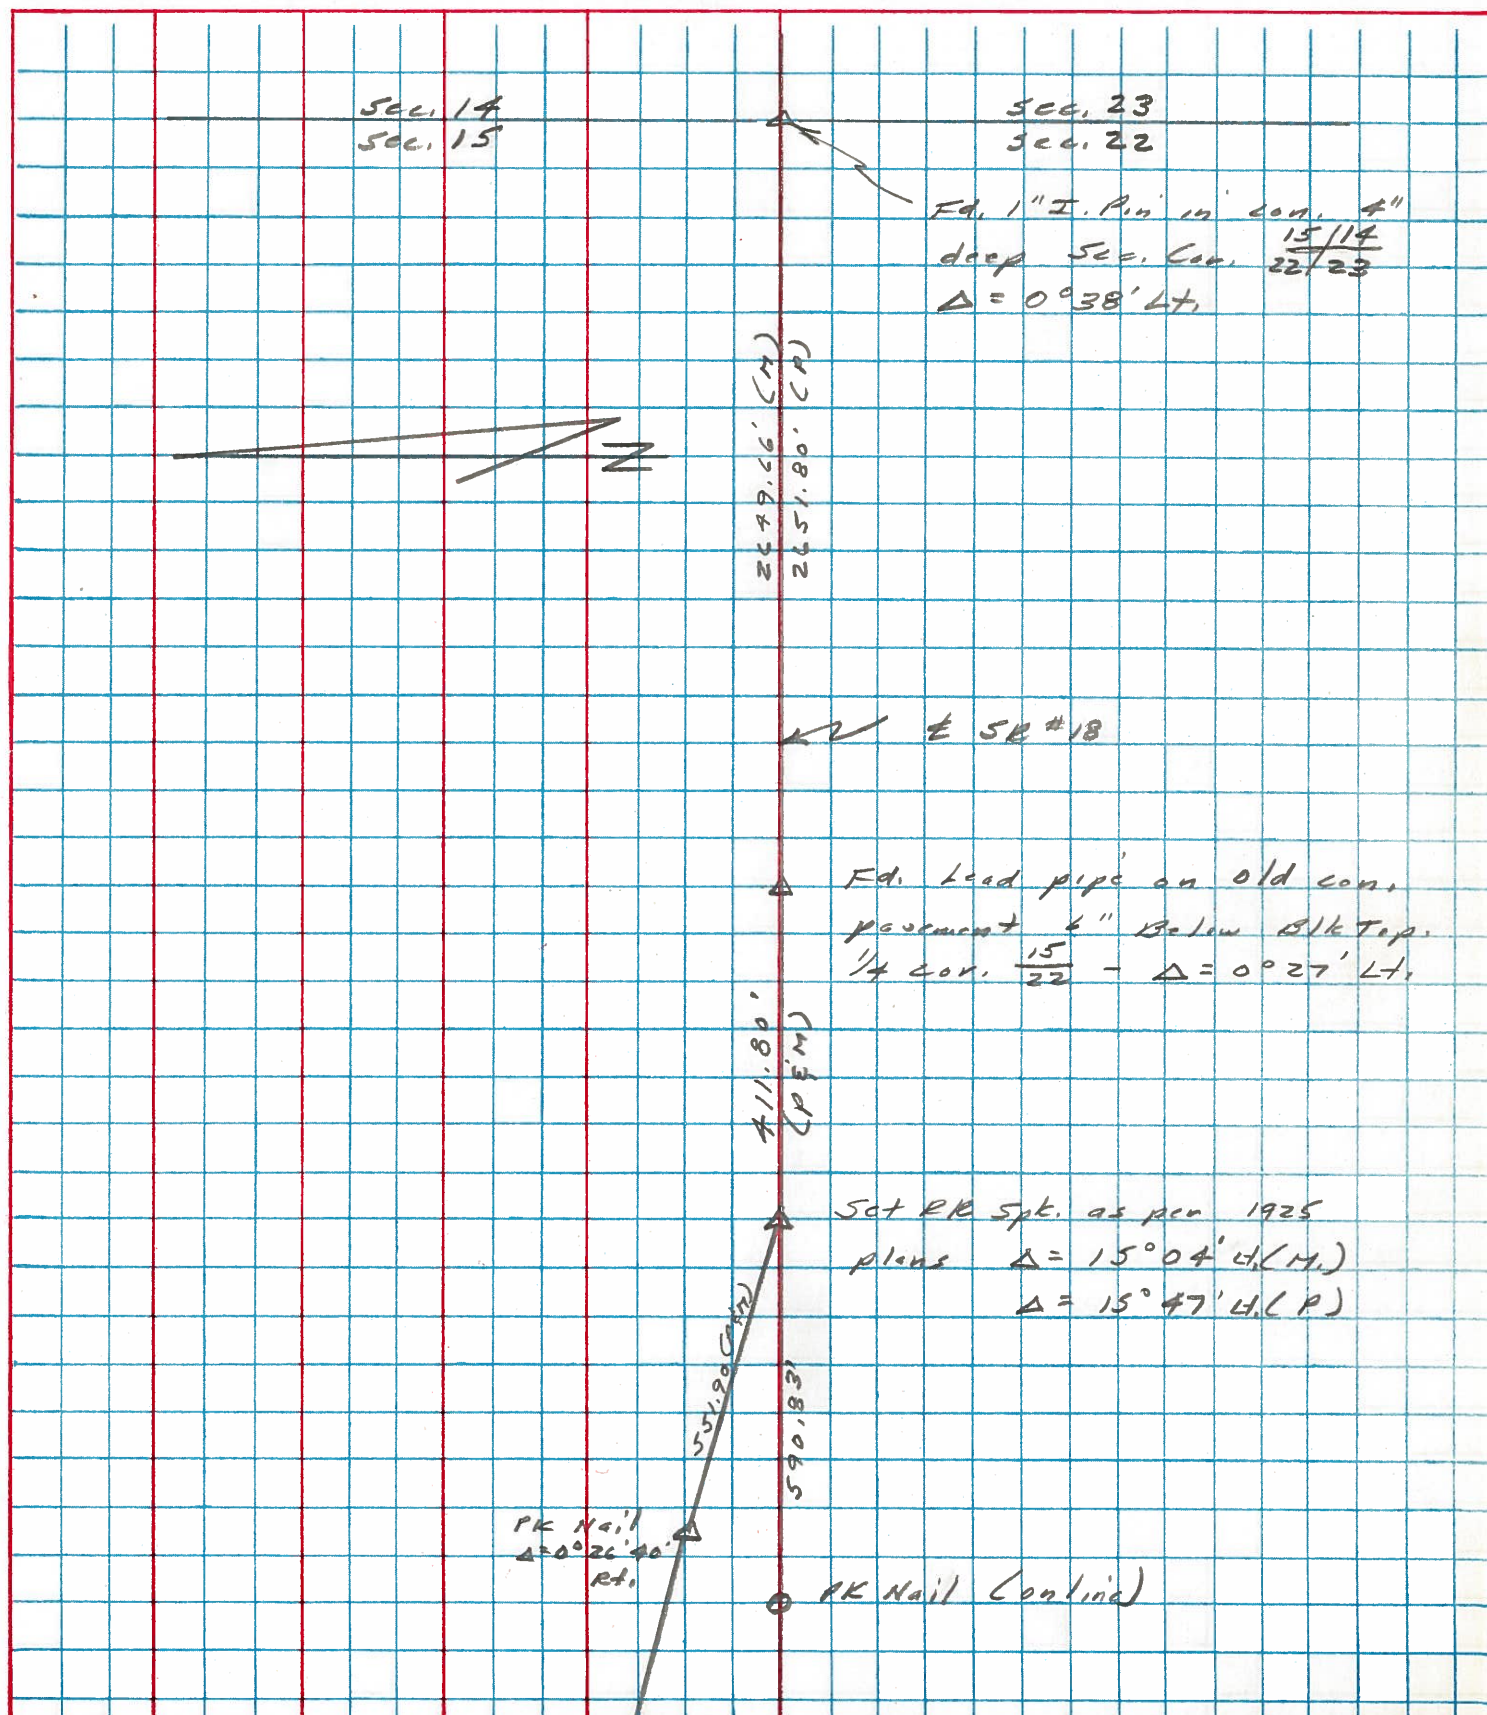

PERSONNEL	TITLE	PERSONNEL	TITLE
Stone			
Michalek			
Dennis			
Curtis			

COUNTY Henry DATE 3 Sept. 74

S. R. #18 WEATHER Cloudy

SEC. Berthow Twp. TEMP. 56°

DESCRIPTION Alignment LEFT CENTER LINE RIGHT JOB NO. _____

$$\Delta \begin{array}{r} 108 + 767 \\ 100 + 63.4 \\ \hline 813.3 \end{array}$$

1925 Plans gives

$$\begin{array}{r} \text{P.I.} \quad 124 + 27.5 \quad \text{P.T.} \quad 124 + 27.5 \\ \text{C.R.} \quad 100 + 63.4 \\ \hline 2364.1 \end{array}$$

$$\begin{array}{r} 124 + 27.5 \\ 108 + 76.7 \\ \hline 1550.8 \end{array}$$

$$\begin{array}{r} 1553.00' (P) \\ 1553.00' (M) \end{array}$$

$$\begin{array}{r} 818.30' (P) \\ 818.30' (M) \end{array}$$

Made extensive search
Could Not find
Set 1/2" iron pipe as per
1925 plans $\Delta = 29^{\circ}56' (P)$
 $\Delta = 30^{\circ}01'40'' (M)$

Made extensive search - (Could not find)
Set RR Spk. as per
1925 plans - $\Delta = 1^{\circ}18' \text{ R.I. } (P)$
 $\Delta = 1^{\circ}18' \text{ R.I. } (M)$

Sec. 14
St. 15

1" I.P. 5
 $\Delta = 0^{\circ}38' 44''$

Sec. 23
Sec. 22

PERSONNEL TITLE PERSONNEL TITLE

Stone

COUNTY HenryDATE 17 May 73

Danno

S. R. #18WEATHER Fair

Michalak

SEC. DeshlerTEMP. 52°

Curtis

DESCRIPTION

References to Control Points

JOB NO.

LEFT

CENTER LINE

RIGHT

Fd. Stone 7" deep
24' to North edge pt
25' to South edge pt.

V 1025+48.65 ±

Corn City
Bar
Hic!

chiseled "t" on
con. base to
U-haul sign

E Main St.

chiseled "t" on
metal light post

Deshler Hdw.

chiseled "t" on Con.
Step to upstairs Res.

Charles Co.

Dept. Store

40

Sec. Cor. $\frac{15}{22} \frac{14}{23}$ Bartlow Twp.
Fd. 1" 1. Pin in Concrete 1 1/2"
deep. Sta. 974+16.0 = S.L.M.

E SR #18

shiner

39.58'

shiner in 3' high
Tel. pole stub

61.43'

974+16

E TWP. RD. #32

41.17'

shiner

48.62'

shiner in 3' high
Tel. Pole stub