
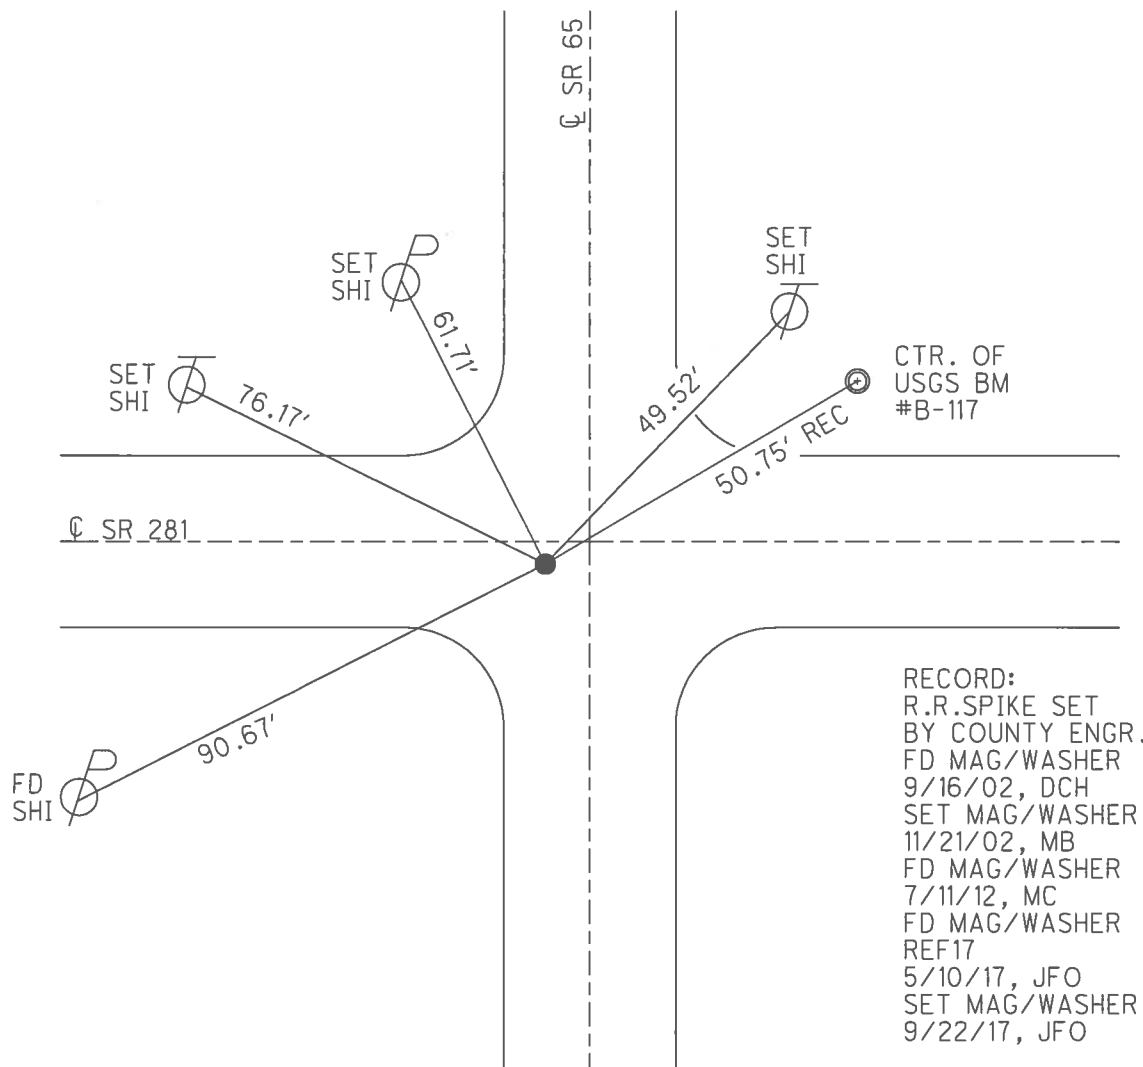


O.D.O.T. DISTRICT 2 SURVEY OFFICE (USE ONLY)

PERSONNEL _____ REFERENCE NO. 17 SHEET 20 OF 42
NOTES RHOADES DATE 5/8/17 ROUTE SR 65
H.C. O'DONNELL WEATHER SUNNY COUNTY HENRY
R.C. RHOADES TEMP. 44° TOWNSHIP RICHFIELD
SECTION 28
T 4 N R 8 E

TYPE MONUMENT MAG/WASHER
ON SURFACE - ~~BELOW~~ ON _____
LEFT - CL PAV'T - ~~RIGHT~~ 3.2', 1.7' S. OF CL SR 281
- TO - EDGE PAVEMENT
S.L.M. 423+45

GRID: NORTHING: 592437.952 EASTING: 1572551.483

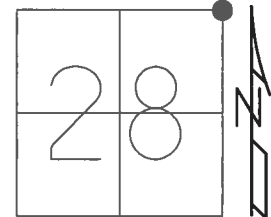

RECORD:
R.R.SPIKE SET
BY COUNTY ENGR.
FD MAG/WASHER
9/16/02, DCH
SET MAG/WASHER
11/21/02, MB
FD MAG/WASHER
7/11/12, MC
FD MAG/WASHER
REF17
5/10/17, JFO
SET MAG/WASHER
9/22/17, JFO

O.D.O.T. DISTRICT 2 SURVEY OFFICE (USE ONLY)

PERSONNEL

REFERENCE NO. 17

SHEET 20 OF 42

NOTES BARNHISEL

DATE 9/16/02

ROUTE SR 65

H.C. CANTERBURY

WEATHER SUNNY

COUNTY HENRY

R.C. BARNHISEL

TEMP. 70°

TOWNSHIP RICHFIELD

SECTION 28

T 4 N R 8 E

TYPE MONUMENT MAG / WASHER



ON SURFACE - ~~BELOW~~ ON

LEFT - ℄ PAV'T - ~~RIGHT~~ 3.2', (1.7' SOUTH OF ℄ SR 281)

TO EDGE PAVEMENT

S.L.M. 423+45

Grid: Northing: 592437.974 Easting: 1572551.428

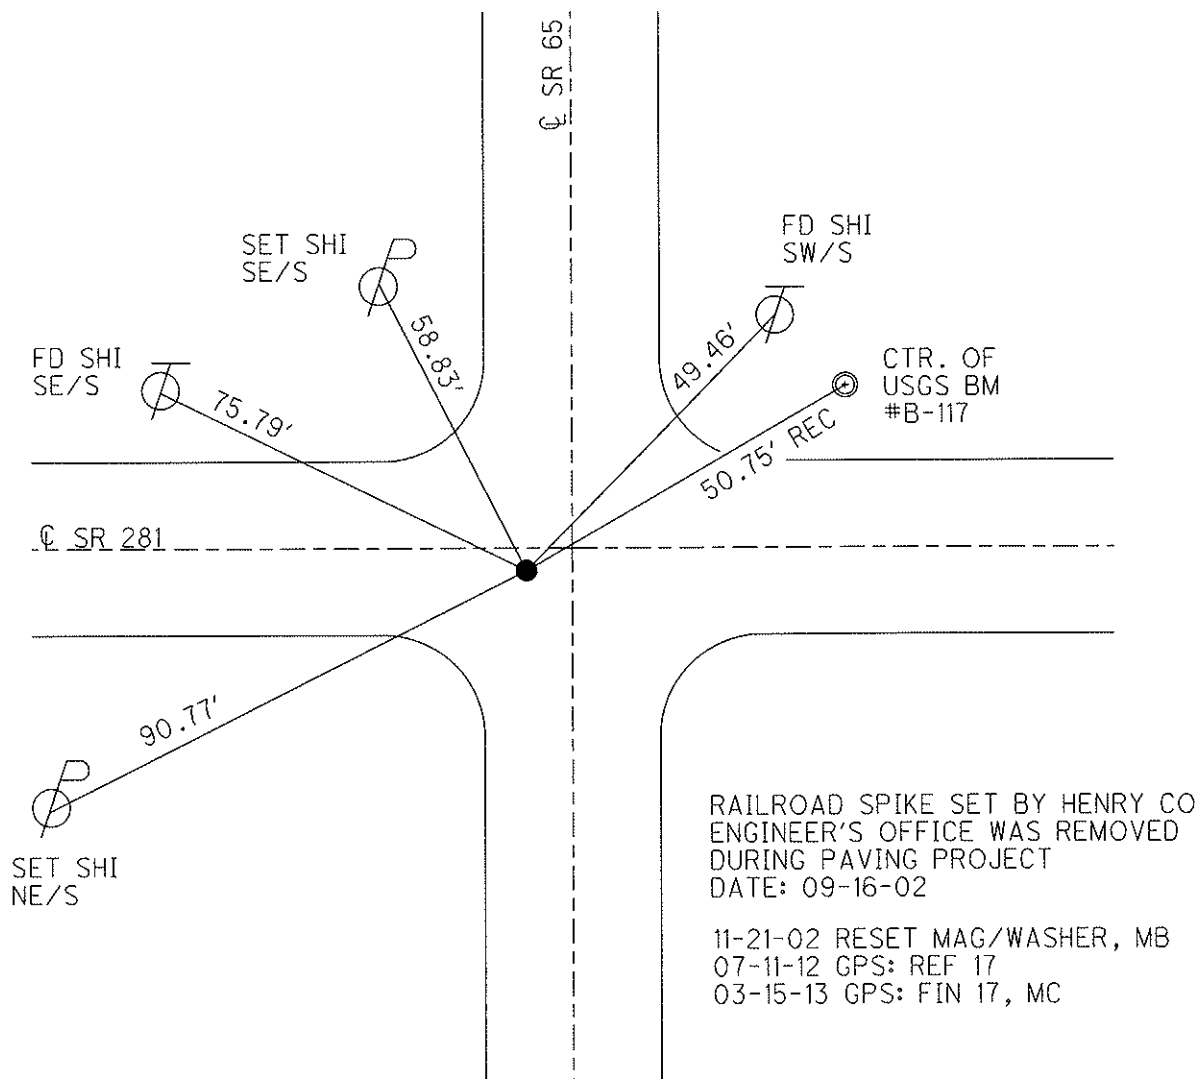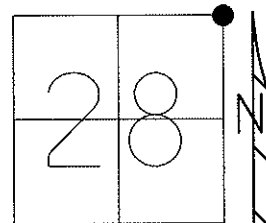

O.D.O.T. DISTRICT 2 SURVEY OFFICE

PERSONNEL

REFERENCE NO. 17

SHEET 18 OF 29

NOTES BARNHISEL "RC"

H.C. CANTERBURY

R.C. _____

DATE 9-16-02

WEATHER Sunny

TEMP. +70°

ROUTE 65

COUNTY HENRY

TOWNSHIP RICHFIELD

SECTION 28

T4 √ R 8 E

TYPE MONUMENT PK& WASHER


ON SURFACE - ~~BELOW~~ yes

LEFT - ϵ PAW'T. - RIGHT 3.2'

 - TO - EDGE PAVEMENT

S.L.M. 423+45 1.7' South of

1.7' South of E SR 281

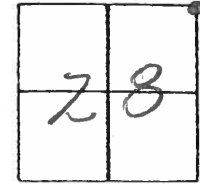


Reset mag Nail & Washer

11-21-02

MB

Mag Nail Removed, Railroad Spike Reset Date

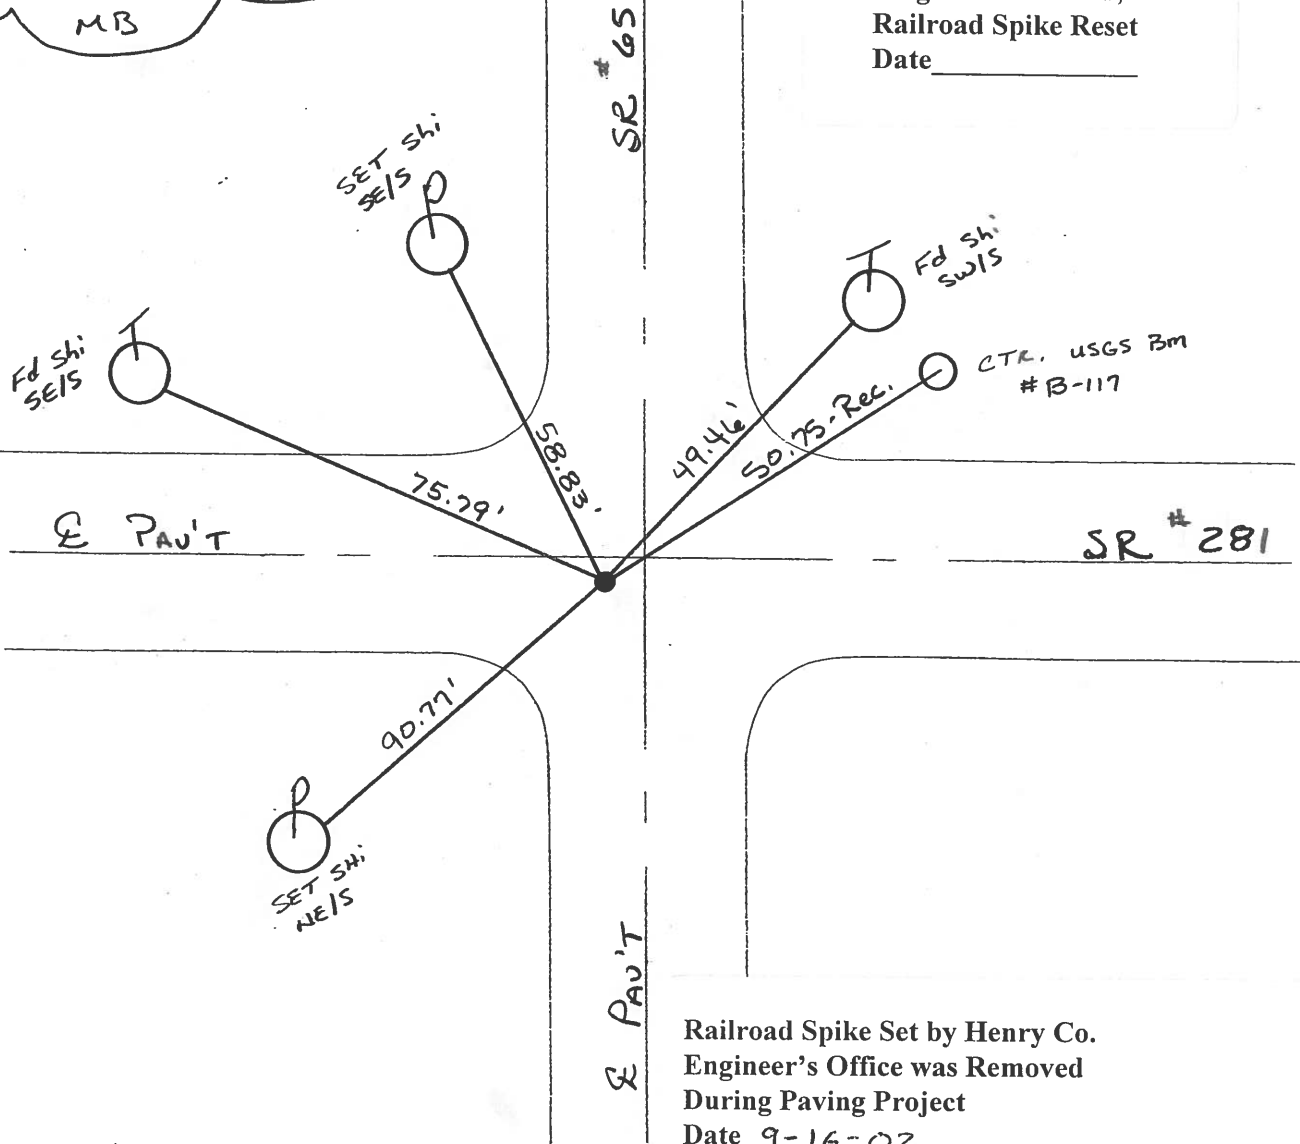

**Railroad Spike Set by Henry Co.
Engineer's Office was Removed
During Paving Project
Date 9-16-02**

O.D.O.T. DISTRICT 2 SURVEY OFFICE

PERSONNEL

REFERENCE NO. 17

SHEET 18 OF 18

NOTES BARNHISEL ✓

H.C. 11 12 13 100

R.C. ~~HOFFMAN~~ MB

DATE 4-11-90

WEATHER Sunny ✓

TEMP. ~~+35°~~ +70

ROUTE 65

COUNTY HENRY

TOWNSHIP Richfield

SECTION 28

T4 NR BE

TYPE MONUMENT P.K. & Washer ✓



ON SURFACE - ~~BELOW~~ yes ✓

LEFT - & PAN'T. - RIGHT 3.2 ✓

- TO - EDGE PAVEMENT 1.7 S. OF

SI M ~~473 + 510~~ ~~411 + 92~~ ~~411 + 92~~

Removed
9-26-02

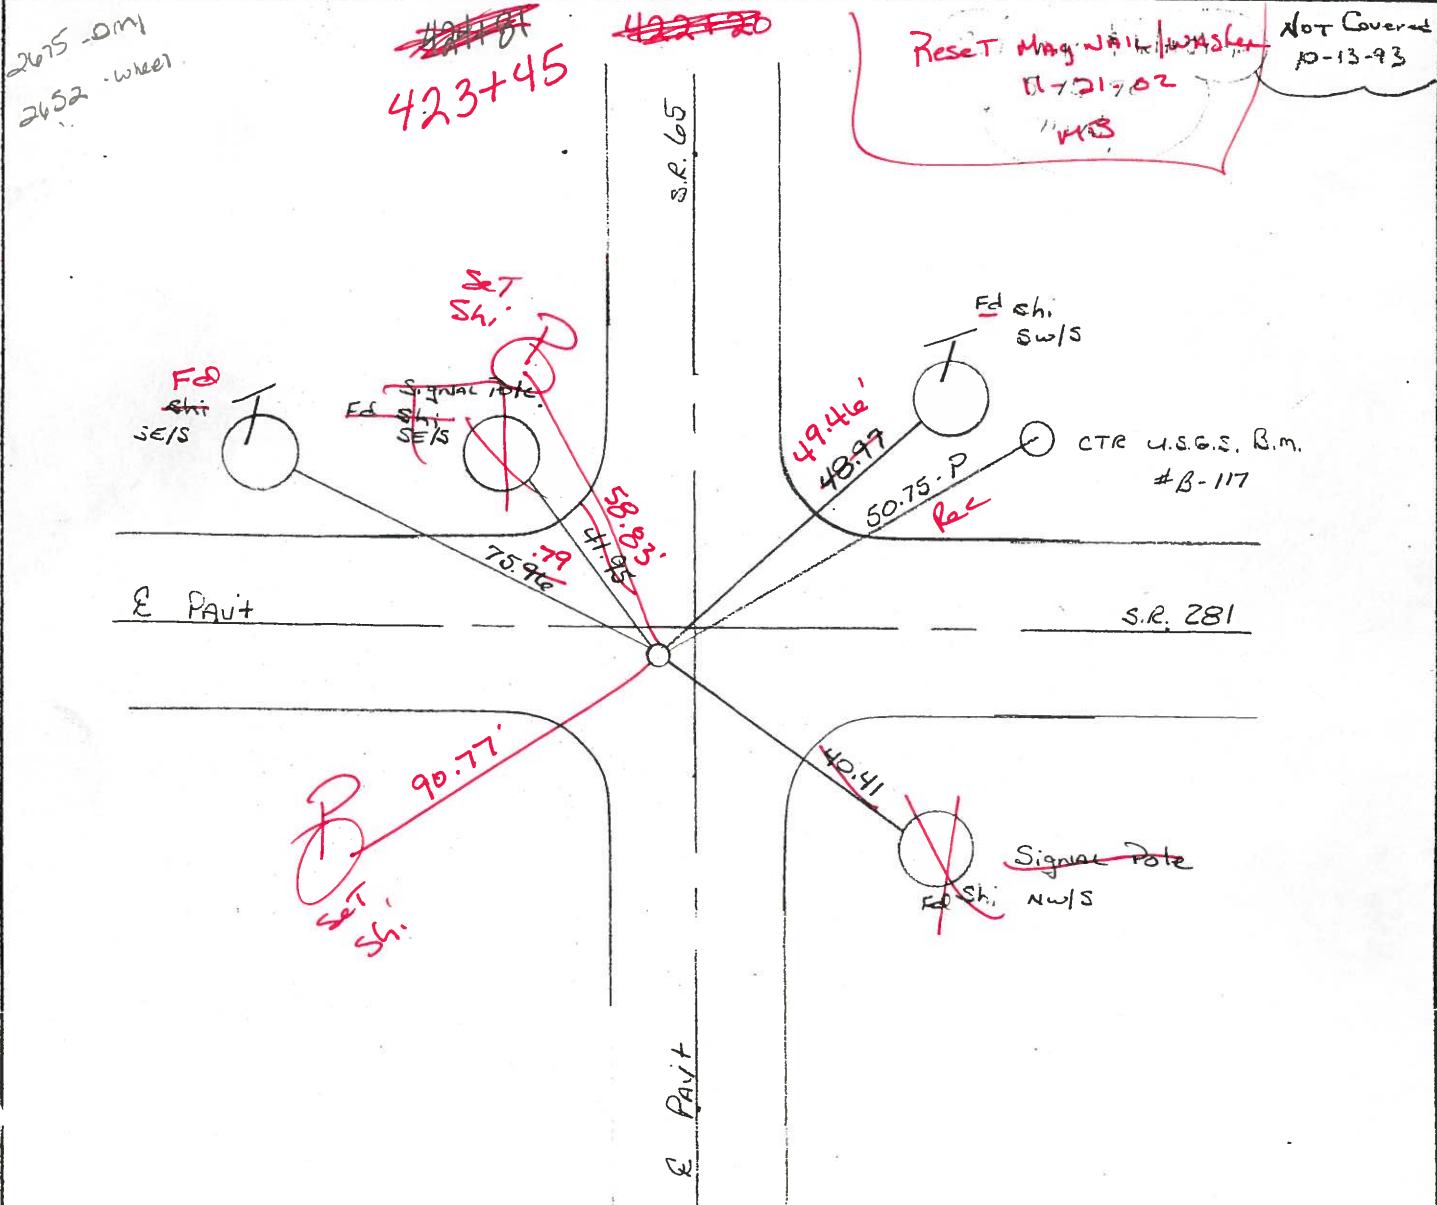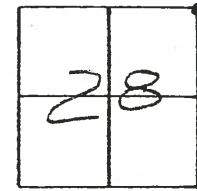

Q.D.O.T. DISTRICT 2 SURVEY OFFICE

SHEET _____ OF _____

County HENRY S.R. 65

Township RICHFIELD

Section 28

T4N, R8E

Personnel HOFFMAN

LOEHLER H.C.

HOUSEHOLDER R.C.


BARNHISEL

17

Date 1-27-84

Weather Cloudy

Temp. +30°

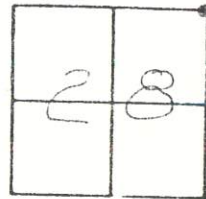

Fd 3/4" I. PIPE @ SURFACE

1' S. of & Pavt 281

3' Lt. of & Pavt 65

S.L.M. 423 + 56

Set PK/WASHER

8-28-84


SWH

PK 1/2 Washer

3.2 Lt &

1.7 S of & 281

423+56

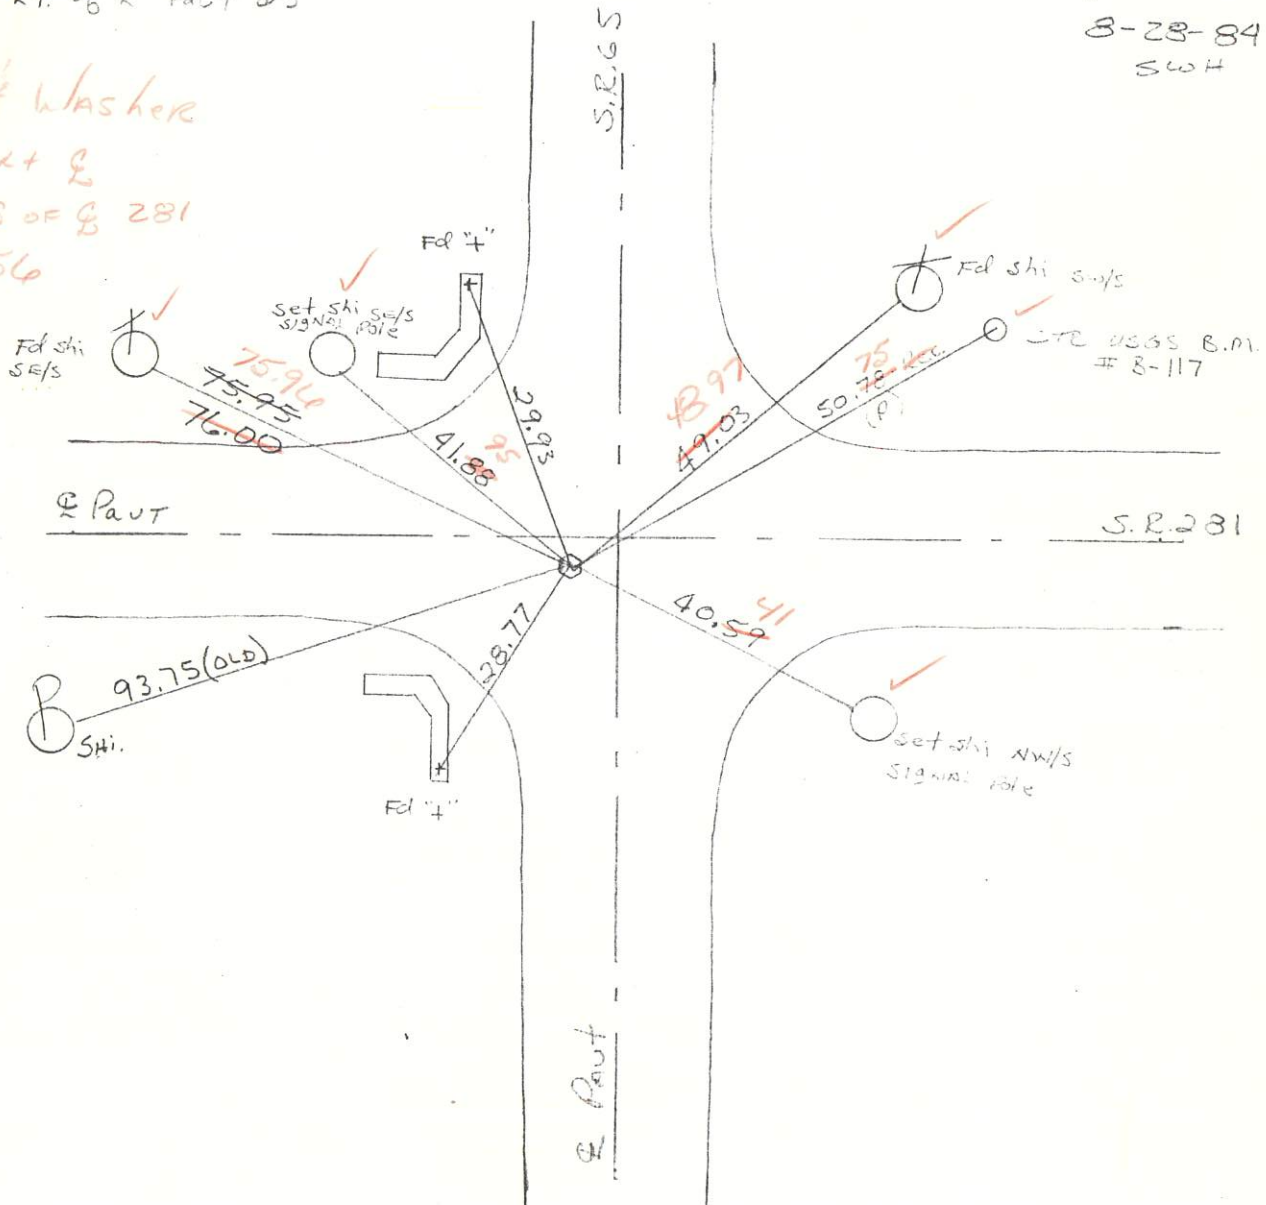

Q.D.O.T. DISTRICT 2 SURVEY OFFICE

SHEET _____ OF _____

County HENRY S.R. 65

Township RICHFIELD

Section 28

T4N, R8E

Personnel HOFFMAN

LOEHKE H.C.

HOUSEHOLDER R.C.


BARNHISEL

17

Date 1-27-84

Weather Cloudy

Temp. +30°

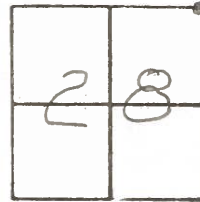

Fd 3/4" I. PIPE @ SURFACE

1' S. of & Part 281


3' Lt. of & Part 65


S.L.M. 423 + 56

Set PK/WASHER

8-28-84

SWH

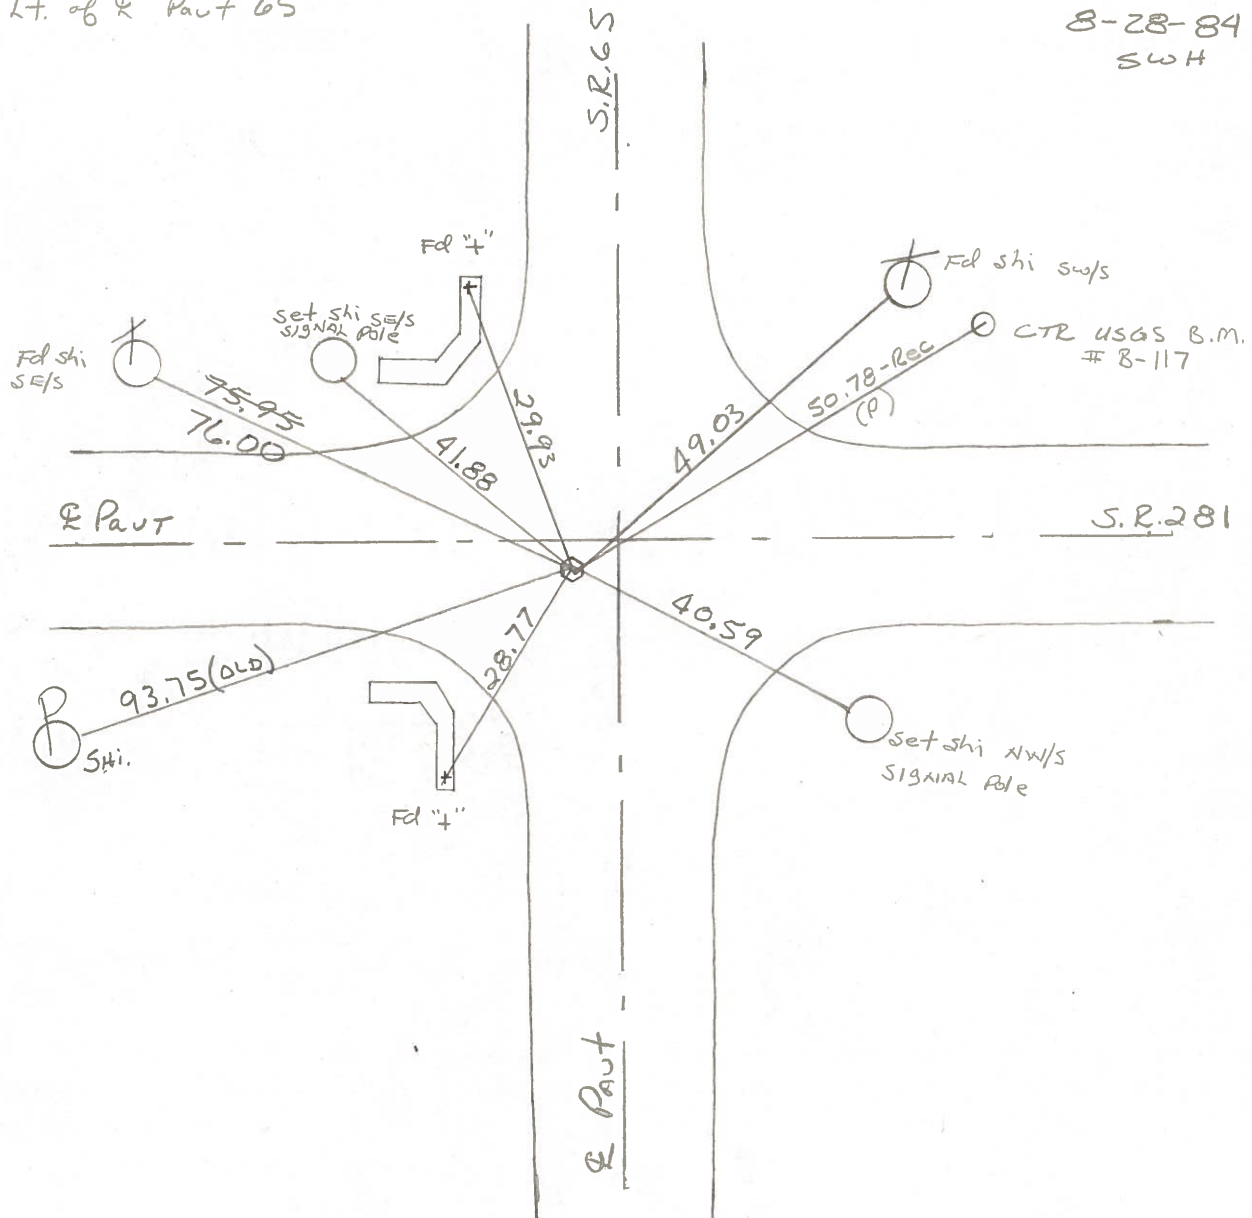

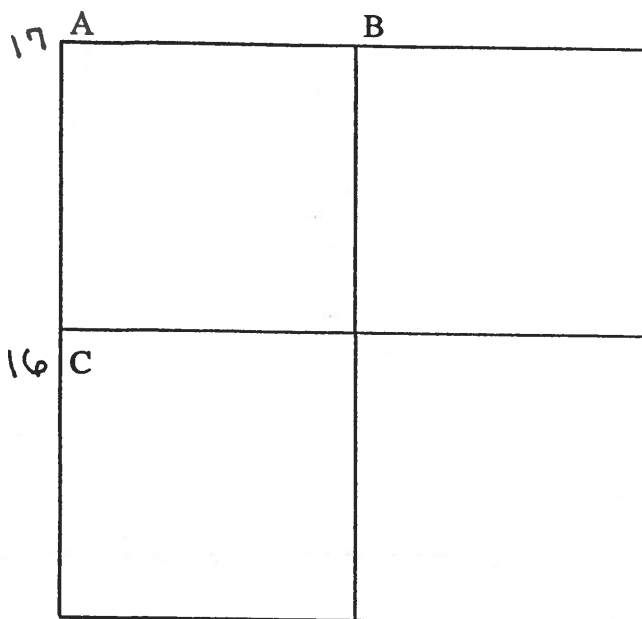

COUNTY: HENRY

TOWNSHIP: RICHFIELD

T-4-N R-8-E

SECTION: 27

7/26/79 R.W., J.J., G.M.

17 A - Found recorded iron pipe over iron pin. No stone could be located. Replaced iron pipe in original position. Pk's 6' north and west.

56.30' N.W. to duplex se/s telephone pole.

29.88' N.W. to "+" north end of headwall.

49.04' N.E. to shiner sw/s telephone pole.

50.75' N.E. to center USGS BM "B-117".

28.68' S.W. to "+" south end of headwall.

8/1/88 R.W., S.K. Found Pk. nail and shiner on surface.

41.66' N.W. to shiner se/s signal pole.

56.29' N.W. to duplex sw/s power pole.

41.61' N.W. to "+" north end conc. pipe.

50.74' N.E. to center USGS BM "B-117 1947".

48.94' N.E. to shiner sw/s telephone pole.

40.49' S.E. to shiner nw/s signal pole.

39.93' S.W. to "+" center north wall catch basin. (P)

60.40' S.W. to "+" south end conc. pipe. (P)

12/21/79 R.W., C.S.

B - Corner is lost. Reestablished N¼ Post midway between and in line with the NE corner and NW corner of Sec. 27. Placed 5/8" x 18" iron pin at N¼ Post. Pk's 15' northeast and northwest. Stone is 8.0' south of south edge 20' pavement.

43.55' N.N.E. to "+" top east end conc. headwall. (P)

52.81' N.N.E. to duplex s/s telephone pole. (P)

19.72' S.E. to 5/8"x30" iron pin on ditch bank.

22.02' S.W. to 5/8"x30" iron pin on ditch bank.

9/1/88 R.W., S.K., K.A. Reset iron pin. Set new Pk's 10' NW and NE.

36.11' N.W. to 5/8" iron pin at north edge pavement. (P)

37.58' N.E. to 5/8" iron pin at north edge pavement. (P)

19.74' S.E. to 5/8" iron pin on ditch bank. (P)

22.06' S.W. to 5/8" iron pin on ditch bank. (P)

PERSONNEL	TITLE	PERSONNEL	TITLE	COUNTY	DATE	WEATHER	TEMP.
Smith				Henry	4-18-1974	Clear-Warm	65°
Bowers				S. R. 65			
Mead				SEC. Richfield Twp.			

DESCRIPTION	LEFT	CENTER LINE	RIGHT	JOB NO.
-------------	------	-------------	-------	---------

