
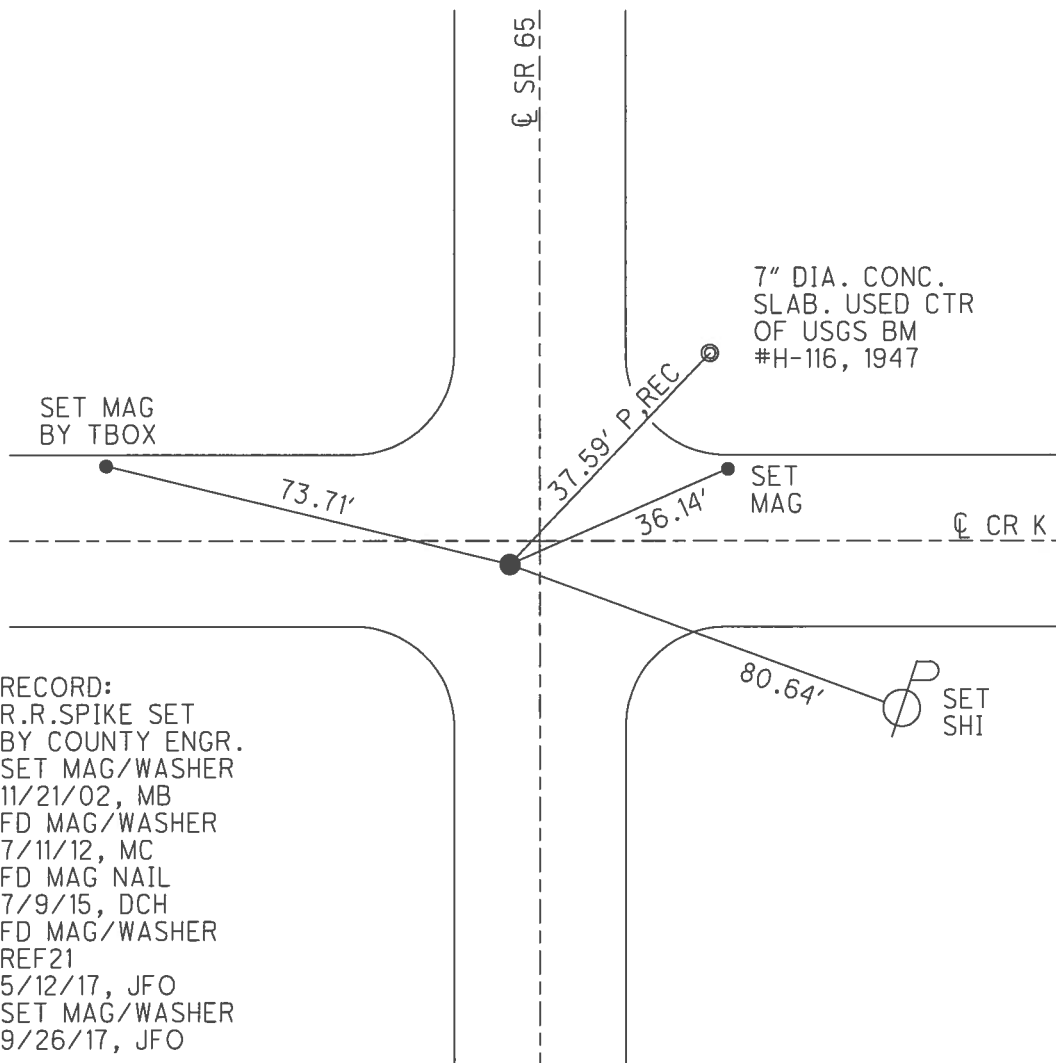


O.D.O.T. DISTRICT 2 SURVEY OFFICE (USE ONLY)

PERSONNEL _____ REFERENCE NO. 21 SHEET 24 OF 42
NOTES RHOADES DATE 5/9/17 ROUTE SR 65
H.C. O'DONNELL WEATHER SUNNY COUNTY HENRY
R.C. RHOADES TEMP. 47° TOWNSHIP RICHFIELD
SECTION 16
T 4 N R 8 E



TYPE MONUMENT MAG/WASHER
ON SURFACE - ~~BELOW~~ ON
LEFT - CL PAV'T - ~~RIGHT~~ 5.6', 5' S.OF CL CR K W.
- TO - EDGE PAVEMENT
S.L.M. 529+25
GRID: NORTHING: 603045.127 EASTING: 1572600.423

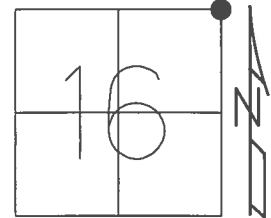

O.D.O.T. DISTRICT 2 SURVEY OFFICE (USE ONLY)

PERSONNEL	REFERENCE NO. <u>21</u>	SHEET <u>24</u> OF <u>42</u>	
NOTES	DATE <u>07-09-15</u>	ROUTE <u>SR 65</u>	
H.C. <u>HOMAN</u>	WEATHER <u>CLOUDY</u>	COUNTY <u>HENRY</u>	
R.C. <u>FARKAS</u>	TEMP. <u>70°</u>	TOWNSHIP <u>RICHFIELD</u>	
<u>LEU</u>		SECTION <u>16</u>	
<u>O'DONNELL</u>		T <u>4</u> N R <u>8</u> E	

TYPE MONUMENT MAG NAIL
 ON SURFACE - ~~BELOW~~ ON
 LEFT - ℄ PAV'T - ~~RIGHT~~ 5.6', (5' S.OF ℄ CR K WEST)
- TO EDGE PAVEMENT
 S.L.M. 529+25
 GRID: NORTHING: 603045.178 EASTING: 1572600.373

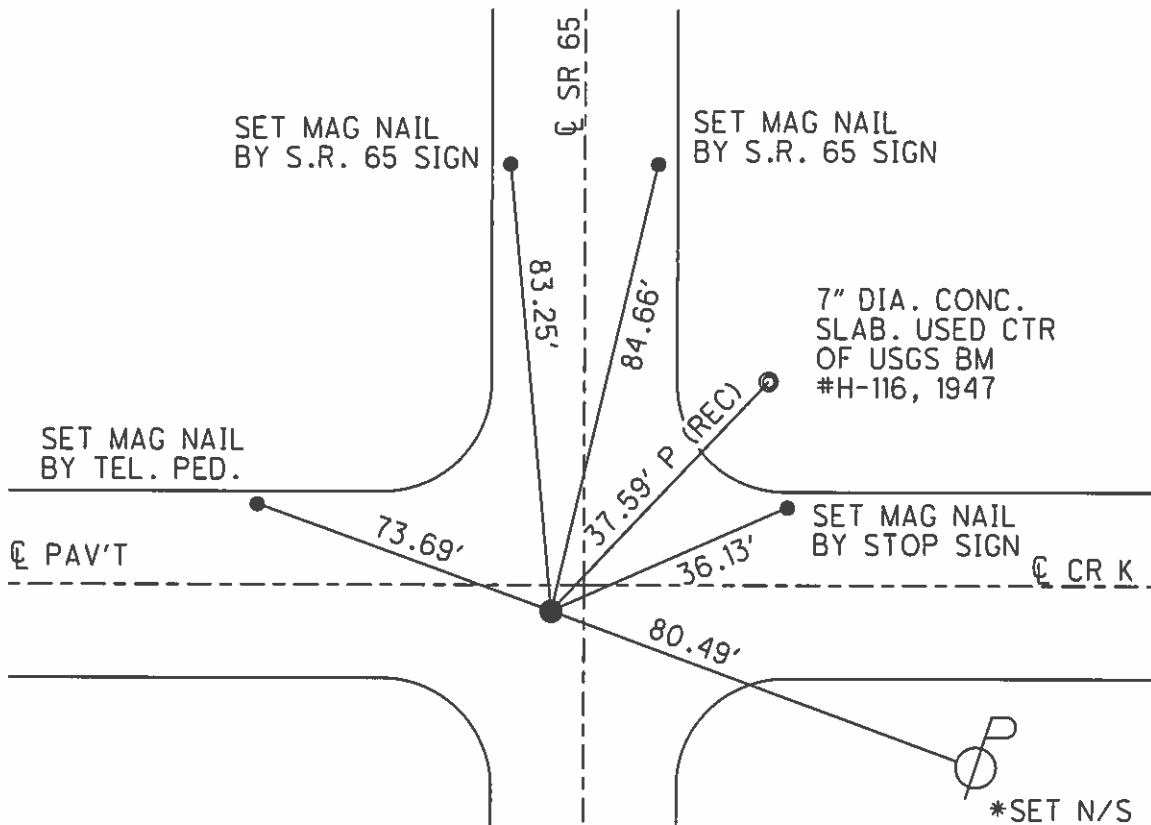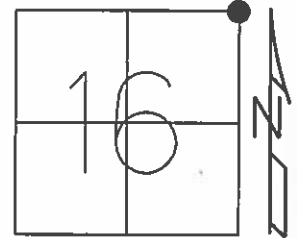

RAILROAD SPIKE SET BY HENRY CO
 ENGINEER'S OFFICE WAS REMOVED
 DURING PAVING PROJECT
 DATE: 10-05-02

11-21-02 RESET MAG/WASHER, MB
 POINT CHIPPED OUT, 3-15-13
 07-11-12 GPS: REF 21
 03-15-13 GPS: FIN 21, MC

*SET N/S IN NEW
 P.P. ON 07-16-15 AFTER
 CONSTRUCTION. DCH, JLL

O.D.O.T. DISTRICT 2 SURVEY OFFICE (USE ONLY)

PERSONNEL

REFERENCE NO. 21

SHEET 24 OF 42

NOTES BARNHISEL

DATE 10/5/02

ROUTE SR 65

H.C. CANTERBURY

WEATHER CLOUDY

COUNTY HENRY

R.C. BARNHISEL

TEMP. 70°

TOWNSHIP RICHFIELD

SECTION 16

T 4 N R 8 E

TYPE MONUMENT MAG / WASHER


~~ON SURFACE~~ - BELOW 3"

LEFT - CL PAV'T - ~~RIGHT~~ 5.6', (5' S.OF CL CR K WEST)

- TO - EDGE PAVEMENT


S.L.M. 529+25

Grid: Northing: 603045.178 Easting: 1572600.373

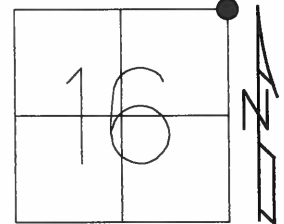

RAILROAD SPIKE SET BY HENRY CO
ENGINEER'S OFFICE WAS REMOVED
DURING PAVING PROJECT
DATE: 10-05-02

11-21-02 RESET MAG/WASHER, MB
POINT CHIPPED OUT, 3-15-13
07-11-12 GPS: REF 21
03-15-13 GPS: FIN 21, MC

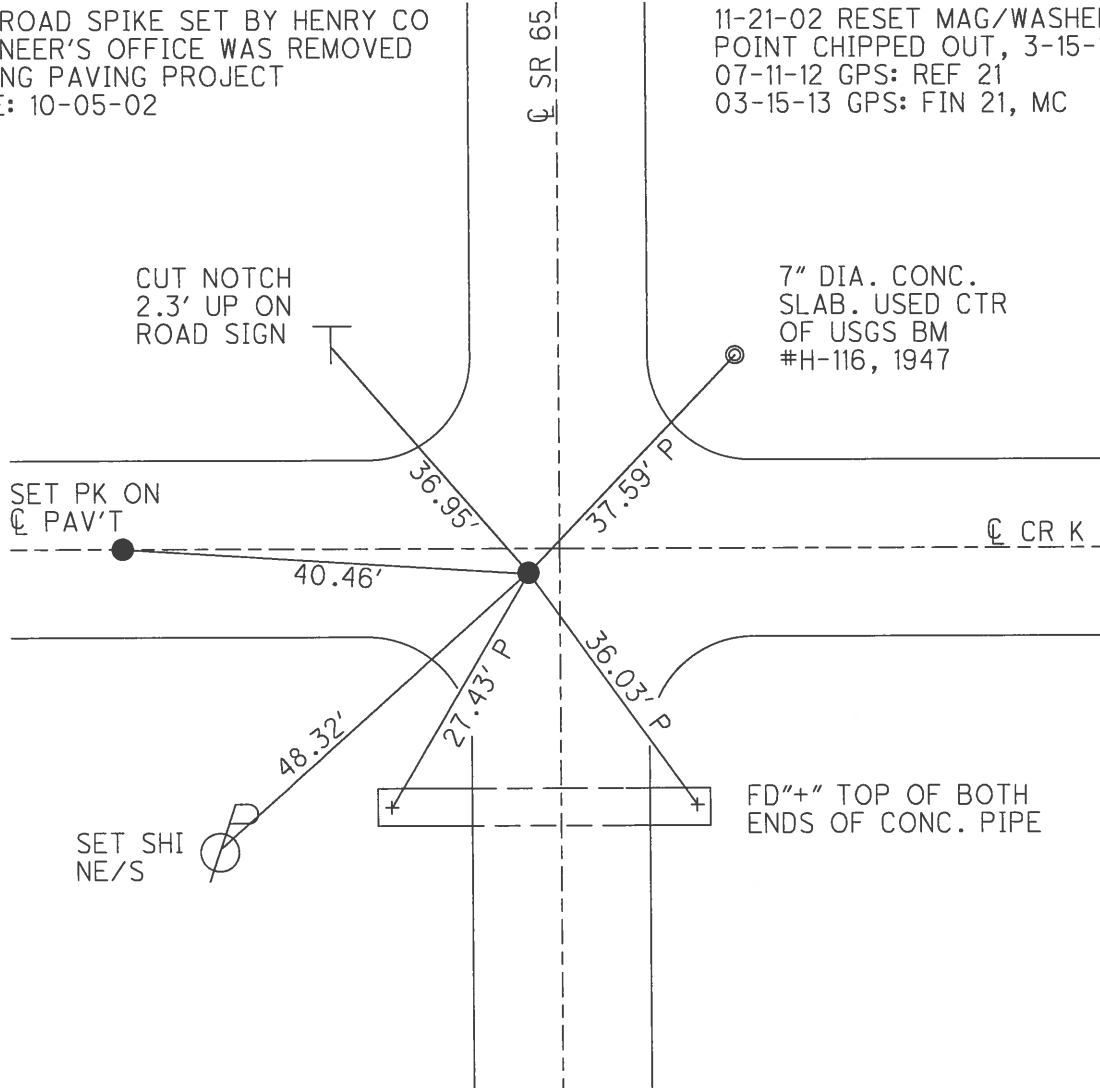

O.D.O.T. DISTRICT 2 SURVEY OFFICE

PERSONNEL

REFERENCE NO. 21

SHEET _____ OF _____

NOTES BARNHISEL ✓

H.C. 11 4 MC

R.C. : HOFFMAN MB

DATE 4-11-90

WEATHER Sunny & cloudy

TEMP. + ~~35°~~ +70

ROUTE 65

COUNTY HENRY

TOWNSHIP Richfield

SECTION 16

T 4 N R 8 E


TYPE MONUMENT P.K. & W. Ashore

ON SURFACE - ~~BELOW~~ YES 3"

LEFT - & PAV'T. - RIGHT 5.6 ✓

TO EDGE PAVEMENT 5.0' S of E Co. Rd "K" West

S.L.M. ~~529+36~~ ~~529+32~~ 529+25

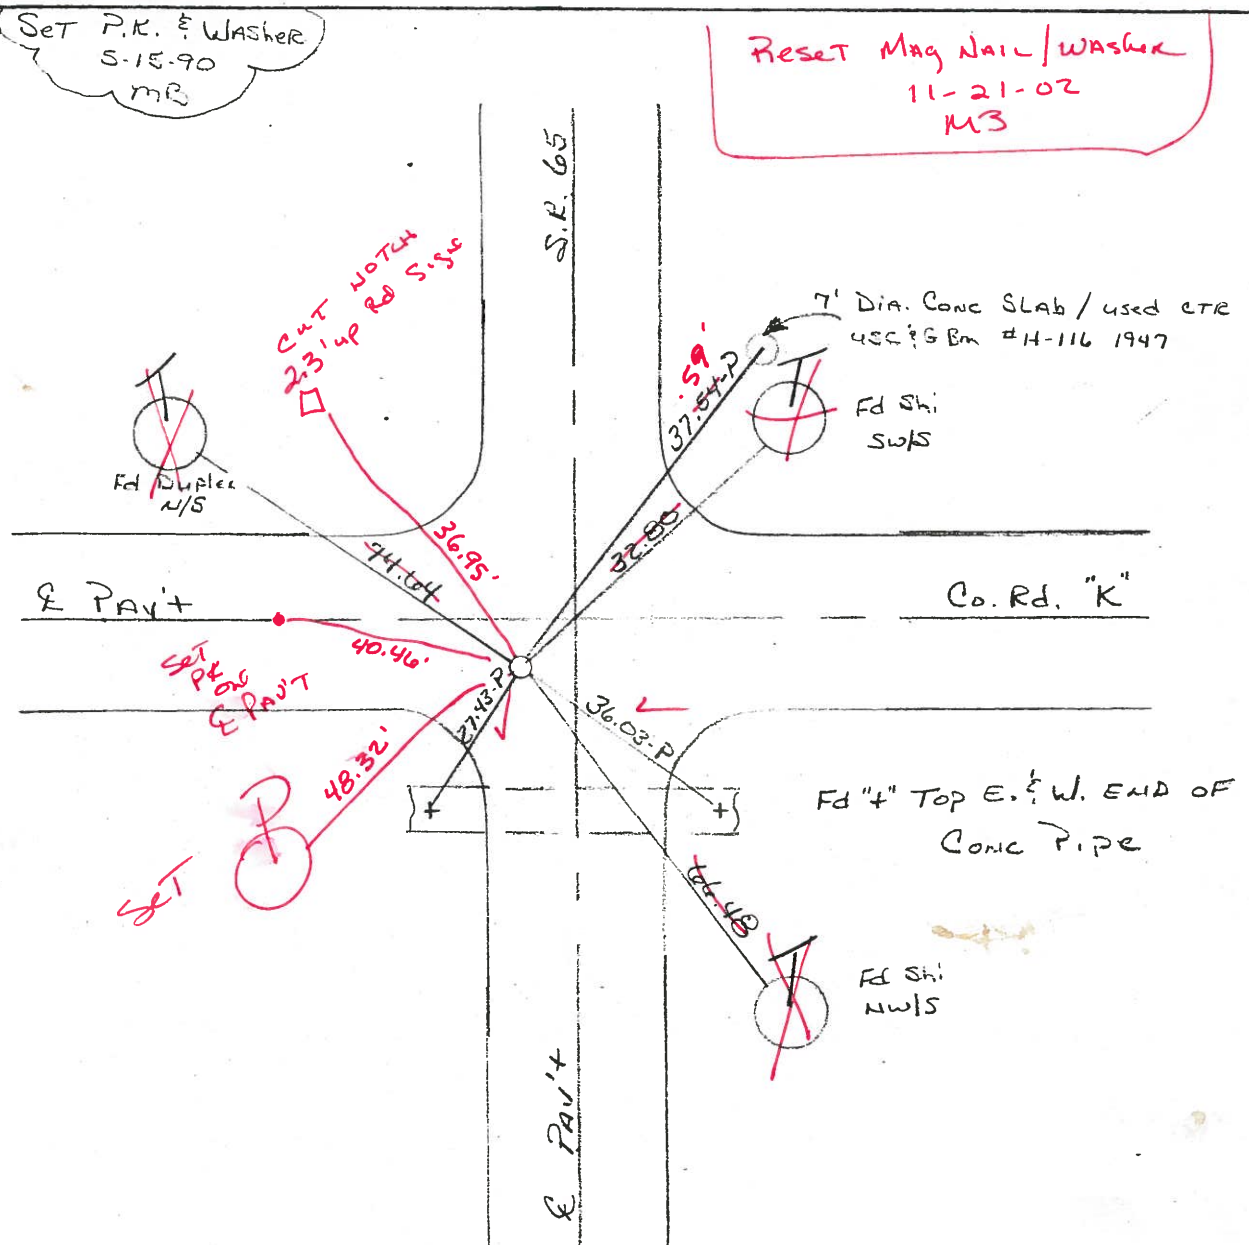

ODOT. DISTRICT 2 SURVEY OFFICE

SHEET _____ OF _____

County HENRY S.R. 65

Township RICHFIELD

Section 16

T4N, R8E

Personnel HOFFMAN

21

LOGHREE H.C.


HOUSEHOLDER R.C.

BARNHISEL

Date 1-27-84

Weather Cloudy

Temp. 30°

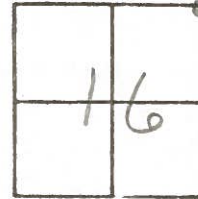

Fd P.R. SPK SET BY COUNTY

@ surface

54' Lt. of & Pant SR65


5.0' S. of & Pant Co. Rd. "K"

SLM = 529+64

SET PK/WASHER

8-28-84

S.W.H.

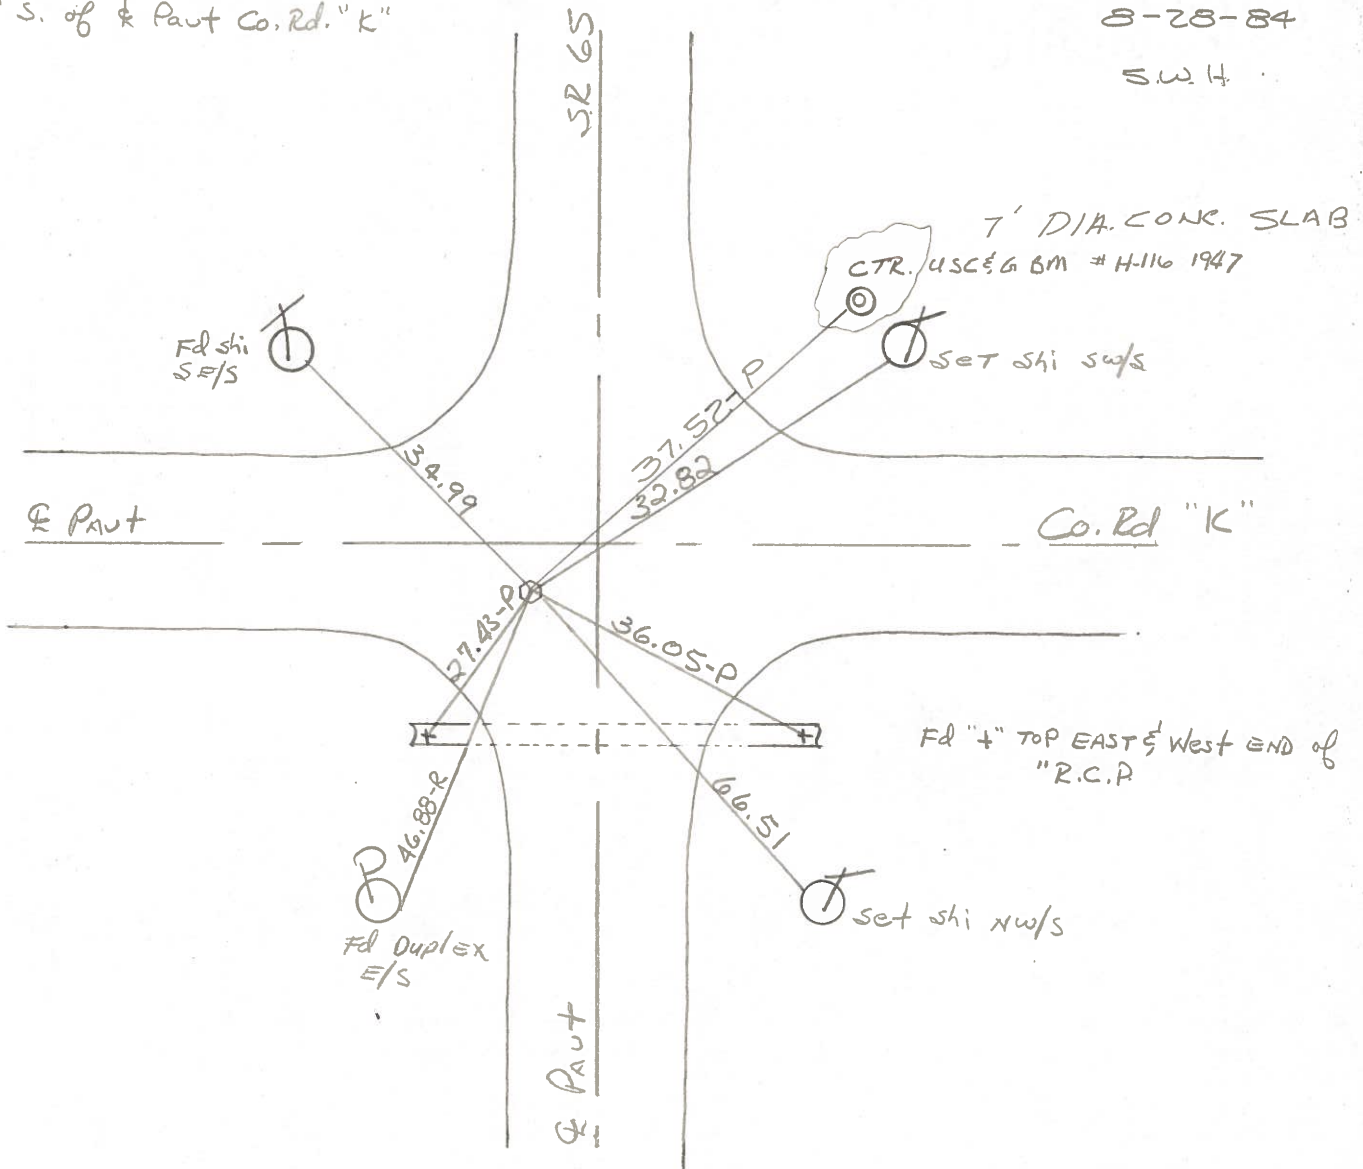

SHEET _____ OF _____

Date 1-27-84

Weather cloudy

Temp. 30°

16	

LOEHKE H.C.

Householder R.C.

BARNHISEL

$$SLM = 529 + 64$$

SET PK/WASHER

8-28-84

S.W.H.

P, K & Washer

5.0 S. E. W


Fel Duplex
N/S ✓


~~Fd shi~~
SE/S

7' DIA. CONC. SLAB

CTR. USCEG BIN # H-116 1947

Fd "4" TOP EAST & West END of
"R.C.P.

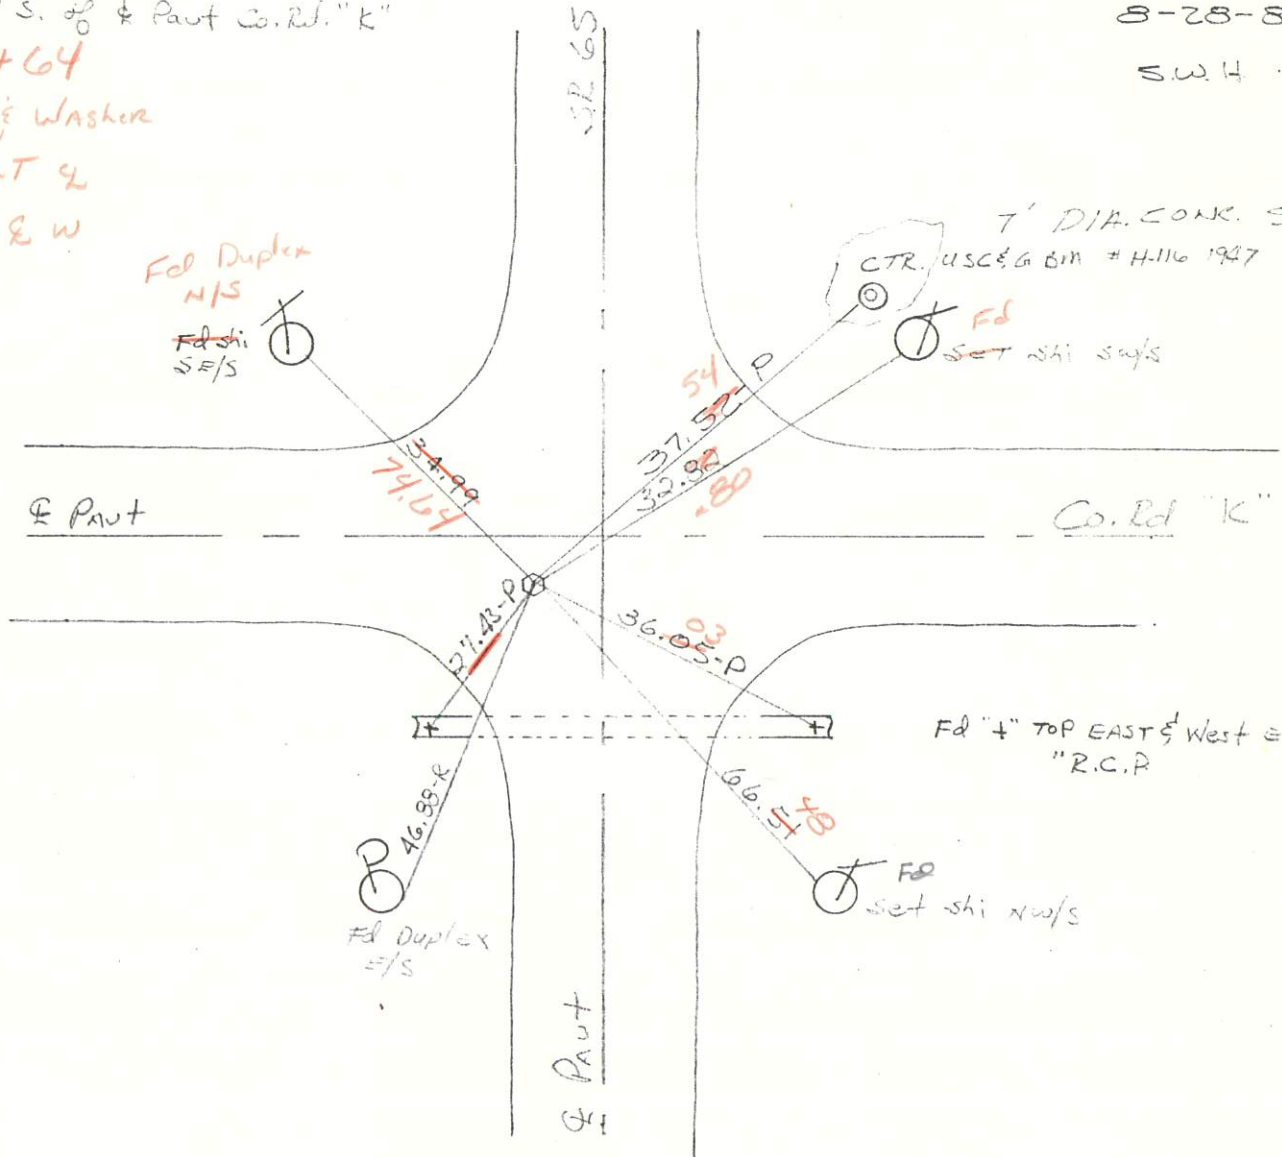

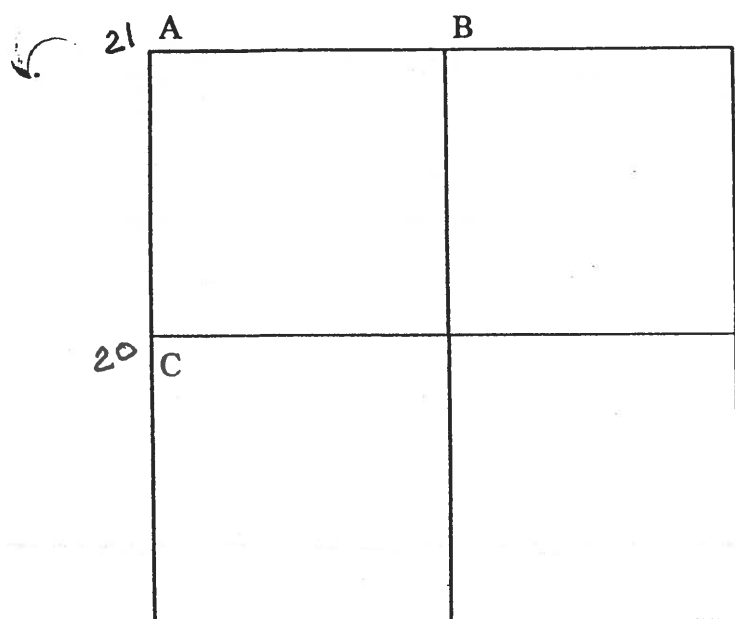

COUNTY: HENRY

TOWNSHIP: RICHFIELD

T- 4 -N R- 8 - E

SECTION: 15

7/30/79 R.W., J.J., G.M.

21 A - Found recorded RR spike over high point of stone (6"x8"x19") 8" below road surface. Placed center punched RR spike on surface over high point of stone. Pk's 6' north and west. Stone is 3.0' east of west edge 18' pavement.

34.92' W.N.W. to shiner se/s telephone pole.

33.13' E.N.E. to duplex se/s telephone pole.

46.02' S.S.E. to shiner ne/s telephone pole.

46.88' S.W. to duplex e/s power pole.

7/20/88 R.W., S.K., K.A.

Found nail/shiner on surface.

74.58' W.N.W. to duplex ne/s telephone pole. NEW

37.51' N.E. to center USGS BM "H116 1947". (P)

33.11' N.E. to duplex (new) nw/s telephone pole.

36.03' S.E. to "+" east end conc. pipe. (P)

66.50' S.S.E. to nail/shiner nw/s telephone pole. NEW


27.42' S.W. to "+" west end conc. pipe. (P)

46.83' S.W. to duplex e/s power pole.

PERSONNEL	TITLE	PERSONNEL	TITLE
BURNSIDE			
SMITH			
BOWERS			
MEAD			

COUNTY HENRY DATE 4-25-75
S. R. 65 WEATHER Cloudy
SEC. N.E. COR. SEC. 16 TEMP. +50

DESCRIPTION REF. TO SECTION CORNER (RICHFIELD TWP.) JOB NO. _____

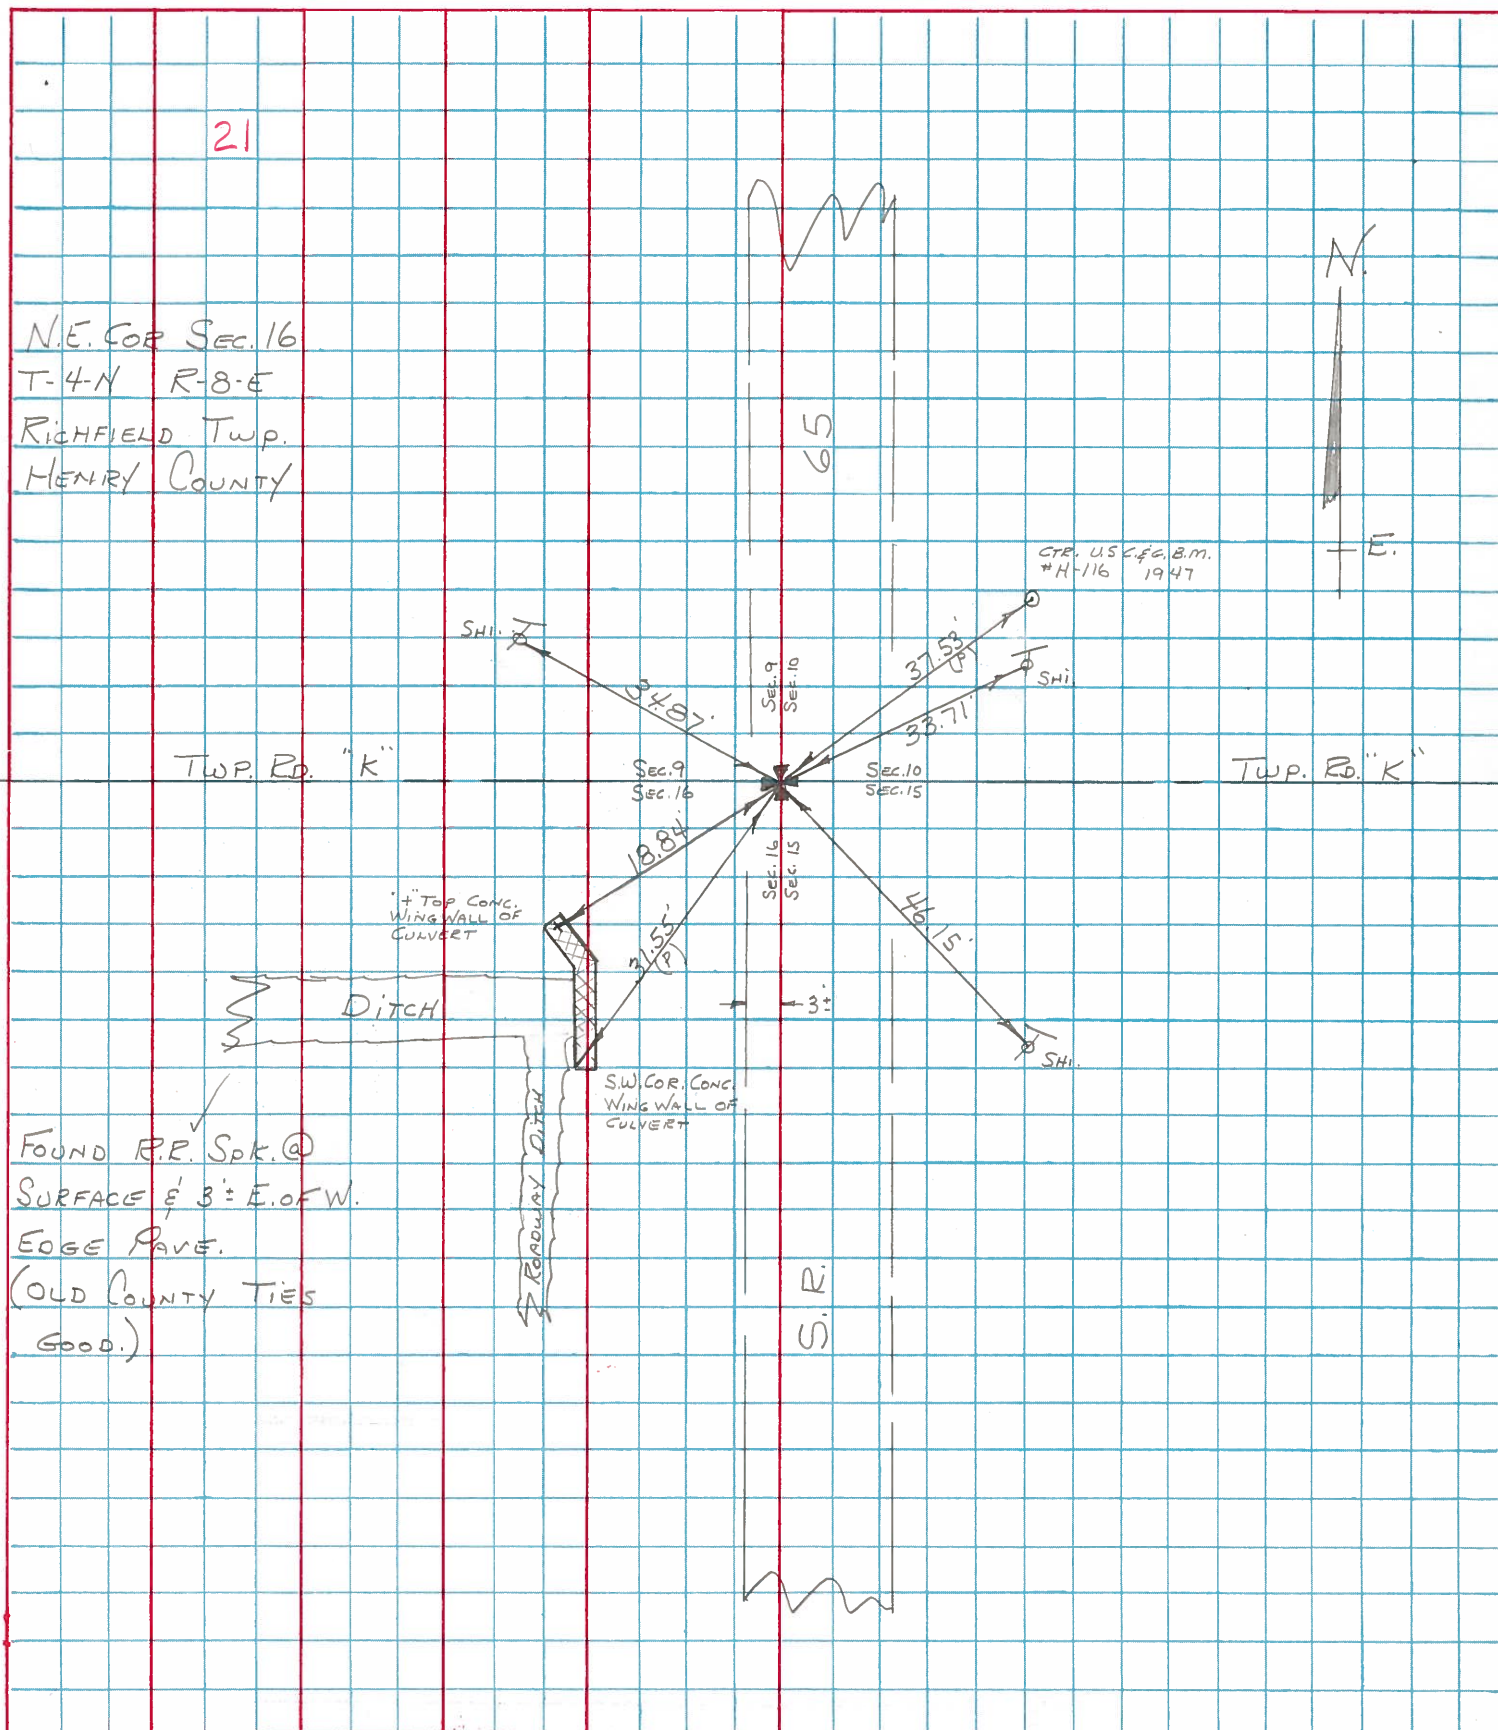

PERSONNEL	TITLE	PERSONNEL	TITLE
Smith			
Bowers			
Mead			

COUNTY Henry DATE 4-16-1974


S. R. 65 WEATHER Clear-Mild

SEC. Richfield Twp. TEMP. 52°

DESCRIPTION	LEFT	CENTER LINE	RIGHT	JOB NO.
-------------	------	-------------	-------	---------

SE Corner Sec. 9
Richfield Twp.
Ed. R.R. Spire @ Surface
± SR 65

21

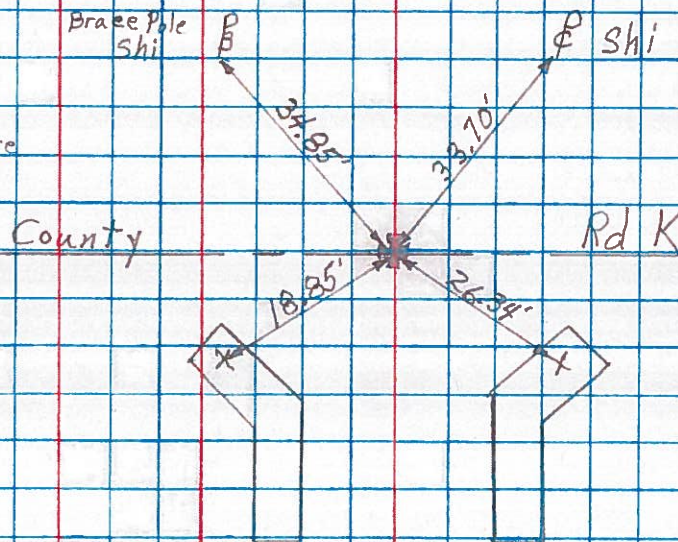

20

E 1/4 Corner Sec. 16
Richfield Twp.
Ed. R.R. Spire @ Surface
± SR 65

