

O.D.O.T. DISTRICT 2 SURVEY OFFICE (USE ONLY)

PERSONNEL _____ REFERENCE NO. 23 SHEET 26 OF 42
NOTES RHOADES DATE 5/9/17 ROUTE SR 65
H.C. O'DONNELL WEATHER SUNNY COUNTY HENRY
R.C. RHOADES TEMP. 47° TOWNSHIP RICHFIELD
SECTION 9
T 4 N R 8 E

TYPE MONUMENT MAG NAIL



~~ON SURFACE~~ - BELOW ON _____

LEFT - CL PAV'T - ~~RIGHT~~ 5.0', 10' S. OF CL W.

TO EDGE PAVEMENT

S.L.M. 582+25

GRID: NORTHING: 608315.606 EASTING: 1572631.681

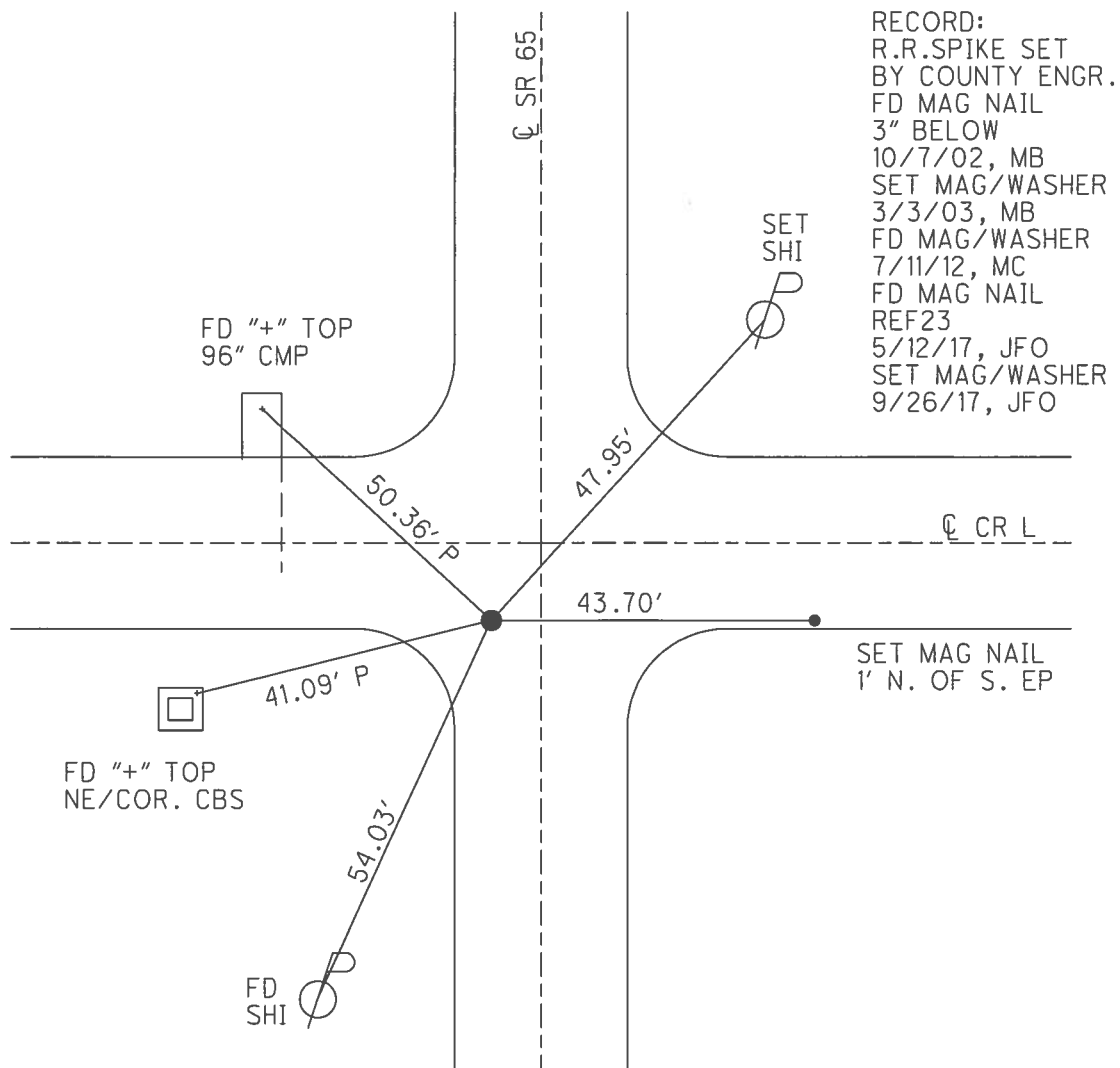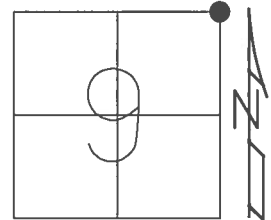

O.D.O.T. DISTRICT 2 SURVEY OFFICE (USE ONLY)

PERSONNEL

REFERENCE NO. 23

SHEET 26 OF 42

NOTES BARNHISEL

DATE 10/7/02

ROUTE SR 65

H.C. CANTERBURY

WEATHER SUNNY

COUNTY HENRY

R.C. BARNHISEL

TEMP. 55°

TOWNSHIP RICHFIELDSECTION 9

T_4 N R_8 E

TYPE MONUMENT MAG NAIL


~~ON SURFACE~~ - BELOW 3'

LEFT - C PAV'T - ~~RIGHT~~ 5.0', (10' S. OF C WEST)


____ TO ____ EDGE PAVEMENT

S.L.M. 582+25

Grid: Northing: 608315.669 Easting: 1572631.632

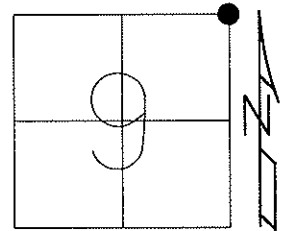

RAILROAD SPIKE SET BY HENRY CO
ENGINEER'S OFFICE WAS REMOVED
DURING PAVING PROJECT
DATE: 10-07-02

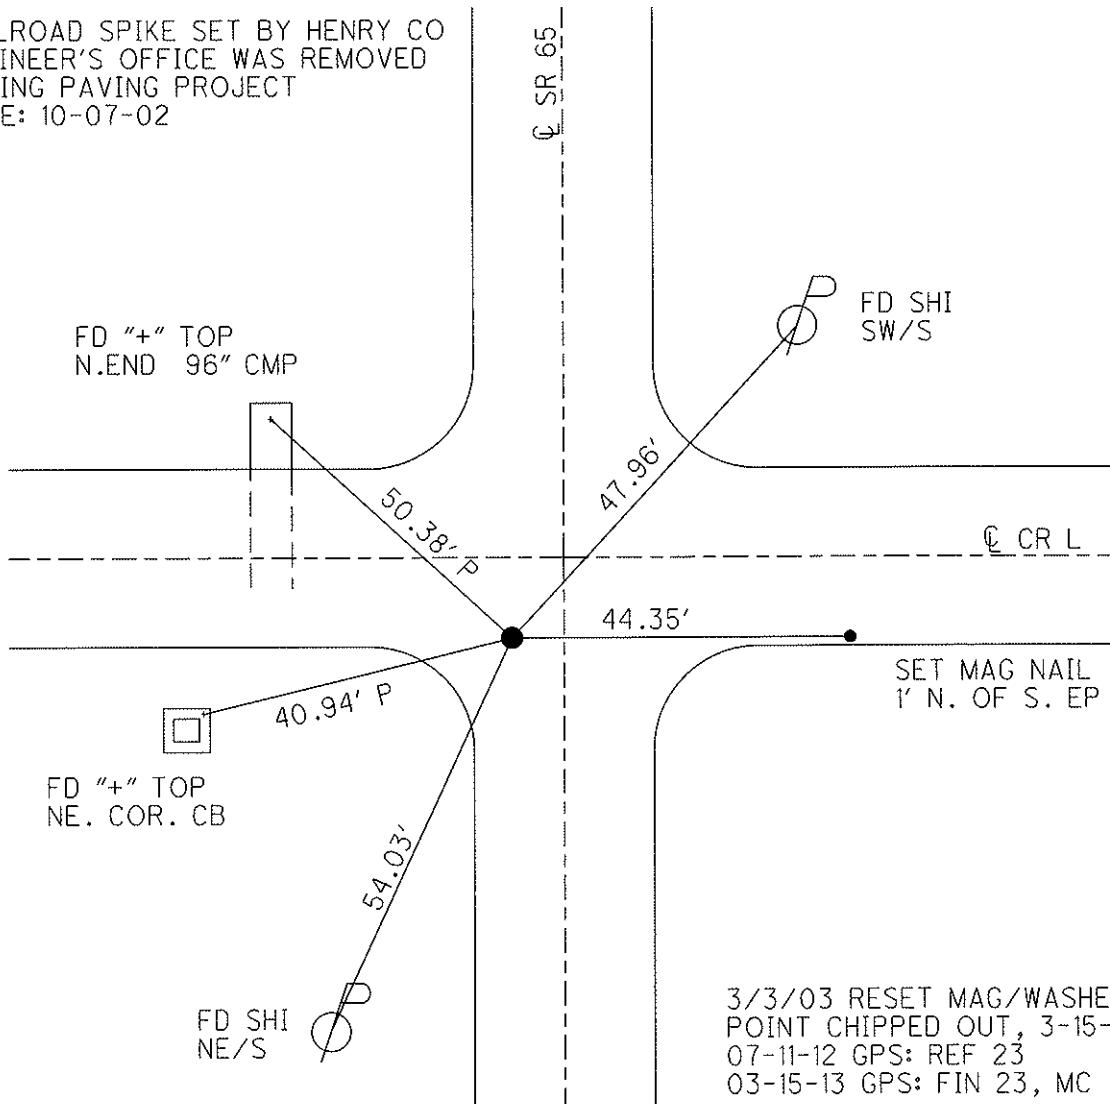

3/3/03 RESET MAG/WASHER, MB
POINT CHIPPED OUT, 3-15-13
07-11-12 GPS: REF 23
03-15-13 GPS: FIN 23, MC

O.D.O.T. DISTRICT 2 SURVEY OFFICE

PERSONNEL

REFERENCE NO. 23

SHEET 24 OF 29

NOTES BARNHISEL RC

H.C. CANTERBURY

R.C. _____

DATE 10-07-02

WEATHER SUNNY

TEMP. +55°

ROUTE 65

COUNTY HENRY

TOWNSHIP RICHFIELD

SECTION 9

T 4 N R 8 E


TYPE MONUMENT Lg RR Spk

~~ON SURFACE~~ - BELOW 3"

LEFT - E PAU'T. - RIGHT 5.0'


- TO - EDGE PAVEMENT

S.L.M. 582+25 10' S. OF E WEST

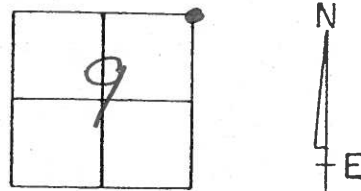

Reset Mag Nail & Washer
3-3-03
MB

Mag Nail Removed,
Railroad Spike Reset
Date _____

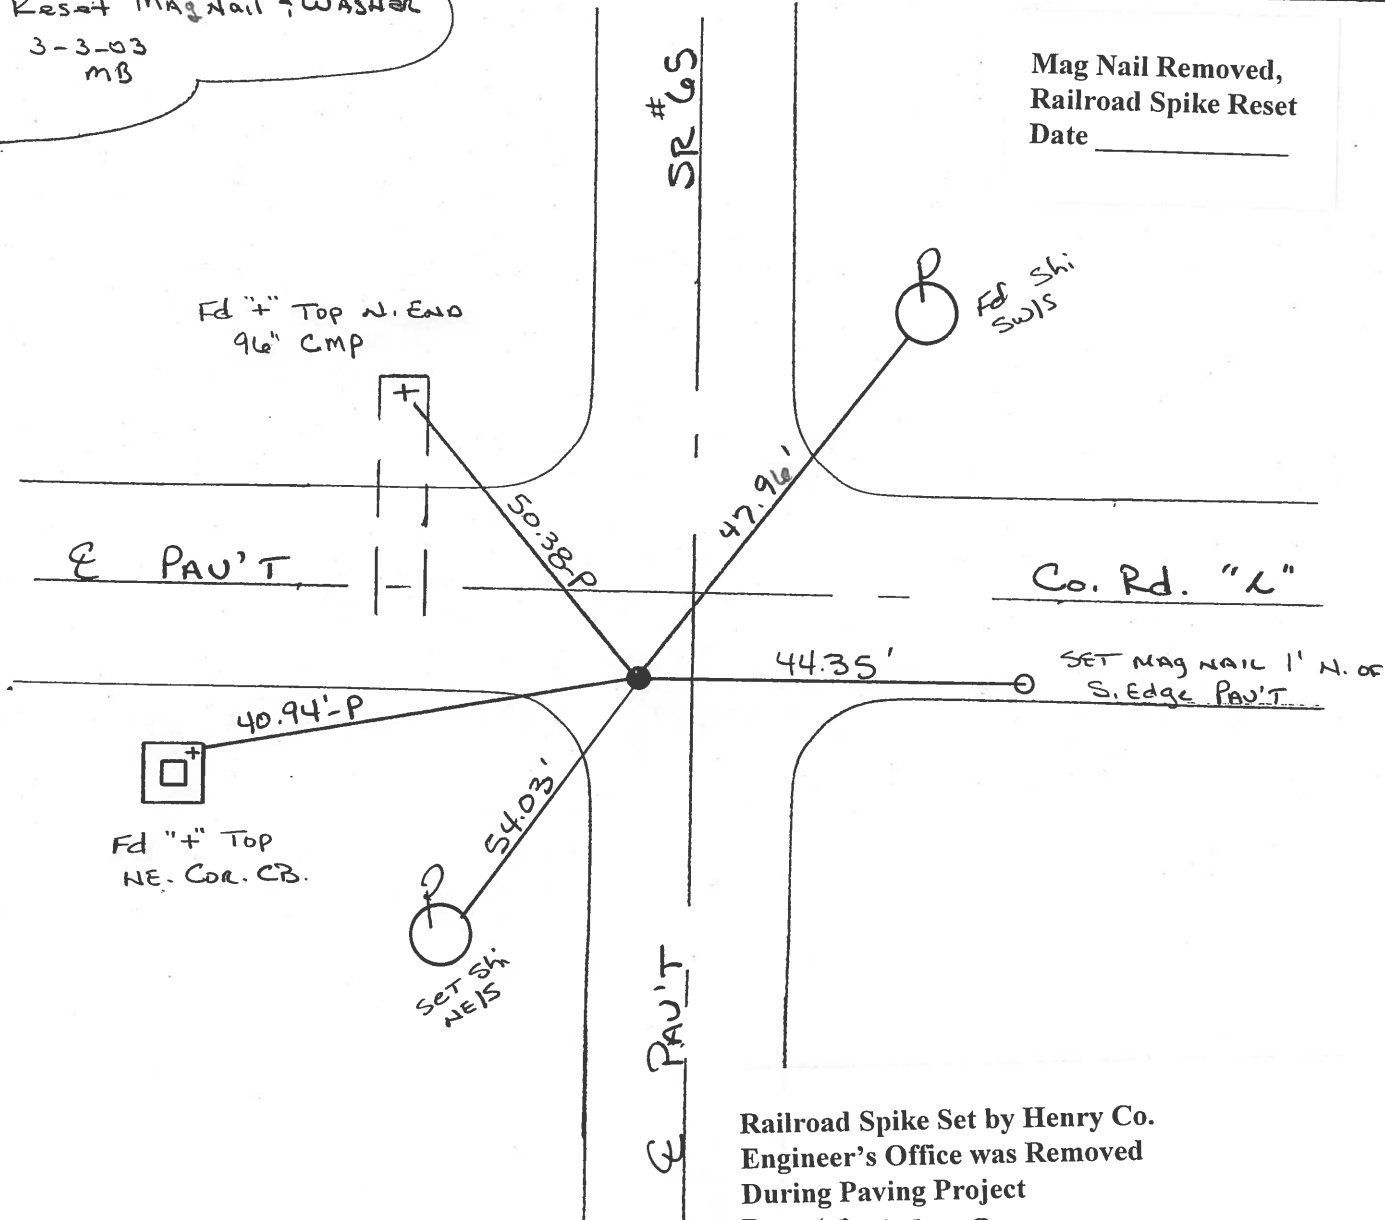

Railroad Spike Set by Henry Co.
Engineer's Office was Removed
During Paving Project
Date 10-07-02

O.D.O.T. DISTRICT 2 SURVEY OFFICE

PERSONNEL

REFERENCE NO. 23

SHEET OF

NOTES BARNHISEL ✓

10-07-02

H.C. " " MC

DATE 4-11-90

ROUTE 65

R.C. HOFFMAN MB

WEATHER SUNNY ✓

COUNTY HENRY

TEMP. +35° +55°

TOWNSHIP RICHFIELD

SECTION 9

T4 N R 8 E


TYPE MONUMENT P.K. & WASHER REMOVED

ON SURFACE - BELOW yes 3"

LEFT- & PAV'T. - RIGHT 5.0


- TO - EDGE PAVEMENT 10.0 S. OF & Co Rd "L" west

S.L.M. 582+25

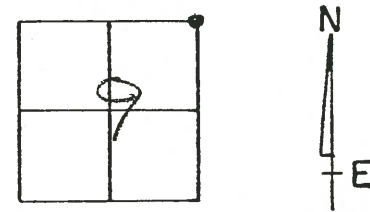

Set P.K. & WASHER
5-15-90
MB

Reset Mag Nail
3-3-03
MB

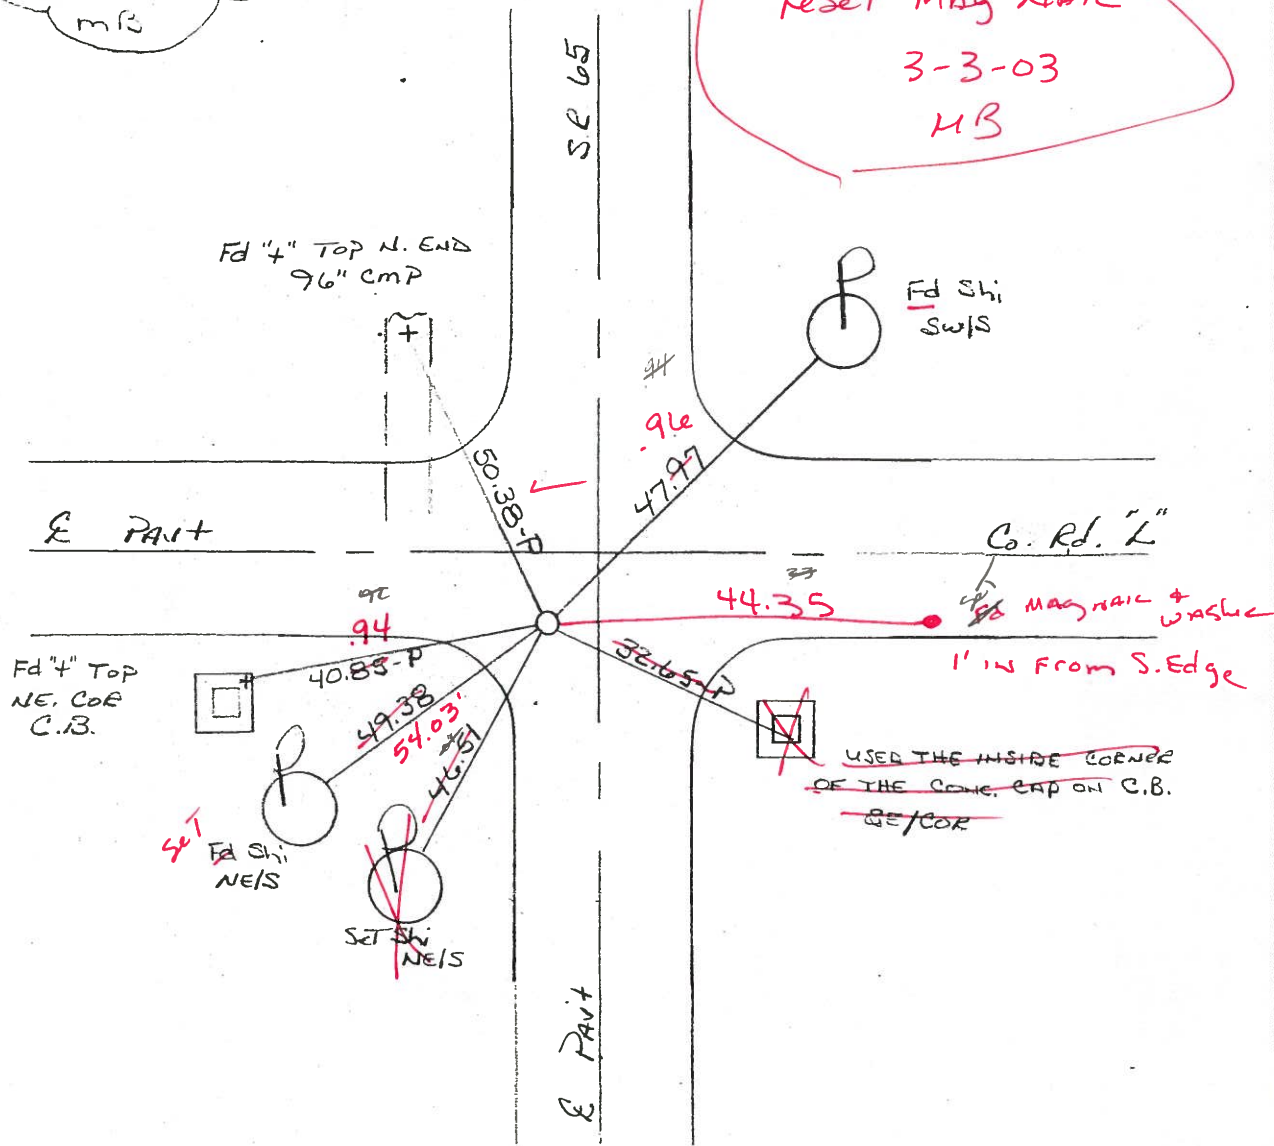

ODOT. DISTRICT 2 SURVEY OFFICE

SHEET _____ OF _____

County HENRY S.R. 65

Township RICHFIELD

Section 9

T4N, R8E

Personnel HOFFMAN

LOEHRKE H.C.

HOUSEHOLDER R.C.


BARNHISEL

23

Date 1-27-84

Weather cloudy

Temp. 30°

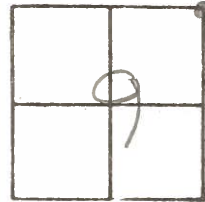

Fd. CTR. PUNCHED R.R. SPK set BY COUNTY

SLM = 582+35

@ surface


4.5' Lt. & SR65 PAUT.

104' S. of & Co. Rd. "L" PAUT.

SET PK/WASHER

8-28-84

SW.H.

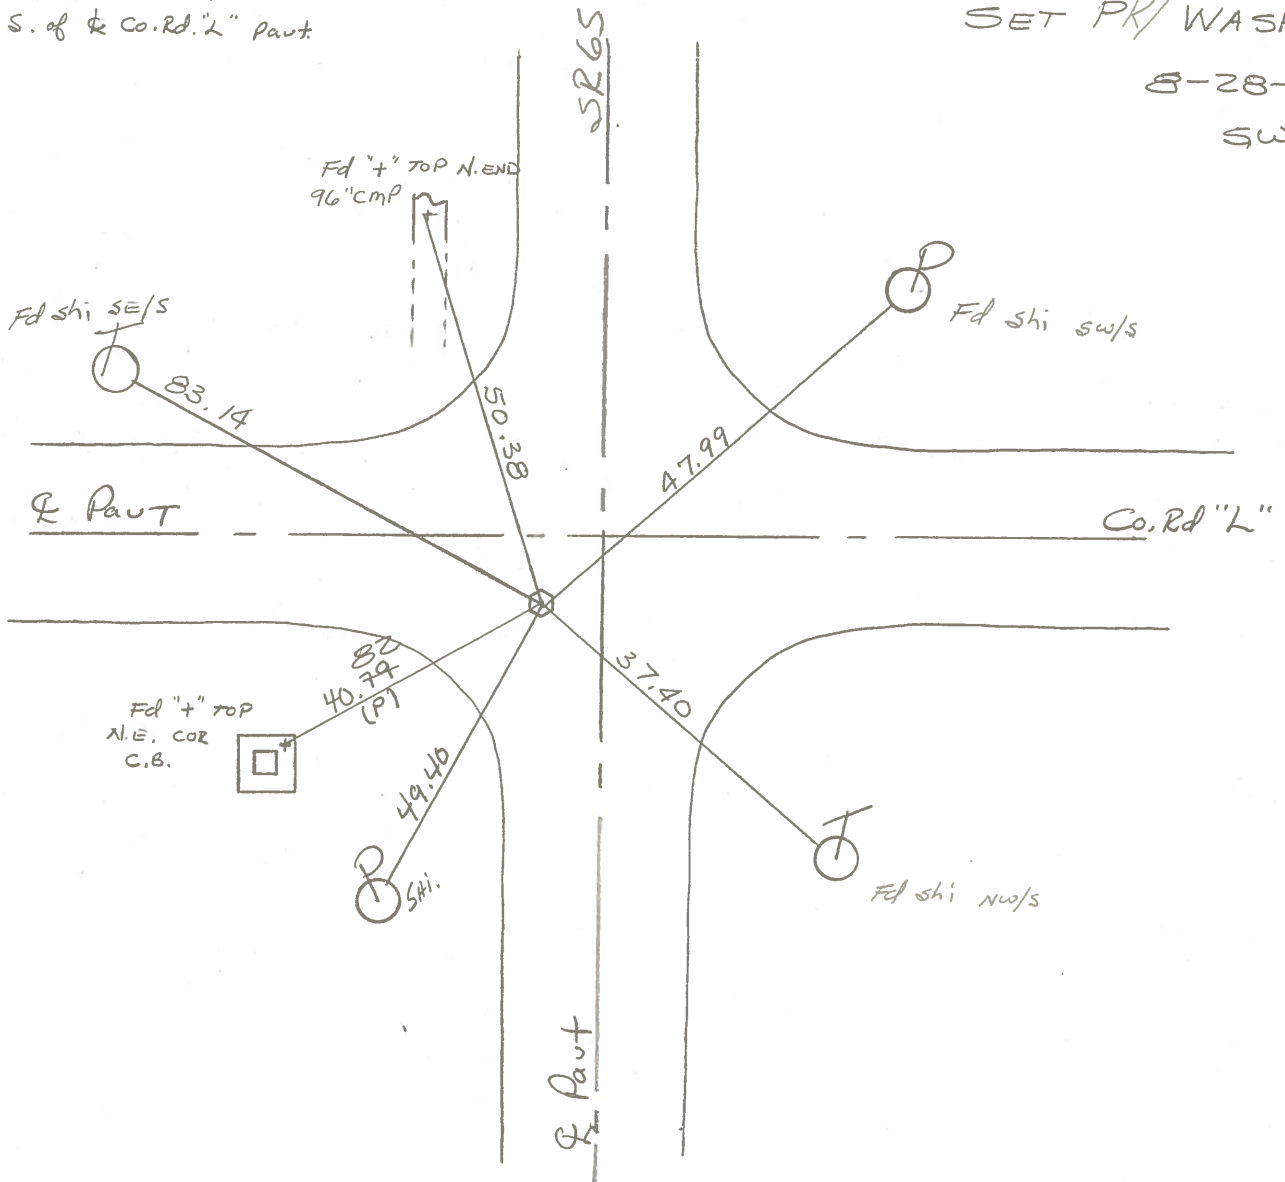

Q.D.O.T. DISTRICT 2 SURVEY OFFICE

SHEET _____ OF _____

County HENRY S.R. 65

Township RICHFIELD

Section 9

T4N, R8E

Personnel HOFFMAN

LOEHRKE H.C.


HOUSEHOLDER R.C.

BARNHISEL

Date 1-27-84

Weather cloudy

Temp. 30°

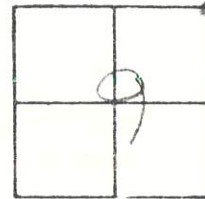

#23

Fd. CTR. PUNCHED R.R. SPK set BY COUNTY

SLM = 582+35

@ surface

4.5' Lt & SR65 PAUT.

10.4' S. of & Co. Rd "L" PAUT

SET PK/WASHER


8-28-84


SWH

582+36

50.4 &

10.0 S of & West

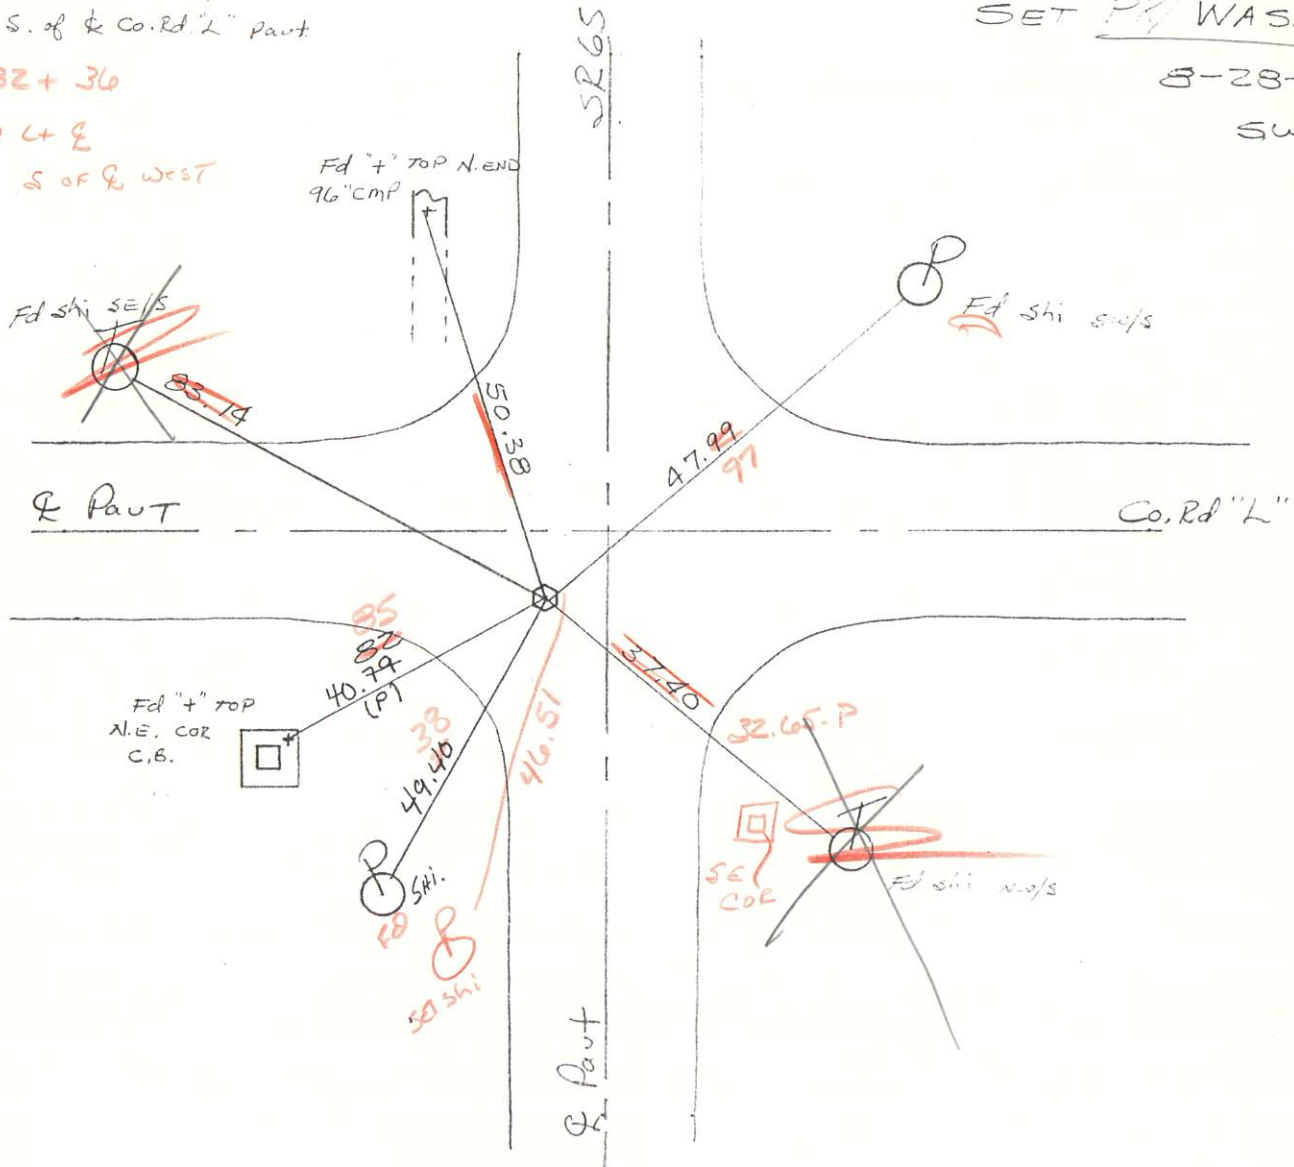

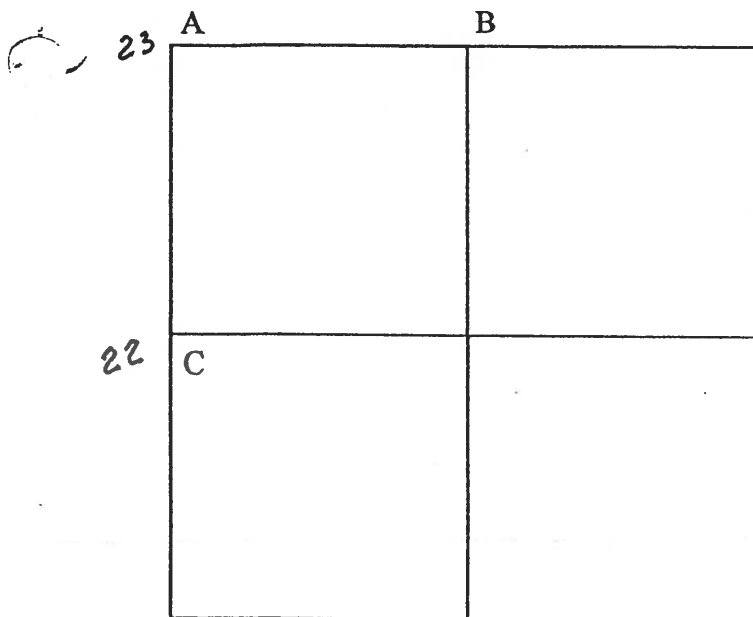

COUNTY: HENRY

TOWNSHIP: RICHFIELD

T-4-N R-8-E

SECTION: 10

7/31/79 R.W., J.J., G.M.

- 23 A - Found recorded RR spike 0.09' north and 0.12' west of top center of stone (4"x7"x16") 17" below road surface. Also found two small stones and wood stake. Removed small stones and wood stake. Placed center punched RR spike on surface over top center of stone. Pk's 6' north and east. Stone is 5.0' east of west edge 18' pavement.

50.34' N.N.W. to "+" top north end 96" CMP. (P)

45.02' N.E. to center well casing. (P)

47.85' N.E. to shiner sw/s power pole.

37.36' S.E. to shiner nw/s telephone pole.

49.35' S.W. to shiner ne/s power pole.

40.78' S.W. to "+" NE corner catch basin. (P)

7/18/88 R.W., S.K., K.A.

Found nail/shiner on surface. Pk's 6' north and east.

50.36' N.N.W. to "+" north end CMP. (P)

47.97' N.E. to shiner sw/s power pole.


55.33' N.E. to center USGS Sta. "GILES 1950".(P)

49.37' S.W. to shiner ne/s power pole.

40.82' S.W. to "+" NE corner catch basin. (P)

PERSONNEL	TITLE	PERSONNEL	TITLE
BURNSIDE			
SMITH			
BOWERS			
MEAD			

COUNTY HENRY DATE 4-25-75
 S. R. 65 WEATHER CLOUDY
 SEC. N.E. COR. SEC. 9 TEMP. +50°
 DESCRIPTION REF. TO SECTION CORNER (RICHFIELD TWP.) JOB NO. _____

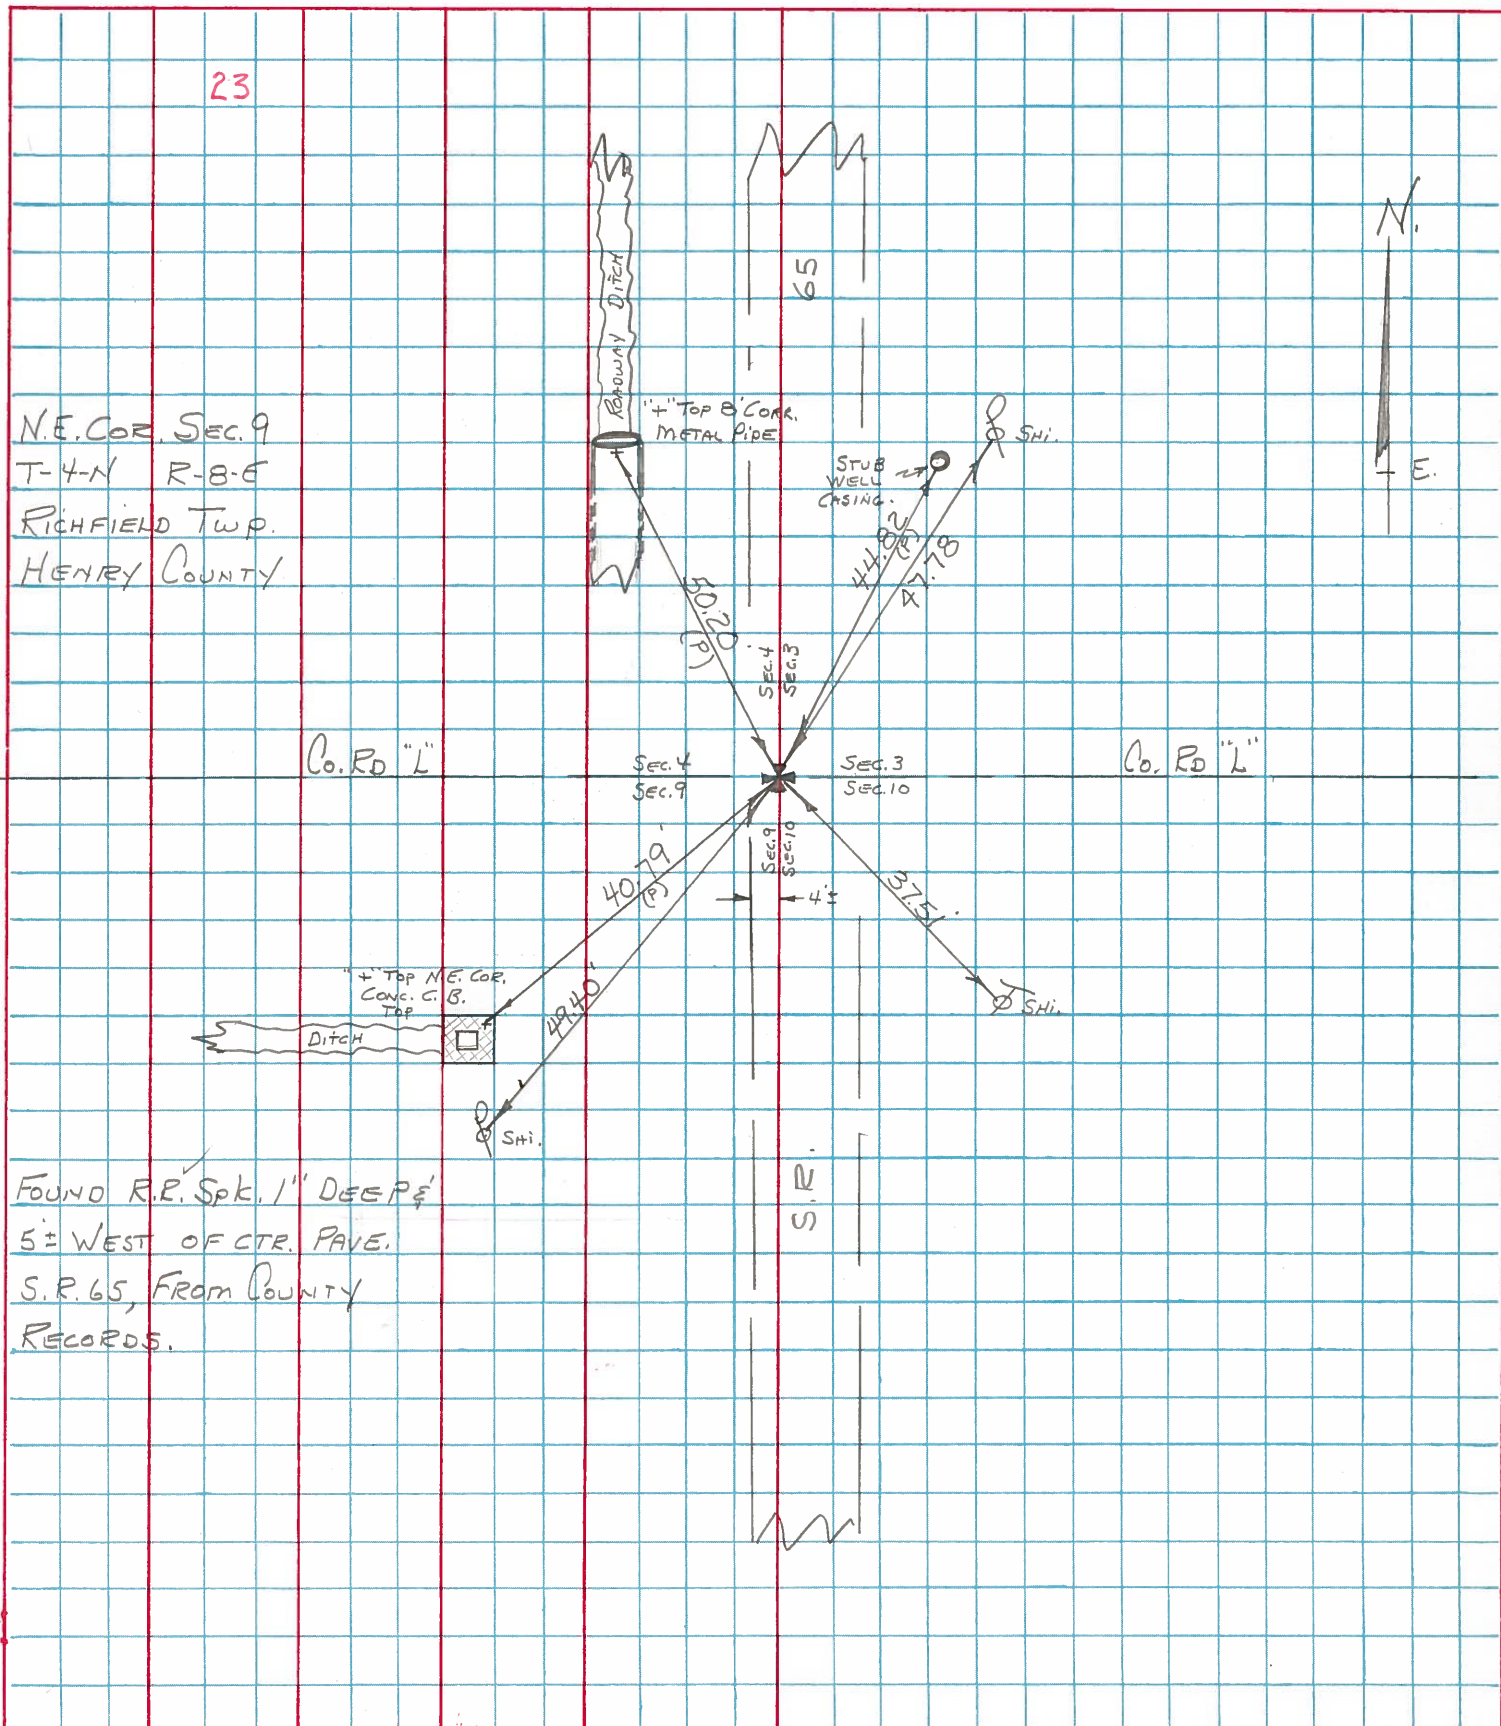

SHEET NO. _____

PERSONNEL	TITLE	PERSONNEL	TITLE
BURNSIDE			
SMITH			
BOWERS			

COUNTY HENRY DATE 4-25-74

S. R. 65 WEATHER Pt. Cloudy

SEC. _____ TEMP. +60°

DESCRIPTION ± CONTROL POINTS JOB NO. _____

