


O.D.O.T. DISTRICT 2 SURVEY OFFICE (USE ONLY)

PERSONNEL		REFERENCE NO.	<u>24</u>	SHEET	<u>27</u> OF <u>42</u>
NOTES	<u>HUSS</u>	DATE	<u>7/11/12</u>	ROUTE	<u>SR 65</u>
H.C.	<u>HUSS</u>	WEATHER	<u>CLEAR</u>	COUNTY	<u>HENRY</u>
R.C.	<u>CANTERBURY</u>	TEMP.	<u>78°</u>	TOWNSHIP	<u>RICHFIELD</u>
	<u>COUTCHER</u>			SECTION	<u>4</u>
	<u>HARBAUGH</u>			T <u>4</u> N R <u>8</u> E	


TYPE MONUMENT MAG/WASHER
~~ON SURFACE~~ - BELOW 5"
 LEFT - C PAV'T - ~~RIGHT~~ 9.7'
0' TO LT EDGE PAVEMENT
 S.L.M. 609+10

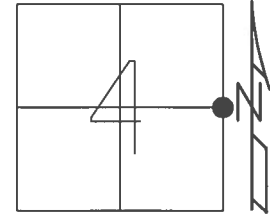

GRID: NORTHING: 610999.538 EASTING: 1572642.933

RECORD:
 R.R.SPIKE SET
 BY COUNTY ENGR.
 10/7/02
 SET MAG/WASHER
 11/14/02, MB
 FD MAG/WASHER
 7/11/12, MC
 D.N.F. POINT
 5/12/17, JFO
 SET MAG/WASHER
 RECREF24
 9/26/17, JFO

FD 5/8" IPINS
 ON DITCH BANK
 ±2' W.OF EB

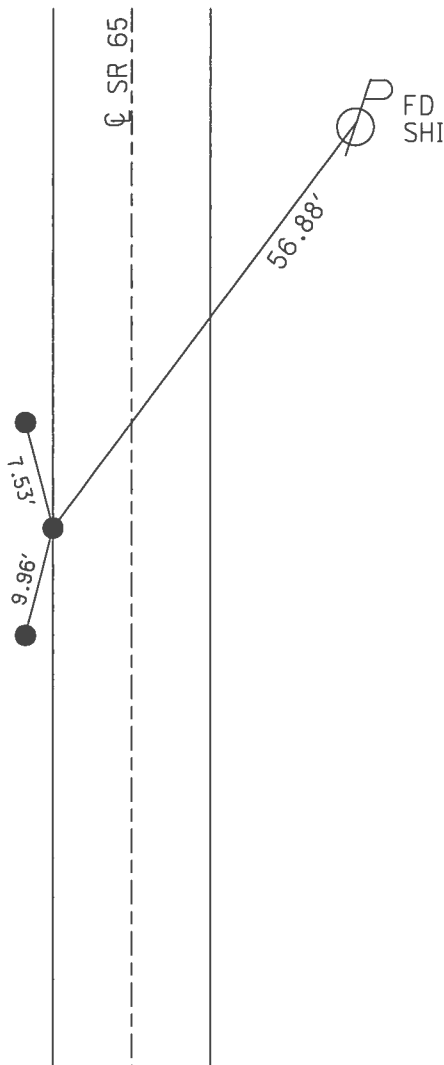

O.D.O.T. DISTRICT 2 SURVEY OFFICE (USE ONLY)

PERSONNEL

REFERENCE NO. 24

SHEET 27 OF 42

NOTES HUSS

DATE 7/11/12

ROUTE SR 65

H.C. HUSS

WEATHER CLEAR

COUNTY HENRY

R.C. CANTERBURY

TEMP. 78°

TOWNSHIP RICHFIELD

COUTCHER

SECTION 4

HARBAUGH

T 4 N R 8 E

TYPE MONUMENT MAG / WASHER


~~ON SURFACE~~ - BELOW 5"

LEFT - Q PAV'T - ~~RIGHT~~ 9.7', (ON W.EP)

0' TO LT EDGE PAVEMENT


S.L.M. 609+10

Grid: Northing: 610999.538 Easting: 1572642.933

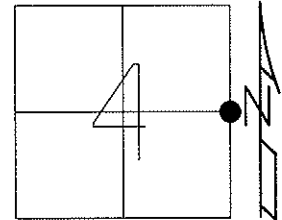

RAILROAD SPIKE SET BY HENRY CO
ENGINEER'S OFFICE WAS REMOVED
DURING PAVING PROJECT
DATE: 10-07-02

SET $\frac{5}{8}$ " IPINS
ON DITCH BANK
+/- 2' W.OF EB

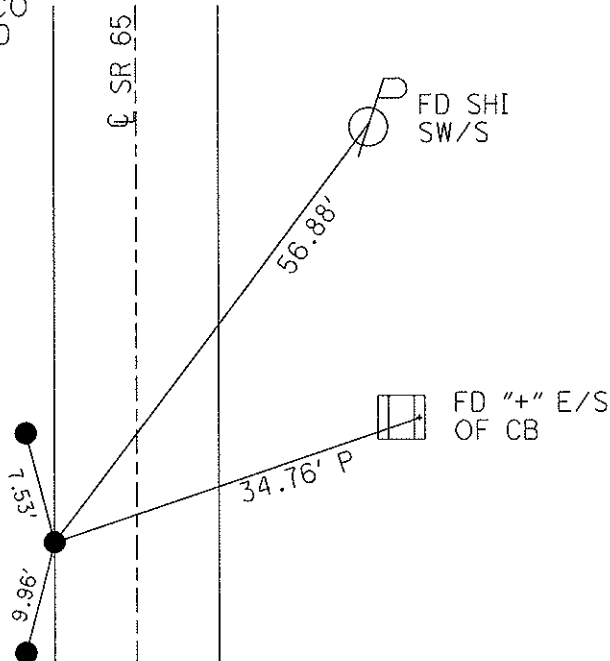

11/14/02 RESET MAG/WASHER, MB
POINT CHIPPED OUT, 3-15-13
07-11-12 GPS: REF 24
03-15-13 GPS: FIN 24, MC

O.D.O.T. DISTRICT 2 SURVEY OFFICE

PERSONNEL

REFERENCE NO. 24

SHEET 25 OF 29

NOTES BARNHISEL RC

H.C. CANTERBURY

R.C. _____

DATE 10-07-02

WEATHER cloudy

TEMP. +55°

ROUTE 65

COUNTY HENRY

TOWNSHIP RICHFIELD

SECTION 4

T 4 N R 8 E


TYPE MONUMENT Lg RR Spk

~~ON SURFACE~~ - BELOW 5"

LEFT- & PAU'T. - ~~RIGHT~~ 9.7'

0.6 TO LT. EDGE PAVEMENT

S.L.M. 609+10

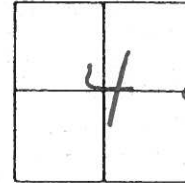


Reset Mag Nail & Washer

11-14-02

MB

Mag Nail Removed,
Railroad Spike Reset
Date _____

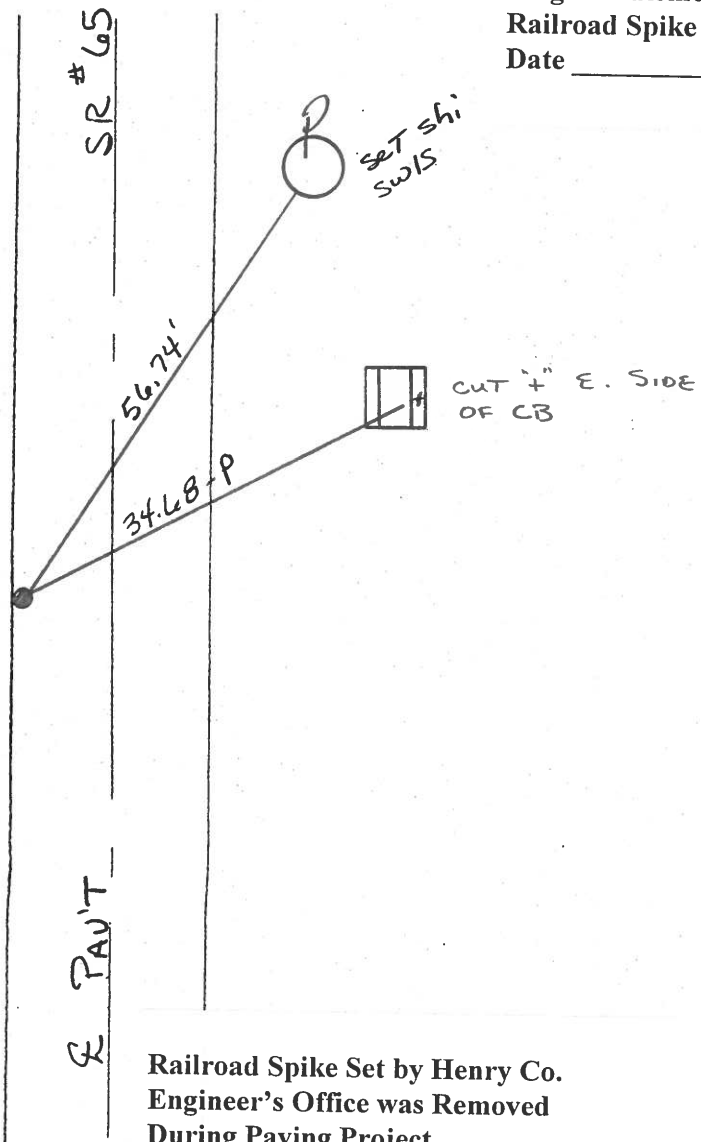

Railroad Spike Set by Henry Co.
Engineer's Office was Removed
During Paving Project
Date 10-07-02

O.D.O.T. DISTRICT 2 SURVEY OFFICE

PERSONNEL

REFERENCE NO. 24

SHEET OF

NOTES BARNHISEL ✓

H.C. " MC

R.C. HOFFMAN MB

DATE 4-11-90

WEATHER Sunny cloudy

TEMP. +40° +55

ROUTE 65

COUNTY Henry

TOWNSHIP Richfield

SECTION 4

T 4 N R 8 E


TYPE MONUMENT P.K. & Washer Removed

ON SURFACE - BELOW yes 5"

LEFT - & PAV'T. - RIGHT 9.7 ✓

O.G. TO LT EDGE PAVEMENT

S.L.M. 609+21 609+51 609+10

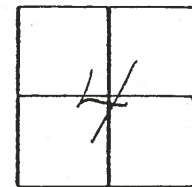

Set P.K. & Washer
5-15-90
MB

Reset Magnetic/washer
11-14-02
MB

DESS

19.26'
6.82'

SR 65

56.74'
33.38-P
34.68-P



Cut "x"

30.69
Fd Sh
w/S

& Pav't

Q.D.O.T. DISTRICT 2 SURVEY OFFICE

SHEET _____ OF _____

County HENRY S.R. 65

Township RICHFIELD

Section 4

T4N, R8E

Personnel HOFFMAN

LOHRKE H.C.

HOUSEHOLDER R.C.


BARNHISEL

24

Date 1-27-84

Weather Cloudy

Temp. 30°

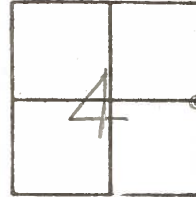

Fd. CTR. PUNCHED R.R. SPK set by County

SLM = 609+18

@ SURFACE

9.7' Lt. of & Paut

0.5' Lt. of Lt. EP.

SET PK/WASHER

8-28-84

SW.H.

Fd Duplex
E/S

56.20

SR 64

33.31-P

30.36
53



rd. "4" TOP E. WALL
S. END of C.B.

Fd Shi w/s

& Paut

Q.D.O.T. DISTRICT 2 SURVEY OFFICE

SHEET _____ OF _____

County HENRY S.R. 65

Township RICHFIELD

Section 4

T4N, R8E

Personnel HOFFMAN

LOEHRKE H.C.


HOUSEHOLDER R.C.

BARNHISEL

Date 1-27-84

Weather Cloudy

Temp. 30°

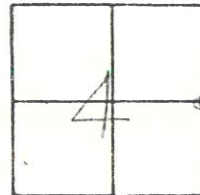

24

Fd. CTR. PUNCHED R.R. SPK set by COUNTY

SLM = 609+18

@ SURFACE


SET PK/WASHER

9.7' Lt. of & PAUT


8-28-84

0.5' Lt. of Lt. EP.

S.W.H.

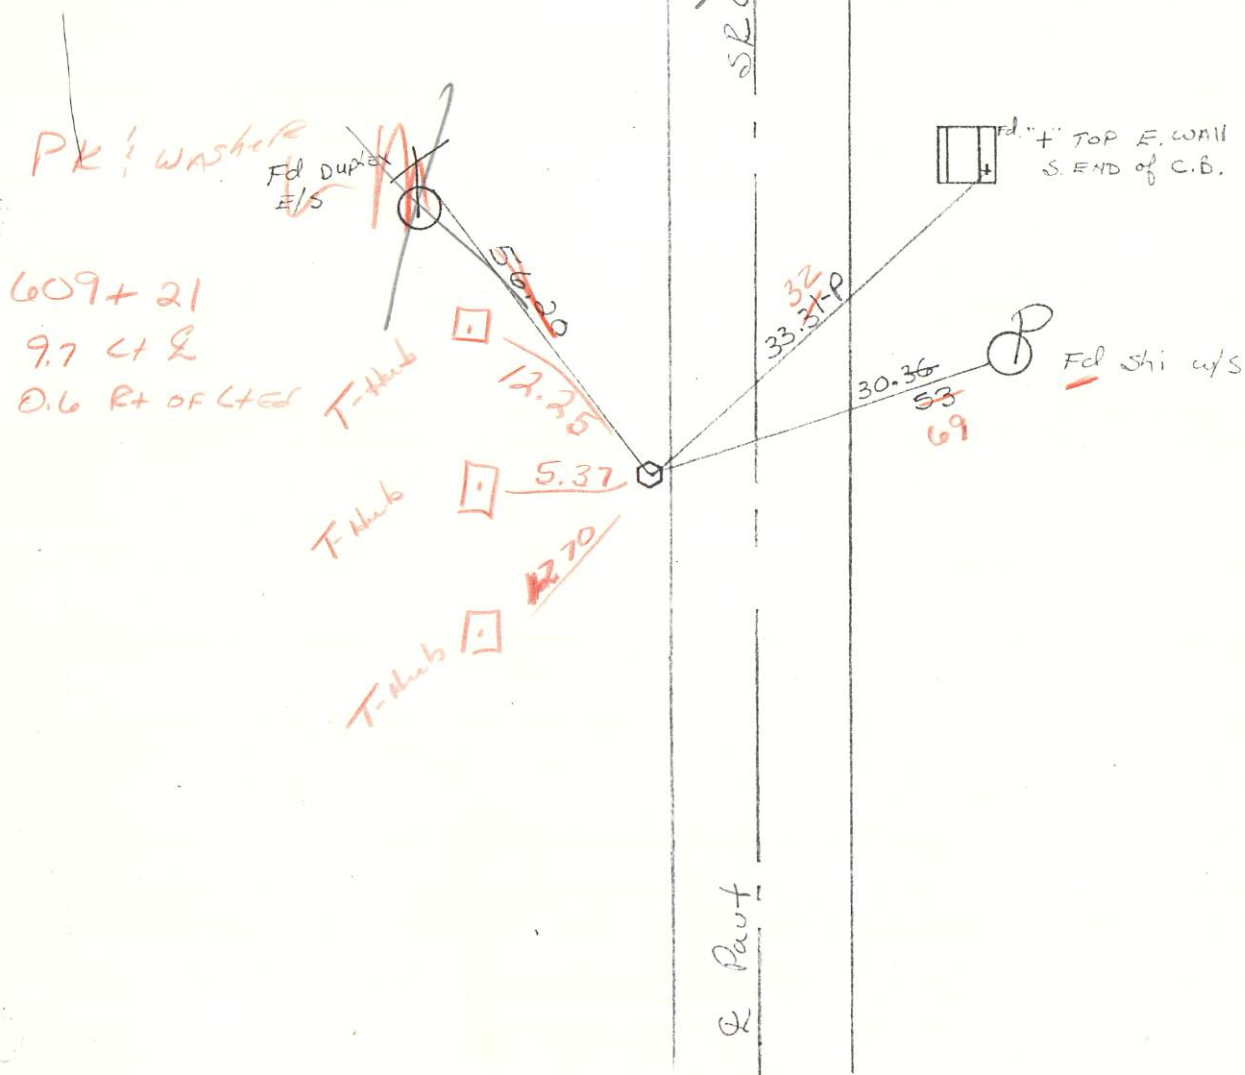

25.A

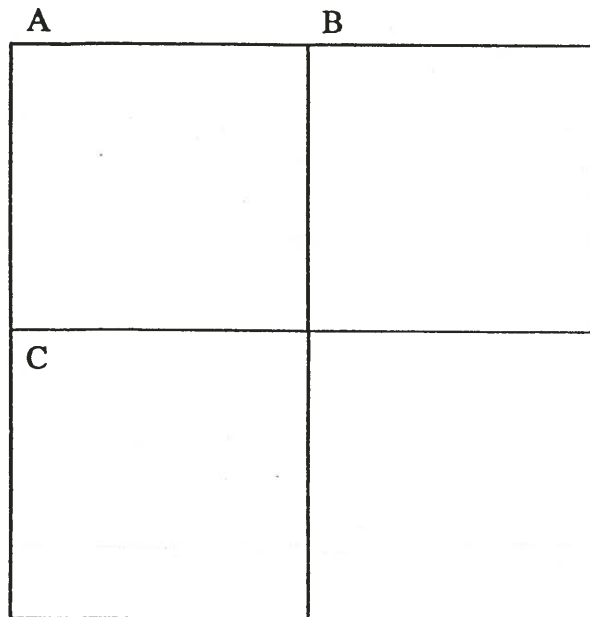

COUNTY: HENRY

TOWNSHIP: RICHFIELD

T- 4 - N R- 8 - E

SECTION: 3

8/20/79 R.W., J.J., C.S.

B - Found stone (6'x6"x15") 20" below road surface. Placed center punched RR spike on surface over high point of stone. Pk's 6' northeast and northwest. Stone is 0.6' north of south edge 12' pavement.

38.89' N.N.E. to "+" in large stone (15"x15"x15"). (P)

73.12' N.E. to duplex w/s buried cable marker.

60.82' E.S.E. to near face Twp. Rd. sign post. GONE

32.56' S.S.E. to duplex n/s power pole.

30.87' E. to S $\frac{1}{4}$ Post, Sec. 34; Richfield Twp.

7/13/88 R.W., S.K., K.A.

18.41' N.W. to 5/8" iron pin 3' north of pavement.

38.86' N.N.E. to "+" in large stone (15"x15"x15"). (P)

73.25' N.E. to duplex w/s buried cable marker.

32.96' S.S.E. to duplex (new) w/s power pole.

8/1/79 R.W., J.J., G.M.

24 C - Found recorded iron pipe over small stone 0.63' west of high point of true stone (4"x7"x16") 16" below road surface. Found iron pipe on s/s of small stone. Removed iron pipes and small stone. Placed center punched RR spike on surface over high point of stone. Pk's 6' northeast and southeast. Stone is 0.6' west of west edge 18' pavement.

30.59' W. to center conc. R/W monument. (P)

56.28' N.W. to duplex e/s telephone pole.

33.25' N.E. to "+" south end, east wall catch basin. (P)

30.46' E.N.E. to shiner w/s power pole.

29.92' E. to center conc. R/W monument. (P)

7/13/88 R.W., S.K., K.A.

Found nail/shiner and Pk's northeast and southeast.

33.30' N.E. to "+" south end east wall of catch basin. (P)

30.47' E.N.E. to nail/shiner w/s power pole.

26.93' S.E. to 5/8" iron pin at east edge pavement.

PERSONNEL	TITLE	PERSONNEL	TITLE
-----------	-------	-----------	-------

BURNSIDE

Smith

BOWERS

MEAD

COUNTY HENRY

DATE 5-5-75

S. R. 65

WEATHER Cloudy

SEC. E. 1/4 POST SEC. 4
(RICHFIELD TWP.)

TEMP. $+56^{\circ}$


DESCRIPTION REF. TO SECTION CORNER

LEFT

CENTER LINE

RIGHT

JOB NO.

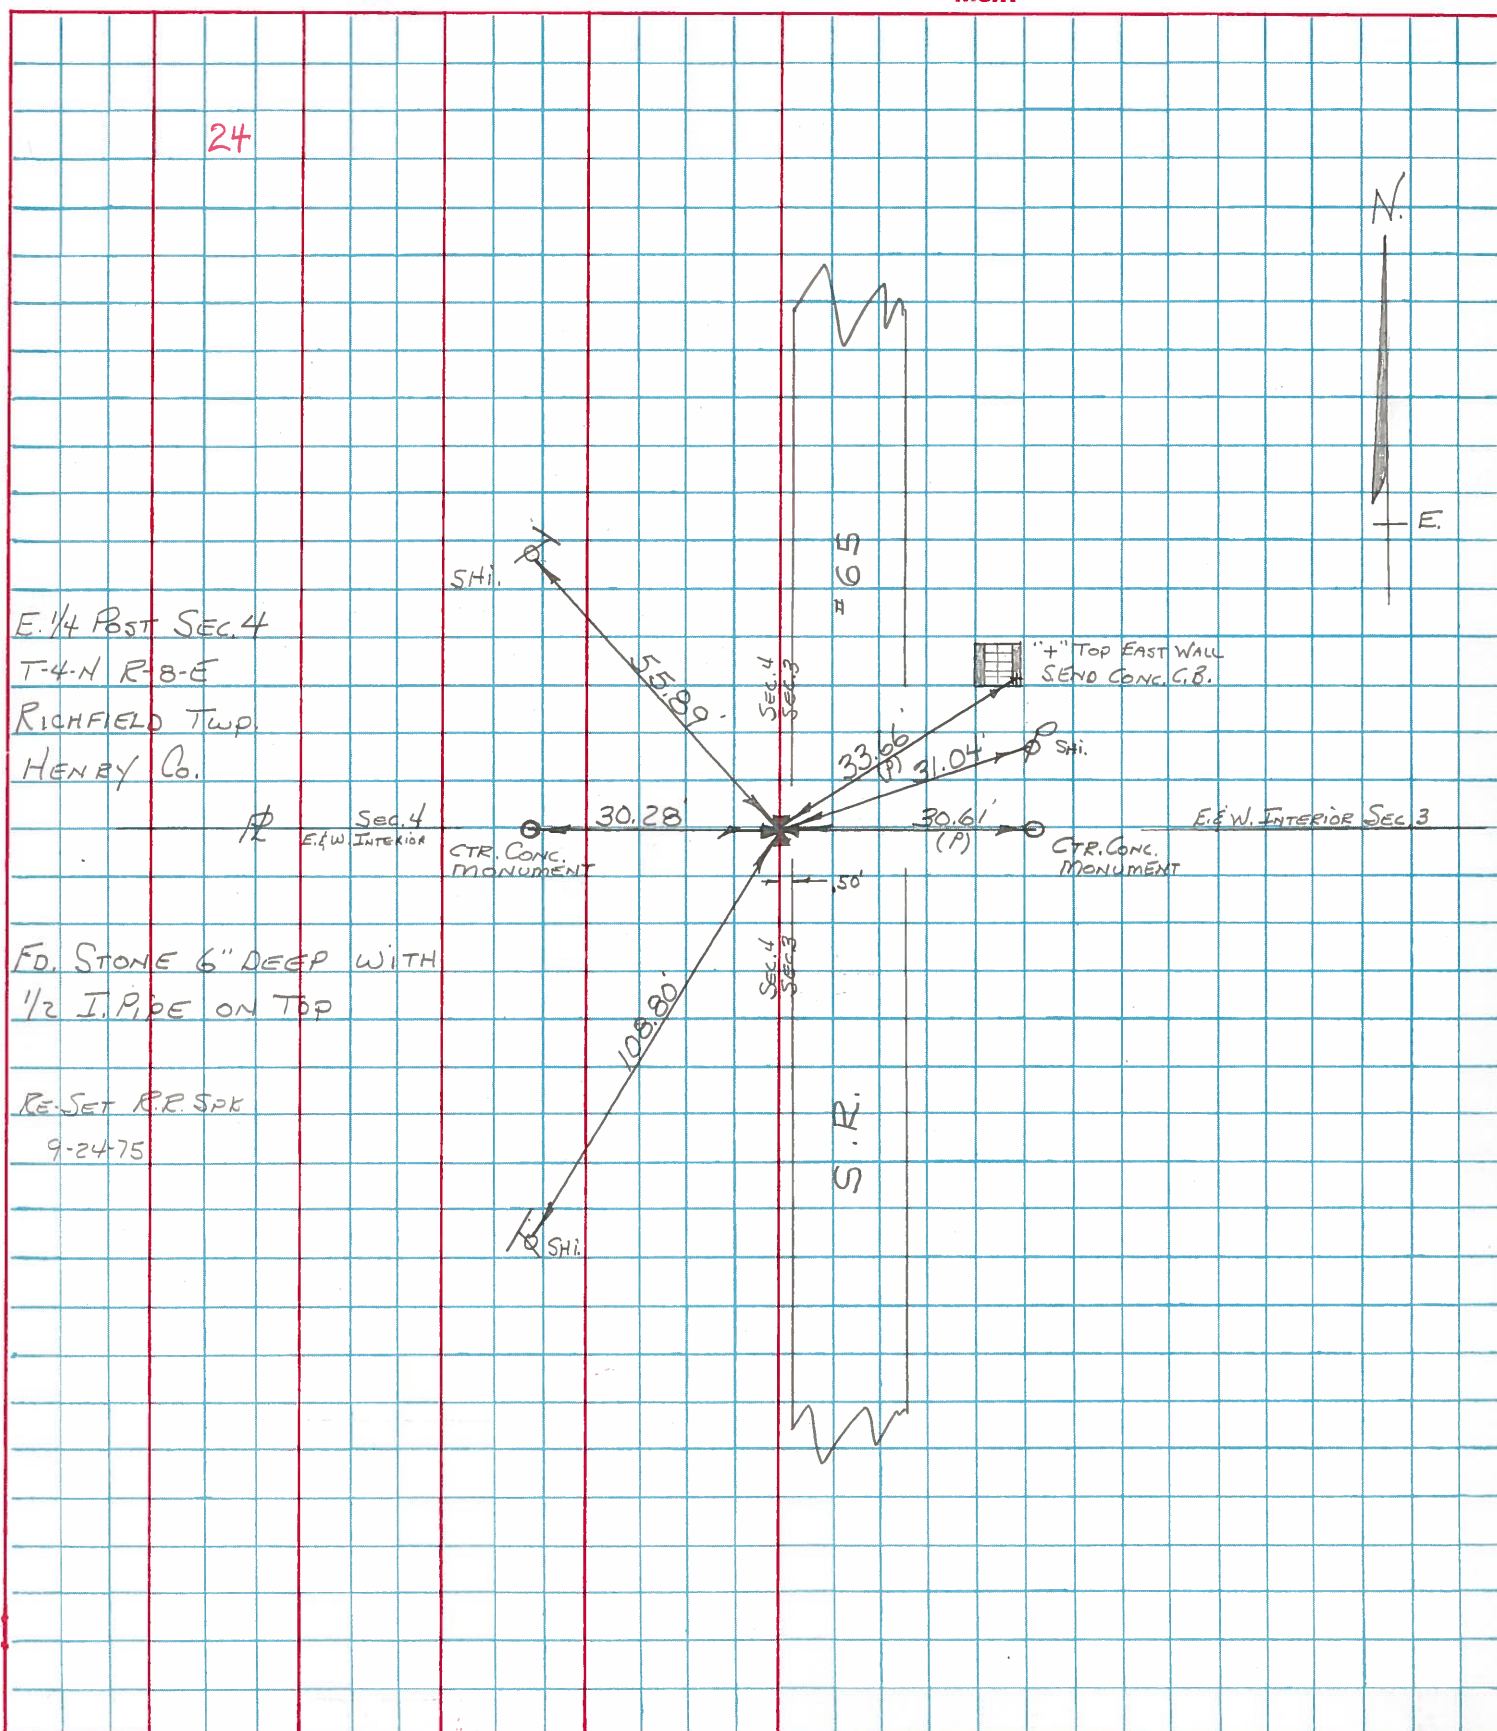

PERSONNEL TITLE PERSONNEL TITLE

BURNSIDE

SMITH

BOWERS

COUNTY HENRY

DATE 4-25-74

S. R. 65

WEATHER Pt. Cloudy

SEC. _____

TEMP. +60°

DESCRIPTION $\pm$ CONTROL POINTS

LEFT

CENTER LINE

RIGHT

JOB NO. _____

24

W. 1/4 COR. SEC. 3

RICHFIELD TWP.

FD. 1/2" I. PIPE

.50' W. OF W. EDGE

PAINT OVER STONE

NE 1/4 6" DEEP 1/2" W. OF W. EDGE

PAINT

CTR. CONC.
MON."T" TOP EAST WALL
CONC. C.B.CTR. CONC.
MON.

E. R. 1/4 S. R. 65

23

S.W. COR. SEC. 3

RICHFIELD TWP.

FD. R.E. SPT.

1" DEEP

COUNTY

ROAD "L"

"T" TOP CONC.
TOP OF
CONC. BULK.
C.B. & M.H.

SHI.

SHI.

