

O.D.O.T. DISTRICT 2 SURVEY OFFICE (USE ONLY)

PERSONNEL

REFERENCE NO. 7 A

SHEET 12 OF 24

NOTES HOFFMAN
H.C. HOUSEHOLDER
R.C. LOEHRKE
GRIFFITH

DATE 1/22/82
WEATHER SNOW, WINDY
TEMP. 14°

ROUTE SR 108
COUNTY HENRY
TOWNSHIP PLEASANT
SECTION 11
T 3 N R 6 E

DWG BY RHOADES PID _____

TYPE MONUMENT P.K.NAIL

ON SURFACE - ~~BELOW~~ ON _____

OFFSET CL PAVEMENT 4.1' LT : ~~RT~~

5.8' TO LT EDGE PAVEMENT


STATION: 214+14.20

HORZ.DATUM: _____

GEOID: _____


GRID: NORTHING: _____

EASTING: _____

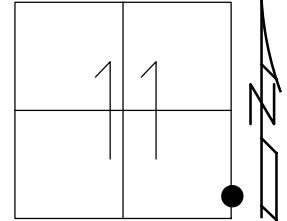

RECORD:
SET P.K.NAIL
F/CL BRIDGE CONTROL
1/22/82, CL
D.N.RESET
9/92, CL

CL SR 108

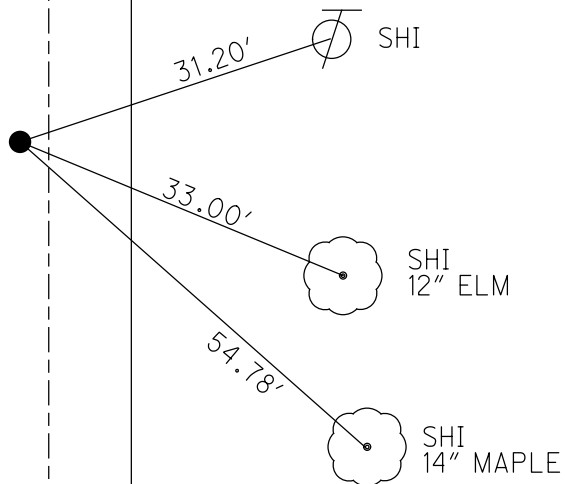

County HENRY S.R. 108

Township PLEASANT

Section 11

T. 3 N, R. 6 E

Personnel Hoffman

Householder


Lodke

Griffith

Date 1-22-82

Weather Snow - windy

Temp. +14°

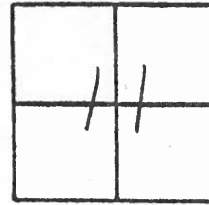

Set P.K. Nail For Bridge Control STA 214 + 14.20

4.1 W. of R. part

13.3 to E. E.P.

5.8 to W. E.P.

#7-A

DID NOT Re-SET
Sept 1992
C.L.

