

O.D.O.T. DISTRICT 2 SURVEY OFFICE (USE ONLY)

PERSONNEL

REFERENCE NO. 66

SHEET OF

NOTES NIESE

DATE 8/21/23

ROUTE SR 108

H.C. NIESE

WEATHER

COUNTY HENRY

R.C.

TEMP.

TOWNSHIP NAPOLEON

SECTION 13

DWG BY BARRIERE

PID 110867

T 5 N R 16 E

TYPE MONUMENT MONBOX W/ 1" IPIN

ON SURFACE - BELOW ON

OFFSET $\mathcal{C}$ PAVEMENT ON LT : RT

 TO EDGE PAVEMENT

STATION: 882+82

HORIZ.DATUM: NAD83(2011)/HEN LDP


GEOID: 18

GRID: NORTHING: 635425.073

EASTING: 1520773.500


LDP: NORTHING: 491598.434

EASTING: 155246.710

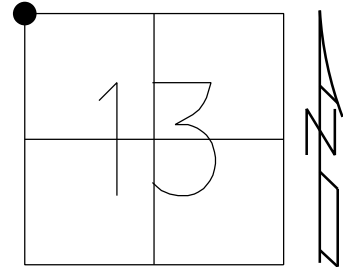

RECORD: P.I.

STA 883+50.96
FD MONBOX
W/ IPIN
8/2/01, MRC
FD MONBOX
W/ 1" IPIN
REF66
8/21/23, TDN

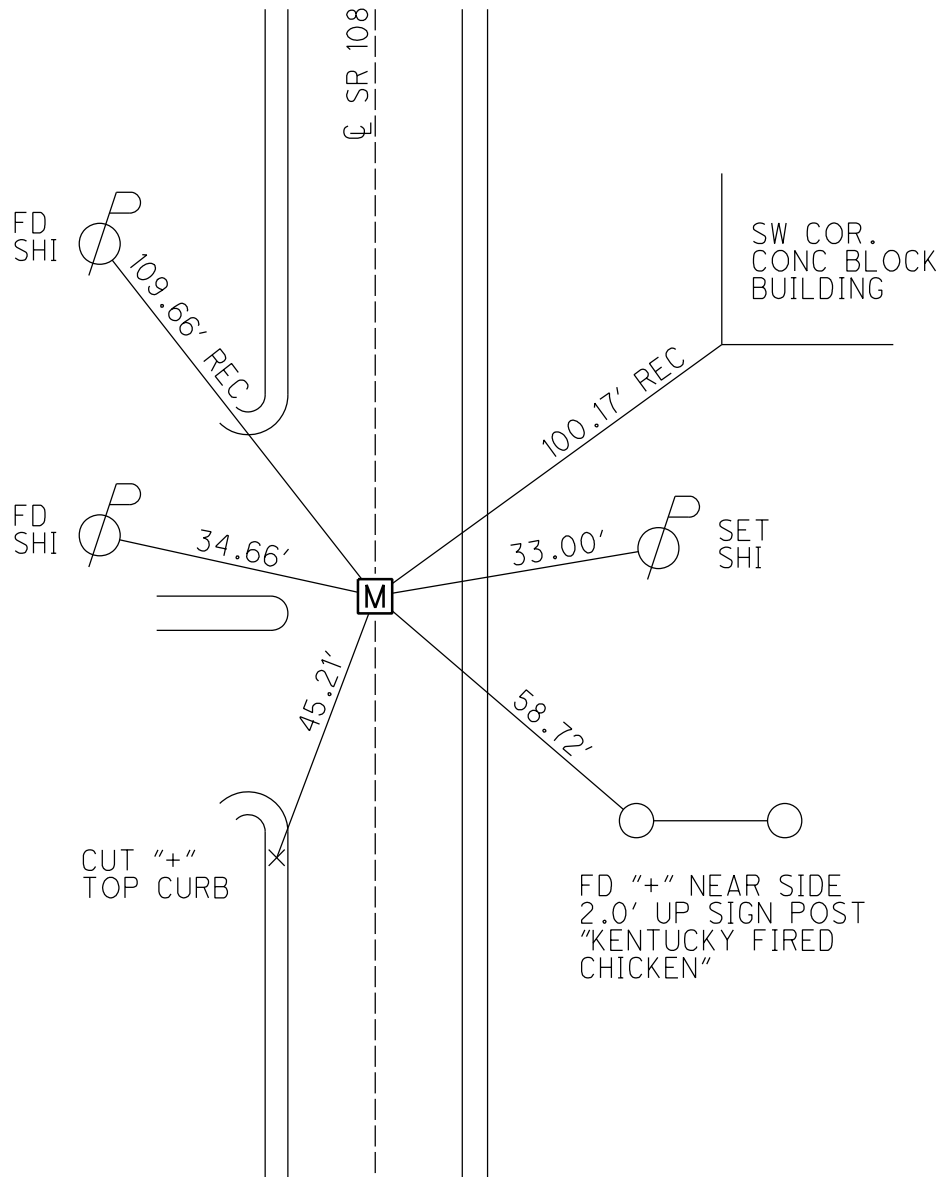

O.D.O.T. DISTRICT 2 SURVEY OFFICE (USE ONLY)

PERSONNEL

REFERENCE NO. 66

SHEET 11 OF 14

NOTES MOSER

DATE 8/2/01

ROUTE SR 108

H.C. CANTERBURY

WEATHER CLEAR

COUNTY HENRY

R.C. MOSER

TEMP. 85°

TOWNSHIP NAPOLEON

DWG BY NIESE

PID

SECTION 13

T 5 N R 16 E

TYPE MONUMENT MONBOX W/ IPIN

ON SURFACE - ~~BELOW~~ ON

OFFSET Q PAVEMENT ON LT : RT

20.2' TO LT ~~EDGE PAVEMENT~~ FACE OF CURB


STATION: 882+82

HORZ.DATUM:


GEOID:

GRID: NORTHING:

EASTING:

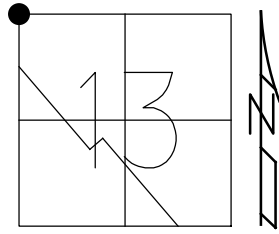

RECORD:
STA 883+50.96
FD MONBOX
W/ IPIN
8/2/01, MRC

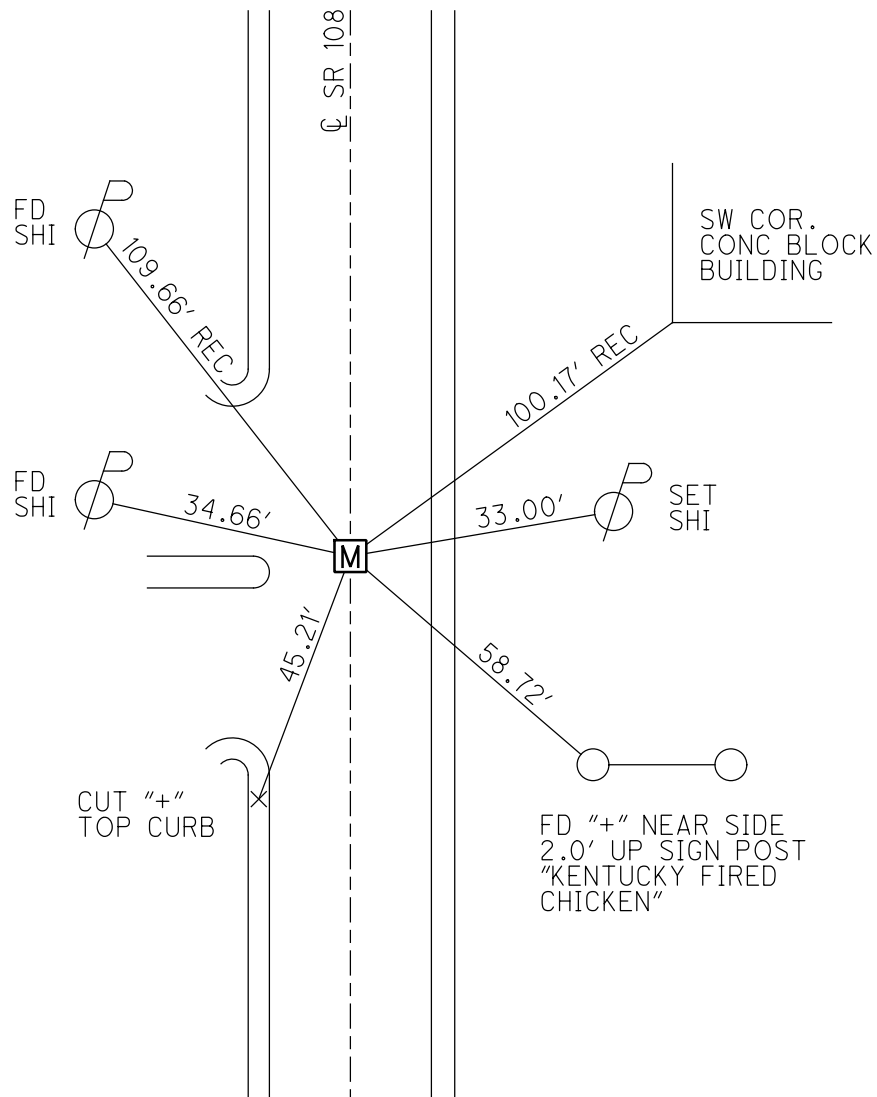

O.D.O.T. DISTRICT 2 SURVEY OFFICE

PERSONNEL

REFERENCE NO. 66

SHEET 6 OF 21

NOTES MOSE

H.C. CANTERBURY

R.C. MOSE

DATE 8-2-01

WEATHER CLEAR

TEMP. +85°F

ROUTE 108

COUNTY HENRY

TOWNSHIP NAPOLÉON

SECTION 13

T 5 N R 6 E

I. PIN


TYPE MONUMENT Mon Box - OPENED LID

ON SURFACE - ~~BELOW~~ ON

~~LEFT~~ - LT. PAV'T. - ~~RIGHT~~ R


20.2 TO LT. EDGE PAVEMENT FACE OF CURB

S.L.M. 882 + 82

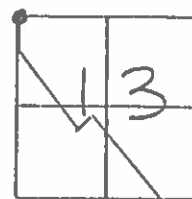

RECORD:

STA. 883+50.96

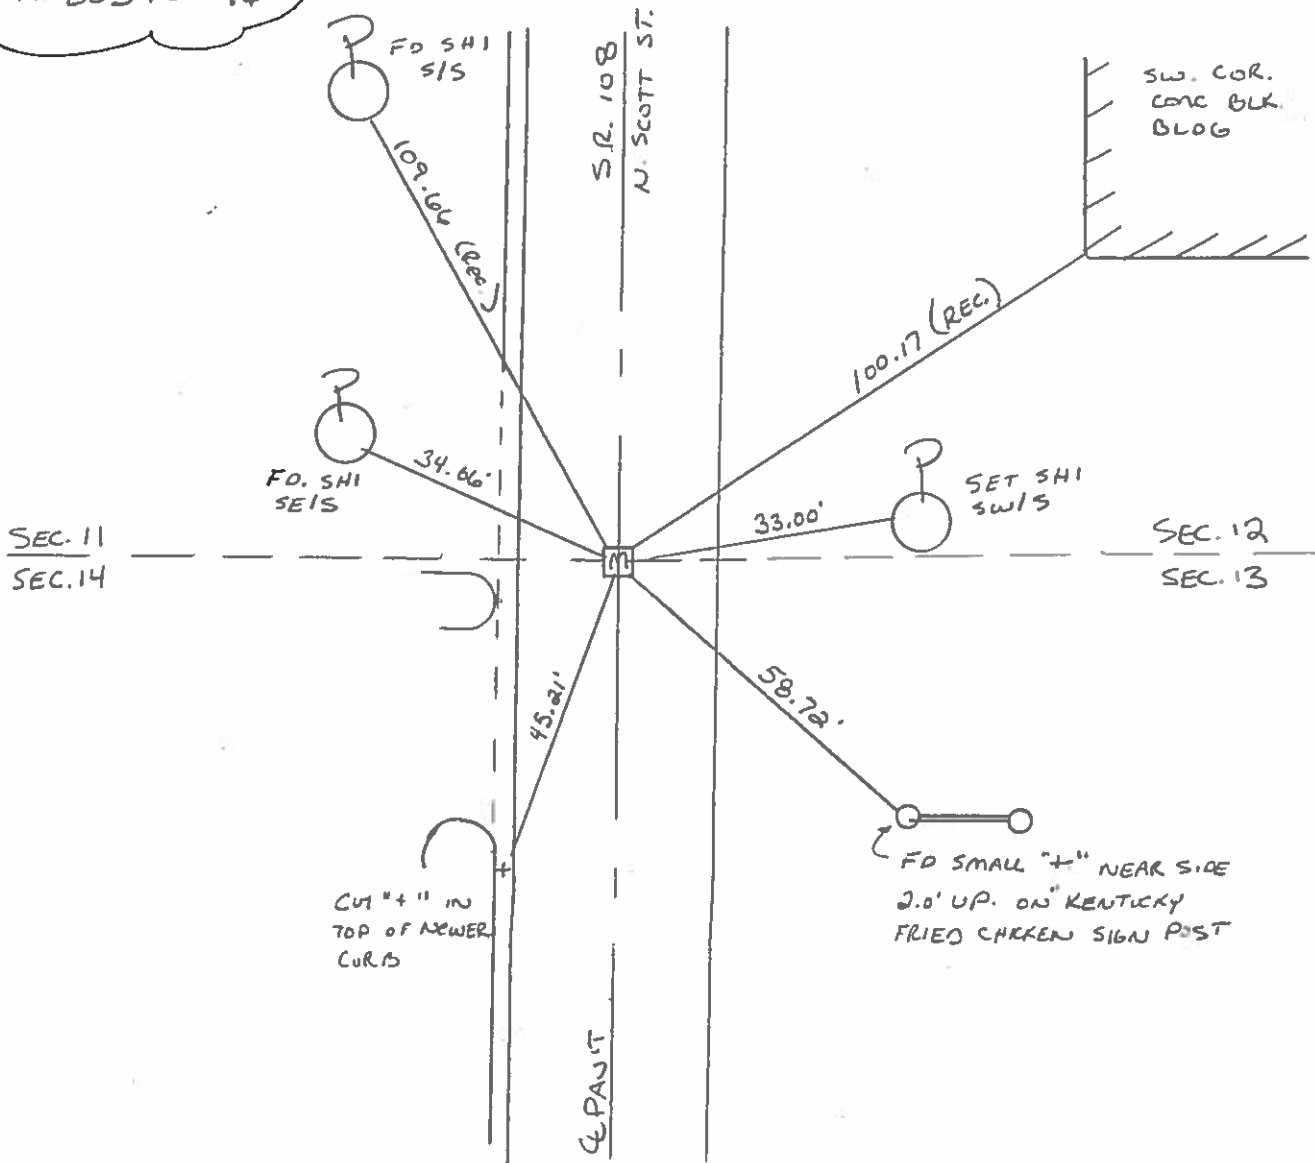

O.D.O.T. DISTRICT 2 SURVEY OFFICE

PERSONNEL

REFERENCE NO. 66

SHEET 18 OF 33

NOTES HOFFMAN

H.C. BARNHISEL

R.C. LOEHKE

DATE 4-8-88

WEATHER CLEAR

TEMP. 58°

ROUTE SR 108

COUNTY HENRY

TOWNSHIP NADOLSON

SECTION 13

T 5 N R 6 E

TYPE MONUMENT Boat SPIKE


ON SURFACE - BELOW 1"

LEFT- & PAW'T. - RIGHT 1'

14.1 TO LT EDGE PAVEMENT

S.L.M. 882 + 82

Set small
R.R. SPIKE
5-25-88 SWN

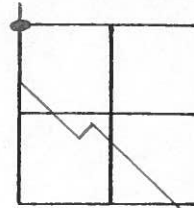

Record:
883+50.96

ALSO FOUND
@ surface:
P.K. 0.17' N. of spike
&
Hinge Nail 0.31' N. of spike

Fd shi
S/S

109.96

SR 108
N. Section St.

SW COR. CONC.
BLK. BLDG.

100.17 RECORD

Set shi
S/S

34.21

Sec 11
Sec 14

30.51

Set shi
S/S

Sec 12
Sec 13

CUT "T"
TOP of
New CURB

42.37

58.68

Cut "T" Near Sign 3' up
Kentucky Fried Chicken
Sign Post

Left
Right

Q.D.O.T. DISTRICT 2 SURVEY OFFICE

Sht. 18 of 19
S.R. 108

County HENRY

Township NAPOLEON

Section SE. COR. SEC. 11

T5N, R6E

Personnel BURNSIDE

SMITH


KNAPE

MEAD

Date 8-30-77

Weather CLEAR

Temp. +85°

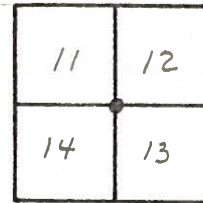

FD. BOAT SPK.
@ SURFACE

STA 883+50.96

