

O.D.O.T. DISTRICT 2 SURVEY OFFICE (USE ONLY)

PERSONNEL

REFERENCE NO. 66A

SHEET OF

NOTES NIESE

DATE 8/21/23

ROUTE SR 108

H.C. NIESE

WEATHER

COUNTY HENRY

R.C.

TEMP.

TOWNSHIP NAPOLEON

DWG BY BARRIERE

PID 110867

SECTION 12

T 5 N R 6 E


TYPE MONUMENT MONBOX W/ 1" IPIN

ON SURFACE - BELOW ON

OFFSET $\varnothing$ PAVEMENT ON LT : RT

 TO EDGE PAVEMENT

STATION: 904+07

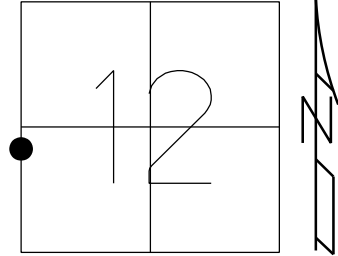


HORIZ.DATUM: NAD83(2011)/HEN LDP GEOID: 18

GRID: NORTHING: 637548.723 EASTING: 1520821.478

LDP: NORTHING: 493722.757 EASTING: 155255.728

RECORD: P.I.
STA 904+75.14

FD MONBOX
W/ IPIN
8/2/01, MRC
FD MONBOX
W/ 1" IPIN
REF66A
8/21/23, TDN

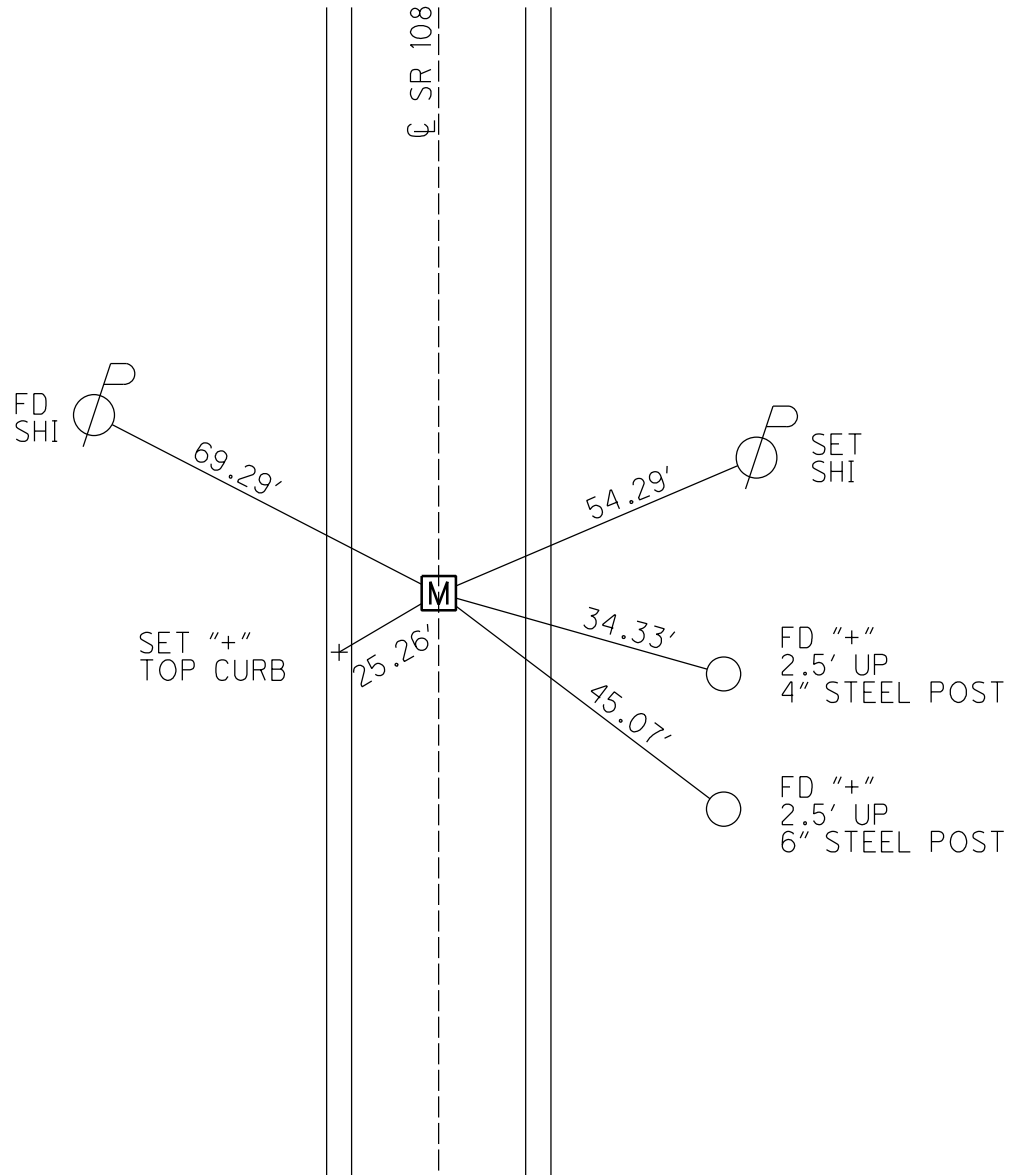

O.D.O.T. DISTRICT 2 SURVEY OFFICE (USE ONLY)

PERSONNEL

REFERENCE NO. 66 A

SHEET 12 OF 14

NOTES MOSER

DATE 8/2/01

ROUTE SR 108

H.C. CANTERBURY

WEATHER CLEAR

COUNTY HENRY

R.C. MOSER

TEMP. 85°

TOWNSHIP NAPOLEON

DWG BY NIESE PID _____

SECTION 12

T 5 N R 6 E

TYPE MONUMENT MONBOX W/ IPIN

ON SURFACE - ~~BELOW~~ ON


OFFSET Q PAVEMENT ON LT : RT

20.0' TO RT ~~EDGE PAVEMENT~~ FACE OF CURB


STATION: 904+07

HORIZ.DATUM: _____ GEOID: _____

GRID: NORTHING: _____ EASTING: _____

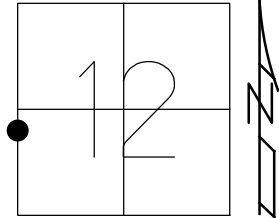

RECORD: P.O.T.
STA 904+75.14
FD MONBOX
W/ IPIN
8/2/01, MRC

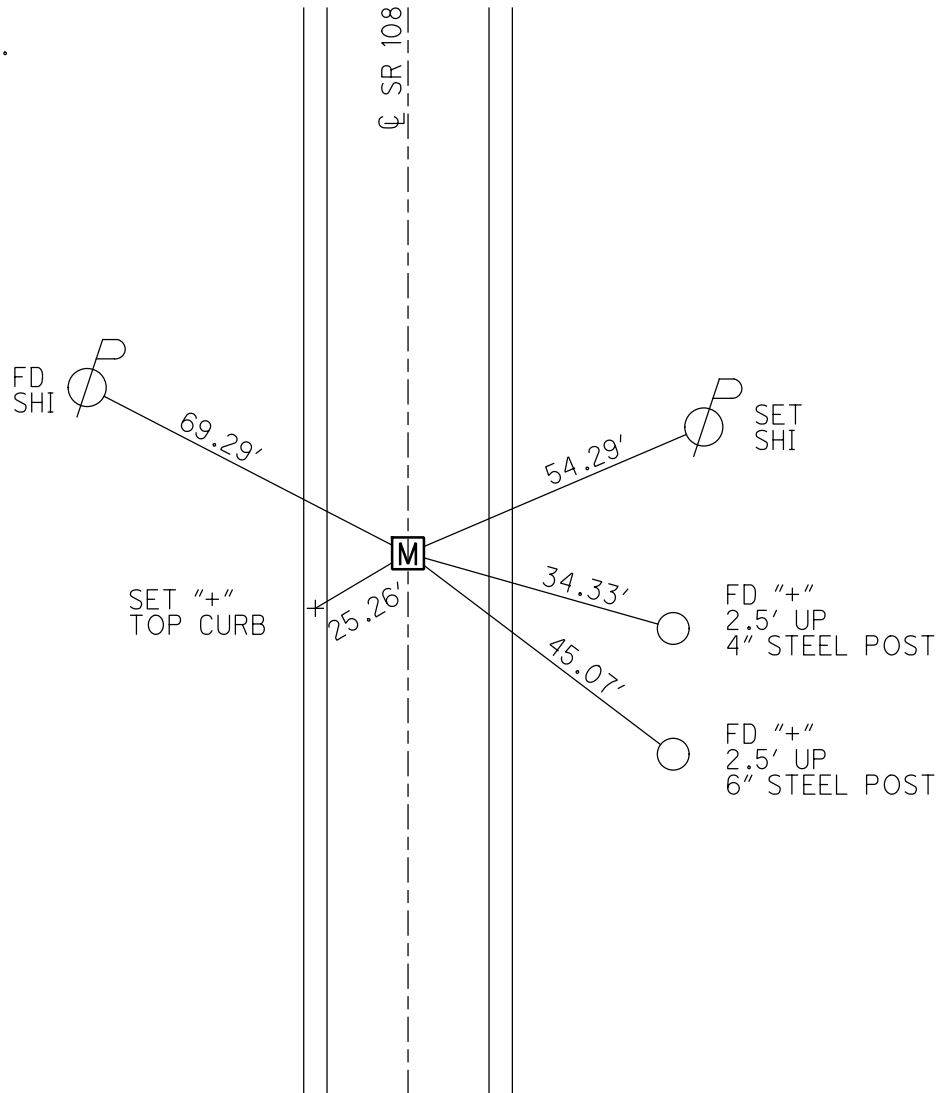

O.D.O.T. DISTRICT 2 SURVEY OFFICE

PERSONNEL

NOTES MOSE

H.C. CANTERBURY

R.C. MOSE

REFERENCE NO. 66-A

DATE 8-2-01

WEATHER CLEAR

TEMP. +85°F

SHEET 7 OF 21

ROUTE 108

COUNTY HENRY

TOWNSHIP NAPOLEON

SECTION 11

T 5 N R 6 E


TYPE MONUMENT Mon Box - OPENED LID

ON SURFACE - BELOW ON

LEFT - & PAV'T. - RIGHT CL


20.0 TO RT. EDGE PAVEMENT FACE OF CURB

S.L.M. 904+07

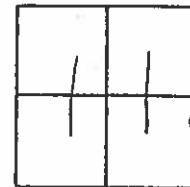

RECORD:

POT STA: 904+75.14

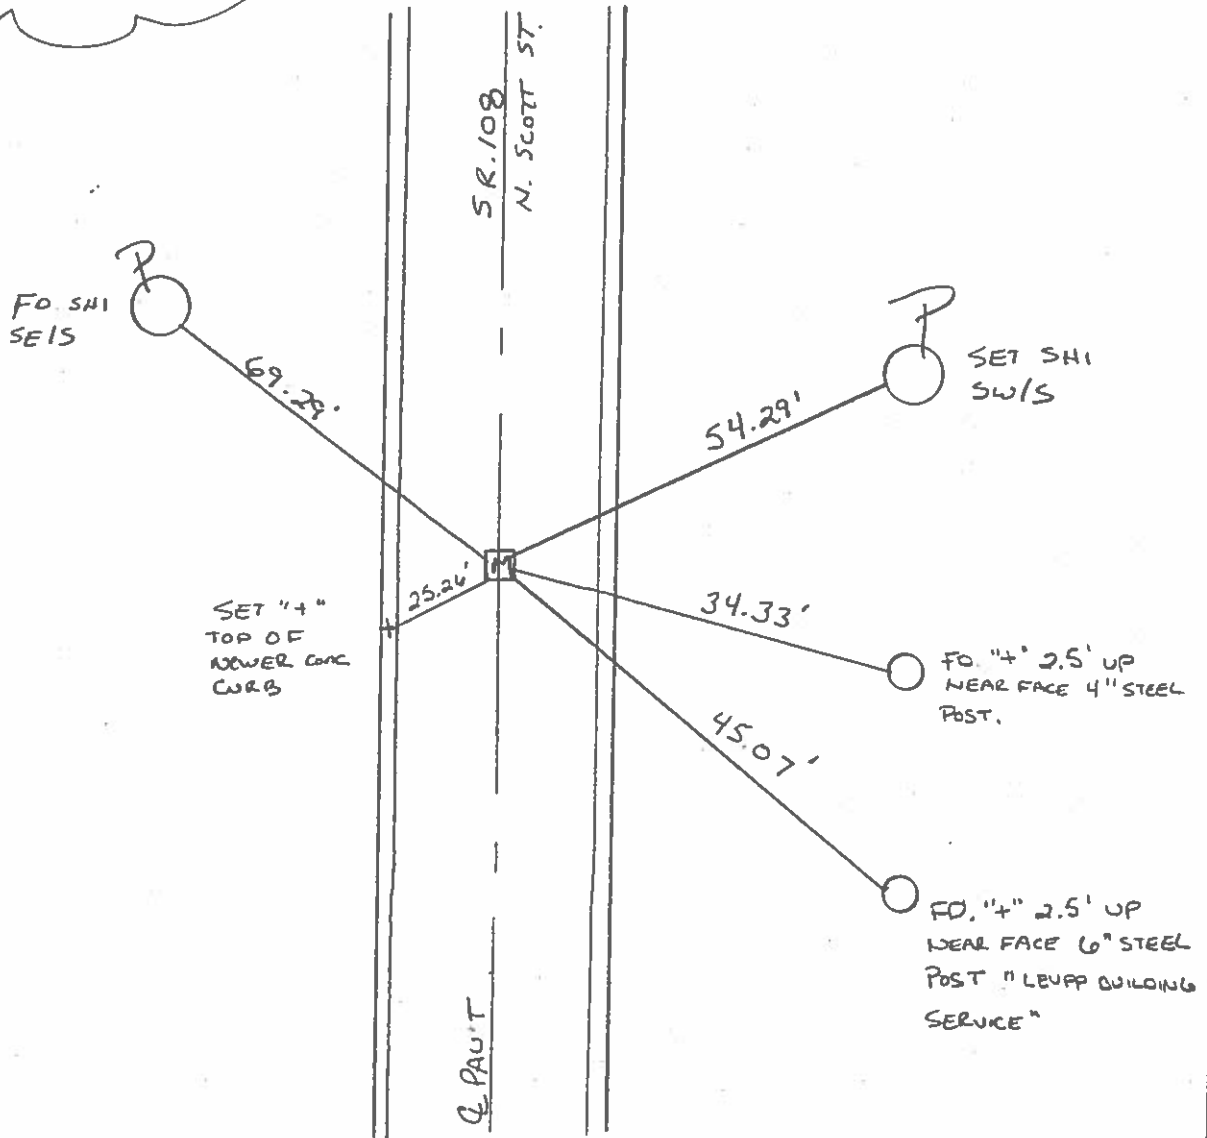

O.D.O.T. DISTRICT 2 SURVEY OFFICE

PERSONNEL

REFERENCE NO. 67

SHEET 19 OF 33

NOTES HOFFMAN

H.C. BARNHISEL

R.C. LO342K5

DATE 4-8-88

WEATHER CLEAR

TEMP. 58°

ROUTE SR 108

COUNTY HENRY

TOWNSHIP Napoleon

SECTION 11

T5 NR 6 E

TYPE MONUMENT Boat spikes


~~ON SURFACE~~ - BELOW 1"

~~LEFT - & PAN'T. - RIGHT~~ YES

14.1 TO R+ EDGE PAVEMENT


S.L.M. 904+07

Set small
R.R. SPIKE
5-25-88 SWH

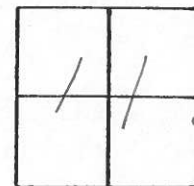

Record:

P.O.T. $904 + 75.14$

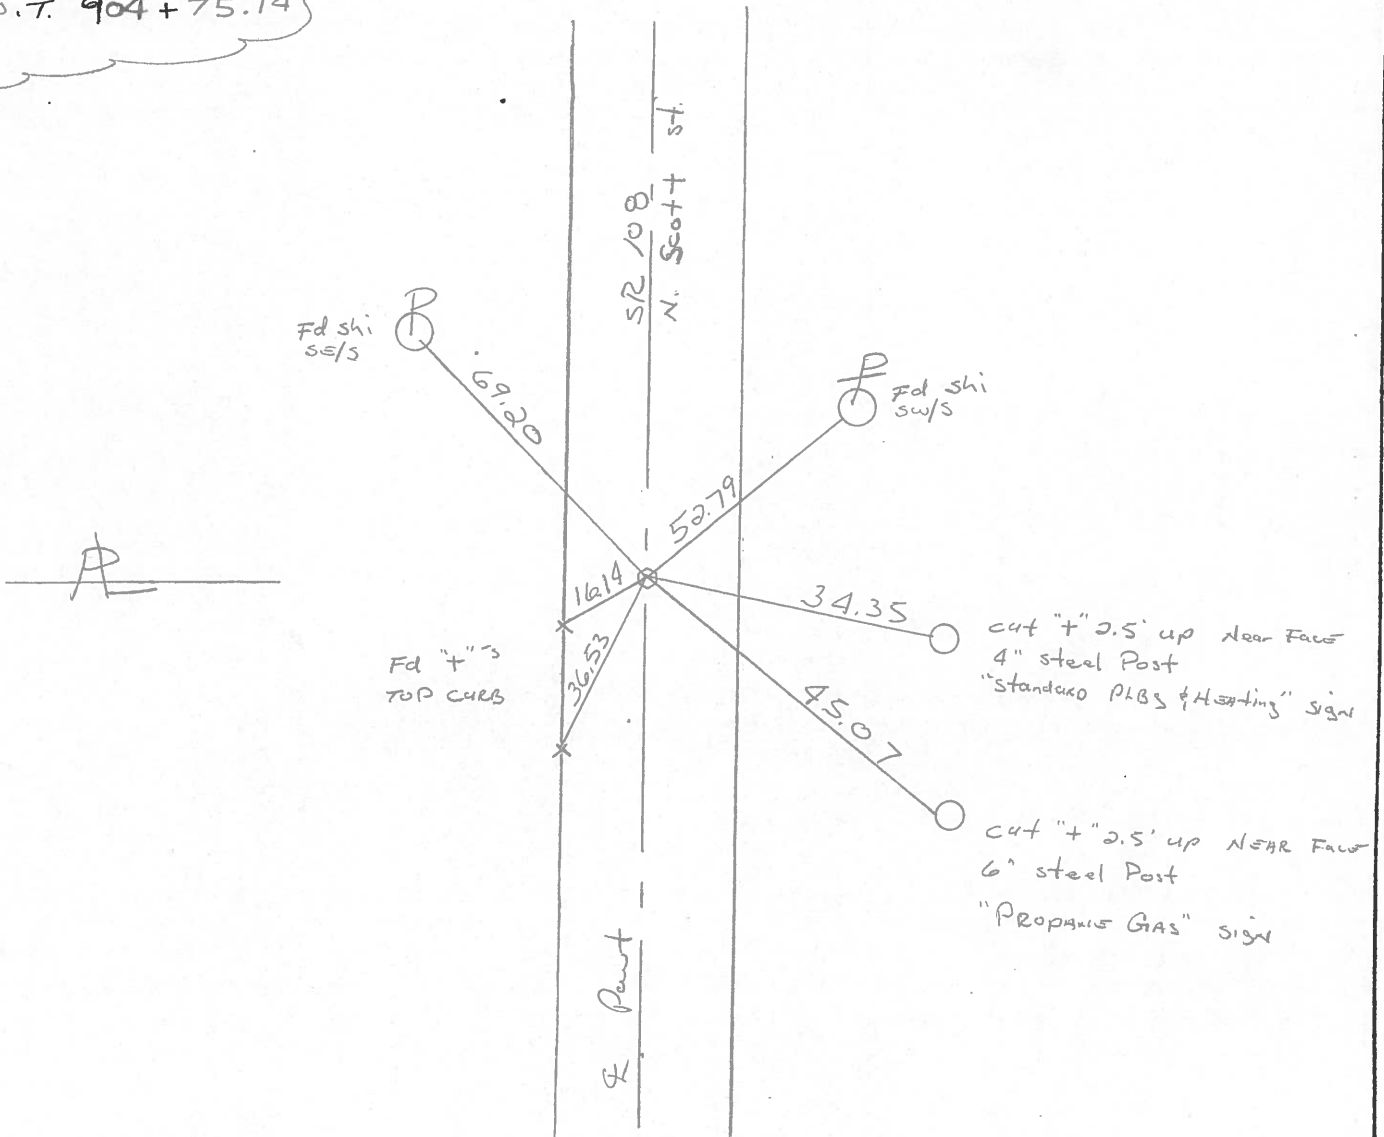

O.D.O.T. DISTRICT 2 SURVEY OFFICE

PERSONNEL

REFERENCE NO. _____

SHEET 20 OF 33

NOTES HOFFMAN

H.C. BARNHISEL

R.C. LOENKE

REED

DATE 4-18-88

WEATHER P. CLEAR

TEMP. 43°

ROUTE SR 108

COUNTY HENRY

TOWNSHIP NAPOLEON

SECTION 11

T5 N R 6 E


TYPE MONUMENT Monument + Box

ON SURFACE - BELOW YES

LEFT - & PAW'T. - RIGHT YES

14.2 TO RT EDGE PAVEMENT


S.L.M. 909 + 06

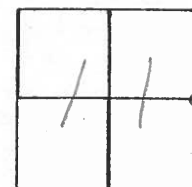

1966 PLAN = 909 + 74.40

DID NOT OPEN LID.

(67)

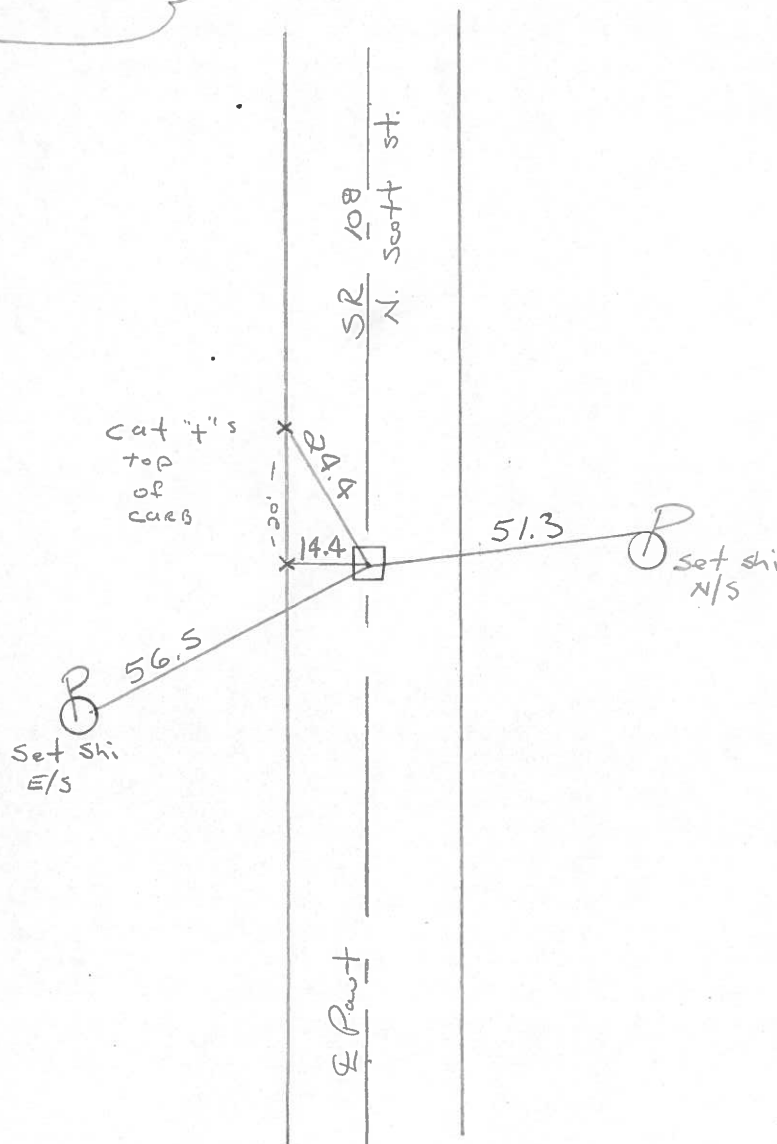

Q.D.O.T. DISTRICT 2 SURVEY OFFICE

Sht. 19 of 19
S.R. 108

County HENRY

Date 8-30-77

Township NAPOLÉON

Weather CLEAR

Section 11

Temp. +85°


T5N, R6E

Personnel BURNSIDE

SMITH

KNAPE

MEAD

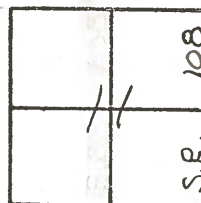


F.D. P.K. NAIL @
SURFACE

P.O.T.

STA. 904 + 75.14

#6

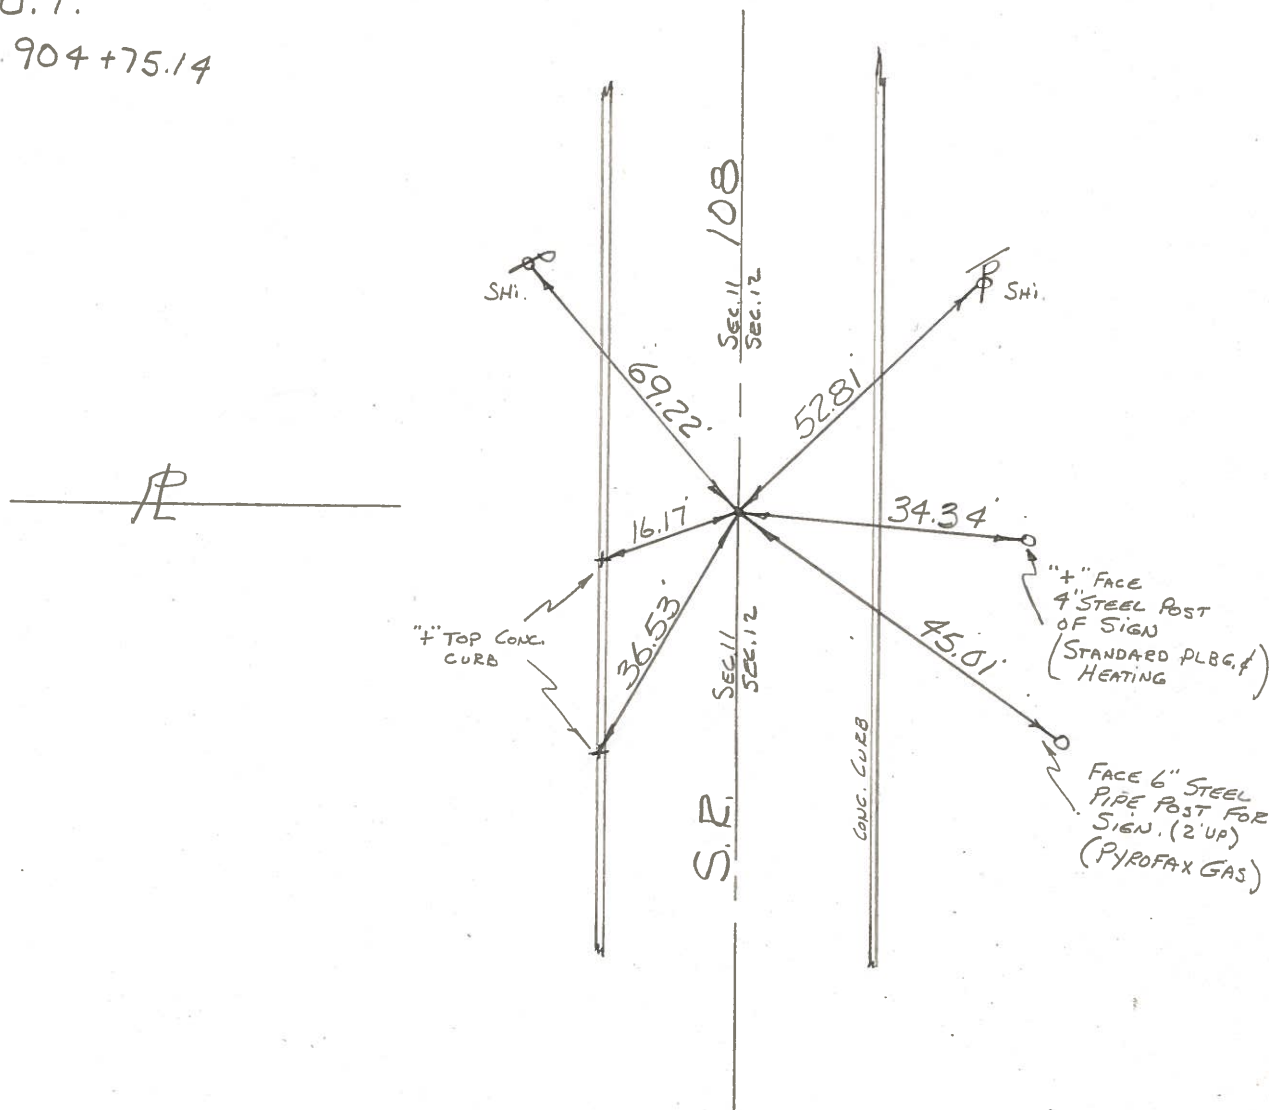

PERSONNEL	TITLE	PERSONNEL	TITLE	COUNTY	DATE	WEATHER	TEMP.
Tomsic				HENRY	Sept. 18, 1974		
Neuser				S. R. 108			
Vanyo				SEC. NAPOLEON TWP.			
Granata							

DESCRIPTION	LEFT	CENTER LINE	RIGHT	JOB NO.
-------------	------	-------------	-------	---------

