

# O.D.O.T. DISTRICT 2 SURVEY OFFICE (USE ONLY)

PERSONNEL

REFERENCE NO. 67

SHEET      OF     

NOTES NIESE

DATE 8/21/23

ROUTE SR 108

H.C. NIESE

WEATHER     

COUNTY HENRY

R.C.     

TEMP.     

TOWNSHIP NAPOLEON

DWG BY BARRIERE

PID 110867

SECTION 12

T 5 N R 6 E

TYPE MONUMENT MONBOX W/ STONE

ON SURFACE - BELOW ON

OFFSET  $\varnothing$  PAVEMENT ON LT : RT


     TO      EDGE PAVEMENT

STATION: 909+06

HORIZ.DATUM: NAD83(2011)/HEN LDP GEOID: 18

GRID: NORTHING: 638047.769 EASTING: 1520832.654


LDP: NORTHING: 494221.959 EASTING: 155257.749

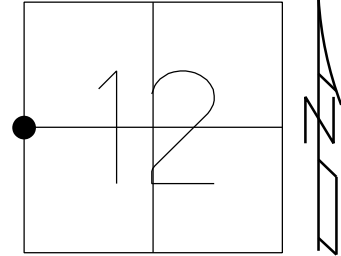

RECORD: P.I.  
STA 909+74.40  
 $\Delta=00^{\circ}06'$  LT  
HEN-108-17.50-1966 PLAN

FD MONBOX  
8/2/01, MRC  
FD MONBOX  
W/ STONE 2.4' DOWN  
REF67  
8/22/23, TDN  
FD MONBOX  
W/ STONE  
12/21/23, TDN

**\*\*NOTE\*\***  
TIES ARE TO CENTER OF  
BOX IN 2001, NOT TO STONE  
**\*\*\*\*\***

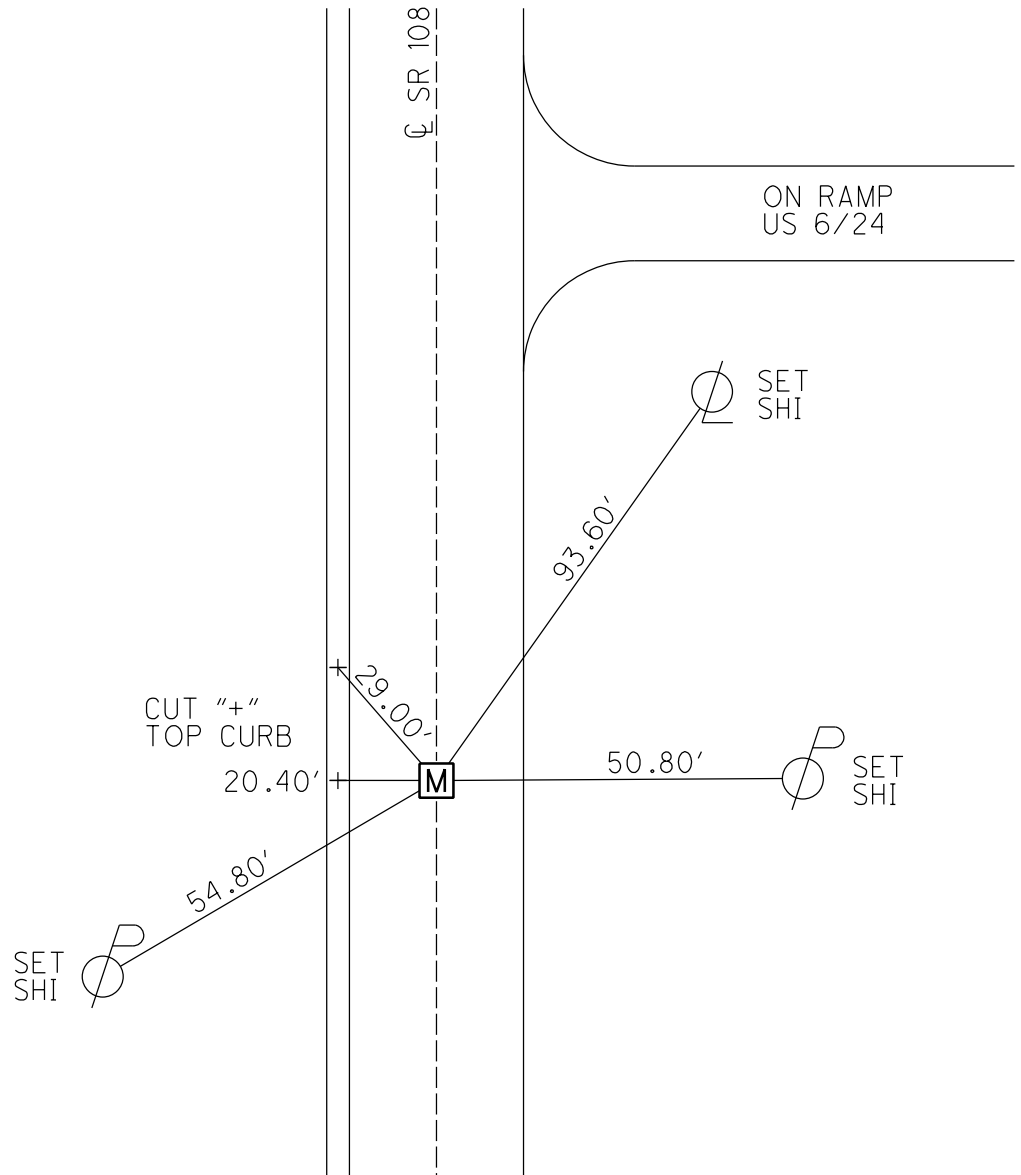

O.D.O.T. DISTRICT 2 SURVEY OFFICE (USE ONLY)

PERSONNEL

REFERENCE NO. 67

SHEET 13 OF 14

NOTES MOSER

DATE 8/2/01

ROUTE SR 108

H.C. CANTERBURY

WEATHER CLEAR

COUNTY HENRY

R.C. MOSER

TEMP. 85°

TOWNSHIP NAPOLEON

DWG BY NIESE PID                     

SECTION 12

T 5 N R 6 E

TYPE MONUMENT MONBOX

ON SURFACE - ~~BELOW~~ ON

OFFSET Q PAVEMENT ON LT : RT

20.1' TO LT ~~EDGE PAVEMENT~~ FACE OF CURB


STATION: 909+06

HORIZ.DATUM:                     


GEOID:                     

GRID: NORTHING:                     

EASTING:                     

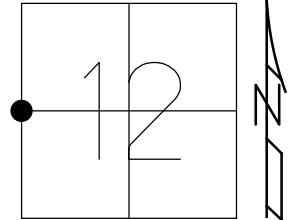

RECORD:  
1966 PLAN  
STA 909+74.40  
FD MONBOX  
8/2/01, MRC

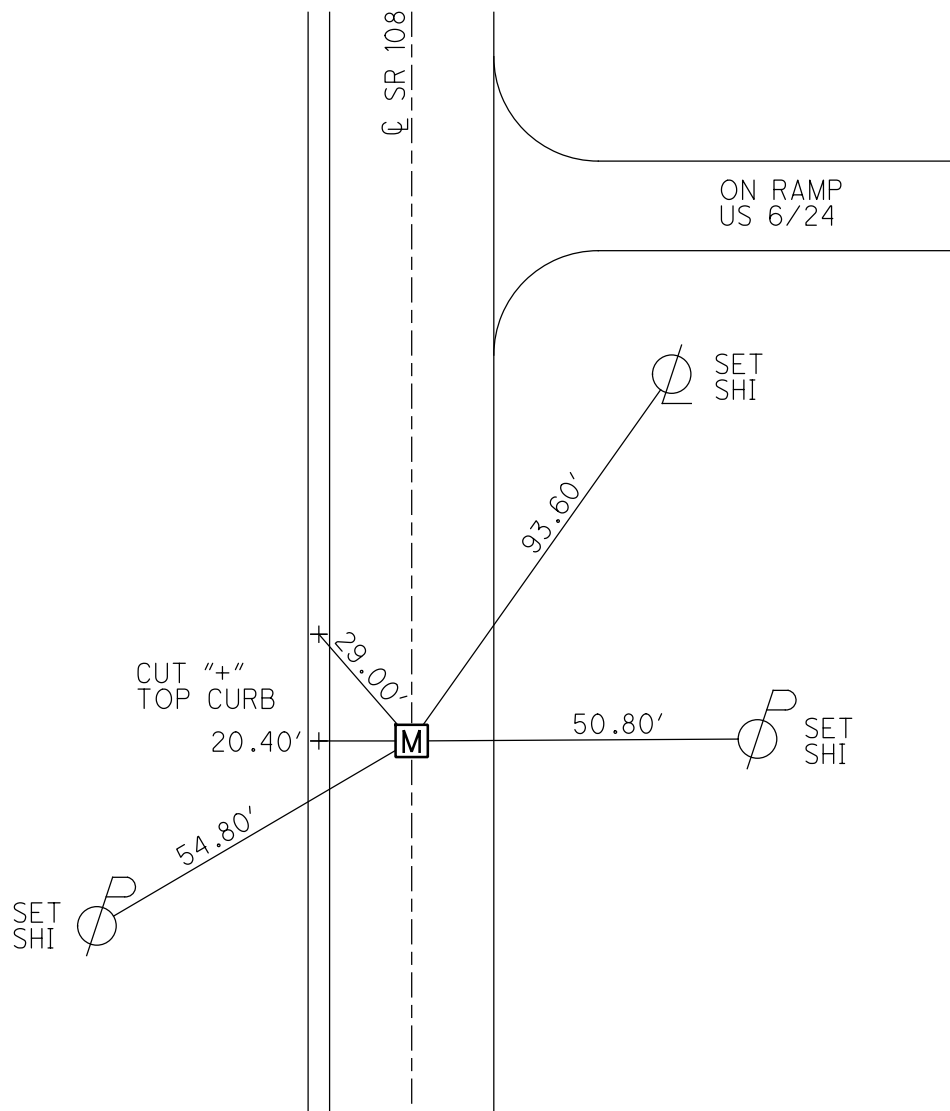

# O.D.O.T. DISTRICT 2 SURVEY OFFICE

PERSONNEL

REFERENCE NO. 67

SHEET 8 OF 21

NOTES MOER

H.C. CANTERBURY

R.C. MOER

DATE 8-2-01

WEATHER CLEAR

TEMP. +85°F

ROUTE 108

COUNTY HENRY

TOWNSHIP NAPOLEON

SECTION 11

T. S N. R 6 E


TYPE MONUMENT Mon Box

ON SURFACE - BELOW ON

LEFT - ℄ PAV'T. - RIGHT ℄

20.1 TO LT EDGE PAVEMENT FACE OF CURB

S.L.M. 909+06

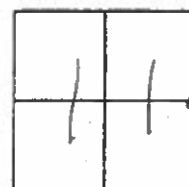

1966 PLAN = 909+74.40

