


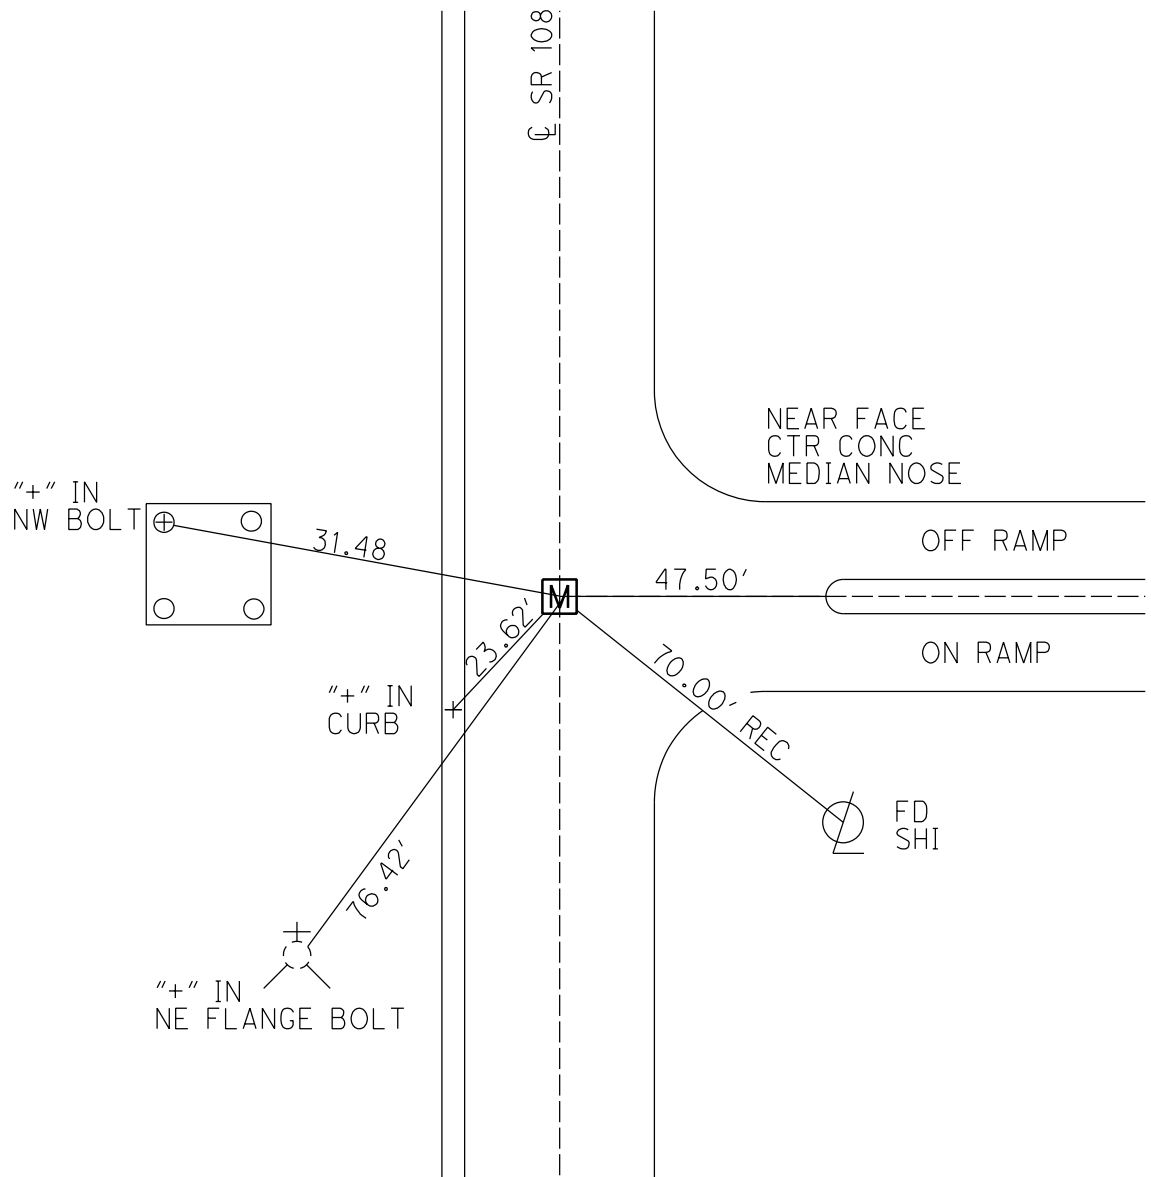

O.D.O.T. DISTRICT 2 SURVEY OFFICE (USE ONLY)

PERSONNEL

REFERENCE NO. 67 A

SHEET 14 OF 14

NOTES MOSER

DATE 8/2/01

ROUTE SR 108

H.C. CANTERBURY

WEATHER OVERCAST

COUNTY HENRY

R.C. MOSER

TEMP. 90°

TOWNSHIP NAPOLEON

SECTION 12

DWG BY NIESE PID

T 5 N R 6 E

TYPE MONUMENT MONBOX

ON SURFACE - ~~BELOW~~ ON


OFFSET Q PAVEMENT ON LT : RT

20.1' TO LT ~~EDGE PAVEMENT~~ FACE OF CURB


STATION: 910+52

HORIZ.DATUM: GEOID:

GRID: NORTHING: EASTING:

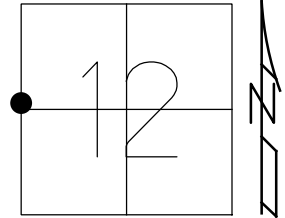

RECORD:
1965 PLAN
STA 911+21.05
FD MONBOX
8/2/01, MRC

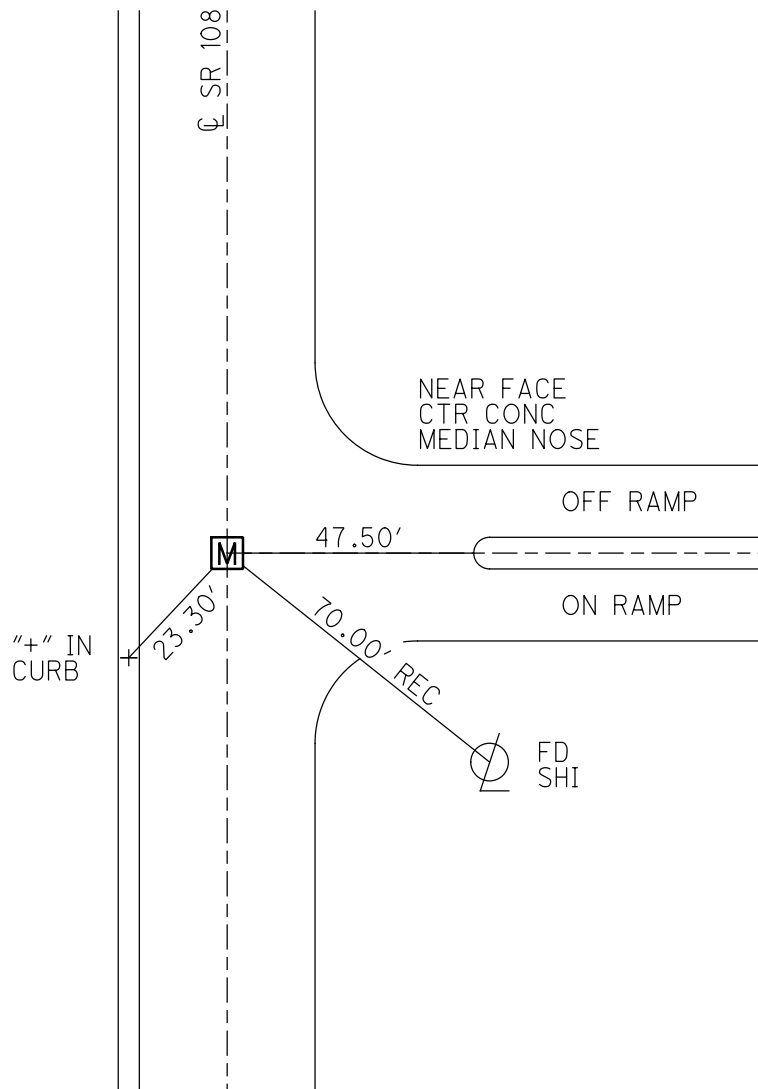

O.D.O.T. DISTRICT 2 SURVEY OFFICE

PERSONNEL

REFERENCE NO. 67-A

SHEET 9 OF 21

NOTES MOSER

H.C. CANTERBURY

R.C. MOSER

DATE 8-2-01

WEATHER OVERCAST

TEMP. +90°F

ROUTE 108

COUNTY HENRY

TOWNSHIP NAPOLEON

SECTION 11

T 5 N R 6 E


TYPE MONUMENT Mon. Box

ON SURFACE - ~~BELOW~~ ON

~~LEFT~~ - Q PAV'T. - ~~RIGHT~~ Q BOTH


20.1 TO LT. EDGE PAVEMENT FACE CURB

S.L.M. 910+52

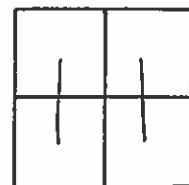

R65 PLAN = 911+21.05

DID NOT OPEN 410

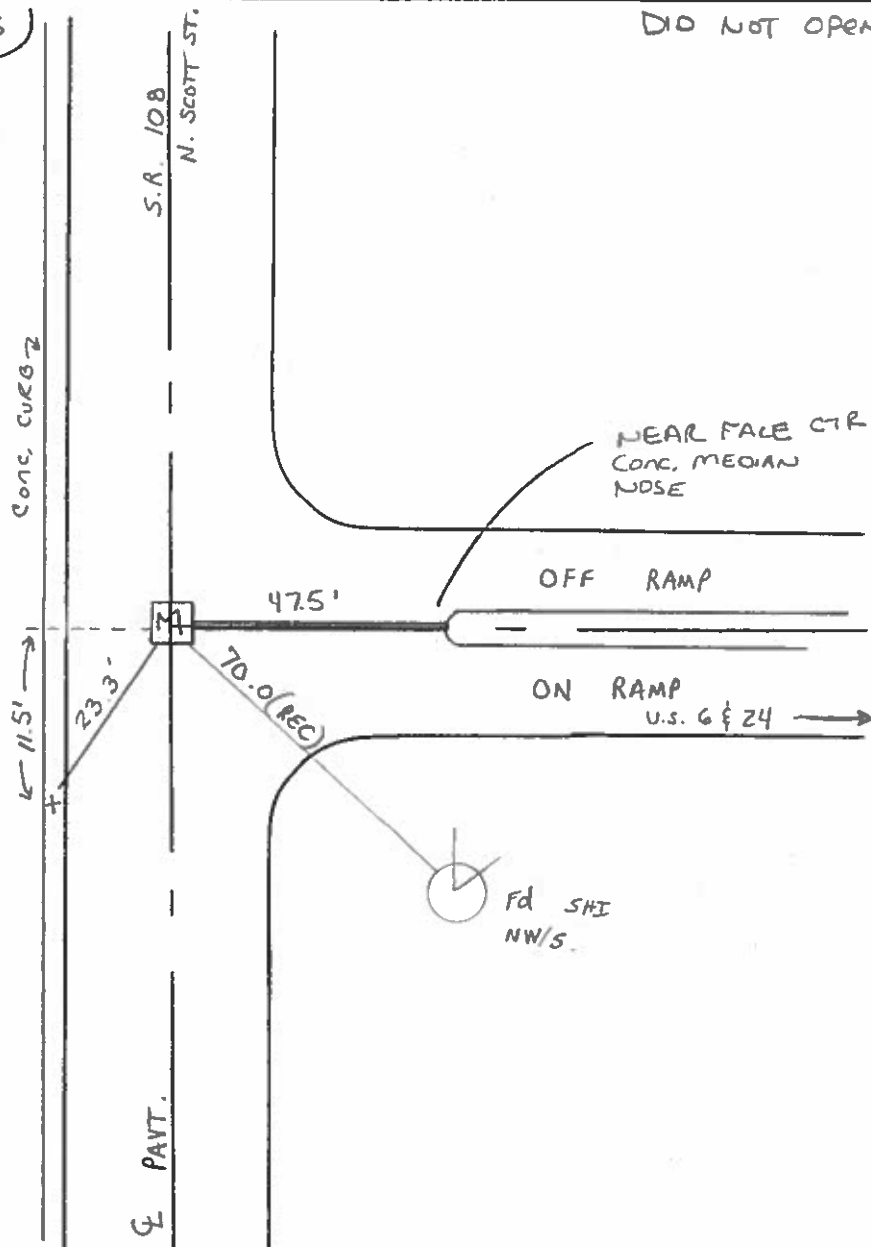

O.D.O.T. DISTRICT 2 SURVEY OFFICE

PERSONNEL

REFERENCE NO. _____

SHEET 21 OF 33

NOTES HOFFMAN

H.C. BARNATSEL

R.C. LOEHRLKE

REED

DATE 4-18-88

WEATHER P. CLEAR

TEMP. 43°

ROUTE SR 108

COUNTY HENRY

TOWNSHIP NAPOLEON

SECTION 11

T5 NR 6 E


TYPE MONUMENT Monument Box

ON SURFACE BELOW YES

LEFT- & PAV'T. - RIGHT YES

14.2 TO L+ EDGE PAVEMENT

S.L.M. 910 +52

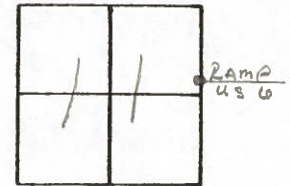

1965 PLAN = 911 + 21.05

67-A

DID NOT OPEN LID

