

O.D.O.T. DISTRICT 2 SURVEY OFFICE (USE ONLY)

PERSONNEL

REFERENCE NO. 67B

SHEET OF

NOTES ASTON
H.C. NIESE
R.C. ASTON

DATE 8/21/23
WEATHER CLEAR
TEMP. 90°

ROUTE SR 108
COUNTY HENRY
TOWNSHIP NAPOLEON
SECTION 11

DWG BY BARRIERE PID 110867

T 5 N R 6 E

TYPE MONUMENT MONBOX W/ 1.5" IPIN

ON SURFACE - BELOW ON

OFFSET $\varnothing$ PAVEMENT ON LT : RT


 TO EDGE PAVEMENT

STATION: 910+52

HORZ.DATUM: NAD83(2011)/HEN LDP GEOID: 18


GRID: NORTHING: 638194.324 EASTING: 1520835.635

LDP: NORTHING: 494368.555 EASTING: 155258.042

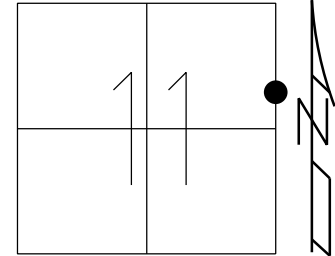

RECORD:
1965 PLAN= 920+00

FD MON.BOX
SHOT IPIN
REFB67
8/2/01, KPM
FD CMON SET BY
BOCKRATH & ASSOC.
"ODOT & PS 8306
C/L
BOCKRATH & ASSOC."
SET ON 2/7/24
NEWREF67B
2/9/24, TDN

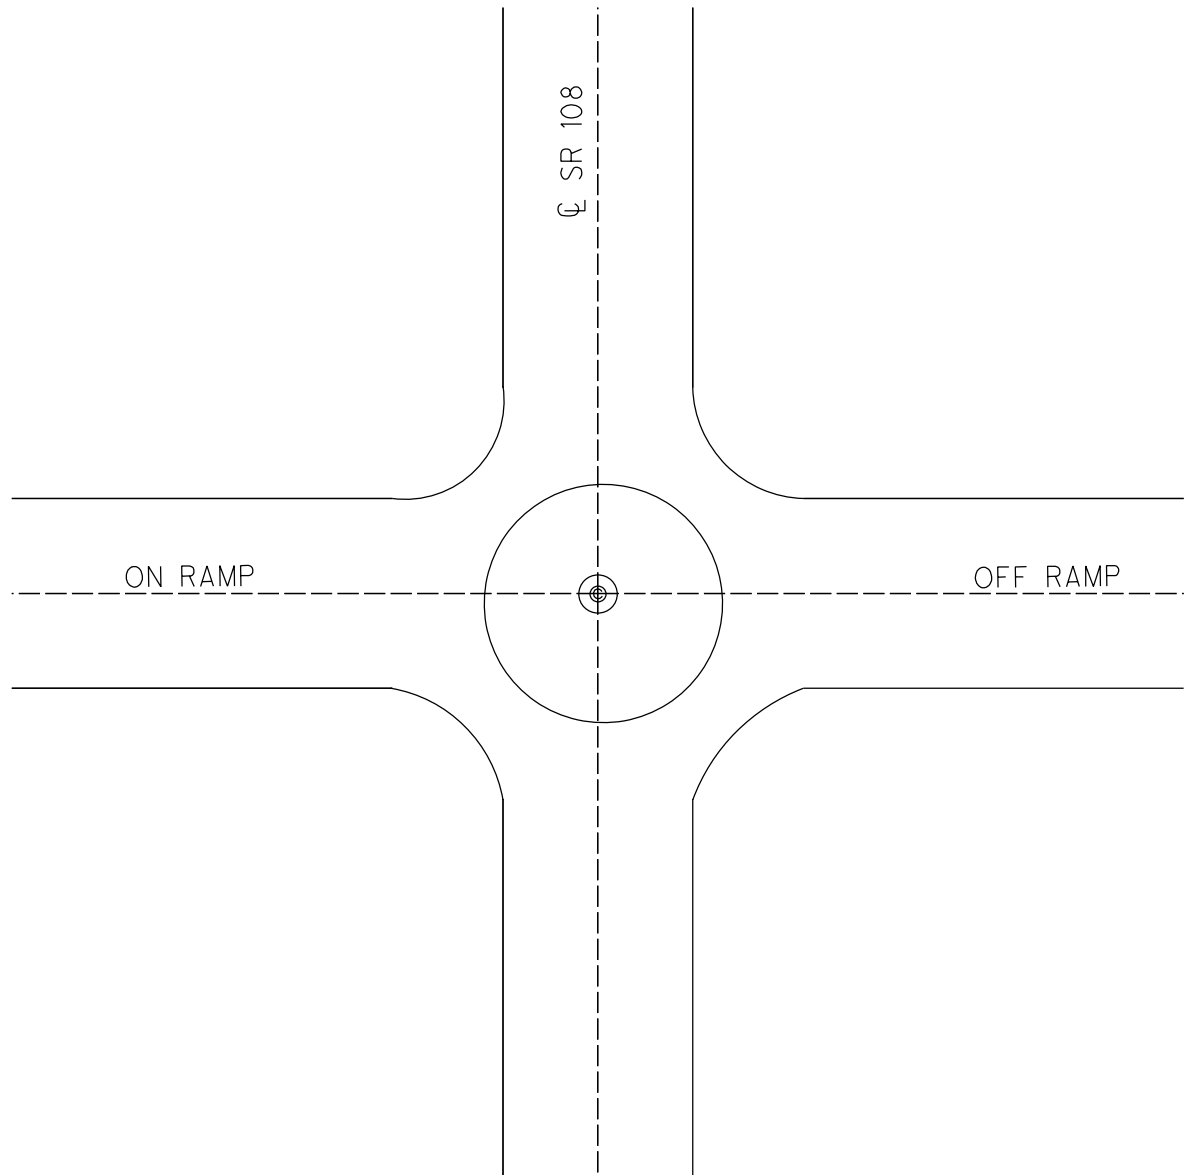

O.D.O.T. DISTRICT 2 SURVEY OFFICE (USE ONLY)

PERSONNEL

REFERENCE NO. 67 B

SHEET 1 OF 21

NOTES HUSS

DATE 4/15/09

ROUTE SR 108

H.C. CORDES

WEATHER CLDY-RAIN

COUNTY HENRY

R.C. CORY

TEMP. 45°

TOWNSHIP NAPOLEON

SECTION 11

T 5 N R 6 E

TYPE MONUMENT MON.BOX



ON SURFACE - ~~BELOW~~ ON

LEFT - Q PAV'T - RIGHT ON

- TO - EDGE PAVEMENT

S.L.M. 920+00.15

Grid: Northing: 639073.189 Easting: 1520854.181

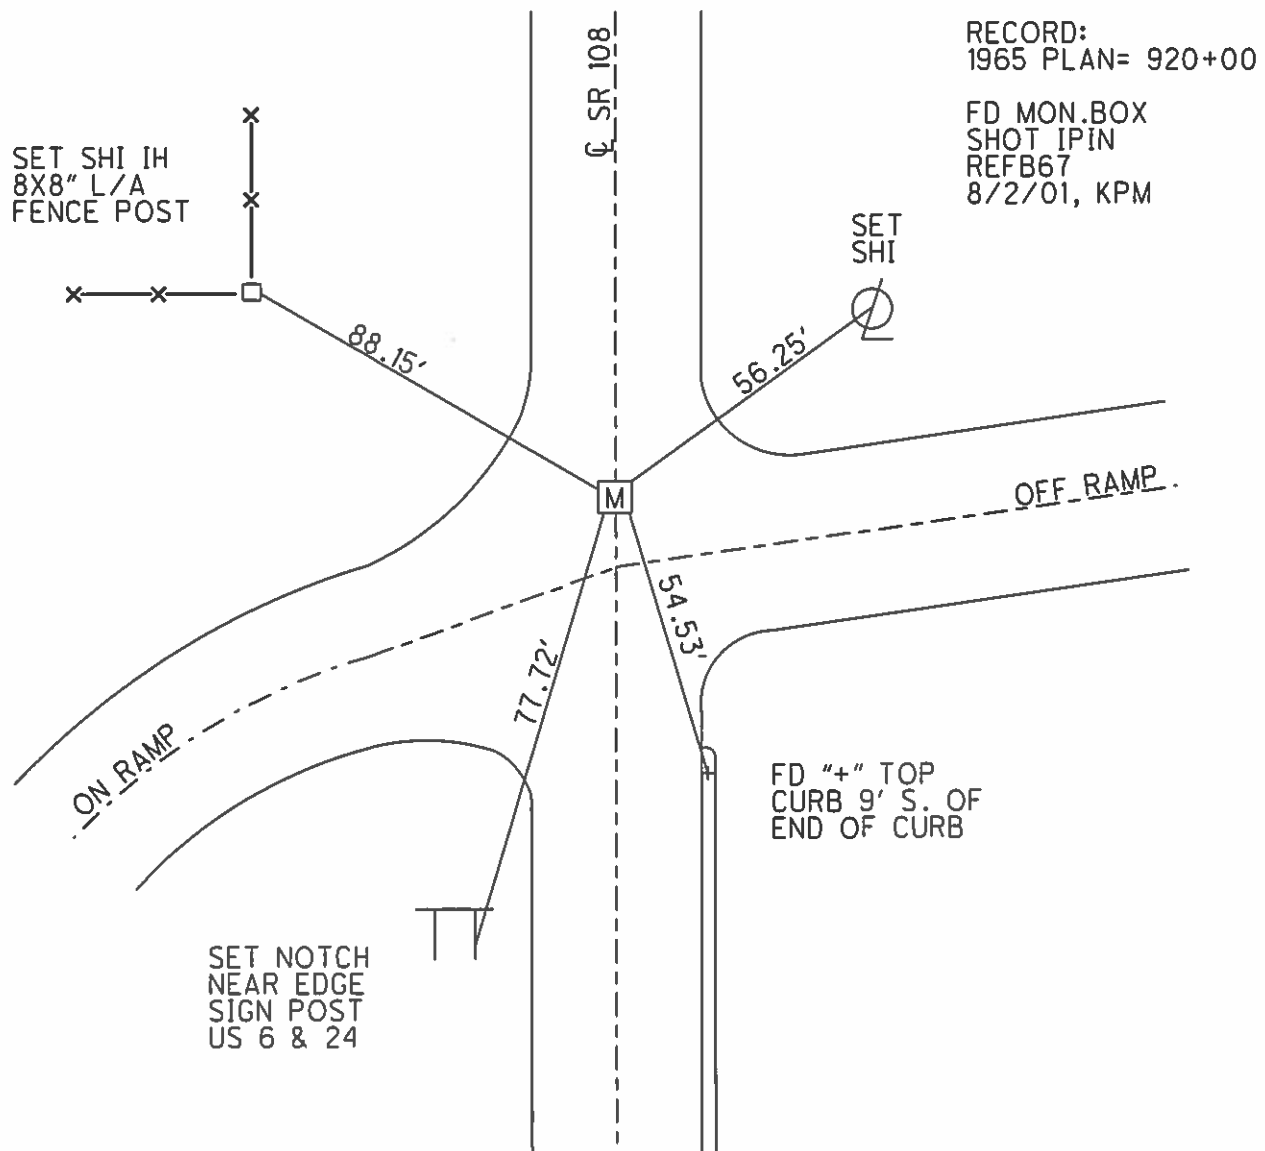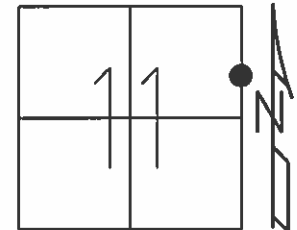

O.D.O.T. DISTRICT 2 SURVEY OFFICE

PERSONNEL

REFERENCE NO. 67-B

SHEET 10 OF 21

NOTES MOSE

H.C. CANTERBURY

DATE 8-2-01

ROUTE 108

R.C. MOSE

WEATHER OVERCAST

COUNTY HENRY

TEMP. +90°F

TOWNSHIP NAPOLEON

SECTION 11

T 5 N R 6 E


TYPE MONUMENT Mon. Box

ON SURFACE - BELOW ON

~~LEFT~~ - & PAV'T. - ~~RIGHT~~ &


- TO - EDGE PAVEMENT

S.L.M. 919+33

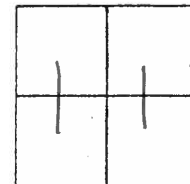

RECORD:
1965 PLAN = 920+00

DID NOT OPEN LID

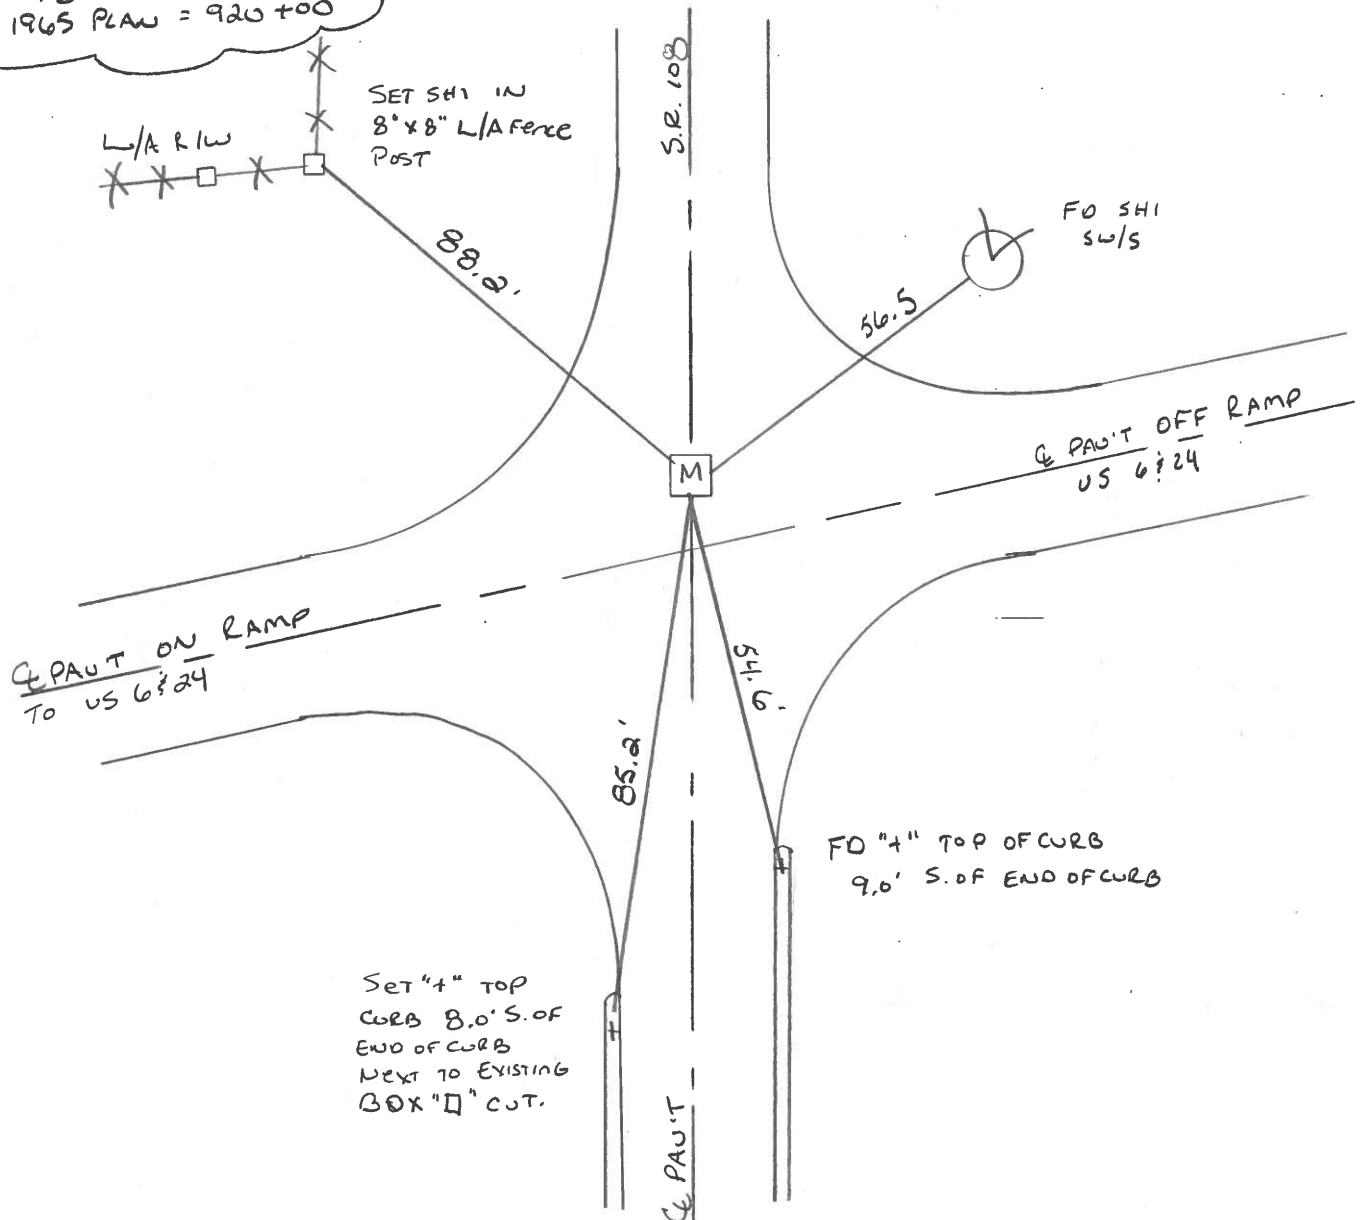

O.D.O.T. DISTRICT 2 SURVEY OFFICE

PERSONNEL

REFERENCE NO. _____

SHEET 22 OF 33

NOTES HOFFMAN

H.C. BARNHISEL

R.C. LOSHKKE

REED

DATE 4-18-88

WEATHER P. CLEAR

TEMP. 43°

ROUTE 52 108

COUNTY HENRY

TOWNSHIP NAPOLEON

SECTION 11

T. 5 N. R. 6 E.


TYPE MONUMENT Monument Box

ON SURFACE - BELOW YES

LEFT- & PAV'T. - RIGHT YES

TO EDGE PAVEMENT

S.L.M. 919+33

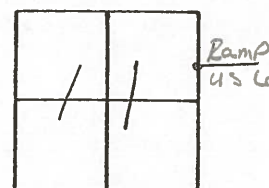

1965 PLAN = 920+00

DID NOT OPEN A.D.

(67-B)

