

O.D.O.T. DISTRICT 2 SURVEY OFFICE (USE ONLY)

PERSONNEL

REFERENCE NO. 9

SHEET 10 OF 25

NOTES BARRIERE
H.C. MILLER
R.C. BARRIERE

DATE 10/4/24
WEATHER CLEAR
TEMP. 57°

ROUTE SR 109
COUNTY HENRY
TOWNSHIP MARION
SECTION 10

DWG BY BARRIERE PID 99587

T 3 N R 7 E

TYPE MONUMENT MAG NAIL/WASHER

ON SURFACE - BELOW ON

OFFSET $\varnothing$ PAVEMENT LT : RT

 TO EDGE PAVEMENT

STATION: 211 + 90

HORIZ.DATUM: OHIO LDP (HENRY)


GEOID: 18

GRID: NORTHING: 571475.342


EASTING: 1545978.503

LDP: NORTHING: 428116.885

EASTING: 181622.731

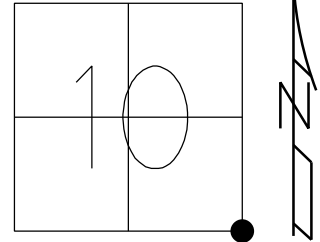

RECORD:
SET PK/WASHER
9/23/98, MRC
FD P.K./WASHER
5/19/08, MC
FD SM.R.R.SPIKE
REF9
6/17/16, JFO
FD SM.R.R.SPIKE
REF9
11/29/21-DSA
SET MAG/WASH
REF9
10/4/24-JAM

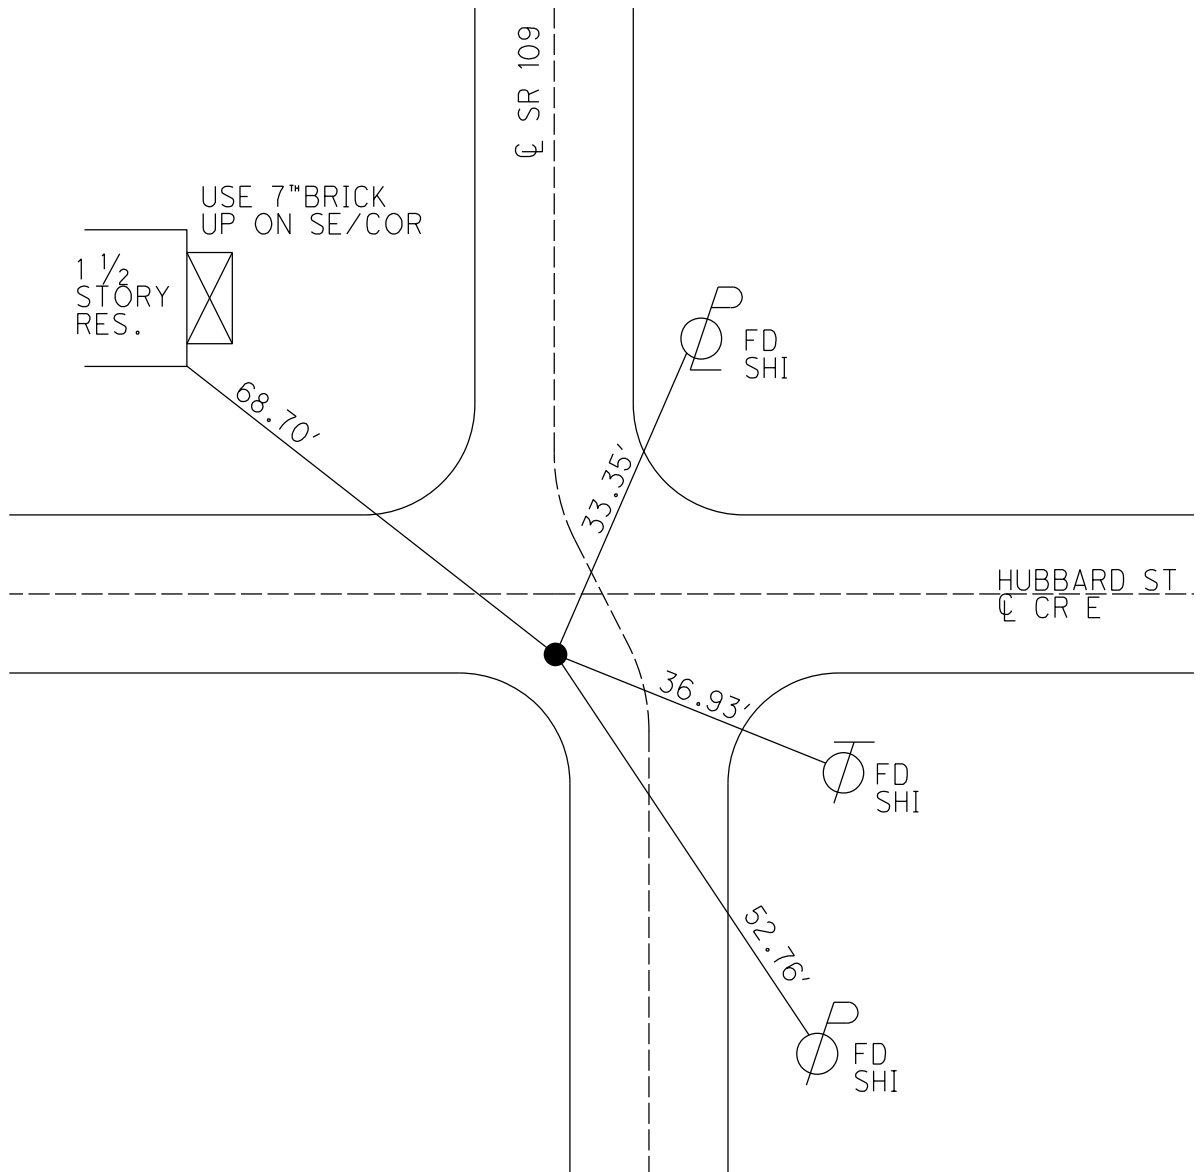

O.D.O.T. DISTRICT 2 SURVEY OFFICE (USE ONLY)

PERSONNEL

REFERENCE NO. 9

SHEET 10 OF 26

NOTES MOSER

DATE 6/30/08

ROUTE SR 109

H.C. CANTERBURY

WEATHER OVERCAST

COUNTY HENRY

R.C. MOSER

TEMP. 65°

TOWNSHIP MARION

SECTION 10

T 3 N R 7 E

TYPE MONUMENT SM.R.R.SPIKE


ON SURFACE - ~~BELOW~~ ON

LEFT - Q PAV'T - ~~RIGHT~~ 5.0', 2.2' S OF Q W


- TO - EDGE PAVEMENT

S.L.M. 211+90

Grid: Northing: 571475.342 Easting: 1545978.503

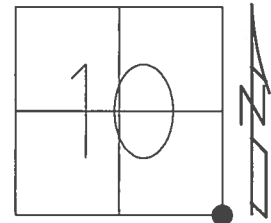

USE 7" BRICK
UP ON SE/COR
1 1/2
STORY
RES.

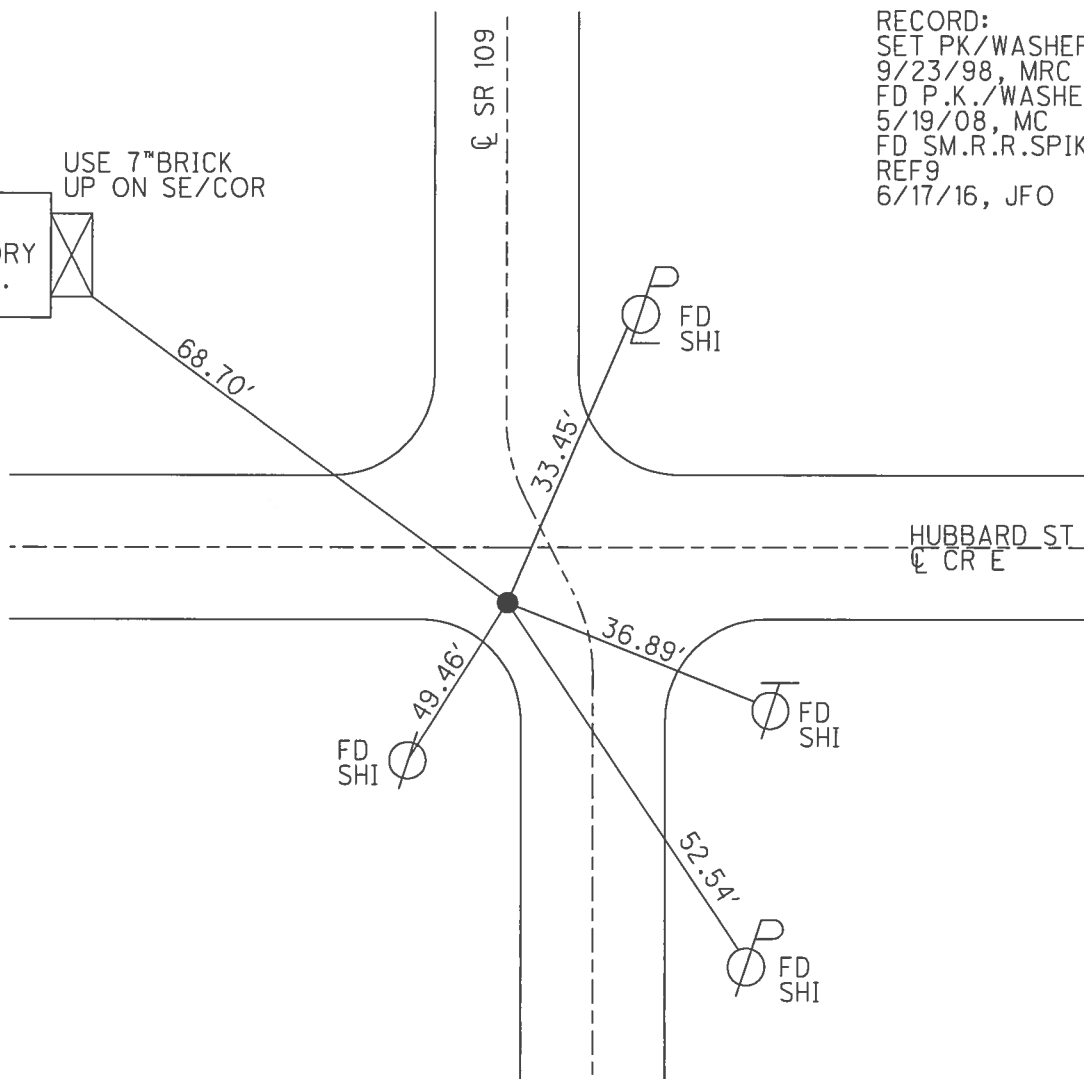

RECORD:
SET PK/WASHER
9/23/98, MRC
FD P.K./WASHER
5/19/08, MC
FD SM.R.R.SPIKE
REF9
6/17/16, JFO

O.D.O.T. DISTRICT 2 SURVEY OFFICE

PERSONNEL

REFERENCE NO. 9

SHEET 9 OF 21

NOTES Canterbury

H.C. Canterbury

R.C. Rousos

DATE 5-7-98

WEATHER overcast

TEMP. 6.5°

ROUTE 109

COUNTY HENRY

TOWNSHIP MARION

SECTION 10

T3 N R 7 E


TYPE MONUMENT Small SPIKE

ON SURFACE - BELOW 1" Below

LEFT- & PAN'T. - RIGHT 5.2'

TO EDGE PAVEMENT 2.2' S of & Rmt. West

S.L.M. 6 + 484.46 (21190)

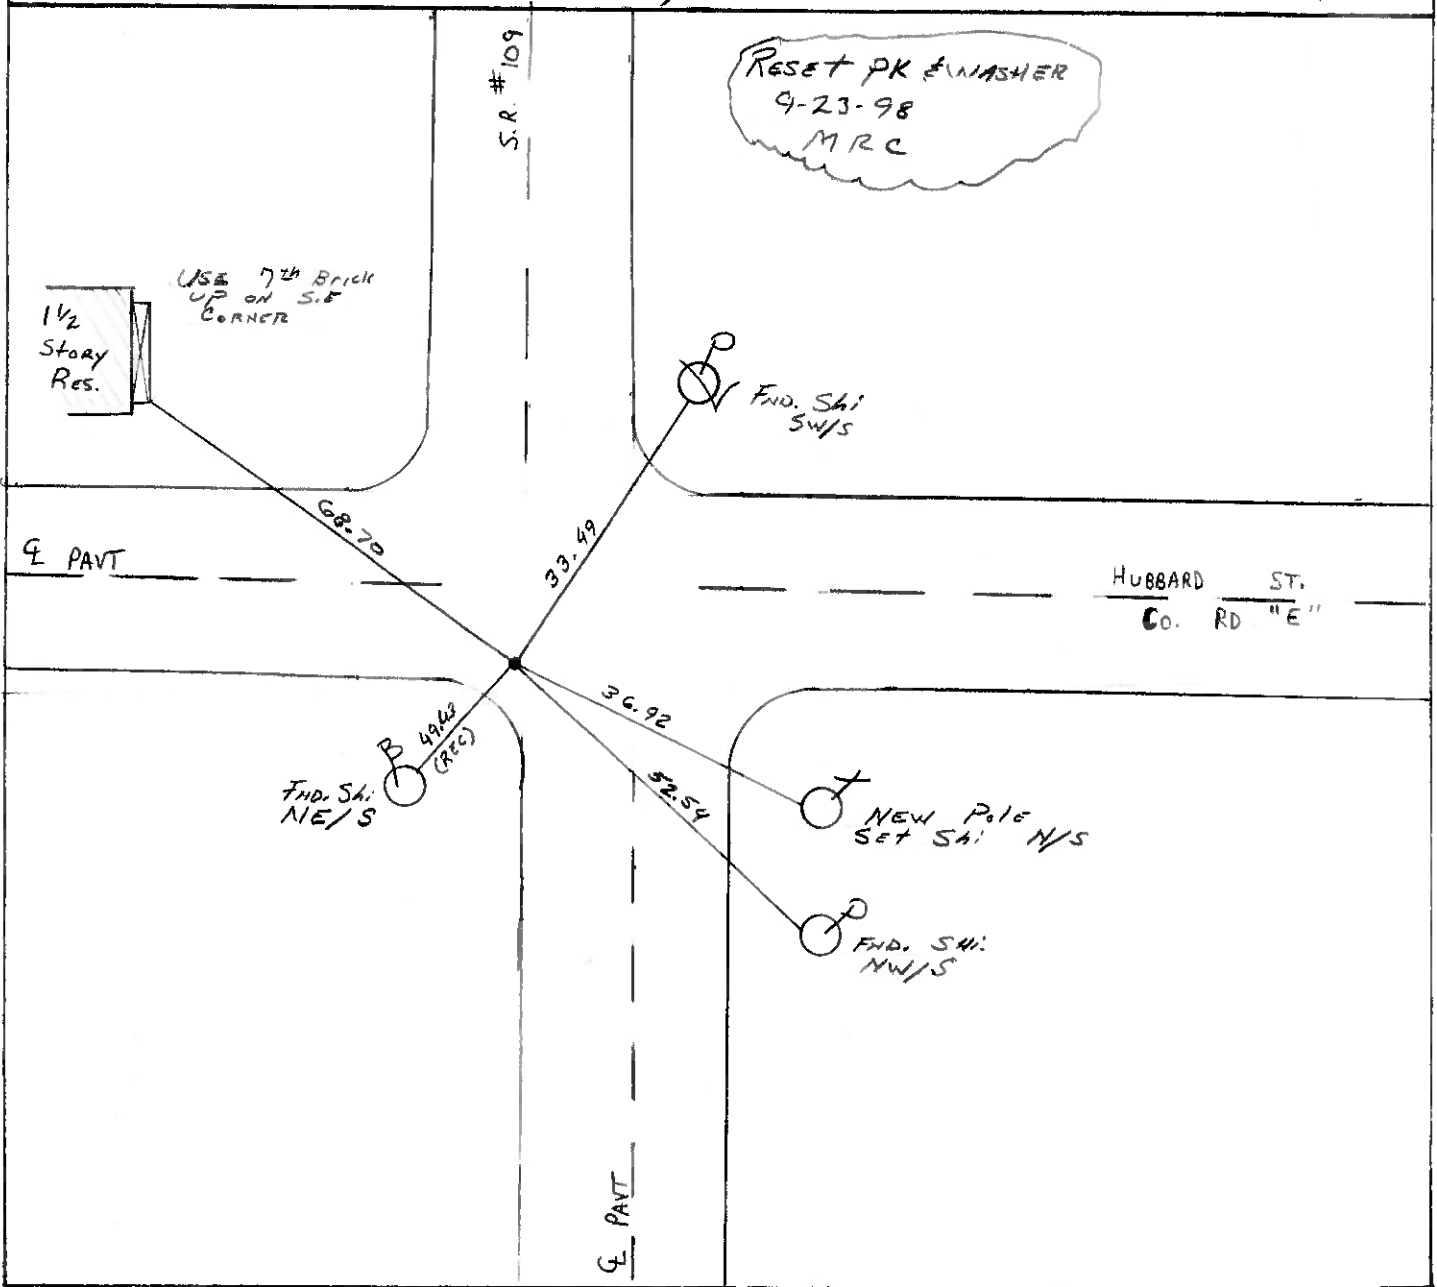

O.D.O.T. DISTRICT 2 SURVEY OFFICE

PERSONNEL

REFERENCE NO. 9

SHEET 9 OF

NOTES BARNHISEL

H.C. " "

R.C. HOFFMAN

DATE 3-29-89

WEATHER cloudy - windy

TEMP. +44°

ROUTE 109

COUNTY HENRY

TOWNSHIP MARION

SECTION 10

T 3 N R 7 E



TYPE MONUMENT P.K. NAIL

ON SURFACE - BELOW YES

LEFT- & PAV'T. - RIGHT 5.2

TO EDGE PAVEMENT 2.2' S OF & PAV'T

S.L.M. 211+90 WEST

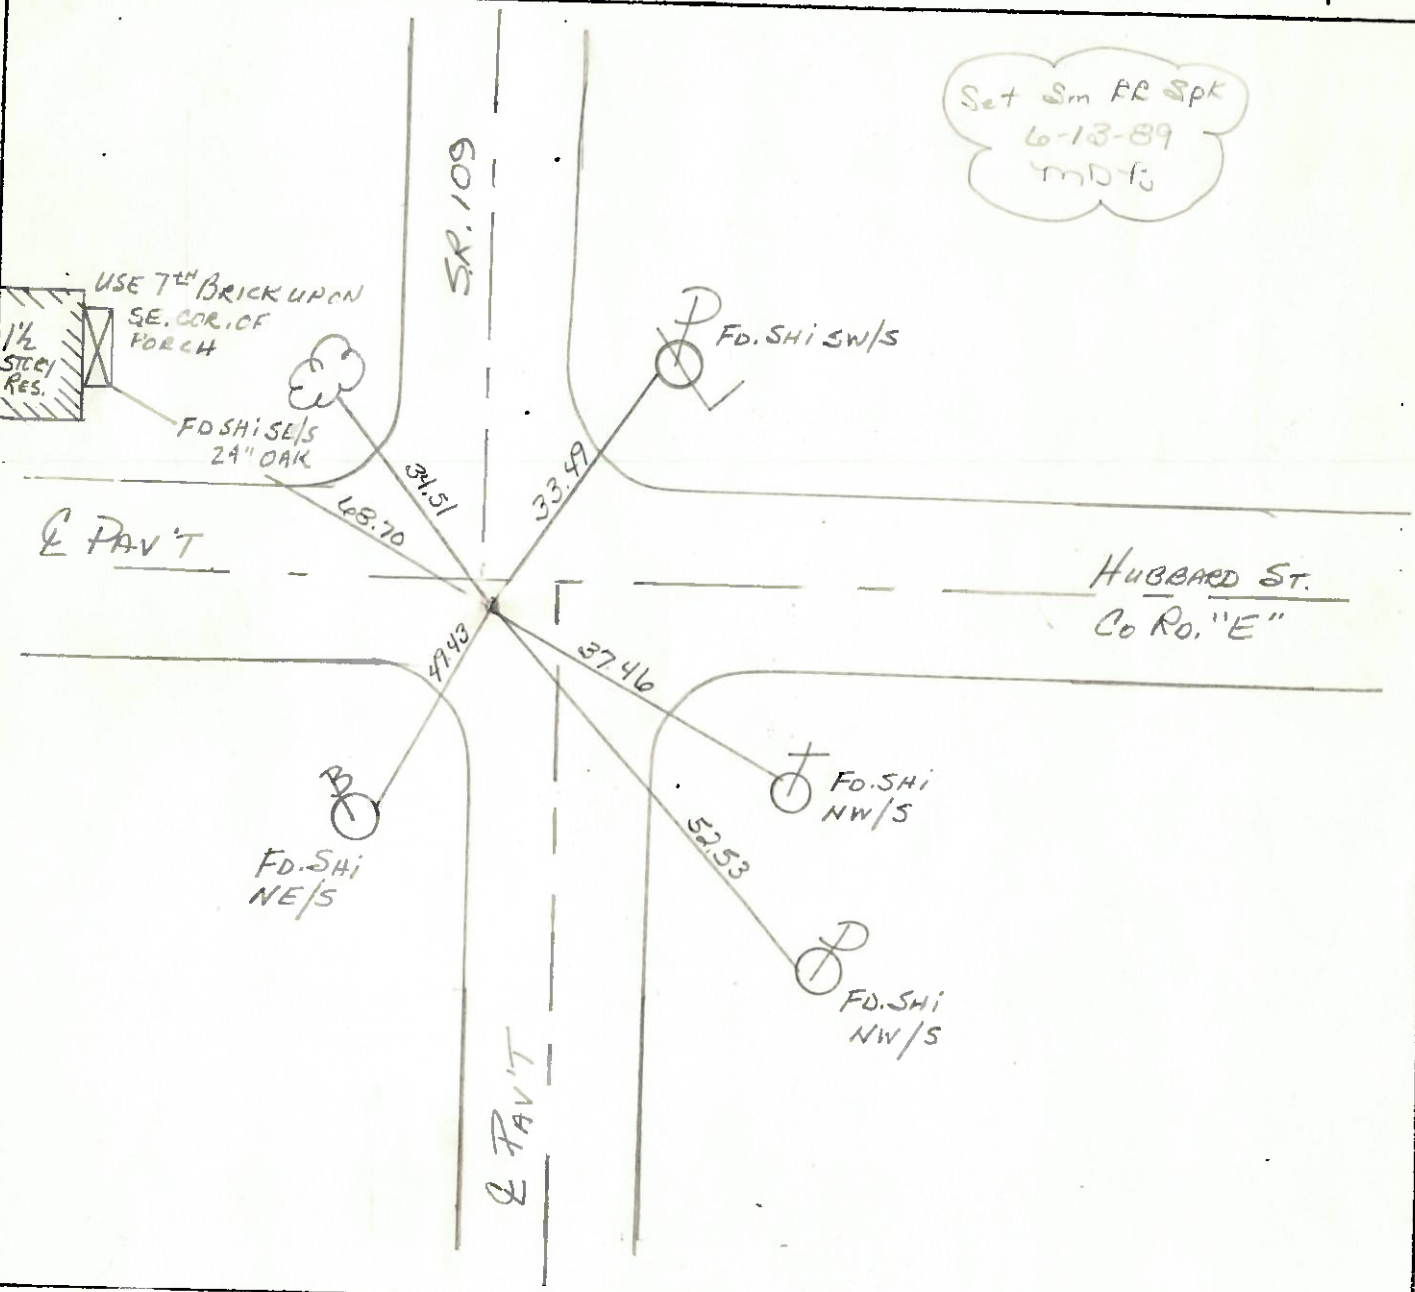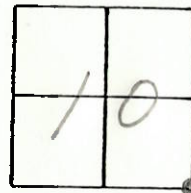

ODOT DISTRICT 2 SURVEY OFFICE

SHEET _____ OF _____

County HENRY S.R. 109

Date APRIL 19, 83

Township MARION

Weather CLEAR

Section 10 IN HAMLER

Temp. +30°


T3N, R7E

Personnel HOFFMAN

#9

LOEHKE

BARNHISEL

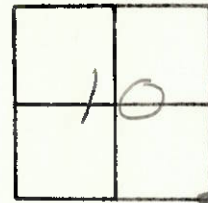


Fd SMALL R.R. SPK. @ SURFACE
6.5' Lt. of & PAUT S.R. 109 SOUTH
2.2' SOUTH of & PAUT HUBBARD ST. EAST.

SLIN 211+49


SET P.K./WASHER

9-19-83

SWH

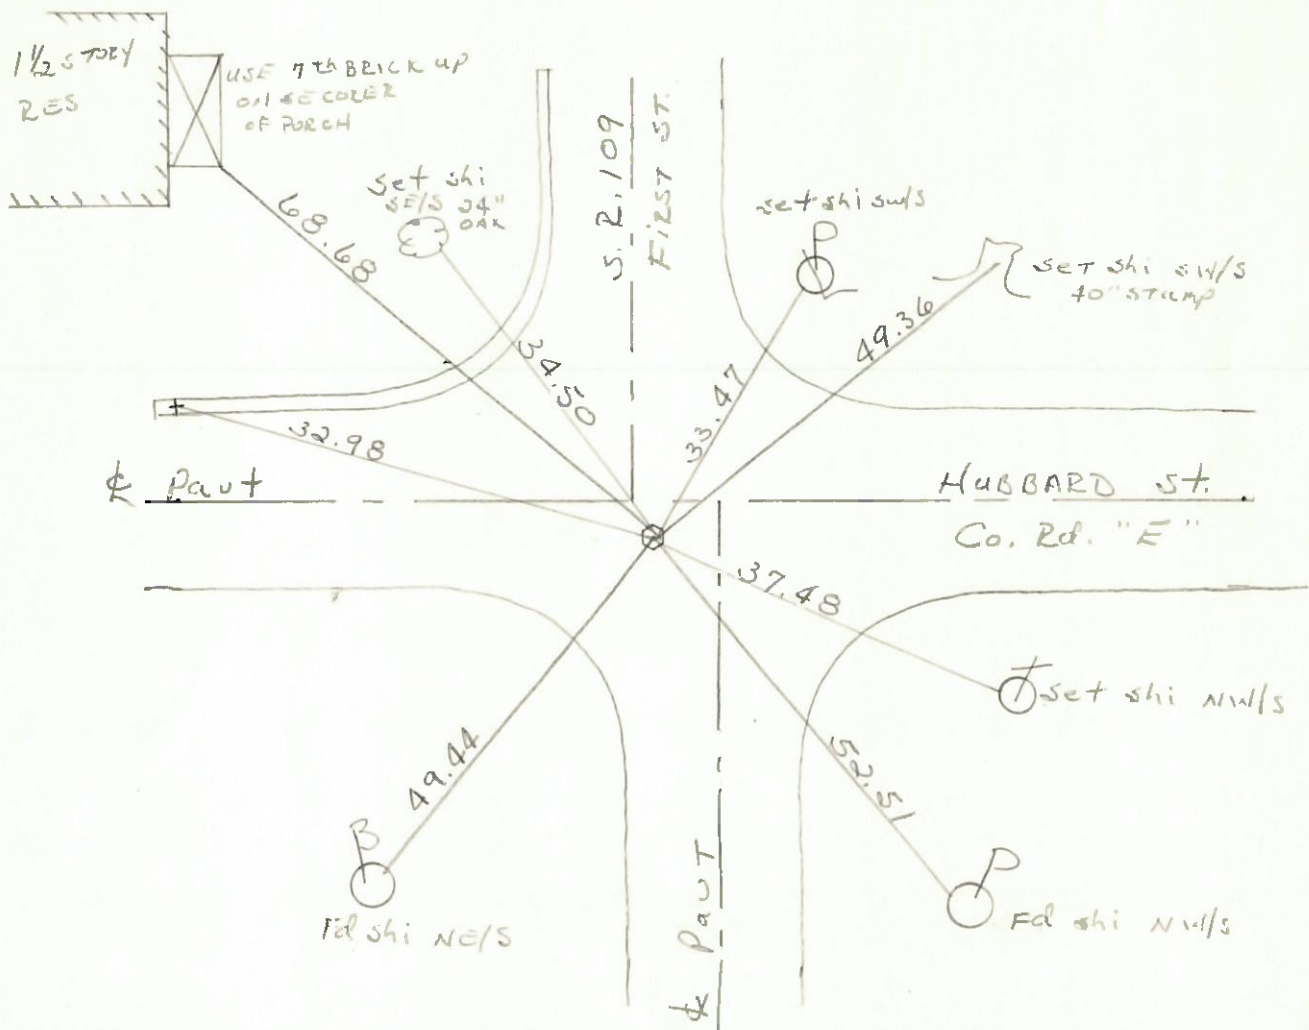

PERSONNEL	TITLE	PERSONNEL	TITLE	COUNTY	DATE
Stone				Henry	13 May 79
Michaelak				S. R. # 109	WEATHER Cloudy
Dunn				SEC. Marion Twp.	TEMP. 55°
Curtis					
DESCRIPTION	Refer to Control Points			JOB NO.	02999(6)
	LEFT	CENTER LINE	RIGHT		

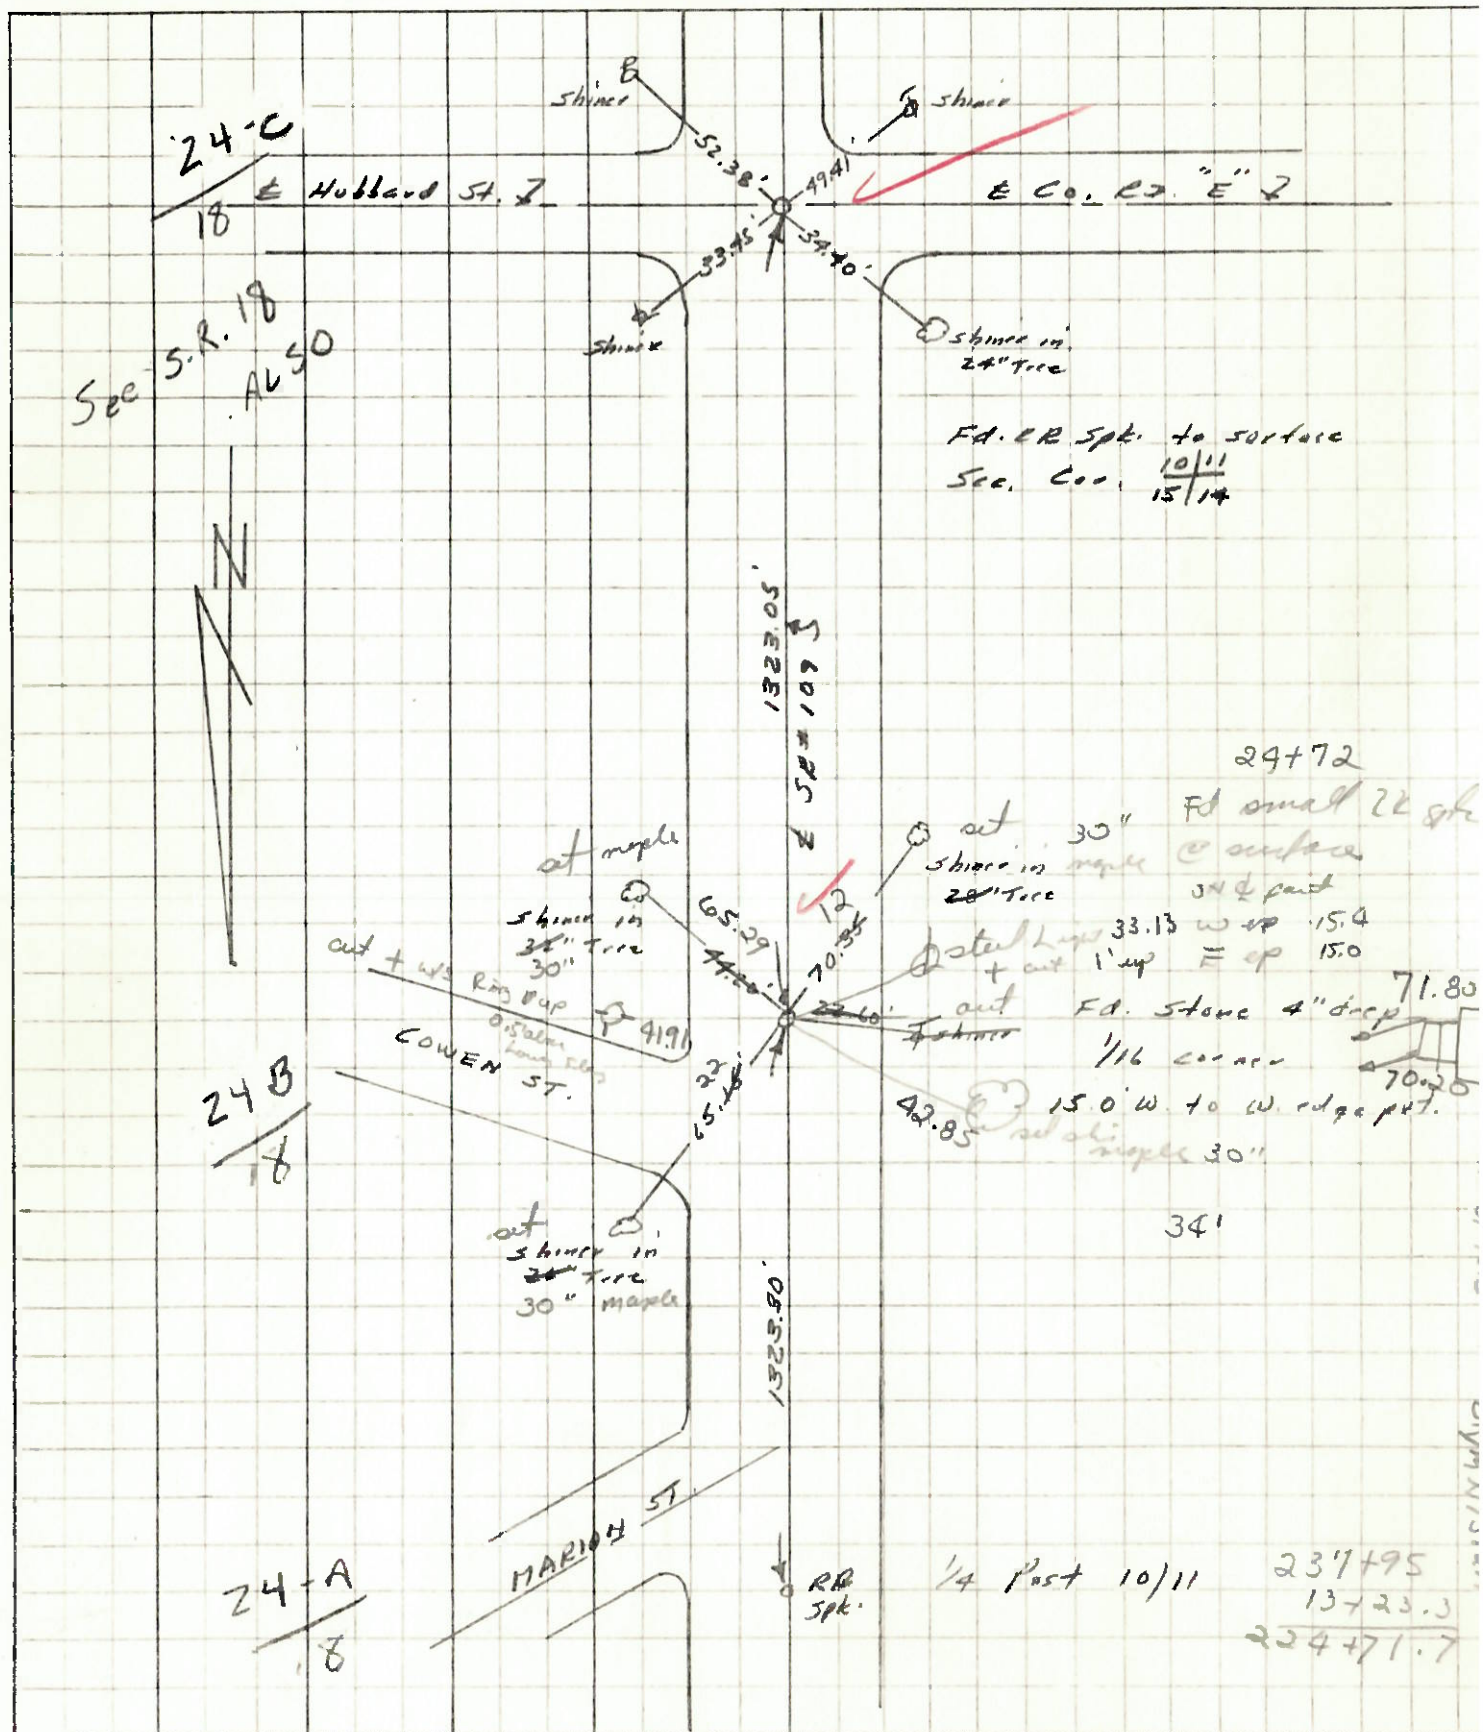

PERSONNEL TITLE PERSONNEL TITLE

BURNSIDE

SMITH

KIOWSKI

COUNTY HENRY

DATE 8-7-72

S. R. 109

WEATHER RAIN

SEC. HAMLER

TEMP. +70°


DESCRIPTION

LEFT

CENTER LINE

RIGHT

JOB NO. 029280

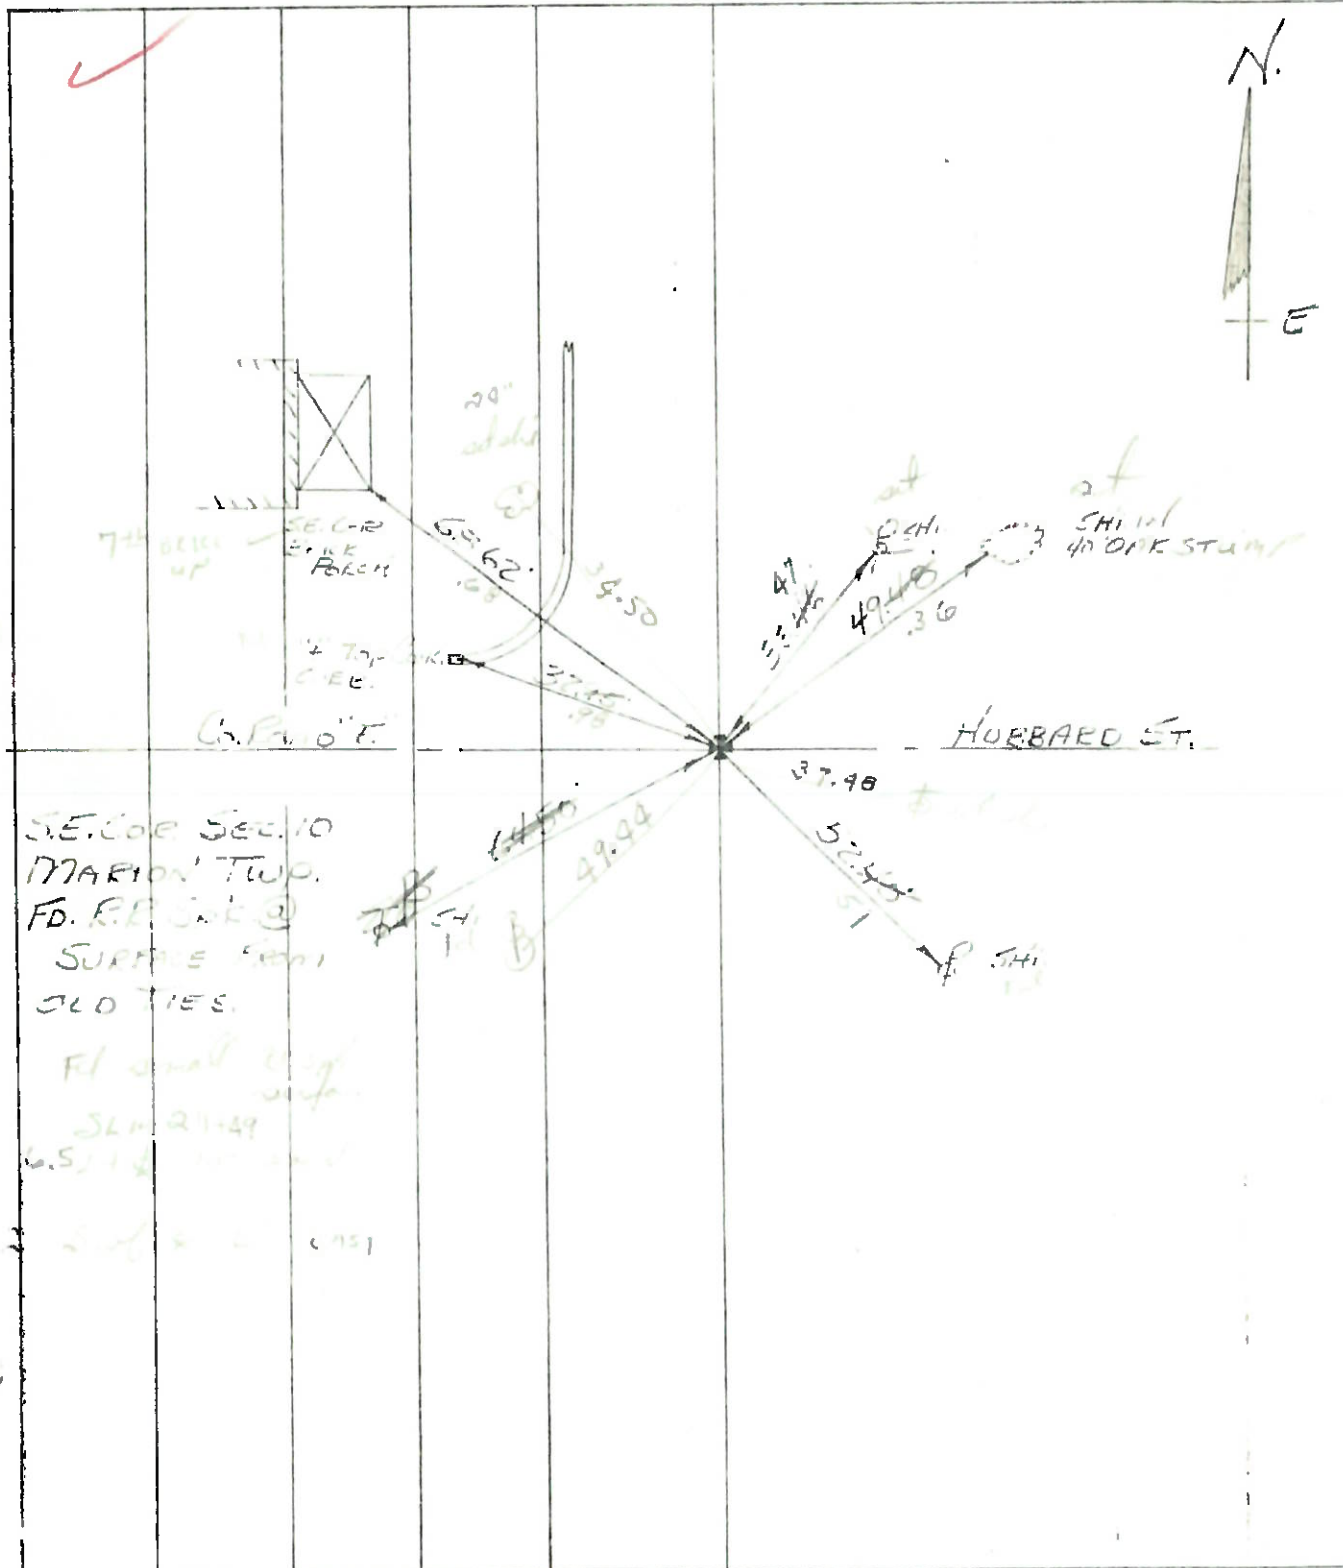

PERSONNEL TITLE PERSONNEL TITLE

COUNTY Henry DATE 2-5-58
10-25-60S. R. #107 WEATHER

SEC. TEMP.

DESCRIPTION Hambler JOB NO.

LEFT

CENTER LINE

RIGHT

9 #58 Iron Pipe Conc. Part 32.06 32.28' S.W. "X" Retaining Wall
NE Cor Sec. Fd. Iron Rod 4" 34.95' S.S.W. "X" "
#15 Marion Twp. below Surface 25.70 25.48' N.E. "X" Top curb ✓
W. Chape 25.82 25.88' N.W. "X" "
73.35 73.10' N.W. Cor. Res.

10 #59 3/4" Iron Pipe in Part 63.67 64.00' S.W. N.E. Cor. House Fdn.
E 1/4 Sec 10 (Ruffer) 56.45 28.00' W. Spk. P. Pole ✓
Marion Twp. 40.60 56.60' N.W. S.E. Cor. House Fdn.
S.S.W. Top ctr. Fire Hyd.

11 #60 3/4" Iron Pipe 15.21 15.25' S.W. S.E. Cor. S. Bridge Rd.
NE Cor Sec (Ruffer) 23.45 23.37' N.W. N.E. Cor. N. " "
#10 Marion Twp. 82.30 82.05' N.E. S.W. Cor. House Fdn.
51.20 N.E. Shi. 20" Maple ✓
43.09 S.E. Shi. T. Pole
50.10 N.W. Shi. P. Pole