

O.D.O.T. DISTRICT 2 SURVEY OFFICE (USE ONLY)

PERSONNEL	REFERENCE NO.	<u>9 A</u>	SHEET	<u>11</u>	OF	<u>25</u>
NOTES	<u>CANTERBURY</u>	DATE	<u>05-07-1998</u>	ROUTE	<u>SR 109</u>	
H.C.	<u>CANTERBURY</u>	WEATHER	<u>OVERCAST</u>	COUNTY	<u>HENRY</u>	
R.C.	<u>ROUSOS</u>	TEMP.	<u>65°</u>	TOWNSHIP	<u>MARION</u>	
				SECTION	<u>10</u>	
				T <u>3</u> N	R <u>7</u> E	

TYPE MONUMENT PK



ON SURFACE - BELOW ON

~~LEFT - C~~ PAV'T - ~~RIGHT~~ ON, 34' S OF PVM'T OF COWEN ST.

16.7' TO LT FACE OF CURB

S.L.M. 225+15

Grid: Northing: _____ Easting: _____

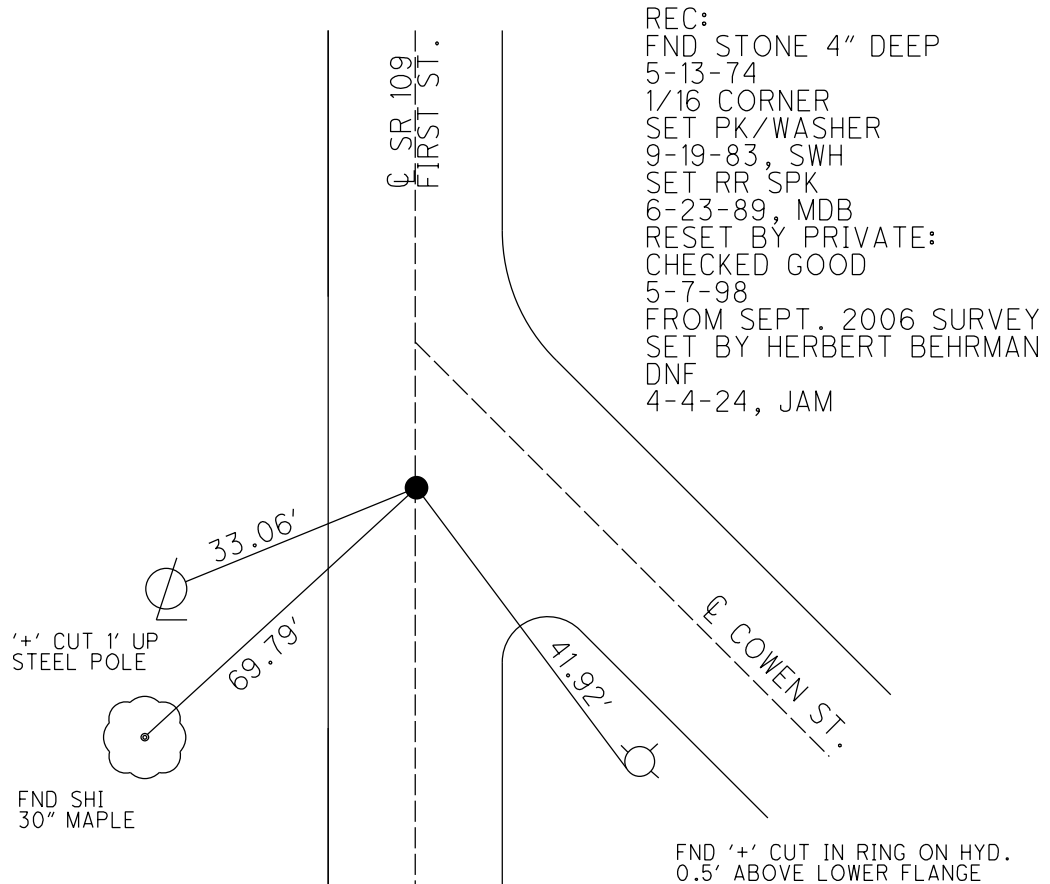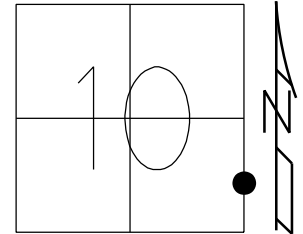

O.D.O.T. DISTRICT 2 SURVEY OFFICE

PERSONNEL

REFERENCE NO. 9A

SHEET 10 OF 21

NOTES Canterbury

H.C. Canterbury

R.C. Rouses

DATE 5-7-98

WEATHER OVERCAST

TEMP. 65°

ROUTE 109

COUNTY HENRY

TOWNSHIP Marion

SECTION 10

T3 N R 7 E


TYPE MONUMENT P.K.

ON SURFACE - ~~BELOW~~ YES

~~LEFT- & PAV'T. - RIGHT~~ ON & 34'S of Pmt.


16.7 TO 1' EDGE PAVEMENT OF Cowen St.

S.L.M. 225+15 SLK (225+15)

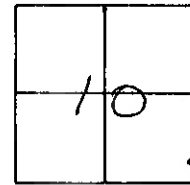

RECORD:
FND Stone 9" DEEP
Vib CORNER

RESET
By Private's
checked- Good

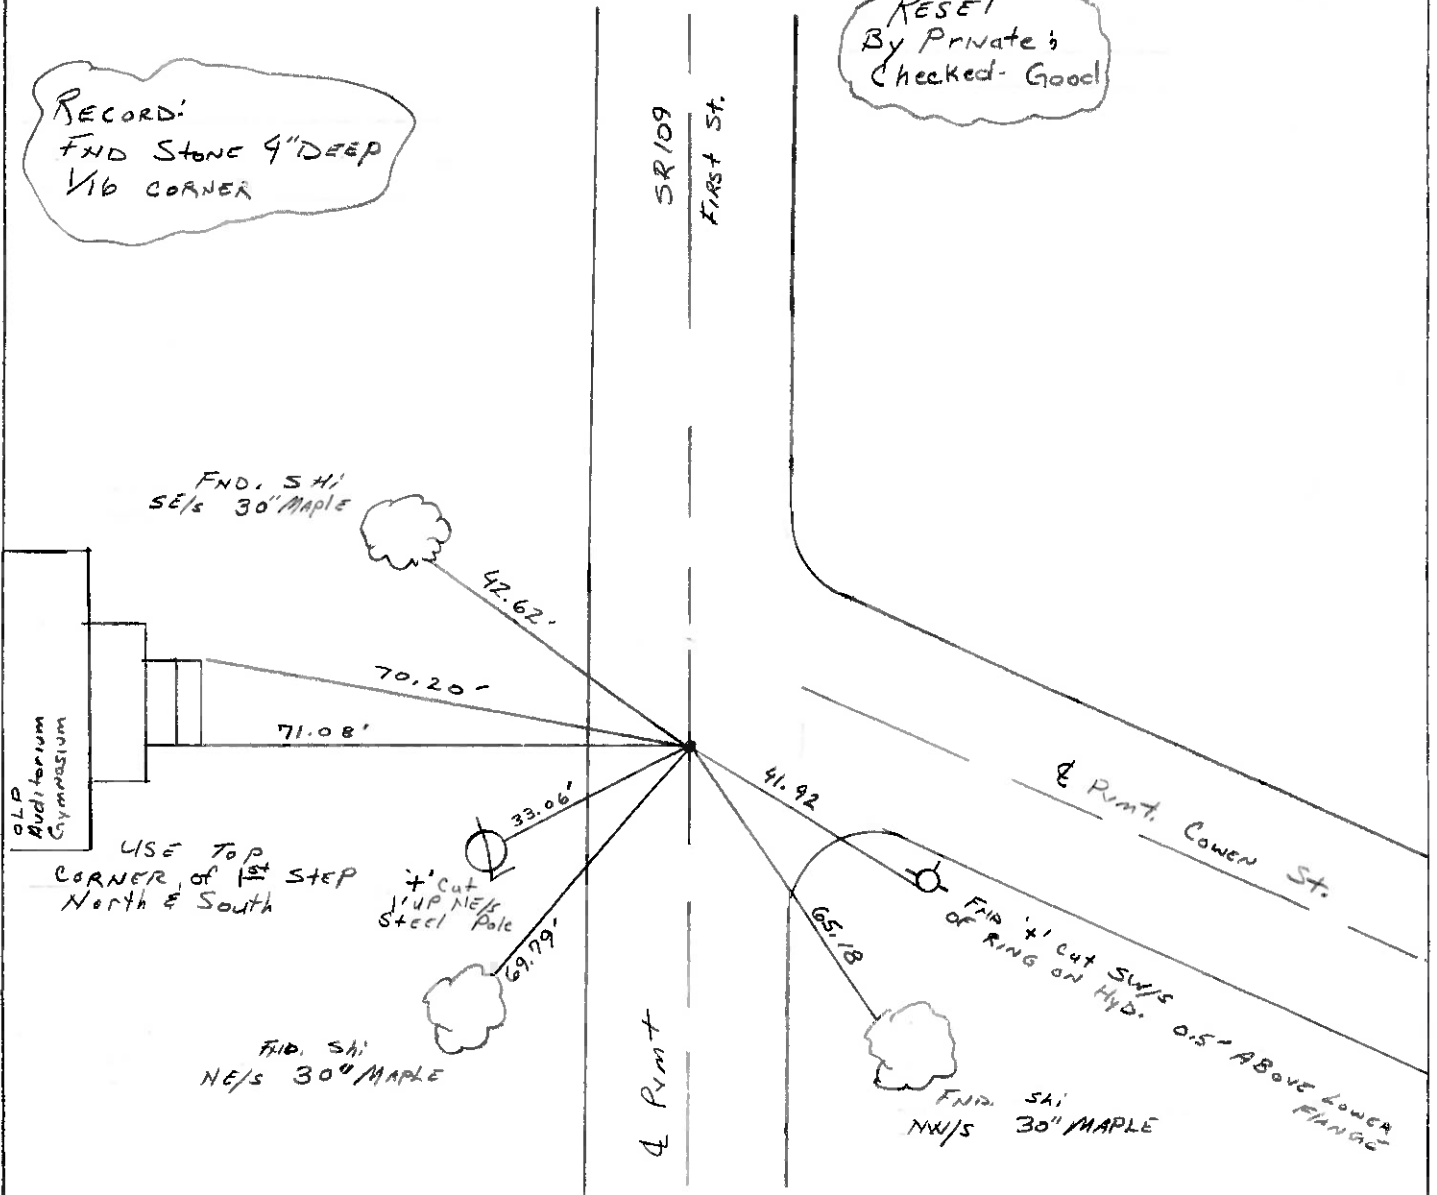

DRAWN BY: TR

O.D.O.T. DISTRICT 2 SURVEY OFFICE

PERSONNEL

REFERENCE NO. 9A

SHEET 10 OF

NOTES BARNHISEL

H.C.

R.C. HOFFMAN

DATE 3-29-89

WEATHER cloudy - hot / dry

TEMP. +44°

ROUTE 109

COUNTY HENRY

TOWNSHIP MARION

SECTION 10

T3 NR 7 E

TYPE MONUMENT P.R. & WASHER



ON SURFACE - ~~BELOW~~ YES

LEFT - & PAN'T. - RIGHT ON E

15.6 TO LT. EDGE PAVEMENT

S.L.M. 225 + 15


34' S of E PAV. T
CF COWEN ST.

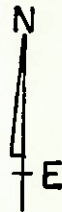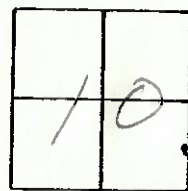

RECORD:

FD. STONE 4" DEED
1/16 CORNER

Set Sm RE Spt
6-23-89
mDB

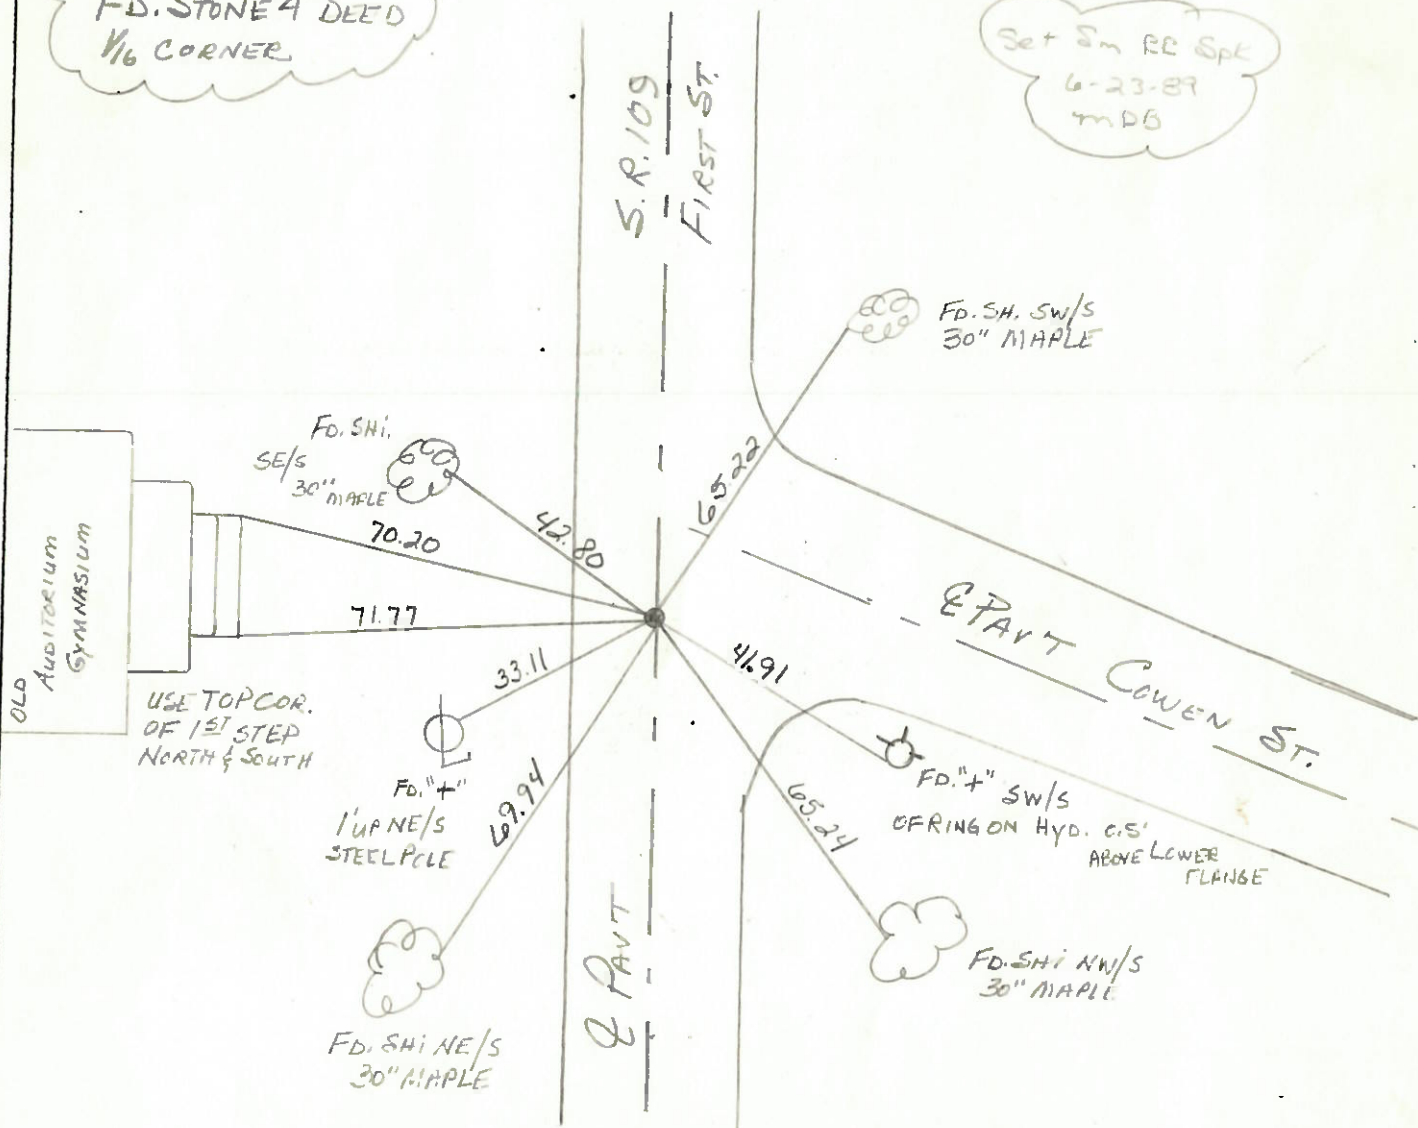

Q.D.O.T. DISTRICT 2 SURVEY OFFICE

SHEET _____ OF _____

County HENRY S.R. 109

Township MARION

Section 10 IN HAMLER

T3N, R7E

Personnel Hoffman

LOEHKE


BARHISEL

#9-A

Date April 19, 83

Weather Clear

Temp. +30°

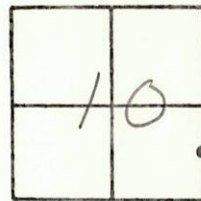

Fd SMALL R.R. SPIC @ surface
ON & PAUT SR 109

34' SOUTH of & PAUT COWEN ST

Record;
Fd STONE 4" deep
YIL CORNER


15.4 TO W.E.P.

15.0 TO E.E.P

SLM 224 + 72

SET P.K./WASHER

9-19-83 SWH

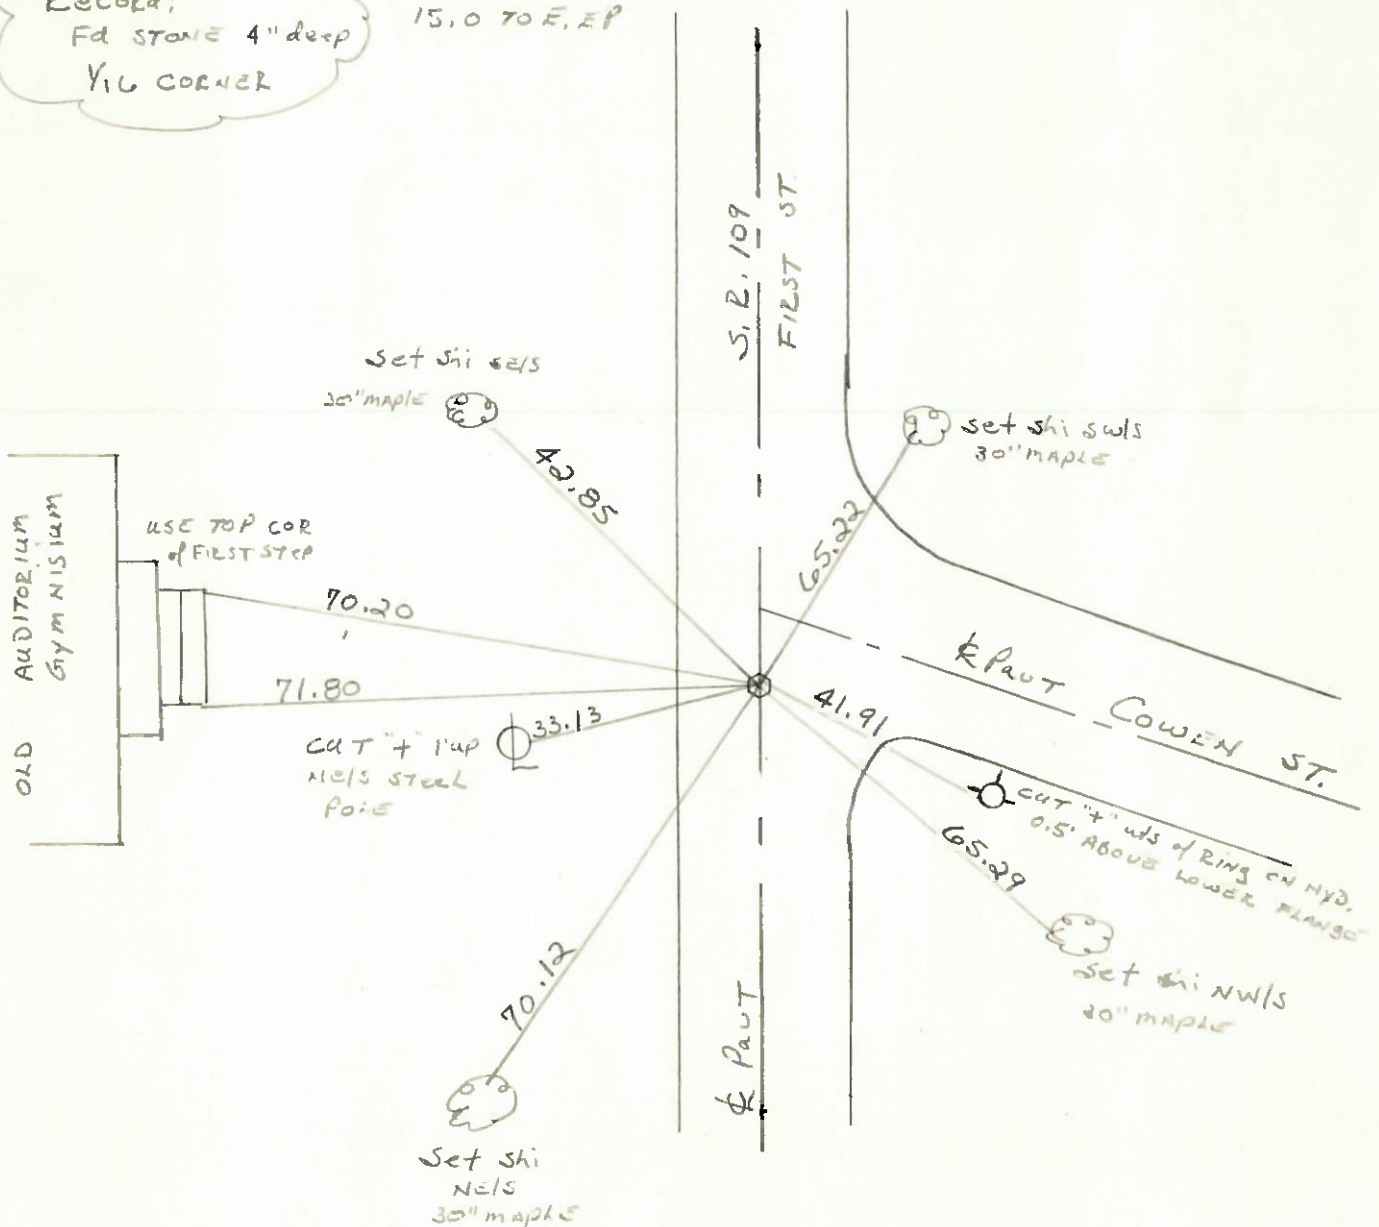

PERSONNEL	TITLE	PERSONNEL	TITLE
<u>Stone</u>			
<u>Michaelak</u>			
<u>Dunn</u>			
<u>Curtis</u>			

COUNTY Henry DATE 13 May 77
 S. R. # 109 WEATHER Cloudy
 SEC. Marion Twp. TEMP. 55°

DESCRIPTION Refs. to Control Points LEFT CENTER LINE RIGHT JOB NO. 029996

