


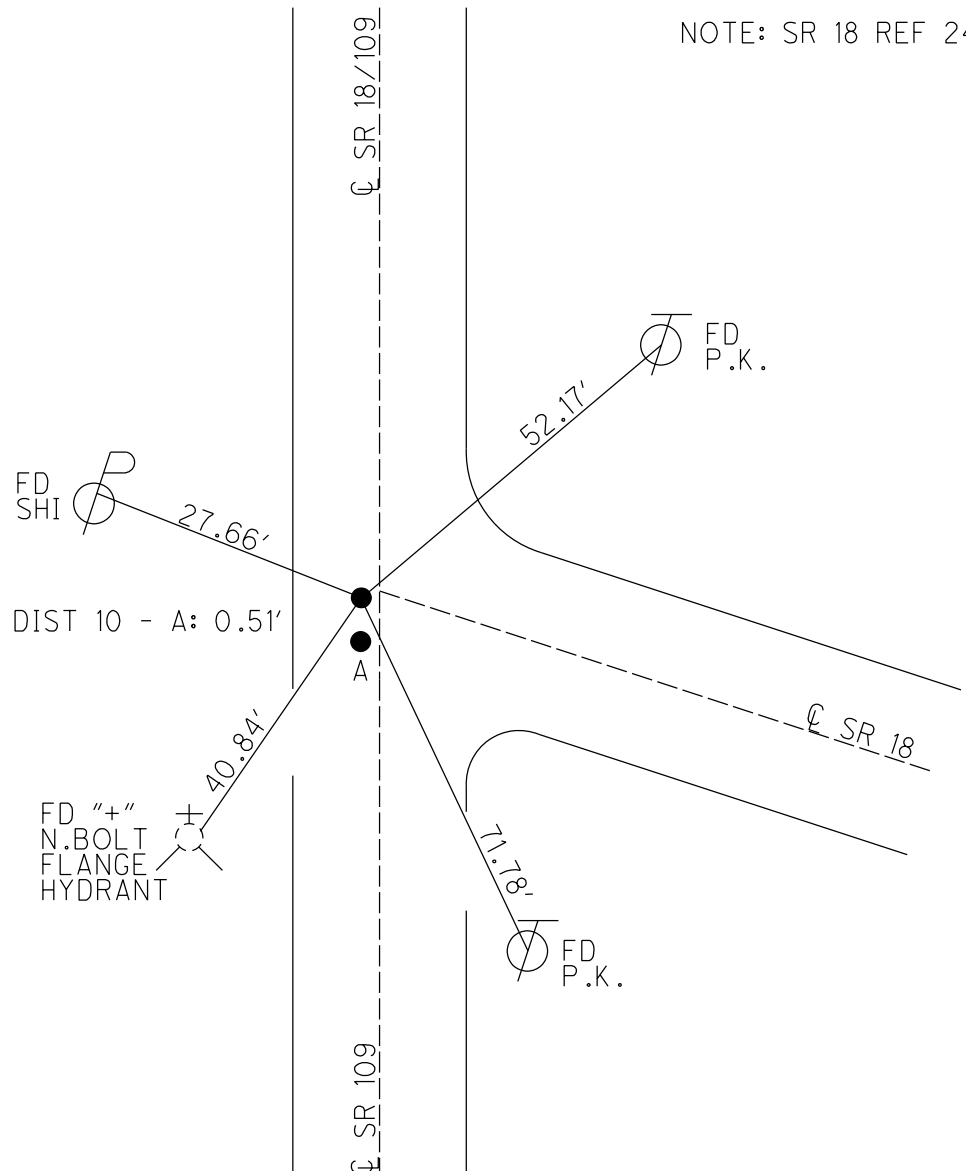

O.D.O.T. DISTRICT 2 SURVEY OFFICE (USE ONLY)

PERSONNEL

REFERENCE NO. 10

SHEET 16 OF 25

NOTES RHOADES

DATE 6/27/22

ROUTE SR 109

H.C. AUBLE

WEATHER SUNNY

COUNTY HENRY

R.C. RHOADES

TEMP. 65°

TOWNSHIP MARION

SECTION 10

DWG BY RHOADES PID PAVE TRAIN

T 3 N R 7 E

TYPE MONUMENT MAG/WASHER

ON SURFACE - ~~BELOW~~ ON

OFFSET 0.5' LT : ~~RT~~

10.6' TO LT EDGE PAVEMENT


STATION: 241+38

HORZ.DATUM: NAD83 2011

GEOID: NAVD88 2018


GRID: NORTHING: 574121.306

EASTING: 1546001.129

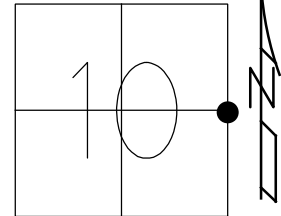

RECORD:
FD 1/23/07
SET P.K./WASHER
9/24/98, MRC
FD P.K./WASHER
3" DOWN
REF 24
6/26/08, KPM
FD MAG/WASHER
REF10
2/14/19, JLL
FD MAG/WASHER
REF24
6/27/22, JFO
1/11/23, JMR

NOTE: SR 18 REF 24

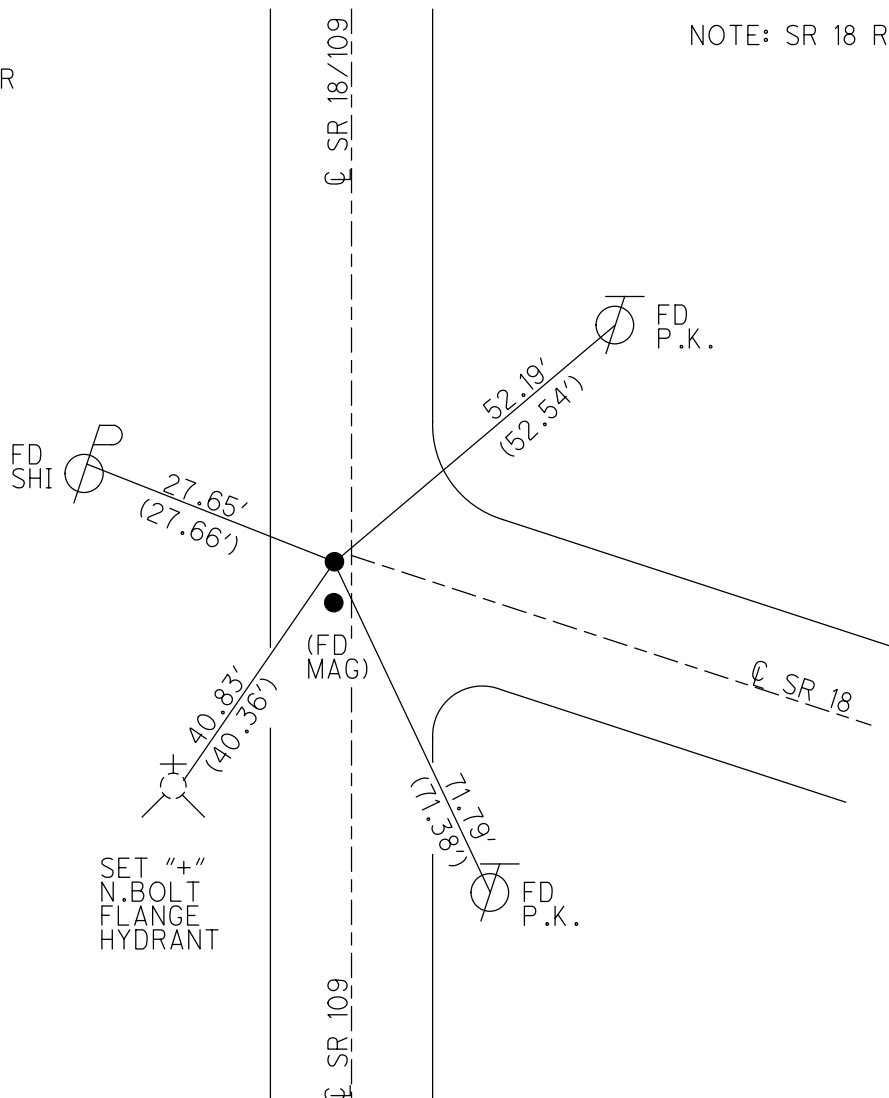


O.D.O.T. DISTRICT 2 SURVEY OFFICE (USE ONLY)

PERSONNEL	REFERENCE NO. <u>10</u>	SHEET <u>16</u> OF <u>26</u>
NOTES <u>CANTERBURY</u>	DATE <u>05-08-1998</u>	ROUTE <u>SR 109</u>
H.C. <u>CANTERBURY</u>	WEATHER <u>CLOUDY</u>	COUNTY <u>HENRY</u>
R.C. <u>ROUSOS</u>	TEMP. <u>65°F</u>	TOWNSHIP <u>MARION</u>
		SECTION <u>10</u>
		<u>T 3 N R 7 E</u>


TYPE MONUMENT PK & WASHER
~~ON SURFACE~~ - BELOW 3"
 LEFT - ℄ PAV'T - ~~RIGHT~~ 0.7'
9.8' TO LT EDGE PAVEMENT
 S.L.M. 241+38

Grid: Northing: _____ Easting: _____

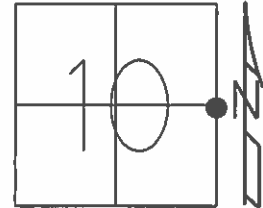

REC:
 $\Delta = 00^\circ - 00' - 30''$ RT

RESET PK & WASHER
 09-24-1998
 MRC

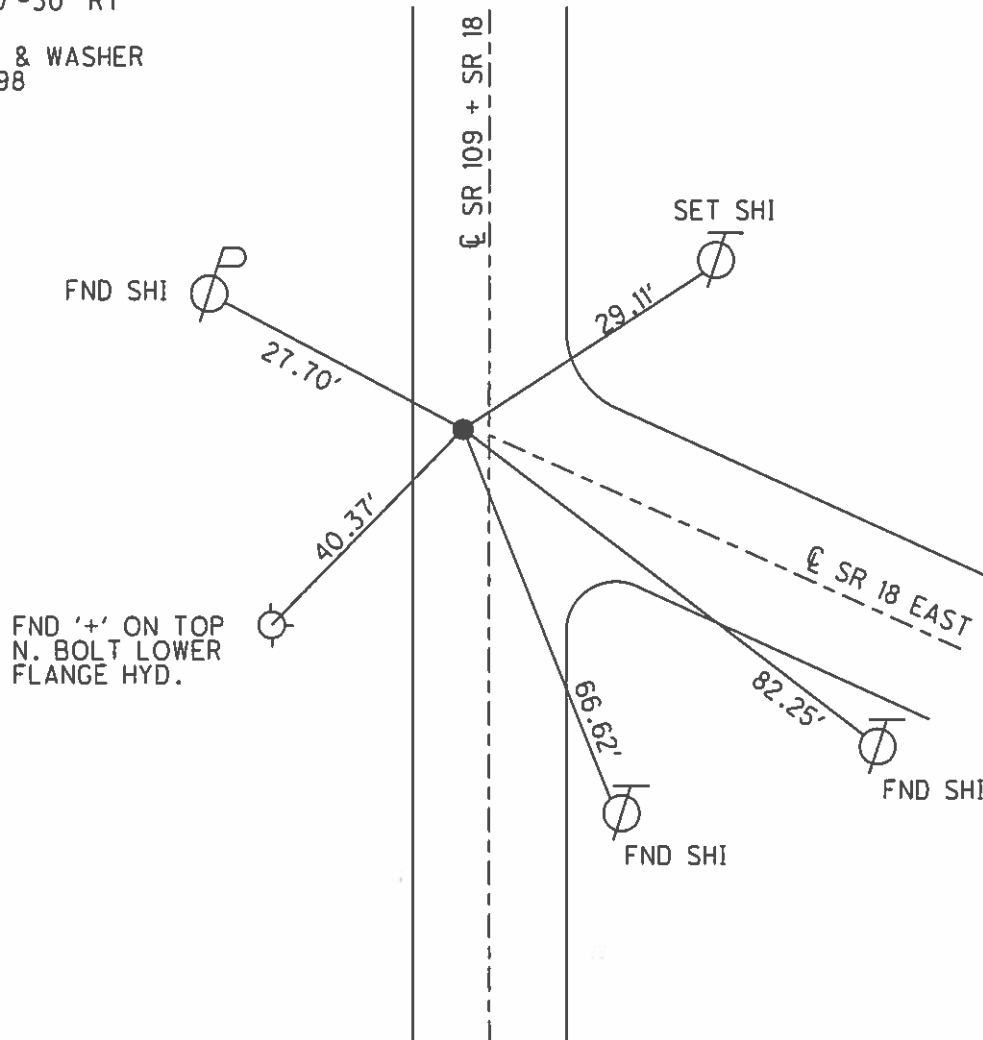

O.D.O.T. DISTRICT 2 SURVEY OFFICE

PERSONNEL

REFERENCE NO. 10

SHEET 13 OF 21

NOTES CANTERBURY

H.C. CANTERBURY

R.C. Route 109

DATE 5-3-98

WEATHER Cloudy

TEMP. 65°F

ROUTE 109

COUNTY HENRY

TOWNSHIP MARION

SECTION 10

T.3 N R.7 E


TYPE MONUMENT PX & WASHER

ON SURFACE - BELOW 3" Below

LEFT- & PAU'T. - RIGHT 8.7

9.8 TO L EDGE PAVEMENT


S.L.M. 7+292.07 SLK (291+38 slm)

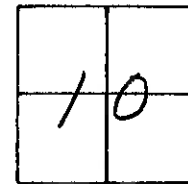

RECORD:

$\Delta = 00^{\circ}00'30''$ RT

RESET PX & WASHER
9-24-98
MRC

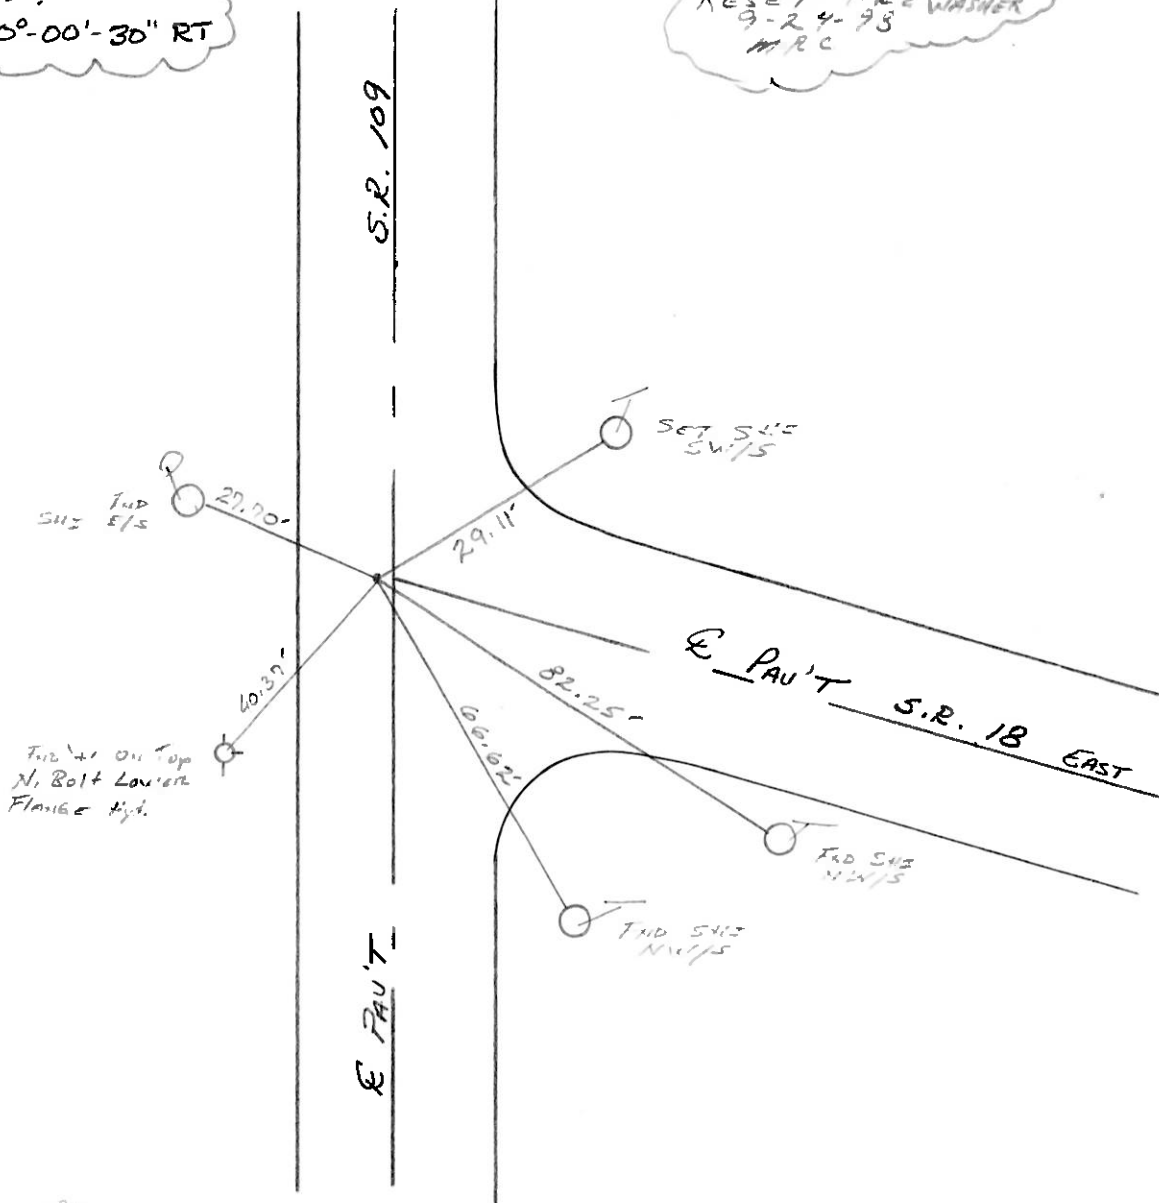

DRAWN BY

O.D.O.T. DISTRICT 2 SURVEY OFFICE

PERSONNEL

REFERENCE NO. 10

SHEET 13 OF

NOTES BARNHISEL

H.C. " "

DATE 3-29-89

ROUTE 109

R.C. HOFFMAN

WEATHER cloudy - Windy

COUNTY HENRY

TEMP. +44°

TOWNSHIP MARION

SECTION 10

T 3 N R 7 E


TYPE MONUMENT PK & WASHER

ON SURFACE - BELOW YES

LEFT-℄ PAV'T. - RIGHT 0.7

11.2 TO ℄ EDGE PAVEMENT


S.L.M. 241 + 38

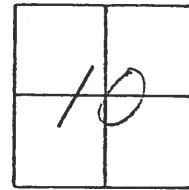

(PK & WASHER ON
℄ OF S.R. 18)


RECORD:
 $\Delta = 0^{\circ} - 00' - 30''$ R.T.

Set 3m RR Spk
6-23-89
m.d.b.

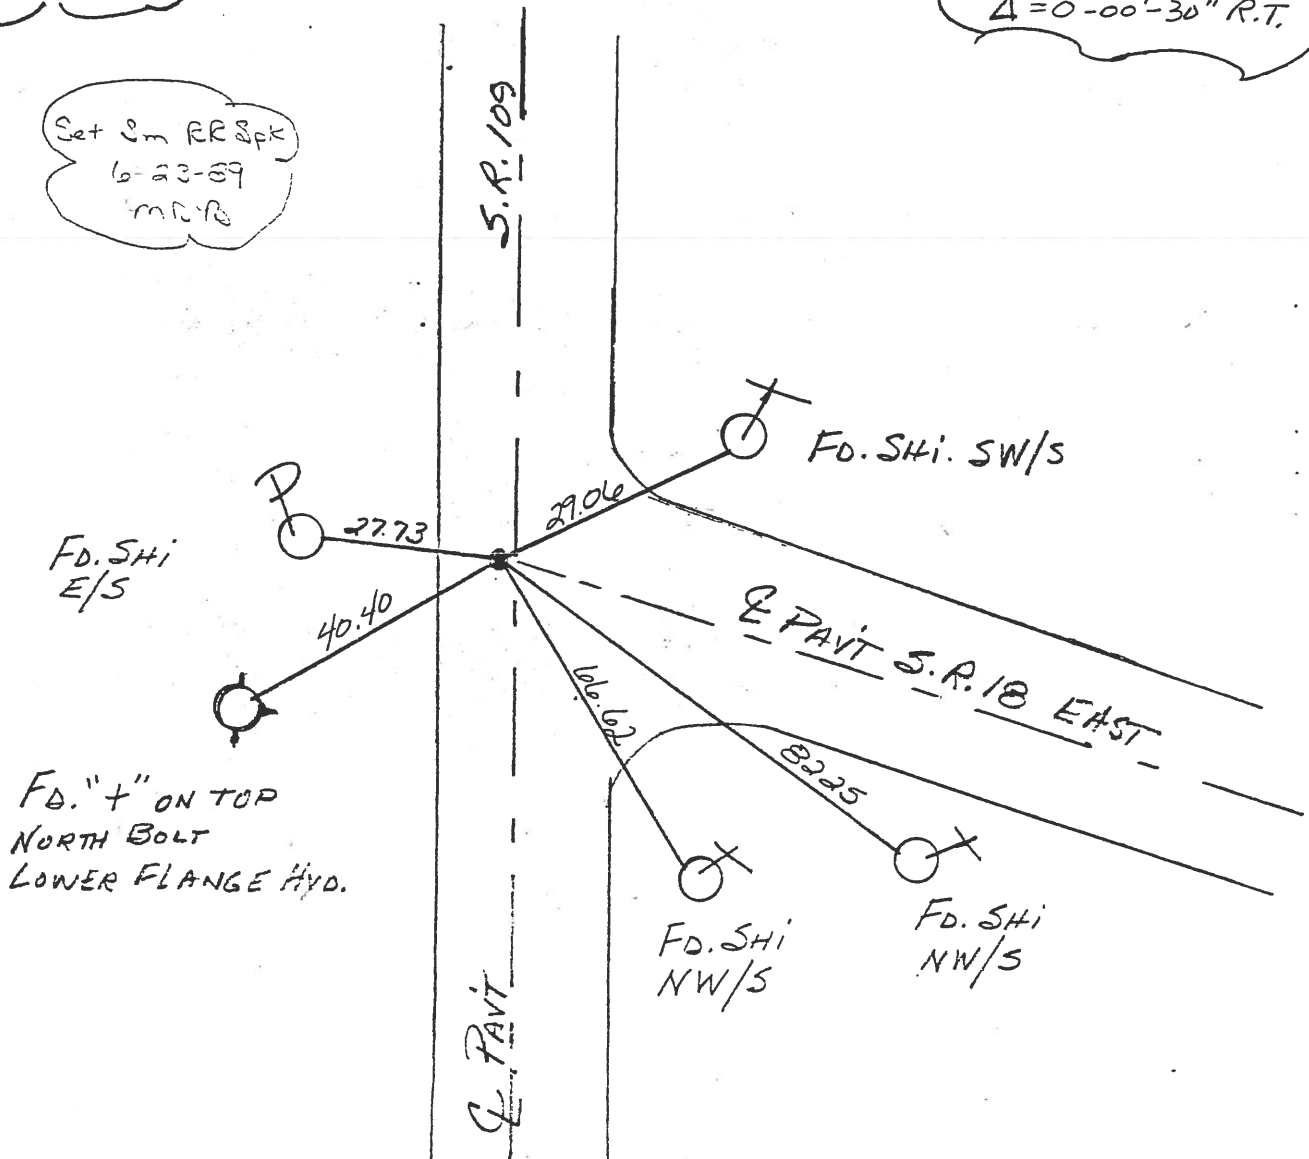

County HENRY S.R. 109Township MARIONSection 10

T3N, R7E

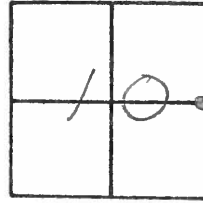Personnel HOFFMANLOEHRKEBARNHISELDate April 19, 83Weather CLEARTemp. +34°

#10

Fd R.R. spk @ surface

1.1' Lt SR 109 & Paut

9.1' TO W.E.P. SR 109

S.L.M. 237+95


Record:

 $\Delta = 0^{\circ}-00'-30''$ R.T.

SET P.K./WASHER

9-19-83


SWH

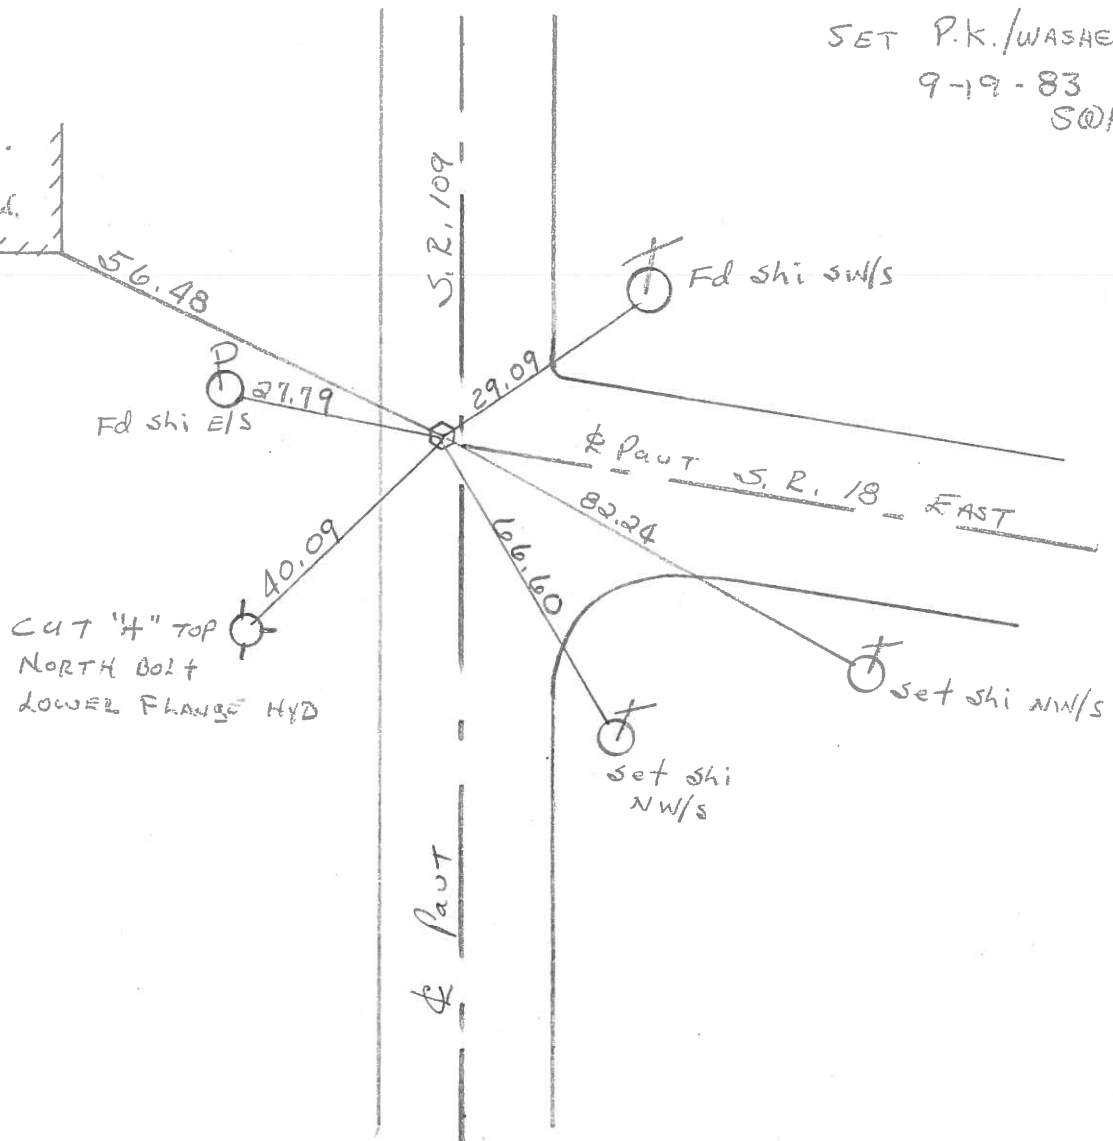USE S.E.
CORNER
HOUSE FdA.

SHEET NO. _____

PERSONNEL	TITLE	PERSONNEL	TITLE	COUNTY	DATE	WEATHER	TEMP.
BURNSIDE				HENRY	11-7-73	CLEAR	+42°
SMITH				S. R. 18 & 109	HAMLER, O.		
MEAD				SEC.			

DESCRIPTION & ALIGNMENT FOR MARION STREET JOB NO. 028280

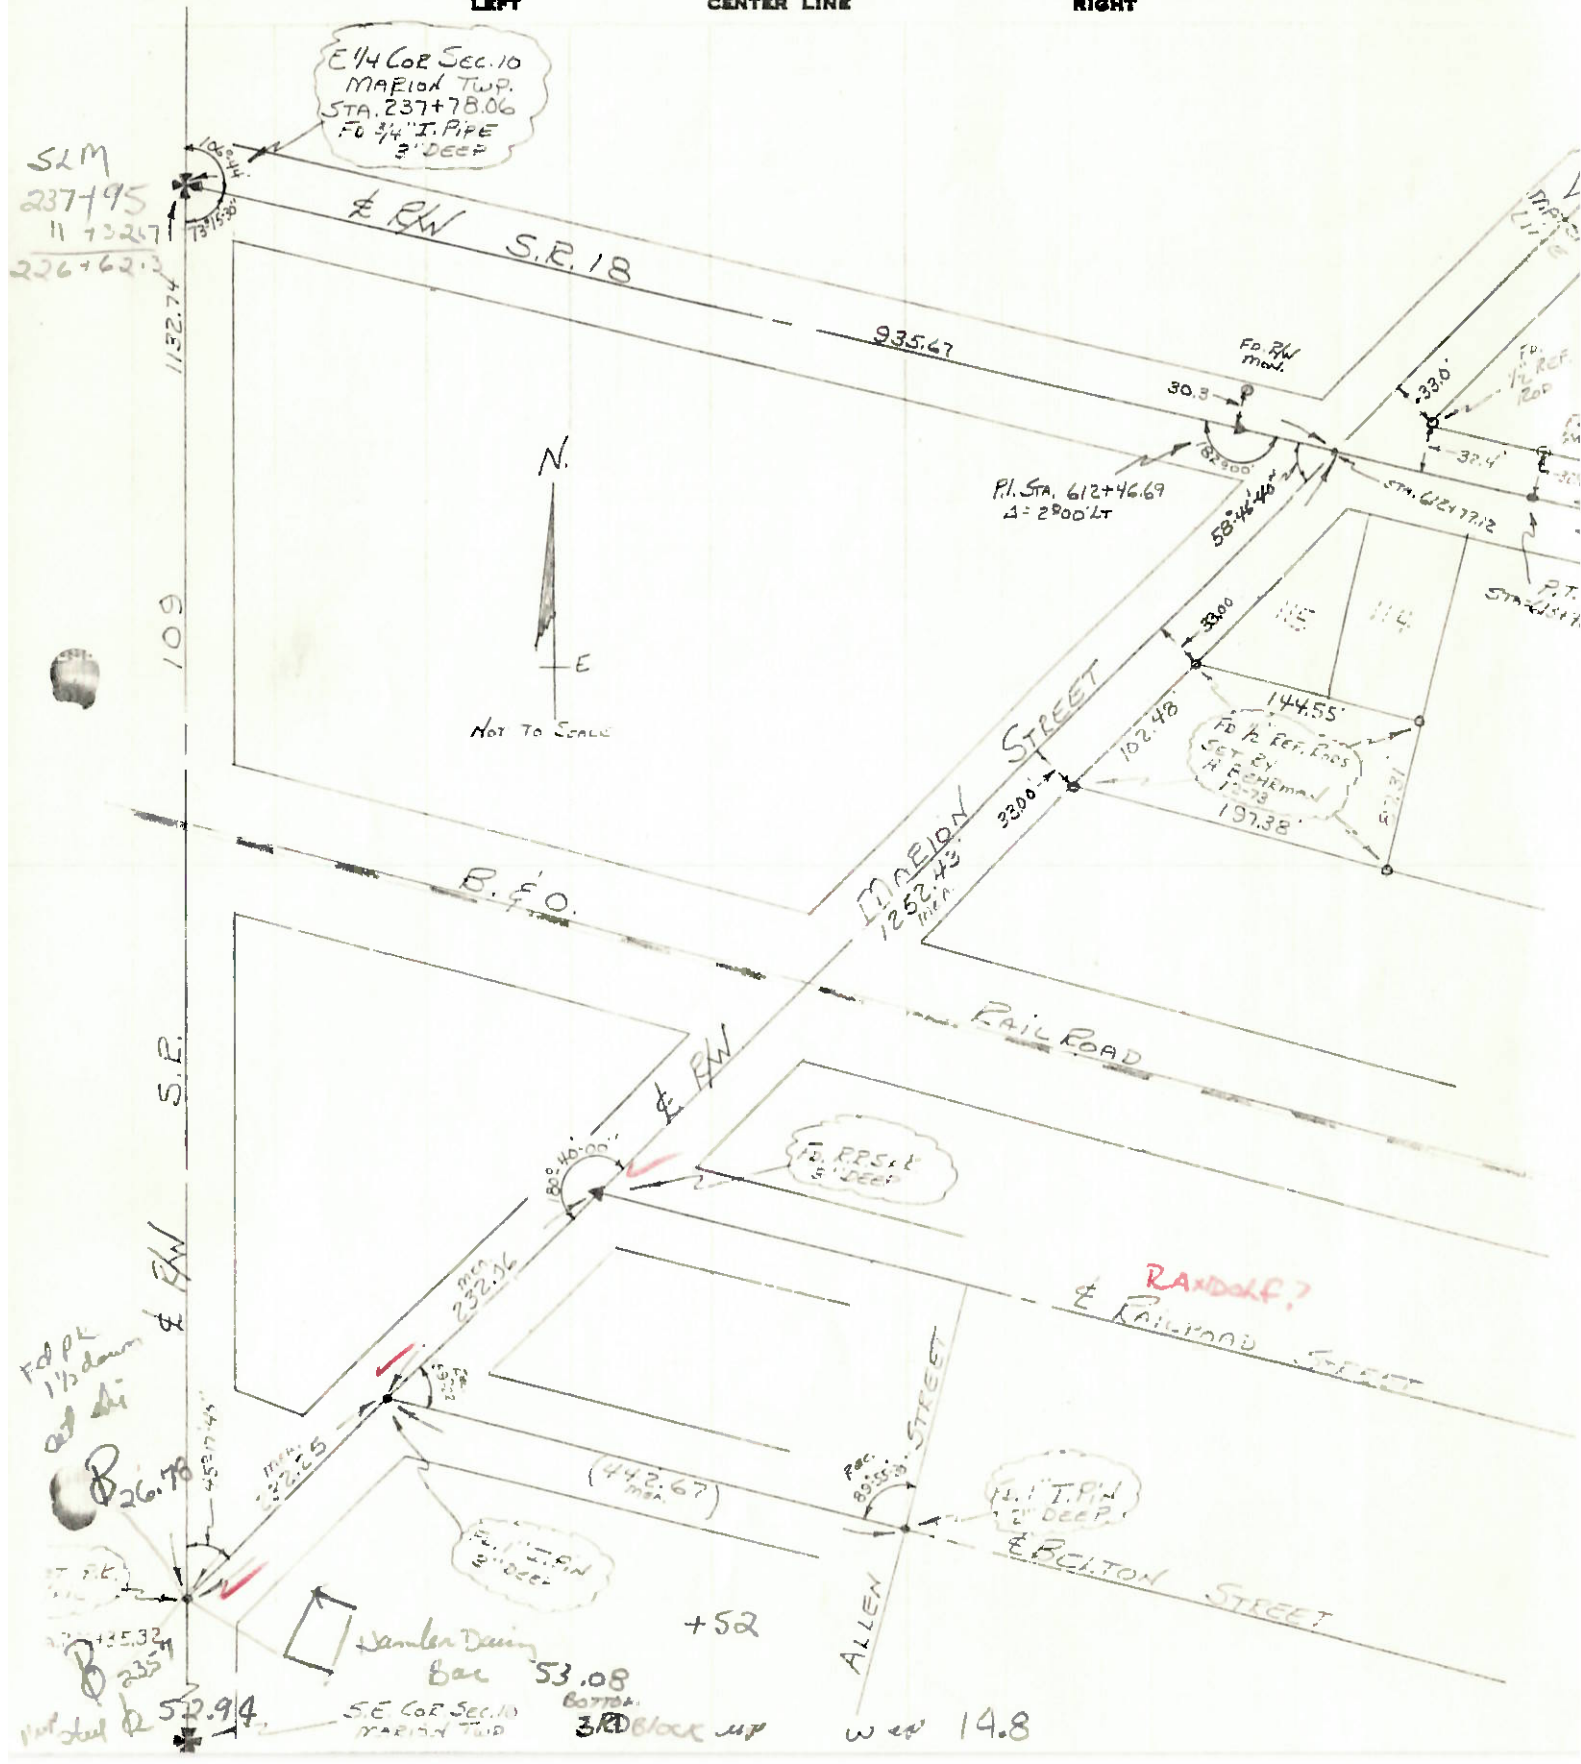

PERSONNEL	TITLE	PERSONNEL	TITLE
Tomsic			
Neuser			
Granata			
Vanya			

COUNTY HENRYDATE Oct. 31, 1973S. R. 109

WEATHER

SEC. MARION TWP.

TEMP

DESCRIPTION

LEFT

CENTER LINE

RIGHT

JOB NO.

Jct. S.R. 109

E. Co. Rd. "F"

S.E. Cor. Sec. 3

S.W. Cor. Sec. 2

MARION TWP.

MARION

Co.

Rd. "F"

Ed. R.R. spk @ surface

shiner 18" Maple

Jct. S.R. 109

S.R. 18 E.

MARION TWP.

shiner

27.51'

29.05'

shiner

S.R. 18 E.

Duplex S.F. 10" Walnut

Ed. 3/4" Iron Pipe

@ Baltimore St.

HAMMER OHIO

MARION TWP.

shiner

51.72'

S.R. 109

Ed. P.R. nail

S.E. bolt in base
RR. X-ing sign

24.00'

27.11'

shiner

38.00'

PERSONNEL TITLE PERSONNEL TITLE

BURNSIDE

COUNTY HENRY

DATE 8-7-72

SMITH

S. R. 109

WEATHER SHOWERS

KIJOWSKI

SEC. HAMLER

TEMP. +70°

DESCRIPTION CONTROL TIES

JOB NO. 028280

LEFT

CENTER LINE

RIGHT

E 1/4 COR. SEC. 10
MARION TWP
FD. 3/4" I. PIPE 3"
BELOW SURFACE
S.L.M. STA. 237+78.06
S.R. 109
Δ=0°00'30" R.

SE COR.
HO. FDN.

NE COR.
HO. FDN.

56.45'
SHI. P 27.50'

63.84'

39.98'

29.04' SHI.

73°15'30"

#10-124
109 18

S.R. 18

NEAR EDGE
"FLANGE" FIRE
HYD.

S.R. 109



SHI. P

51.69'

38.88' SHI.

27.10' SHI.

SE COR. CONC. BASE
P.R. KING SIGNAL

23.64'

B. & O. R.R.

PERSONNEL TITLE PERSONNEL TITLE

COUNTY Henry DATE 2-5-58
10-25-60S. R. #107 WEATHER

SEC. TEMP.

DESCRIPTION Hambler JOB NO.

LEFT

CENTER LINE

RIGHT

9 #58 Iron Pipe Conc. Part 32.06 32.28' S.W. "X" Retaining Wall
NE cor Sec. Fd. Iron Rod 4" 34.95' S.S.W. "X" "
#15 Marion Twp. below Surface 25.70 25.48' N.E. "X" Top curb ✓
W. Chape 25.82 25.80' N.W. "X" "
73.35 73.10' N.W. Cor. Res.

10 #59 3/4" Iron Pipe in Part 63.67 64.00' S.W. N.E. Cor. House Fdn.
E 1/4 Sec 10 (Ruffer) 56.45 20.00' W. Spk. P. Pole ✓
Marion Twp. 40.60 56.60' N.W. S.E. Cor. House Fdn.
S.S.W. Top ctr. Fire Hyd.

11 #60 3/4" Iron Pipe 15.21 15.25' S.W. S.E. Cor. S. Bridge Rd.
NE cor Sec (Ruffer) 23.45 23.37' N.W. N.E. Cor. N. " "
#10 Marion Twp. 82.30 82.05' N.E. S.W. Cor. House Fdn.
51.20 N.E. Shi. 20" Maple ✓
43.09 S.E. Shi. T. Pole
50.10 N.W. Shi. P. Pole