

O.D.O.T. DISTRICT 2 SURVEY OFFICE (USE ONLY)

PERSONNEL

REFERENCE NO. 11

SHEET 16 OF 25

NOTES BARRIERE
H.C. MILLER
R.C. BARRIERE

DATE 10/4/24
WEATHER CLEAR
TEMP. 75°

ROUTE SR 109
COUNTY HENRY
TOWNSHIP MARION
SECTION 3
T 3 N R 7 E

DWG BY BARRIERE PID 99587

TYPE MONUMENT MAG NAIL/WASHER

ON SURFACE - BELOW ON

OFFSET $\varnothing$ PAVEMENT 6' LT ~~RT~~

TO EDGE PAVEMENT

STATION: 236+64

HORIZ.DATUM: OHIO LDP (HENRY)


GEOID: 18

GRID: NORTHING:


EASTING:

LDP: NORTHING: 433409.109

EASTING: 181571.091

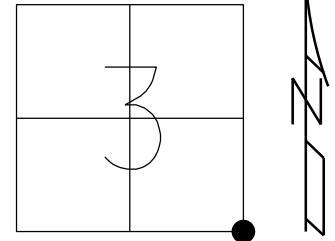


RECORD:
FD SM RR SPK 5/98
RESET PK & WASHER
09-24-1998
M.R.C.
FD RR SPIKE
2" BELOW
REF11
2/14/19
FD SM RR SPIKE
REF11
11-29-21, DSA
SET MAG/WASHER
REF11
10/4/24, JAM

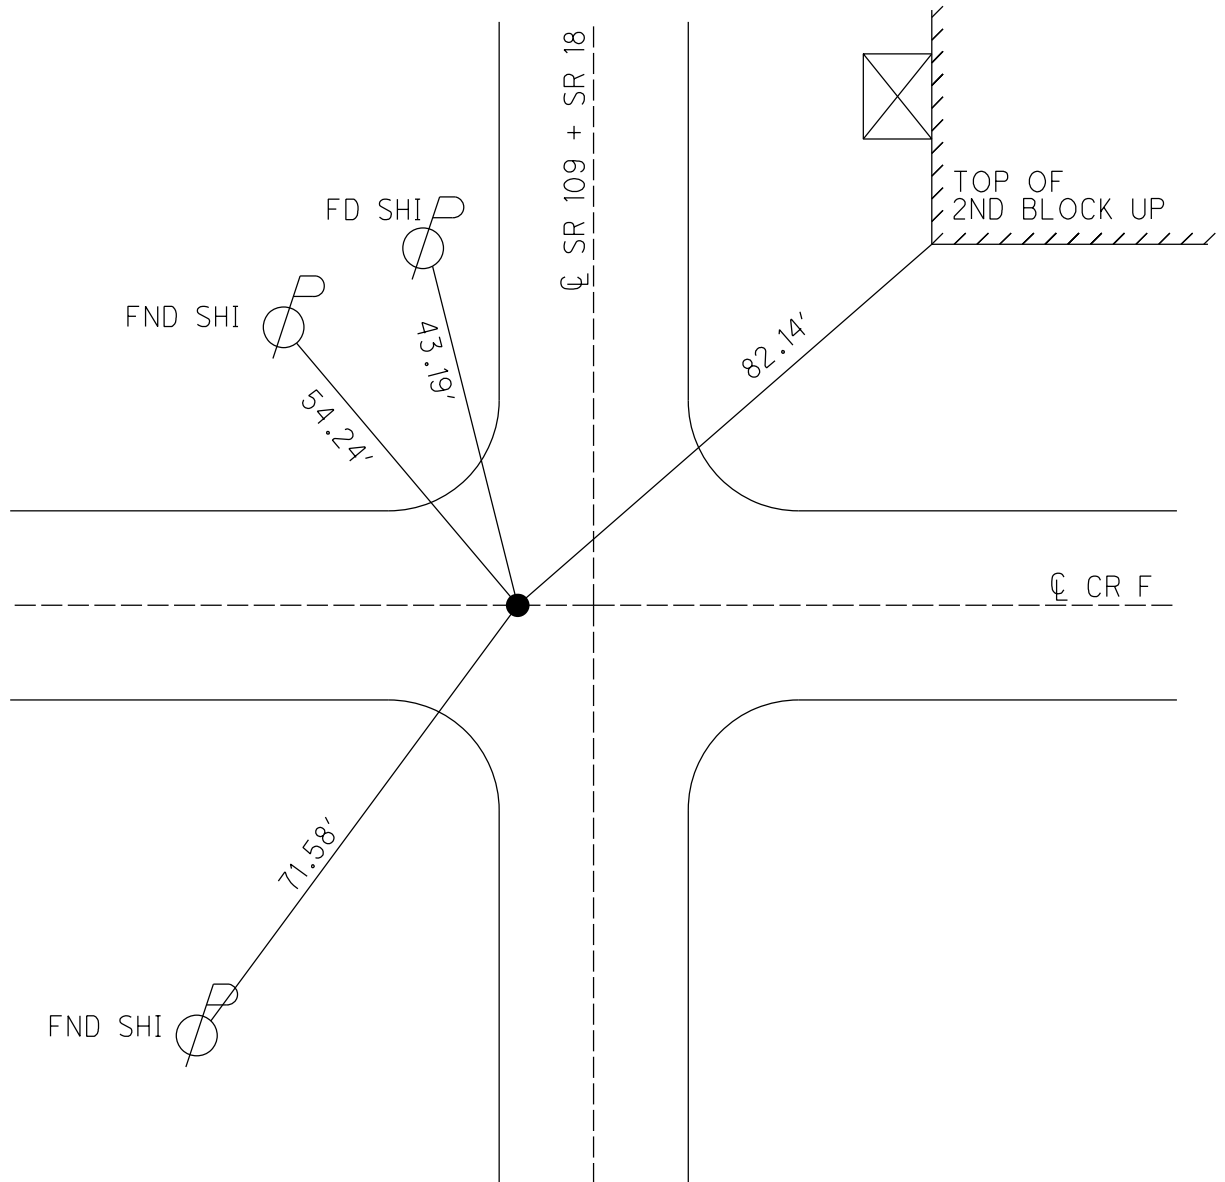

O.D.O.T. DISTRICT 2 SURVEY OFFICE (USE ONLY)


PERSONNEL _____ REFERENCE NO. 11 SHEET 17 OF 26
 NOTES CANTERBURY DATE 05-08-1998 ROUTE SR 109
 H.C. CANTERBURY WEATHER CLOUDY COUNTY HENRY
 R.C. ROUSOS TEMP. 65°F TOWNSHIP MARION
 SECTION 3
 T 3 N R 7 E

TYPE MONUMENT SMALL RR SPK
 ON SURFACE - ~~BELOW~~ ON
 LEFT - ~~PAV'T~~ - ~~RIGHT~~ 6'
 - TO - EDGE PAVEMENT
 S.L.M. 236+64
 Grid: Northing: _____ Easting: _____

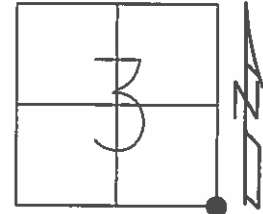

FND SM RR SPK 05-1998

RESET PK & WASHER
 09-24-1998
 M.R.C.

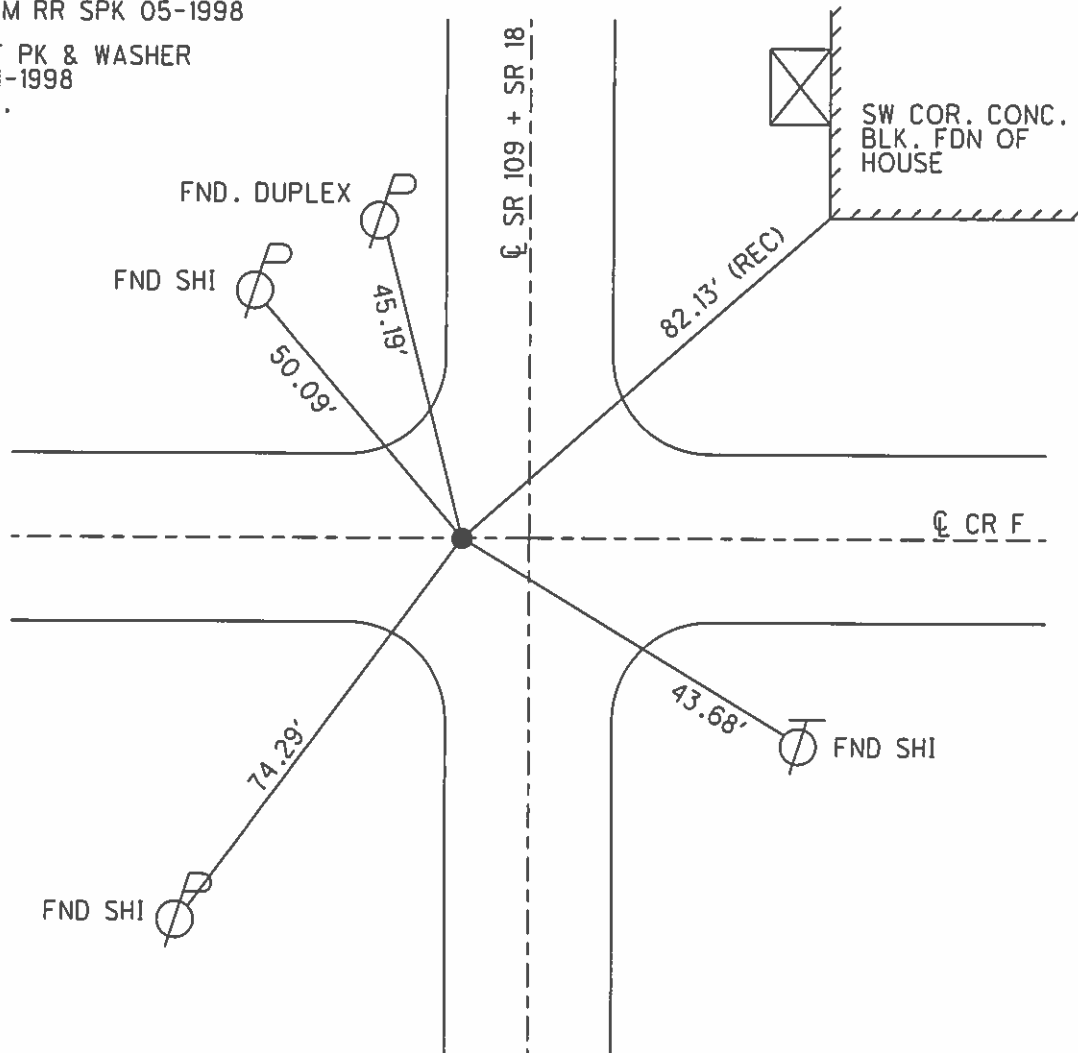

O.D.O.T. DISTRICT 2 SURVEY OFFICE

PERSONNEL

REFERENCE NO. 11

SHEET 13A OF 21

NOTES CANTERBURY

H.C. CANTERBURY

R.C. Rousar

DATE 5-8-98

WEATHER Cloudy

TEMP. 65°F

ROUTE 18+109

COUNTY Henry

TOWNSHIP Marion

SECTION 3

T 3 N R 7 E

TYPE MONUMENT Small RR spike


ON SURFACE - ~~BELOW~~ Surface

LEFT - ~~C PAVT~~ - RIGHT 6' left of C / ON C TO EAST

TO EDGE PAVEMENT


S.L.M. 7+633.53

267+78 / 5.07

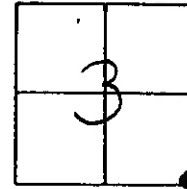

Fd. Sm. RR spk 5/98

RESET P.I.C. & WASHED
9-24-98
MRC

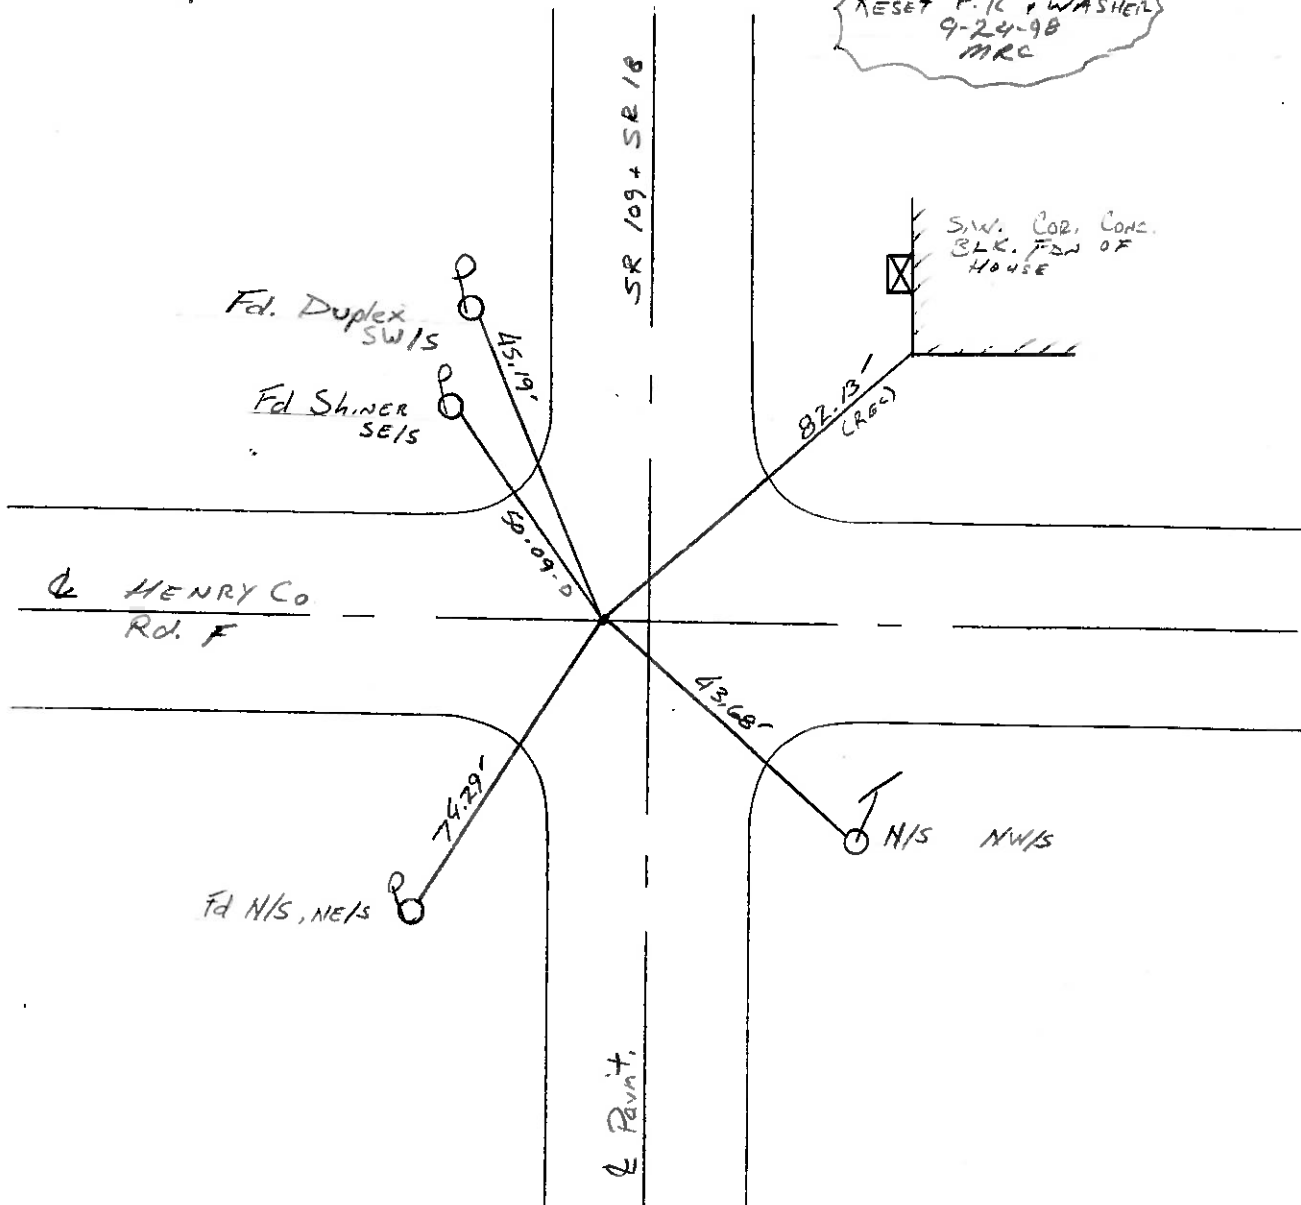

DRAWN BY: TR

ODOT DISTRICT 2 SURVEY OFFICE

SHEET 19 OF

County HENRY S.R. 18-109

Township MARION

Section 3

T3N, R7E

Personnel S. Hoffmann

C. Doehrke

J. Householder


#23/18

#11/109

Date 5-29-81

Weather PARTLY CLOUDY


Temp. +75°

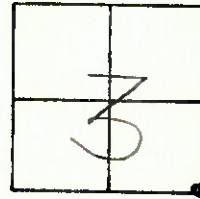

Fd. R.R. SPK @ SURFACE
6' W. of & PAUT.

S.L.M. 578+21

SET P.K./WASHER
9-19-83 SWH

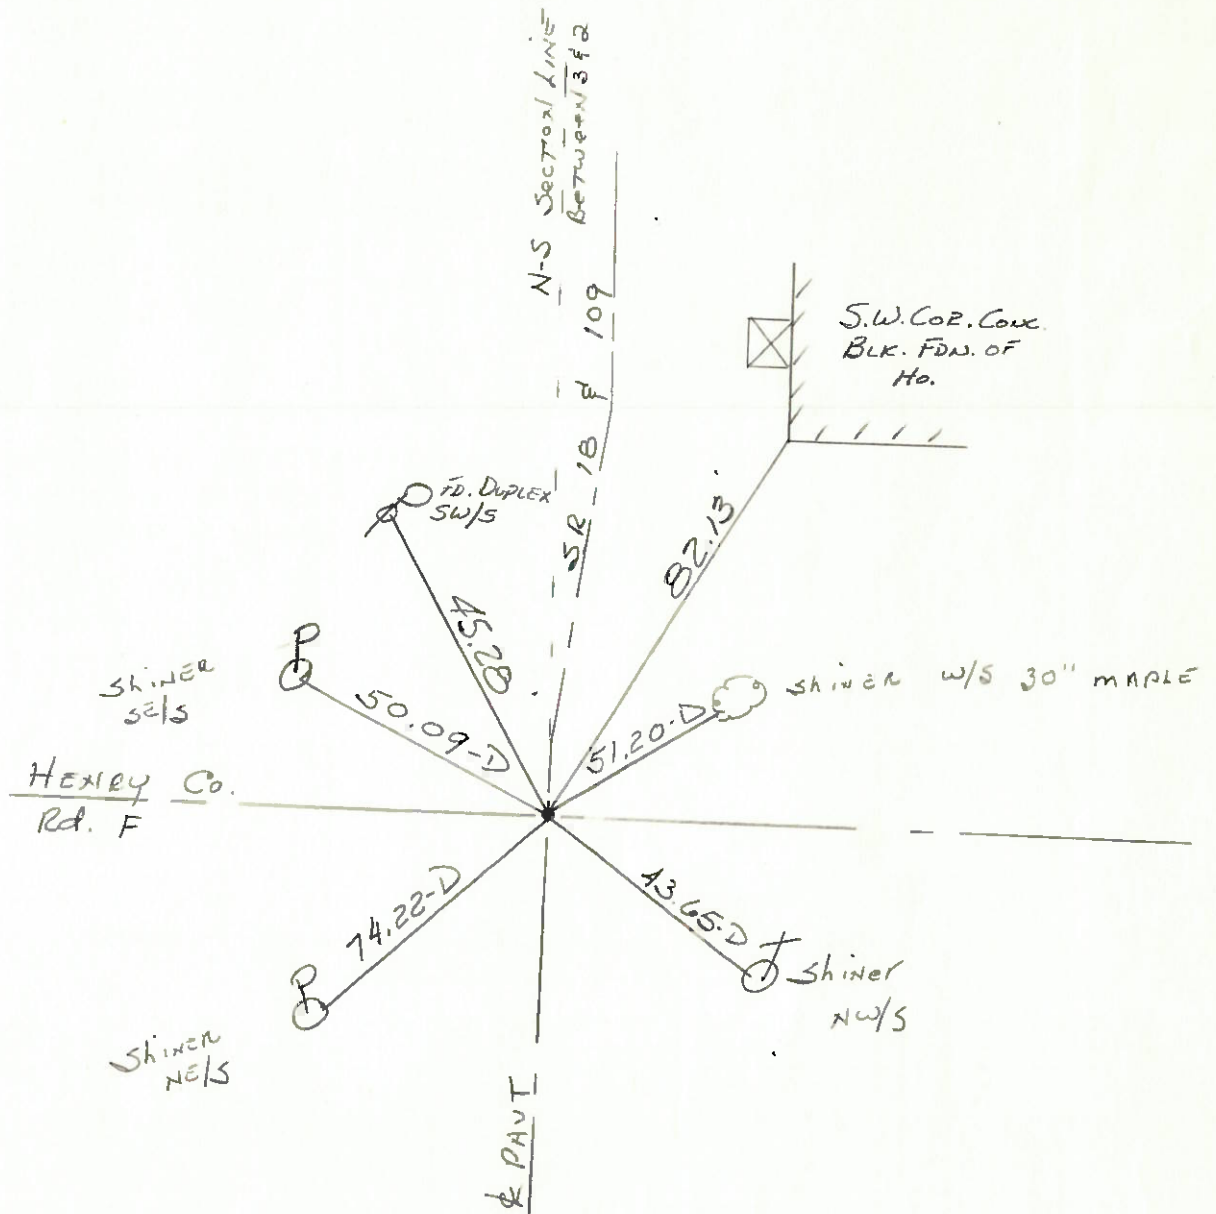

PERSONNEL	TITLE	PERSONNEL	TITLE
Tomsic			
Neuser			
Granata			
Vanya			

COUNTY HENRYDATE Oct. 31, 1973S. R. 109

WEATHER

SEC. MARION TWP.

TEMP

DESCRIPTION

LEFT

CENTER LINE

RIGHT

JOB NO.

Jct. S.R. 109

E. Co. Rd. "F"

S.E. Cor. Sec. 3

S.W. Cor. Sec. 2

MARION TWP.

MARION

Co.

Rd. "F"

Ed. R.R. spk @ surface

shiner 18" Maple

Jct. S.R. 109

S.R. 18 E.

MARION TWP.

shiner

27.51'

29.05'

shiner

S.R. 18 E.

Duplex S.F. 10" Walnut

Ed. 3/4" Iron Pipe

@ Baltimore St.

HAMMER OHIO

MARION TWP.

shiner

51.72'

S.R. 109

Ed. P.R. nail

S.E. bolt in base
RR. X-ing sign


24.00'

27.11'

shiner

38.00'

shiner

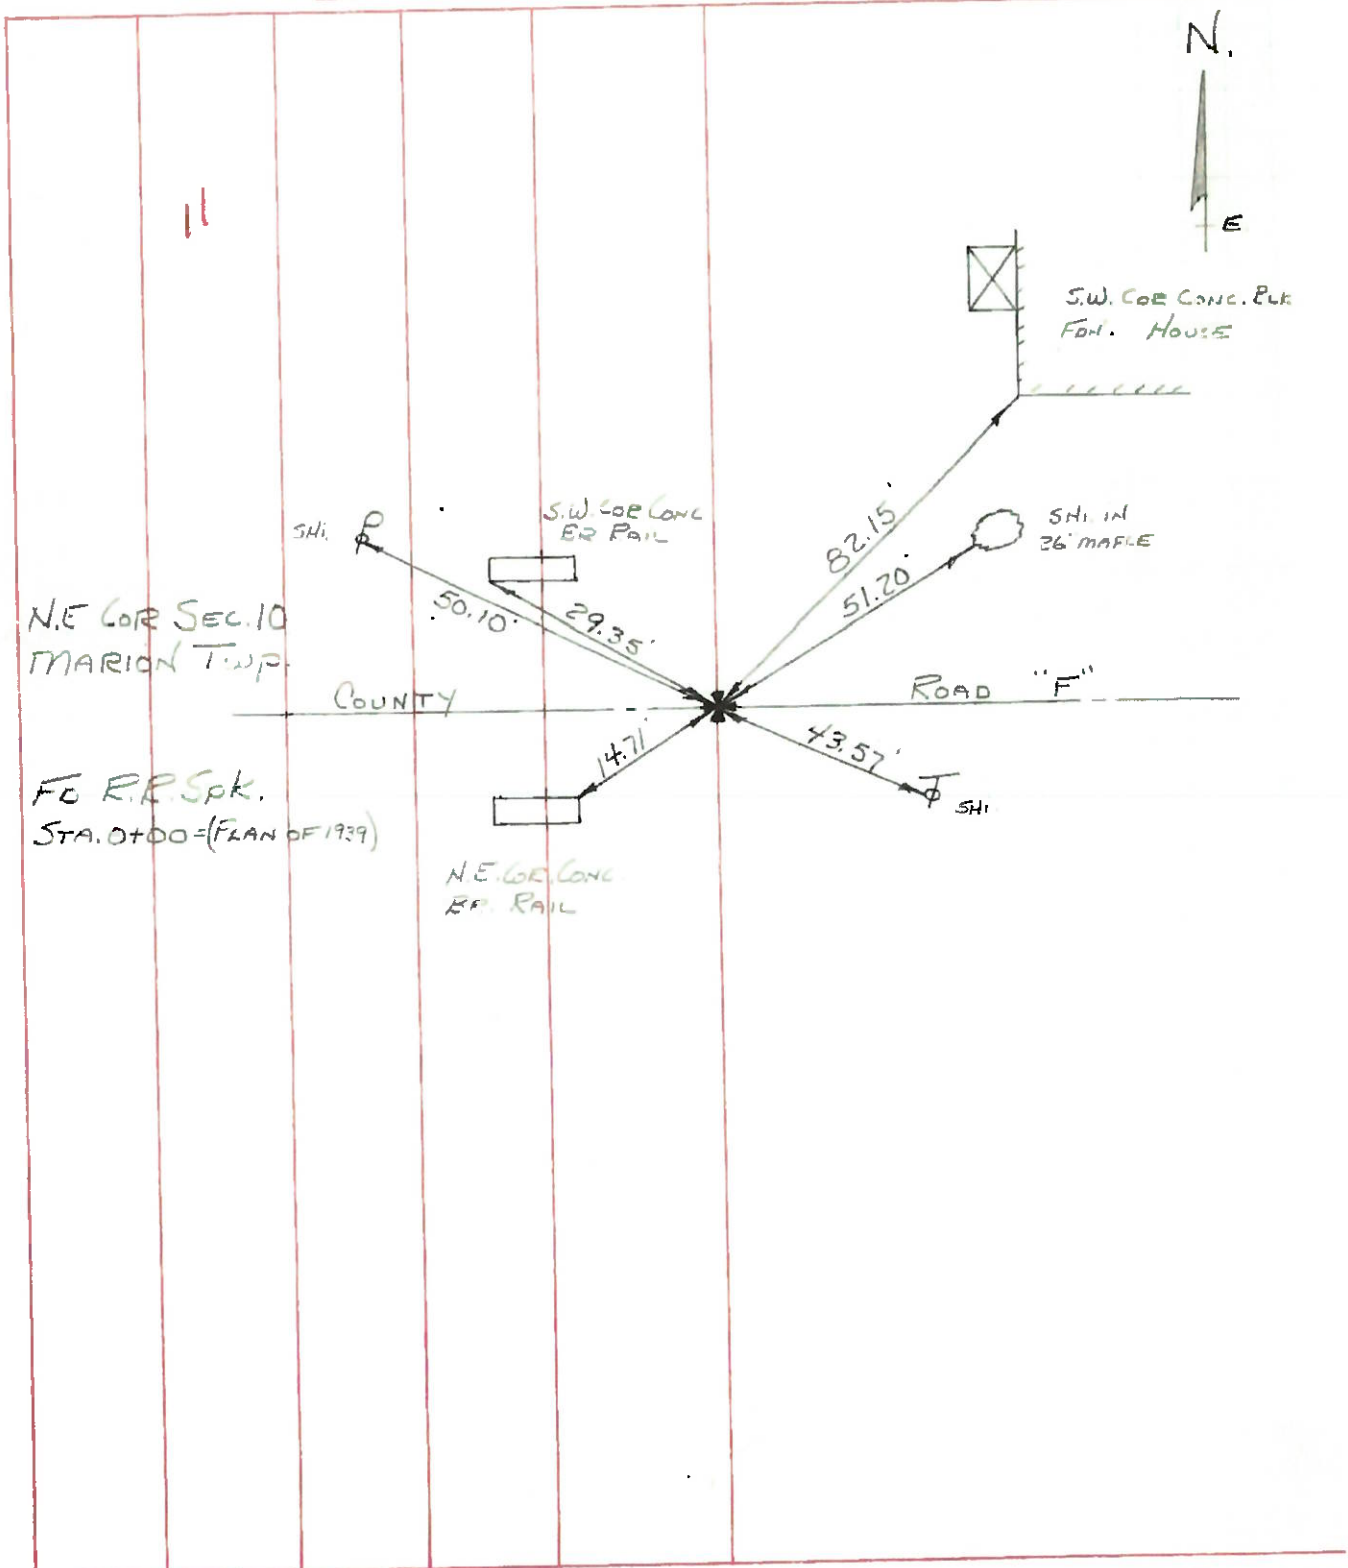PERSONNEL TITLE PERSONNEL TITLE COUNTY HENRY DATE 5-11-72BURNSIDE POWERS S. R. 18 E 5 R 109 WEATHER CLEARSEC. TEMP. +62°DESCRIPTION CONTROL POINTS NORTH OF HAMLER JOB NO.

PERSONNEL TITLE PERSONNEL TITLE

COUNTY Henry DATE 2-5-58
10-25-60S. R. #107 WEATHER

SEC. TEMP.

DESCRIPTION Hambler JOB NO.

LEFT

CENTER LINE

RIGHT

9

#58 Iron Pipe Conc. Part 32.06 32.28' S.W. "X" Retaining Wall
NE Cor Sec. Fd. Iron Rod 4" 34.95' S.S.W. "X" "
#15 Marion Twp. below Surface 25.70 25.48' N.E. "X" Top curb ✓
W. Chape 25.82 25.80' N.W. "X" "
73.35 73.10' N.W. Cor. Res.

10

#59 3/4" Iron Pipe in Part 63.67 64.00' S.W. N.E. Cor. House Fdn.
E 1/4 Sec 10 (Ruffer) 56.45 20.00' W. Spk. P. Pole ✓
Marion Twp. 40.60 56.60' N.W. S.E. Cor. House Fdn.
S.S.W. Top ctr. Fire Hyd.

11

#60 3/4" Iron Pipe 15.21 15.25' S.W. S.E. Cor. S. Bridge Rd.
NE Cor Sec (Ruffer) 23.45 23.37' N.W. N.E. Cor. N. " "
#10 Marion Twp. 82.30 82.05' N.E. S.W. Cor. House Fdn.
51.20 N.E. Shi. 20" Maple ✓
43.09 S.E. Shi. T. Pole
50.10 N.W. Shi. P. Pole