

O.D.O.T. DISTRICT 2 SURVEY OFFICE (USE ONLY)

PERSONNEL

REFERENCE NO. 11 A

SHEET 18 OF 25

NOTES CANTERBURY

DATE 8/18/98

ROUTE SR 109

H.C. ROUSOS

WEATHER PTLY CLOUDY

COUNTY HENRY

R.C. BARNHIESEL

TEMP. 80°

TOWNSHIP MARION

SECTION 3

DWG BY GARRETT PID PAVE TRAIN

T 3 N R 7 E

TYPE MONUMENT RR SPK IN WOOD HUB

~~ON SURFACE~~ - BELOW 2"

OFFSET Q PAVEMENT 20.3' LT : ~~RT~~

10' TO LT EDGE PAVEMENT


STATION: 565+27

HORZ.DATUM: _____

GEOID: _____


GRID: NORTHING: _____

EASTING: _____

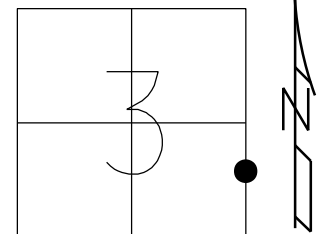

RECORD:
FND SM RR SPK 5-98
FND SMALL RR SPK SET IN
WOOD HUB 2" BELOW SURFACE
10' W OF W E.P. E 20.3' W.
OF Q PVMT. SR 18/109

D.N.F. - 10/4/24

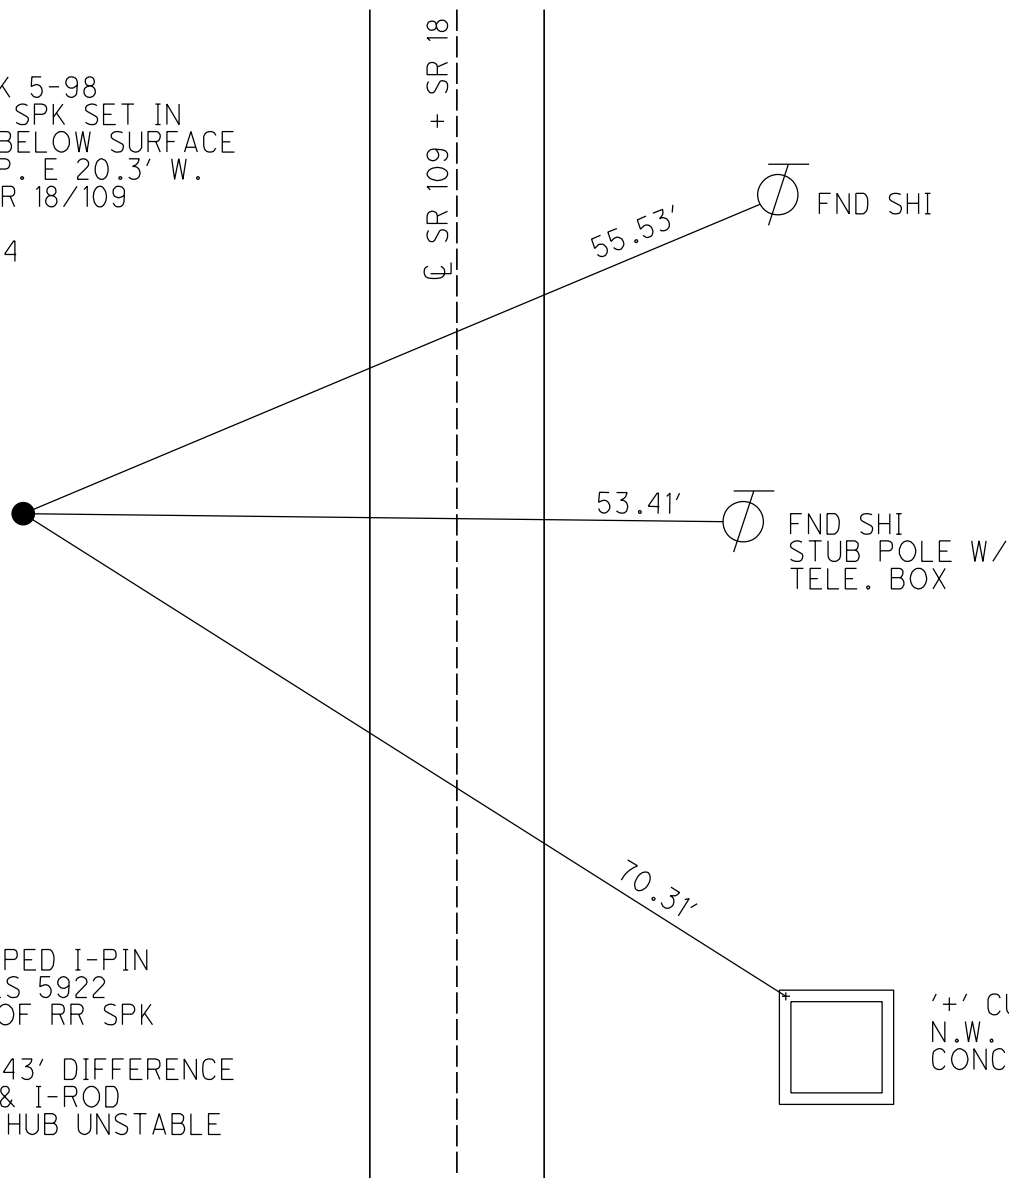

NOTE:
ALSO FND CAPPED I-PIN
STAMPED # RLS 5922
3.5" TO N.E. OF RR SPK

THERE IS A 0.43' DIFFERENCE
BETWEEN SPK & I-ROD
SMALL SPK IN HUB UNSTABLE

'+' CUT ON
N.W. COR.
CONC. CB

O.D.O.T. DISTRICT 2 SURVEY OFFICE (USE ONLY)

PERSONNEL	REFERENCE NO.	11 A	SHEET	18	OF	26
NOTES	CANTERBURY	DATE	08-18-1998	ROUTE	SR 109	
H.C.	ROUSOS	WEATHER	PRTLY CLDY	COUNTY	HENRY	
R.C.	BARNHISEL	TEMP.	+80°F	TOWNSHIP	MARION	
				SECTION	3	
				T	3	N
				R	7	E

TYPE MONUMENT RR SPK IN WOOD HUB


~~ON SURFACE~~ - BELOW 2"

LEFT - ~~PAV'T~~ - RIGHT 20.3'

10' TO LT EDGE PAVEMENT


S.L.M. 565+27

Grid: Northing: _____ Easting: _____

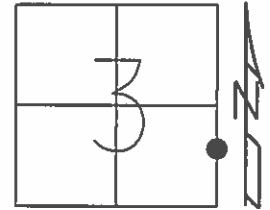

FND SM RR SPK 05-1998

REC:
FND SMALL RR SPK SET IN
WOOD HUB 2" BELOW SURFACE
10' W OF W E.P. E 20.3' W.
OF C PVMT. SR 18/109

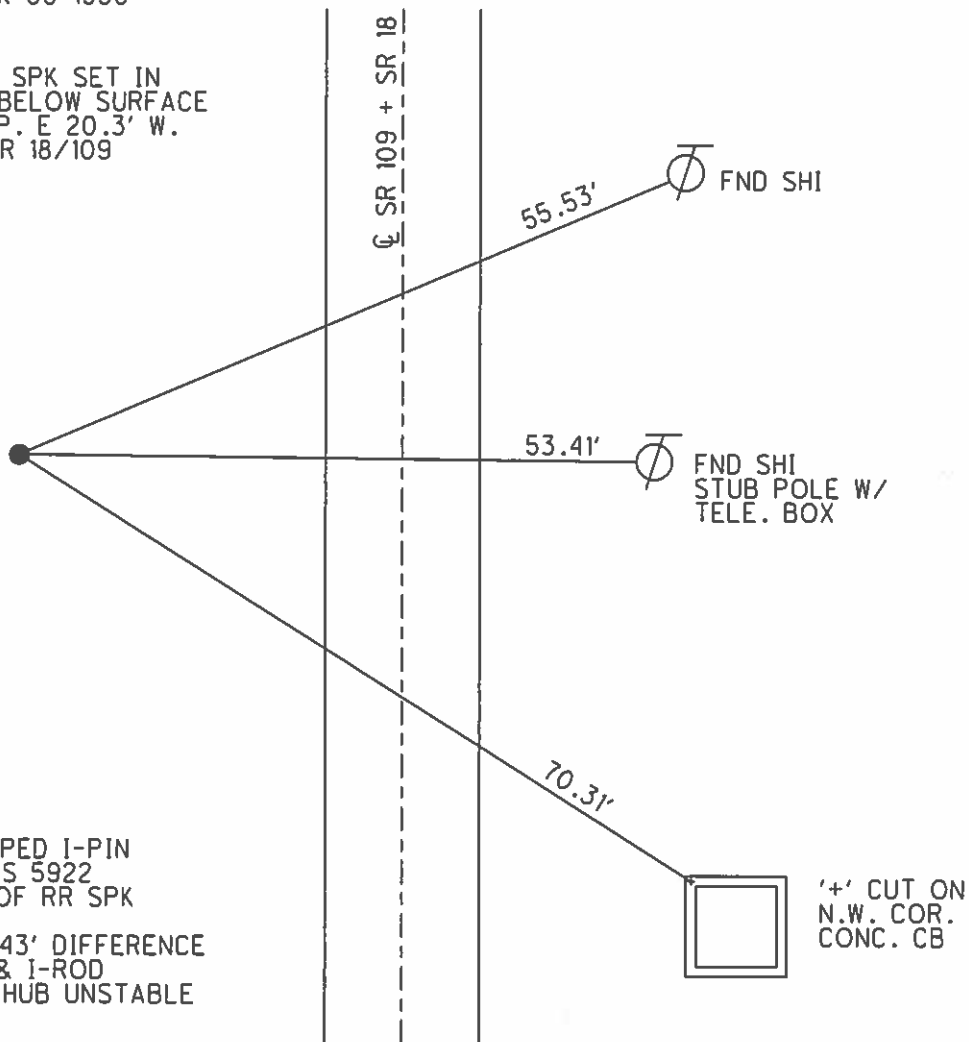

NOTE:
ALSO FND CAPPED I-PIN
STAMPED # RLS 5922
3.5" TO N.E. OF RR SPK

THERE IS A 0.43' DIFFERENCE
BETWEEN SPK & I-ROD
SMALL SPK IN HUB UNSTABLE

O.D.O.T. DISTRICT 2 SURVEY OFFICE

PERSONNEL

REFERENCE NO. 11A

SHEET 14 OF 21

NOTES Canterbury

H.C. Rousar

R.C. Barnhill

DATE 8-18-98

WEATHER Partly Cldy

TEMP. +80°F

ROUTE SR 109 + 18

COUNTY Henry

TOWNSHIP Marion

SECTION 3

T 3 N R 7 E


TYPE MONUMENT Sm. RR spike in wood hub

~~ON SURFACE~~ - BELOW 2" Below

LEFT- & PAV'T. ~~RIGHT~~ 20.3' W of E

10' ETO W EDGE PAVEMENT

S.L.M. 17 + 229 SLM (MEASURED STA 565+27)

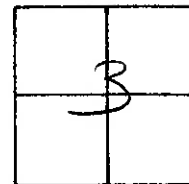

280+98/5.32

OFF PAVEMENT


Note:

Also Found capped I-pin
stamped *RLS 5922
3.5" to N.E. of RR spike

* THERE IS A 0.43' DIFFERENCE
BETWEEN SPIKE & I-ROD
- Small SPIKE IN HUB IS UNSTABLE

RECORD:

Find, Small RR SPIKE SET IN
WOOD HUB 2" Below SURFACE
10' W. OF W. E.P. & 20.3' W.
OF & Pavt. SR 18/109

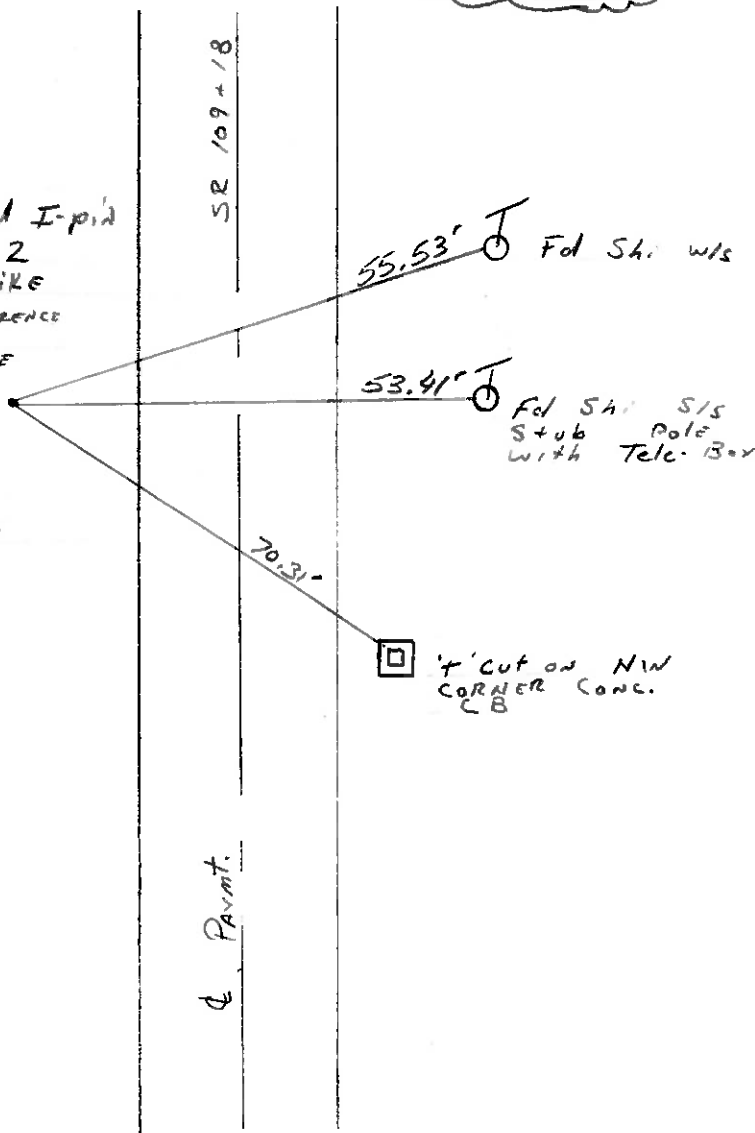

DRAWN BY TP

QD.O.T. DISTRICT 2 SURVEY OFFICE

SHEET _____ OF _____

County HENRY S.R. 18E109

Township MARION

Section 3

T3N, R7E

Personnel HOFFMAN

LOEHRKE

HOUSEHOLDER


BARNHISEL

#11-A
52109

Date 4/25/83

Weather CLEAR

Temp. +60°

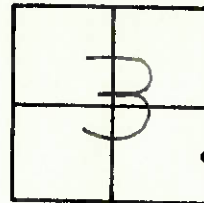

FD. SMALL R.R. SPK. SET
IN WOOD HUB 2"
BELOW SURFACE
10' WEST OF WEST. E.P. &
20.3' WEST OF & PAVE.
S.R. 18/109

S.L.M. STA. 565+02±

MEASURED
STA. 565+27

