

O.D.O.T. DISTRICT 2 SURVEY OFFICE (USE ONLY)

PERSONNEL

REFERENCE NO. 13

SHEET 20 OF 25

NOTES CANTERBURY

DATE 8/18/98

ROUTE SR 109

H.C. ROUSOS

WEATHER PRTLY CLDY

COUNTY HENRY

R.C. BARNHIESEL

TEMP. 80°

TOWNSHIP MARION

SECTION 3

DWG BY GARRETT

PID PAVE TRAIN

T 3 N R 7 E

TYPE MONUMENT STONE

~~ON SURFACE~~ - BELOW 2"

OFFSET Q PAVEMENT 19.7' LT : ~~RT~~
10' TO LT EDGE PAVEMENT


STATION: 538+71

HORZ.DATUM: _____

GEOID: _____

GRID: NORTHING: _____

EASTING: _____

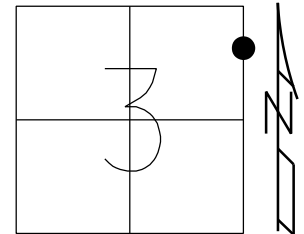

NOTE:
THERES A 8" LONG BROKE PIECE
OF STEEL TRUCK SPRING OVER
STONE 10.0' TO W EDGE OF PVT.
& HEN. 18. SLM STA. 538+69

RECORD:
D.N.F-10/4/24-JAM

FND '+' CUT
ON E FACE
COR. POST

27.41'
(D)

Q SR 109 + SR 18

59.34'



FND SHI

113.24'




FND '+' CUT ON
E SIDE CONC. CB

O.D.O.T. DISTRICT 2 SURVEY OFFICE (USE ONLY)


PERSONNEL	REFERENCE NO.	<u>13</u>	SHEET	<u>20</u>	OF	<u>26</u>
NOTES	<u>CANTERBURY</u>	DATE	<u>08-18-1998</u>	ROUTE	<u>SR 109</u>	
H.C.	<u>ROUSOS</u>	WEATHER	<u>PRTLY CLDY</u>	COUNTY	<u>HENRY</u>	
R.C.	<u>BARNHISEL</u>	TEMP.	<u>+80°F</u>	TOWNSHIP	<u>MARION</u>	
				SECTION	<u>3</u>	
				T	<u>3</u>	R
					<u>N</u>	<u>E</u>

TYPE MONUMENT STONE
~~ON SURFACE~~ - BELOW 2"
 LEFT - ~~C PAV'T~~ - RIGHT 19.7'
10.0' TO LT EDGE PAVEMENT
 S.L.M. 538+71

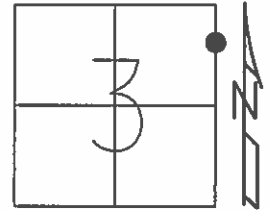

Grid: Northing: _____ Easting: _____

NOTE:
 THERES A 8" LONG BROKE PIECE
 OF STEEL TRUCK SPRING OVER
 STONE 10.0' TO W EDGE OF PVT.
 & HEN. 18. SLM STA. 538+69

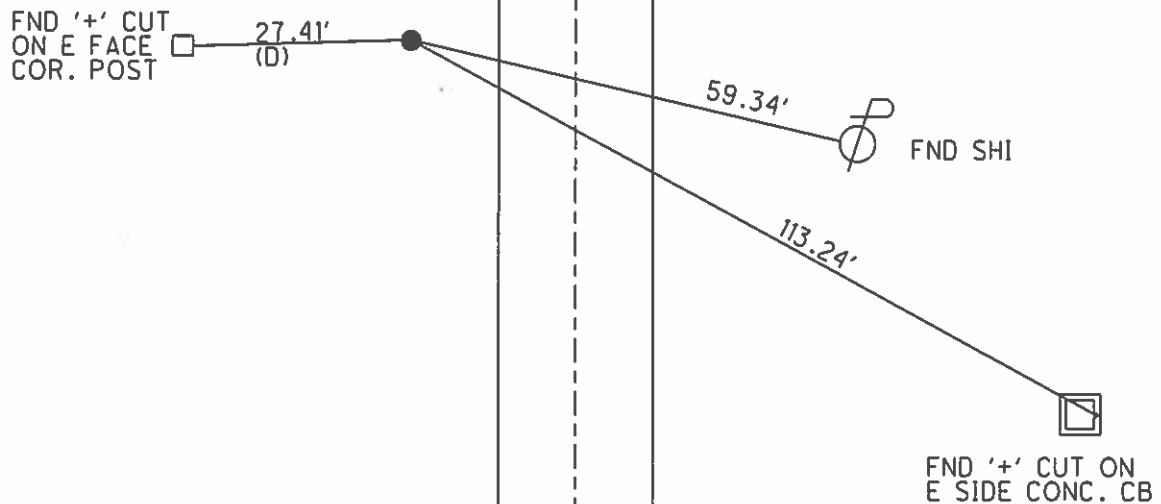

O.D.O.T. DISTRICT 2 SURVEY OFFICE

PERSONNEL

REFERENCE NO. 13

SHEET 16 OF 21

NOTES Canterbury

H.C. Rousos

R.C. Barnhisel

DATE 8-18-98

WEATHER Ptly. Cldy

TEMP. +80°F

ROUTE 109+18

COUNTY HENRY

TOWNSHIP Marion

SECTION 3

T 3 N R 2 E


TYPE MONUMENT STONE

ON SURFACE - BELOW 2" Below

LEFT - ~~C~~ PAV'T. - RIGHT 19.7' L of E Pmt

10.0' TO L EDGE PAVEMENT

S.L.M. 16+424 SLK (MEASURED Sta 528+71)

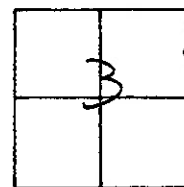

Note:

There's a 8" long Broke Piece
of Steel Truck Spring OVER Stone
10.0' TO W. EDGE OF Pmt. &
19.7' W. OF E Pmt.
HEN. 18. SLM. Sta. 528+69+

303+66/5.75

OFF PAVEMENT

FND. 4' cut
ON E. Face
Cor. Post

27.41'
(D)

59.34'

FND. Sh. 4 1/2

113.25'

FND. 4' cut on
East side CONC. CB.

L PAVMT.

DRAWN BY JR

QD.OT. DISTRICT 2 SURVEY OFFICE

SHEET _____ OF _____

County HENRY S.R. 18E109

Township MARION

Section 3

T3N, R7E

Personnel HOFFMAN

LOEHRKE

HOUSEHOLDER

BARNHISEL


13

S.R. 109

Date 4/25/83

Weather CLEAR

Temp. +60°

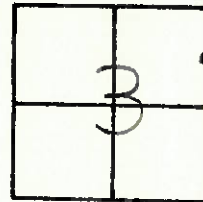

FD. STONE 2' BELOW SURFACE.
PLACED 8" LONG, BROKEN PIECE
OF STEEL TRUCK SPRING
OVER STONE.

10.0' TO WEDGE PAVE. &
19.7' WEST OF & PAVE.

HEN. 18-SLM STA 538+69±

27.41
(D)


" ON E. FACE CONC.
COR. POST.

MEASURED
STA. 538+71

59.16
SH. W/SIDE

113.77
(D)

" ON EAST SIDE
CONC. C.B.

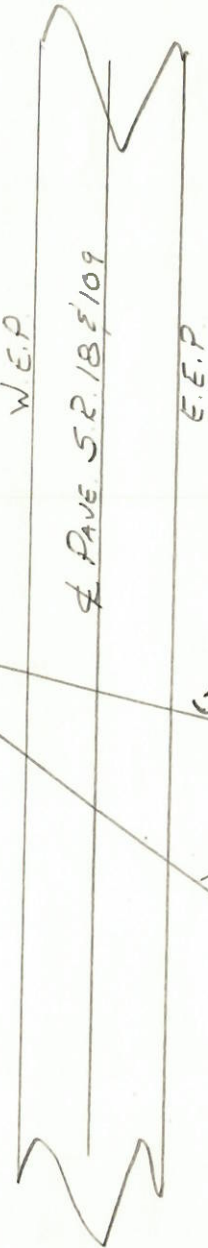

PERSONNEL TITLE PERSONNEL TITLE

Tomsic _____

Neuser _____

Granata _____

Vanya _____


COUNTY HENRY

DATE Oct. 31, 1975

S. R. 109 WEATHER _____

SEC. 17.7 R 101 TEMP _____

DESCRIPTION _____ JOB NO. _____

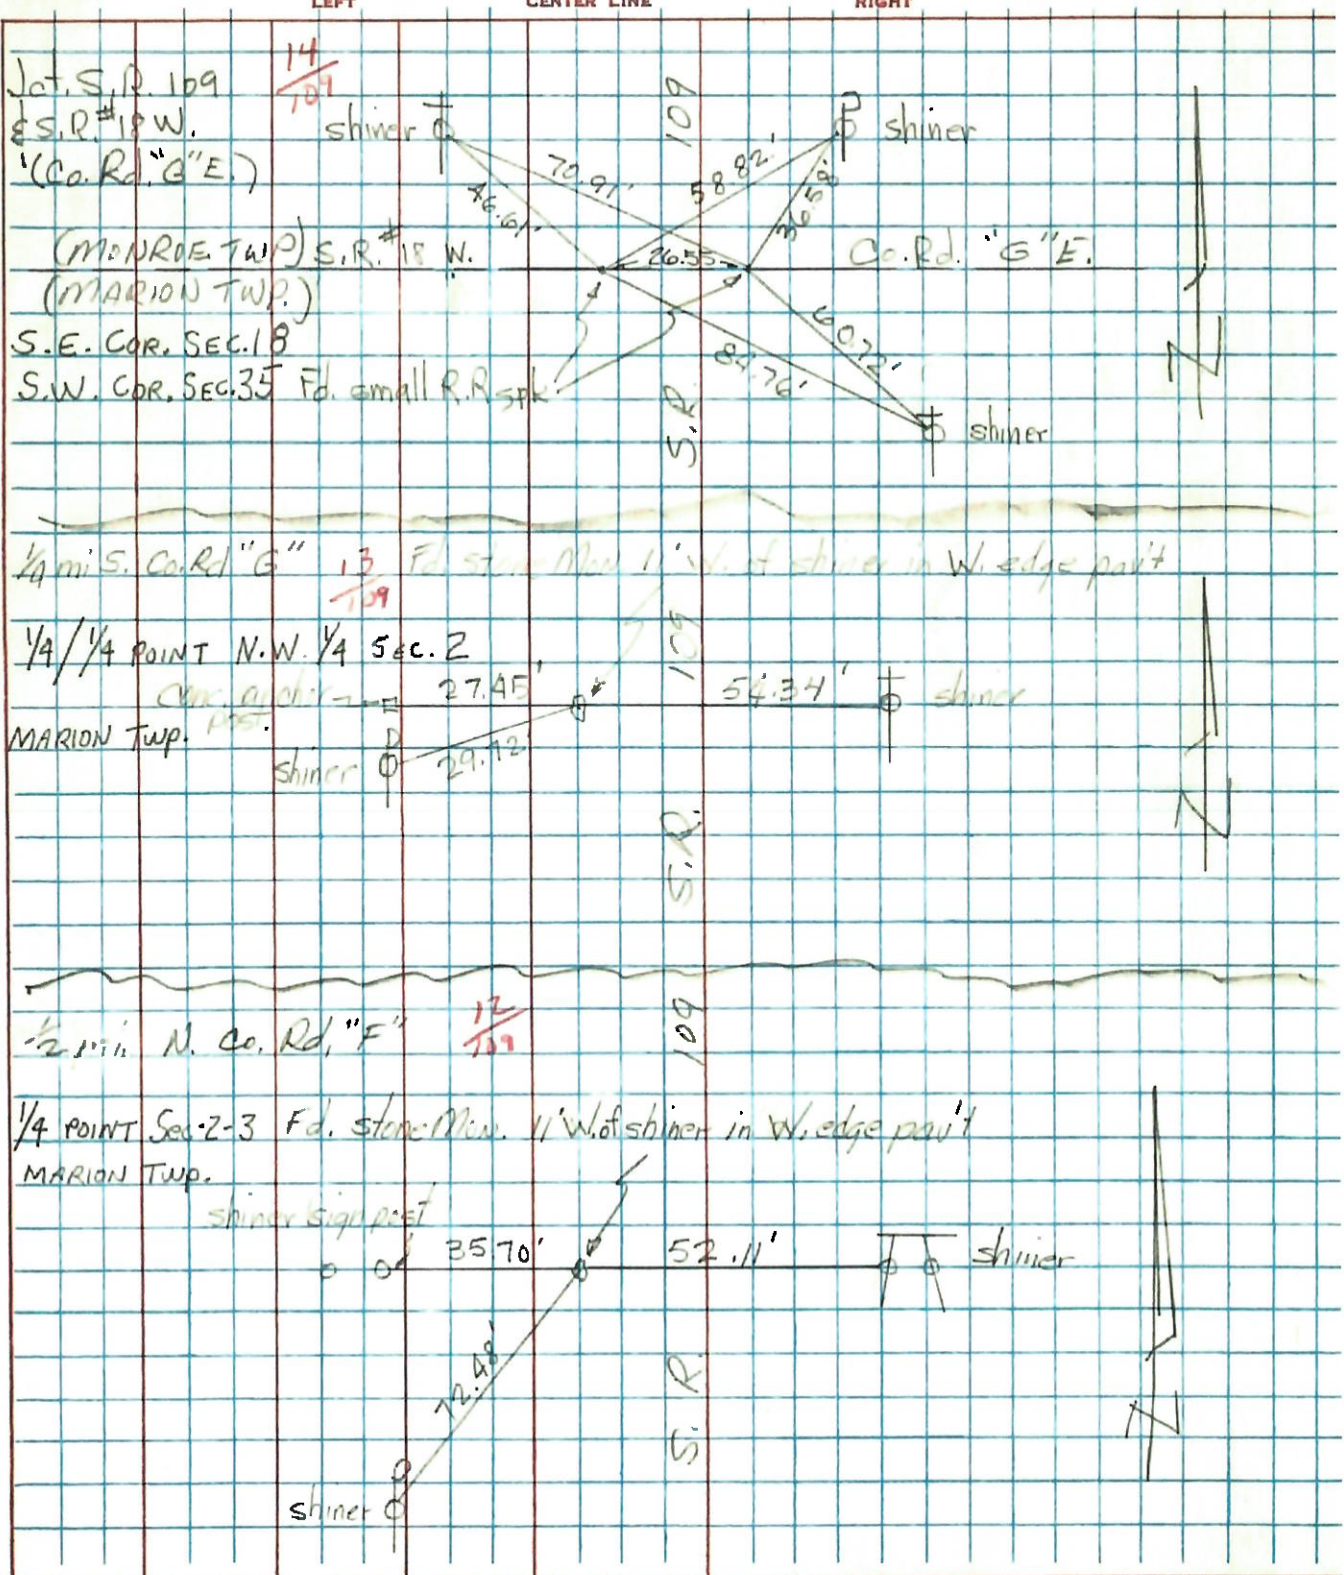

SHEET NO. 3

PERSONNEL TITLE PERSONNEL TITLE

BURNSIDECOUNTY HENRYDATE 5-11-72POWERSS. R. 185°109WEATHER CLEAR

SEC. _____

TEMP. _____

DESCRIPTION CONTROL POINTSNORTH OF HAMLER

JOB NO. _____

LEFT

CENTER LINE

RIGHT

13

E 1/4 COR. OF THE N.E. 1/4
SEC. 3
MARION TWP.

FOUND STONE ON
LINE 10' W. OF W.
EDGE PAVEMENT
NO ANGLE
STA. 39+52.7 (PLAN OF 1939)

4" EAST SIDE CONC.
COR. PCT



27.42'

54.27

29.63'

141.85

SHI.

SHI.

SHI.



PERSONNEL	TITLE	PERSONNEL	TITLE	COUNTY	DATE
				Henry	
				S. R. #109	WEATHER
				SEC.	TEMP.
					JOB NO.

DESCRIPTION	LEFT	CENTER LINE	RIGHT
-------------	------	-------------	-------

12

#61 Stone on fence line
E 1/4 Sec. #3
Marion, Twp.

54.64 E. Bolt in stump
51.70 E. Spk. in Tele. Pole
28.84 W. Spk. in Cor. Post

13

#62 Stone on fence line
E 1/4 of N.E. 1/4
Sec. #3 Marion, Twp.

55.65 N.E. 1st Post N. Cor. As
55.20 E. Spk. Cor. Post
28.84 S.W. Spk. P. Pole

14

NE. Cor. Sec. #3 Marion, Twp.
#63 Iron bolt in Post
36.87 E. to Shiner Post
10.73 S.W. to Shiner Post
10.08 S.E. to Shiner Post
23.53 W. to Bolt in Cor. Post
21.80 S.W. to Shiner Post
37.85 N.W. to Shiner Post

57.46 N.W. to N.E. Cor. of N.
Bridge Rail.
52.40 S.W. to N.E. Cor. of S
Bridge Rail.
26.58 Distance between
Stones S. Monroe Twp.
37.85 N.W. to S.E. cor. of
N. Bridge Rail
30.11 S.W. to N.E. cor. of
S. Bridge Rail.