

O.D.O.T. DISTRICT 2 SURVEY OFFICE (USE ONLY)

PERSONNEL

REFERENCE NO. 14

SHEET 21 OF 25

NOTES BARRIERE
H.C. MILLER
R.C. BARRIERE

DATE 10/4/24
WEATHER CLEAR
TEMP. 75°

ROUTE SR 109
COUNTY HENRY
TOWNSHIP MONROE
SECTION 34
T 4 N R 7 E

DWG BY BARRIERE PID 99587

TYPE MONUMENT MAG NAIL/WASHER

ON SURFACE - BELOW ON

OFFSET $\varnothing$ PAVEMENT LT : RT

 TO EDGE PAVEMENT

STATION: 317+60

HORIZ.DATUM: OHIO LDP (HENRY)


GEOID: 18

GRID: NORTHING:

EASTING:


LDP: NORTHING: 438673.08

EASTING: 181496.917

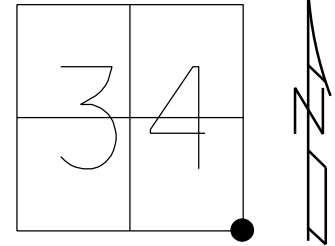

RECORD:
FD SM.R.R.SPIKE
5/18/98, MC
SET P.K./WASHER
9/24/98, MB
FD P.K./WASHER
1/10/07, SAH
6/27/08, KPM
FD SM.R.R.SPIKE
1" DOWN
6/20/16
11/13/17, JFO
FD LG.R.R.SPIKE
1" DOWN
REF14
6/9/20, JFO
3/12/21
1/11/23, JMR
SET MAG/WASHER
10/4/24, JAM

NOTE: REF 20B SR 18

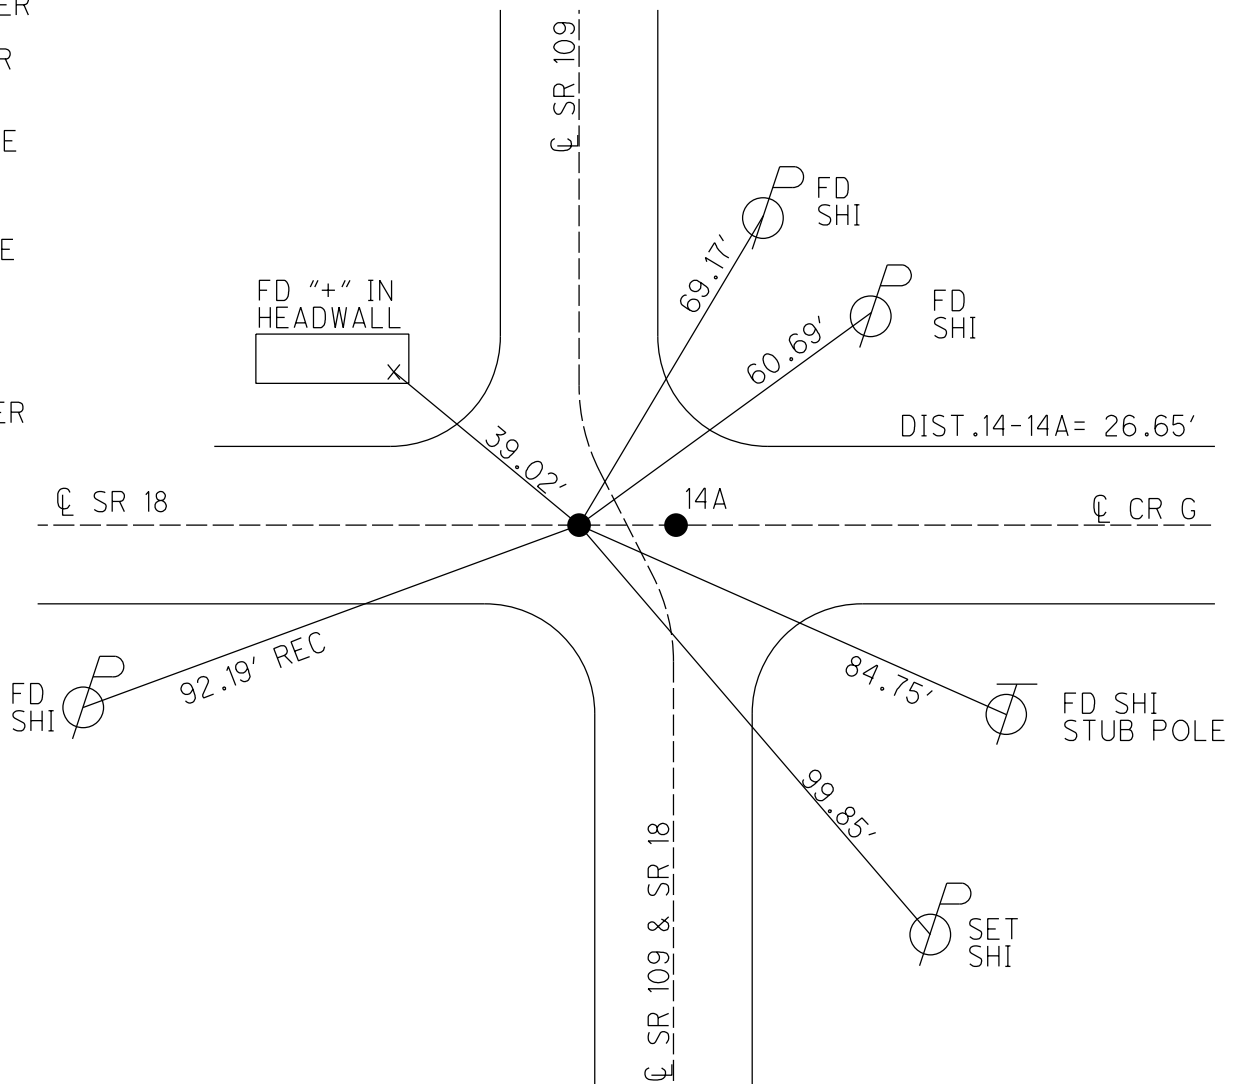

O.D.O.T. DISTRICT 2 SURVEY OFFICE (USE ONLY)

PERSONNEL _____ REFERENCE NO. 14 SHEET 21 OF 25
NOTES NIESE DATE 3/12/21 ROUTE SR 109
H.C. RHOADES WEATHER SUNNY COUNTY HENRY
R.C. _____ TEMP. 50° TOWNSHIP MONROE
DWG BY NIESE PID PAVE TRAIN SECTION 34
T 4 N R 7 E

TYPE MONUMENT LG.R.R.SPIKE

~~ON SURFACE~~ - BELOW 1"

OFFSET Q PAVEMENT 20.5' LT : ~~RT~~

- TO - EDGE PAVEMENT


STATION: 317+60

HORIZ.DATUM: NAD83(2011)

GEOID: NAVD88 2012A


GRID: NORTHING: 582031.179

EASTING: 1546046.403

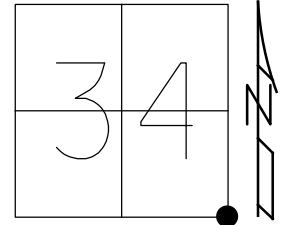

RECORD:
FD SM.R.R.SPIKE
5/18/98, MC
SET P.K./WASHER
9/24/98, MB
FD P.K./WASHER
1/10/07, SAH
6/27/08, KPM
FD SM.R.R.SPIKE
1" DOWN
6/20/16
11/13/17, JFO
FD LG.R.R.SPIKE
1" DOWN
REF14
6/9/20, JFO
3/12/21
1/11/23, JMR

NOTE: REF 20B SR 18

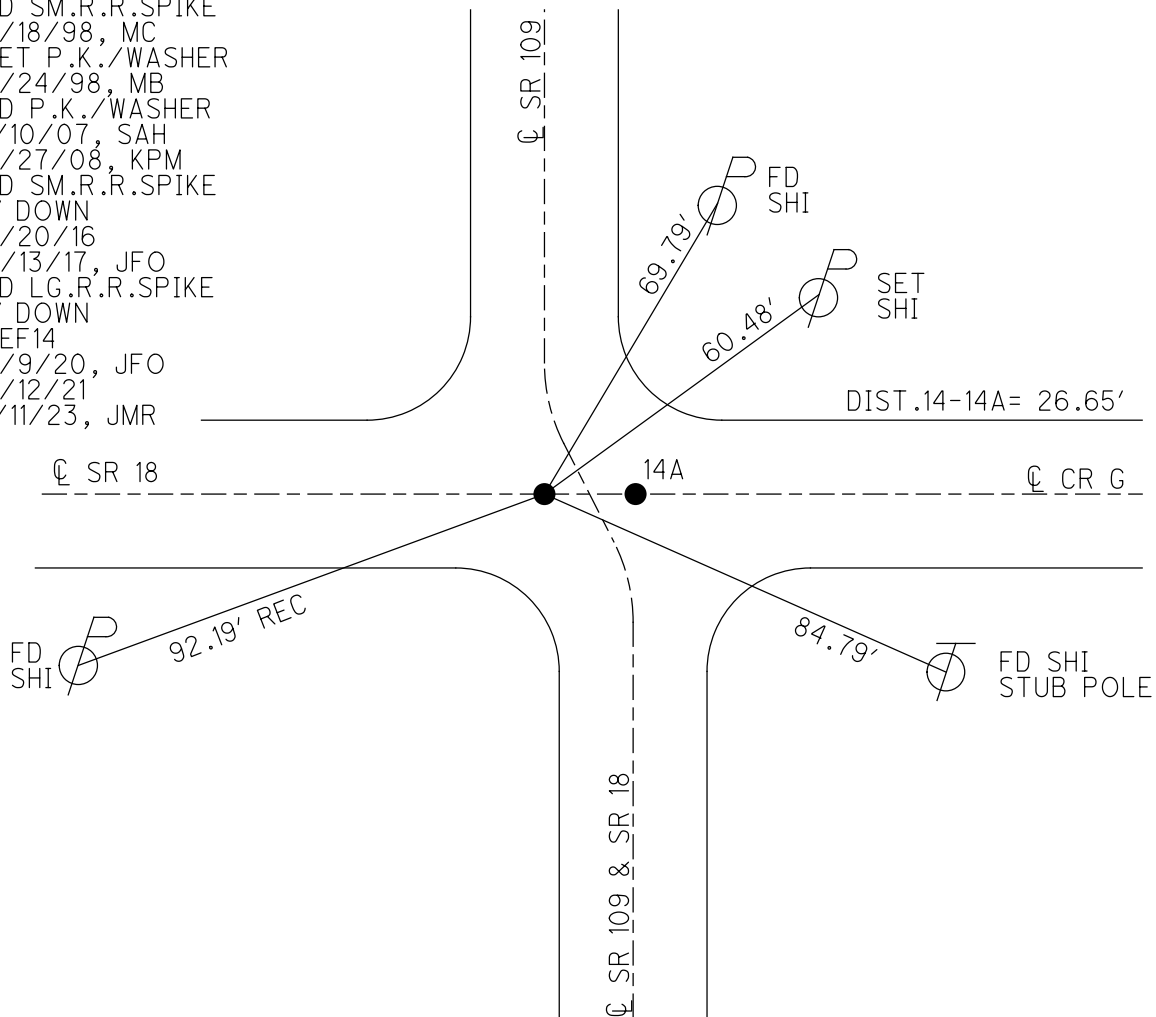

O.D.O.T. DISTRICT 2 SURVEY OFFICE (USE ONLY)

PERSONNEL

REFERENCE NO. 14

SHEET 21 OF 25

NOTES NIESE

DATE 3/12/21

ROUTE SR 109

H.C. RHOADES

WEATHER SUNNY

COUNTY HENRY

R.C.

TEMP. 50°

TOWNSHIP MONROE

DWG BY NIESE

PID PAVE TRAIN

SECTION 34

T 4 N R 7 E

TYPE MONUMENT LG.R.R.SPIKE

~~ON SURFACE~~ - BELOW 1"

OFFSET CL PAVEMENT 20.5' LT : ~~RT~~

- TO - EDGE PAVEMENT


STATION: 317+60

HORIZ.DATUM: NAD83(2011)

GEOID: NAVD88 2012A

GRID: NORTHING: 582031.179


EASTING: 1546046.403

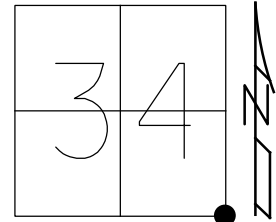

RECORD:

FD SM.R.R.SPIKE
5/18/98, MC
SET P.K./WASHER
9/24/98, MB
FD P.K./WASHER
1/10/07, SAH
6/27/08, KPM
FD SM.R.R.SPIKE
1" DOWN
6/20/16
11/13/17, JFO
FD LG.R.R.SPIKE
1" DOWN
REF14
6/9/20, JFO
3/12/21, JMR

NOTE: REF 20B SR 18

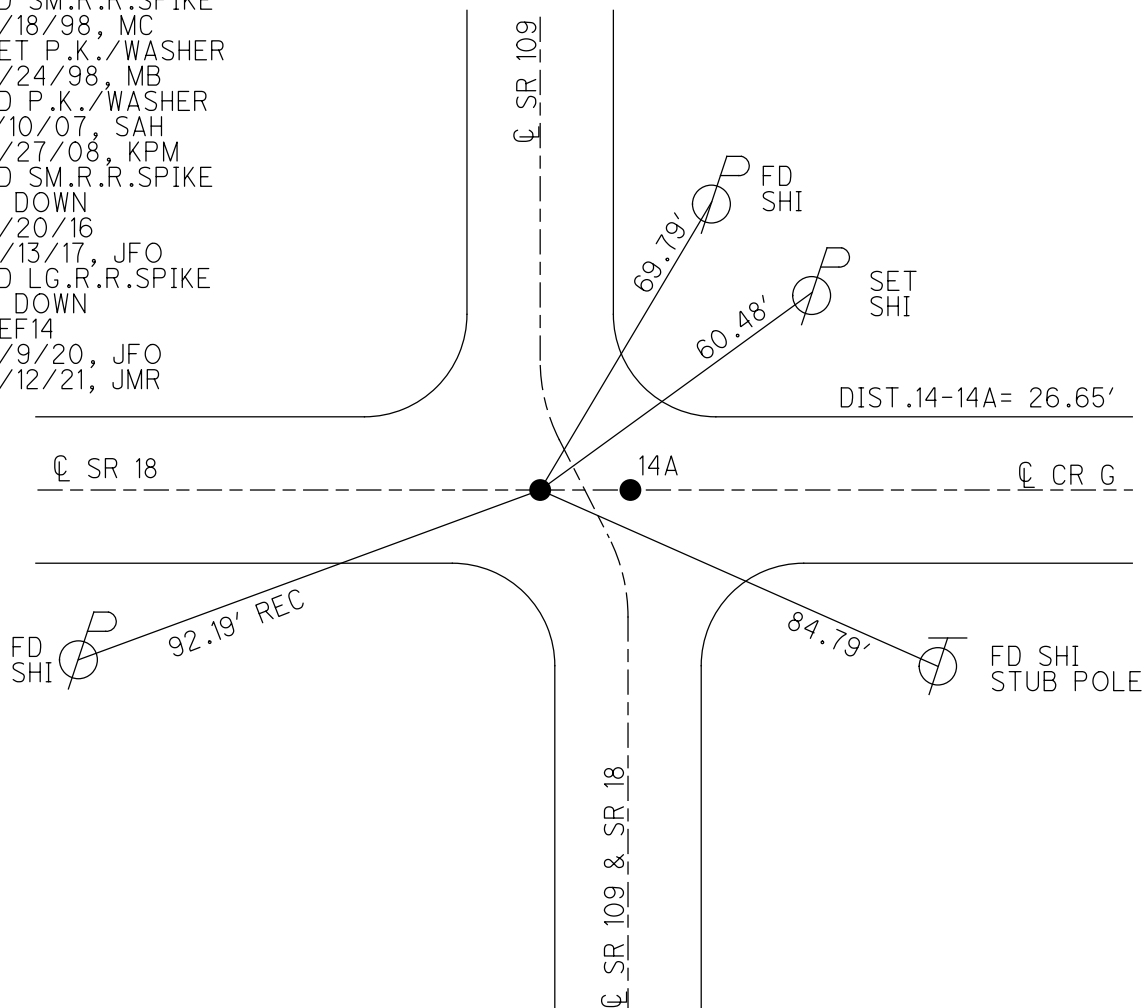


O.D.O.T. DISTRICT 2 SURVEY OFFICE (USE ONLY)


PERSONNEL	REFERENCE NO.	14	SHEET	21	OF	26
NOTES	CANTERBURY	DATE	05-18-1998	ROUTE	SR 109	
H.C.	ROUSOS	WEATHER	SUNNY	COUNTY	HENRY	
R.C.	HUSS	TEMP.	80°F	TOWNSHIP	MONROE	
				SECTION	34	
				T	4	N
				R	7	E

TYPE MONUMENT SM. RR SPK
 ON SURFACE - ~~BELOW~~ ON
 LEFT - CL PAV'T - ~~RIGHT~~ 20.5'
- TO - EDGE PAVEMENT
 S.L.M. 299+33.6

Grid: Northing: _____ Easting: _____

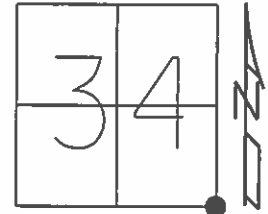

FND SMALL RR SPK @ SURFACE
 20.1' W OF CL PVMT SR109 @ S.E. CORNER
 OF SEC 34 MONROE TWP

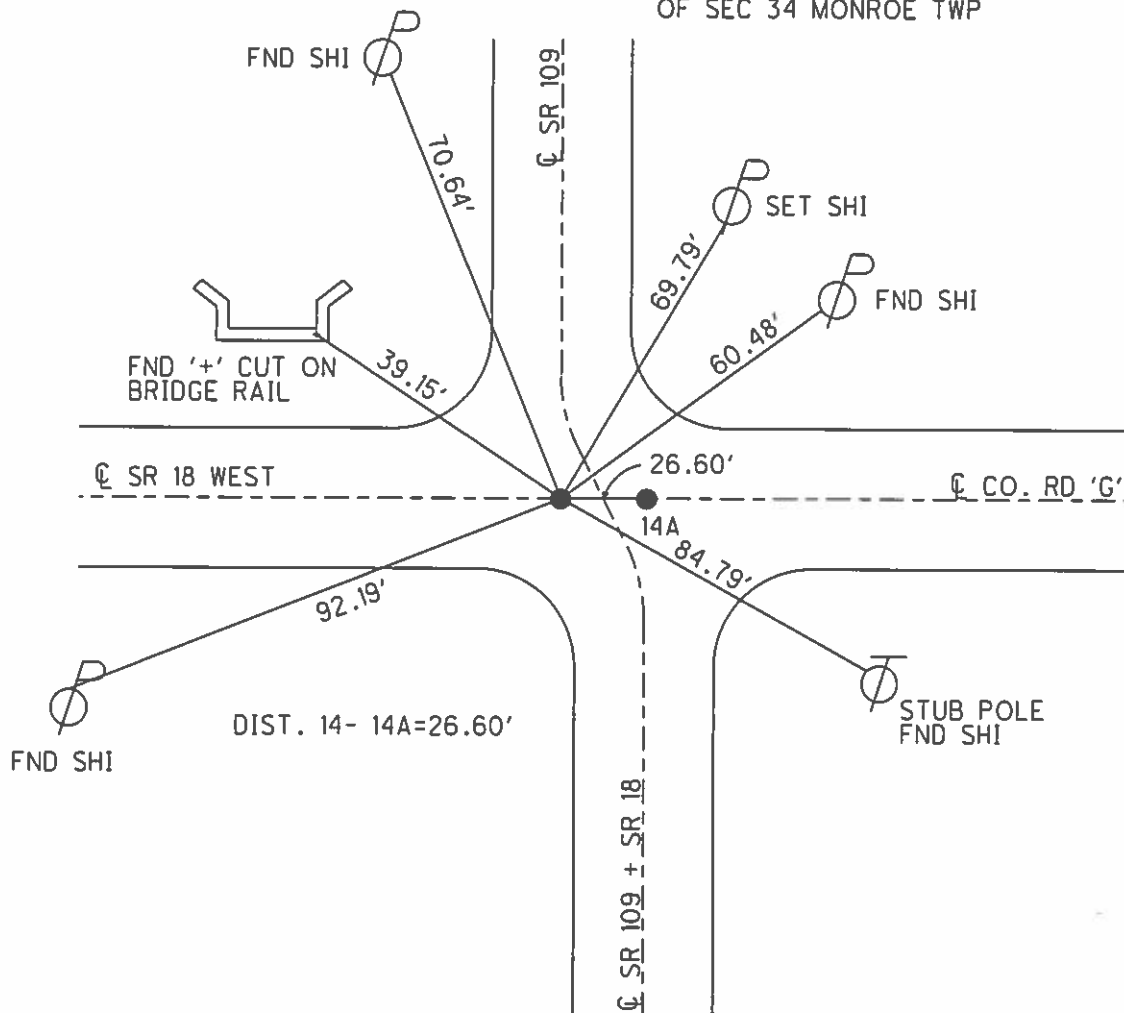

O.D.O.T. DISTRICT 2 SURVEY OFFICE

PERSONNEL

REFERENCE NO. #14

SHEET 17 OF 21

NOTES

H.C.

R.C.

Canterbury

Rouss

Huss

DATE

WEATHER

TEMP.

5-18-98

Sunny

+80°F

ROUTE SR 109

COUNTY Henry

TOWNSHIP Monroe + Marion



SECTION 34 + 3

T. R.

TYPE MONUMENT A - Sm. RR spike / B - RR spike
ON SURFACE BELOW Both on surface

LEFT - C PAV'T. - RIGHT A 20.5' Lt & Rmt B 6.5' Rt & Rmt.
TO EDGE PAVEMENT


S.L.M. SR 109 - 9 + 656 SLK / SR 18, 16 - 020 SLK

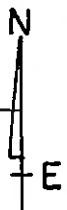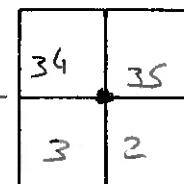

PT 'A' Fd Sm. RR spike @ surface
20.1' W of E Pavt SR 109
@ S.E. corner of SEC 34 Monroe twp

PT 'B' Fd RR spike at surface
set by county @ N.E. corner SEC 3 Marion twp
6.5' E of E Pavt SR 109

316+80 / 6.00

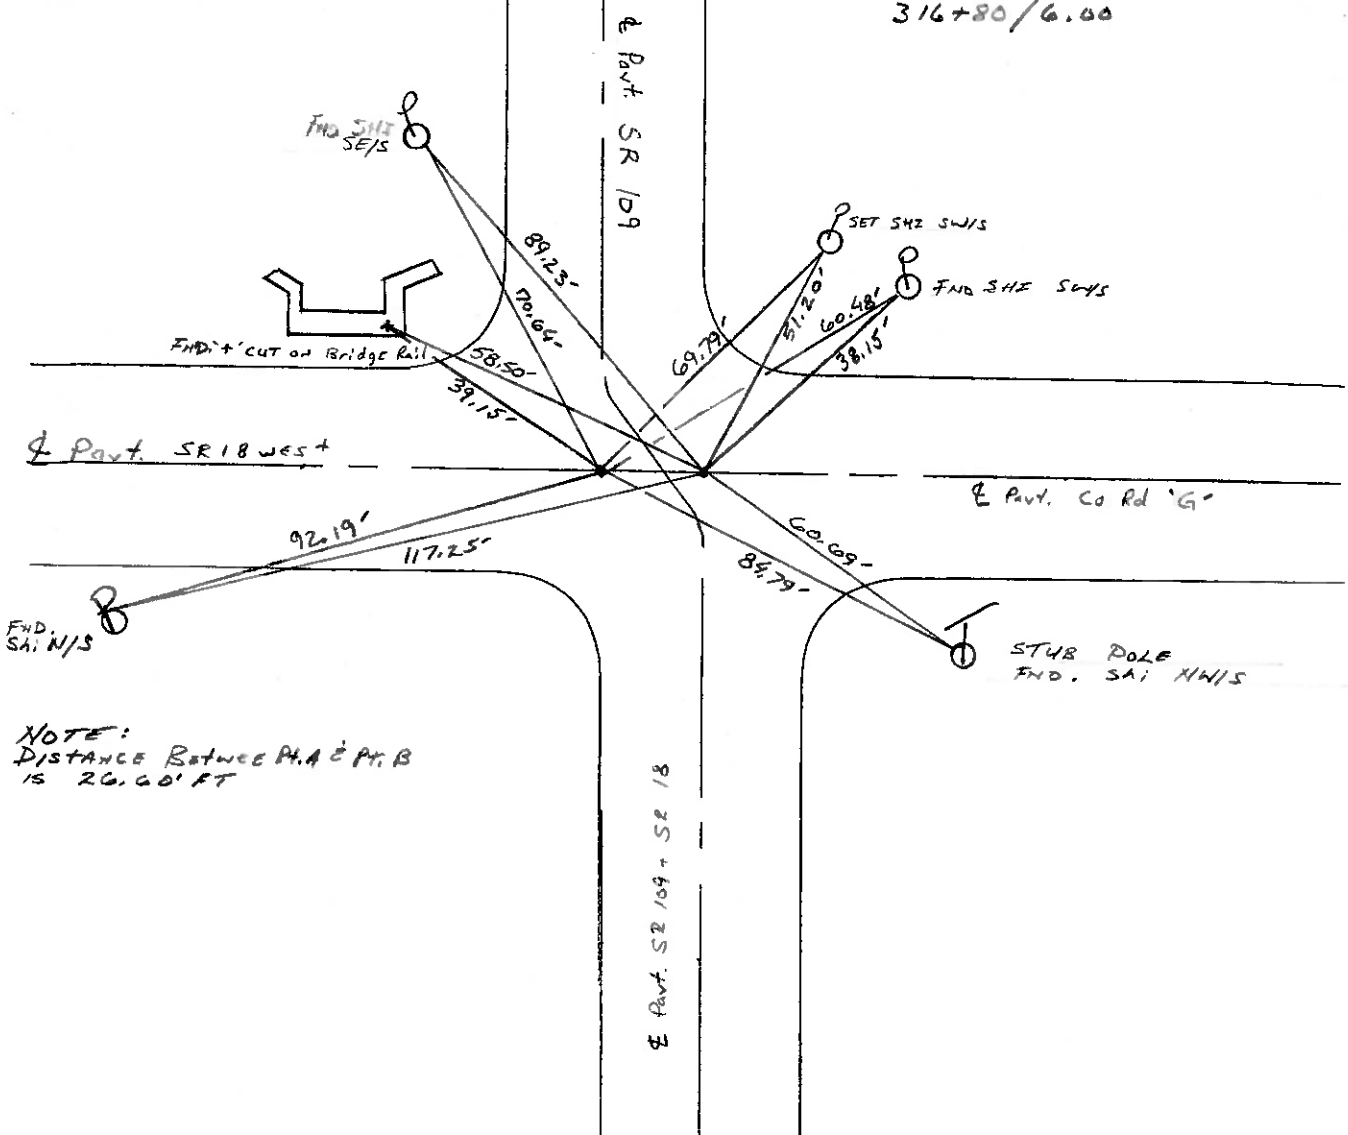

NOTE:
DISTANCE BETWEEN PT. A & PT. B
IS 20.60' FT

Q.D.O.T. DISTRICT 2 SURVEY OFFICE

SHEET _____ OF _____

County HENRY S.R. 109 & 18

Township MONROE & MARION

Section 34 & 3

T N, R E

Personnel HOFFMAN

LOHRICE


BARANISEL

#14
SR 109

Date April 26, 83

Weather Clear

Temp. +65°

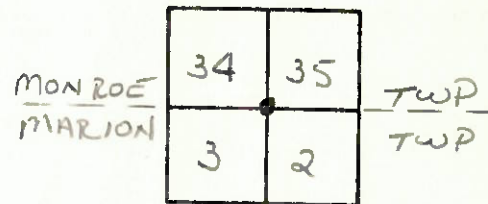

PT "A" Fd small RR spike @ surface
201.1' West of & PAUT SR 109
@ S.E. CORNER SEC. 34, MONROE TWP


PT "B" Fd RR spike @ surface
Set BY County @ N.E. CORNER
SEC 3, MARION TWP.
6.5' East of & PAUT SR 109

SLM SR 109 = 316+80

SLM SR 18 = 525+58

PT. "A" NOT COVERED
THIS PROJECT

P.T. "B" SET P.K./WASHER
9-19-83
SWH

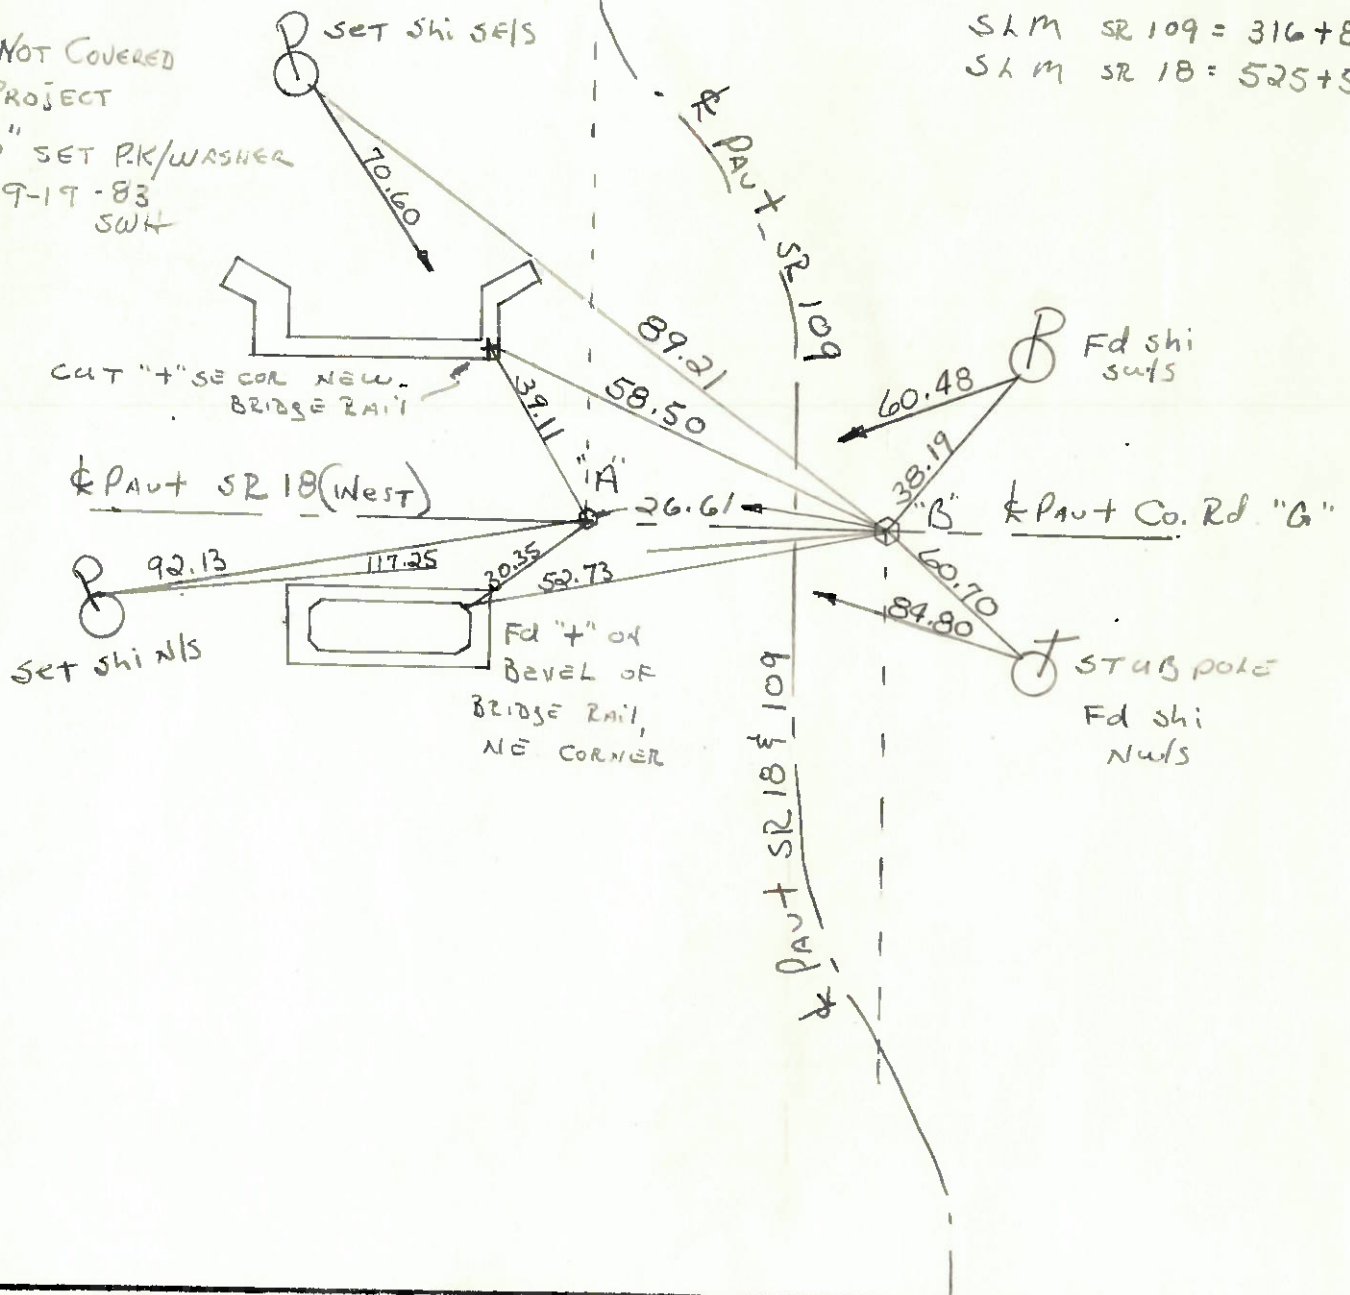

ODOT. DISTRICT 2 SURVEY OFFICE

SHEET 15 OF

County HENRY S.R. 18-109

Date 5-29-81 8-20-81

Township MARION

Weather cloudy

Section 2

Temp. +60°


T3N, R7E

Personnel S. Hoffman

#21

C. Loehrke

L. Householder

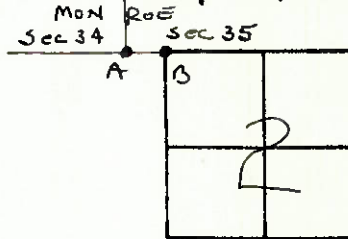


9-26-83
+65°
SW
C.L.
MB

"A" Fd. R.R. SPK @ SURFACE
FD SET SMALL R.R. SPK.
20.1 West of E Part 109
Both with 18 West

PROJECT STA ± 316+80 SL in 109

"B" Fd. R.R. SPK @ SURFACE
E of E part 109 G.S

PROJECT STA ± 525+58 SL in 18

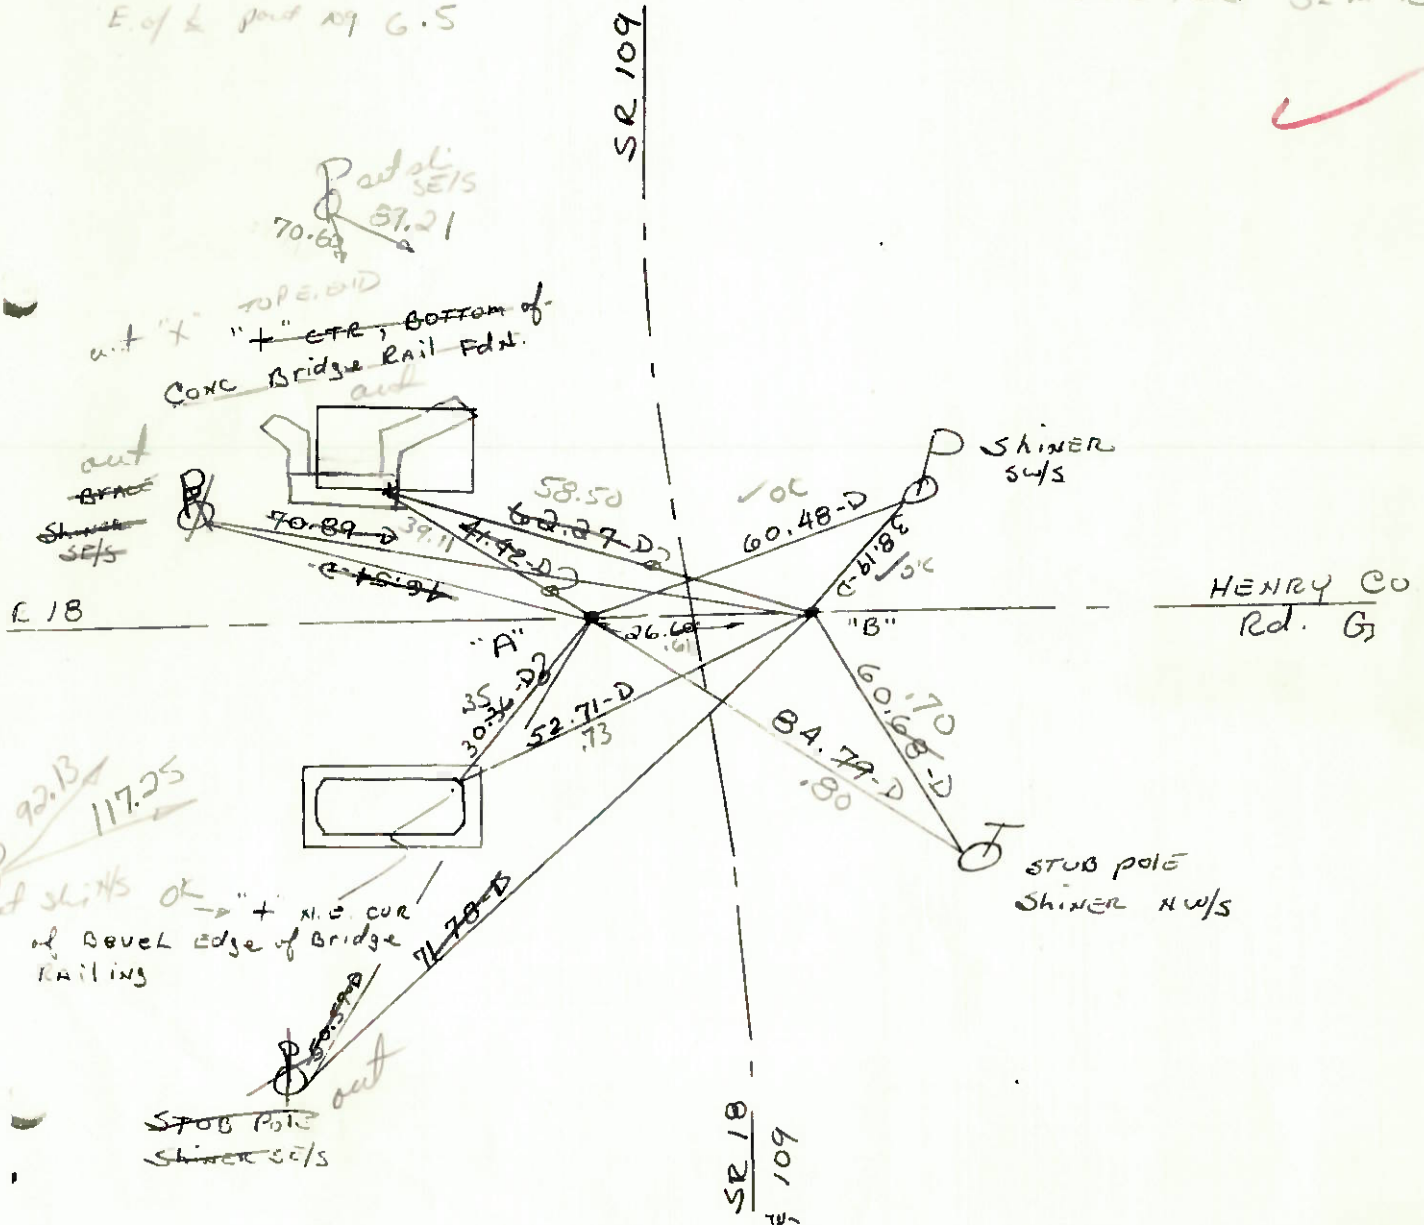

SHEET 15 OF

Date 5-29-81 8-20-81

Weather cloudy

Temp. +60°

MON RUE

Sec 34 Sec 35

A B


2

N

#21 L. Householder

PROJECT STA ±

PROJECT STA ±

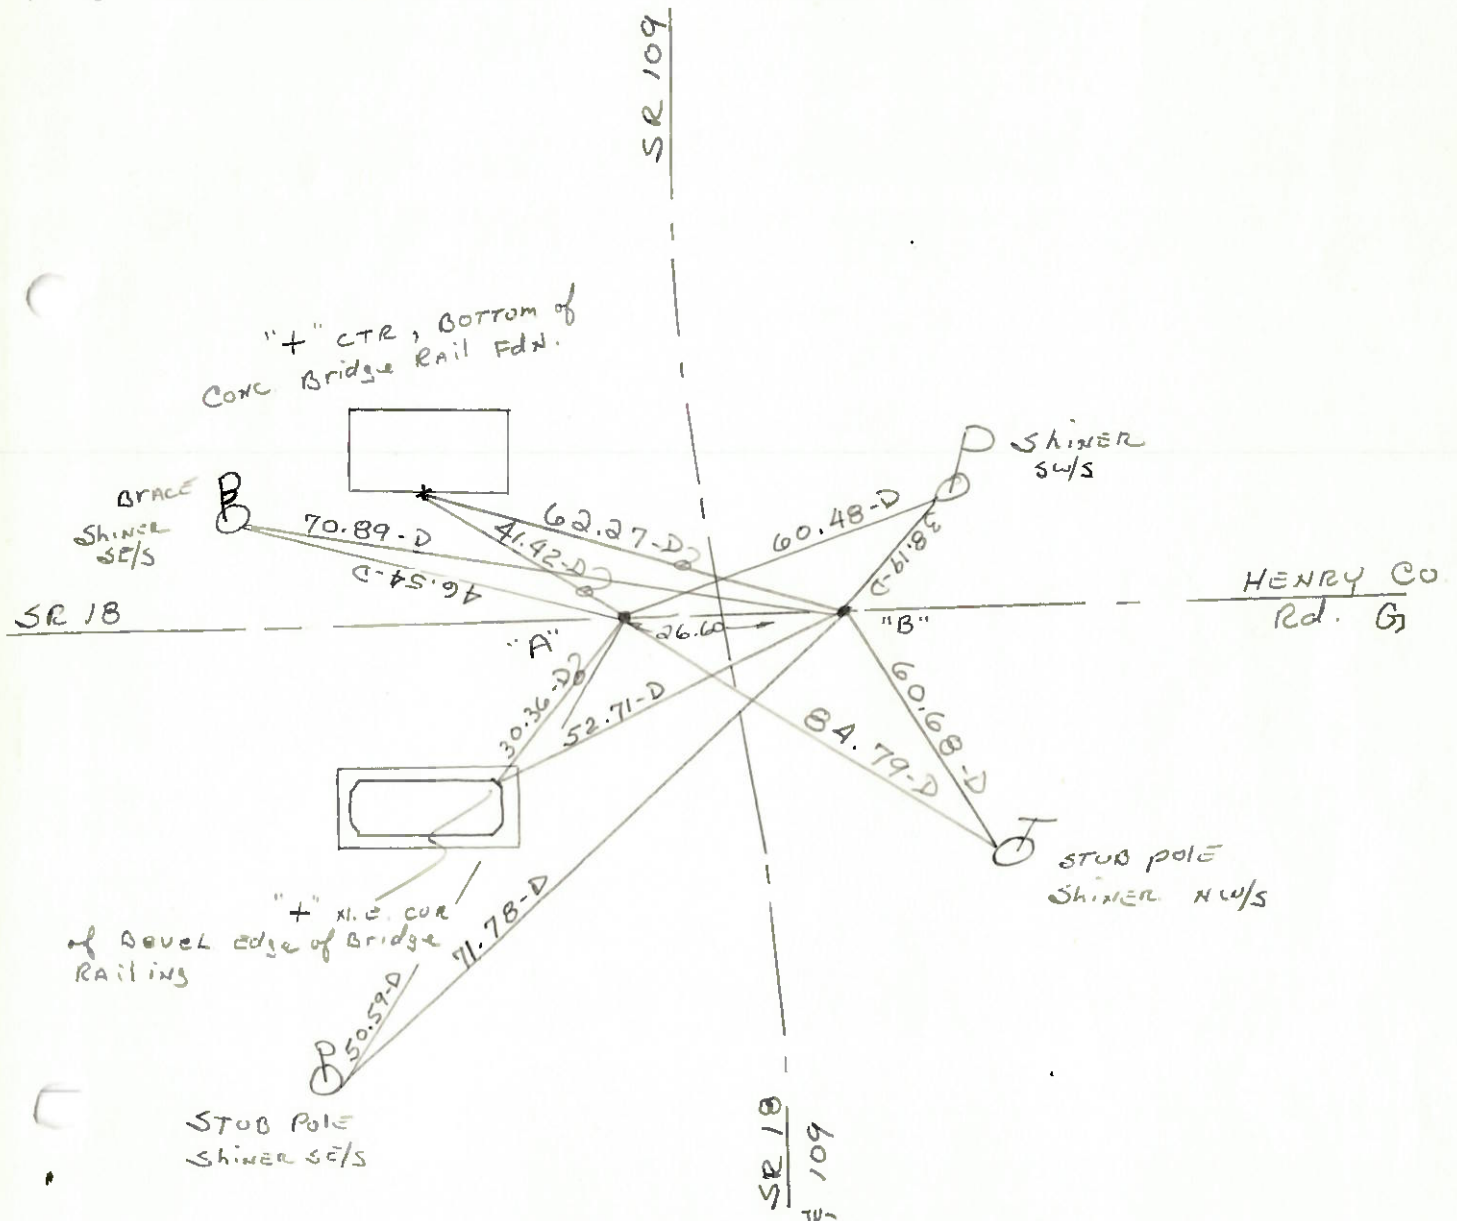

PERSONNEL TITLE PERSONNEL TITLE

Tomsic _____

Neuser _____

Granata _____

Vanya _____


COUNTY HENRY

DATE Oct. 31, 1975

S. R. 109 WEATHER _____

SEC. 17, 18, 19 TEMP _____

DESCRIPTION LEFT CENTER LINE RIGHT JOB NO. _____

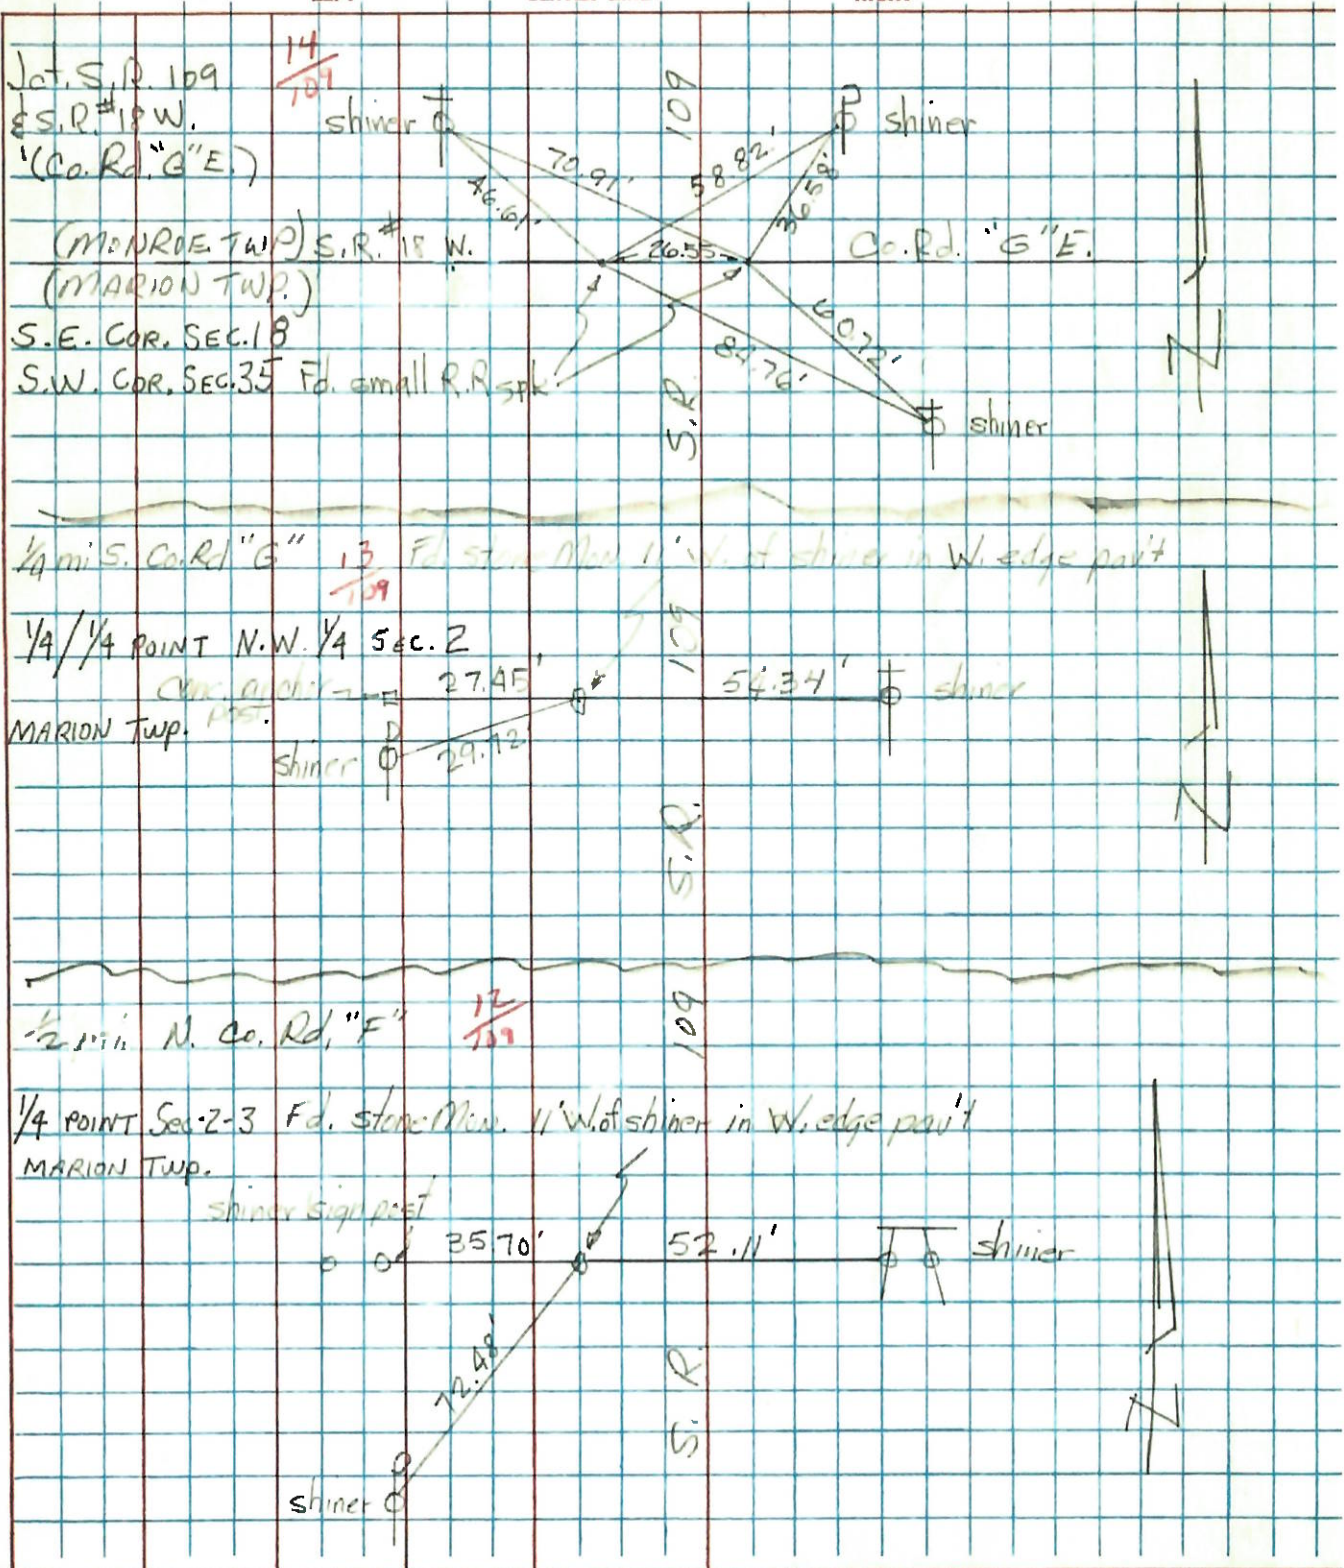

SHEET NO. 4

PERSONNEL TITLE PERSONNEL TITLE

BURNSIDECOUNTY HENRYDATE 5-11-72BOWERSS. R. 18 & 109WEATHER CLEAR

SEC.

TEMP +63°DESCRIPTION CONTROL TIES NORTH OF HAMLER

JOB NO.

LEFT

CENTER LINE

RIGHT

14
104

SEC. 34

SEC. 34
SEC. 35

SEC. 35

S.W. COR. CONC
RR RAILS.W. COR. SEC. 35
OLD TIES GOOD
SET SMALL P.R. SETSTA. 52+63.7
(PLAN OF 1929)SEC 34
SEC. 3

S.R. 18

26.53'

COUNTY ROAD "G" SEC. 35

SEC. 2

NE COR. CONC
RR RAILNE COR. SEC. 3
OLD TIES GOOD
SET SMALL P.R. SET

SEC. 3

SEC. 3
SEC. 2

SEC. 2



66.41'

44.70'

30.10'

52.36'

59.81'

36.57'

84.77'

60.73'

SHI.

SHI.


COUNTY HENRY S.R. 109

T-3-N, R-7-E

TOWNSHIP MISSION

SECTION 2

6-11-79
RW, JS, GM

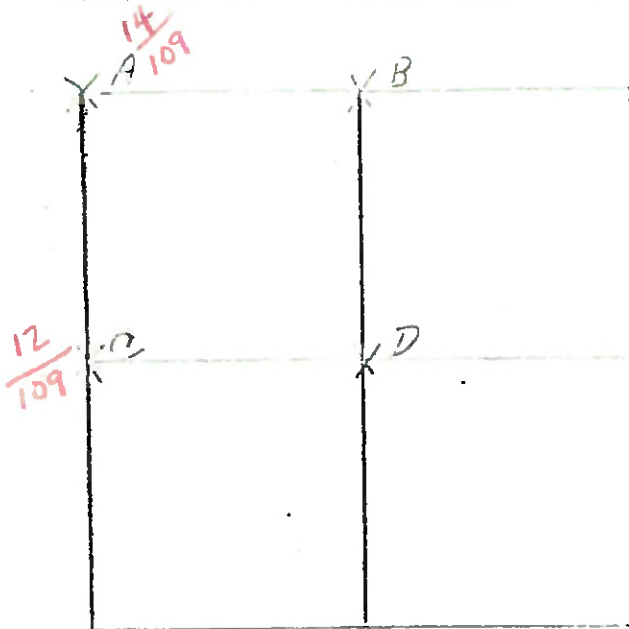

A - FOUND IRON BOLT 0.10' SOUTH
AND 0.11' WEST OF HIGH POINT
OF STONE (8"X14"X1/2") 14" BELOW
ROAD SURFACE. FOUND WOOD
STAKE ^N/₅ STONE. PLACED CENTER
PUNCHED R.R. SPIRE ON SURFACE
OVER HIGH POINT OF STONE. P.K.'S
6' NORTH AND WEST.

70.88' W.N.W. TO SHINER ^{SE}/₅ BRACE POLE
36.44' N.E. TO SHINER ^{SW}/₅ POWER POLE
60.65' E.S.E. TO SHINER ^{NW}/₅ TELEPHONE MARKER POLE
52.73' W.S.W. TO "4" N.E. CORNER CONC. BRIDGE WALL
26.60' W. TO S.W. CORNER SEC. 35, MONROE TWP.
6-11-79 RW, JT, GM

B - FOUND IRON PIN ANGLED OVER TWO STONES. STONE #1 USED
AS A BASE AND IS (10"X15"X5") 19" BELOW ROAD SURFACE. CORNER
STONE SETS ON BASE STONE AND IS (5"X8"X11") 8" BELOW ROAD
SURFACE. REMOVED IRON PIN AND PLACED CENTER PUNCHED R.R. SPIRE
ON SURFACE 0.49' SOUTH OF HIGH POINT OF STONE ON SOUTH LINE OF
SEC. 35; MONROE TWP. P.K.'S 16' N.E. W. STONE IS 8.9' S. OF N. EDGE
OF 18' PAVEMENT
43.97' N.W. TO SPIRE ^S/₅ TELEPHONE POLE
39.25' S.S.E. TO DUPLEX ^W/₅ POWER POLE
45.35' S.W. TO IRON PIN ON SOUTH DITCH BACK
34.30' W. TO S ¹/₄ POST SEC. 35, MONROE TWP.

PERSONNEL	TITLE	PERSONNEL	TITLE	COUNTY	DATE
				Henry	
				S. R. #109	WEATHER
				SEC.	TEMP.
					JOB NO.

DESCRIPTION	LEFT	CENTER LINE	RIGHT
-------------	------	-------------	-------

12

#61 Stone on fence line
E 1/4 Sec. #3
Marion, Twp.

54.64 E. Bolt in stump
51.70 E. Spk. in Tele. Pole
28.84 W. Spk. in Cor. Post

13

#62 Stone on fence line
E 1/4 of N.E. 1/4
Sec. #3 Marion, Twp.

55.65 N.E. 1st Post N. Cor. As
55.20 E. Spk. Cor. Post
28.84 S.W. Spk. P. Pole

14

NE. Cor. Sec. #3 Marion, Twp.
#63 Iron bolt in Post
36.87 E. to Shiner Post
10.73 S.W. to Shiner Post
10.08 S.E. to Shiner Post
23.53 W. to Bolt in Cor. Post
21.80 S.W. to Shiner Post
37.85 N.W. to Shiner Post

57.46 N.W. to N.E. Cor. of N.
Bridge Rail.
52.40 S.W. to N.E. Cor. of S
Bridge Rail.
26.58 Distance between
Stones in Monroe Twp.
37.85 N.W. to S.E. cor. of
N. Bridge Rail
30.11 S.W. to N.E. cor. of
S. Bridge Rail.