

O.D.O.T. DISTRICT 2 SURVEY OFFICE (USE ONLY)

PERSONNEL

REFERENCE NO. 14A

SHEET 21 OF 25

NOTES BARRIERE
H.C. MILLER
R.C. BARRIERE

DATE 10/4/24
WEATHER CLEAR
TEMP. 75°

ROUTE SR 109
COUNTY HENRY
TOWNSHIP MONROE
SECTION 34

DWG BY BARRIERE PID 99587

T 4 N R 7 E

TYPE MONUMENT MAG NAIL/WASHER

ON SURFACE - BELOW ON

OFFSET Q PAVEMENT LT : RT

 TO EDGE PAVEMENT

STATION: 317+60

HORIZ.DATUM: OHIO LDP (HENRY)


GEOID: 18

GRID: NORTHING:

EASTING:


LDP: NORTHING: 438673.195

EASTING: 181523.55

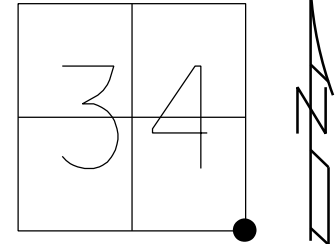

RECORD:
FD SM.R.R.SPIKE
5/18/98, MC
SET P.K./WASHER
9/24/98, MB
FD P.K./WASHER
1/10/07, SAH
6/27/08, KPM
FD SM.R.R.SPIKE
2" DOWN
6/20/16
11/13/17, JFO
FD LG.R.R.SPIKE
2 1/2" DOWN
REFA14
6/9/20, JFO
3/12/21,
1/11/23, JMR
SET MAG/WASH
10/4/24, JAM

NOTE: REF 20B SR 18

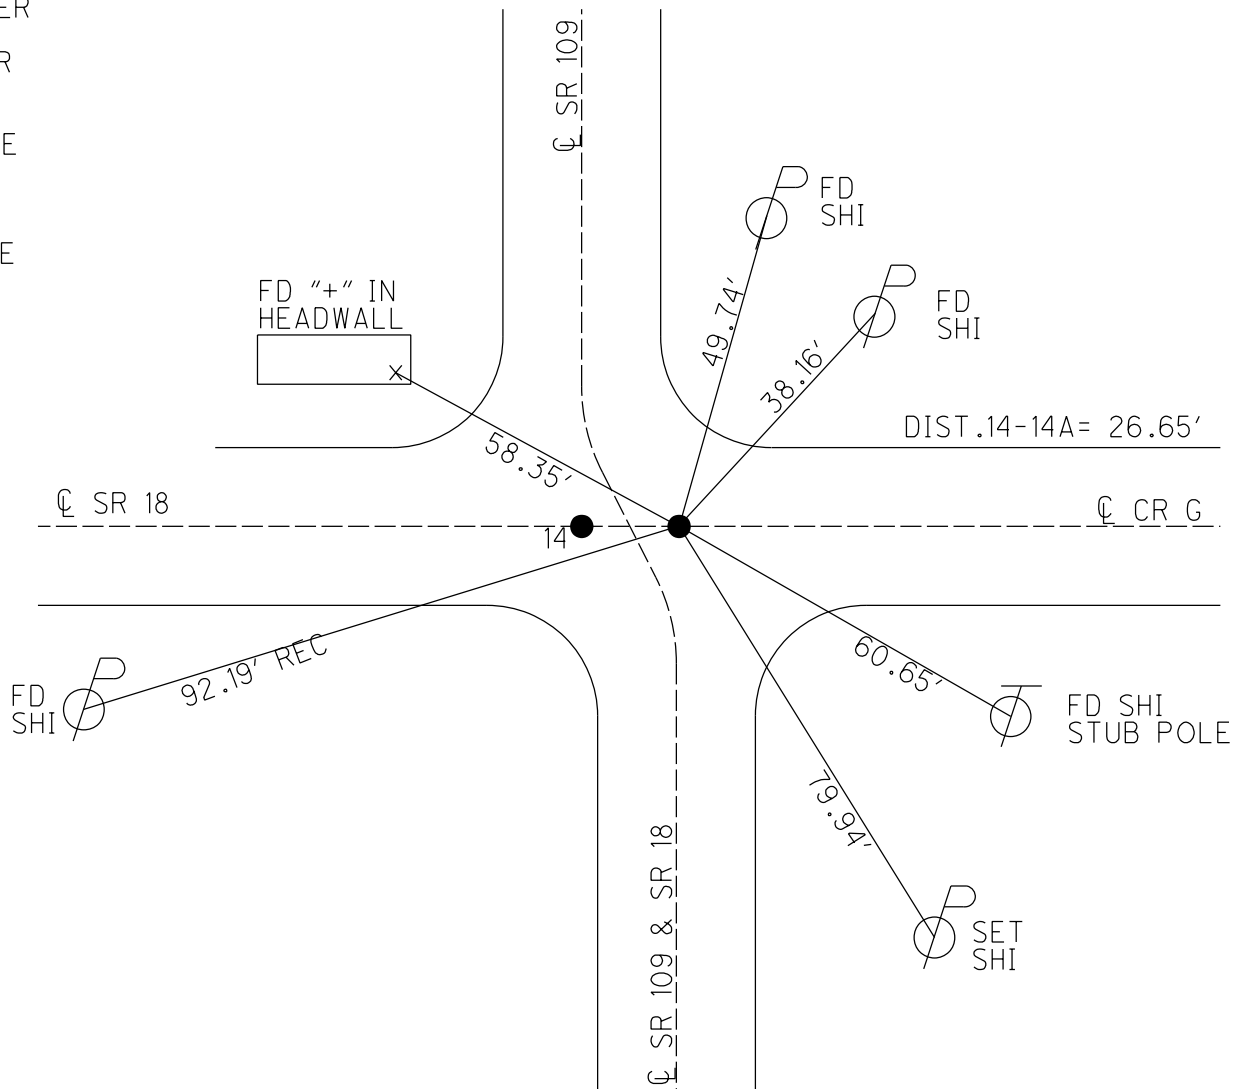

O.D.O.T. DISTRICT 2 SURVEY OFFICE (USE ONLY)

PERSONNEL

REFERENCE NO. 14 A

SHEET 22 OF 25

NOTES NIESE

DATE 3/12/21

ROUTE SR 109

H.C. RHOADES

WEATHER SUNNY

COUNTY HENRY

R.C. _____

TEMP. 50°

TOWNSHIP MONROE

SECTION 34

DWG BY NIESE

PID PAVE TRAIN

T 4 N R 7 E

TYPE MONUMENT LG.R.R.SPIKE

~~ON SURFACE~~ - BELOW 2 1/2"

OFFSET CL PAVEMENT 6.5' ~~LT~~ : RT

- TO - EDGE PAVEMENT


STATION: 317+60

HORZ.DATUM: NAD83(2011)

GEOID: NAVD88 2012A

GRID: NORTHING: 582030.833


EASTING: 1546073.032

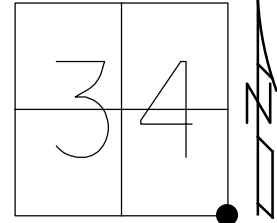

RECORD:

FD SM.R.R.SPIKE
5/18/98, MC
SET P.K./WASHER
9/24/98, MB
FD P.K./WASHER
1/10/07, SAH
6/27/08, KPM
FD SM.R.R.SPIKE
2" DOWN
6/20/16
11/13/17, JFO
FD LG.R.R.SPIKE
2 1/2" DOWN
REFA14
6/9/20, JFO
3/12/21,
1/11/23, JMR

NOTE: REF 21 SR 18

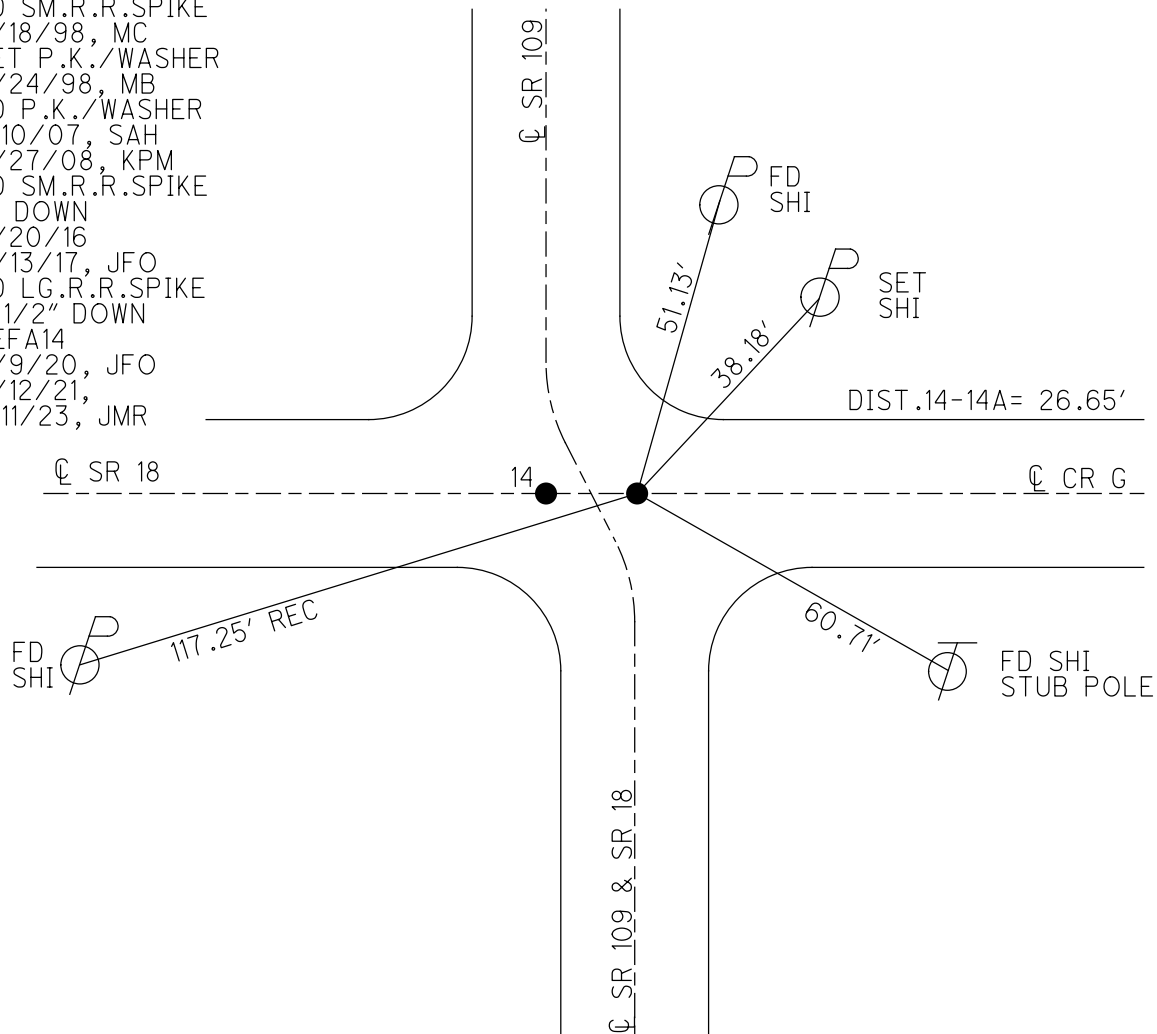

O.D.O.T. DISTRICT 2 SURVEY OFFICE (USE ONLY)

PERSONNEL

REFERENCE NO. 14 A

SHEET 22 OF 25

NOTES NIESE

DATE 3/12/21

ROUTE SR 109

H.C. RHOADES

WEATHER SUNNY

COUNTY HENRY

R.C. _____

TEMP. 50°

TOWNSHIP MONROE

DWG BY NIESE

PID PAVE TRAIN

SECTION 34

T 4 N R 7 E

TYPE MONUMENT LG.R.R.SPIKE

~~ON SURFACE~~ - BELOW 2 1/2"

OFFSET Q PAVEMENT 6.5' ~~LT~~ : RT

- TO - EDGE PAVEMENT


STATION: 317+60

HORZ.DATUM: NAD83(2011)

GEOID: NAVD88 2012A


GRID: NORTHING: 582030.833

EASTING: 1546073.032

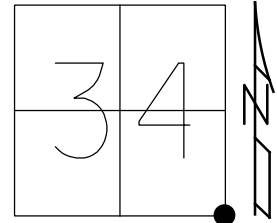

RECORD:
FD SM.R.R.SPIKE
5/18/98, MC
SET P.K./WASHER
9/24/98, MB
FD P.K./WASHER
1/10/07, SAH
6/27/08, KPM
FD SM.R.R.SPIKE
2" DOWN
6/20/16
11/13/17, JFO
FD LG.R.R.SPIKE
2 1/2" DOWN
REFA14
6/9/20, JFO
3/12/21, JMR

NOTE: REF 21 SR 18

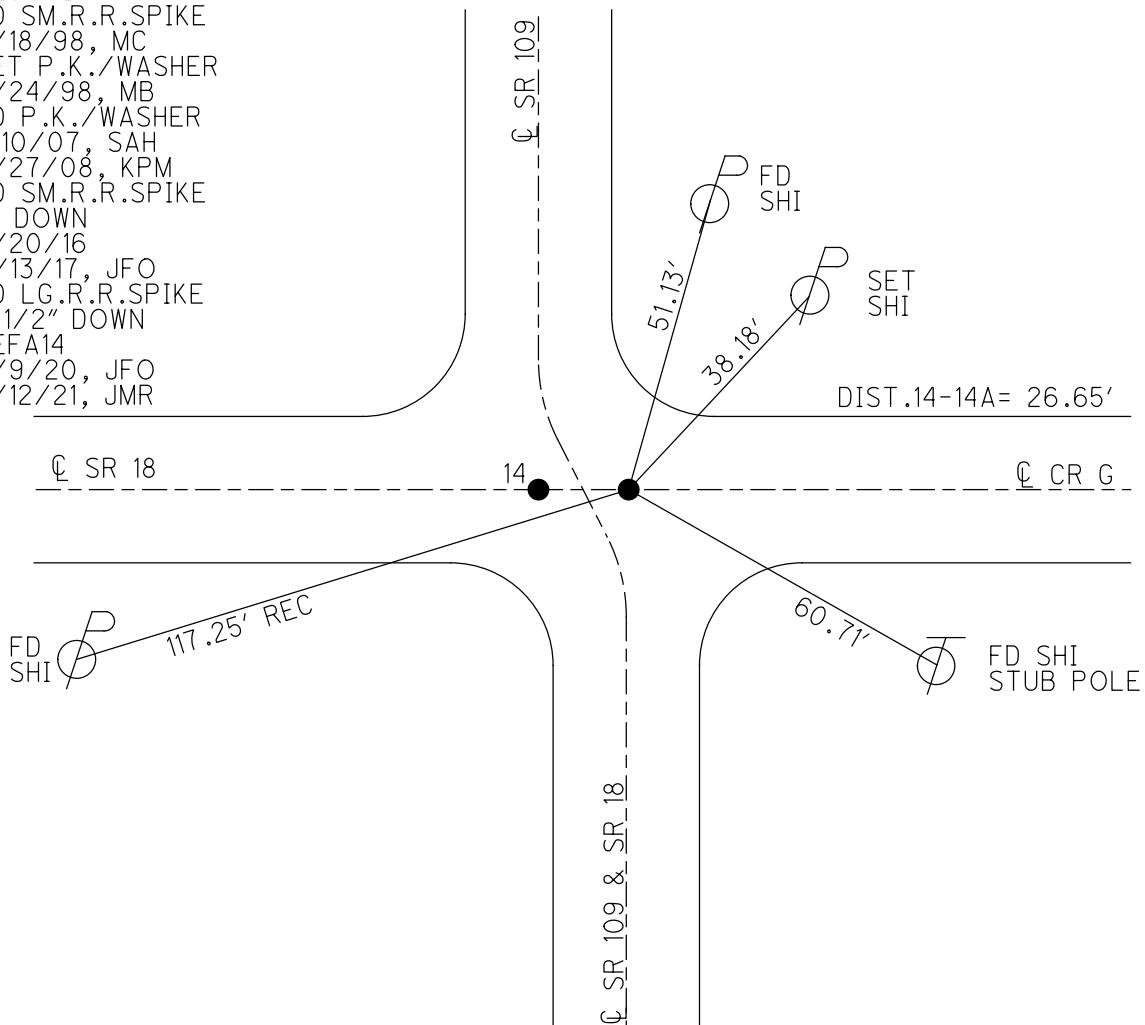

O.D.O.T. DISTRICT 2 SURVEY OFFICE (USE ONLY)

PERSONNEL

REFERENCE NO.

14 A

SHEET 22 OF 26

NOTES CANTERBURY

DATE 05-18-1998

ROUTE SR 109

H.C. ROUSOS

WEATHER SUNNY

COUNTY HENRY

R.C. HUSS

TEMP. 80°F

TOWNSHIP MONROE

SECTION 34

T 4 N R 7 E

TYPE MONUMENT RR SPK

ON SURFACE - ~~BELOW~~ ON

~~LEFT~~ - ϕ PAV'T - RIGHT 6.5'

- TO - EDGE PAVEMENT


S.L.M. 299+33.6

Grid: Northing: Easting:

34	35
3	2



FND RR SPK @ SURFACE SET BY
COUNTY @ N.E. CORNER SEC 3. MARION
TWP 6.5' E OF ϕ PVMT SR 109

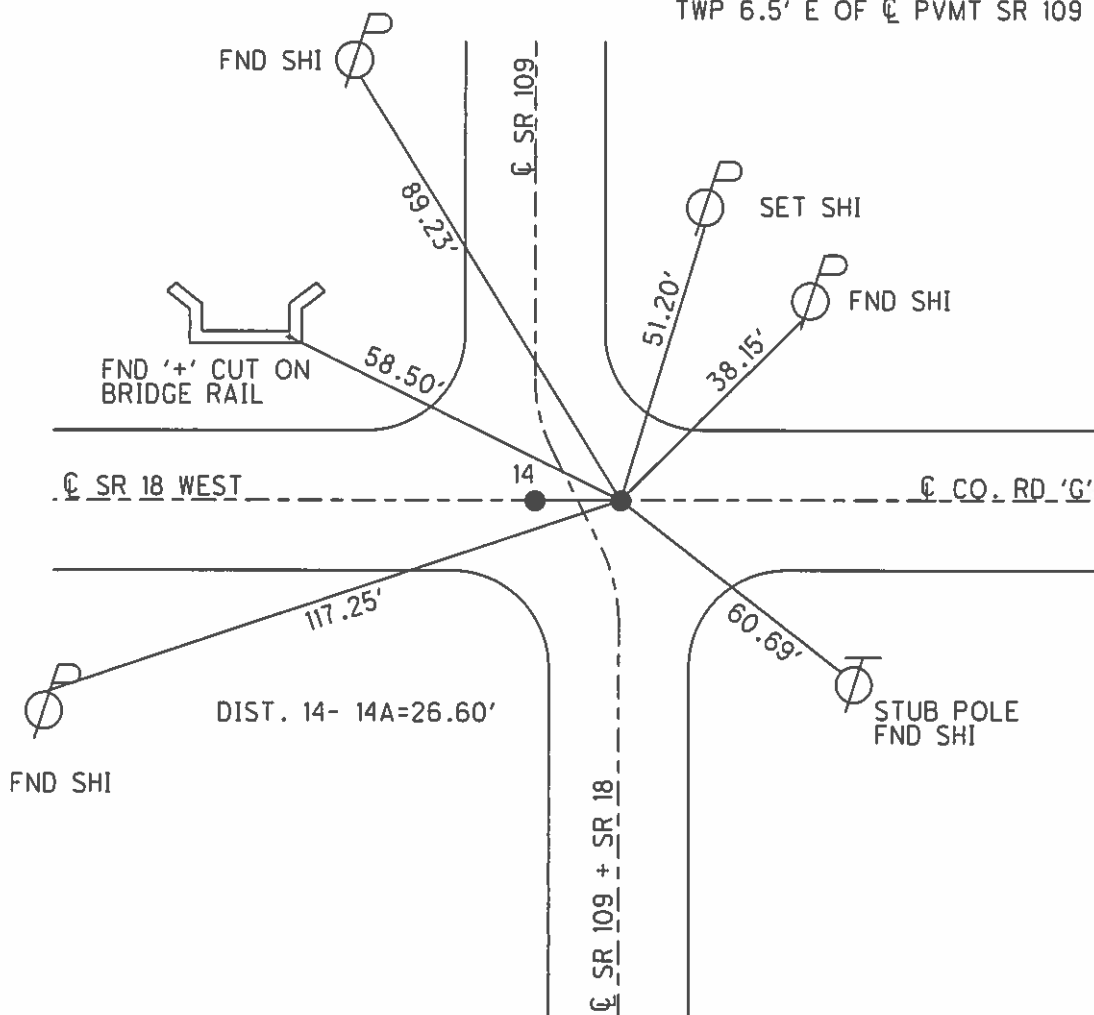

O.D.O.T. DISTRICT 2 SURVEY OFFICE

PERSONNEL

REFERENCE NO. #14

SHEET 17 OF 21

NOTES Canterbury

H.C. Rouss

R.C. Huss

DATE 5-18-98

WEATHER Sunny

TEMP. +80°F

ROUTE SR 109

COUNTY Henry

TOWNSHIP Monroe + Marion


SECTION 34 + 3

T. R.

TYPE MONUMENT A - Sm. RR spike / B - RR spike
ON SURFACE BELOW Both on surface

LEFT - C PAV'T. - RIGHT A 20.5' Lt & Rmt B 6.5' Rt & Rmt.
TO EDGE PAVEMENT


S.L.M. SR 109 - 9 + 656 SLK / SR 18, 16 - 020 SLK

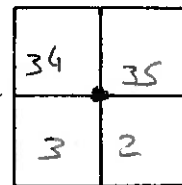

PT 'A' Fd Sm. RR spike @ surface
20.1' W of E Pavt SR 109
@ S.E. corner of SEC 34 Monroe twp

PT 'B' Fd RR spike at surface
set by county @ N.E. corner SEC 3 Marion twp
6.5' E of E Pavt SR 109

316+80 / 6.00

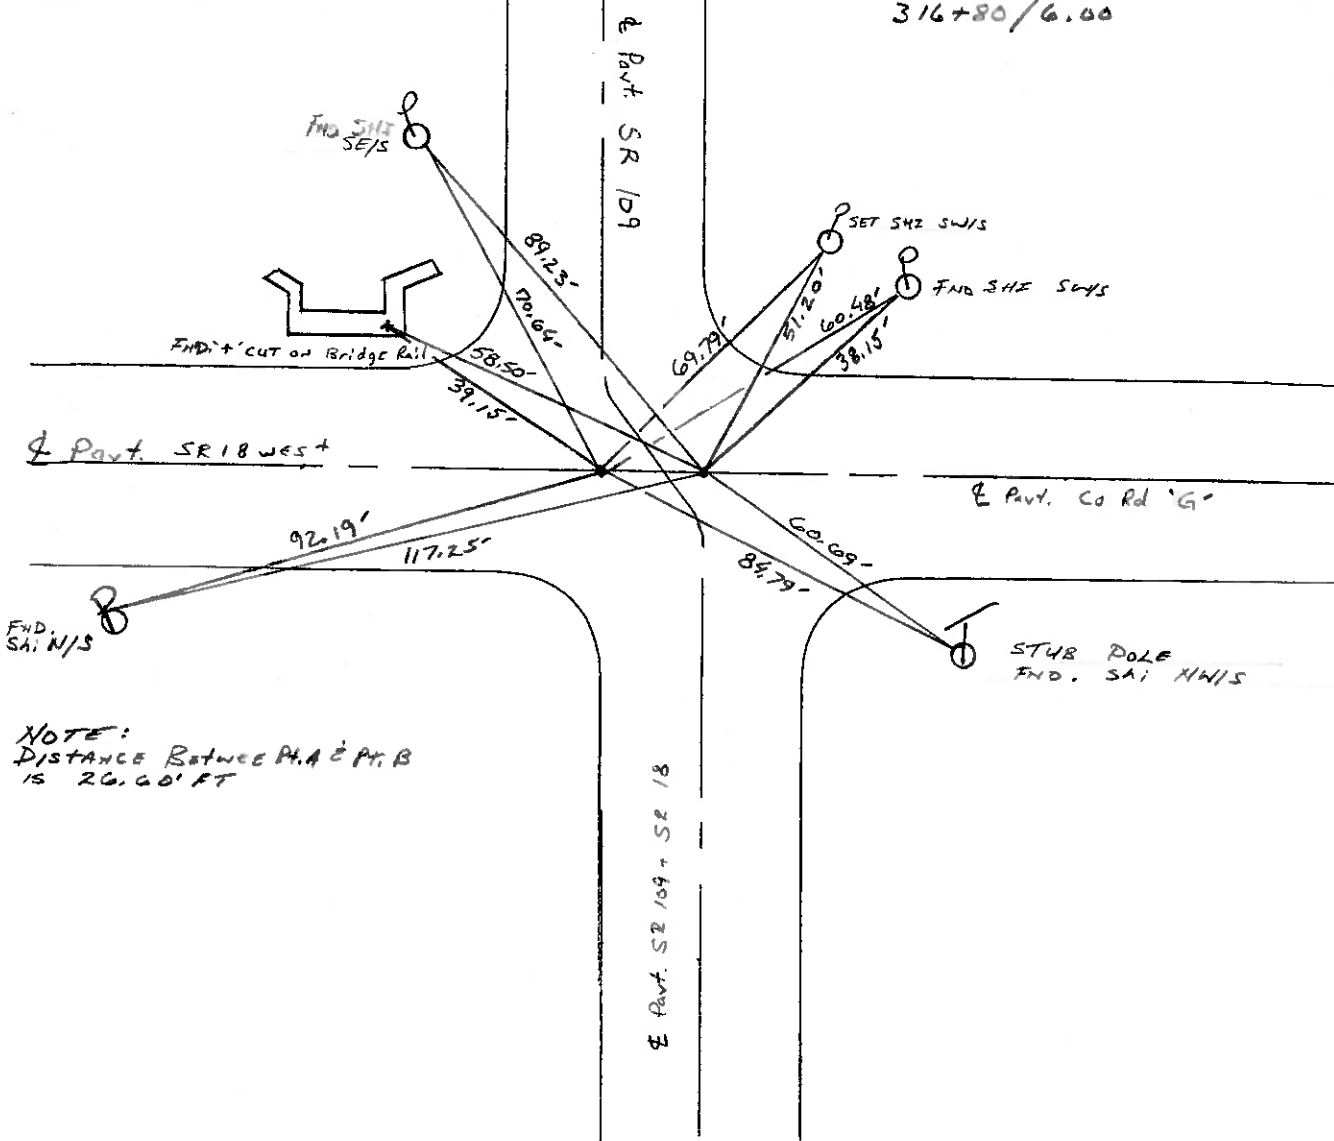

Q.D.O.T. DISTRICT 2 SURVEY OFFICE

SHEET _____ OF _____

County HENRY S.R. 109 & 18

Township MONROE & MARION

Section 34 & 3

T N, R E

Personnel HOFFMAN

LOHRICE

BARANISEL

#14
SR 109

Date April 26, 83

Weather Clear

Temp. +65°

MONROE MARION	34	35	TWP TWP
	3	2	



PT "A" Fd small RR spike @ surface
201.1' West of & PAUT SR 109
@ S.E. CORNER SEC. 34, MONROE TWP


PT "B" Fd RR spike @ surface
Set BY County @ N.E. CORNER
SEC 3, MARION TWP.
6.5' East of & PAUT SR 109

SLM SR 109 = 316+80

SLM SR 18 = 525+58

PT. "A" NOT COVERED
THIS PROJECT

P.T. "B" SET P.K./WASHER
9-19-83
SWH

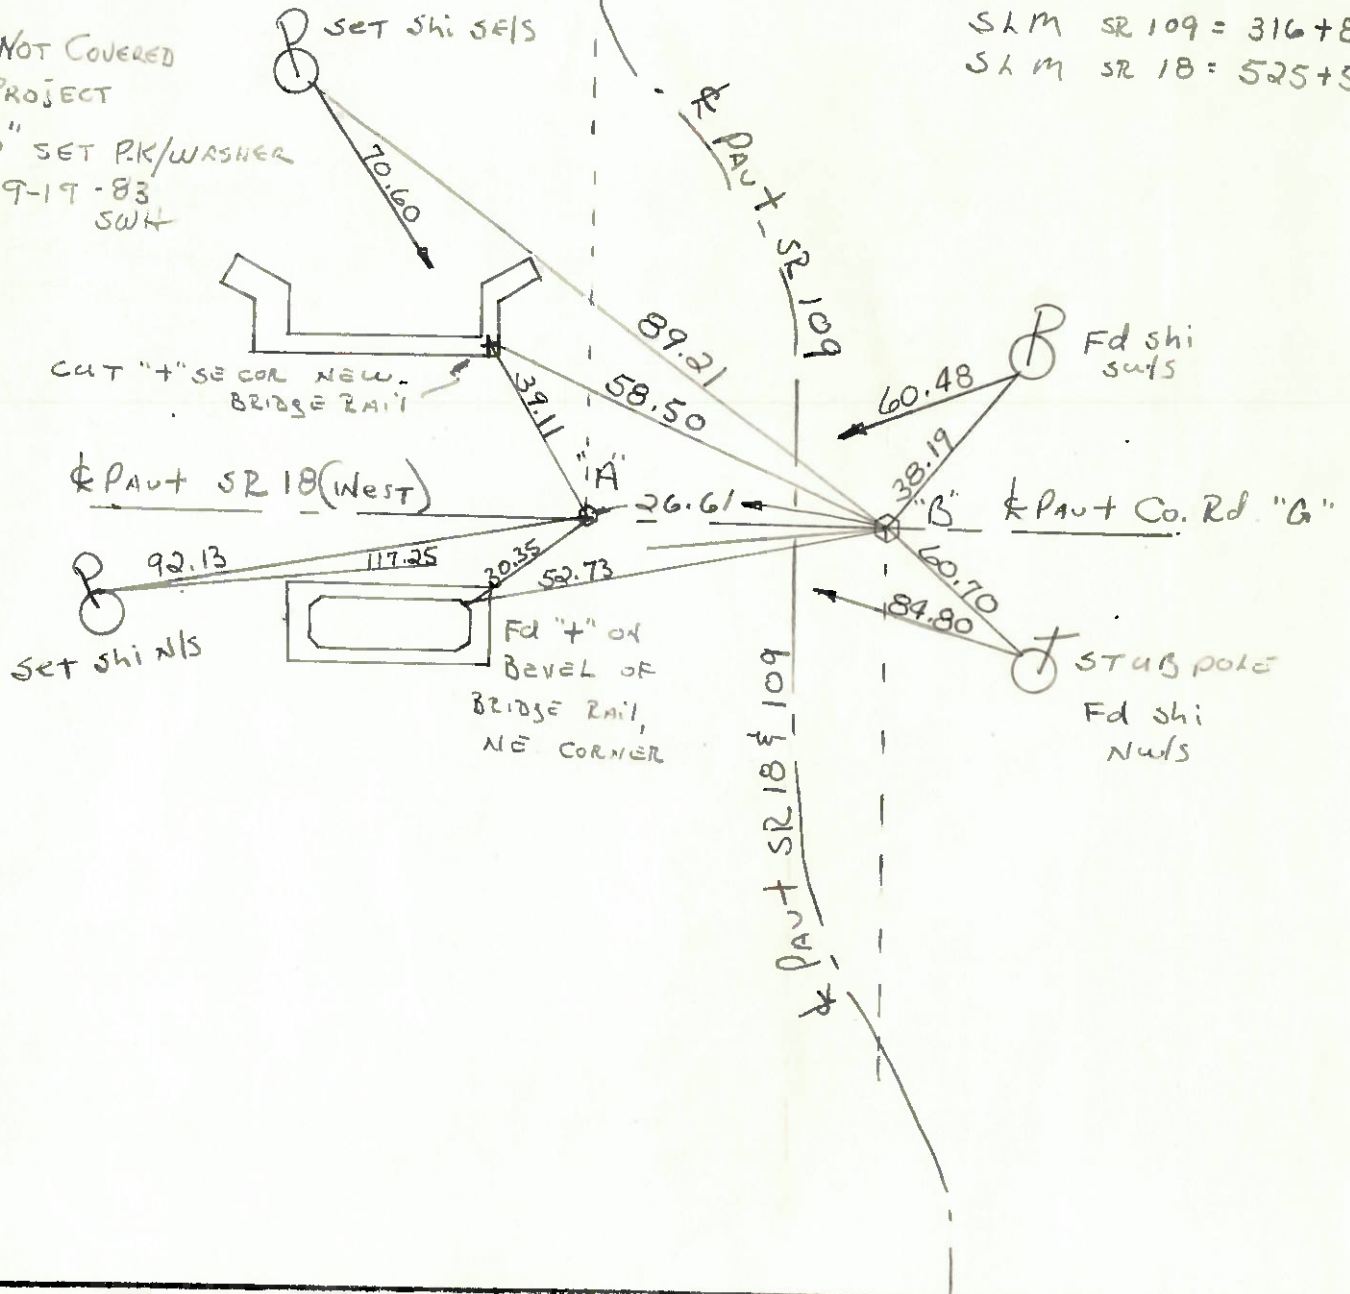

SHEET 15 OF

Date 5-29-81 8-20-81

Weather cloudy

Temp. +60°

N


+650
SWN.
C.L.
M.B.

၄-၁၆-၈၃

#21

PROJECT STA ± 316+80 Lm 109

PROJECT STA $\pm$ 525+59 52 in B

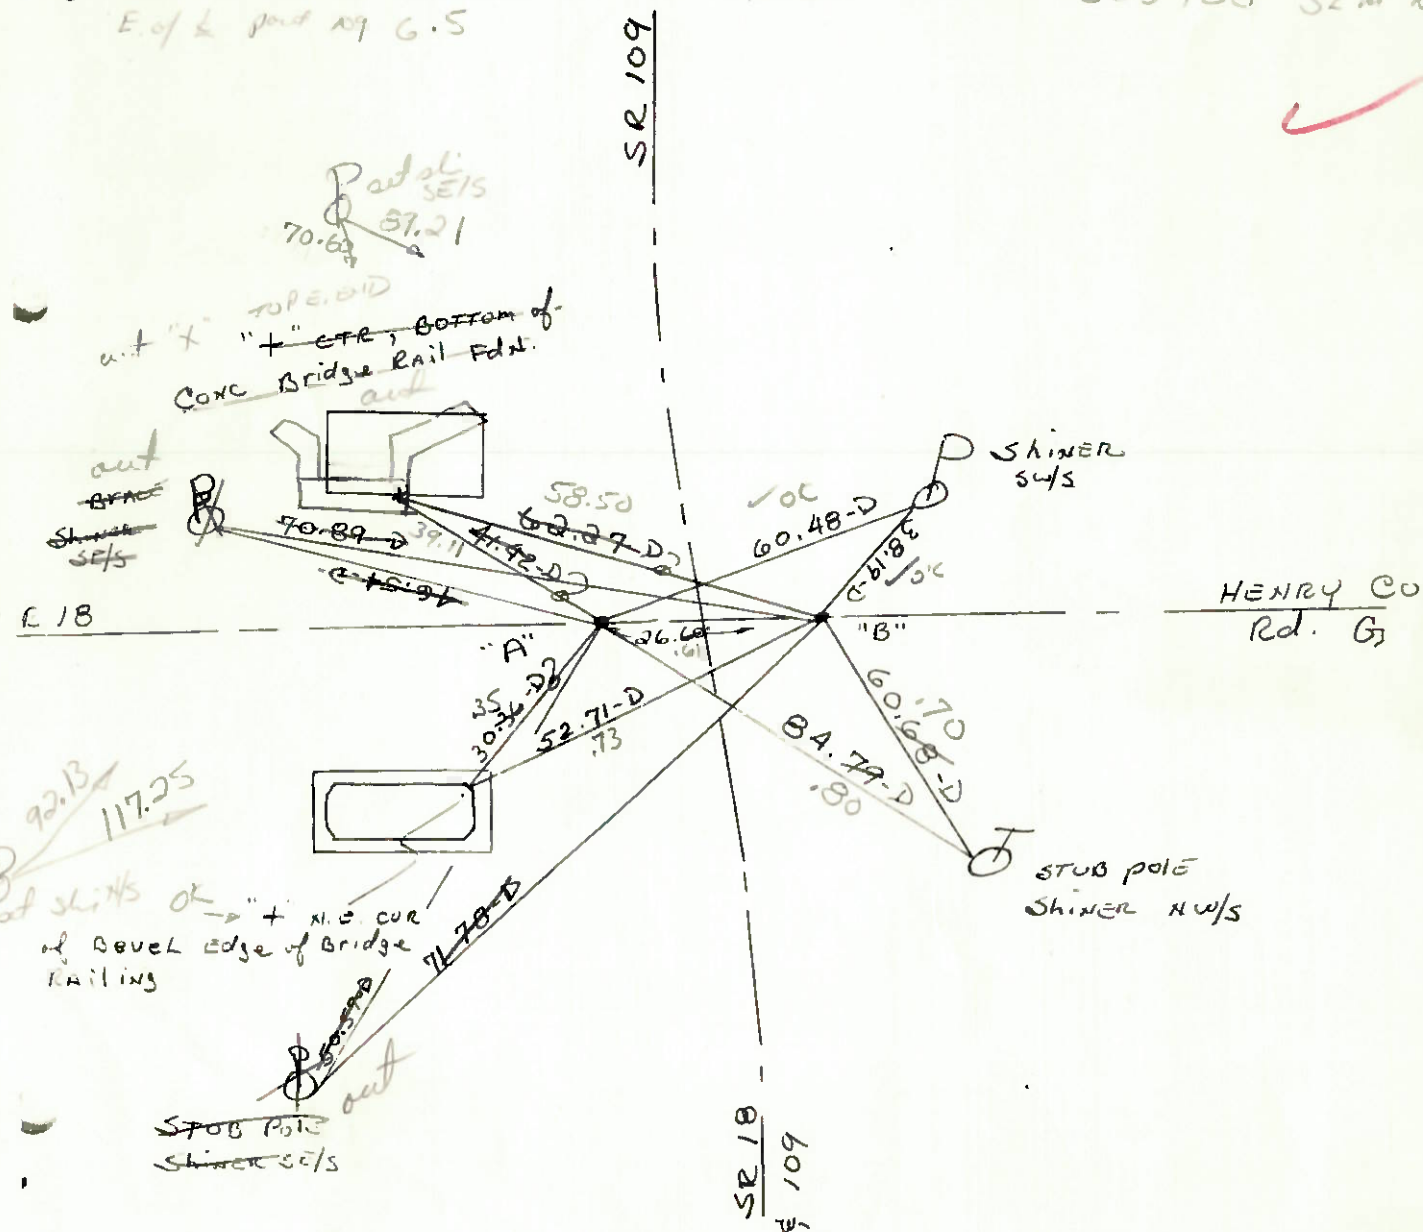

ODOT DISTRICT 2 SURVEY OFFICE

SHEET 15 OF

County HENRY S.R. 18-109

Date 5-29-81 8-20-81

Township MARION

Weather cloudy

Section 2


Temp. +60°

T3N, R7E

Personnel S. NOFFMAN

#21 C. Loehrke

L. Householder

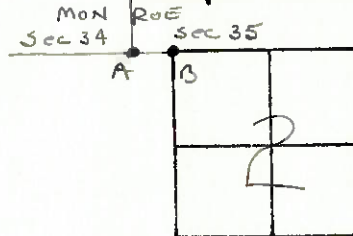


PT. "A" Fd. R.R. SPK @ SURFACE
SET SMALL R.R. SPK.

PROJECT STA ±

PT. "B" Fd. R.R. SPK @ SURFACE

PROJECT STA ±

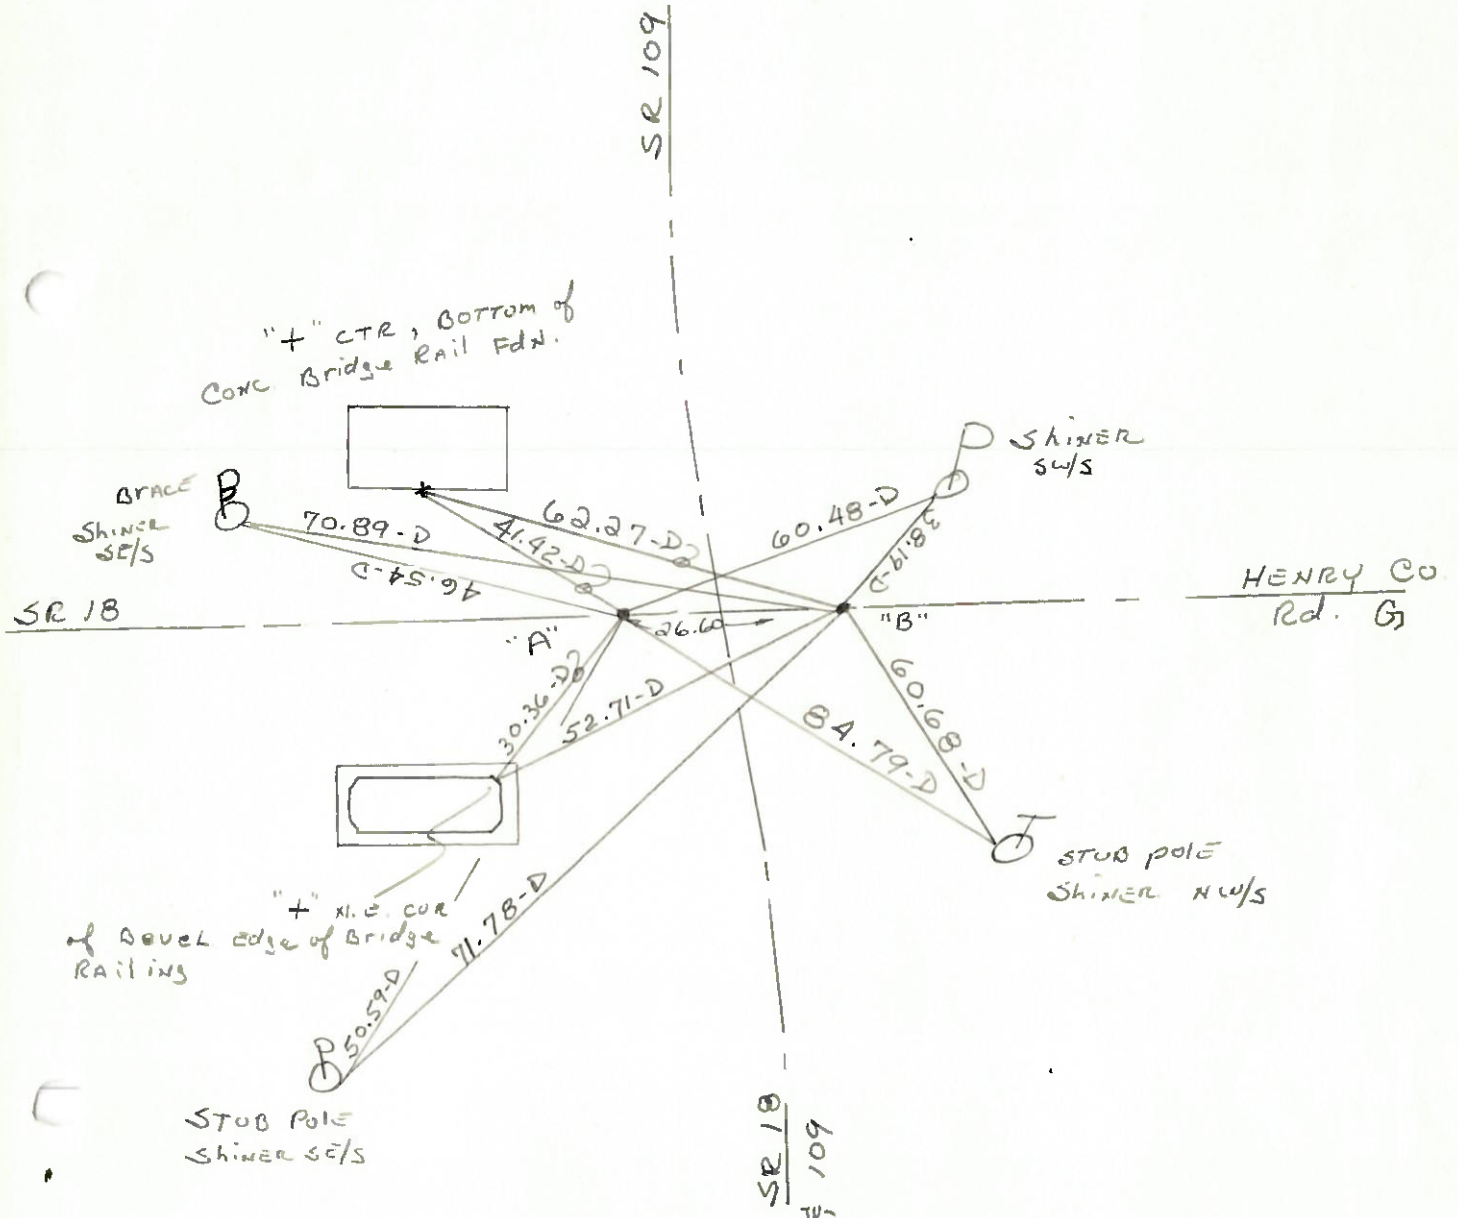

PERSONNEL TITLE PERSONNEL TITLE

Tomsic Neuser

Granata

Vanya


COUNTY HENRY

DATE Oct. 31, 1975

S. R. 109 WEATHER

SEC. 17.7 R 101 TEMP

DESCRIPTION LEFT CENTER LINE RIGHT JOB NO.

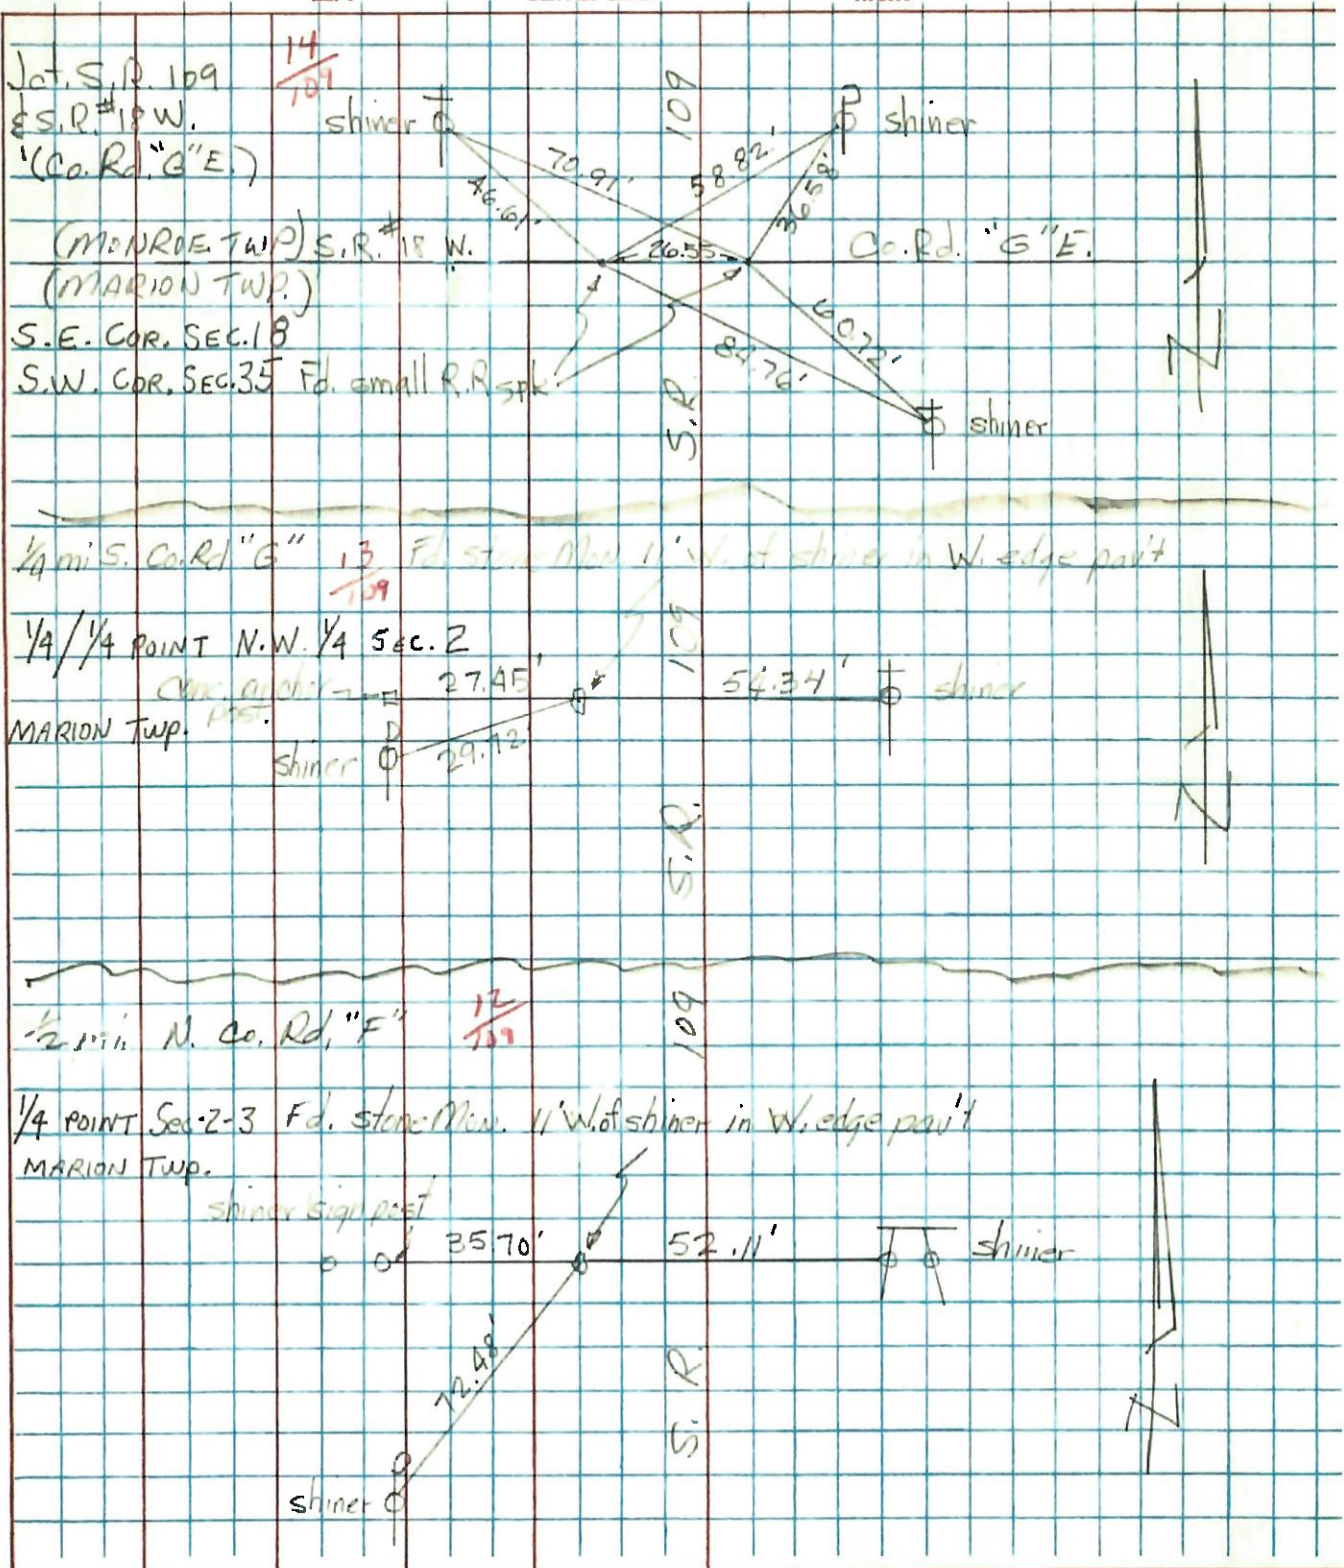

SHEET NO. 4

PERSONNEL TITLE PERSONNEL TITLE

BURNSIDECOUNTY HENRYDATE 5-11-72BOWERSS. R. 18 & 109WEATHER CLEAR

SEC.

TEMP +63°DESCRIPTION CONTROL TIES NORTH OF HAMLER

JOB NO.

LEFT

CENTER LINE

RIGHT

14
104

SEC. 34

SEC. 34
SEC. 35

SEC. 35

S.W. COR. CONC
RR RAILS.W. COR. SEC. 35
OLD TIES GOOD
SET SMALL P.R. SETSTA. 52+63.7
(PLAN OF 1929)SEC. 34
SEC. 3

S.R. 18

COUNTY
ROAD "G" SEC. 35

SEC. 2

N.E. COR. CONC
RR RAILN.E. COR. SEC. 3
OLD TIES GOOD
SET SMALL P.R. SET

SEC. 3

SEC. 3
SEC. 2

SEC. 2



14

14 A