

O.D.O.T. DISTRICT 2 SURVEY OFFICE (USE ONLY)

PERSONNEL

REFERENCE NO. 14B

NOTES BARRIERE

DATE 07/24/25

ROUTE SR 109

H.C. MILLER

WEATHER CLEAR

COUNTY HENRY

R.C. ERNST

TEMP. 85°

TOWNSHIP MARION

SECTION 34

DWG BY BARRIERE


PID 99587

T 4 N R 7 E

TYPE MONUMENT MONBOX W/ 1" IPIN

ON SURFACE - BELOW ON

OFFSET $\oslash$ PAVEMENT _____

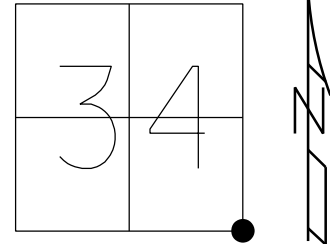

STATION: 317+60

HORZ.DATUM: OHIO LDP (HENRY)

GEOID: 18

GRID: NORTHING: _____

EASTING: _____

LDP: NORTHING: _____

EASTING: _____

RECORD:
FD MONBOX W/ 1" IPIN
7/24/25, JAM

