

O.D.O.T. DISTRICT 2 SURVEY OFFICE (USE ONLY)

PERSONNEL

REFERENCE NO. 17

SHEET 25 OF 25

NOTES NIESE

DATE 3/12/21

ROUTE SR 109

H.C. RHOADES

WEATHER SUNNY

COUNTY HENRY

R.C. _____

TEMP. 50°

TOWNSHIP MONROE

SECTION 34

DWG BY RHOADES PID PAVE TRAIN

T 4 N R 7 E

TYPE MONUMENT SM.R.R.SPIKE

~~ON SURFACE~~ - BELOW 3.5'

OFFSET $\angle$ PAVEMENT 10.7' LT : ~~RT~~

1.0' TO LT EDGE PAVEMENT


STATION: 397+06

HORIZ.DATUM: NAD83(2011)

GEOID: NAVD88 2012A

GRID: NORTHING: 589982.874

EASTING: 1546089.769

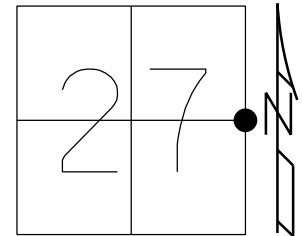

RECORD:

FD SM.R.R.SPIKE

1" DOWN

6/23/89, MDB

FD P.K./WASHER

5/18/98, MC

SET P.K./WASHER

9/28/98, MB

FD SM.R.R.SPIKE

4" DOWN

2-25-19, JLL

3 1/2" DOWN

REF17

6/9/20, JFO

3/12/21, JMR

12/2/21, DSA

SET BARN
SPIKES

8.73'

$\angle$ SR 109

31.53'

36.43'

SET SHI
STUB POLE

35.24' P



FD "+"
CBS

O.D.O.T. DISTRICT 2 SURVEY OFFICE (USE ONLY)

PERSONNEL

REFERENCE NO. 17

SHEET 25 OF 25

NOTES NIESE

DATE 3/12/21

ROUTE SR 109

H.C. RHOADES

WEATHER SUNNY

COUNTY HENRY

R.C. _____

TEMP. 50°

TOWNSHIP MONROE

SECTION 34

DWG BY RHOADES PID PAVE TRAIN

T 4 N R 7 E

TYPE MONUMENT SM.R.R.SPIKE

~~ON SURFACE~~ - BELOW 3.5'

OFFSET Q PAVEMENT 10.7' LT : ~~RT~~

1.0' TO LT EDGE PAVEMENT


STATION: 397+06

HORIZ.DATUM: NAD83(2011)

GEOID: NAVD88 2012A

GRID: NORTHING: 589982.874

EASTING: 1546089.769

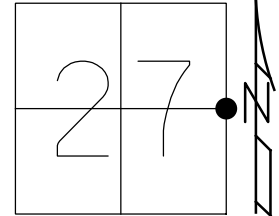

RECORD:
FD SM.R.R.SPIKE
1" DOWN
6/23/89, MDB
FD P.K./WASHER
5/18/98, MC
SET P.K./WASHER
9/28/98, MB
FD SM.R.R.SPIKE
4" DOWN
2-25-19, JLL
3 1/2" DOWN
REF17
6/9/20, JFO
3/12/21, JMR

SET BARN
SPIKES

8.73'

Q SR 109

31.53'

36.43'

SET SHI
STUB POLE

35.24' P



FD "+"
CBS

O.D.O.T. DISTRICT 2 SURVEY OFFICE (USE ONLY)

PERSONNEL

REFERENCE NO. 17

SHEET 25 OF 26

NOTES CANTERBURY

DATE 05-18-1998

ROUTE SR 109

H.C. ROUSOS

WEATHER SUNNY

COUNTY HENRY

R.C. HUSS

TEMP. 80°F

TOWNSHIP MONROE

SECTION 27

T 4 N R 7 E

TYPE MONUMENT PK & WASHER


ON SURFACE - ~~BELOW~~ ON

LEFT - ℄ PAV'T - ~~RIGHT~~ 10.7'

1.0' TO LT EDGE PAVEMENT


S.L.M. 397+06

Grid: Northing: _____ Easting: _____

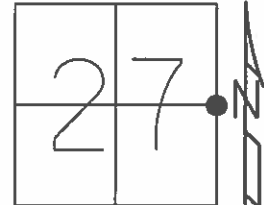

FND SMALL RR SPK 1" DOWN
SET BY M.D.B. 06-23-1989

RESET PK & WASHER
09-28-1998 M.B.

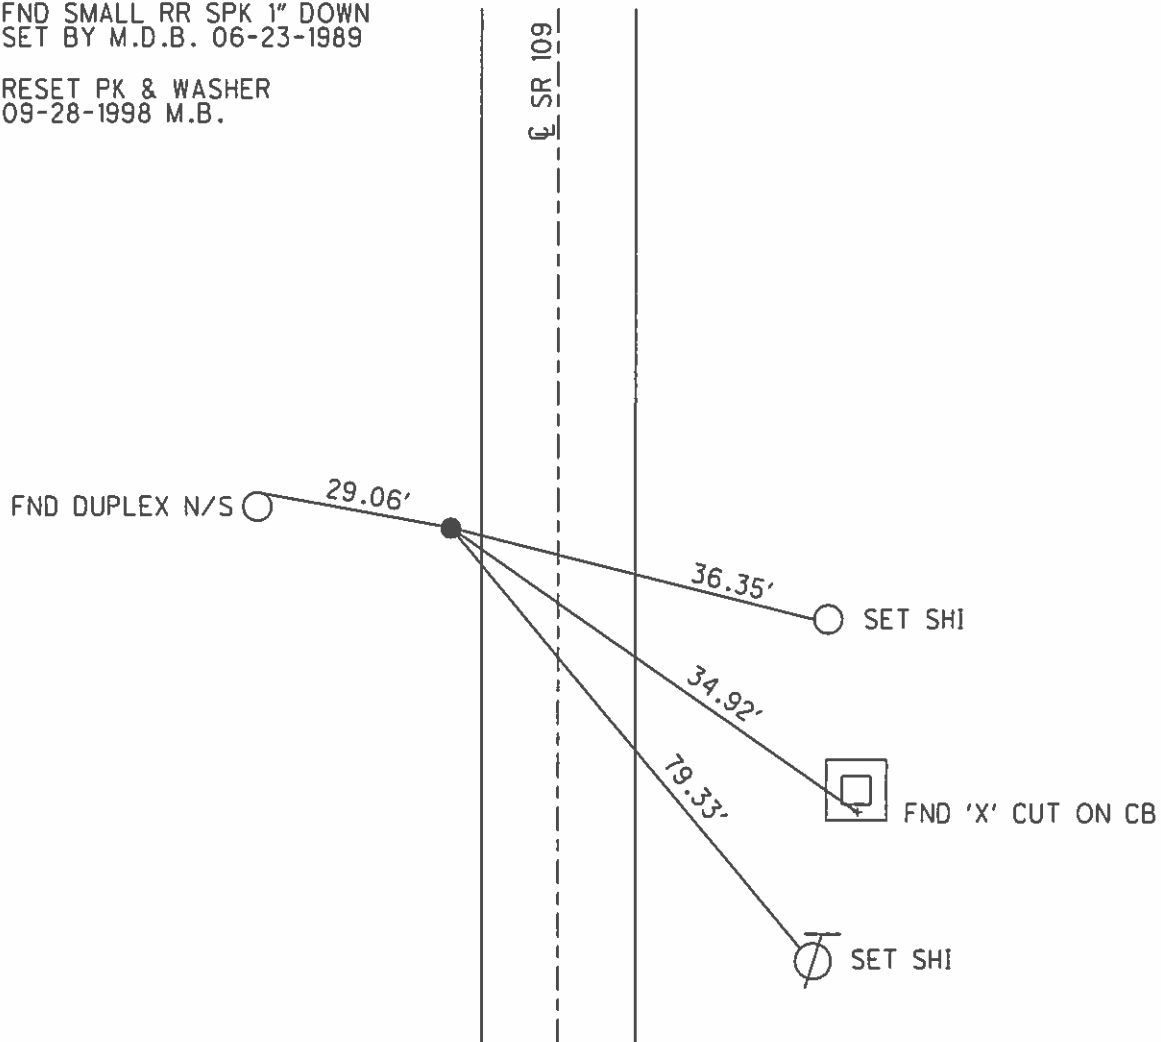

O.D.O.T. DISTRICT 2 SURVEY OFFICE

PERSONNEL

REFERENCE NO. 17

SHEET 20 OF 21

NOTES Canterbury

H.C. Rousos

R.C. Hess

DATE 5-18-98

WEATHER Sunny

TEMP. +80°F

ROUTE 109

COUNTY Henry

TOWNSHIP Monroe

SECTION 27

T 4 N R 7 E


TYPE MONUMENT P.K. & Washer

ON SURFACE - ~~BELOW~~ ON SURFACE

LEFT - & PAV'T. - RIGHT 10.7 L+


1.0' L+ TO L+ EDGE PAVEMENT

S.L.M. 12+088.42 gk (sta 399.0654)

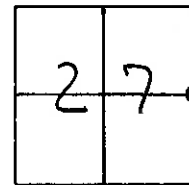

Fnd. Small RR spike 1" Down
SET BY MDB 6-23-89

RESET P.K. & WASHER
9-28-98
MR

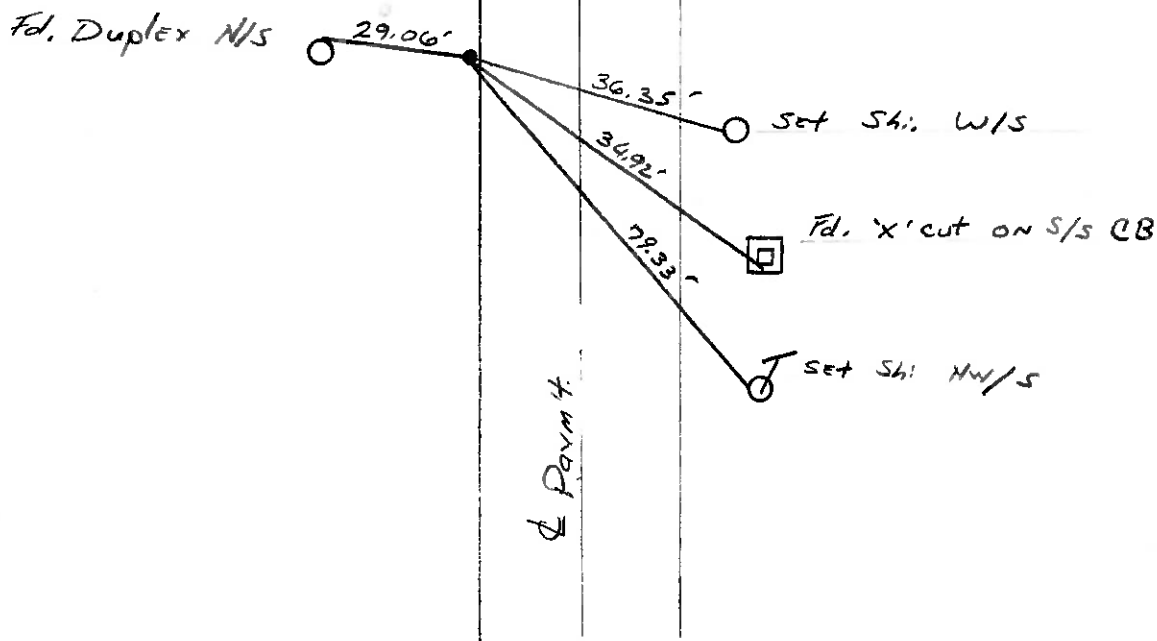

DRAWN BY-MR

O.D.O.T. DISTRICT 2 SURVEY OFFICE

PERSONNEL

REFERENCE NO. 17

SHEET 20 OF

NOTES BARNHISEL

H.C. " "

R.C. Loehke

DATE 3-30-89

WEATHER RAIN

TEMP. +40°

ROUTE 109

COUNTY HENRY

TOWNSHIP MONROE

SECTION 27

T A N R T E



TYPE MONUMENT PK WASHER

ON SURFACE - BELOW YES


LEFT- & PAV'T. - RIGHT 10.7

10 TO EDGE PAVEMENT 1.0' EAST OF WEST. E.P.

S.L.M. 397+06

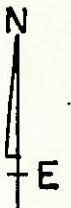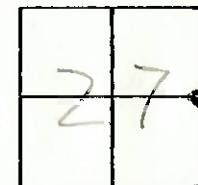

NOTE: NEW C.B. 397+08

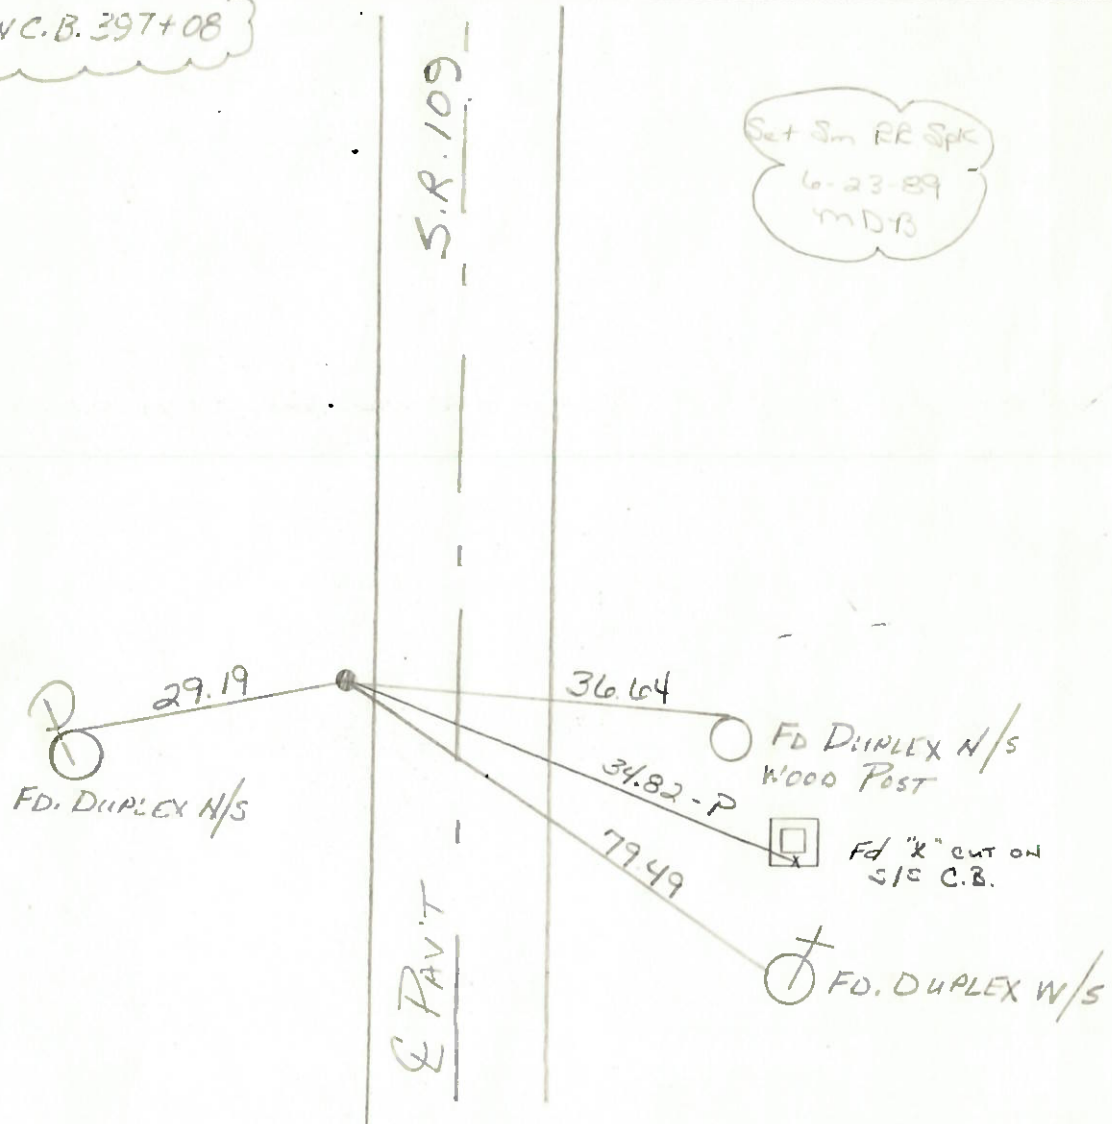

ODOT. DISTRICT 2 SURVEY OFFICE

SHEET _____ OF _____

County HENRY S.R. 109

Date April 26, 83

Township MONROE

Weather Clear

Section 27


Temp. +65°

T4N, R7E

Personnel HOFFMAN

LOEHRKE

BARNHISEL

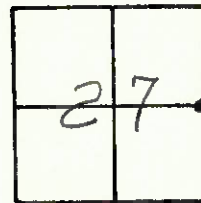

Fd 2.R. spk @ surface, SET BY County

SLM 396+34

10.7 Lt of & Post

~~1.4' West of W.E.P.~~

1' EAST OF WEST E.P.

SET P.K./WASHER

9-19-83

SWH

