

O.D.O.T. DISTRICT 2 SURVEY OFFICE (USE ONLY)

PERSONNEL

REFERENCE NO. 18

SHEET 21 OF 25

NOTES BARRIERE
H.C. MILLER
R.C. BARRIERE

DATE 4/3/24
WEATHER CLOUDY
TEMP. 42°

ROUTE SR 109
COUNTY HENRY
TOWNSHIP MONROE
SECTION 27
T 4 N R 7 E

DWG BY BARRIERE PID 99587

TYPE MONUMENT LG R.R.SPIKE

ON SURFACE - BELOW 1"

OFFSET $\odot$ PAVEMENT LT : RT

 TO EDGE PAVEMENT

STATION: 423+58

HORIZ.DATUM: OHIO LDP (HENRY)


GEOID: 18

GRID: NORTHING: 592634.341


EASTING: 1546102.916

LDP: NORTHING: 449276.302

EASTING: 181358.879

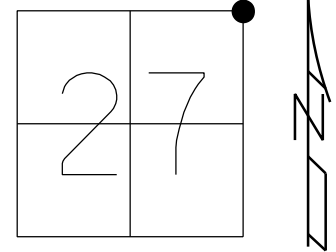

RECORD:
FD SM. RR. SPIKE
SET P.K./WASHER
9/2/98, MB
FD R.R.SPIKE
2" DOWN
9/2/15, JFO
8/3/16, JMR
FD SM.R.R.SPIKE
1.5" DOWN
2/25/19, JLL
1" DOWN
REF18
6/9/20, JFO
3/12/21, JMR
12/3/21, DSA

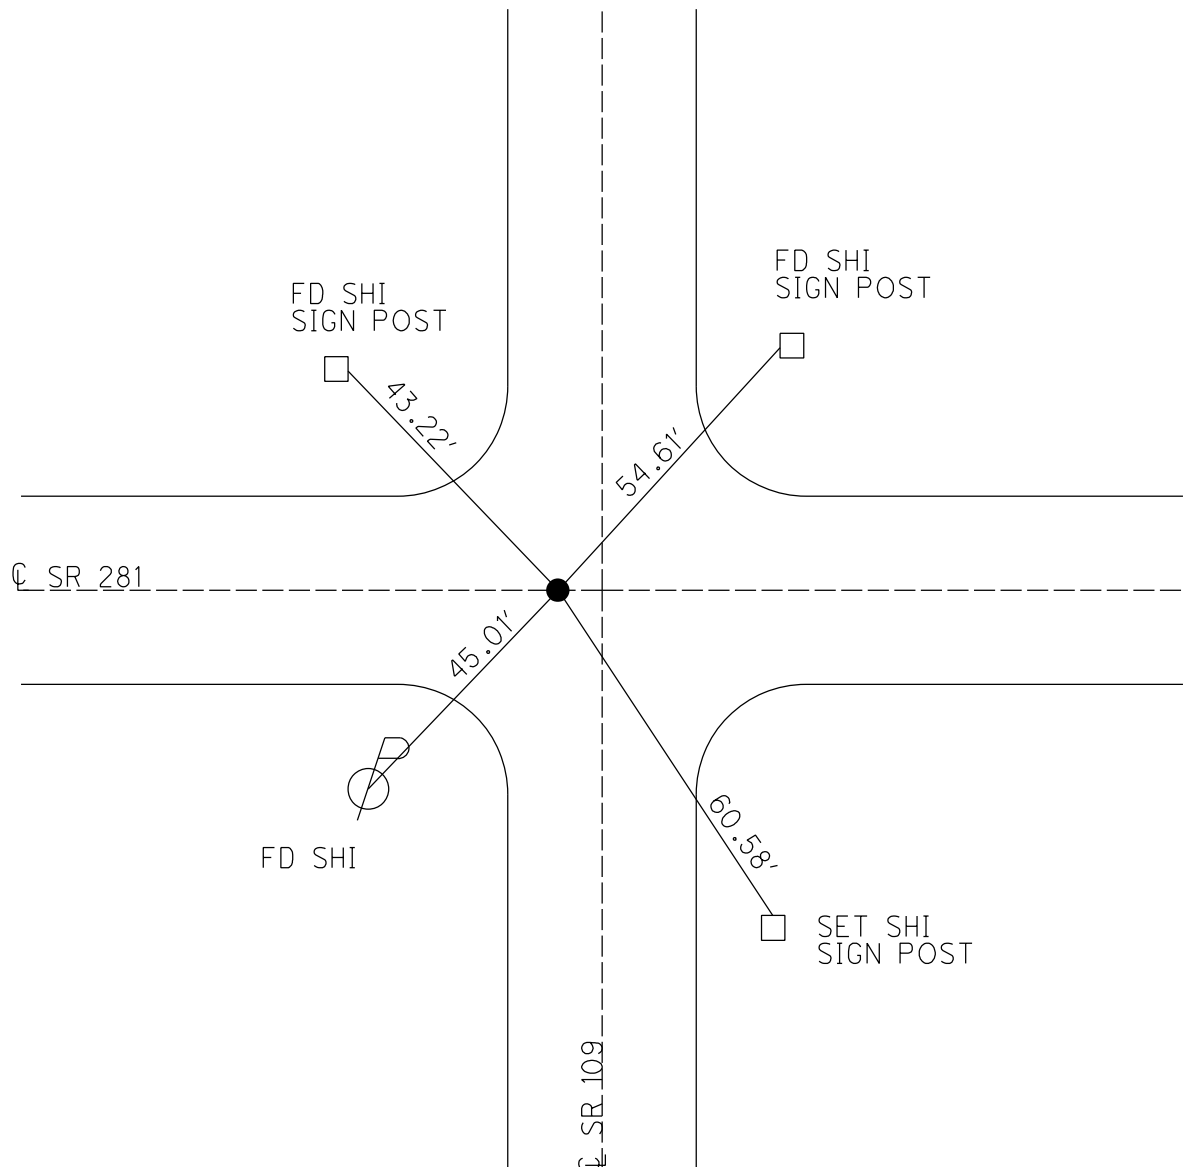

O.D.O.T. DISTRICT 2 SURVEY OFFICE (USE ONLY)

PERSONNEL

REFERENCE NO. 18

SHEET 1 OF 38

NOTES NIESE

DATE 3/12/21

ROUTE SR 109

H.C. RHOADES

WEATHER SUNNY

COUNTY HENRY

R.C.

TEMP. 50°

TOWNSHIP MONROE

DWG BY NIESE

PID PAVE TRAIN

SECTION 27

T 4 N R 7 E

TYPE MONUMENT LG.R.R.SPIKE

~~ON SURFACE~~ - BELOW 1"

OFFSET Q PAVEMENT 8.0' LT : ~~RT~~

- TO - EDGE PAVEMENT


STATION: 423+58

HORZ.DATUM: NAD83(2011)


GEOID: NAVD88 2012A

GRID: NORTHING: 592634.341

EASTING: 1546102.916

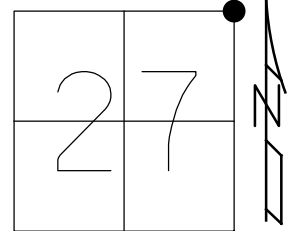

RECORD:
FD SM. RR. SPIKE
SET P.K./WASHER
9/2/98, MB
FD R.R.SPIKE
2" DOWN
9/2/15, JFO
8/3/16, JMR
FD SM.R.R.SPIKE
1.5" DOWN
2/25/19, JLL
1" DOWN
REF18
6/9/20, JFO
3/12/21, JMR

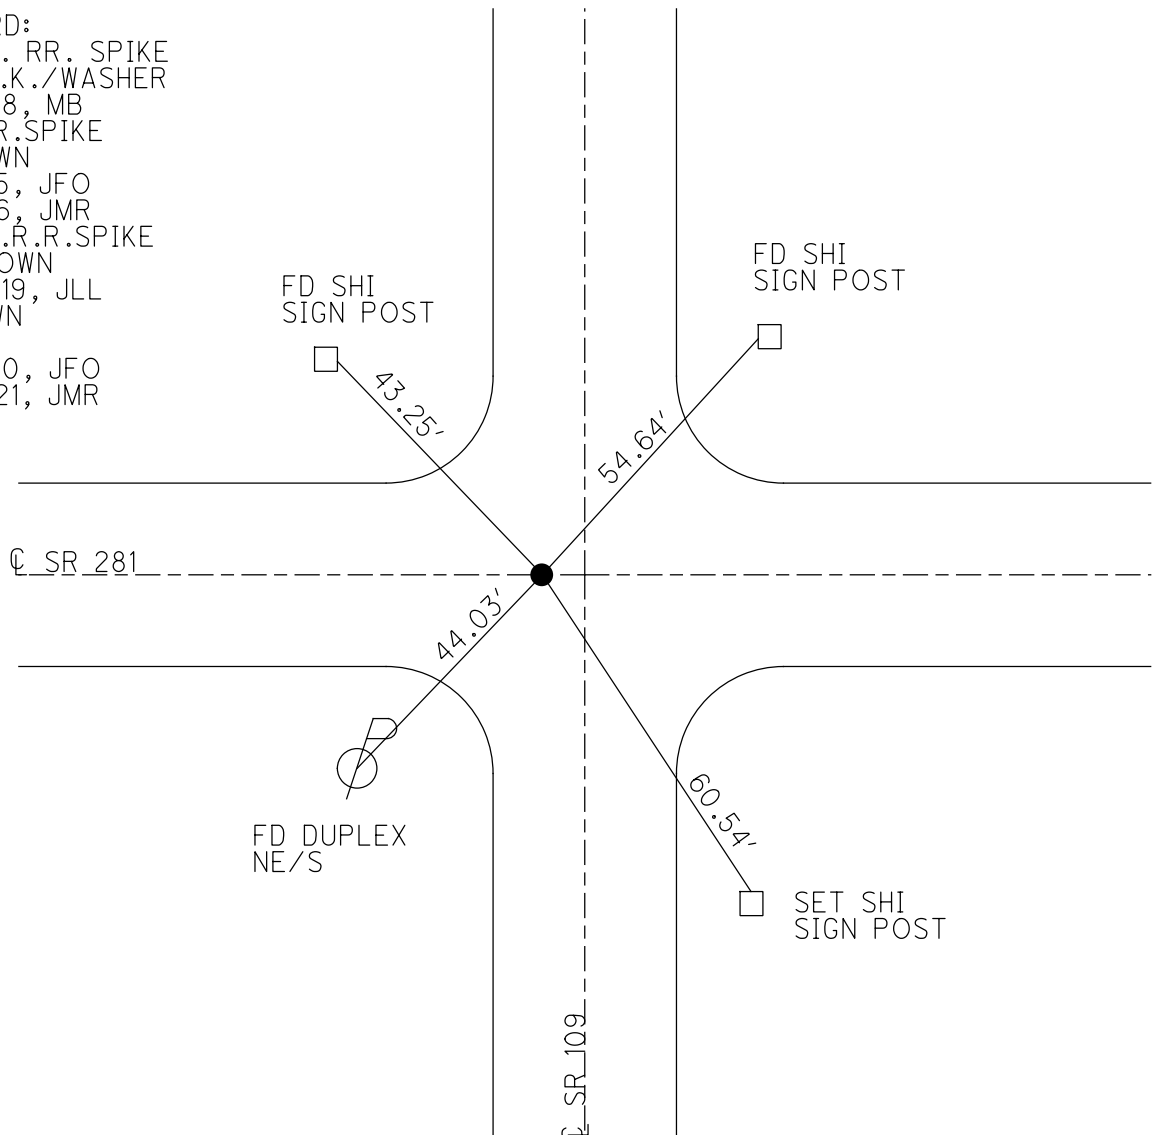

O.D.O.T. DISTRICT 2 SURVEY OFFICE (USE ONLY)

PERSONNEL

REFERENCE NO. 18

SHEET 1 OF 38

NOTES RHOADES

DATE 6/9/20

ROUTE SR 109

H.C. O'DONNELL

WEATHER SUNNY

COUNTY HENRY

R.C. RHOADES

TEMP. 90°

TOWNSHIP MONROE

SECTION 27

DWG BY RHOADES PID PAVE TRAIN

T 4 N R 7 E

TYPE MONUMENT LG.R.R.SPIKE

~~ON SURFACE~~ - BELOW 1"

OFFSET Q PAVEMENT 8.0' LT : ~~RT~~

- TO - EDGE PAVEMENT


STATION: 423+58

HORIZ.DATUM: NAD83 (2011)


GEOID: NAVD88 2012A

GRID: NORTHING: 592634.343

EASTING: 1546102.917

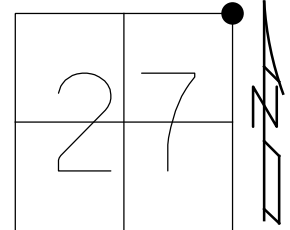

RECORD:
FD SM. RR. SPIKE
SET P.K./WASHER
9-2-98, MB
FD R.R.SPIKE
2" DOWN
9-2-15, JFO
8-3-16, JMR
FD SM.R.R.SPIKE
1.5" DOWN
2-25-19, JLL
1" DOWN
REF18
6/9/20, JFO

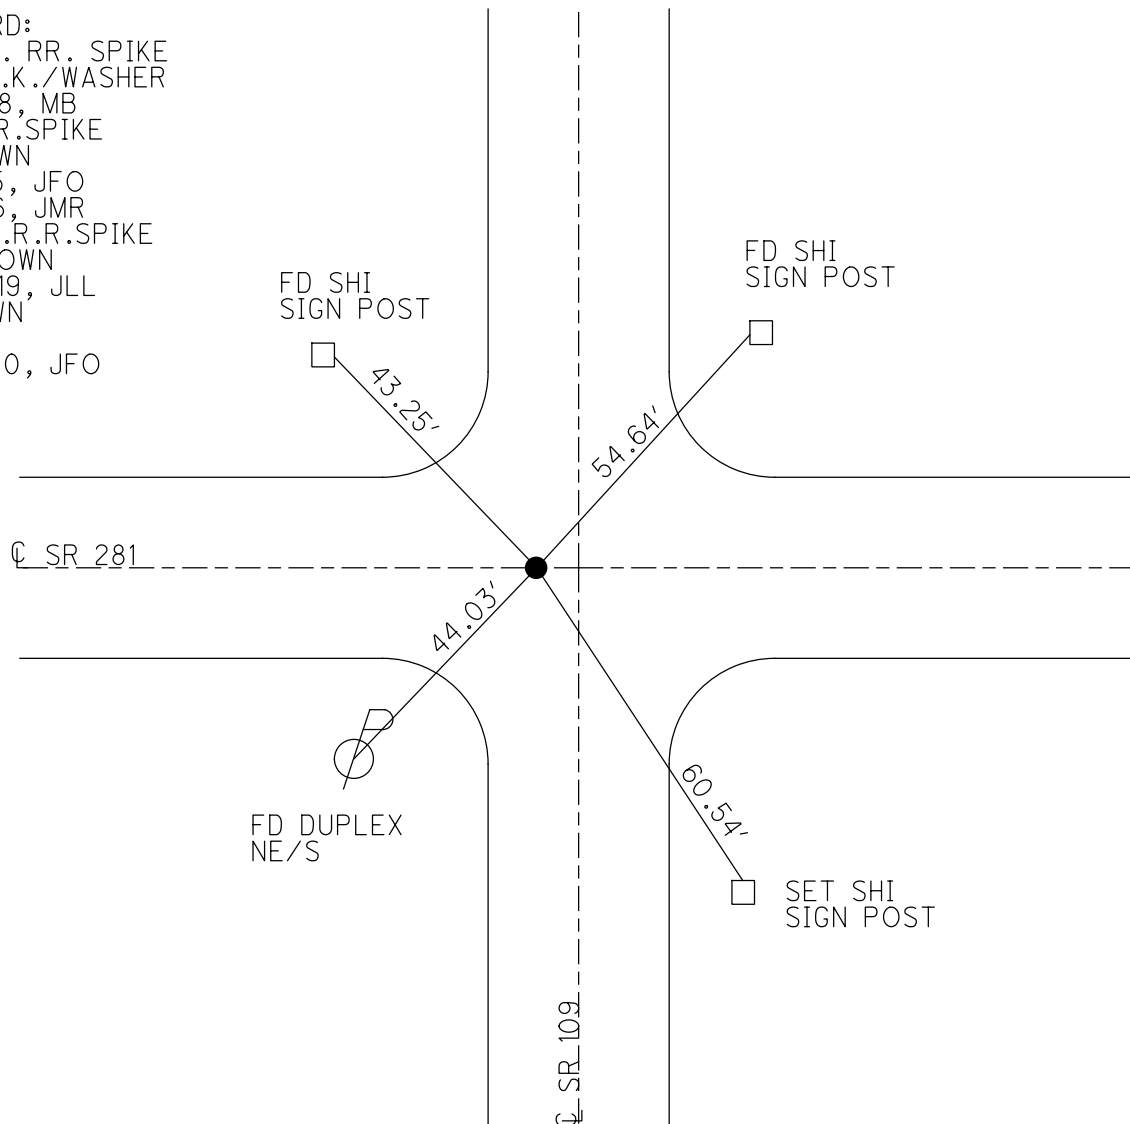


O.D.O.T. DISTRICT 2 SURVEY OFFICE (USE ONLY)

PERSONNEL _____ REFERENCE NO. 18 SHEET 1 OF 38

NOTES CANTERBURY DATE 5-18-98 ROUTE SR 109
H.C. ROUSUS WEATHER CLOUDY COUNTY HENRY
R.C. HUSS TEMP. 80°F TOWNSHIP MONROE
SECTION 27
T 4 N R 7 E

TYPE MONUMENT PK/WASHER
ON SURFACE - ~~BELOW~~ ON
LEFT - Q PAV'T - ~~RIGHT~~ 8.0'
- TO - EDGE PAVEMENT
S.L.M. 423+58

Grid: Northing: 592634.2994 Easting: 1546103.0132

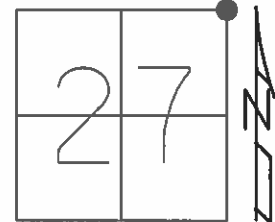


RECORD:
FD SM. RR. SPIKE
SET BY MDB

SET PK/WASHER
9-2-98, MB

FD RR. SPK
2" BELOW
GPS, REG18
9-2-15, JFO

NOT COVERED
8-3-16 JMR

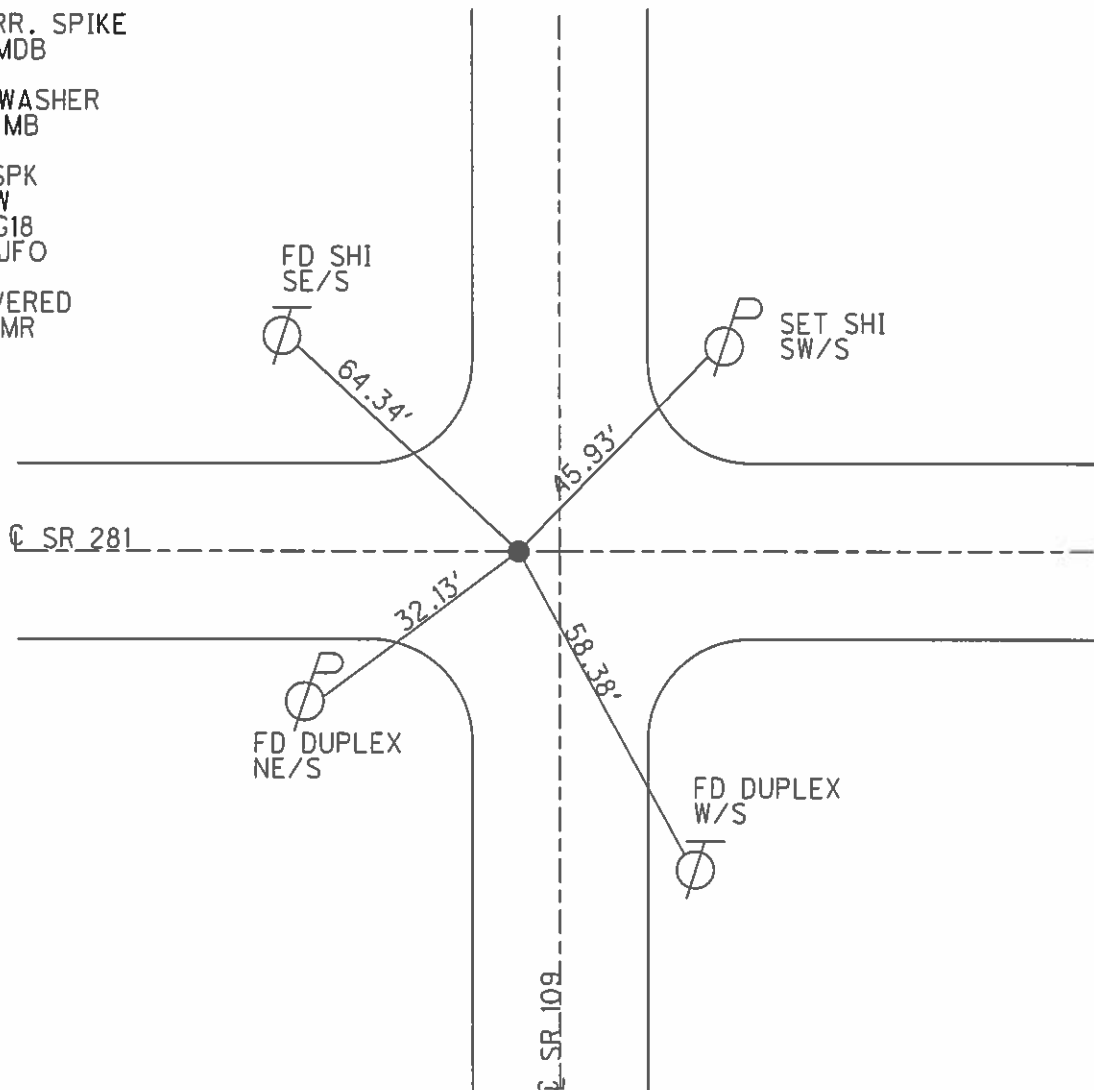

O.D.O.T. DISTRICT 2 SURVEY OFFICE

PERSONNEL

REFERENCE NO. 18

SHEET 21 OF 21

NOTES Canterbury

H.C. Rouss

R.C. Huss

DATE 5-18-98

WEATHER Cloudy

TEMP. +80°F

ROUTE 109

COUNTY Henry

TOWNSHIP MONROE

SECTION 27

T 4 N R 7 E


TYPE MONUMENT PK & WASHER

ON SURFACE - BELOW ON SURFACE

LEFT - Q PAV'T. - RIGHT Q of SR 109 & Rmt


TO EDGE PAVEMENT ON Q of Rmt. SR 281

S.L.M. 12+899 ssk (423+58 ssk)

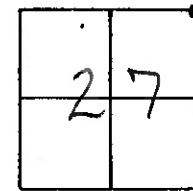

Fnd. Sm. RR spk. @ Surface
Set by MDB on 6-23-89

RESET PK & WASHER
9-23-98
MB

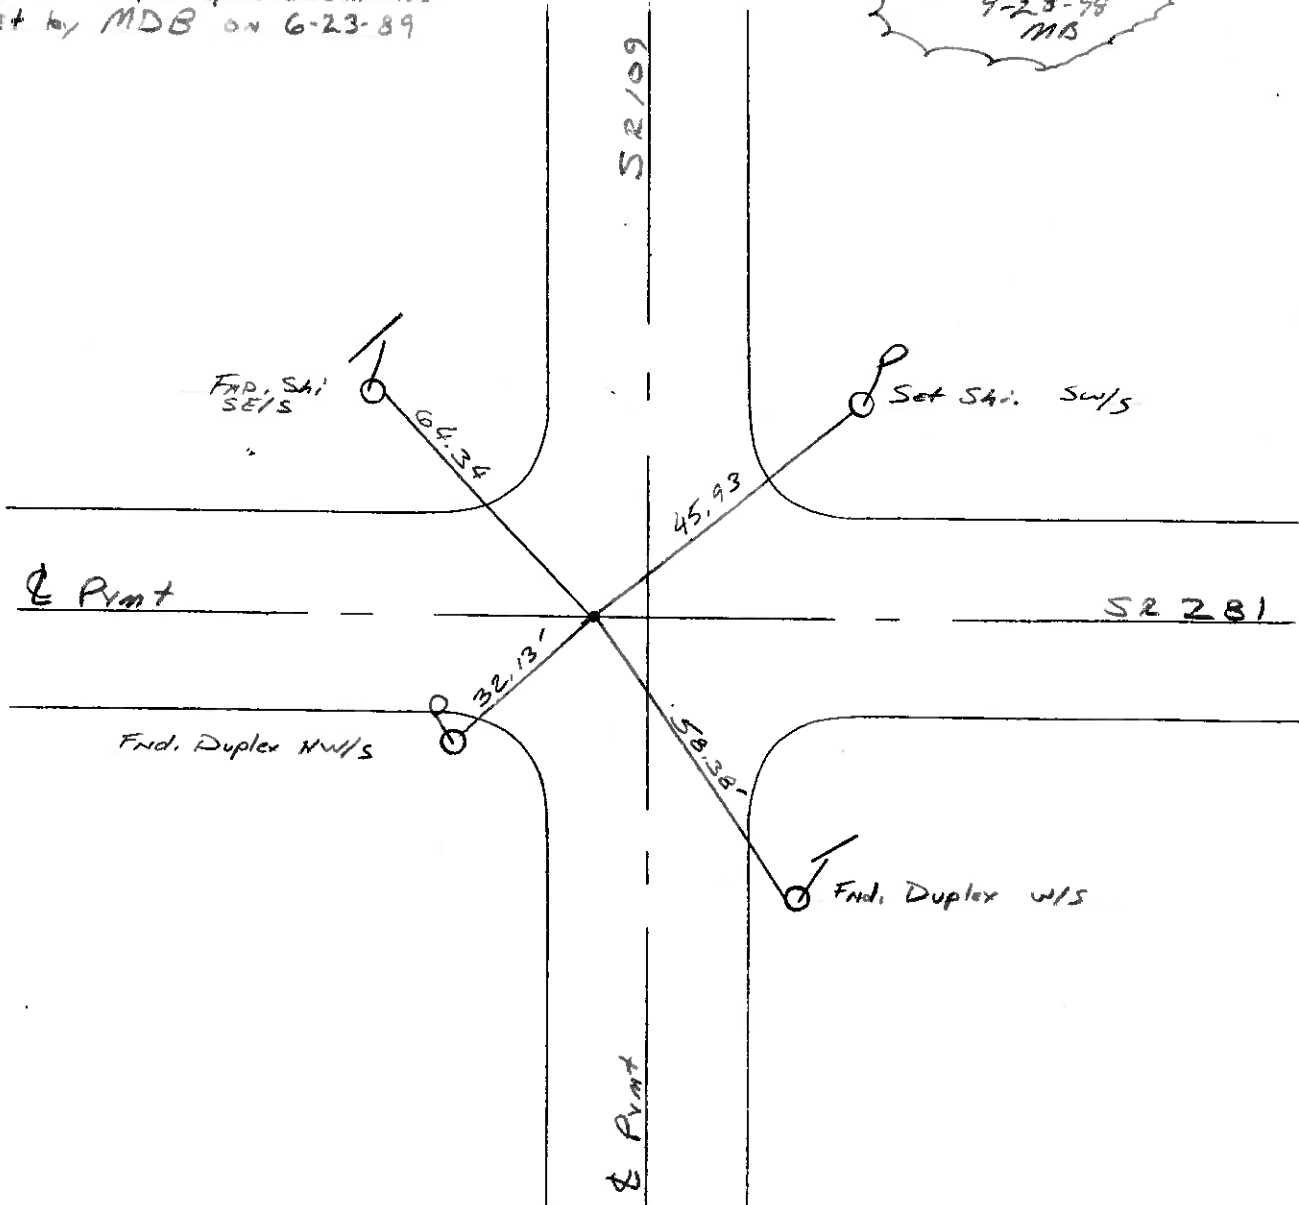

DRAWN BY TR

O.D.O.T. DISTRICT 2 SURVEY OFFICE

PERSONNEL

REFERENCE NO. 18

SHEET 2 OF

NOTES BARNHISEL

H.C. " "

R.C. Locheke

DATE 3-30-89

WEATHER RAIN

TEMP. +40°

ROUTE 109 @ 281

COUNTY HENRY

TOWNSHIP MONROE

SECTION 27

T 4 N R 7 E


TYPE MONUMENT PK & WASHER

ON SURFACE - BELOW YES


LEFT - CL PAV'T. - RIGHT 7.3' OF S.R. 109

TO EDGE PAVEMENT ON 2 PAV'T OF S.R. 281

S.L.M. 423+58

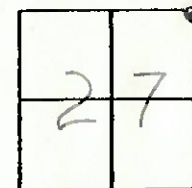

Set 3m RR Spk
6-23-89
m.d.b.

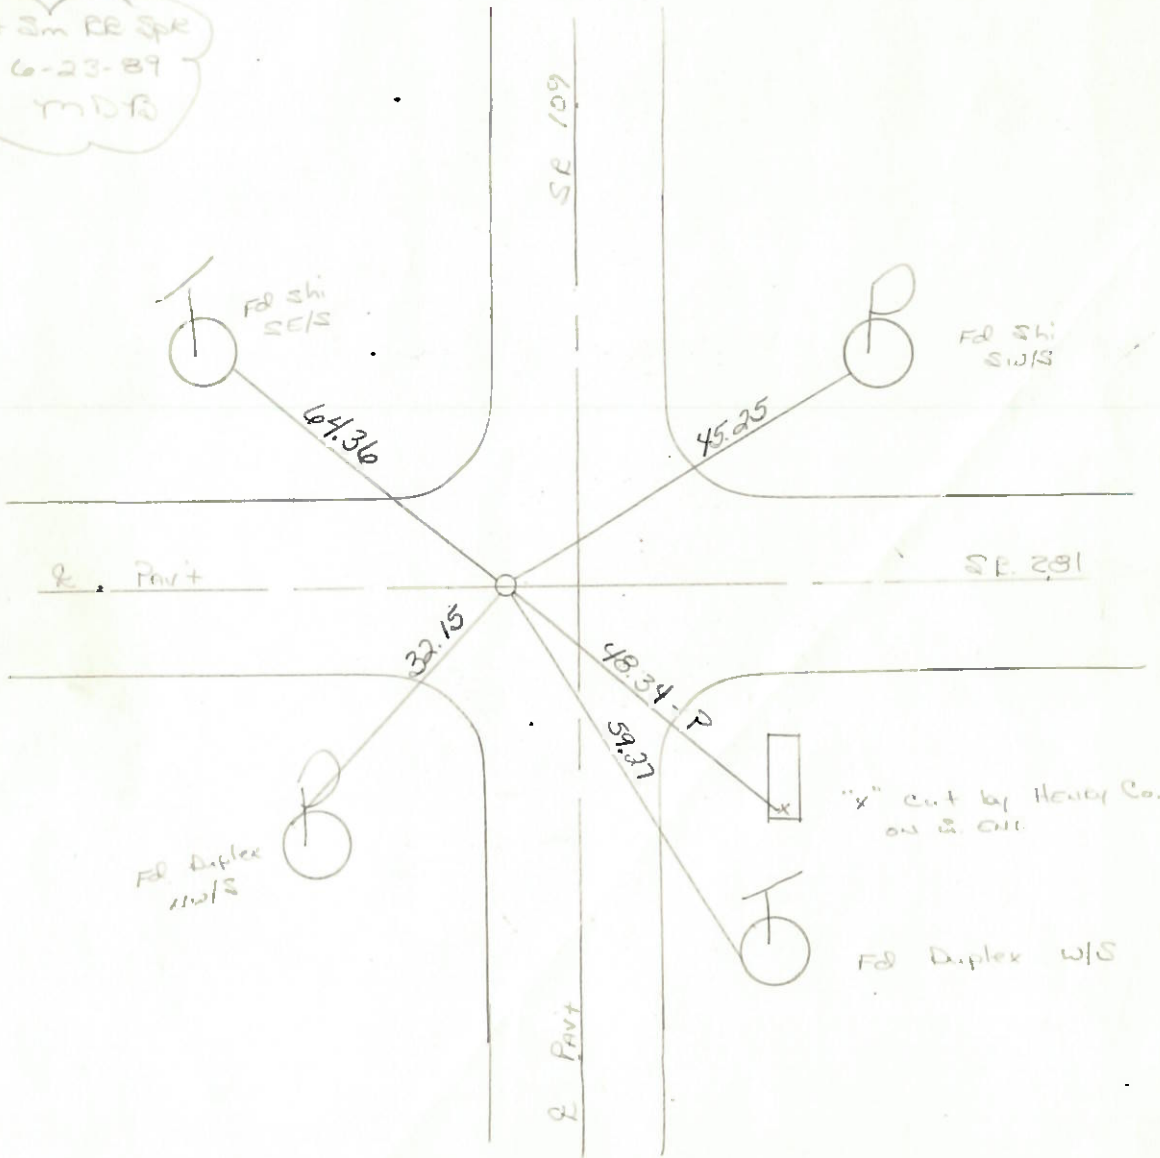

ODOT DISTRICT 2 SURVEY OFFICE

SHEET _____ OF _____

County HENRY S.R. 109 @ 281

Date April 26 83

Township MONROE

Weather CLEAR

Section 27

Temp. +65°

T4N, R7E

Personnel HOFFMAN

LOEHKE

HOUSE HOLDER

#18




Fd R.R. SPL @ SURFACE, SET BY COUNTY
ON & PAUT SR 281

SR 109 S.L.M. 422+85

~~2.8~~ Lt. of & PAUT SR 109
7.3'

SET P.K./WASHER
9-19-83 SWH

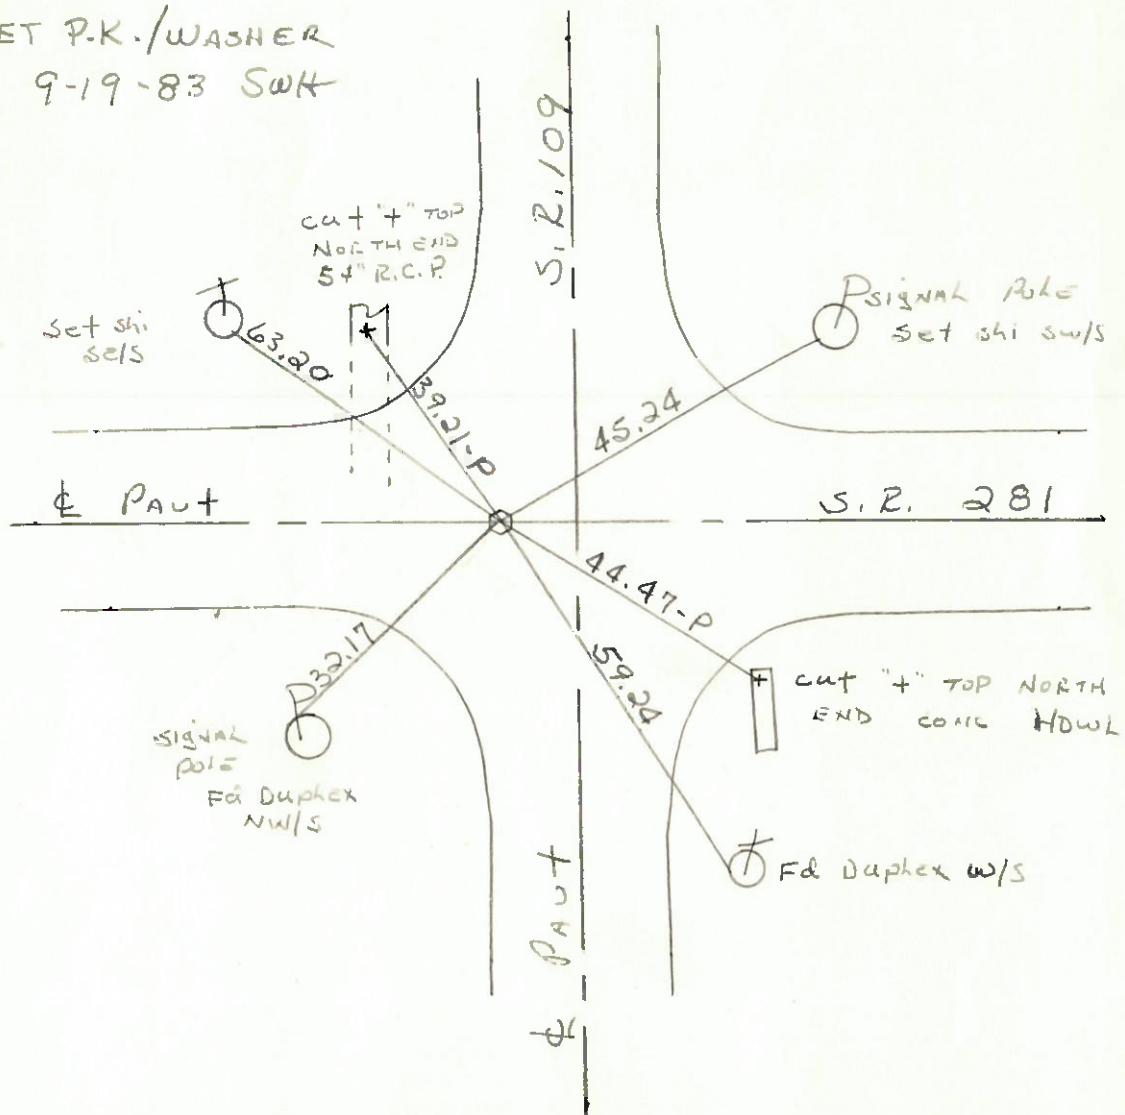

PERSONNEL	TITLE	PERSONNEL	TITLE	COUNTY	DATE	S. R.	WEATHER	SEC.	TEMP.
TOM SIE				Henry	Nov. 1, 1973	109		MONROE TWP.	
NEUS-1									
SEAN T. I.									
THOMAS									

