

O.D.O.T. DISTRICT 2 SURVEY OFFICE (USE ONLY)

PERSONNEL

REFERENCE NO. 19

SHEET 21 OF 25

NOTES NIESE DATE 10/7/24

H.C. MILLER WEATHER SUNNY

R.C. PRESTON-COLVIN TEMP. 64°

ROUTE SR 109

COUNTY HENRY

TOWNSHIP MONROE

SECTION 23

DWG BY BARRIERE PID 99587

T 4 N R 7 E

TYPE MONUMENT MAG NAIL/WASHER

ON SURFACE - BELOW ON

OFFSET C PAVEMENT LT : RT

TO EDGE PAVEMENT

STATION: 450+07

HORIZ.DATUM: OHIO LDP (HENRY)


GEOID: 18

GRID: NORTHING: 595285.4033


EASTING: 1546113.6478

LDP: NORTHING: 451927.417

EASTING: 181320.909

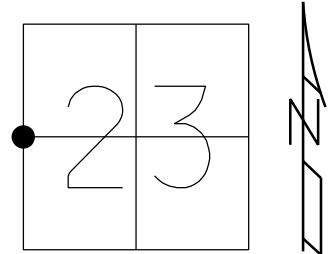

RECORD:
SET MAG/WASHER
10-28-04, MC
FD MAG/WASHER
GPS, REF18
9-2-15, JFO
NOT COVERED
8-3-16 JMR
FD MAG/WASHER
2-25-19, JLL
SET MAG/WASHER
10/7/24, TDN

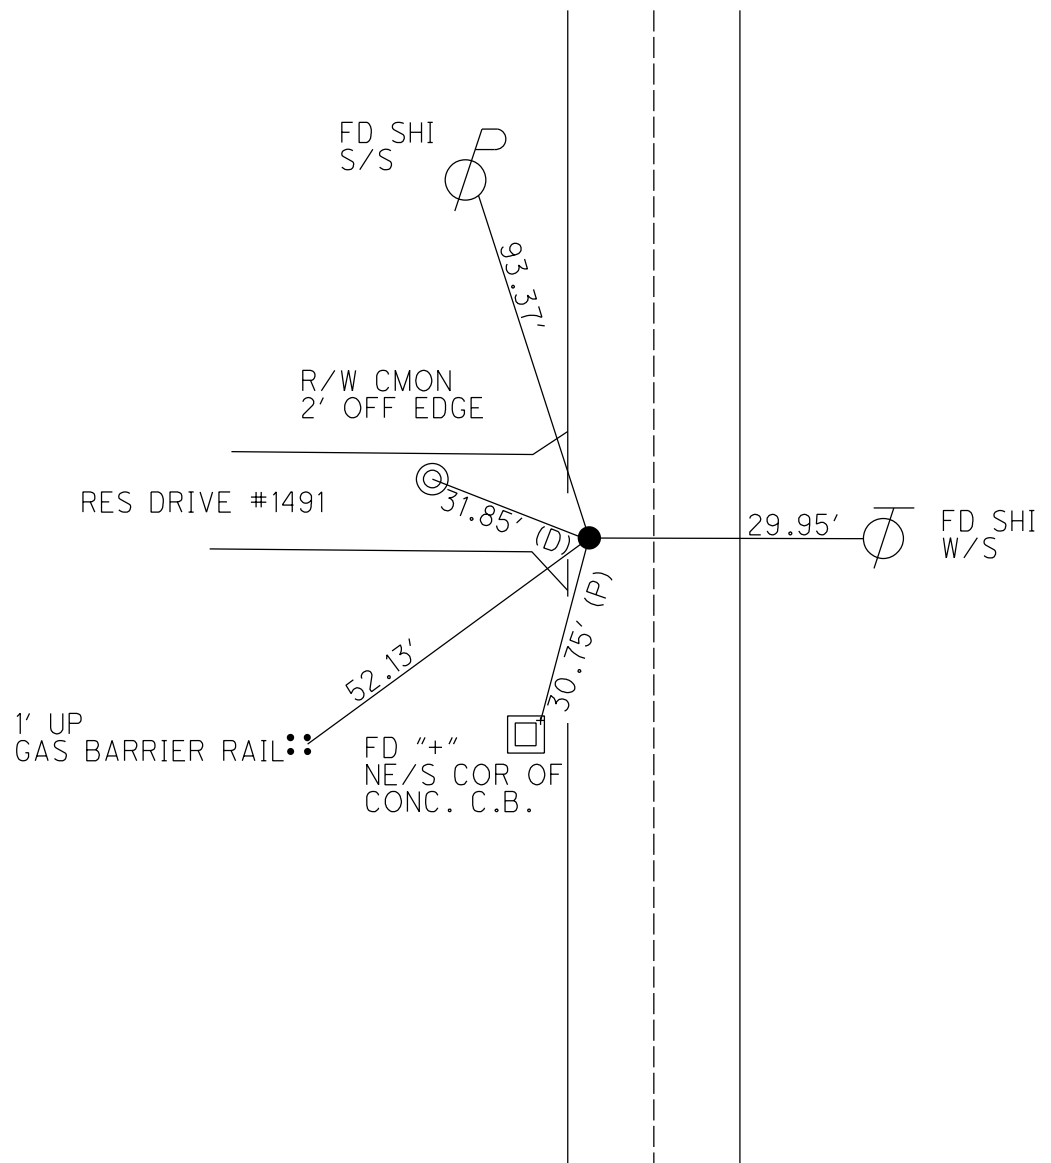

O.D.O.T. DISTRICT 2 SURVEY OFFICE (USE ONLY)

PERSONNEL

REFERENCE NO.

19

SHEET

2

OF

38

NOTES

RHOADES

DATE

9-2-15

ROUTE

SR 109

H.C.

O'DONNELL

WEATHER

SUNNY

COUNTY

HENRY

R.C.

RHOADES

TEMP.

72°F

TOWNSHIP

MONROE

SECTION

23

T 4 N

R 7 E

TYPE MONUMENT

MAG/WASHER

ON SURFACE - ~~BELOW~~

ON

LEFT - C PAV'T

~~RIGHT~~

6.9'

2.3' TO LT EDGE PAVEMENT

S.L.M.


450+07

Grid: Northing:

595285.4033

Easting:

1546113.6478

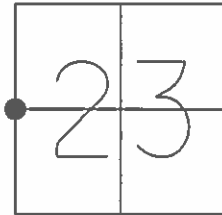


RECORD:

SET MAG/WASHER
10-28-04, MC

FD MAG/WASHER
GPS, REG18
9-2-15, JFO

NOT COVERED
8-3-16 JMR

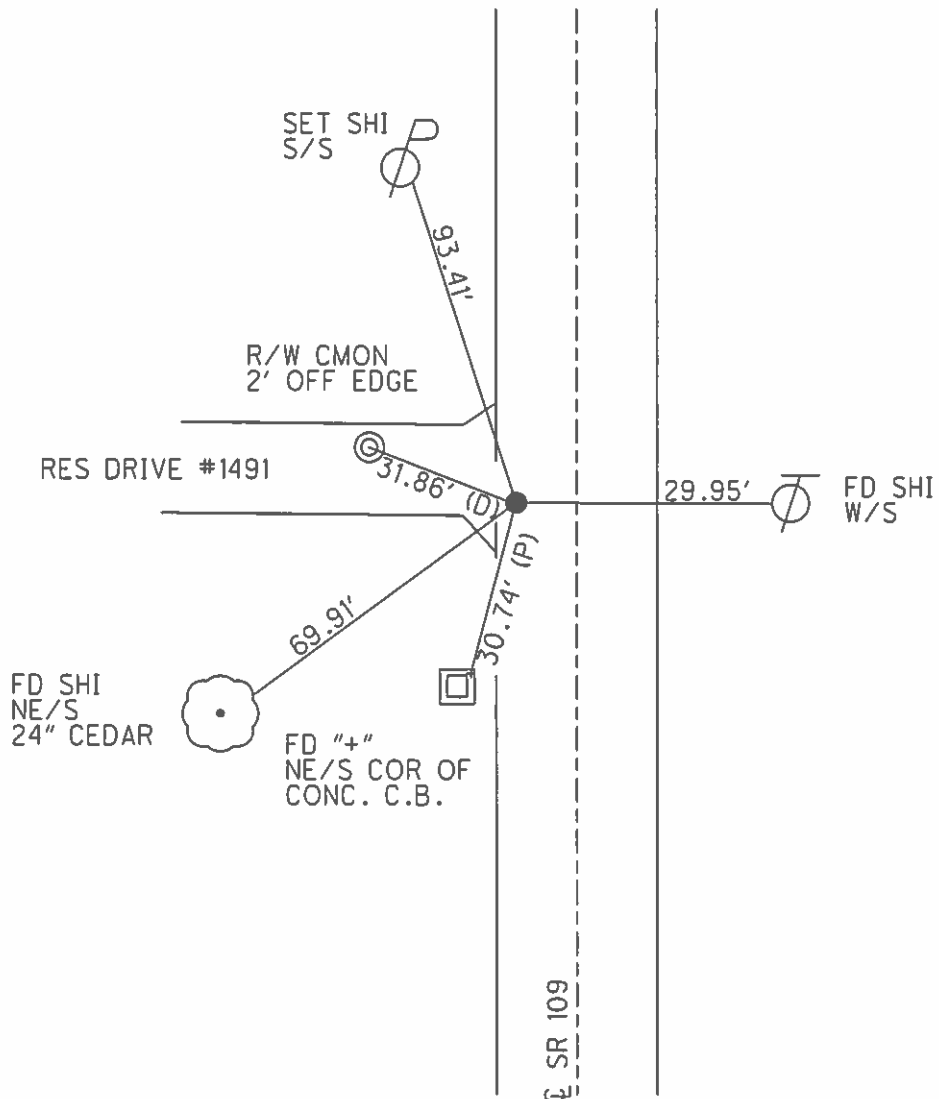

O.D.O.T. DISTRICT 2 SURVEY OFFICE

PERSONNEL

REFERENCE NO. 19

SHEET 1 OF 23

NOTES CANTERBURY

H.C. BARNHISEL

R.C. HOOKE

DATE 8/30/04

WEATHER SUN

TEMP. +70°

ROUTE 109

COUNTY HENRY

TOWNSHIP MONROE

SECTION 23

T 4 N R 7 E



TYPE MONUMENT P.K. / WASHER

ON SURFACE - BELOW YES

LEFT- Q PAV'T. - RIGHT 6.9' LT E

2.3' TO LT. EDGE PAVEMENT

S.L.M. 450+07

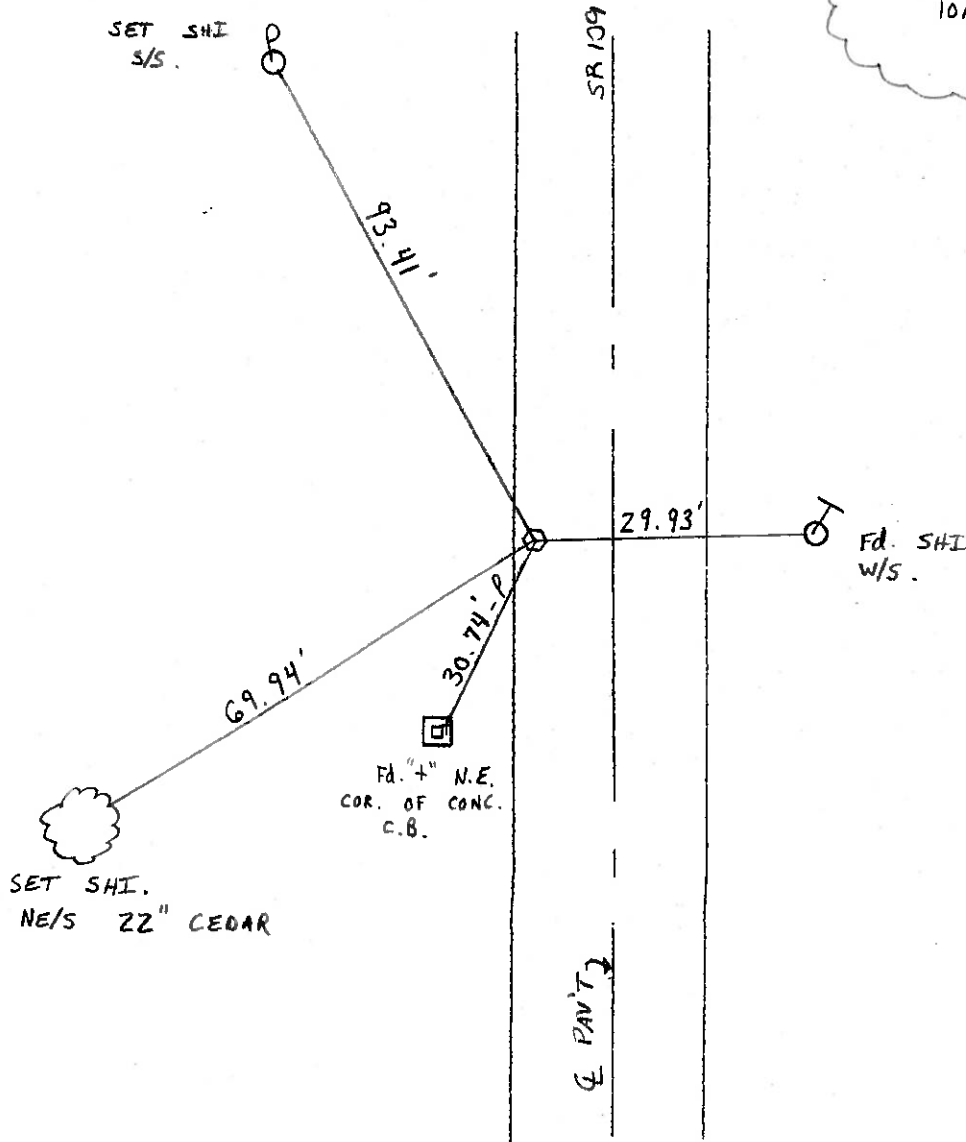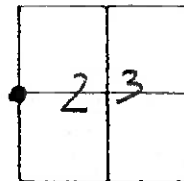

RESET MAG/WASHER

10/28/04

M.C.

Resurveyed 2004

O.D.O.T. DISTRICT 2 SURVEY OFFICE

PERSONNEL

REFERENCE NO. 12

SHEET OF

NOTES BARNHISEL

H.C. K52

R.C. BARNHISEL

OTTO A

DATE 8-5-93

WEATHER SUNNY

TEMP. + 25° F.

ROUTE 109

COUNTY HENRY

TOWNSHIP MONROE

SECTION 23

T4 N R


TYPE MONUMENT LARGE R.R. SPK.

ON SURFACE - BELOW YES


LEFT- & PAV'T. - RIGHT 6.8

3.0 TO LT EDGE PAVEMENT

S.L.M. 450 + 07

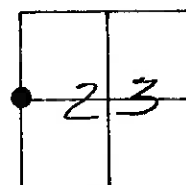

8-24-93
SET PK/WASHER
MB

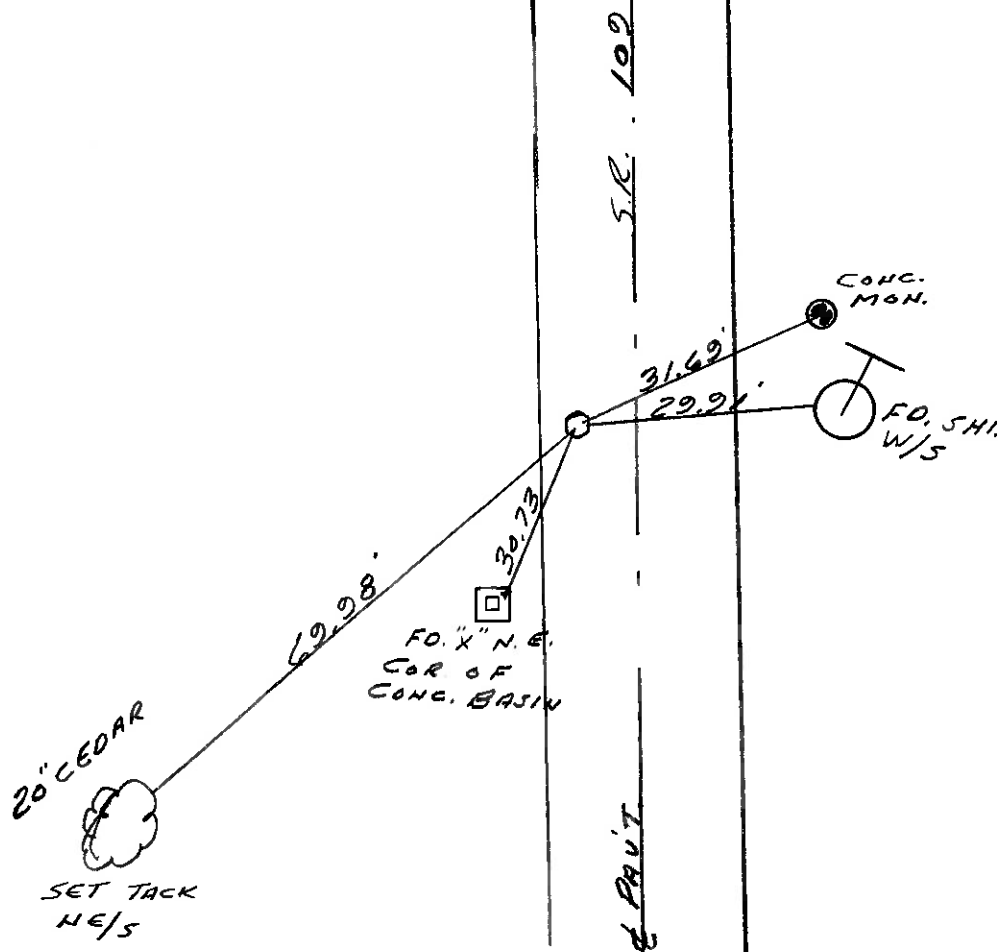

Resurfaced 1993

O.D.O.T. DISTRICT 2 SURVEY OFFICE

PERSONNEL

REFERENCE NO. 19

SHEET OF

NOTES Barnhiser

H.C. Hoffman

R.C. Loehrke

DATE 4-8-85

WEATHER clear

TEMP. +35°

ROUTE 109

COUNTY Henry

TOWNSHIP Monroe

SECTION 2

T 4 N R 7 E



TYPE MONUMENT Lg RR / spk

ON SURFACE - BELOW ✓

LEFT- & PAV'T. - RIGHT 6.7

2.5 TO L+ EDGE PAVEMENT

S.L.M. 449 + 42

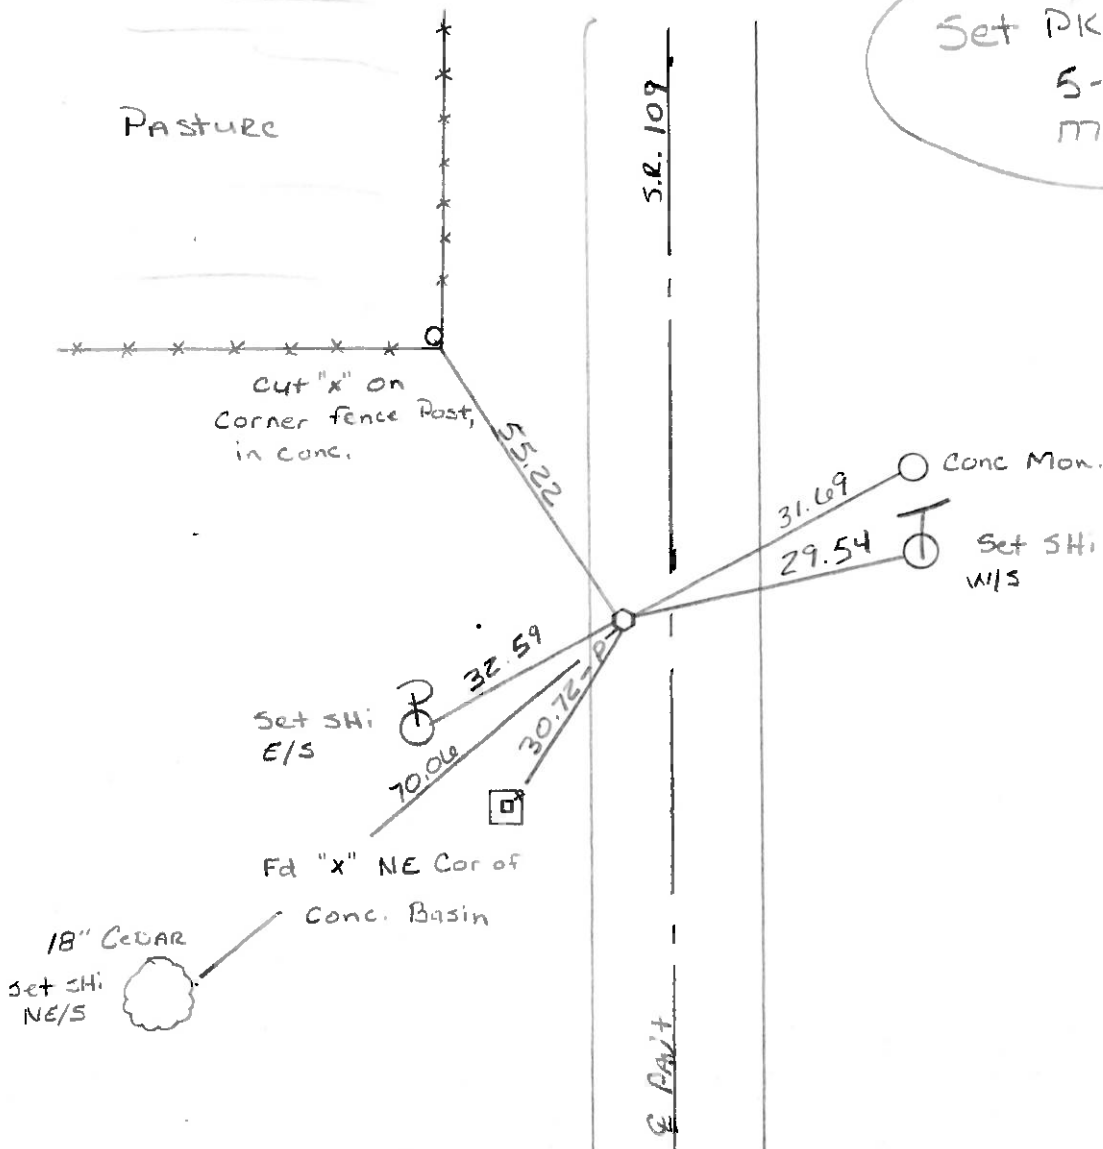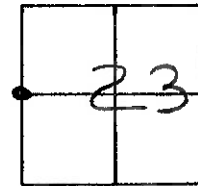

Set PK/Washer
5-8-85
MDB