

O.D.O.T. DISTRICT 2 SURVEY OFFICE (USE ONLY)

PERSONNEL

REFERENCE NO. 21A

SHEET 21 OF 25

NOTES NIESE DATE 10/7/24
 H.C. MILLER WEATHER SUNNY
 R.C. PRESTON-COLVIN TEMP. 68°

ROUTE SR 109
 COUNTY HENRY
 TOWNSHIP MONROE
 SECTION 14
 T 4 N R 7 E

DWG BY BARRIERE PID 99587

TYPE MONUMENT MAG NAIL/WASHER

ON SURFACE - BELOW ON

OFFSET $\varnothing$ PAVEMENT LT : RT


 TO EDGE PAVEMENT

STATION: 517+32


HORIZ.DATUM: OHIO LDP (HENRY) GEOID: 18

GRID: NORTHING: 601909.2996 EASTING: 1546144.5022

LDP: NORTHING: 458551.188 EASTING: 181230.407

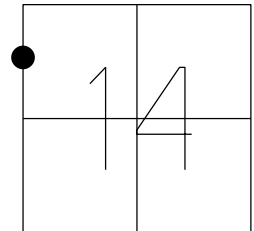

RECORD:
 SET MAG/WASHER
 10-28-04, MC
 FD MAG NAIL
 GPS, REF21
 9-2-15, JFO
 UNCOVERED
 8-3-16, JMR
 FD MAG/W
 REFA21
 12/7/21, DSA
 SET MAG/WASHER
 10/7/24, JAM

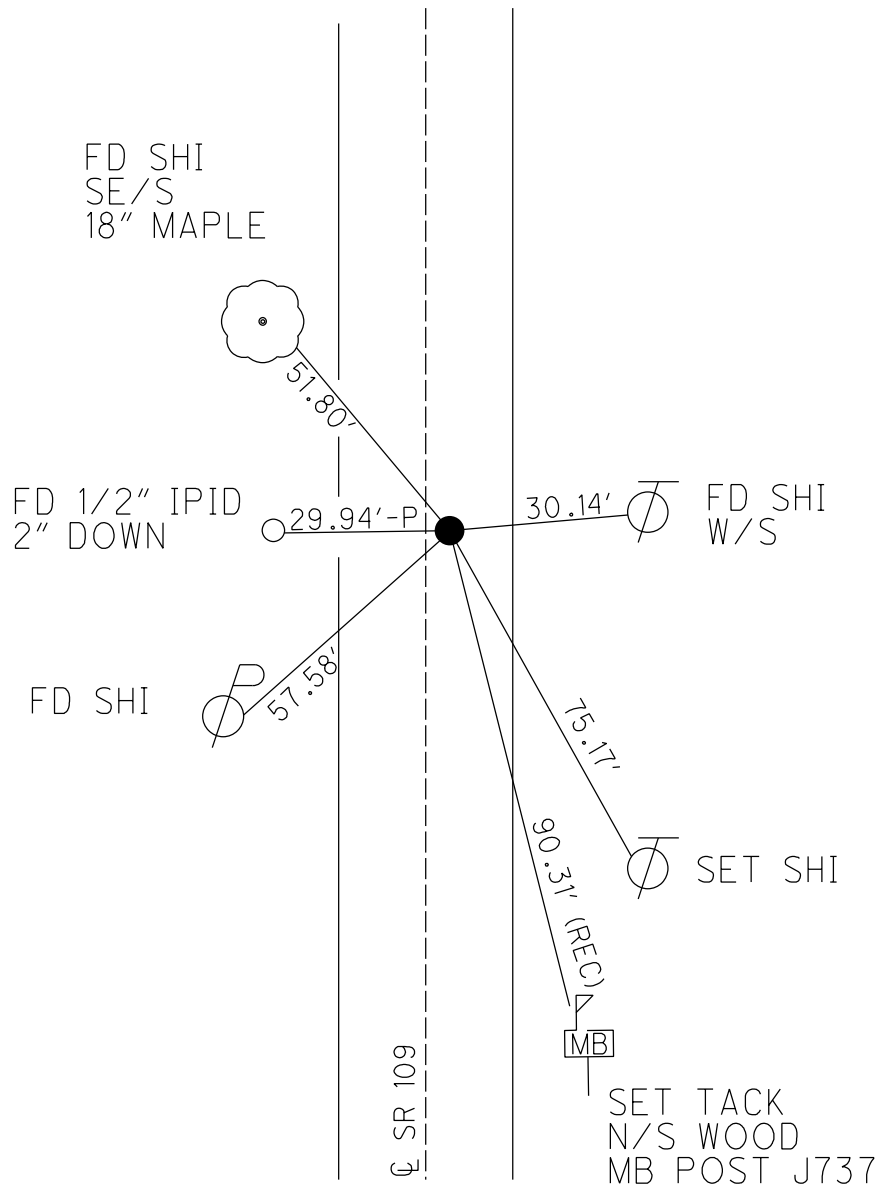

O.D.O.T. DISTRICT 2 SURVEY OFFICE (USE ONLY)

PERSONNEL _____ REFERENCE NO. 21 A SHEET 6 OF 38

NOTES RHOADES DATE 9-2-15 ROUTE SR 109
H.C. O'DONNELL WEATHER SUNNY COUNTY HENRY
R.C. RHOADES TEMP. 72°F TOWNSHIP MONROE
SECTION 14
T 4 N R 7 E

TYPE MONUMENT MAG/WASHER


ON SURFACE - ~~BELOW~~ ON

~~LEFT~~ - Q PAV'T - RIGHT 0.5'

9.1' TO RT EDGE PAVEMENT

S.L.M. 517+32


Grid: Northing: 601909.2996 Easting: 1546144.5022

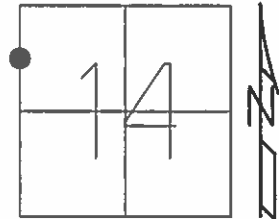

RECORD:
SET MAG/WASHER
10-28-04, MC

FD MAG NAIL
GPS, REF21
9-2-15, JFO

UNCOVERED
8-3-16, JMR

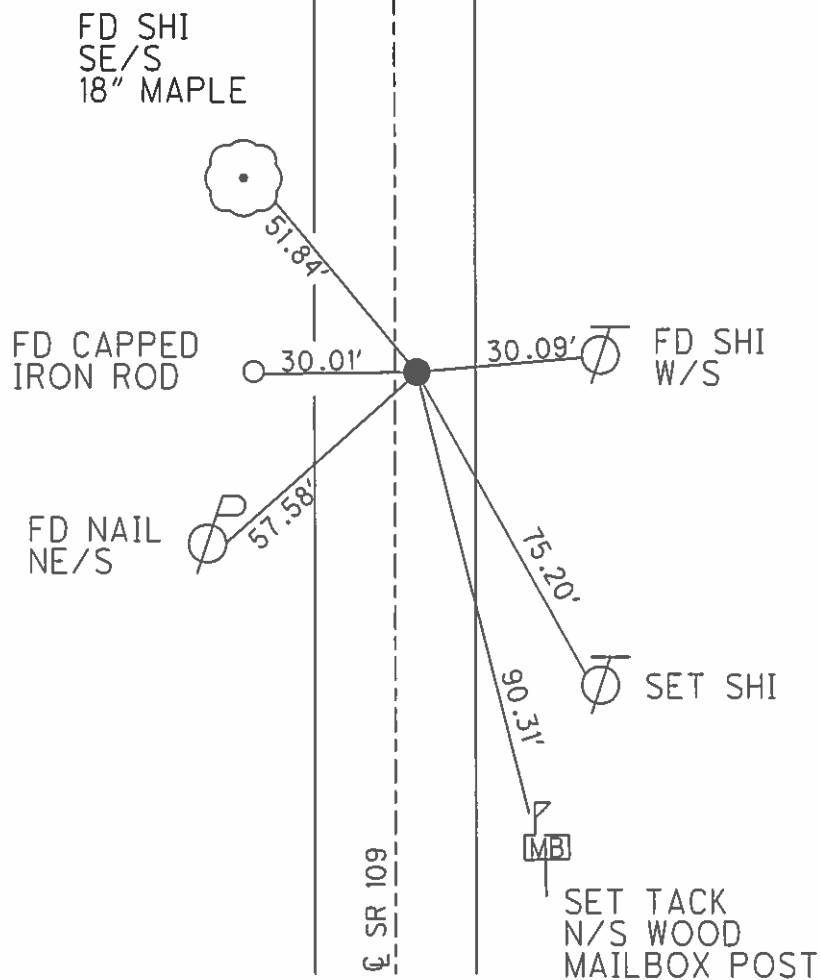

O.D.O.T. DISTRICT 2 SURVEY OFFICE

PERSONNEL

REFERENCE NO. 21-A

SHEET 5 OF 23

NOTES CANTERBURY

H.C. BARNHISEL

R.C. HOOKE

DATE 8/31/04

WEATHER SUN

TEMP. +65°

ROUTE 109

COUNTY HENRY

TOWNSHIP MONROE

SECTION 14

T 4 N R 7 E


TYPE MONUMENT P.K. / WASHER

ON SURFACE - ~~BELOW~~ SURFACE

~~LEFT - & PAV'T.~~ - RIGHT 0.5' RT &

9.1' TO RT. EDGE PAVEMENT

S.L.M. 517 +32

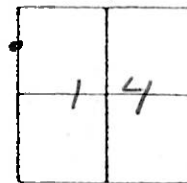

RESET MAG/WASHER
10/28/04
M.C.

16" MAPLE
SET SHI
SE/S.

51.90'

30.01'
Fd. CAPPED
IRON
ROD

30.12'
SET SHI.
W/S.

59.73'

Fd. SHI.
NE/S.

90.31'

SET TACK
N/S. WOOD MAIL BOX POST

SR 109

& PAV'T.

O.D.O.T. DISTRICT 2 SURVEY OFFICE

PERSONNEL

REFERENCE NO. 21-A SHEET OF

NOTES BARNHISEL

H.C. KUSZ

DATE 8-5-93

ROUTE 100

R.C. BARNHISEL

WEATHER SUNNY

COUNTY HENRY

OTTO

TEMP. +25°F

TOWNSHIP MONROE

SECTION 14

T4 NR 7 E


TYPE MONUMENT LARGE R.R. SPK.

ON SURFACE - BELLO YES

LEFT - CL PAV'T. - RIGHT 0.5

10.3 TO 12.7 EDGE PAVEMENT

S.L.M. 517+32

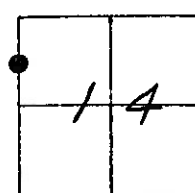

SET PK/WASHER
8-24-93
MB

12" MAPLE
SET TACK
SE/S

SR. 100

32.02
IRON
PIN

59.74
SET SHI.
NE/S

29.32
FO SHI.
W/S

88.99
SET TACK
N/S MAIL BOX
POST

CL PAV'T.

O.D.O.T. DISTRICT 2 SURVEY OFFICE

PERSONNEL

REFERENCE NO. 21-A

SHEET ____ OF ____

NOTES BARNHISEL

H.C. Hoffman

R.C. Loehrke

DATE 4-8-85

WEATHER clear

TEMP. + 35°

ROUTE 109

COUNTY Henry

TOWNSHIP Monroe

SECTION 14

T 4 N R 7 E


TYPE MONUMENT Lg RR / 3PK

ON SURFACE - ~~BELOW~~ ✓

LEFT - C. PAV'T. - RIGHT 0.5

8.4 TO 2+ EDGE PAVEMENT

S.L.M. 516+75

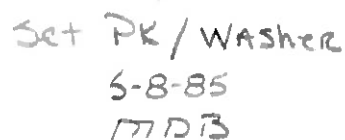

ODOT DISTRICT 2 SURVEY OFFICE

SHEET 16 OF

County HENRY S.R. 18-109

Township MARION

Section 3

T3N, R7E

Personnel S. Hoffman

C. Doehrke


L. Householder

21-A

Date 5-29-81

Weather PARTLY CLOUDY

Temp. +75°

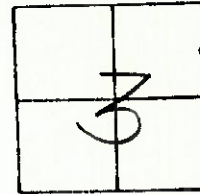

4-25-83
Clear
+600
Sunk
+
Clear

YES Fd. STONE 2" Below surface
10.0' west of W.F.P.
19.7 West of & Part SR 18/109

Hex 18 SLM =
538 +69

Placed 8" long Broken
Piece of steel track
spring over stone

