

O.D.O.T. DISTRICT 2 SURVEY OFFICE (USE ONLY)

PERSONNEL

REFERENCE NO. 22

SHEET 21 OF 25

NOTES NIESE

DATE 10/7/24

ROUTE SR 109

H.C. MILLER

WEATHER SUNNY

COUNTY HENRY

R.C. PRESTON-COLVIN

TEMP. 65°

TOWNSHIP MONROE

DWG BY BARRIERE

PID 99587

SECTION 14

T 4 N R 7 E

TYPE MONUMENT MAG NAIL/WASHER

ON SURFACE - BELOW ON

OFFSET Q PAVEMENT LT : RT

TO EDGE PAVEMENT

STATION: 530+56

HORIZ.DATUM: OHIO LDP (HENRY)


GEOID: 18

GRID: NORTHING: 603233.0863


EASTING: 1546151.3797

LDP: NORTHING: 459875.029

EASTING: 181212.854

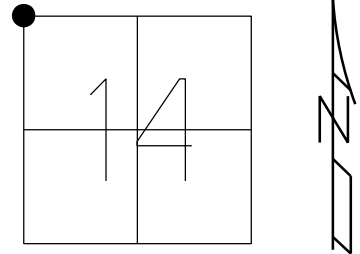

RECORD:
SET MAG/WASHER
10-28-04, MC
FD MAG SHANK
SET MAG/WASHER
GPS, REF21
9-2-15, JFO
UNCOVERED
8-3-16, JMR
FD MAG/W
REF22
12/7/21, DSA
SET MAG/WASHER
10/7/24, JAM

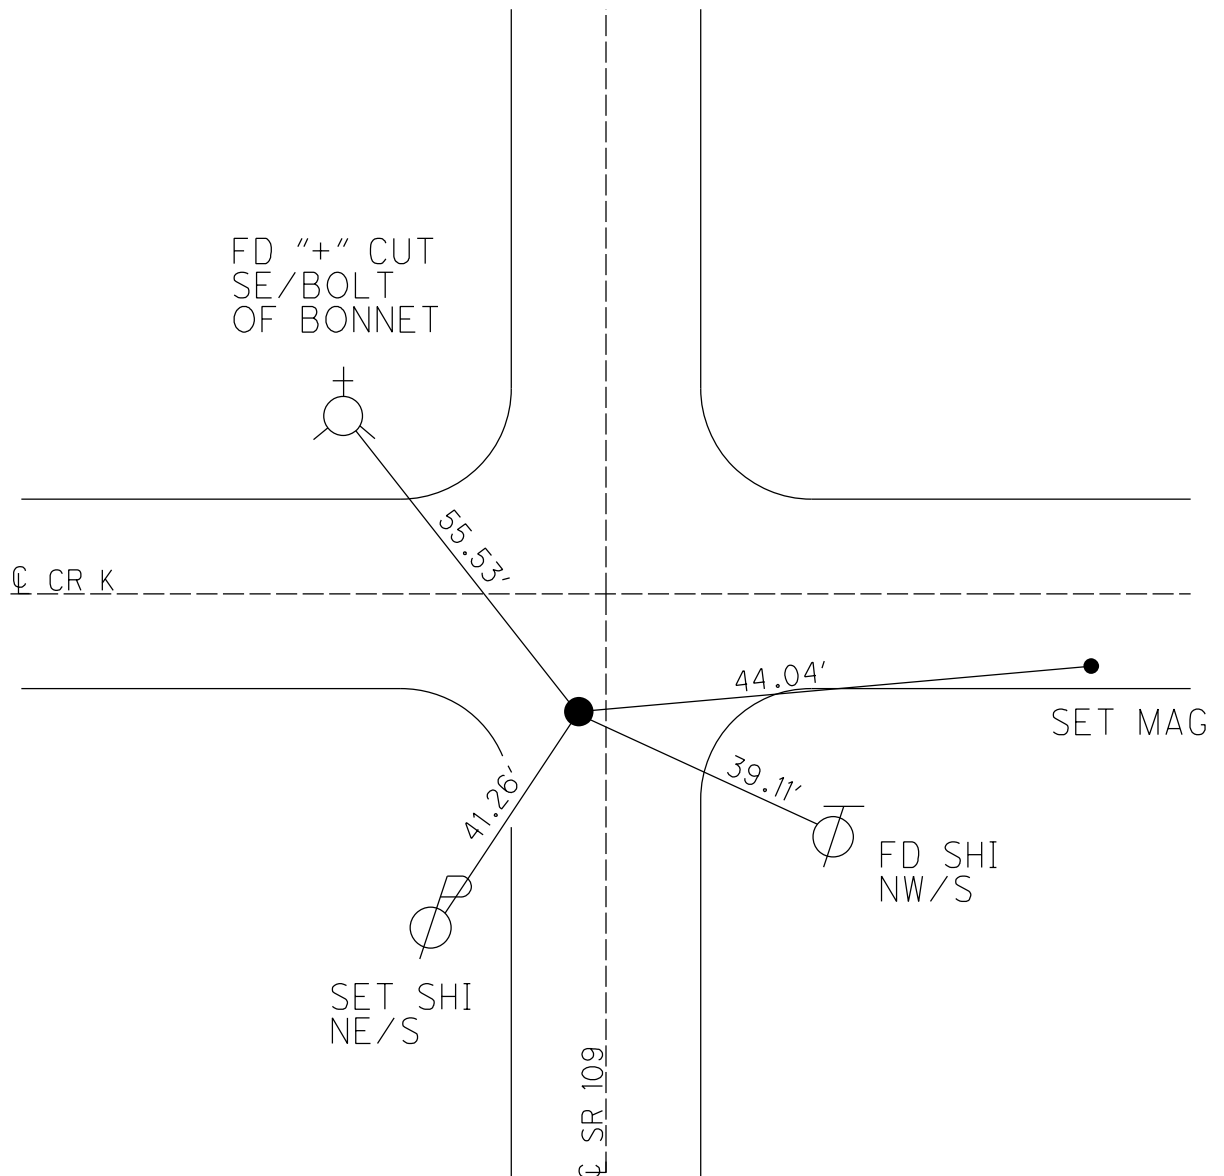


O.D.O.T. DISTRICT 2 SURVEY OFFICE (USE ONLY)

PERSONNEL _____ REFERENCE NO. 22 SHEET 7 OF 38
 NOTES RHOADES DATE 9-2-15 ROUTE SR 109
 H.C. O'DONNELL WEATHER SUNNY COUNTY HENRY
 R.C. RHOADES TEMP. 72°F TOWNSHIP MONROE
 SECTION 14
 T 4 N R 7 E

TYPE MONUMENT MAG/WASHER
 ON SURFACE - ~~BELOW~~ ON
 LEFT - Q PAV'T - ~~RIGHT~~ 1.0'
8.9' TO LT EDGE PAVEMENT
 S.L.M. 530+56


Grid: Northing: 603233.0863 Easting: 1546151.3797

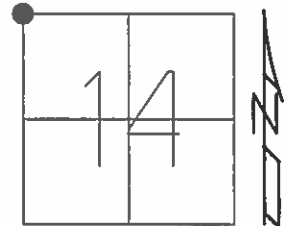

RECORD:
 SET MAG/WASHER
 10-28-04, MC

FD MAG SHANK
 SET MAG/WASHER
 GPS, REF21
 9-2-15, JFO

UNCOVERED
 8-3-16, JMR

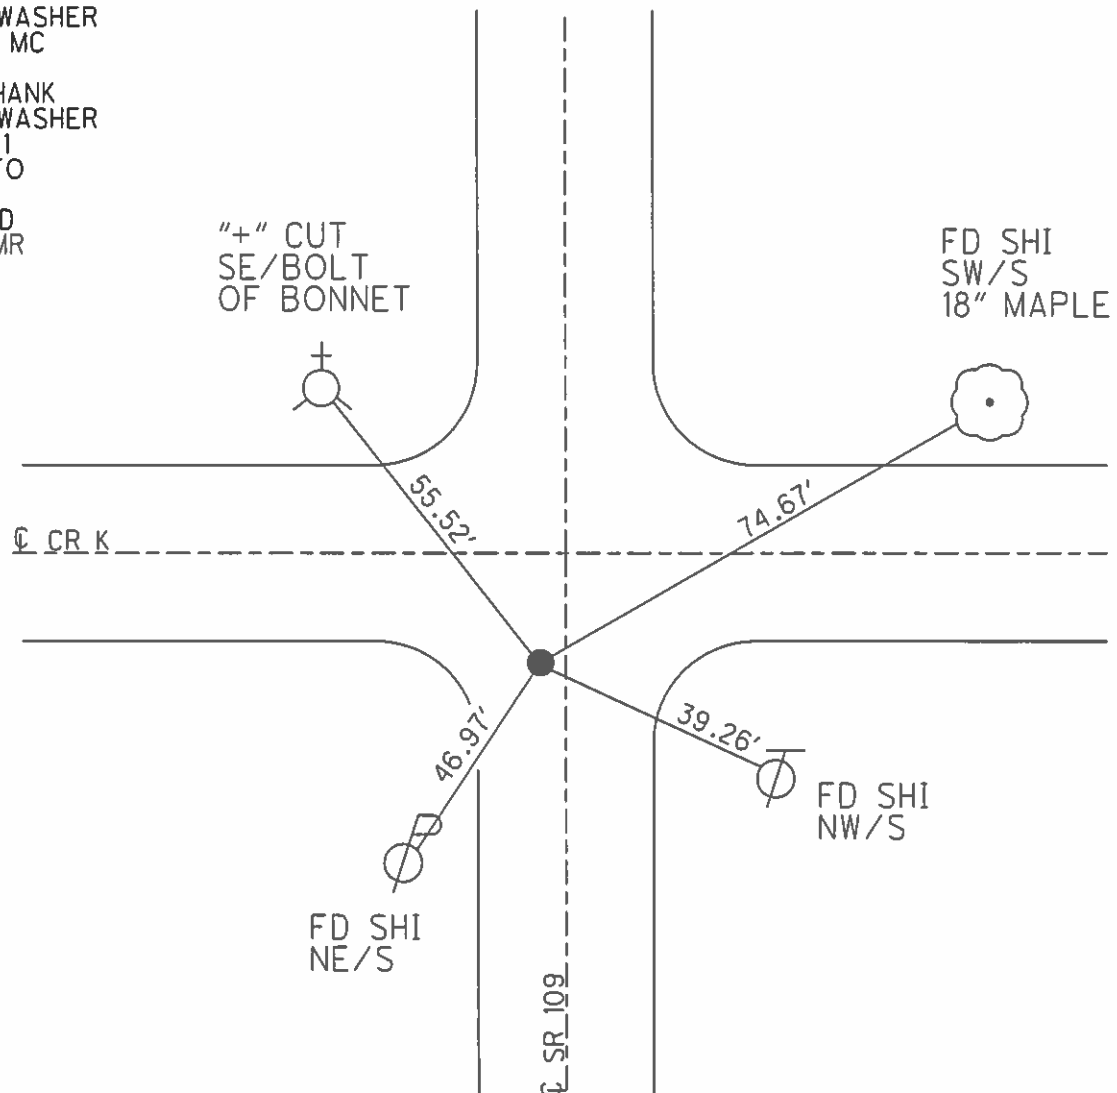

O.D.O.T. DISTRICT 2 SURVEY OFFICE

PERSONNEL

REFERENCE NO. 22

SHEET 6 OF 23

NOTES CANTERBURY

H.C. BARNHISEL

R.C. HOOVER

DATE 8/31/04

WEATHER SUN

TEMP. +65°

ROUTE 109

COUNTY HENRY

TOWNSHIP MONROE

SECTION 14

T4 N R 7 E

TYPE MONUMENT P.K. / WASHER


ON SURFACE - BELOW SURFACE

LEFT - E PAV'T. - RIGHT 1.0' LT E

8.9' TO LT EDGE PAVEMENT ON S. EDGE OF PAVT. EXTENDED

S.L.M. 530 + 56


CO. RD. "K" EAST

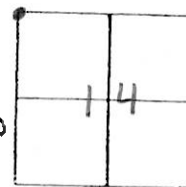

RESET MAG/WASHER

10/28/04

M.C.

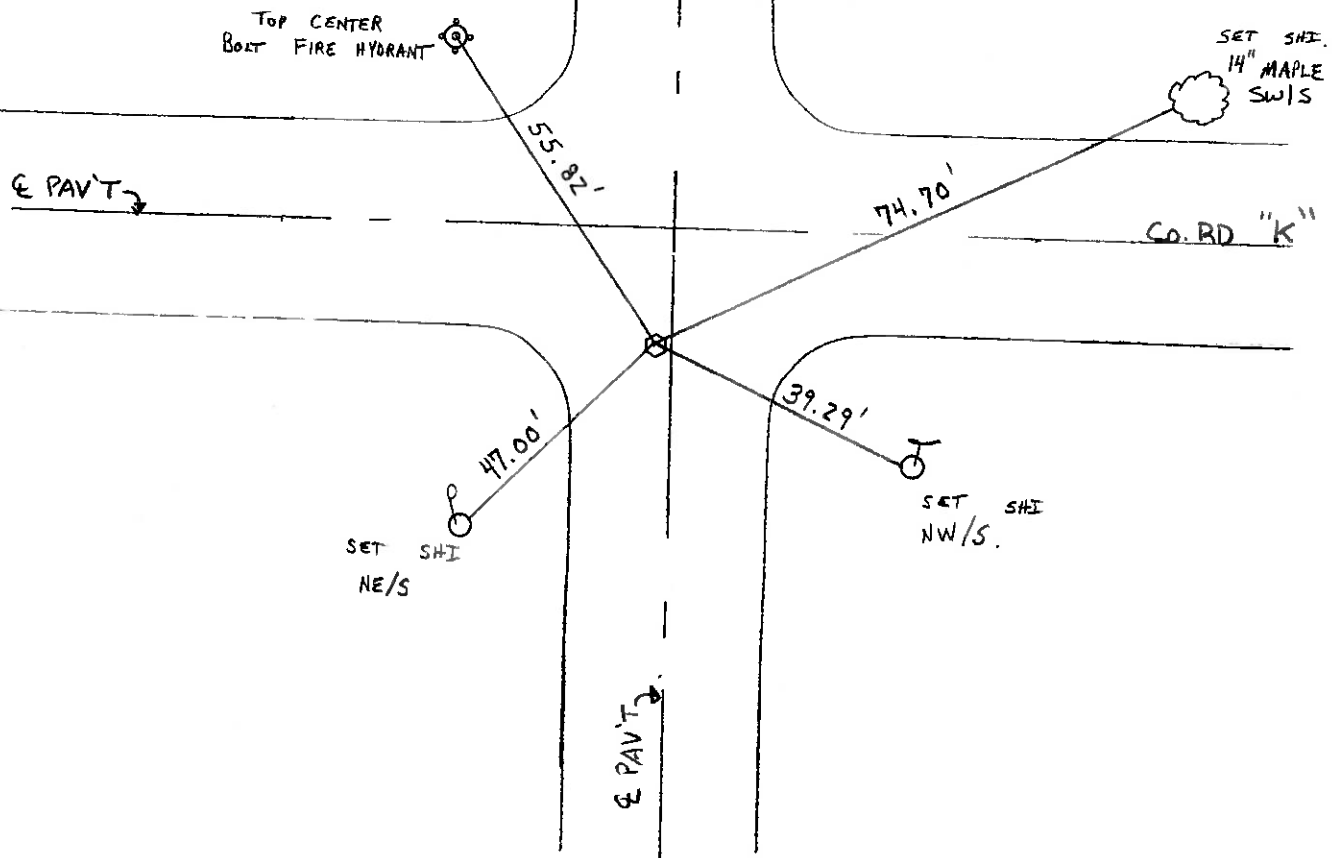

O.D.O.T. DISTRICT 2 SURVEY OFFICE

PERSONNEL

REFERENCE NO. 22

SHEET OF

NOTES BARNHISEL

H.C. VAN DUSEN

R.C. KUSZ

DATE 8-17-93

WEATHER FOG

TEMP. +81°F

ROUTE 109

COUNTY HENRY

TOWNSHIP MONROE

SECTION 14

T 4 N R 2 E


TYPE MONUMENT LARGE RR SPK. PUNCH HOLE

ON SURFACE - BELOW YES


LEFT- & PAVT. - RIGHT 1.4

8.8 TO LT. EDGE PAVEMENT ON S. EDGE PAVT. OF ROAD TO EAST

S.L.M. 530+56

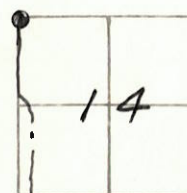

SET PK/WASHER
8-24-93
MB

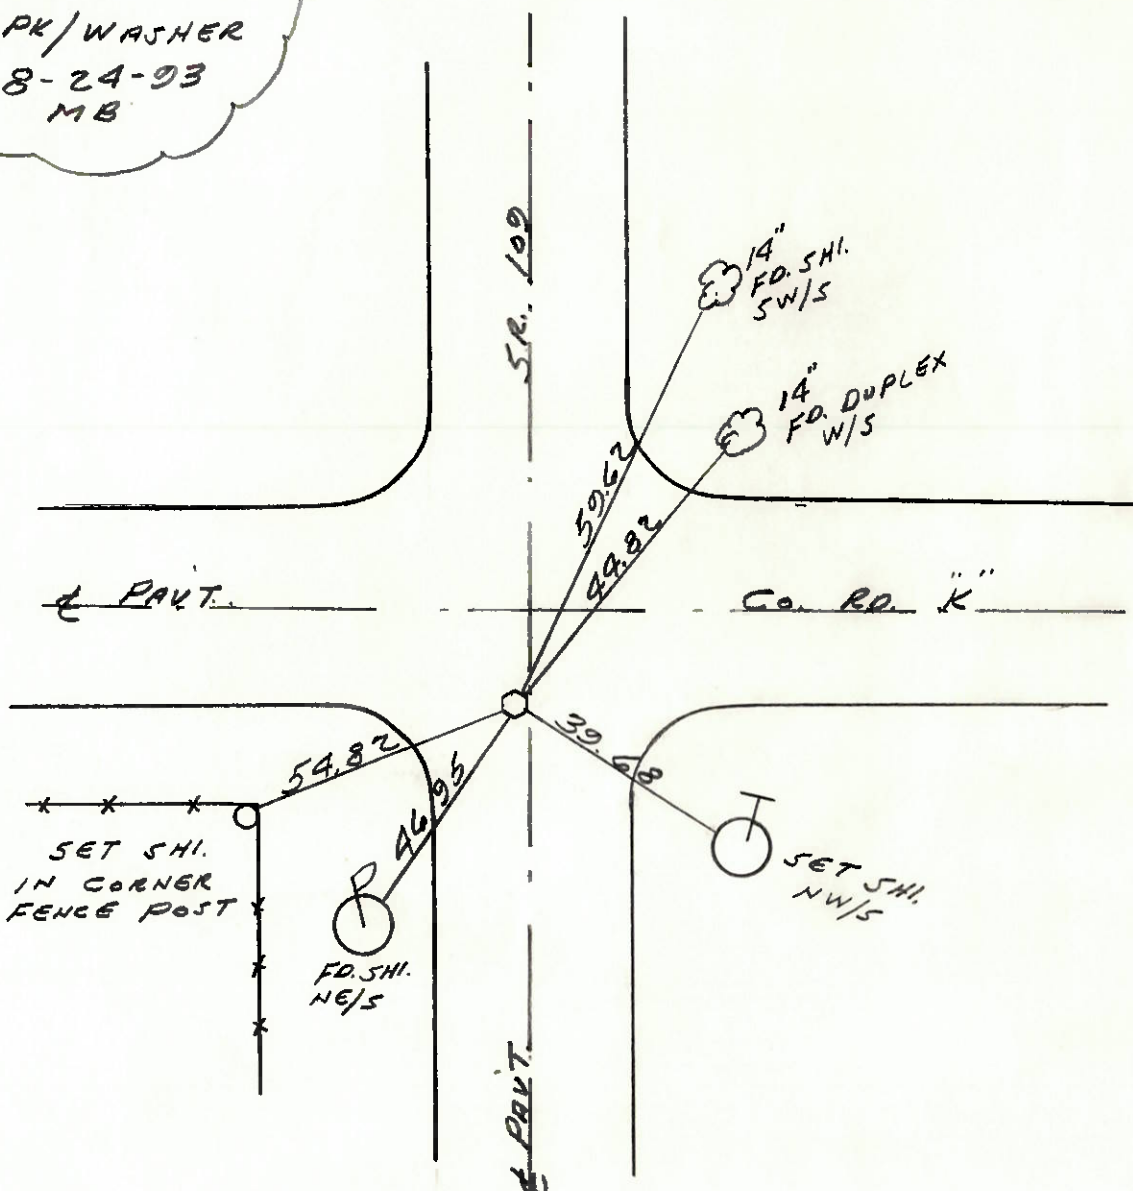

O.D.O.T. DISTRICT 2 SURVEY OFFICE

PERSONNEL

REFERENCE NO. 22

SHEET OF

NOTES Barnhiser

H.C. Hoffman

R.C. Loehrke

DATE 4-8-85

WEATHER clear

TEMP. +35°

ROUTE 109

COUNTY Henry

TOWNSHIP Monroe

SECTION 14

T 4 N R 7 E



TYPE MONUMENT Lg RR/spk Punch hole

ON SURFACE - BELOW ✓

LEFT - 0 PAV'T. - RIGHT 0.8


TO EDGE PAVEMENT 6' 30" E 20" K"

S.L.M. 529+99

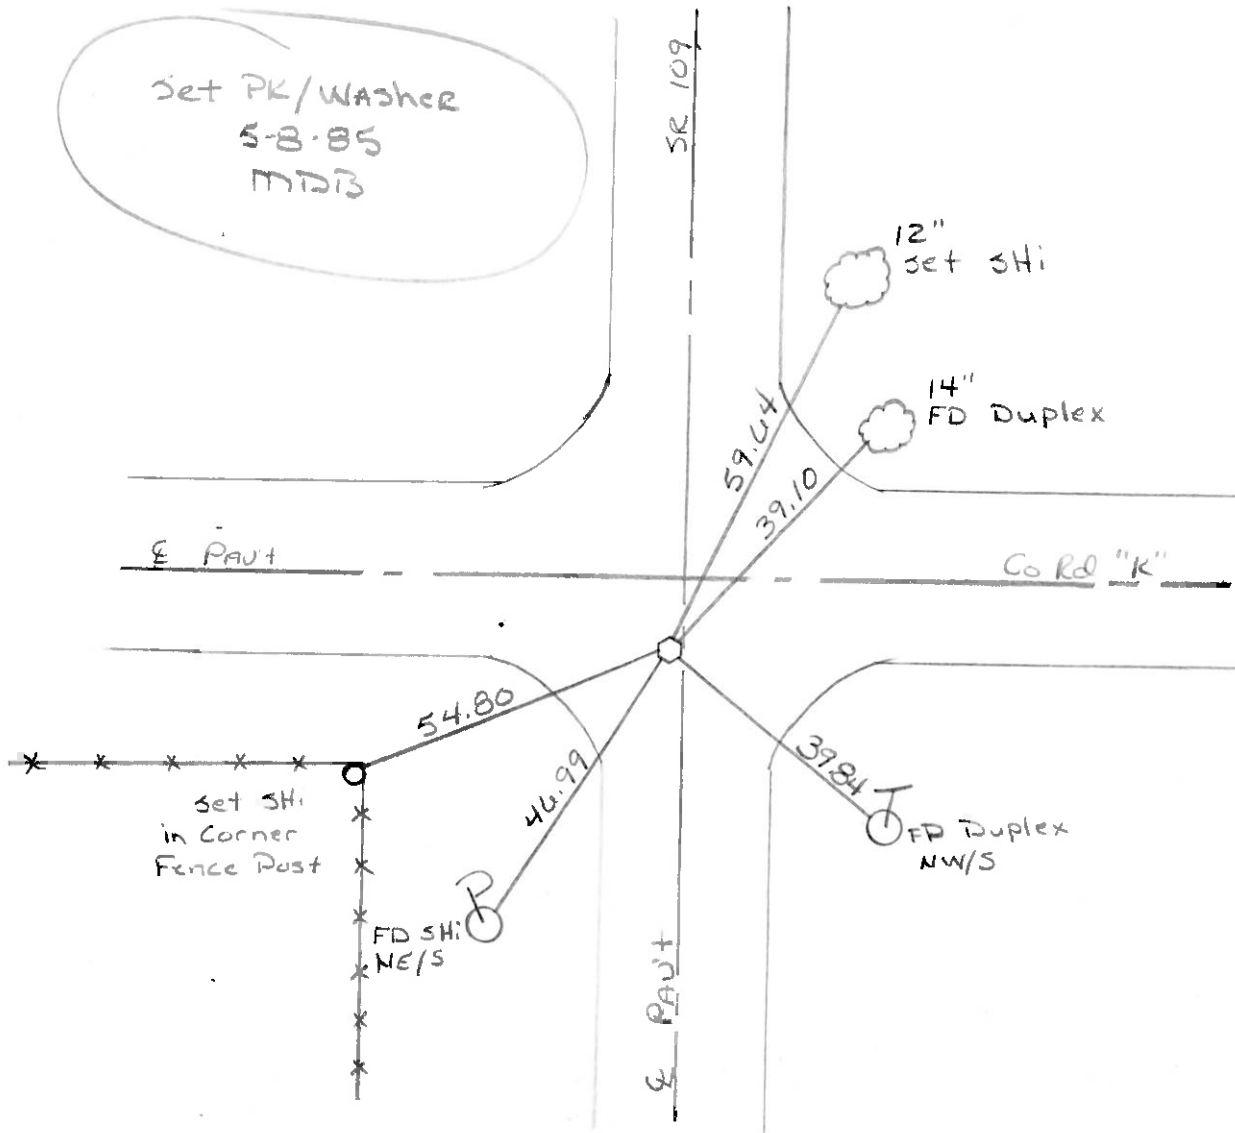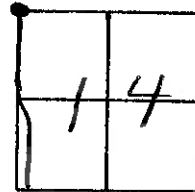

COUNTY HENRY
TOWNSHIP MONROE S.R. 109
SECTION 14

T 1 N , R 7 E

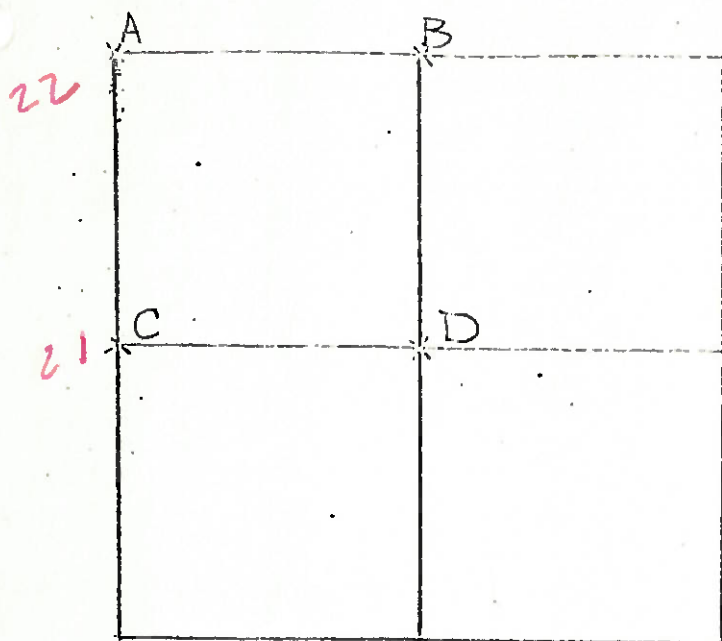

7-13-79 P.W. J.J. G.M.
C - FOUND STONE (6" x 7" x 8")
20" BELOW ROAD SURFACE
PLACED CENTER PUNCHED
R.R. SPIKE ON SURFACE
OVER HIGH POINT OF STONE
P.K.'S SET 6' N. & E
98.53' N.N.E. TO DUPLEX ^{W/S} 6
47.76' S.E. TO DUPLEX ^{W/S} 6
30.44' S.W. TO DUPLEX ^{SE/S} 6

5-1-79 R.W. J.J.

D - FOUND IRON PIPE AND STONE LEANING TO THE SOUTH. PLACED STONE
IN VERTICAL POSITION FROM RECORDED WITNESS TIES. PLACED IRON
PIPE ON ^{W/S} OF STONE ANGLED OVER HIGH POINT OF STONE. TOP OF
PIPE OVER HIGH POINT. STONE IS 12" BELOW GROUND LEVEL.
21.65' E.S.E. TO "+" IN NORTH END OF EAST HEADWALL (PLUMBED)
9.73' S.E. TO "+" IN NORTH END OF WEST HEADWALL (PLUMBED)
14.82' S.S.E. TO "+" IN SOUTH END OF WEST HEADWALL (PLUMBED)


COUNTY HENRY SR 109

TOWNSHIP MONROE

SECTION 14

T 4 N , R 7 E

7-9-79
R.W., J.J., G.M.

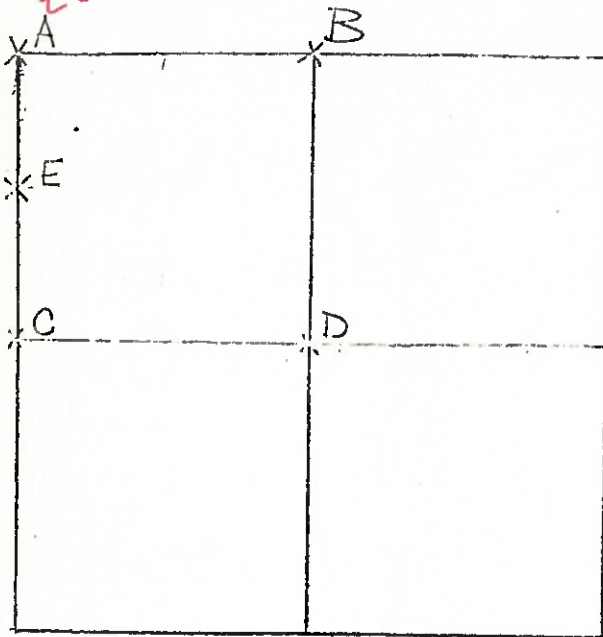

A - FOUND RR SPIKE OVER IRON ROD
SET IN CONCRETE PAVEMENT. COULD
NOT LOCATE SPIKE. RECOVERED IRON
ROD AND SET 1" DIA. x 30" RE-PAIR
7" BELOW ROAD SURFACE. PLACED
CENTER PUNCHER RR SPIKE ON
SURFACE. P.K.'S SOUTH & WEST
SPIKE IS 2.4' EAST OF WEST EDGE OF

20' PAVEMENT.

39.06' N.E. TO DUPLEX $\frac{W}{S}$ 12"

39.74' S.E. TO DUPLEX $\frac{W}{S}$ TELEPHONE

46.98' S.W. TO NAIL & SHINER $\frac{NE}{S}$ POWER POLE

4-12-79 R.W., J.J.

B - FOUND RECORDED IRON PIN ALONG SIDE OF STONE (4" x 8" x 12")
13" BELOW EDGE OF PAVEMENT. PLACED NEW IRON PIN (12" LONG)
OVER CENTER OF STONE. P.K.'S 6' N.W. & N.E.

STONE IS 6" SOUTH OF SOUTH EDGE OF PAVEMENT.

NO TIES AVAILABLE

7-13-79 R.W., J.J., G.M.

E - FOUND HINGE NAIL 2.1' WEST AND 1.5' NORTH OF HIGH POINT OF STC
(10" x 12" x 18") 14" BELOW ROAD SURFACE. REMOVED HINGE NAIL AND PLACED
CENTER PUNCHER P.R. SPIKE ON SURFACE OVER HIGH POINT OF STONE. STONE
LOCATED 10' EAST OF WEST EDGE OF 10' PAVEMENT. P.K.'S SET 6' S.E. W

SPIKE 32.02' W. TO IRON PIN HINGE NAIL 29.98'

24.93' - W. TO "+" EAST END CONC. HDNAIL - 22.92' (REMOVED)
33.80' - E.N.E. TO DUPLEX $\frac{N.W.}{S}$ T - 34.12'
59.96' - S.S.W. TO DUPLEX $\frac{S.W.}{S}$ T - 60.34'

PERSONNEL TITLE PERSONNEL TITLE

TOMSK

NORSE

GRANATI

VANYA

COUNTY. HENRY

DATE NOV. 1, 1973

S. R. 109

WEATHER

SEC. MONROE TWP.

TEMP.

DESCRIPTION

LEFT

CENTER LINE

RIGHT

JOB NO.

Jct. S.R. 109
\$ MAIN ST
MALINTA O.

23-A

Fd. Nail @ surface

shiner

23.16'

S.R.
(TURKEYFOOT)

109 Rd

46.08'

MAIN ST.

shiner

36.01'

shiner

Jct. S.R. 109
\$ TWP. Rd K-2
MALINTA O.

23

Fd. R.R. spk. @ surface

shiner

25.15'

S.R.
(TURKEYFOOT)

109 Rd

39.68'

TWP. K-2

shiner

34.80'

shiner

S. CORP LINE
MALINTA O.

22

shiner

shiner

59.61'

109 Rd

Fd. Iron Rod 3" below surface
(8 1/2 S. & Co. Rd "K")S. CORP.
Co. Rd. "K"LINE MALINTA
TWP. Rd. "K"

47.06'

S.R.
(TURKEYFOOT)

109 Rd

33.00'

shiner

shiner

PERSONNEL TITLE PERSONNEL TITLE

COUNTY HenryDATE 2-6-58S. R. #109

WEATHER

SEC.

TEMP.

DESCRIPTION

Malinta

JOB NO.

LEFT

CENTER LINE

RIGHT

Control Points checked by Jameson 3-6-58

22 #72 Iron Pin

60.80

#1.07' N.W. To Shi. ^{T POLE} ~~P. Pole~~

✓ South Corp Line

OK 2/6/58

39.20

21.65' S.W. To ~~SHINER~~ ^{SHINER} ~~1.0' W. P Pole~~

Sta 530+11.2

41.35

21.55' S.E. To ~~SHINER~~ ^{SHINER} ~~T Pole~~

2?

51.60' NW TO CONC FOUNDATION 1' FROM GRND

43.0' NE TO SHINER IN MAPLE TREES

23 #73 IRON PIN. OK 2/6/58

~~46.83' N.E. To NEAR side pipe in~~

Sta 556+44.15 Twp. Rd. K. 2

Angle 00°-17' H. E. Rd.

33.28' S.E. To ~~SHINER~~ ^{SHINER} N.W. Conc. S.W. Side,

38.30

T POLE ~~P. Pole~~

60.39' S.W. To N.E. Cor. Tile

Block Garage

24 #74 Iron Pipe

OK 2/6/58

80.41' N.W. To S.E. Cor. Walk To

North Corp Line Co. Rd. L

Sta 583+22.38

40.45' N.E. To X on Hd. w. ^{29 35} Porch

41.30' E.N.E. " " " "